



RAILROAD CROSS SECTIONS

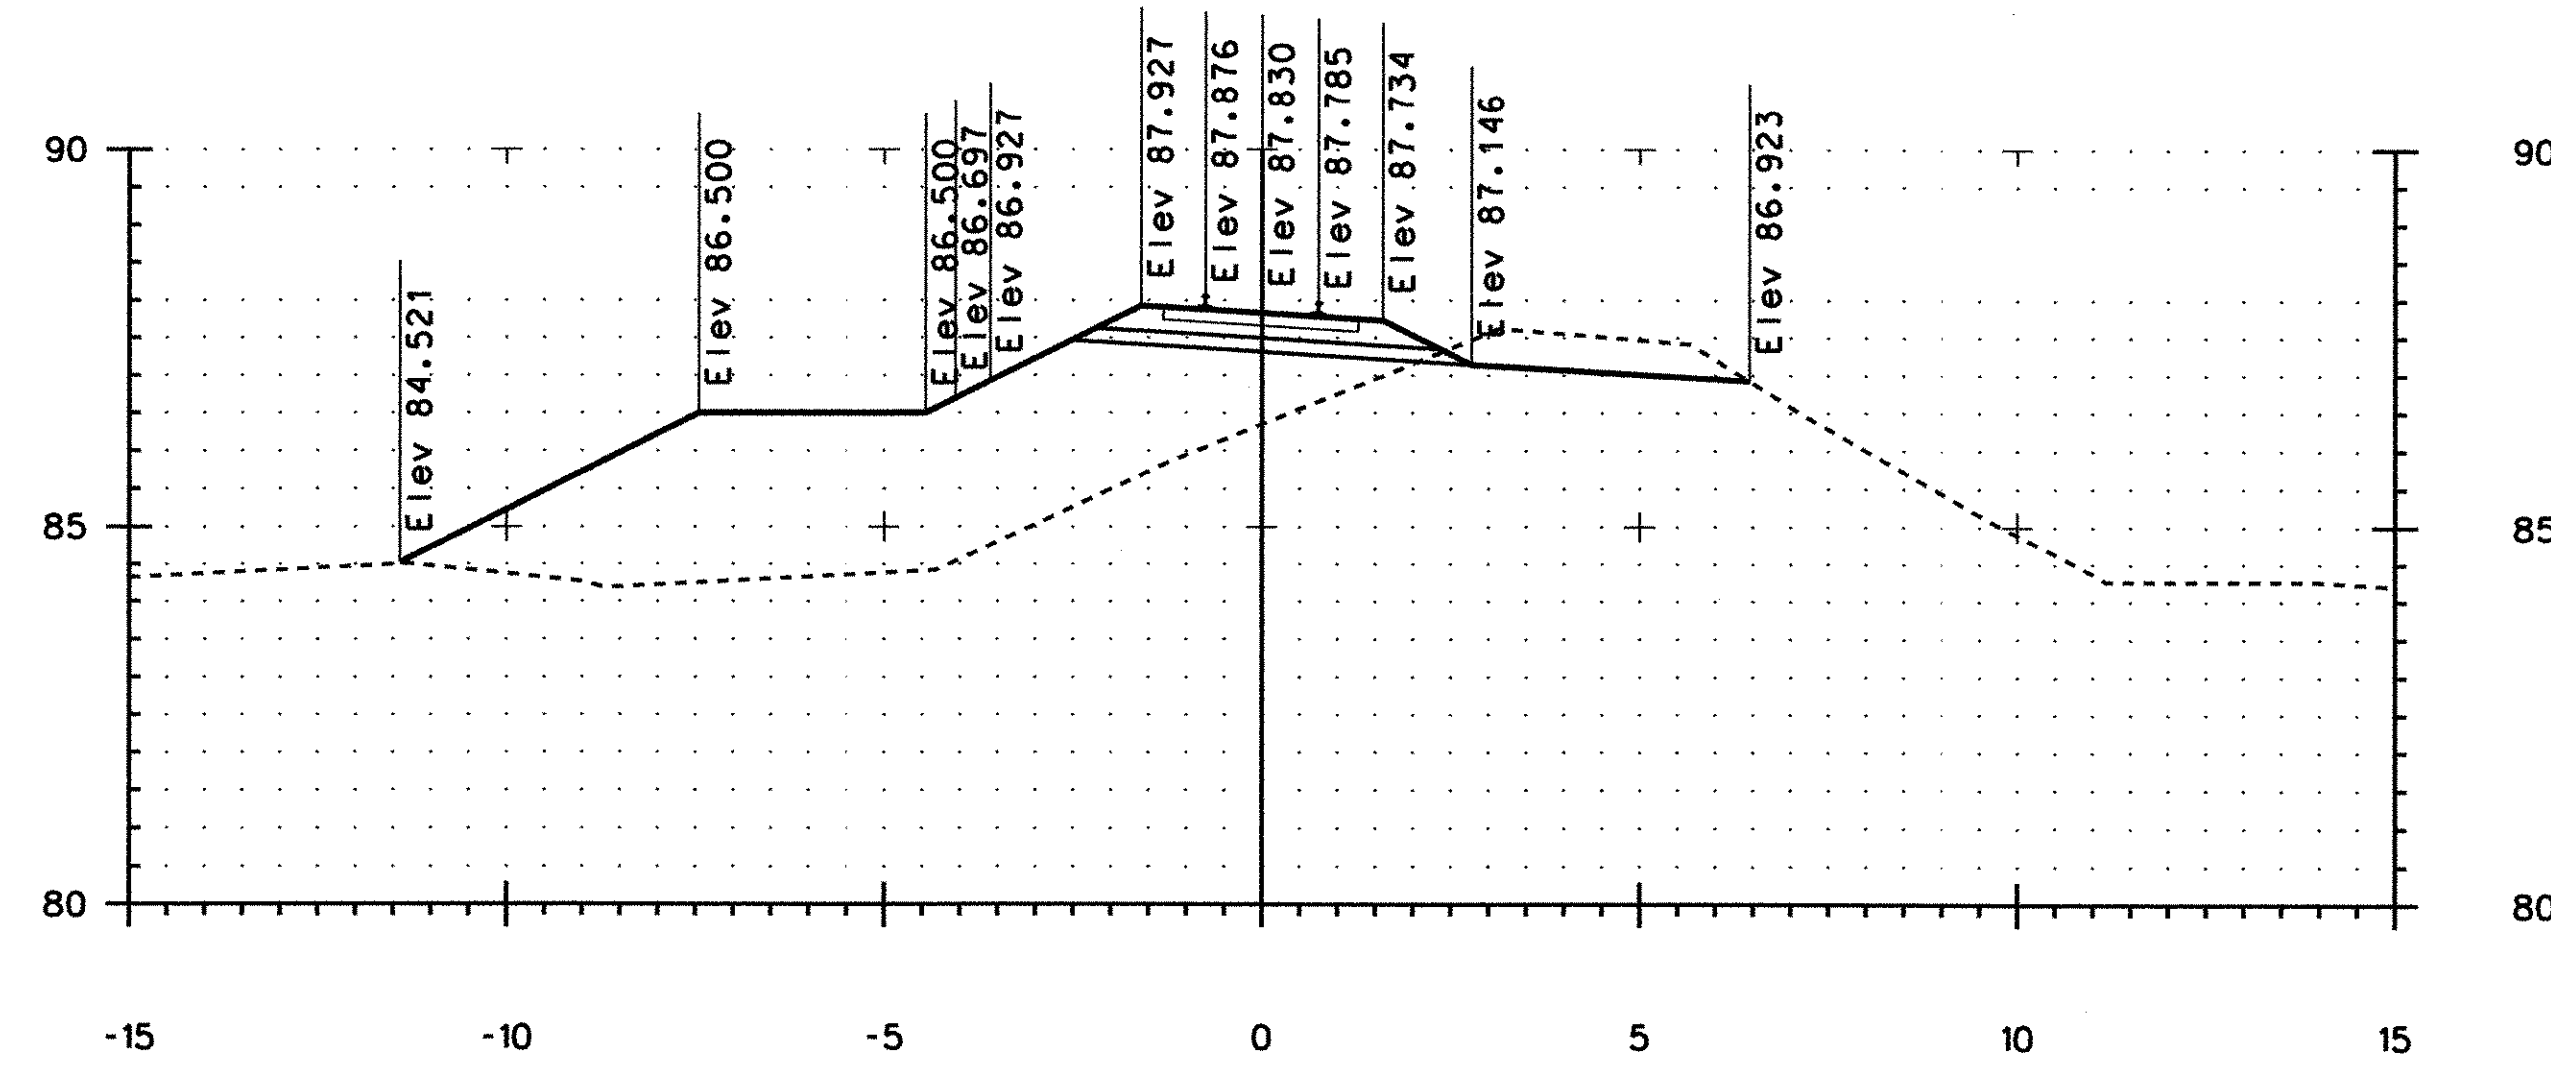

50+220.000

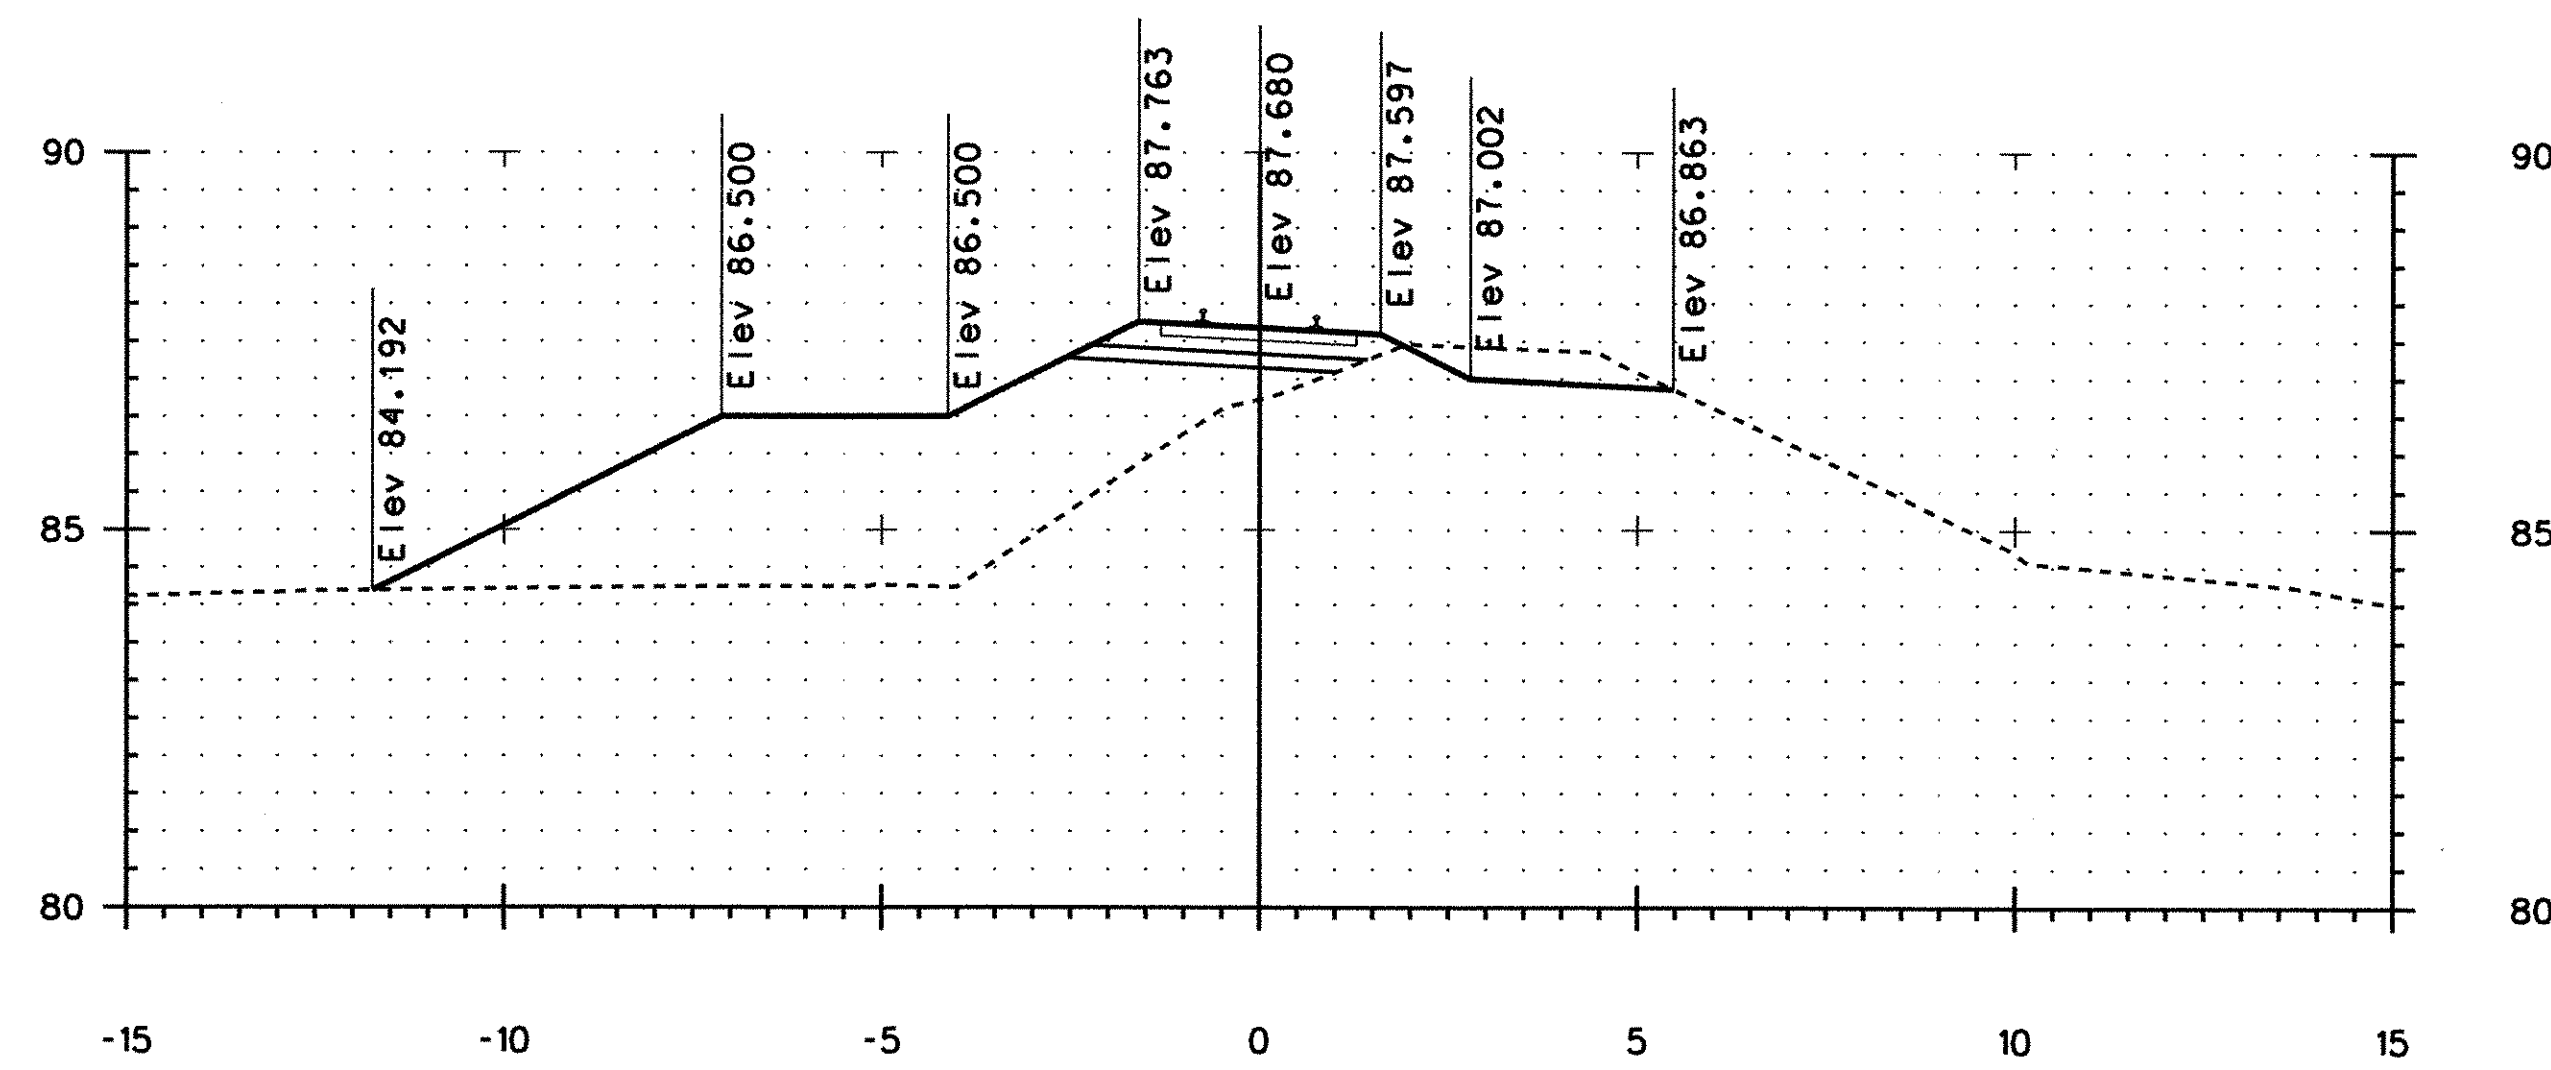

50+200.000

END TRANSITION SECTION
BEGIN FULL DEPTH CONSTRUCTION



PROJECT:	BRATTLEBORO	PROJECT NO.:	NH 010-2(2)
DESIGN FILE NAME:	U:\99123-Brattleboro\dgn\zb270xs1.dgn		
IPARM FILE NAME:	PLOT DATE: 10-02-2002		
FROM STA: 50+200.000 TO STA: 50+220.000 SHEET: 121 OF 145			