



50+260.000

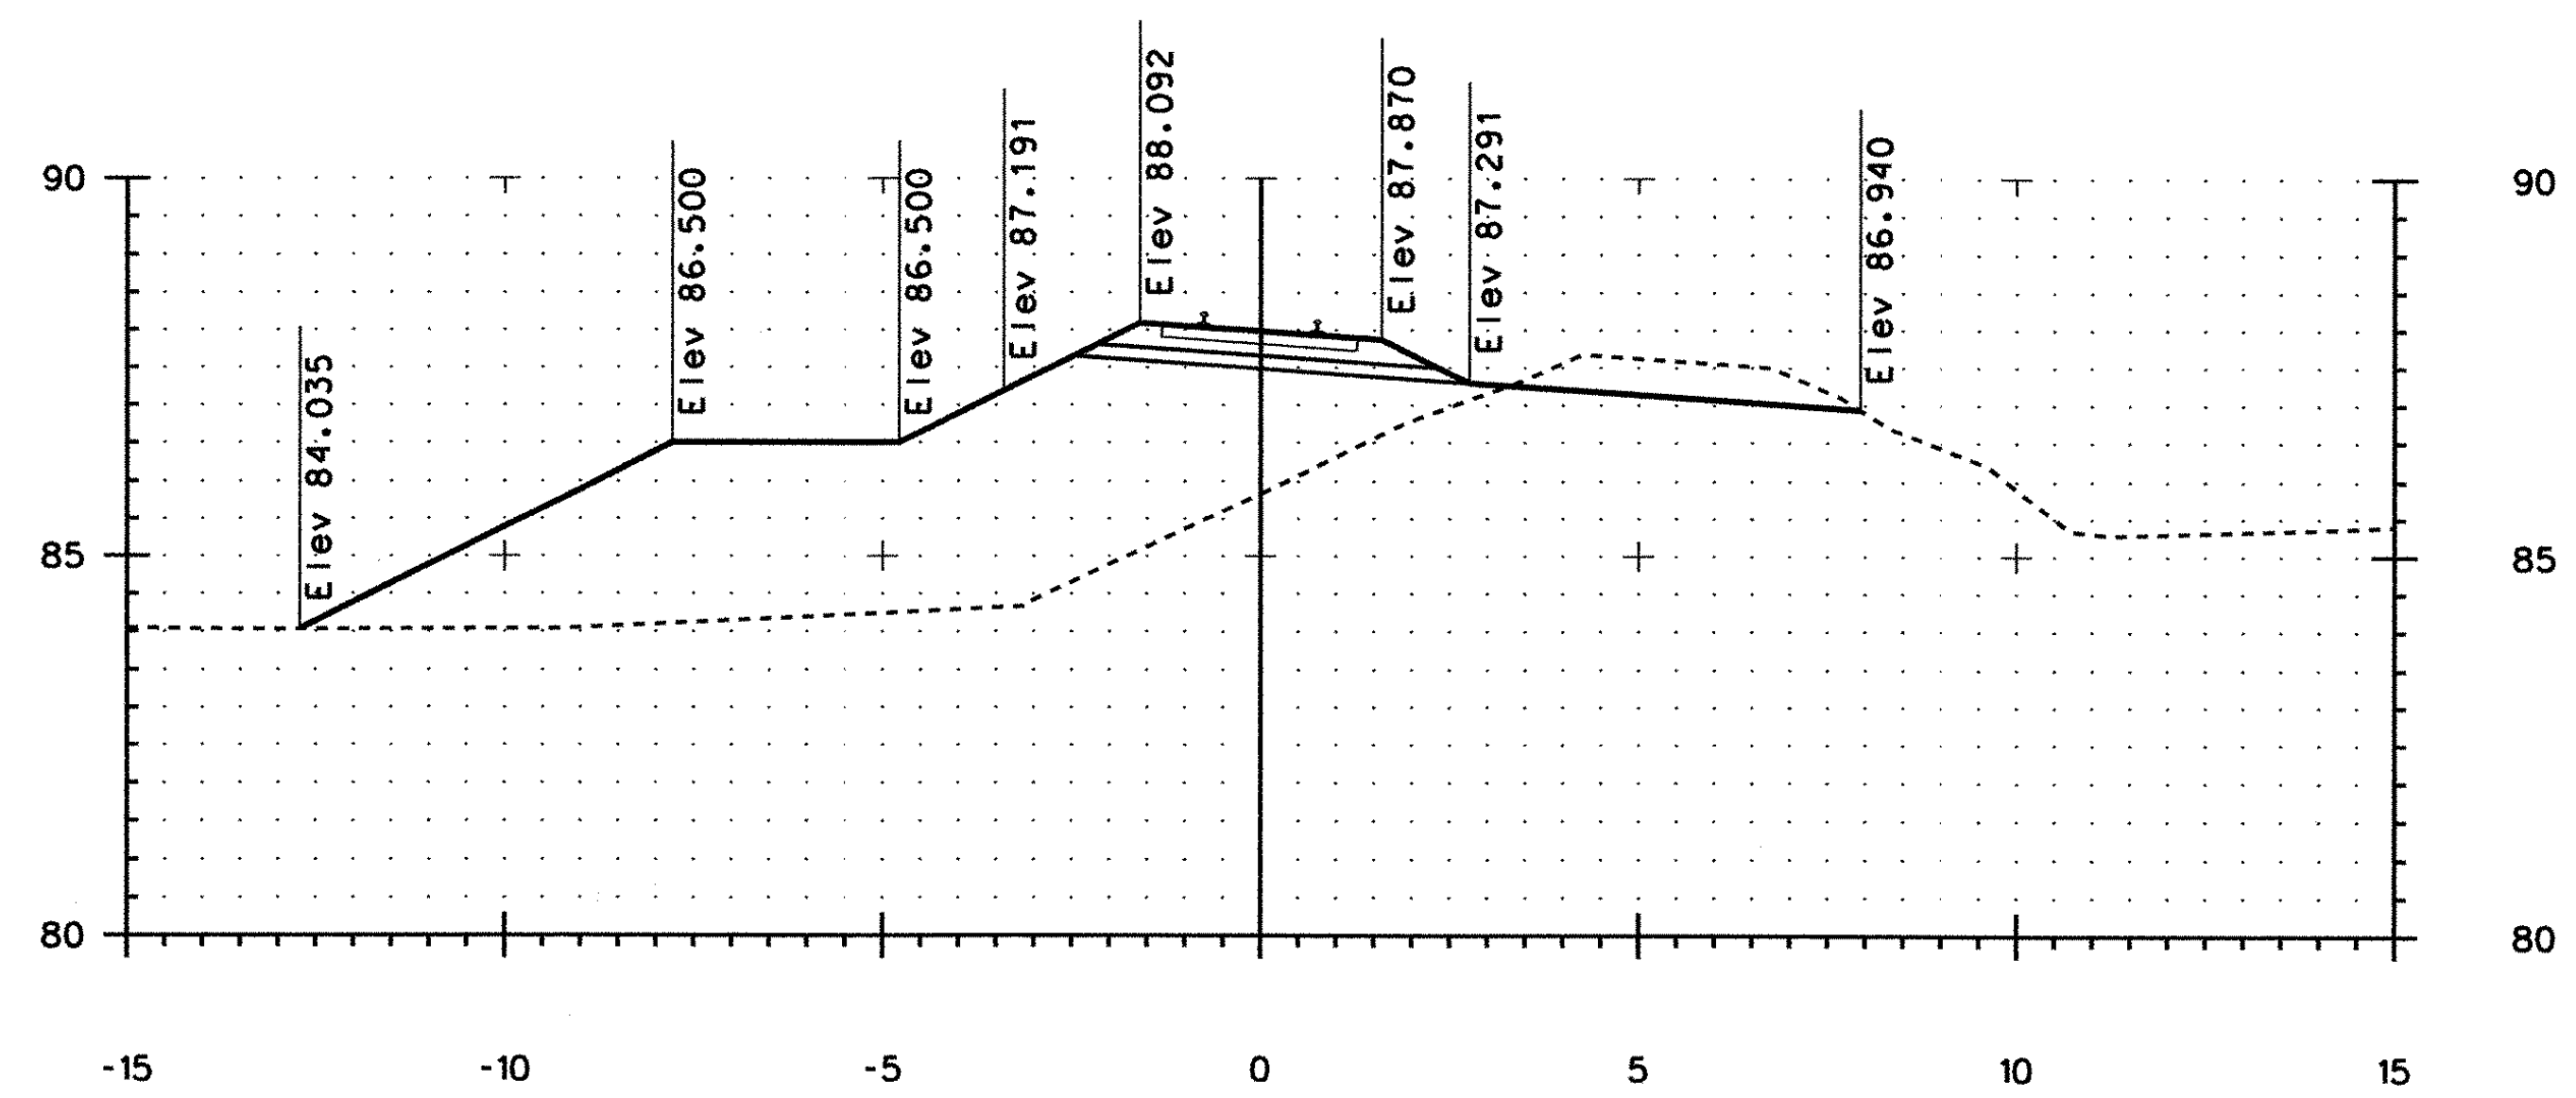

50+240.000

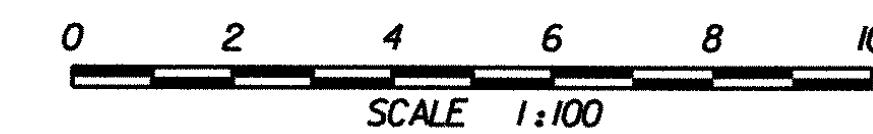

PROJECT: BRATTLEBORO	PROJECT NO.: NH 010-2(2)
DESIGN FILE NAME: U:\99123-Brattleboro\dgn\zb270xsl.dgn	IPARM FILE NAME: PLOT DATE: 10-02-2002
FROM STA: 50+240.000 TO STA: 50+260.000 SHEET: 122 OF 145	