




RAILROAD CROSS SECTIONS

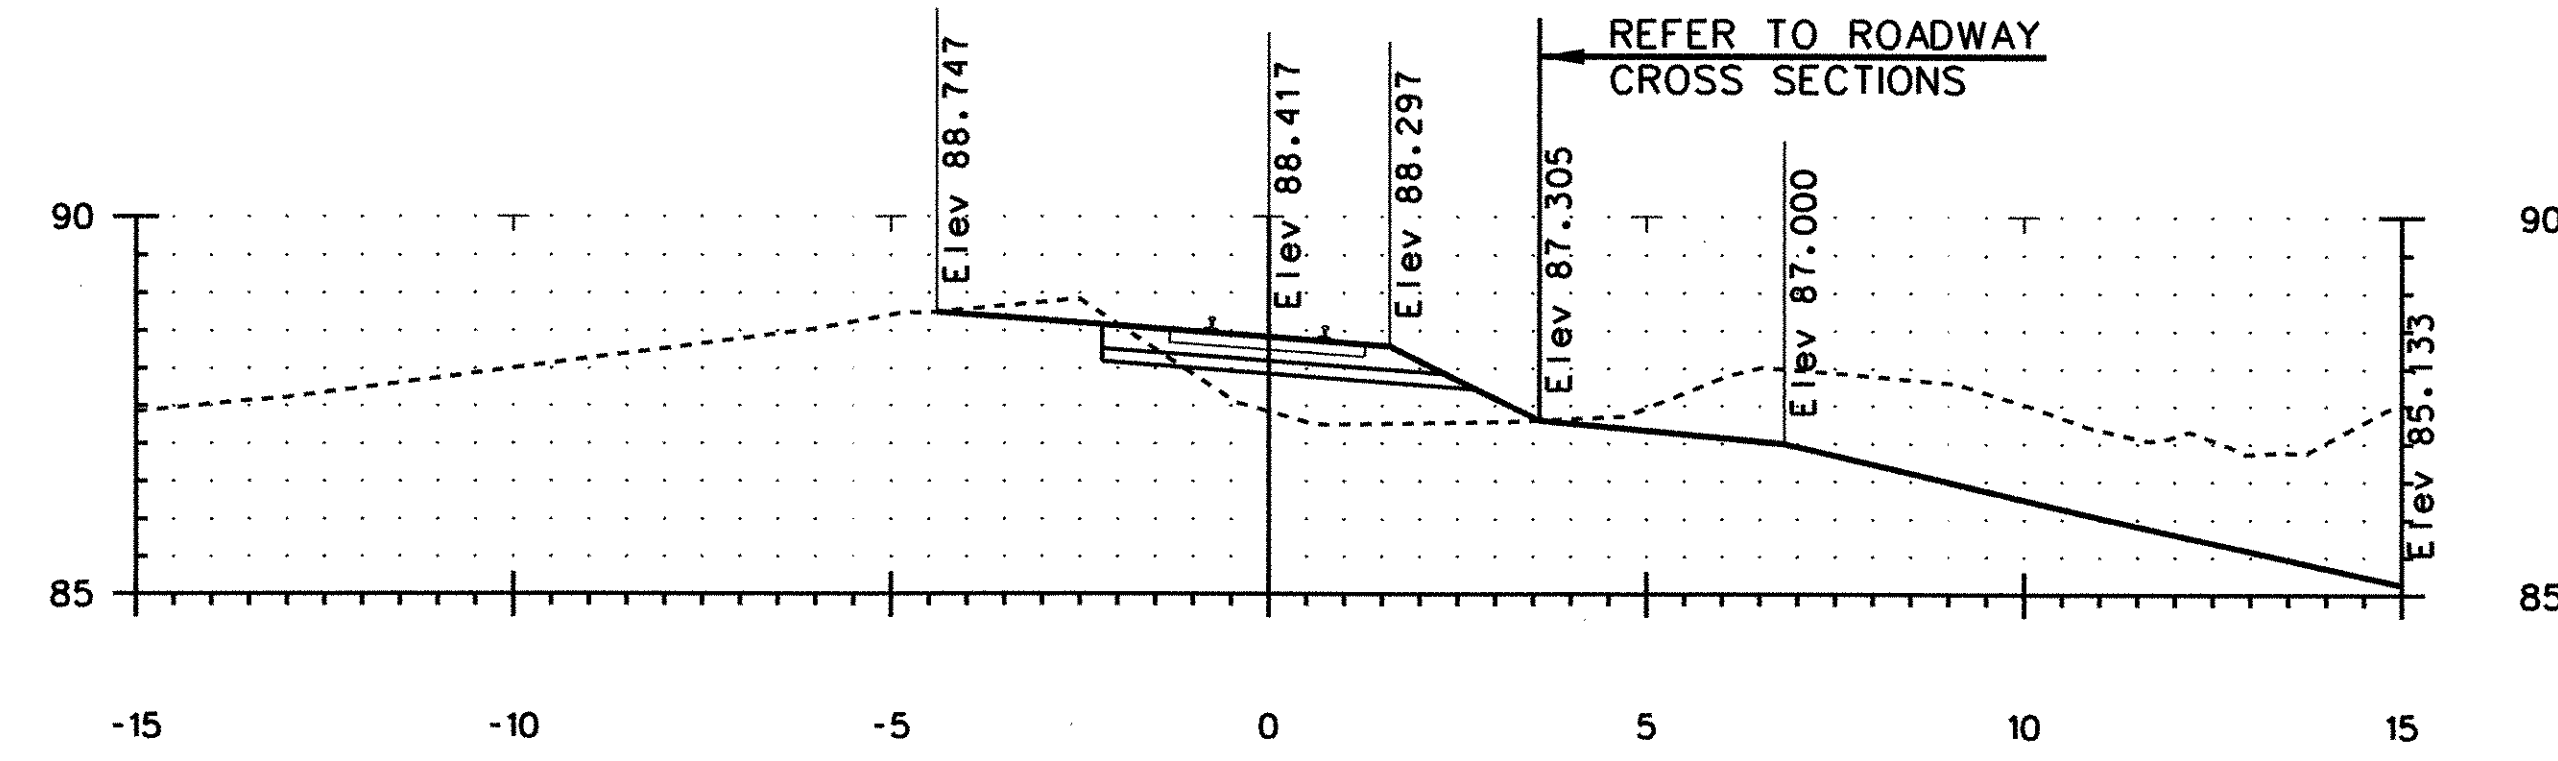

50+300.000

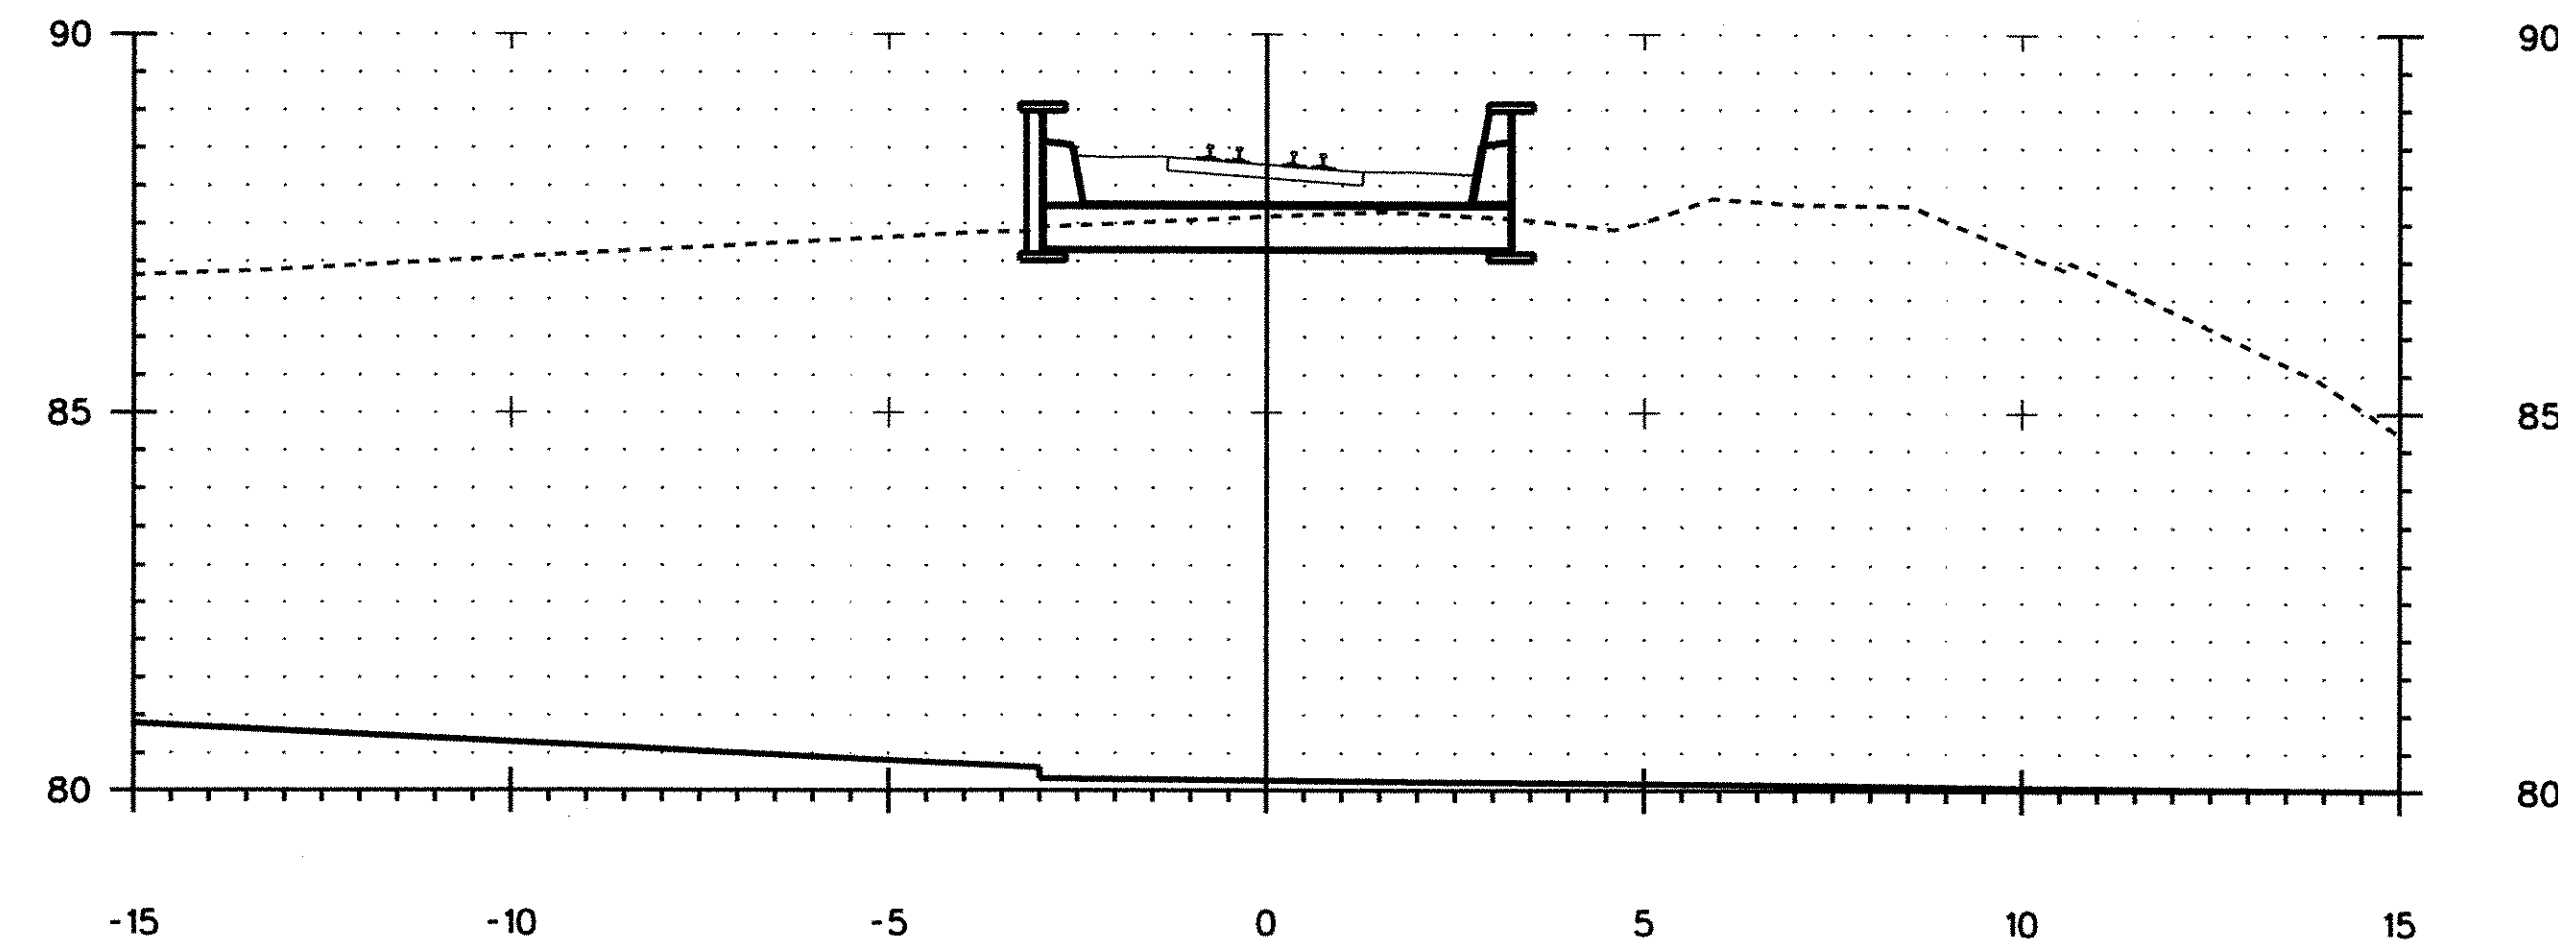

50+280.000

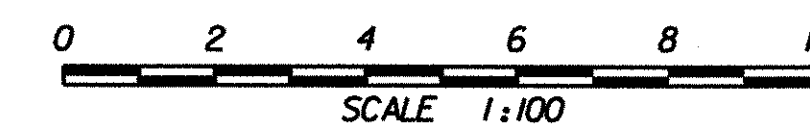

PROJECT:	BRATTLEBORO	PROJECT NO.:	NH 010-2(2)
DESIGN FILE NAME:	U:\99123-Brattleboro\dgn\zb270xs1.dgn		PLOT DATE: 10-02-2002
IPARM FILE NAME:			
FROM STA: 50+280.000 TO STA: 50+300.000 SHEET: 123 OF 145			