




RAILROAD CROSS SECTIONS

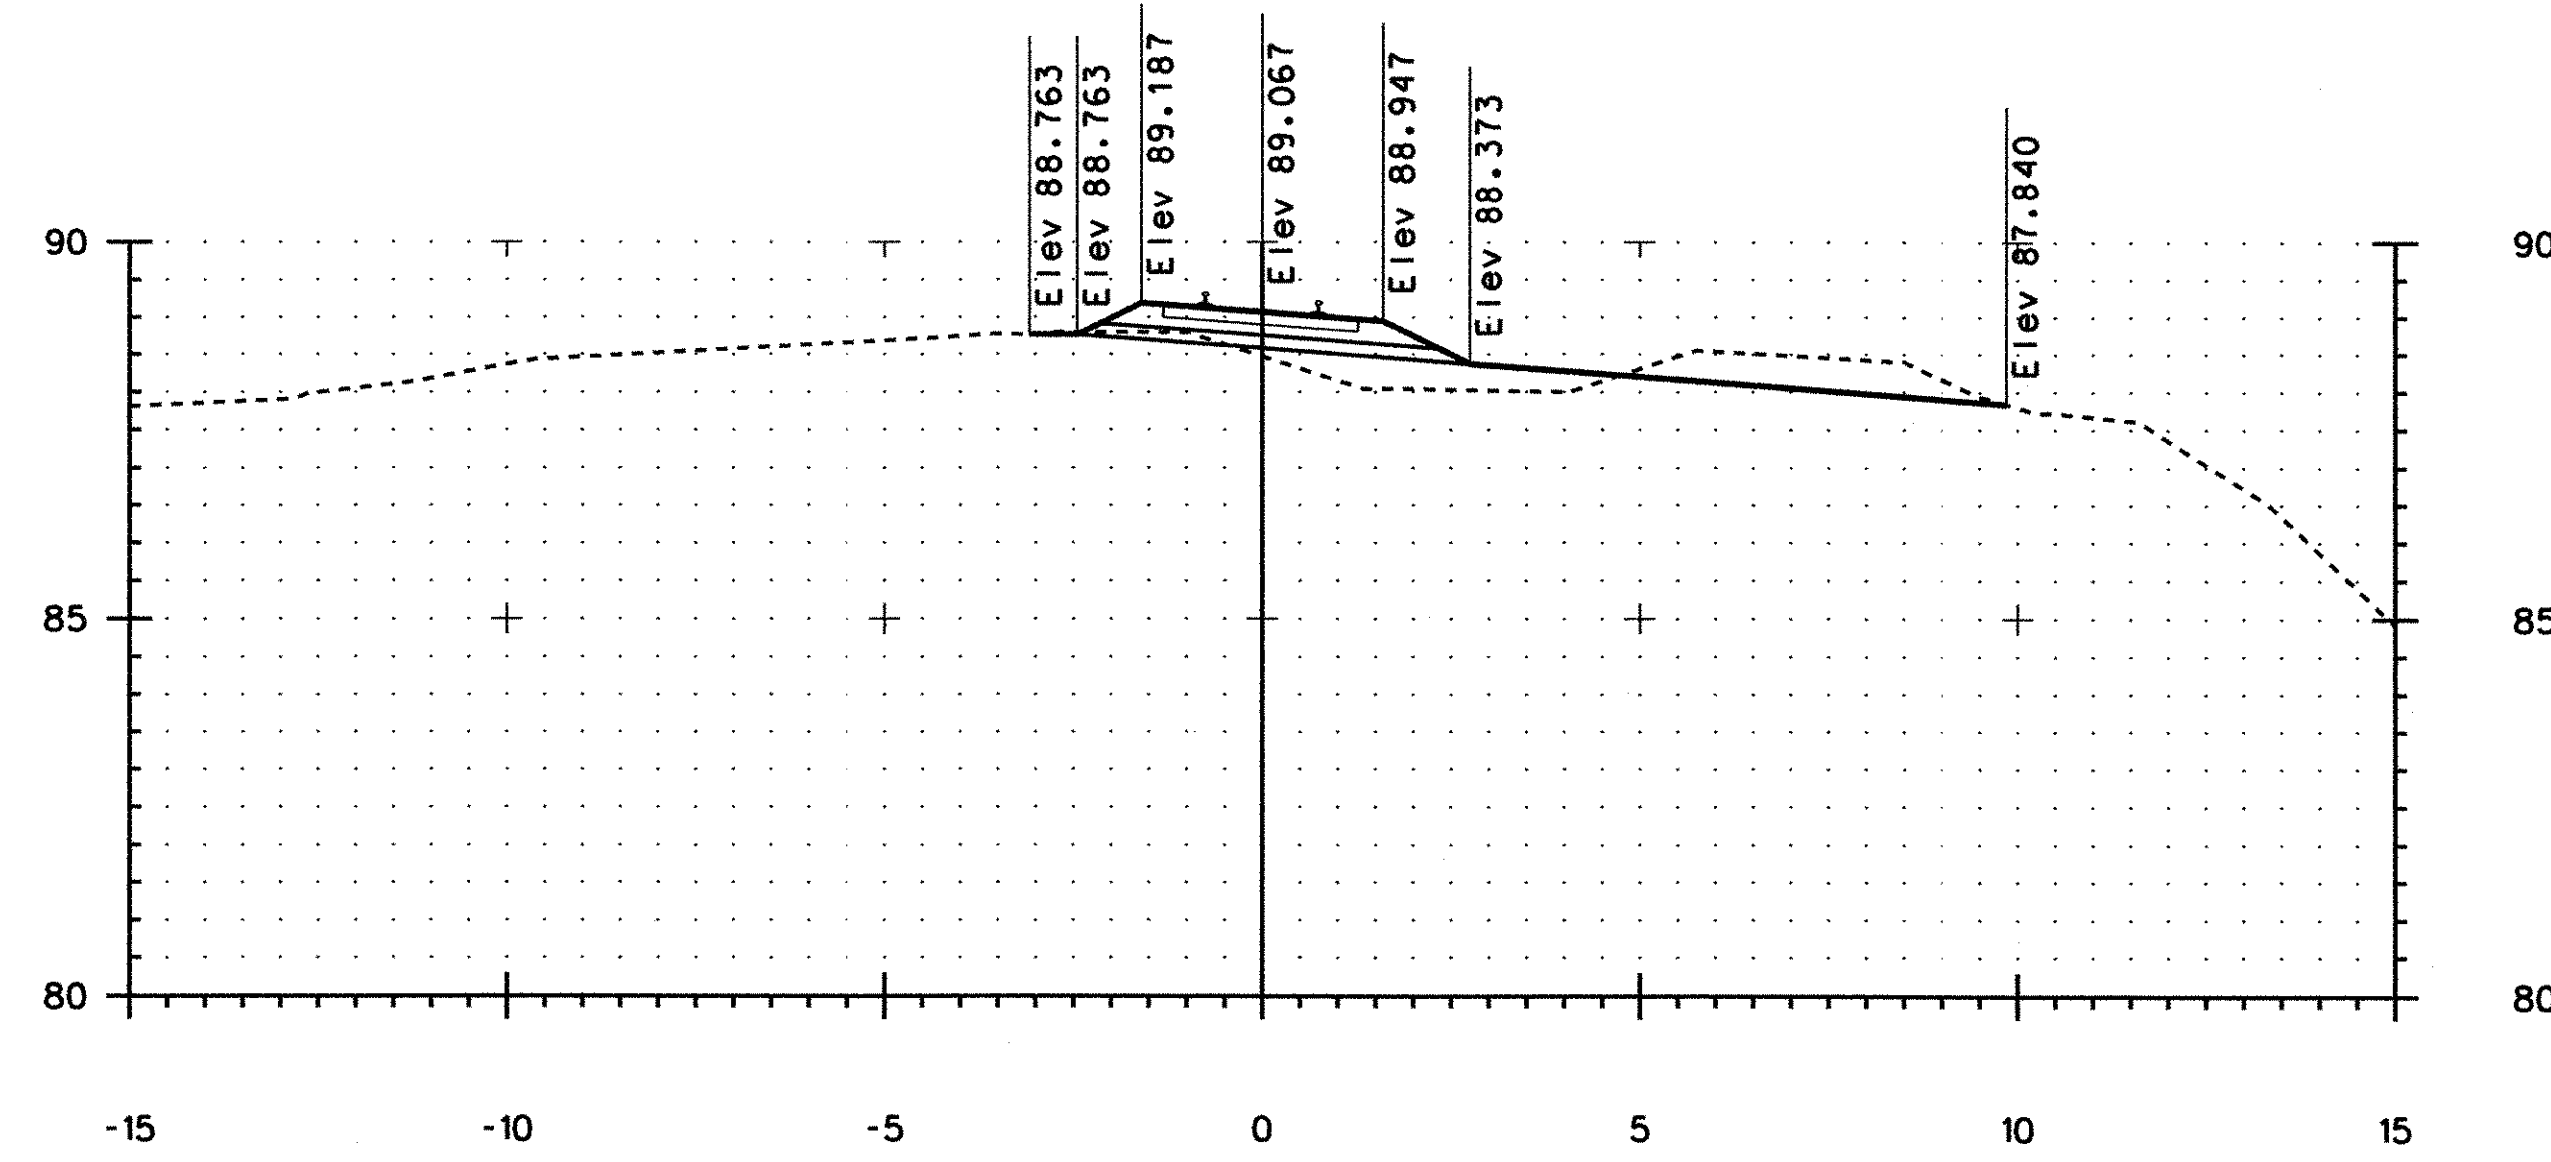

50+420.000

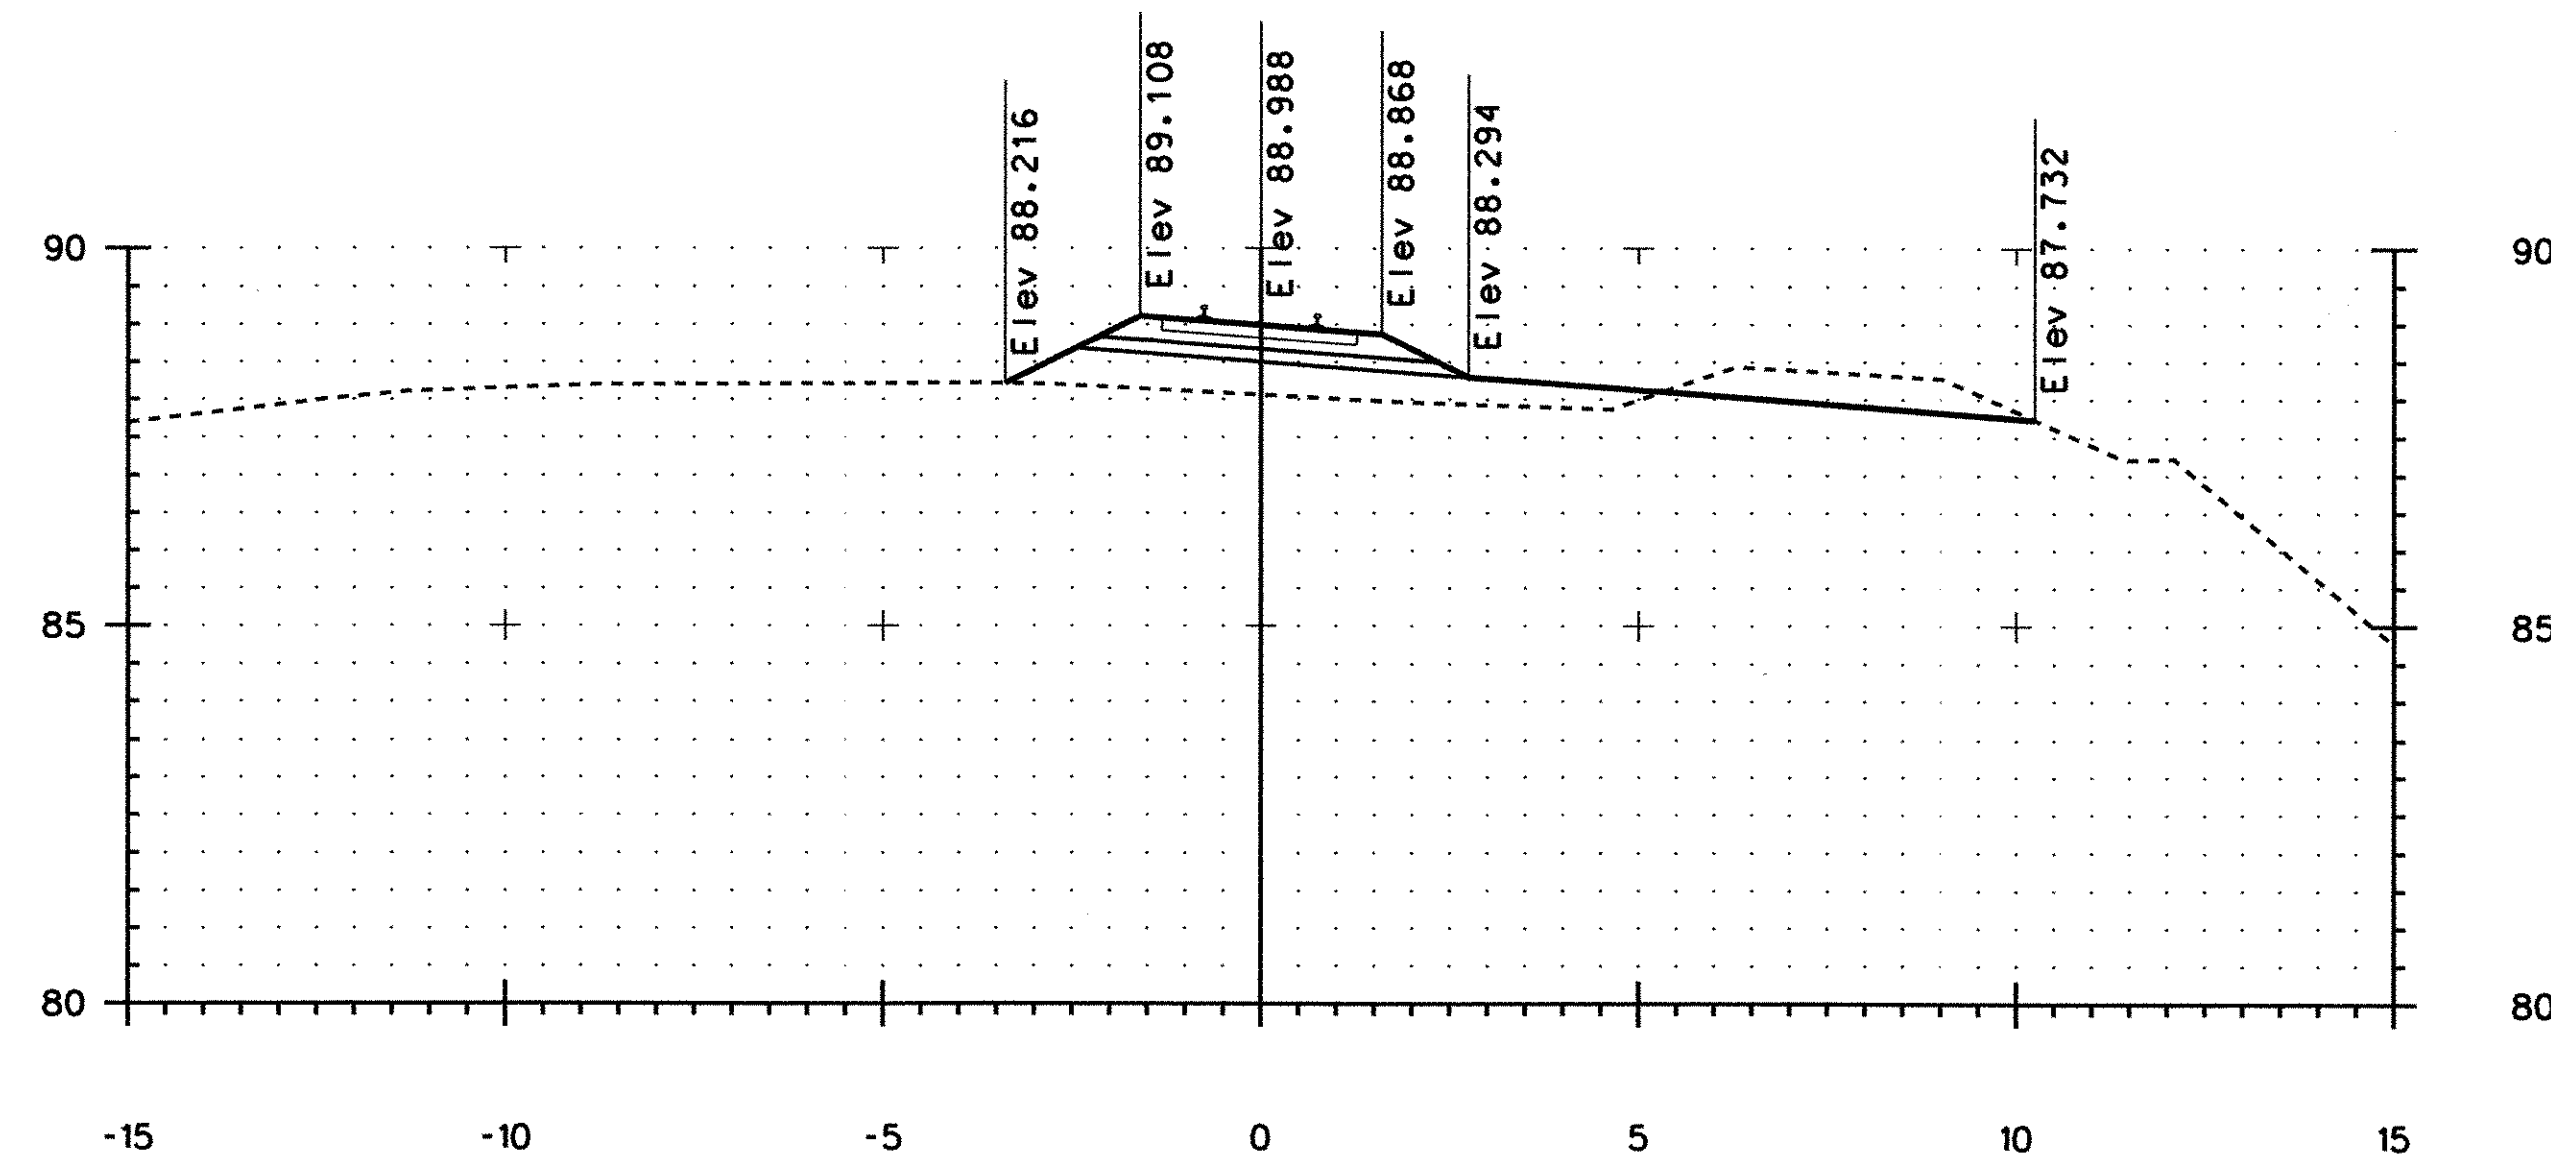

50+400.000

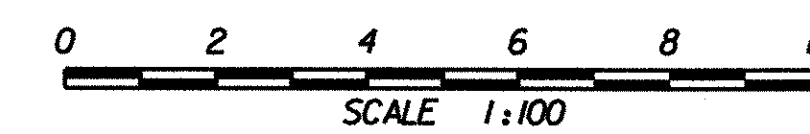

PROJECT:	BRATTLEBORO	PROJECT NO.:	NH 010-2(2)
DESIGN FILE NAME:	U:\99123-Brattleboro\dgn\zb270xs1.dgn		
IPARM FILE NAME:	PLOT DATE: 10-02-2002		
FROM STA: 50+400.000 TO STA: 50+420.000 SHEET: 126 OF 145			