



# RAILROAD CROSS SECTIONS

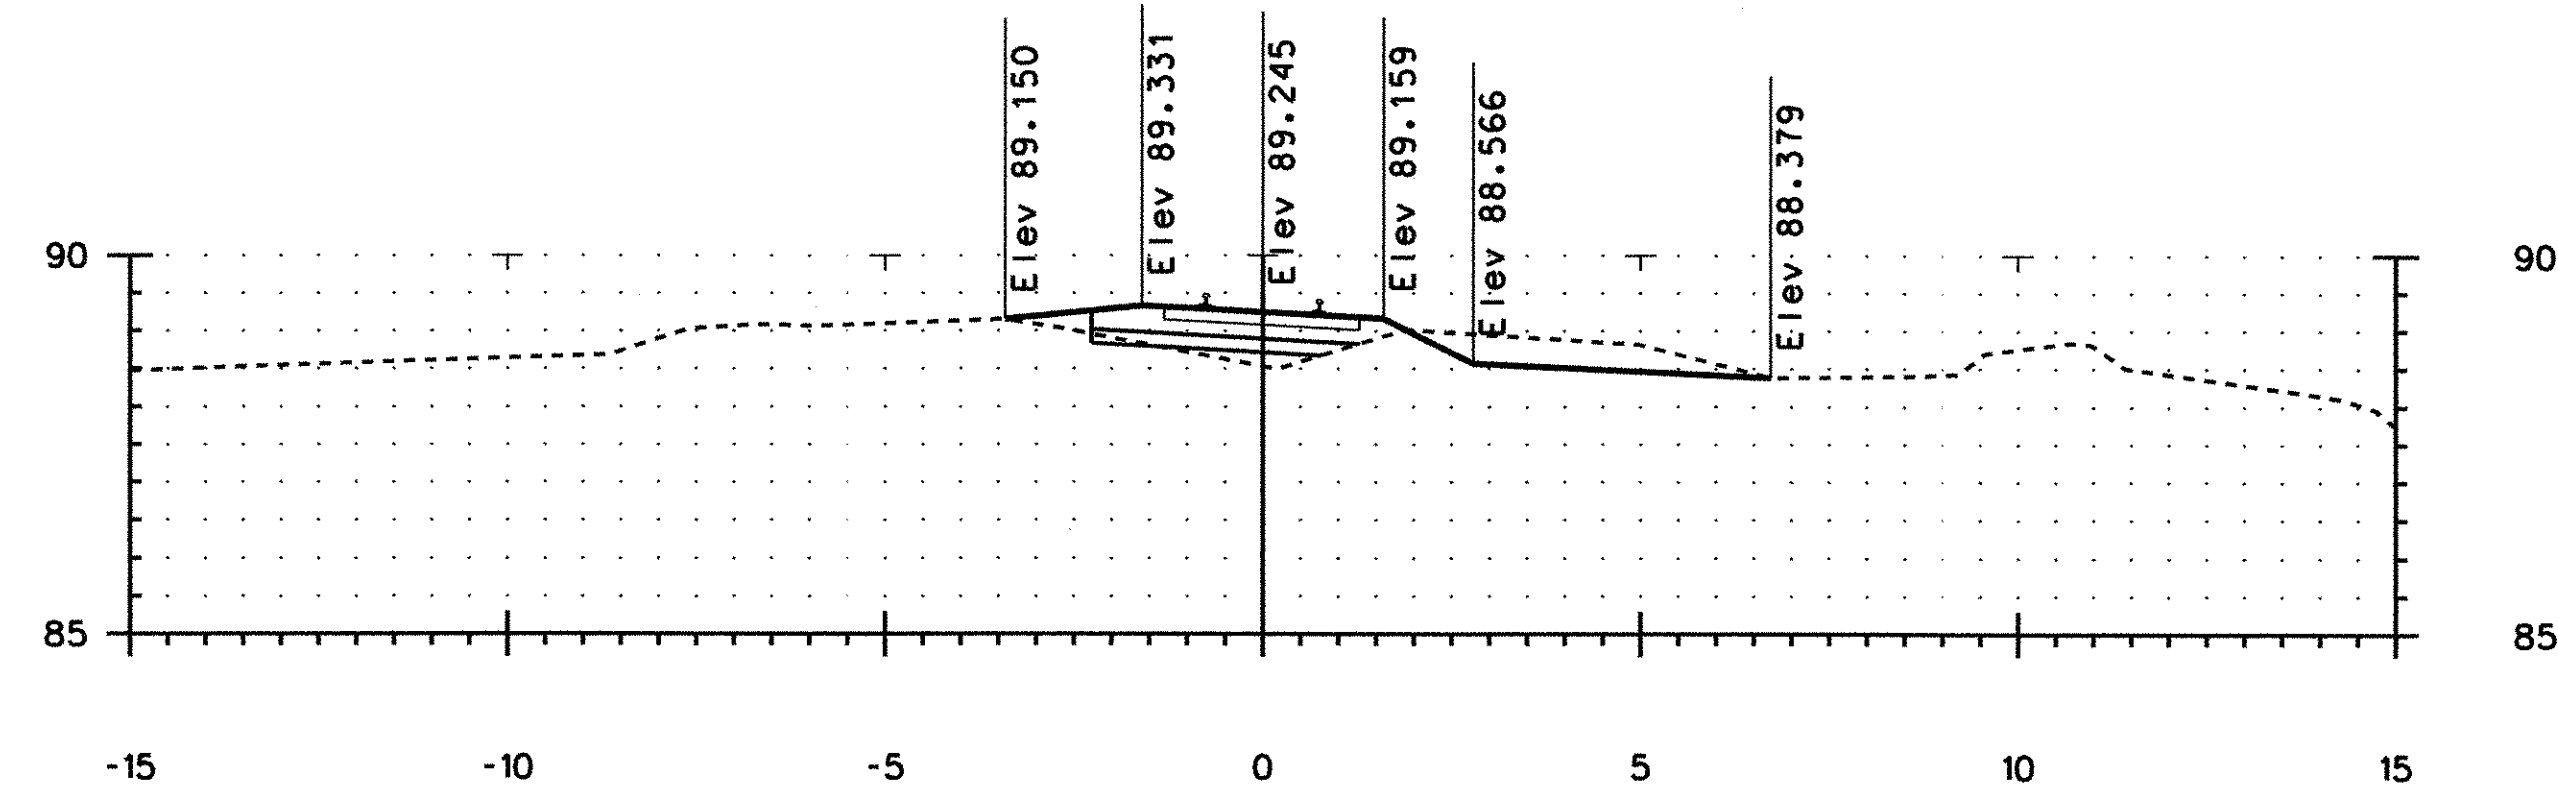


50+500.000

END FULL DEPTH CONSTRUCTION  
BEGIN TRANSITION SECTION

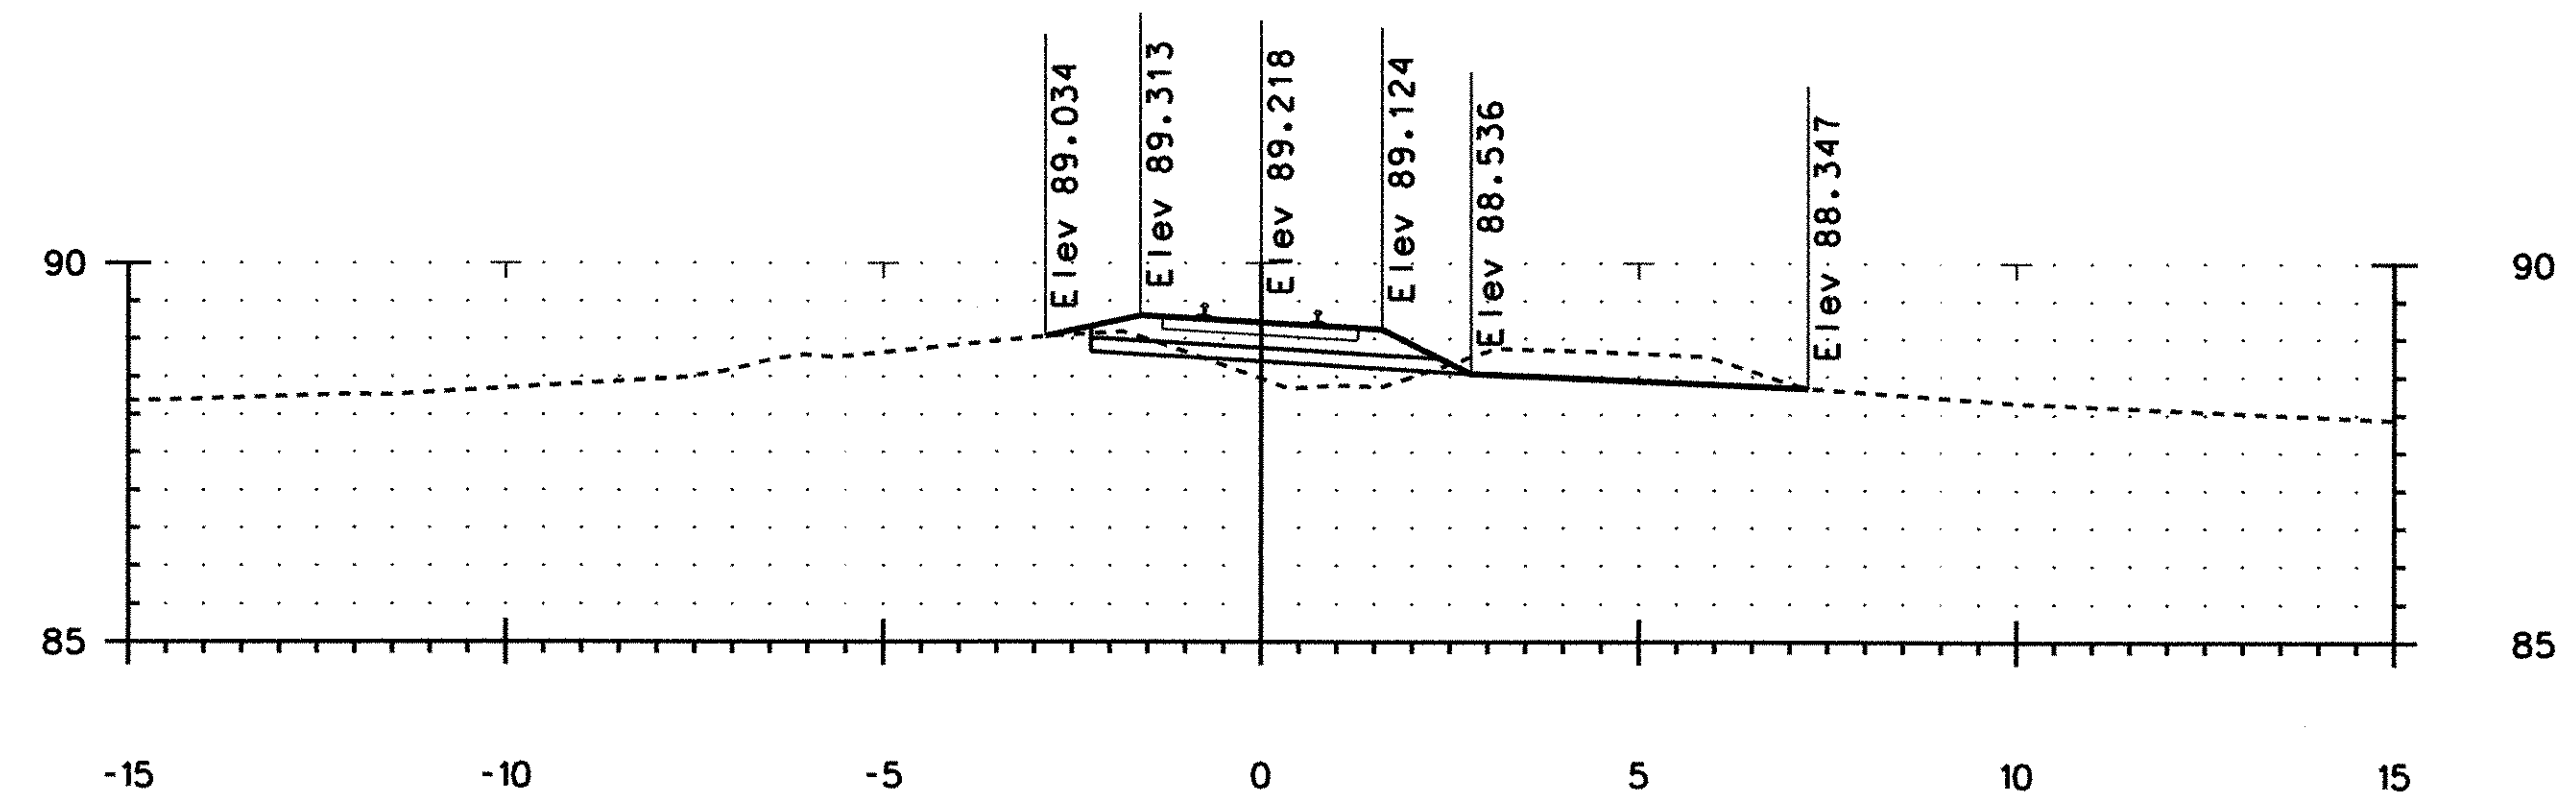

50+480.000

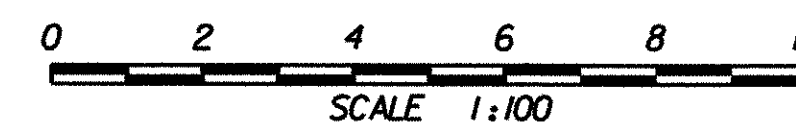

PROJECT: BRATTLEBORO	PROJECT NO.: NH 010-2(2)
DESIGN FILE NAME: U:\99123-Brattleboro\dgn\zb270xs1.dgn	IPARM FILE NAME:
	PLOT DATE: 10-02-2002
FROM STA: 50+480.000 TO STA: 50+500.000 SHEET: 128 OF 145	