



# RAILROAD CROSS SECTIONS

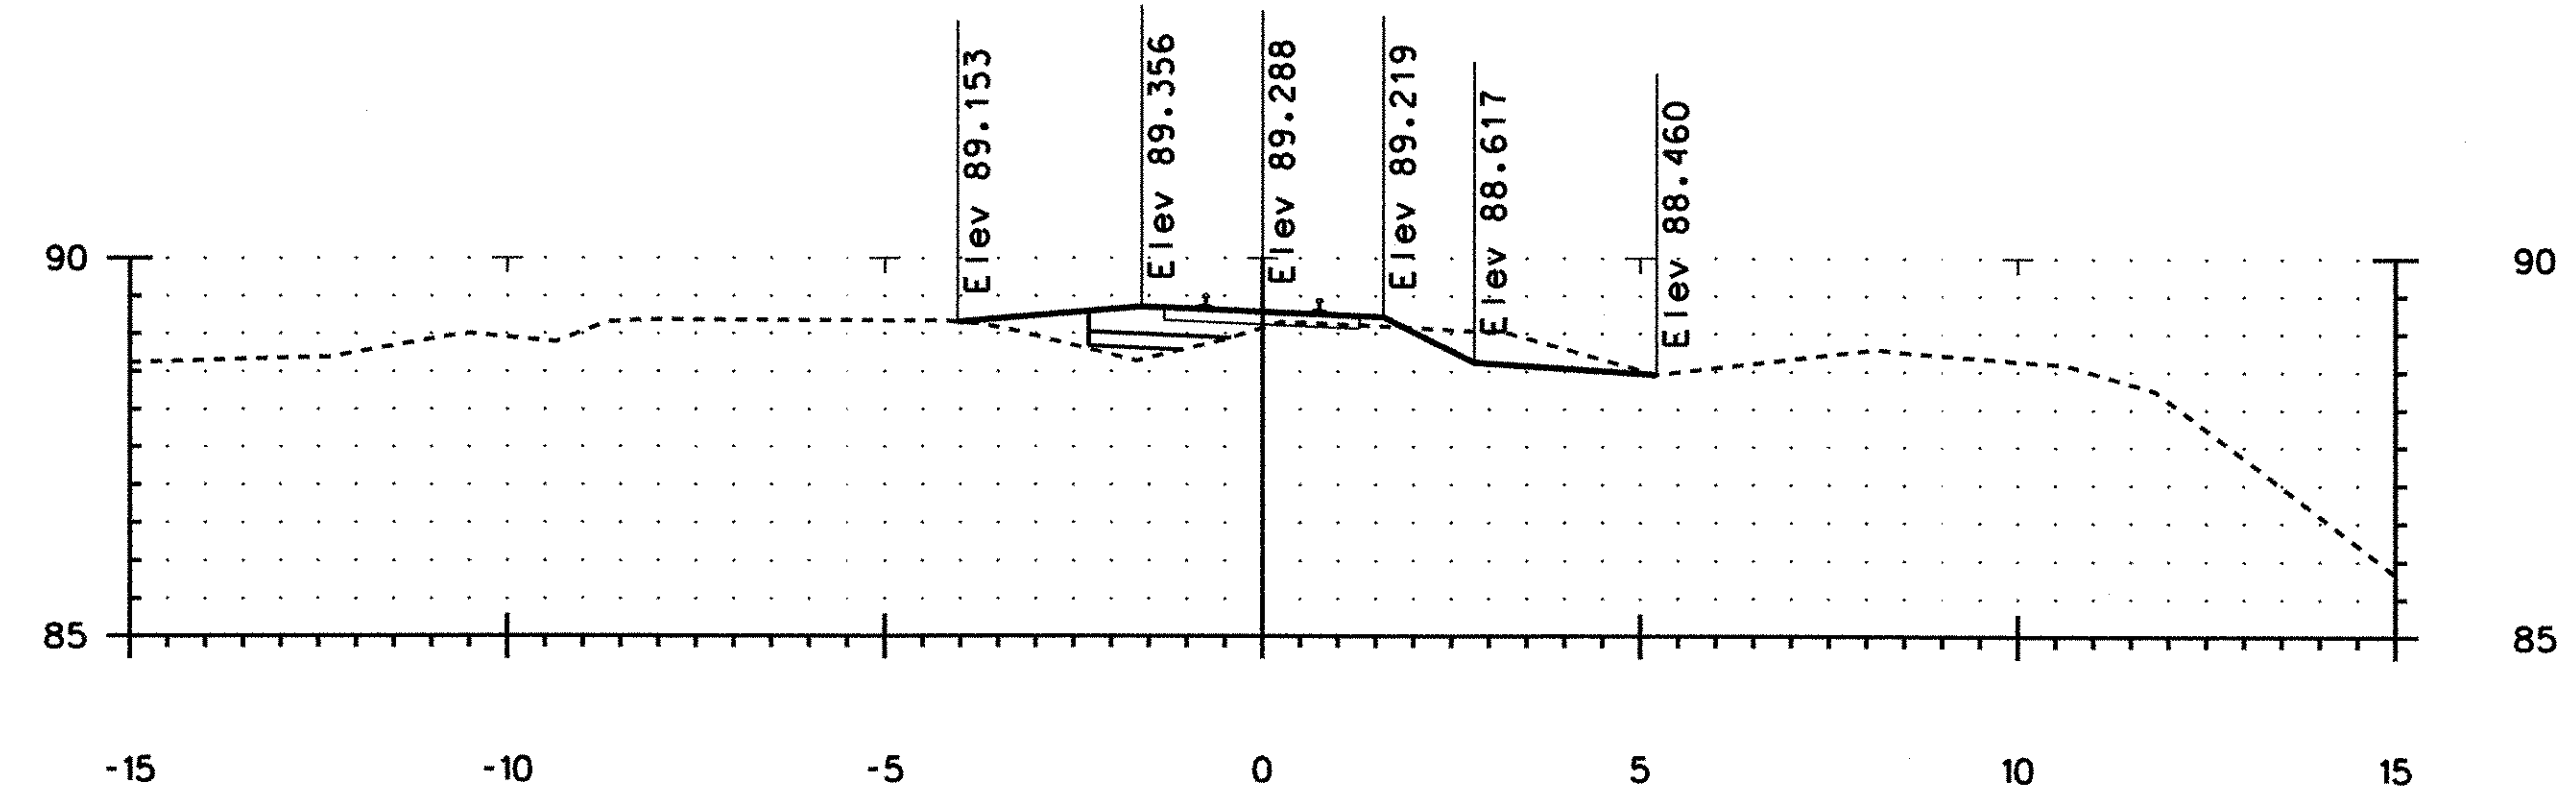

50+540.000

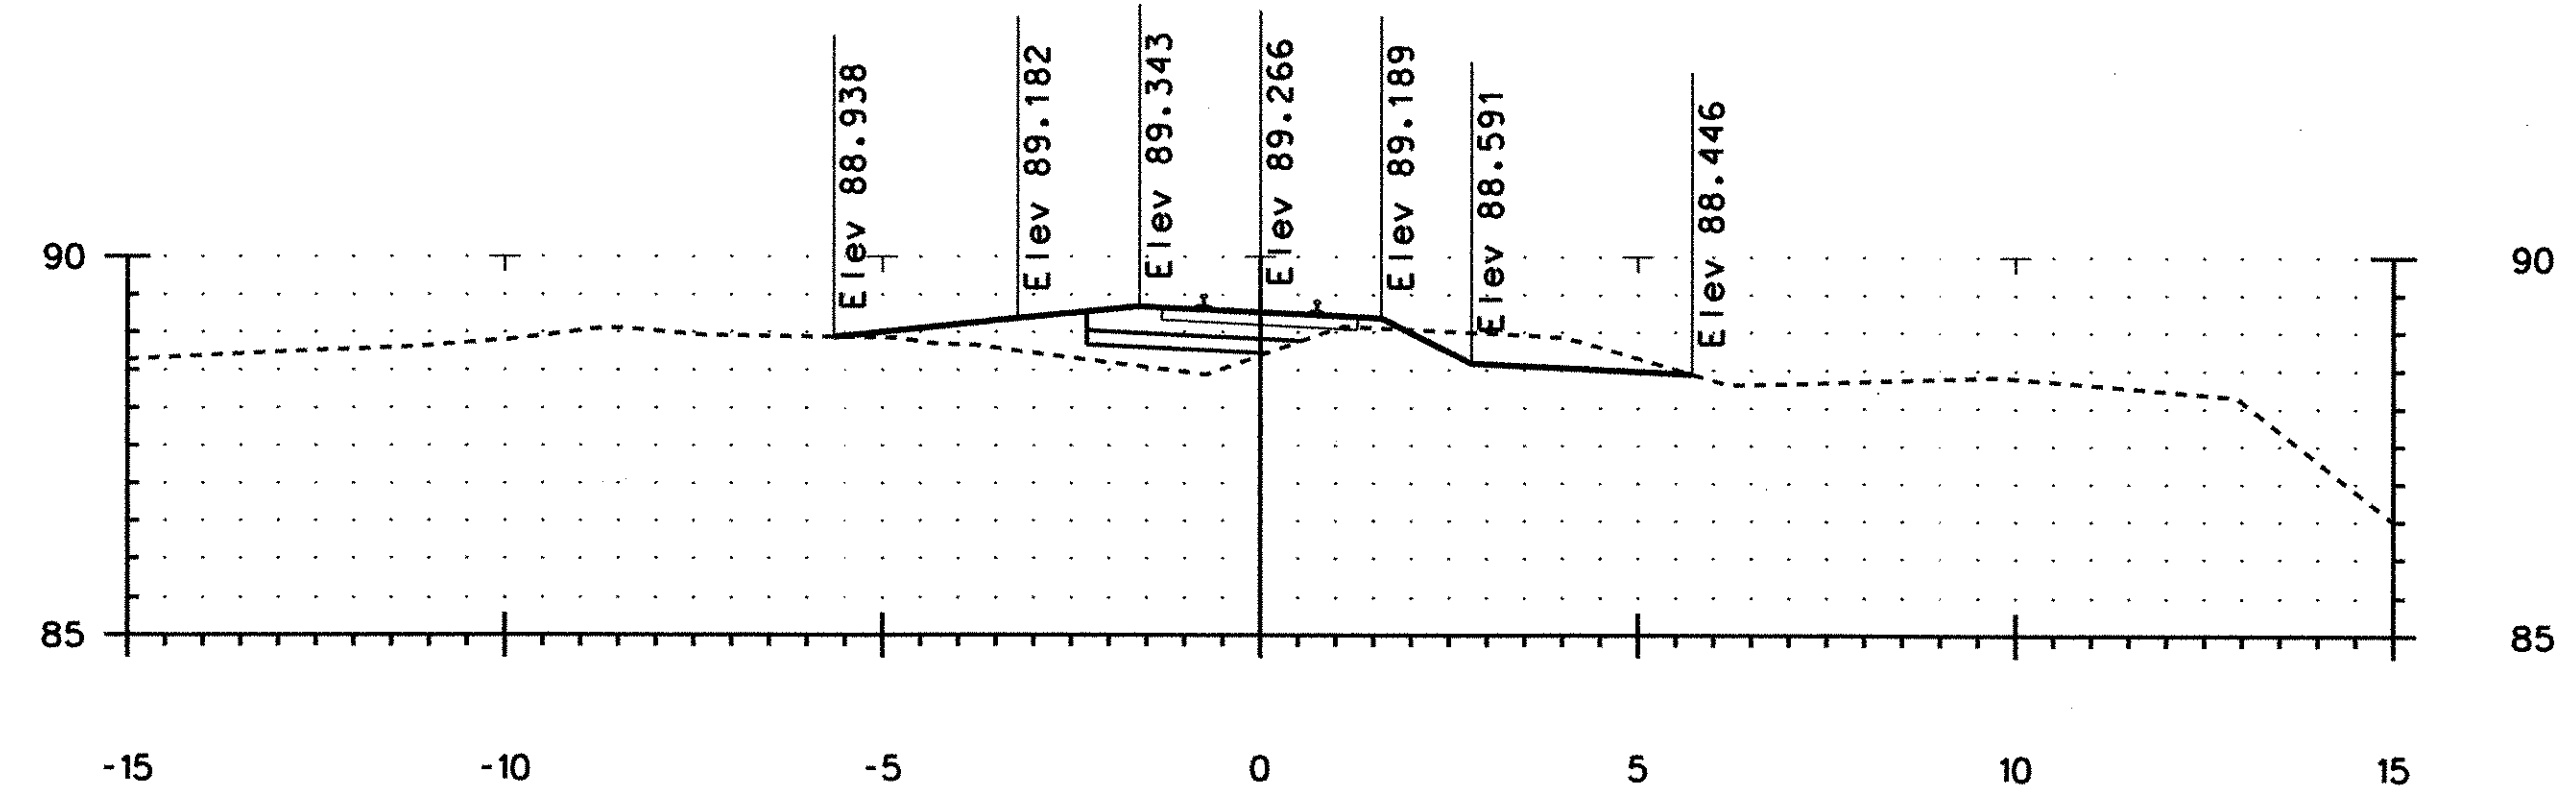

50+520.000



PROJECT:	BRATTLEBORO	PROJECT NO.:	NH 010-2(2)
DESIGN FILE NAME:	U:\99123-Brattleboro\dgn\zb270xs1.dgn		
IPARM FILE NAME:	PLOT DATE: 10-02-2002		
FROM STA: 50+520.000 TO STA: 50+540.000 SHEET: 129 OF 145			