
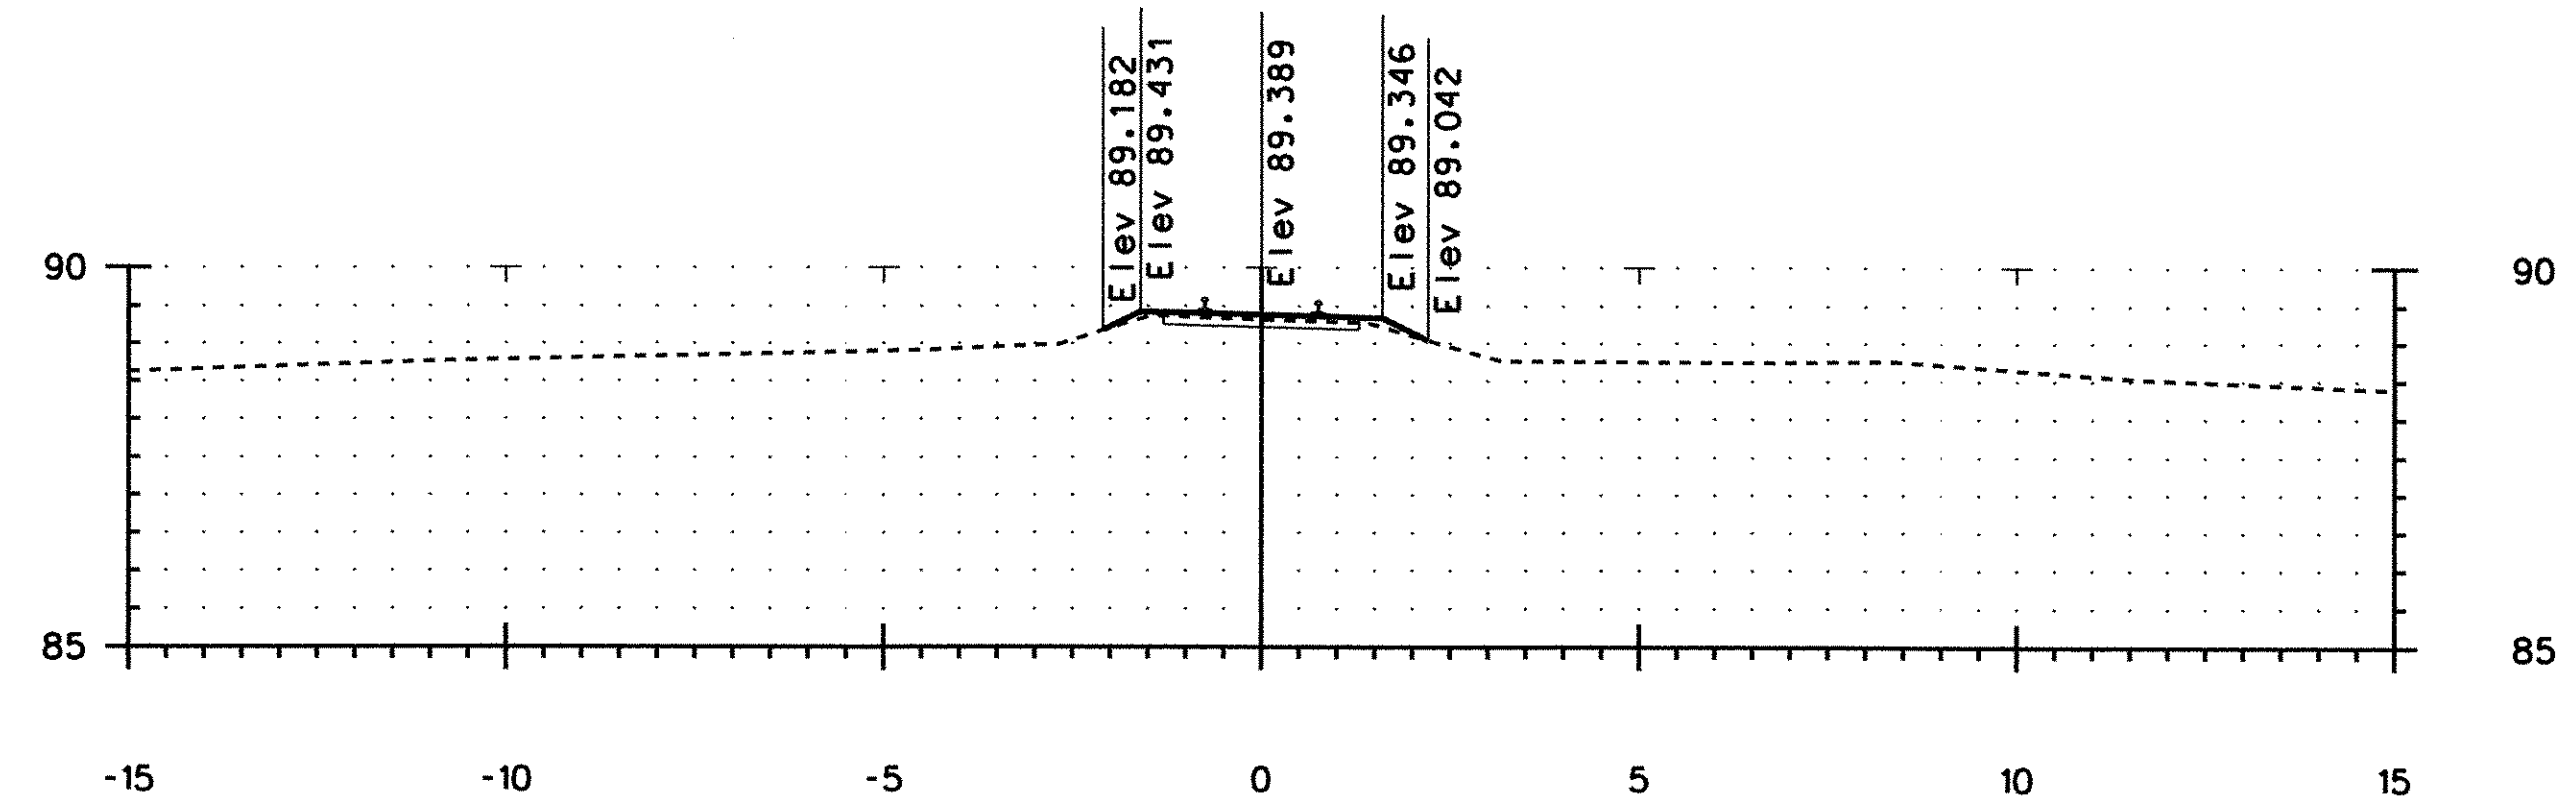


RAILROAD CROSS SECTIONS

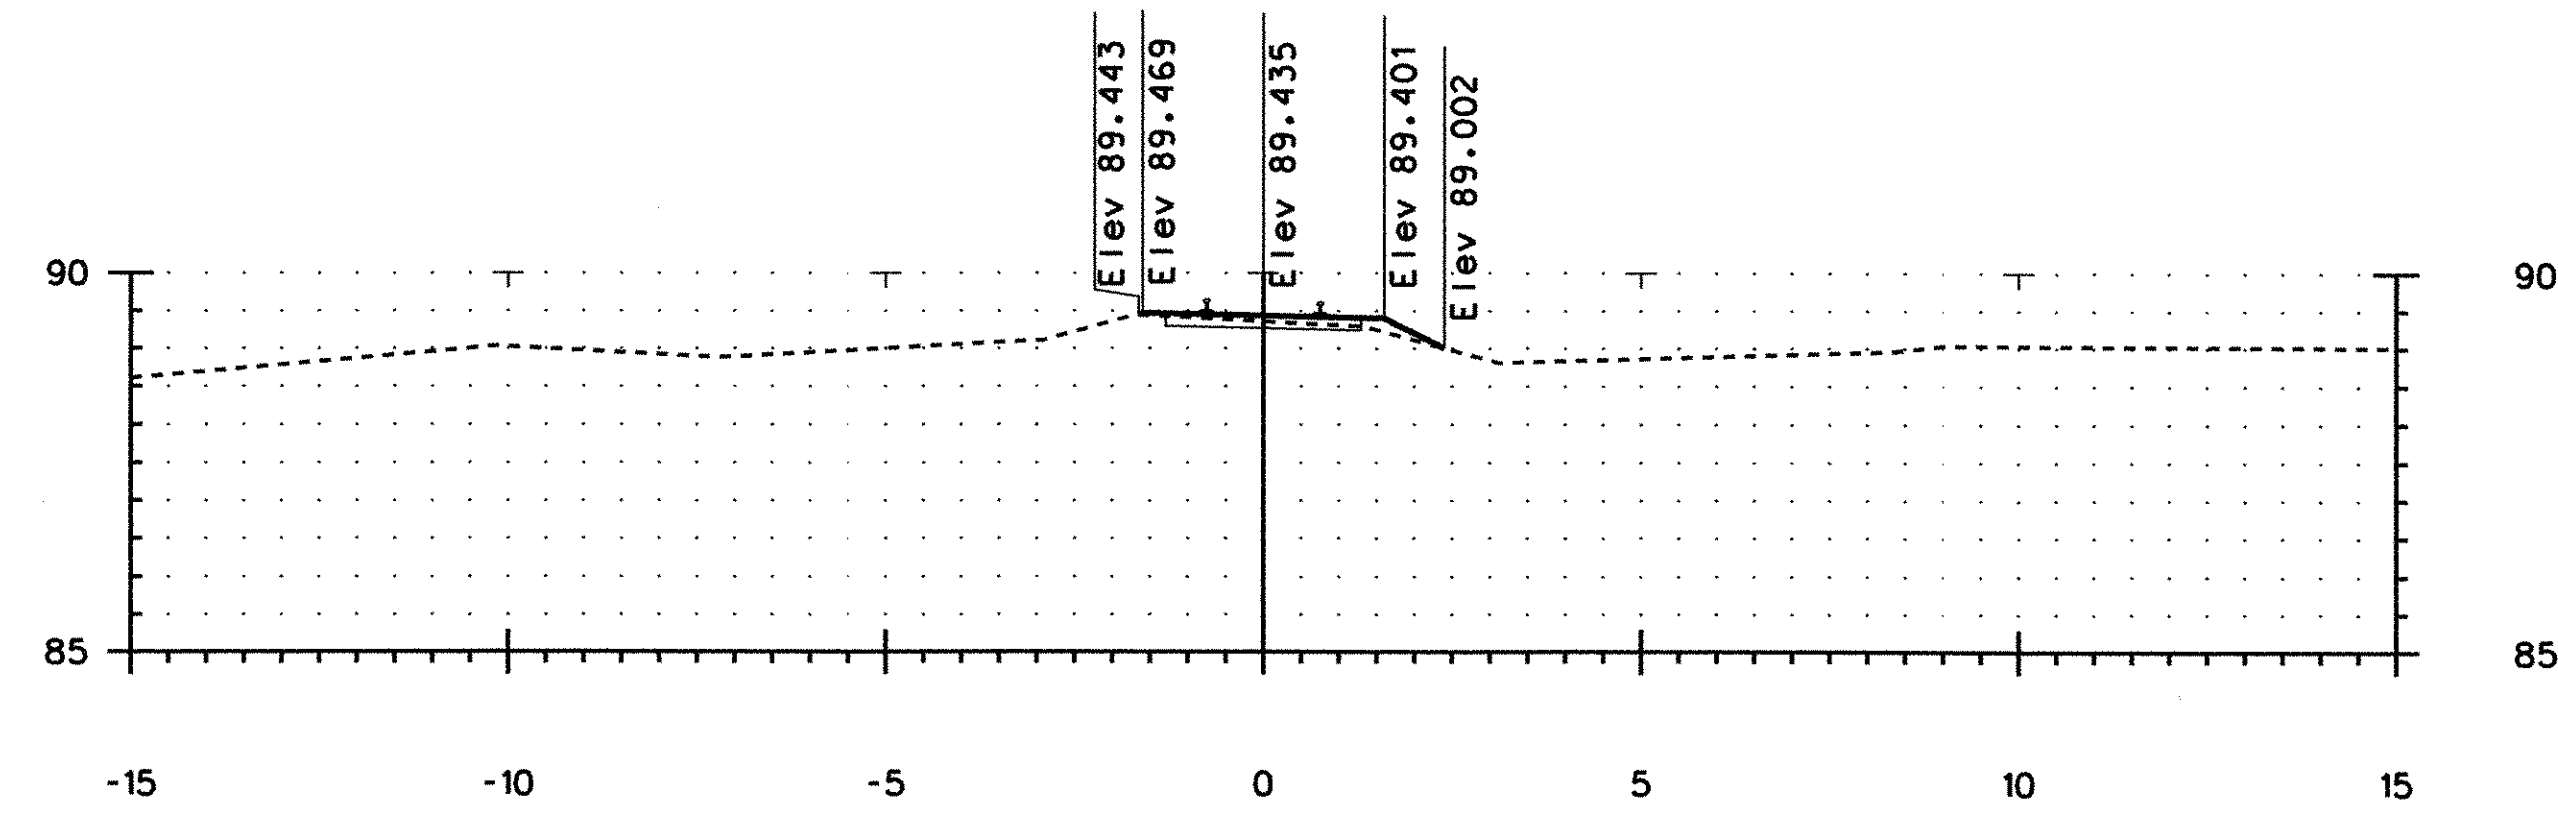

PROJECT:	BRATTLEBORO	PROJECT NO.:	NH 010-2(2)
DESIGN FILE NAME:	U:\99123-Brattleboro\dgn\b270xs1.dgn		PLOT DATE: 10-02-2002
IPARM FILE NAME:			
FROM STA: 50-600.000 TO STA: 50-620.000 SHEET: 131 OF 145			