



RAILROAD CROSS SECTIONS

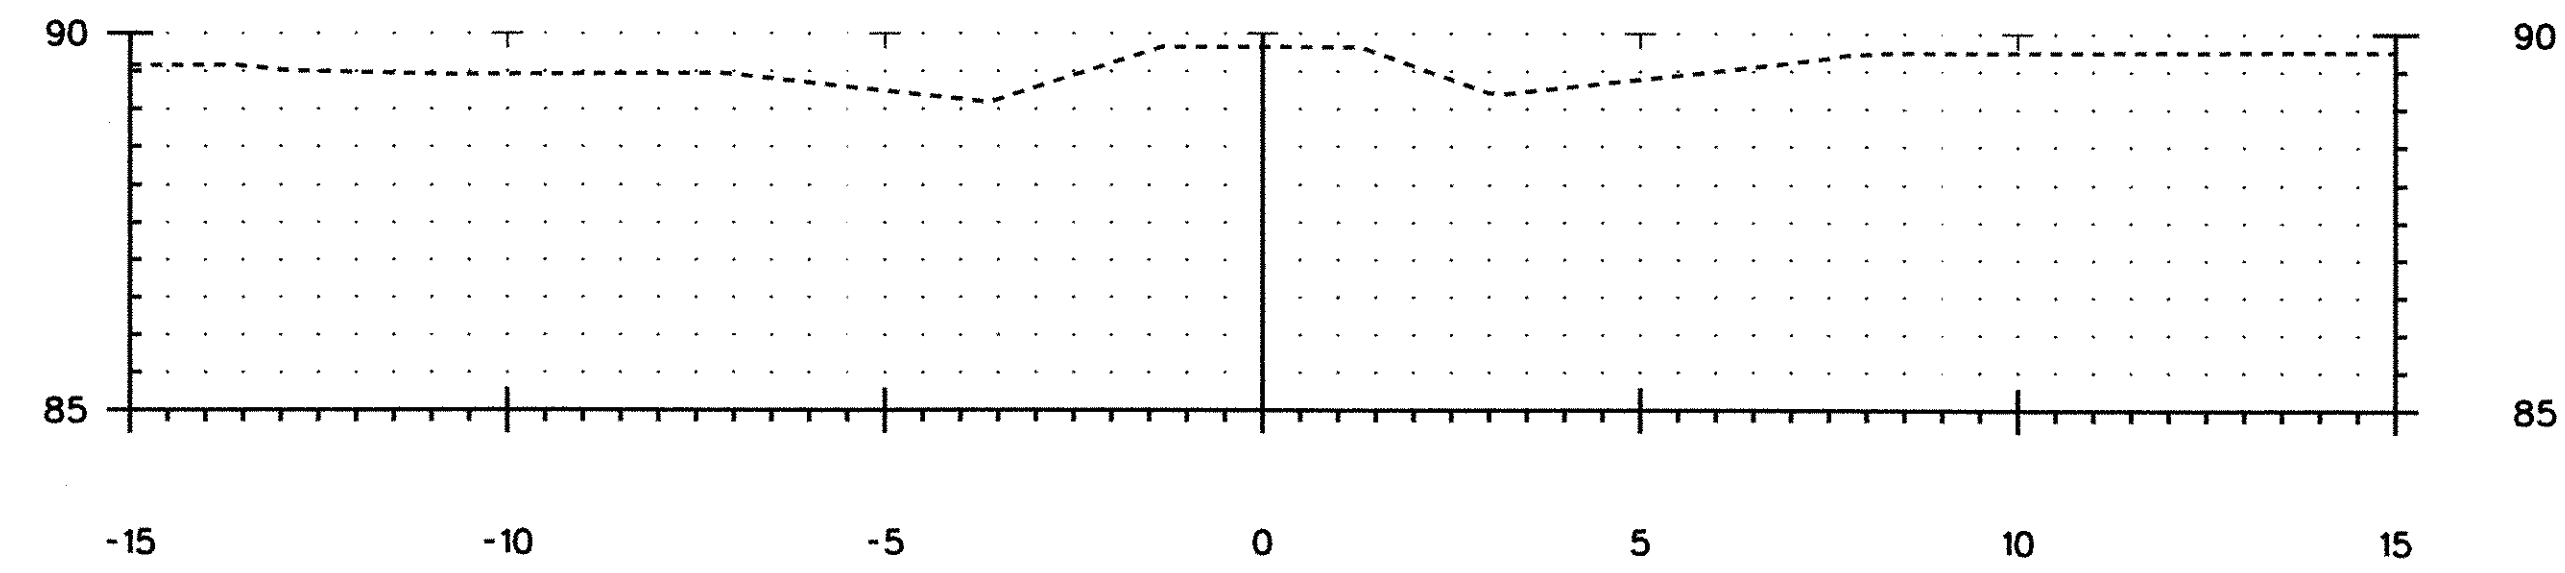


50+700.000

END OF RAILROAD CONSTRUCTION
MEET EXISTING AT STA. 50+698.603
END TRACK REHABILITATION

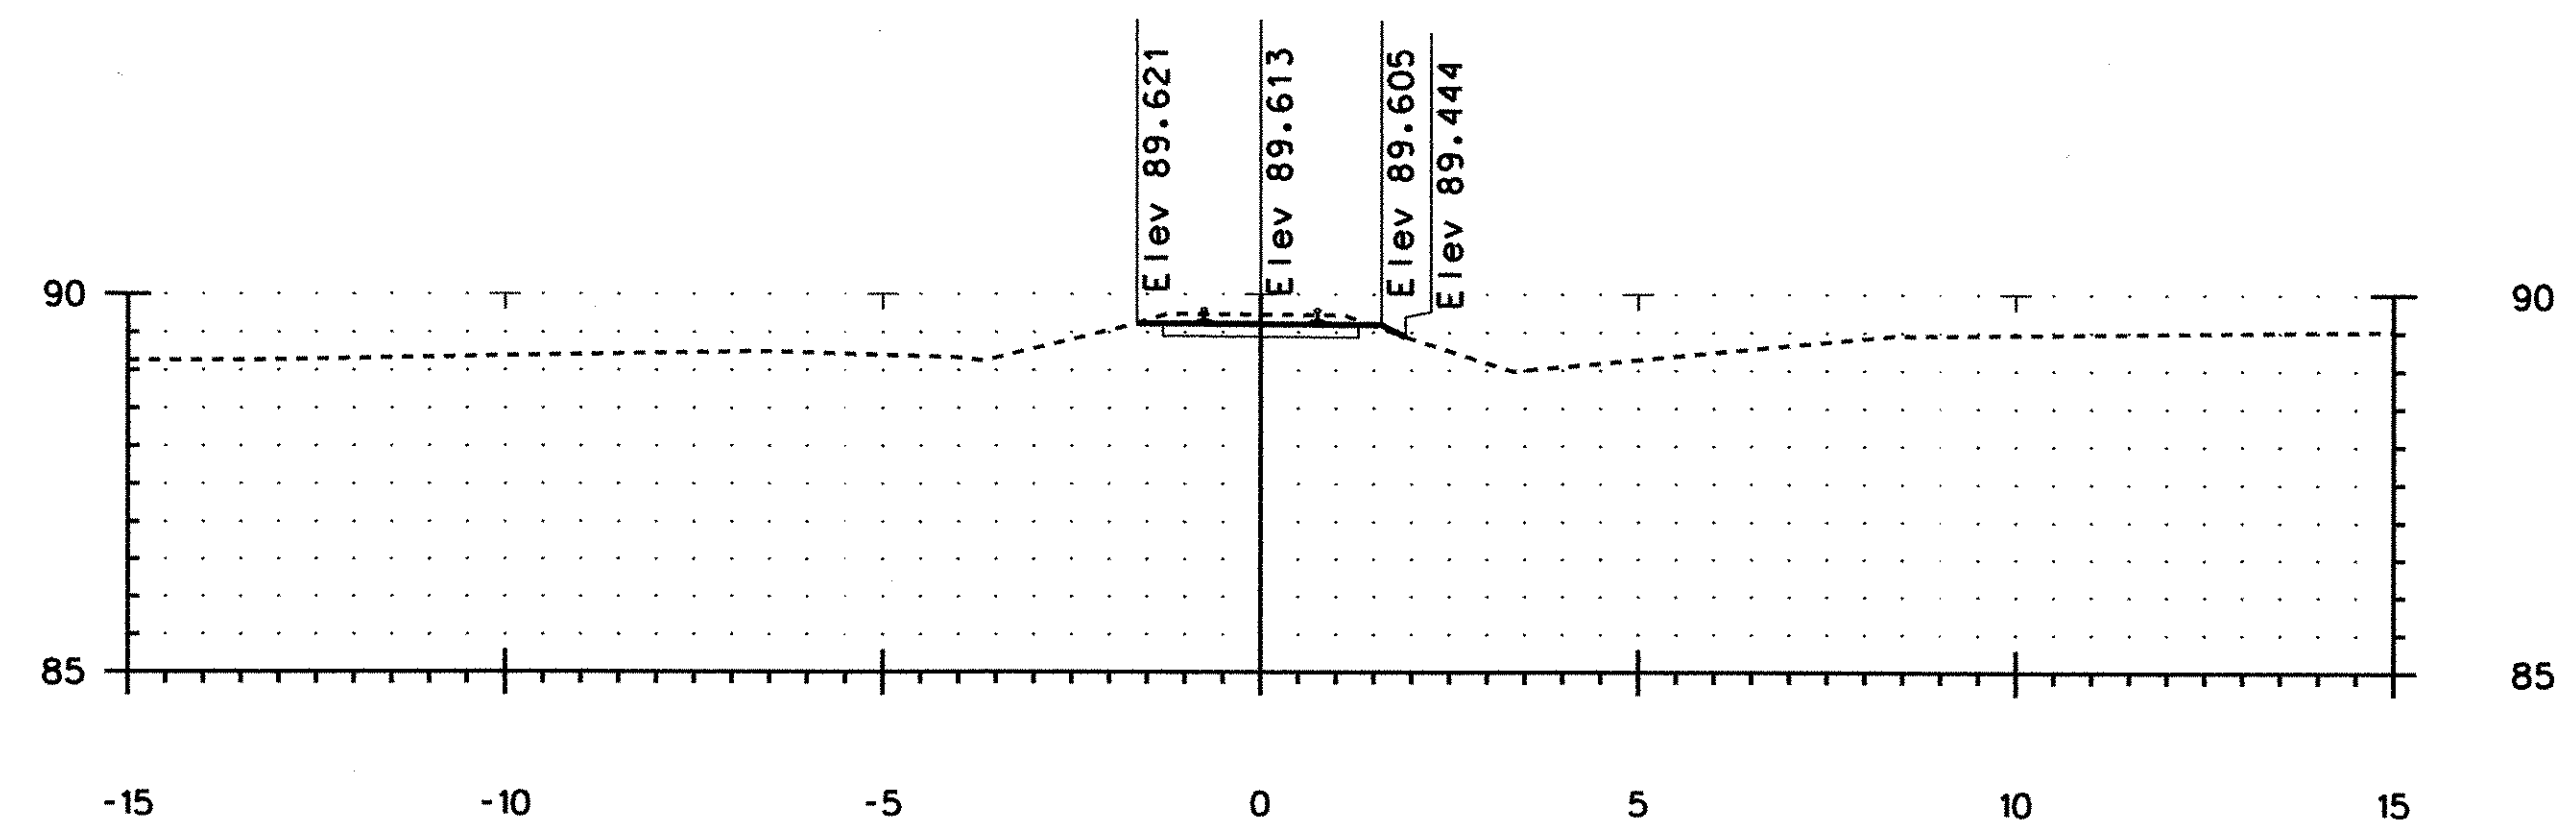

50+680.000

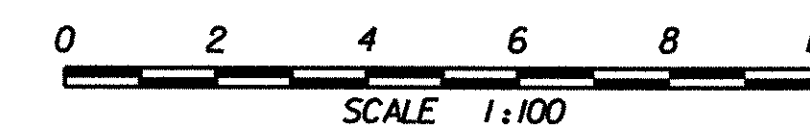

PROJECT:	BRATTLEBORO	PROJECT NO.:	NH 010-2(2)
DESIGN FILE NAME:	U:\99123-Brattleboro\dgn\zb270xs1.dgn		
IPARM FILE NAME:			PLOT DATE: 10-02-2002
FROM STA: 50-680.000 TO STA: 50-700.000		SHEET: 133 OF 145	