



# SARGENT BROOK CROSS SECTIONS

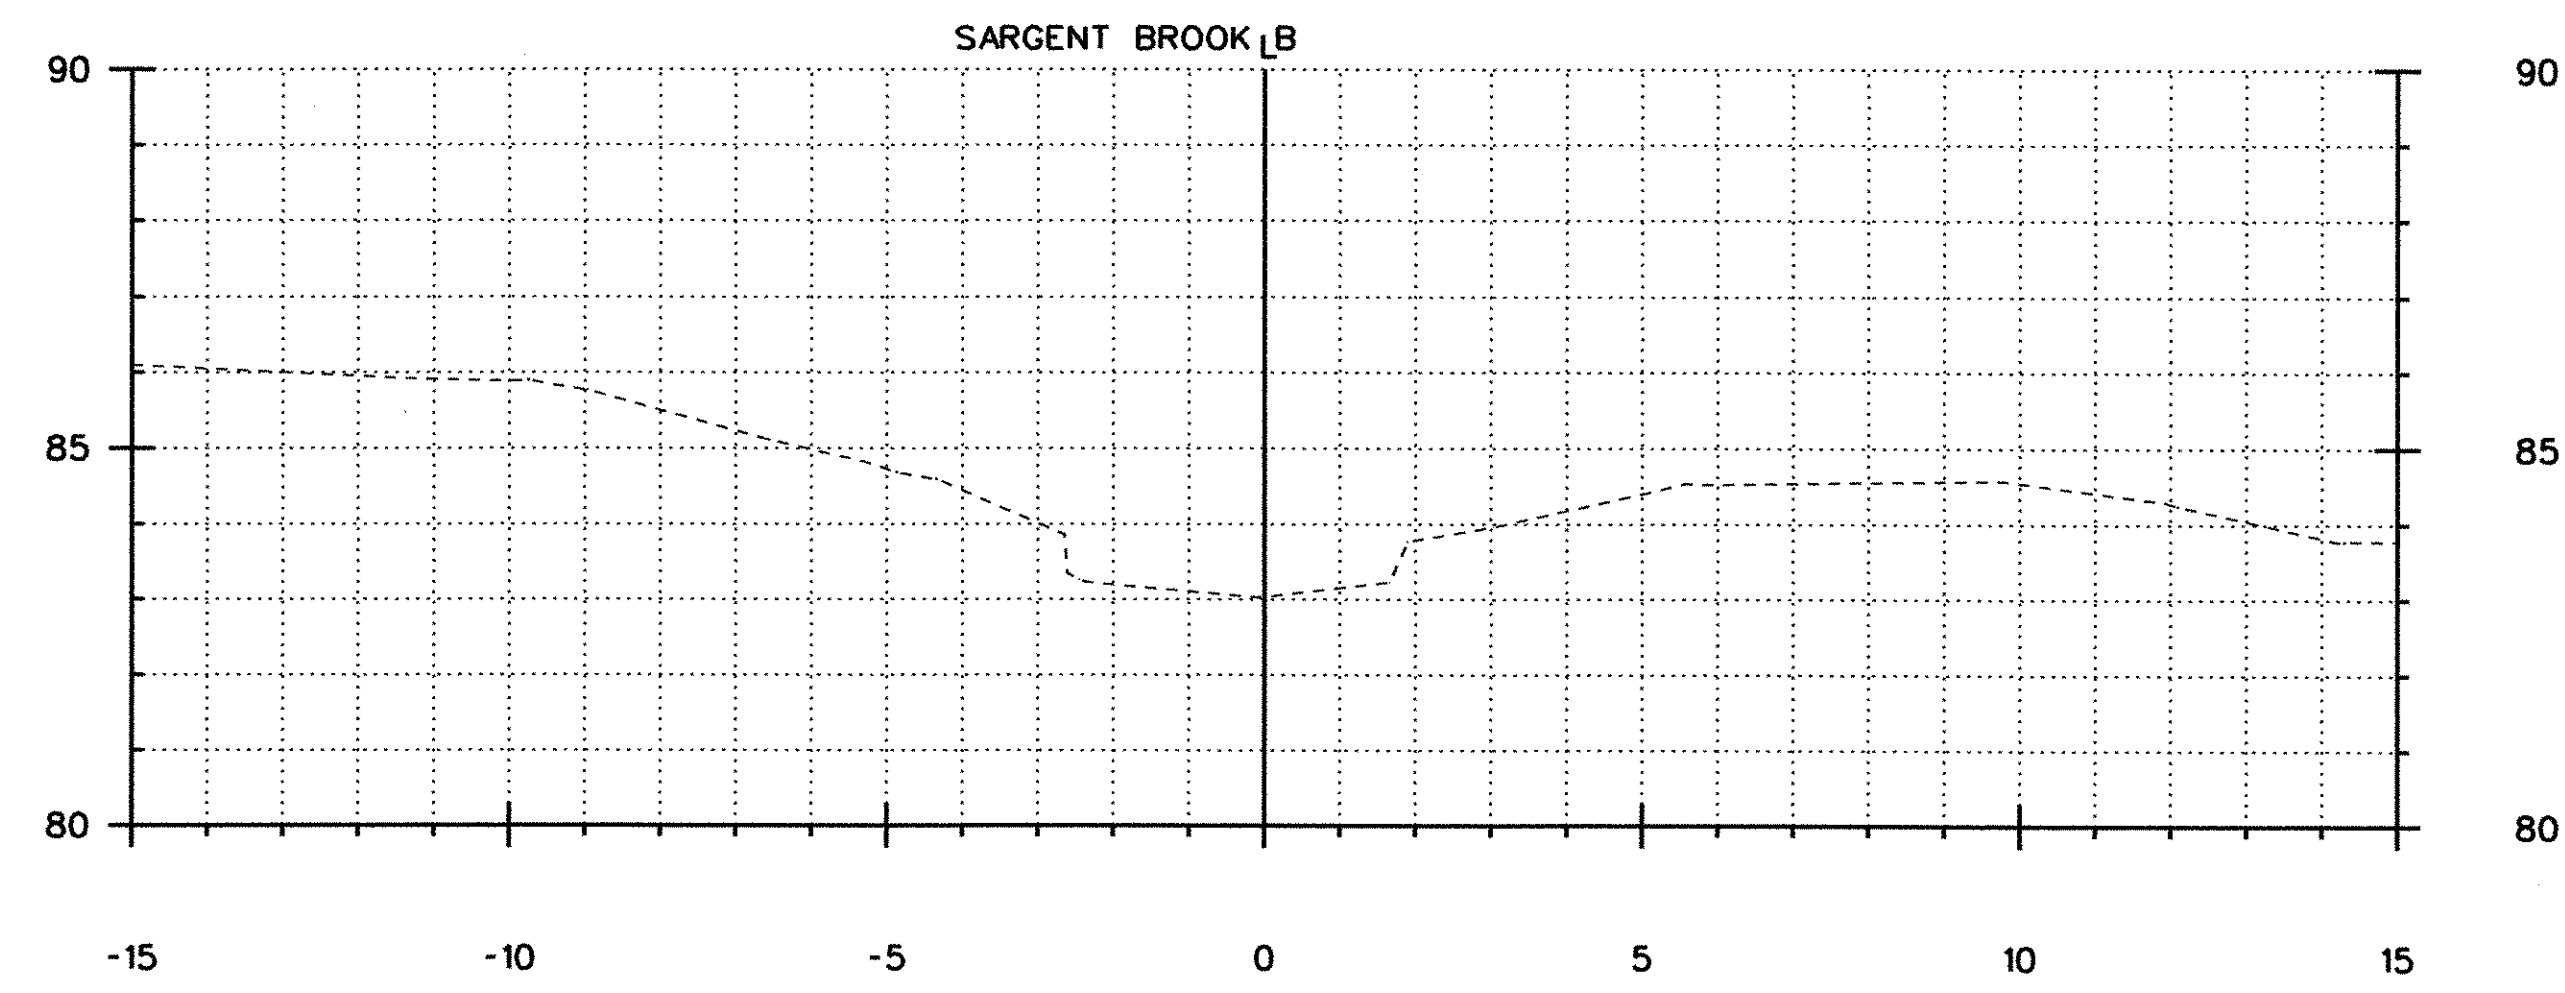

0+025.000

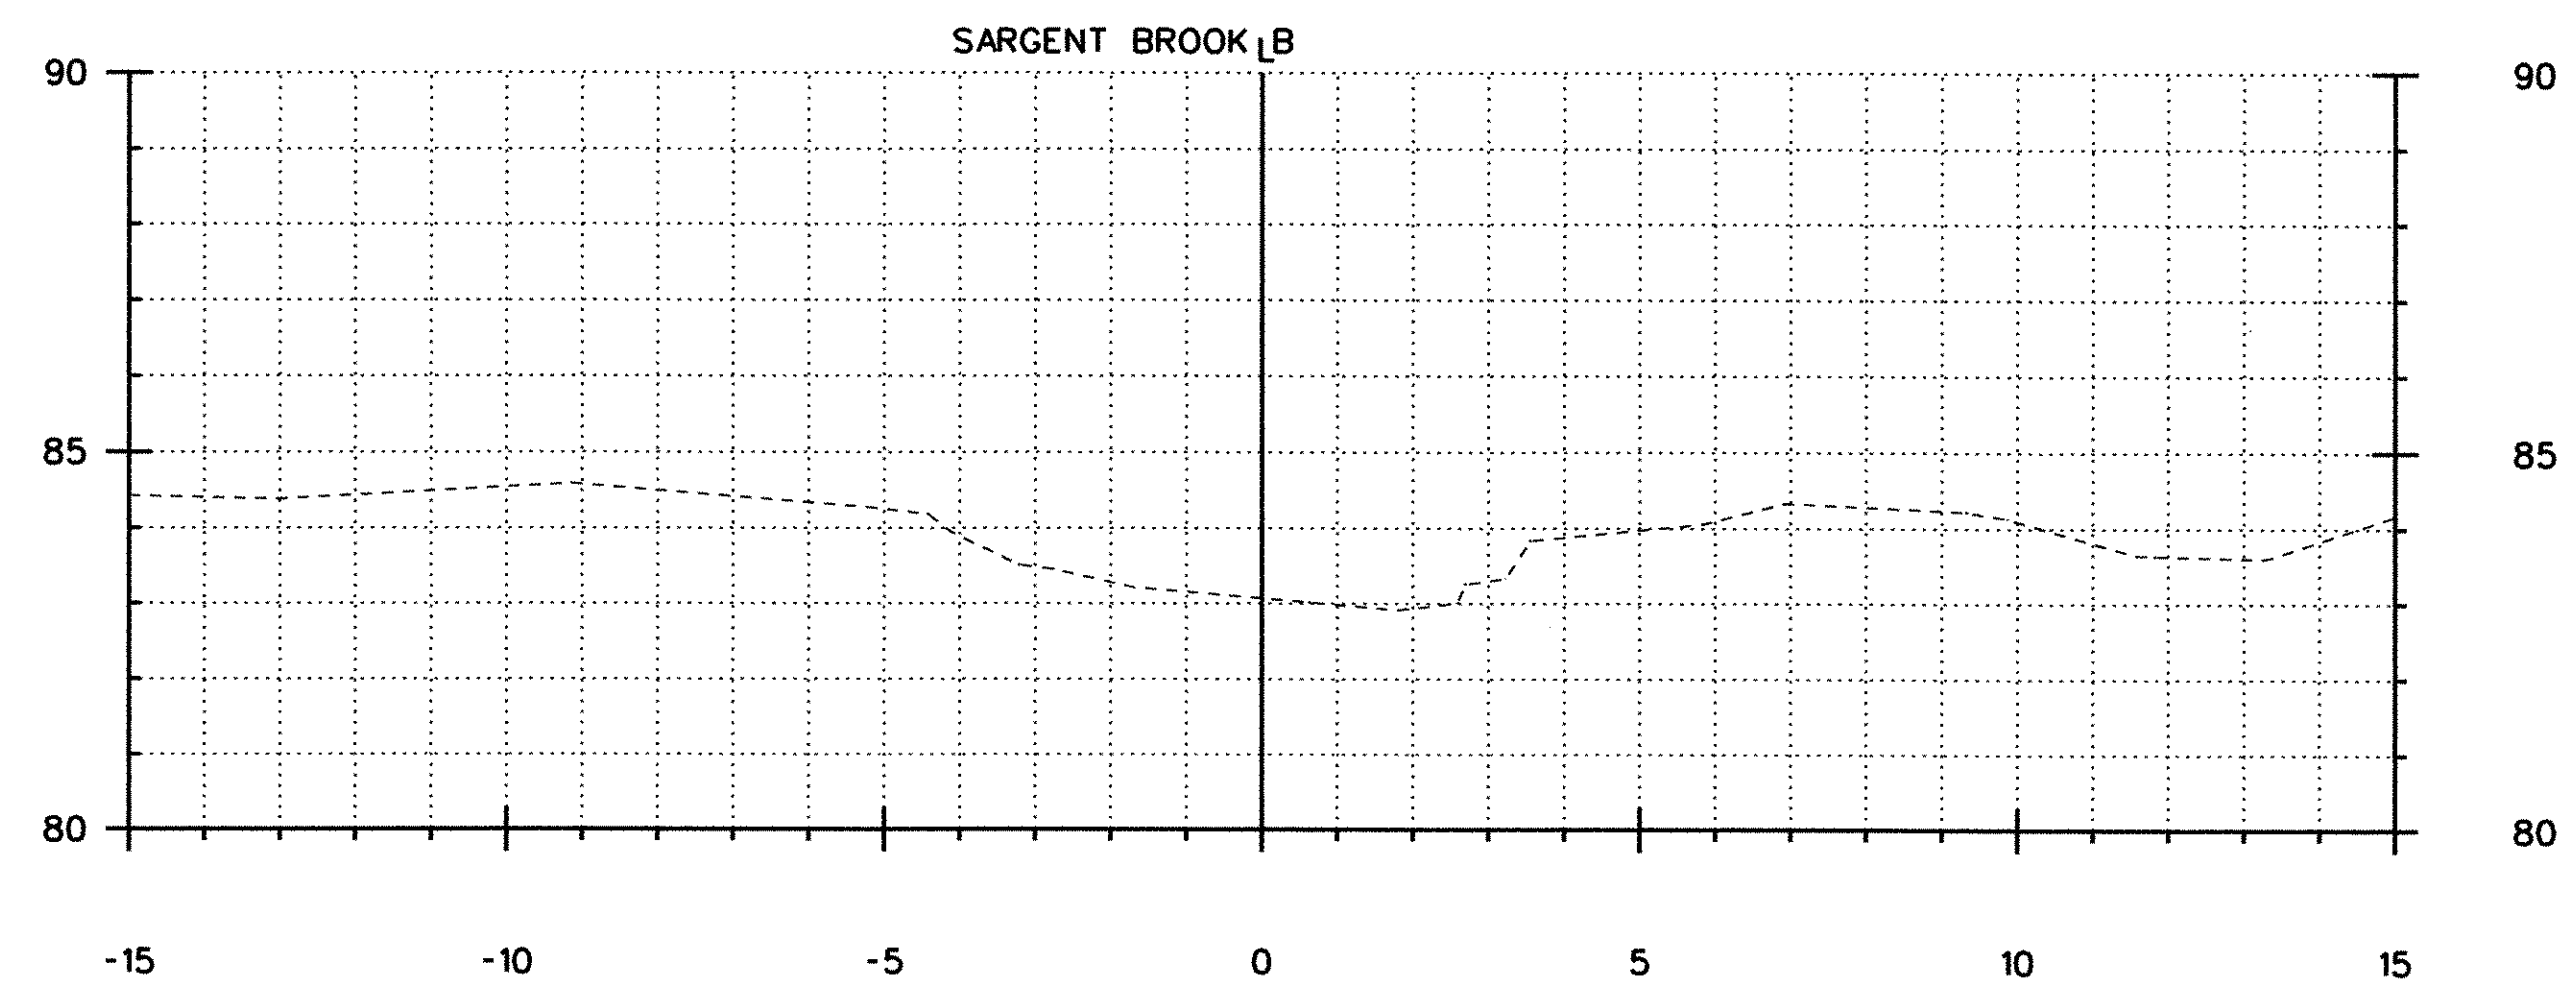

0+020.000



PROJECT:	BRATTLEBORO	PROJECT NO.:	NH 010-2(2)	
DESIGN FILE NAME:	U:\99123-Brattleboro\dgn\b270xs1.dgn		IPARM FILE NAME:	PLOT DATE: 10-02-2002
FROM STA: 0+020.000 TO STA: 0+025.000 SHEET: 134 OF 145				