



SARGENT BROOK CROSS SECTIONS

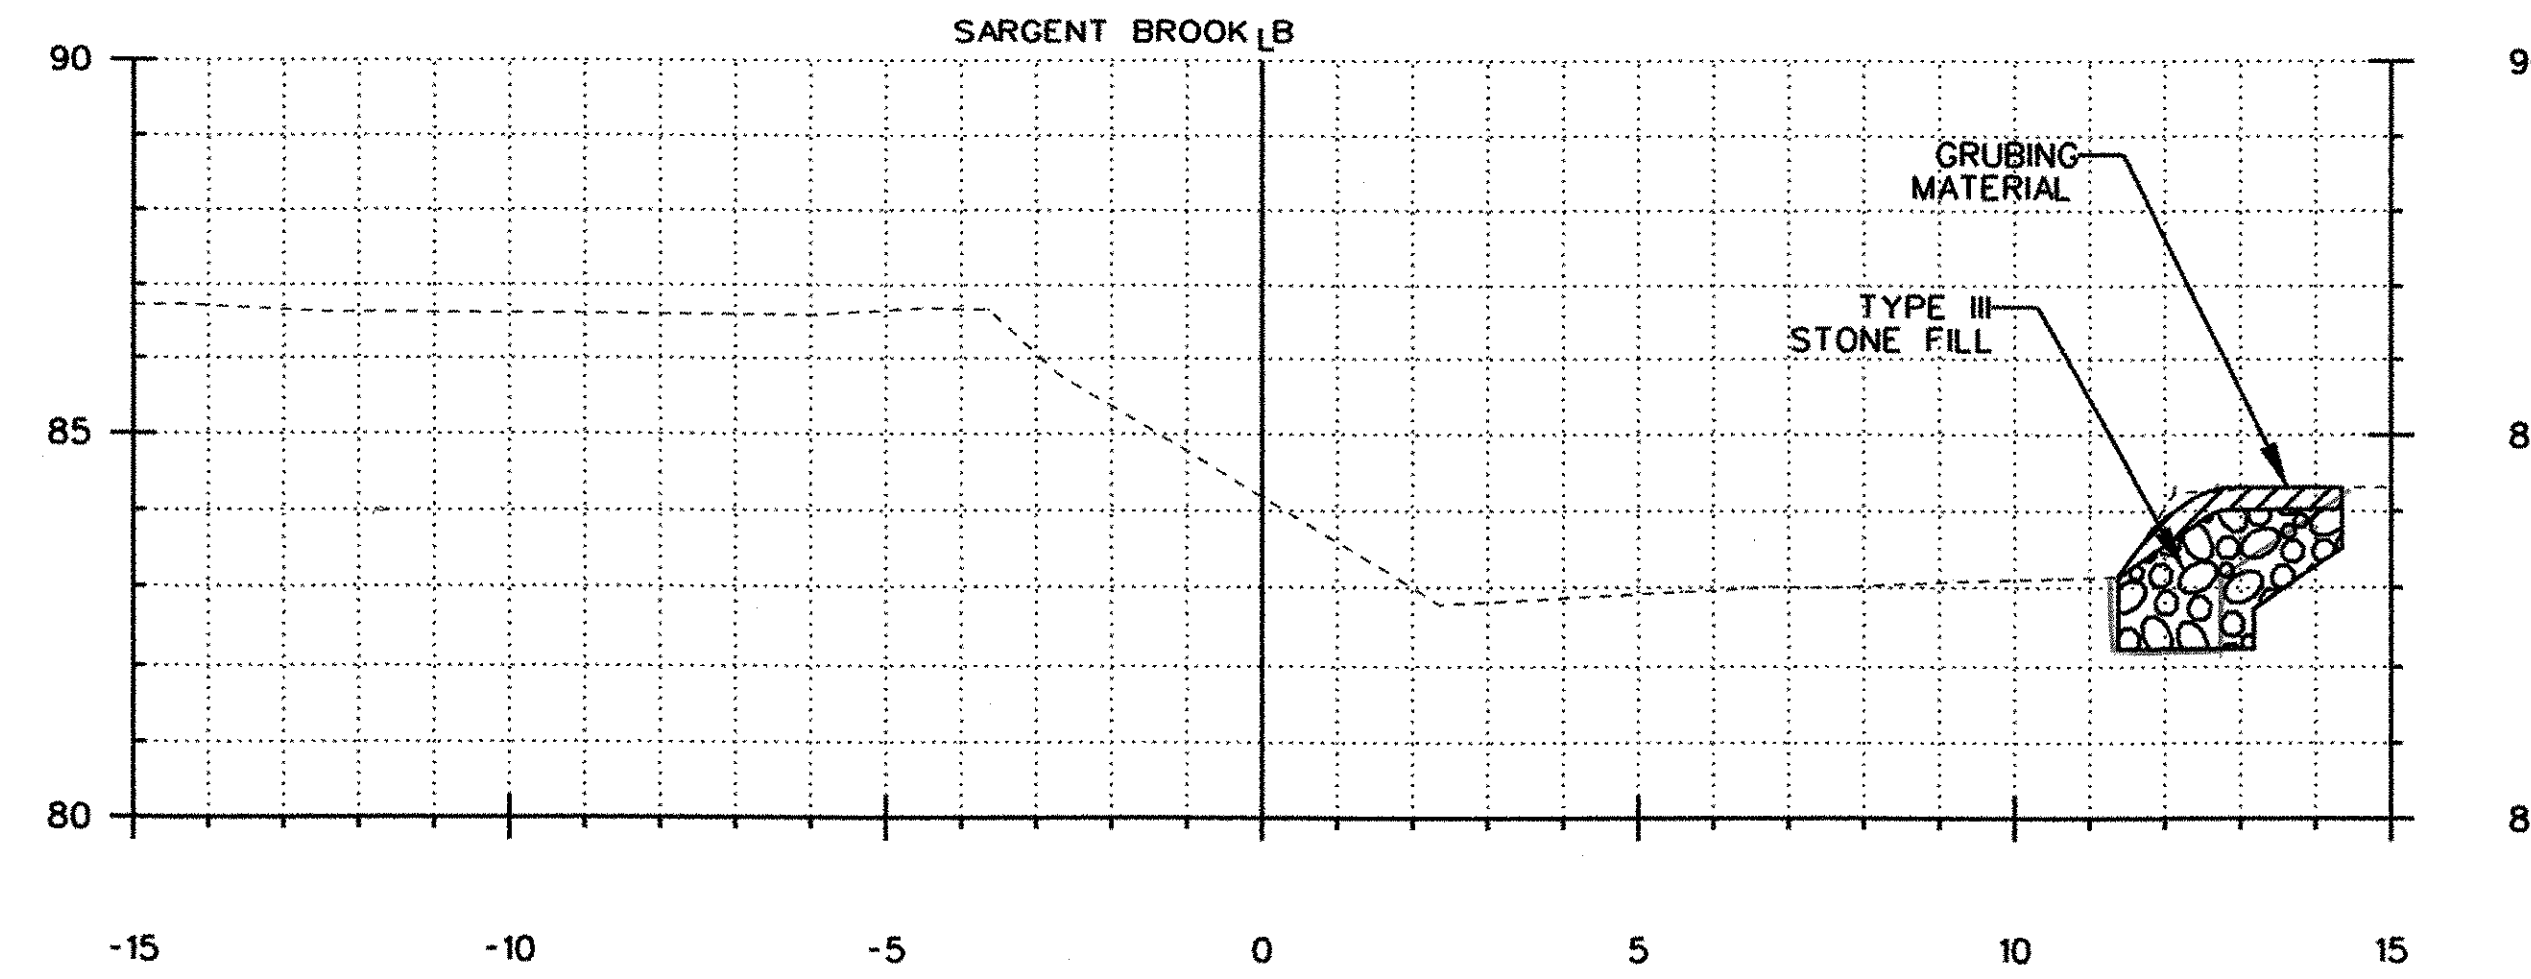


0.51
1.02/2
3.20m² ✓ 100% 07/16

0+055.000

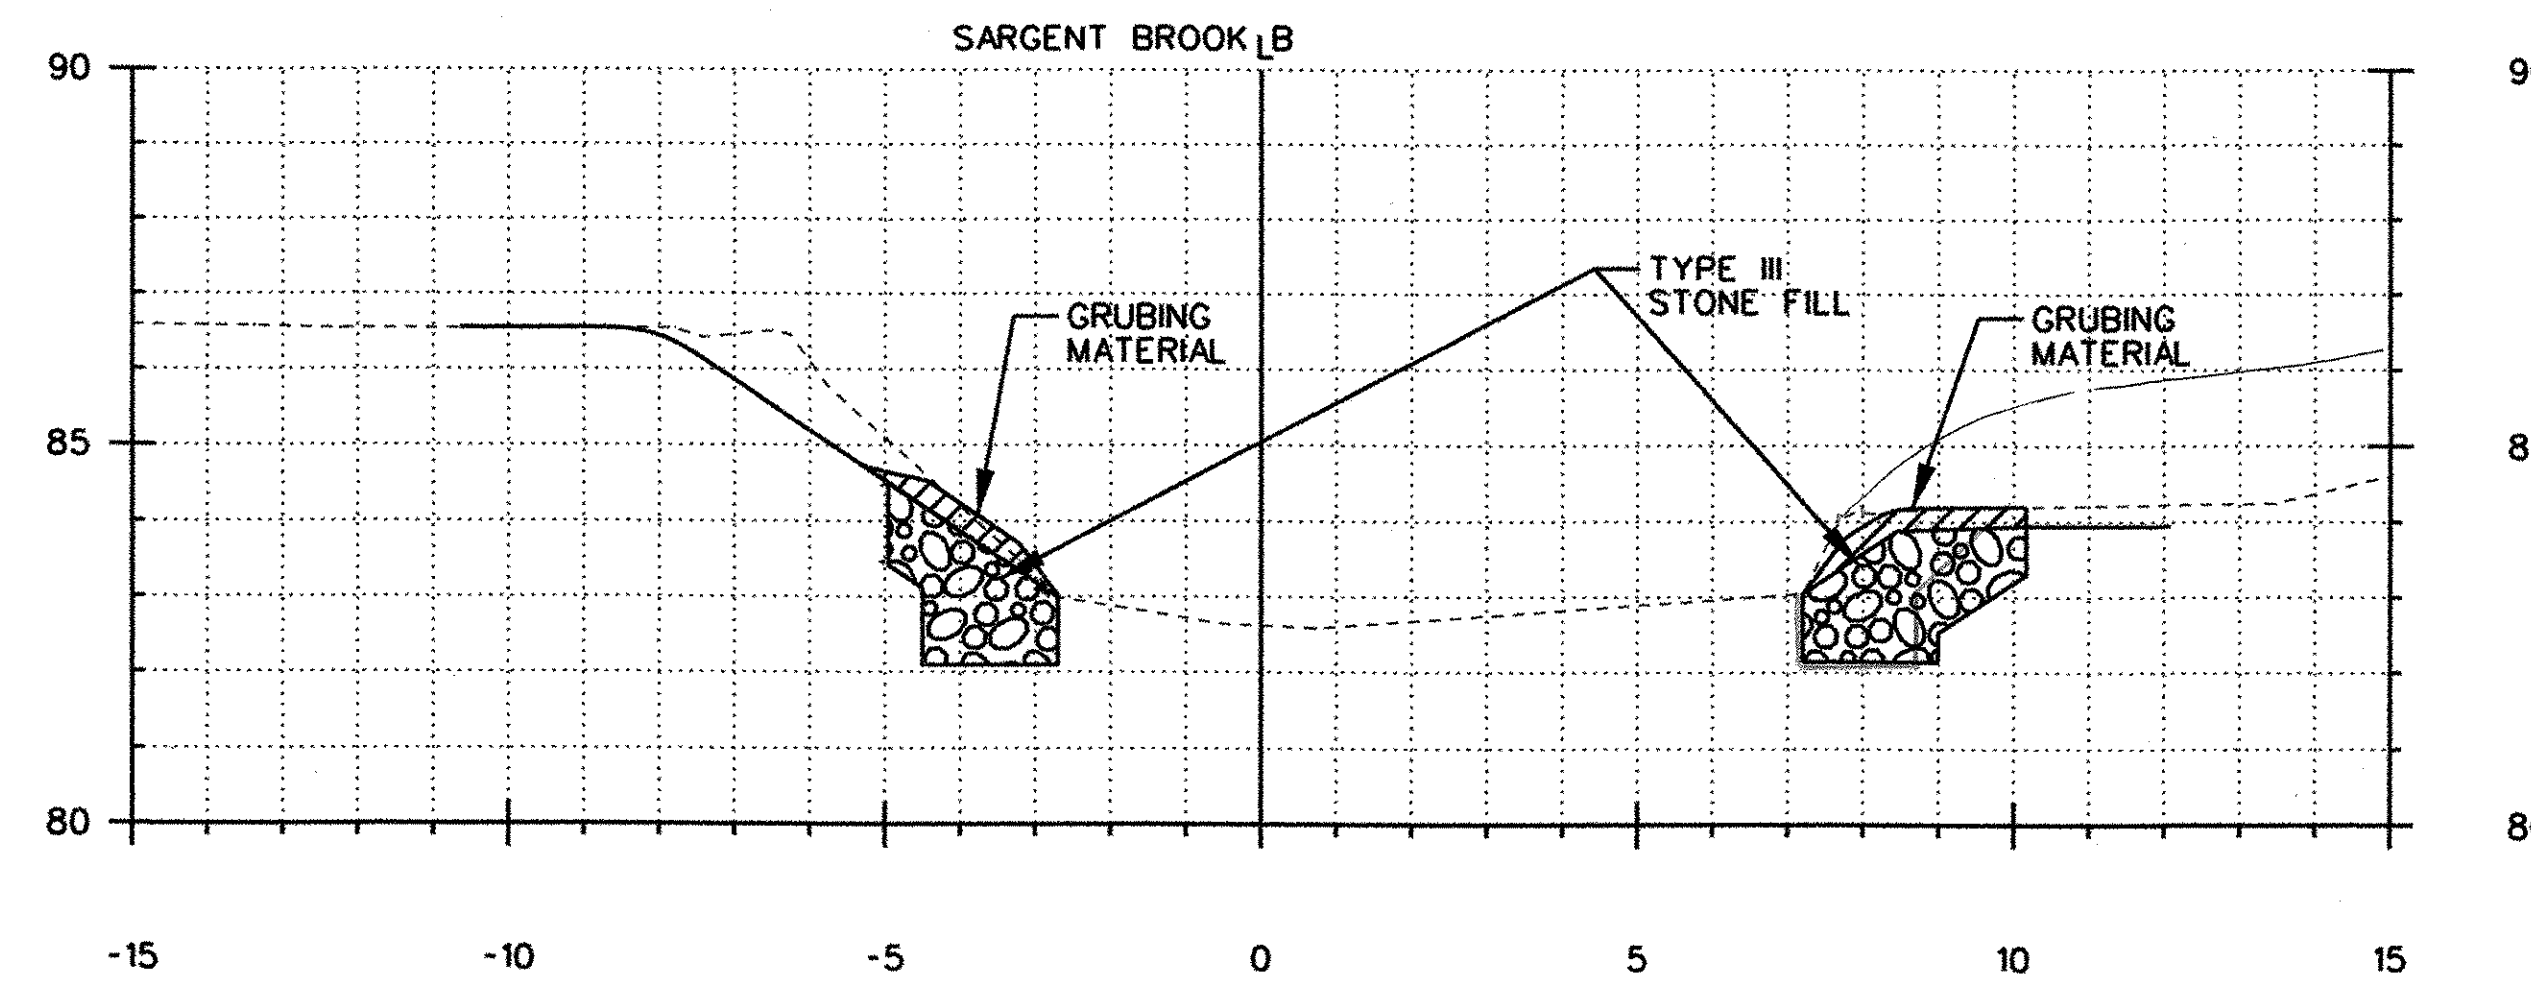

0.50
1.02/2
3.19m² ✓ 100% 07/16

0+050.000

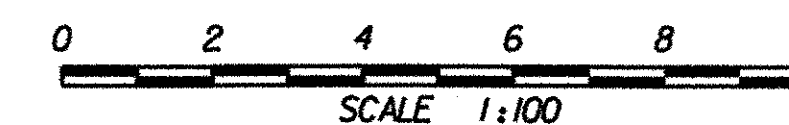

PROJECT:	BRATTLEBORO	PROJECT NO.:	NH 010-2(2)
DESIGN FILE NAME:	U:\99123-Brattleboro\dgn\zb270xs1.dgn		
IPARM FILE NAME:	PLOT DATE: 10-02-2002		
FROM STA: 0+050.000		TO STA: 0+055.000 SHEET: 137 OF 145	