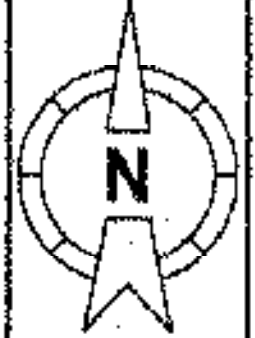



**WORK ORDER**

Notice: Not for Use/disclosure outside of VERIZON without written agreement

**VERIZON**

	<b>SAFETY NOTES:</b> <b>TRAFFIC,</b> <b>ROAD CONSTRUCTION</b>	MOD/REV NO.	DATE	EWO NO.
				PRINT 1 OF
SIGNATURE		TYPE:		C.O. /EXCHANGE NAME:
DATE 3/1/2001		AERIAL		BRATTLEBORO
PRE CT YES <input type="checkbox"/> NO <input checked="" type="checkbox"/>		UNDERGROUND		C.O. /EXCHANGE CODE:
PRIMARY VOLTAGE TO GROUND		BLOCK (NYT)		4731
7.2 KV MGN SYSTEM		CONDUIT		MUNICIPALITY:
				BRATTLEBORO
CABLE PRESS.	UNDER PRESS. YES <input type="checkbox"/> NO <input checked="" type="checkbox"/>	BUFFER YES <input type="checkbox"/> NO <input checked="" type="checkbox"/>	MANHOLE LOCATION MH# NA	
TRANSMISSION	28GA LIMIT YES <input type="checkbox"/> NO <input checked="" type="checkbox"/>	AMT. BRIDGE TAP INPUT	KF	

PROJECT # 131104

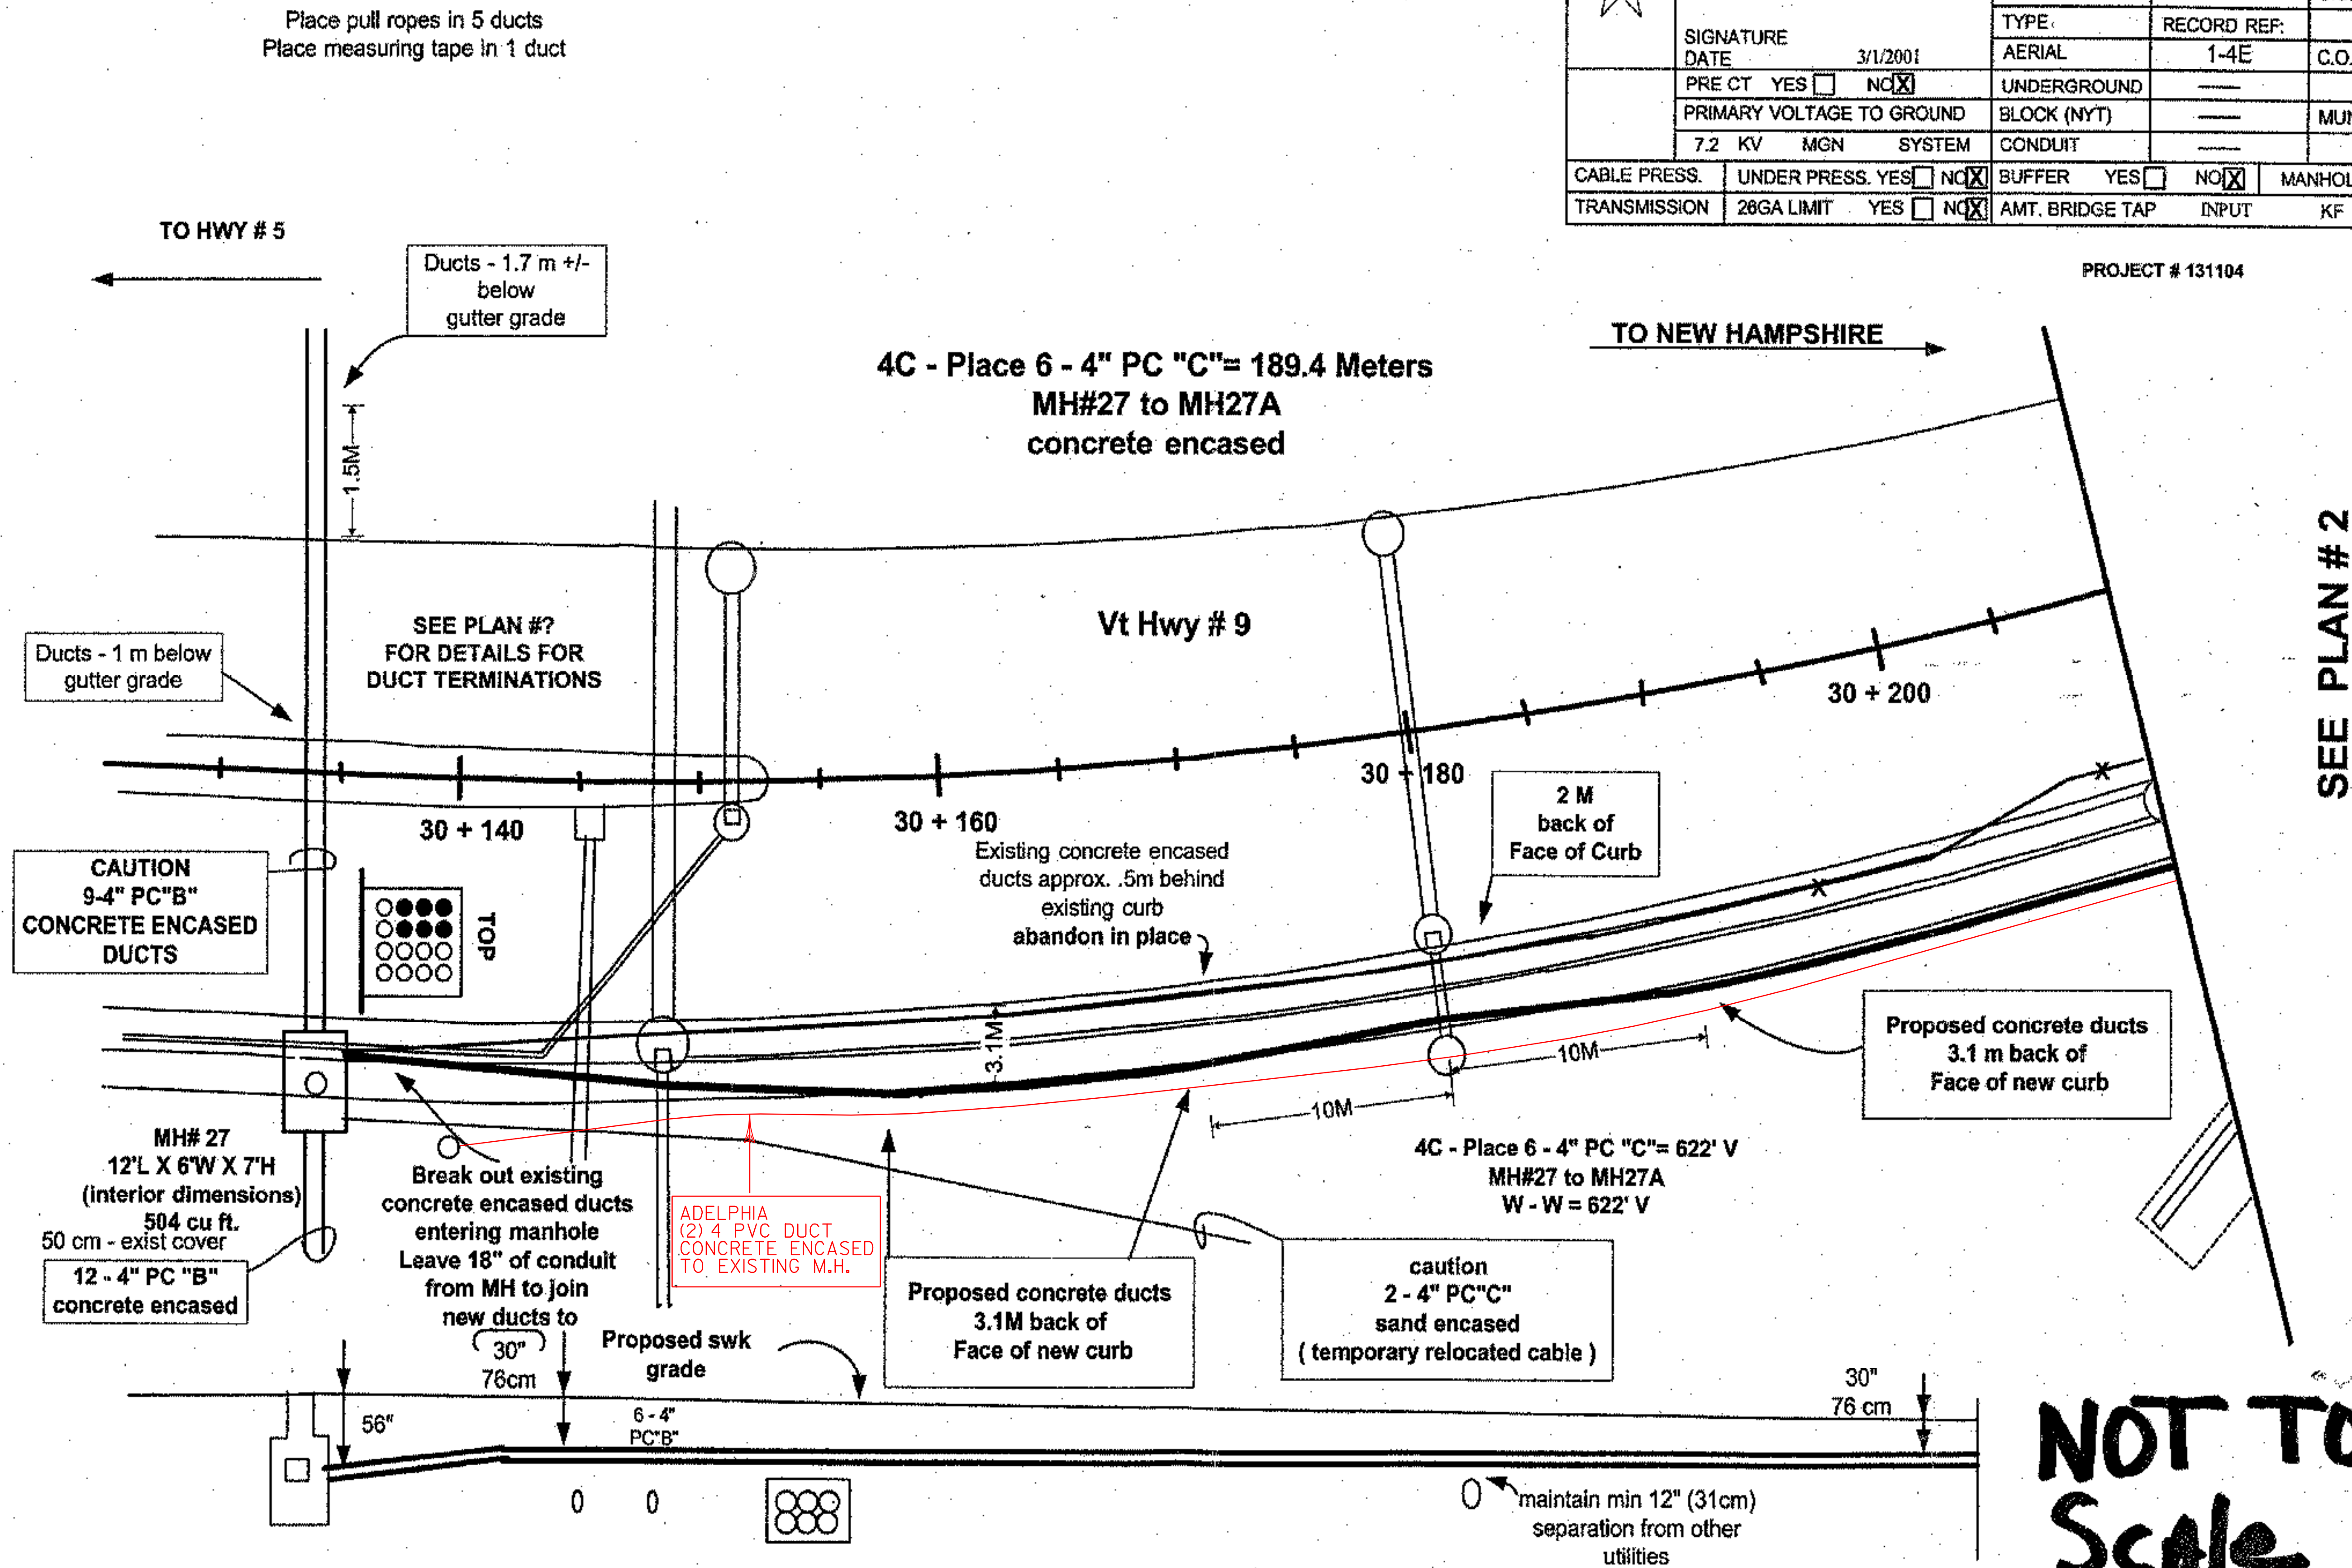

**NOT TO SCALE**

145 A

3/8/2001