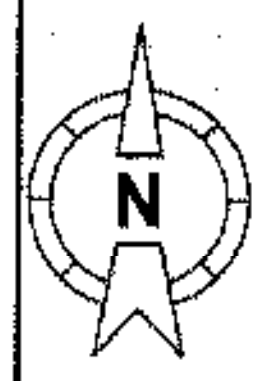



WORK ORDER

Notice: Not for Use/disclosure outside of VERIZON without written agreement

VERIZON

	SAFETY NOTES: TRAFFIC, ROAD CONSTRUCTION		MOD/REV NO.	DATE	EWO NO.
	SIGNATURE				PRINT 2 OF
	DATE 3/1/2001				PREPARED BY:
	PRE CT YES <input type="checkbox"/> NO <input checked="" type="checkbox"/>				C.O. /EXCHANGE NAME:
PRIMARY VOLTAGE TO GROUND			TYPE	RECORD REF:	BRATTLEBORO
7.2 KV MGN SYSTEM			AERIAL	1-4E	C.O. /EXCHANGE CODE:
			UNDERGROUND		4731
			BLOCK (NYT)		MUNICIPALITY:
			CONDUIT		BRATTLEBORO
CABLE PRESS.	UNDER PRESS. YES <input type="checkbox"/> NO <input checked="" type="checkbox"/>	BUFFER YES <input type="checkbox"/> NO <input checked="" type="checkbox"/>	MANHOLE LOCATION MH# NA		
TRANSMISSION	26GA LIMIT YES <input type="checkbox"/> NO <input checked="" type="checkbox"/>	AMT. BRIDGE TAP INPUT	KF		

PROJECT # 131104

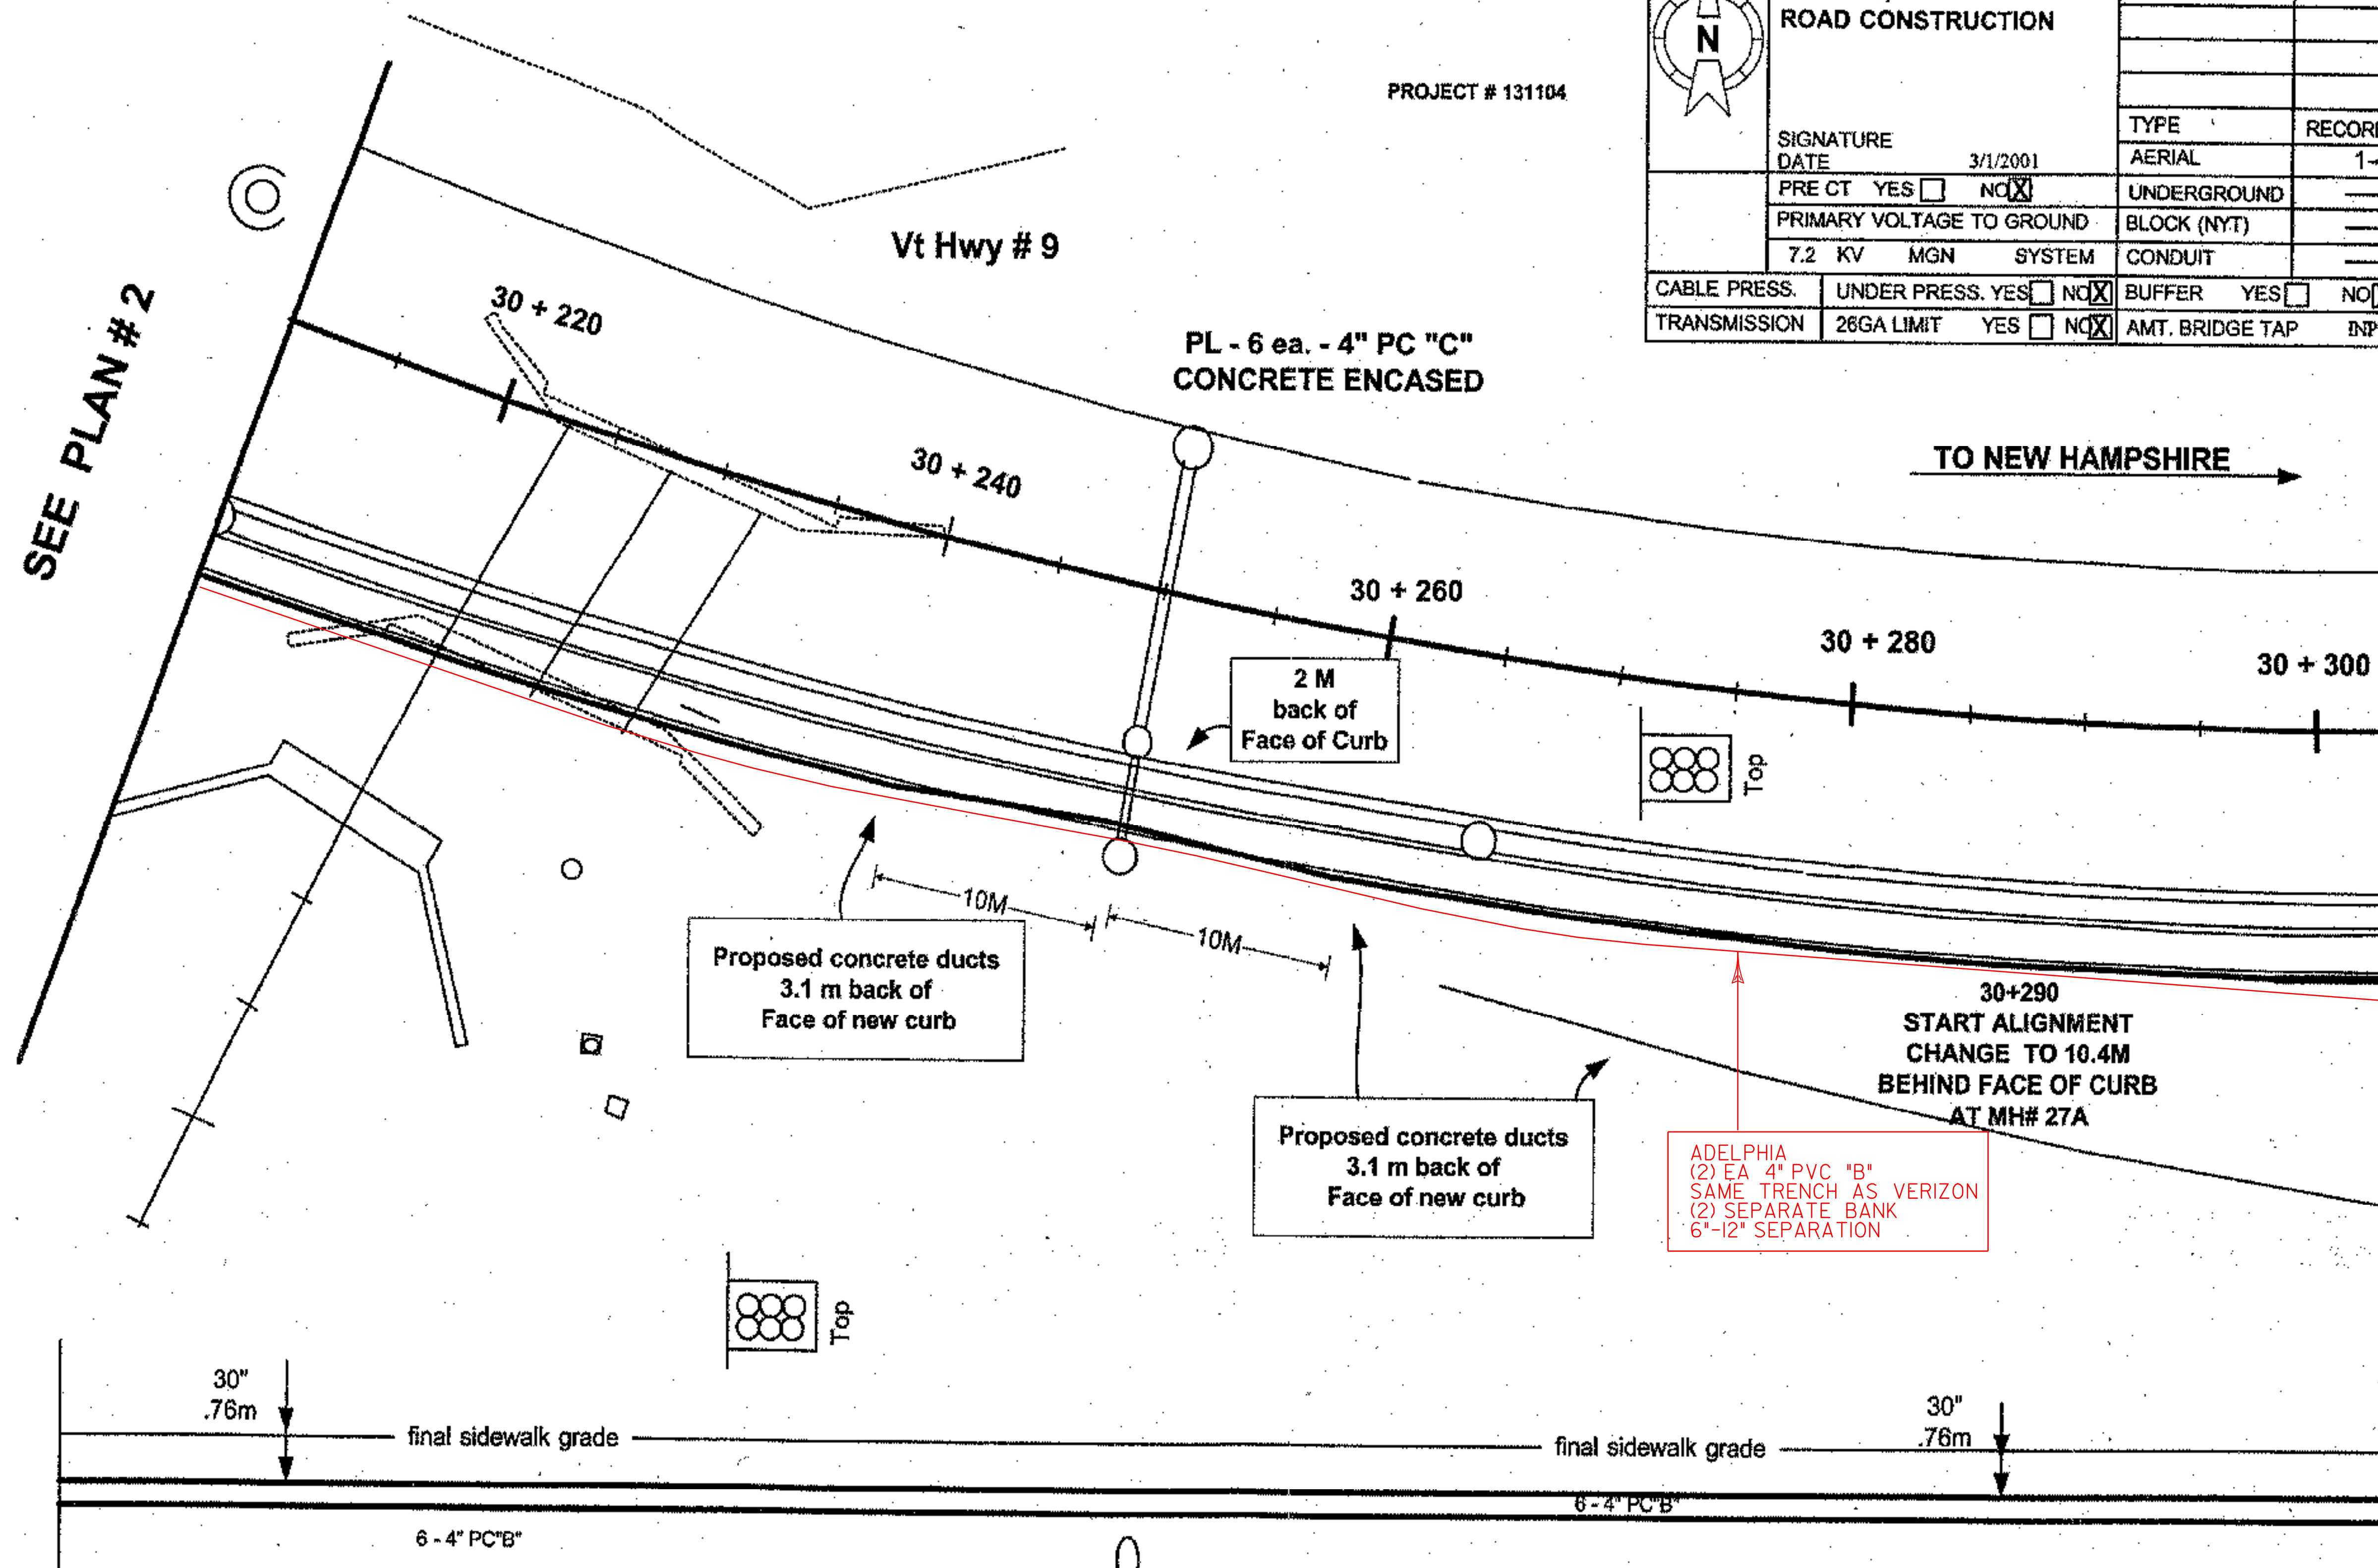

SEE PLAN # 2

SEE PLAN # 3

TO NEW HAMPSHIRE →

3/8/2001

NOT TO SCALE

145B