

WORK ORDER

Notice: Not for Use/disclosure outside of VERIZON without written agreement


VERIZON

4X - ABIP - 12'x6'x7' MH -
(1982)
MH# 27A old
4X - ABIP -MH27A to Pt "A"
- 4 - 4"PC"B" -76'
Verify (1982)

10.4 M FROM C/L
STA 30+320

MH#27A
MH COVER BESIDE SWK
4C - PI - 1 ez - 12'L x 6" W x 7' H
3.66 m LX1.83m W X 2.13m H
E/W 30" (76cm) Frame And Cover
2 - Ladder steps
1 - 8'(2.44 m) hooked ladder -
galvanized

Construction to verify
Wall - Wall distance
MH 27A to MH 27B
=793' V

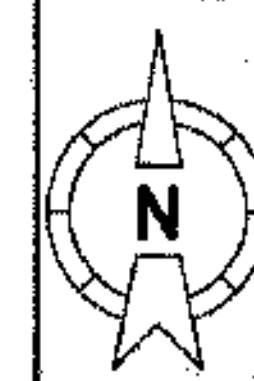

SAFETY NOTES:
TRAFFIC,
ROAD CONSTRUCTION

SIGNATURE
DATE 3/1/2001

PRE CT YES NO

PRIMARY VOLTAGE TO GROUND
7.2 KV MGN SYSTEM


CABLE PRESS. UNDER PRESS. YES NO

TRANSMISSION 26GA LIMIT YES NO

MOD/REV NO.	DATE	EWO NO.
		PRINT 3 OF
		PREPARED BY:
		C.O. /EXCHANGE NAME:
		BRATTLEBORO
		C.O. /EXCHANGE CODE:
		4731
		MUNICIPALITY:
		BRATTLEBORO
		MANHOLE LOCATION MH# NA
		AMT. BRIDGE TAP INPUT KF


Project # 131104

SEE PLAN # 2

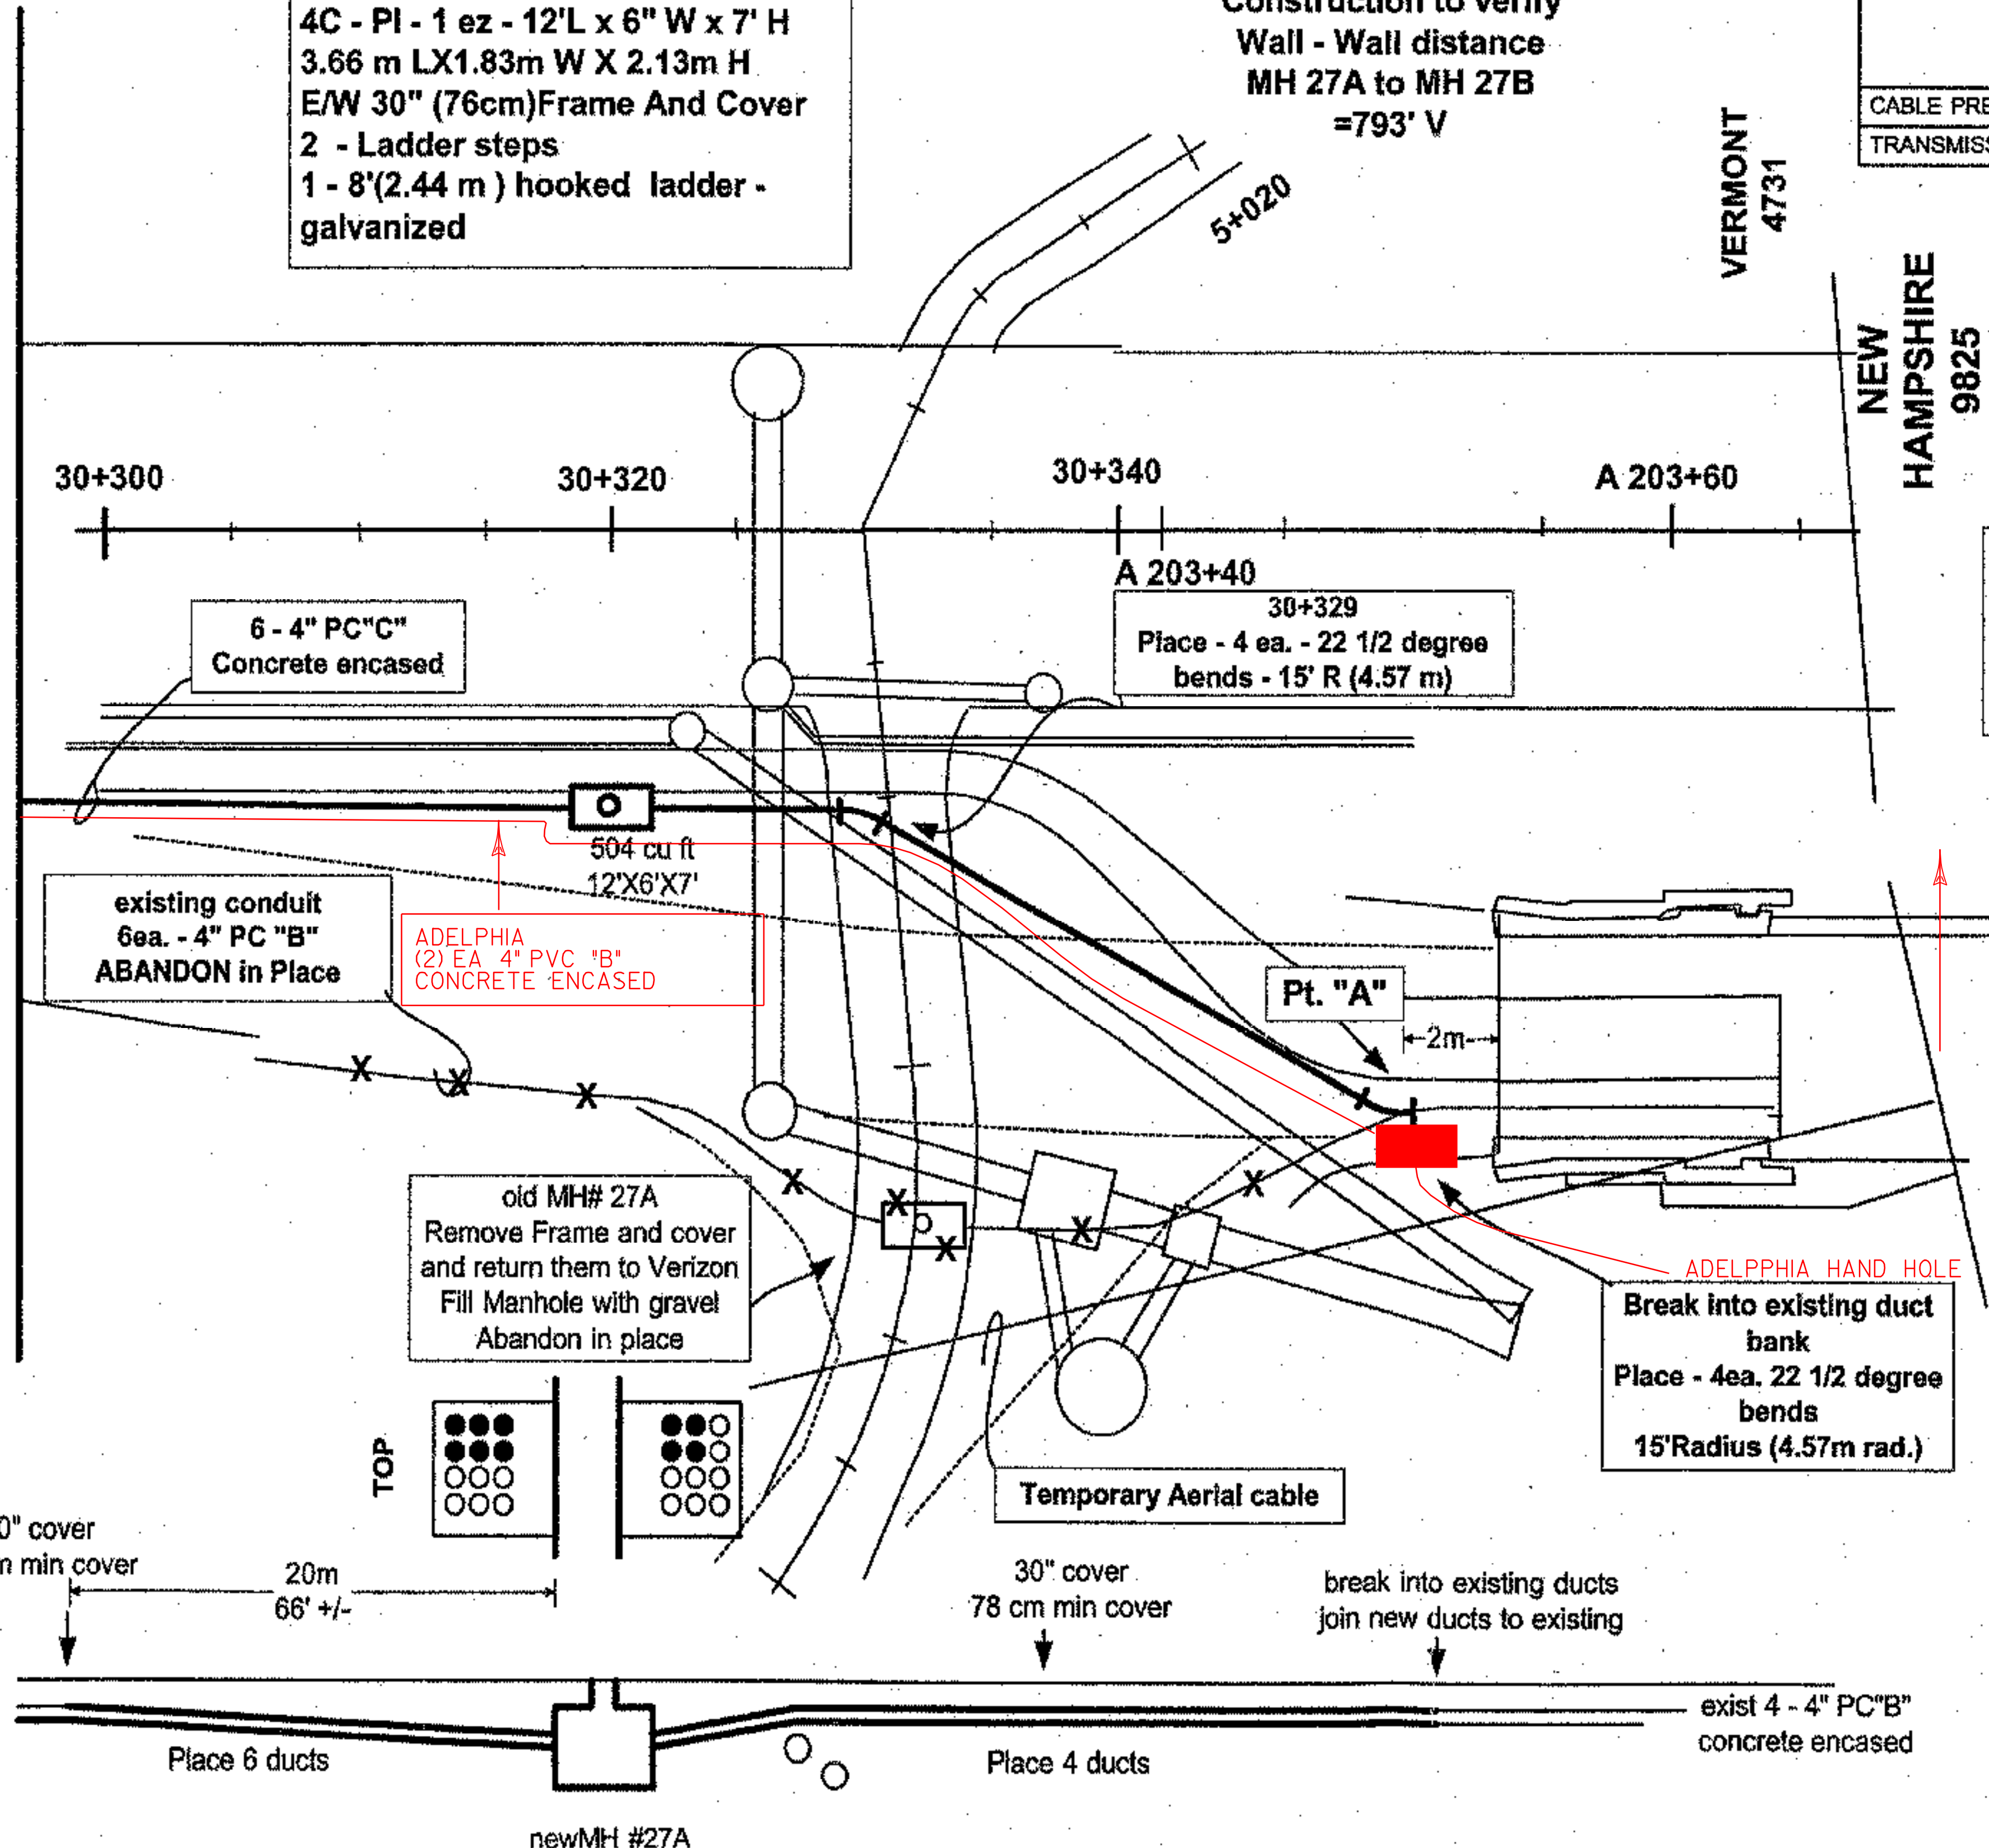

4C - Mh# 27A to Pt "A"
PI - 4 ea. - 4" PC"B"
34.6 m - Verify
114' - verify

CONNECTICUT RIVER

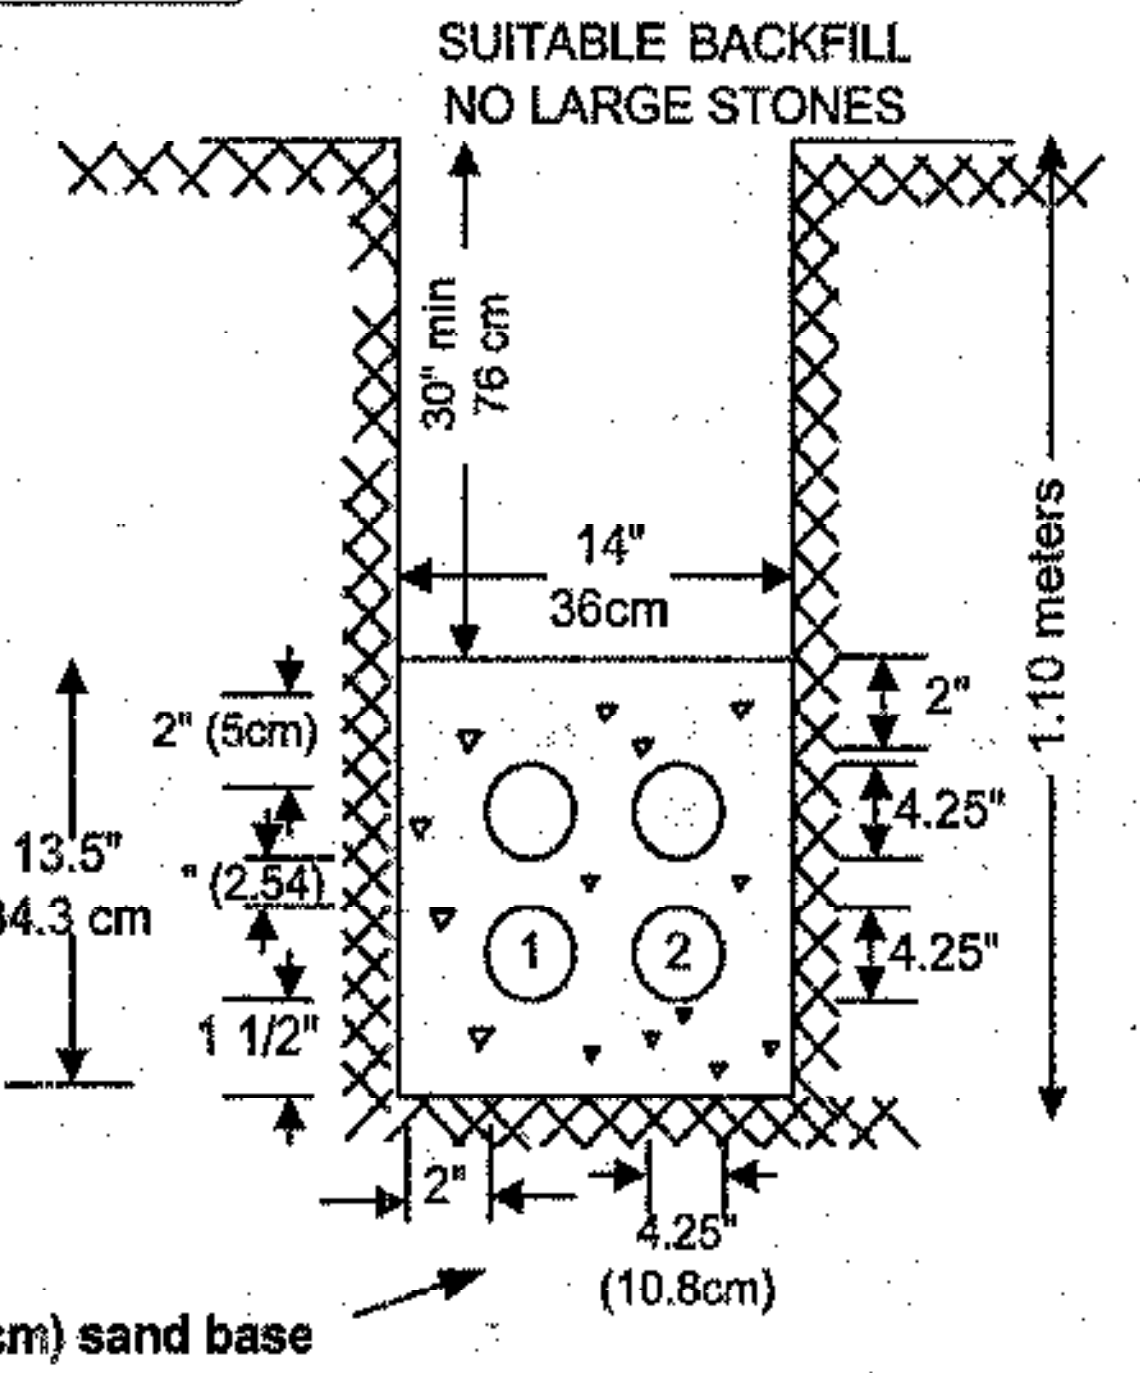

NO TO SCALE

145C

3/8/2001