



FRONT1 OF ABUTMENT FOOTING  
AREA = 13.406m<sup>2</sup>

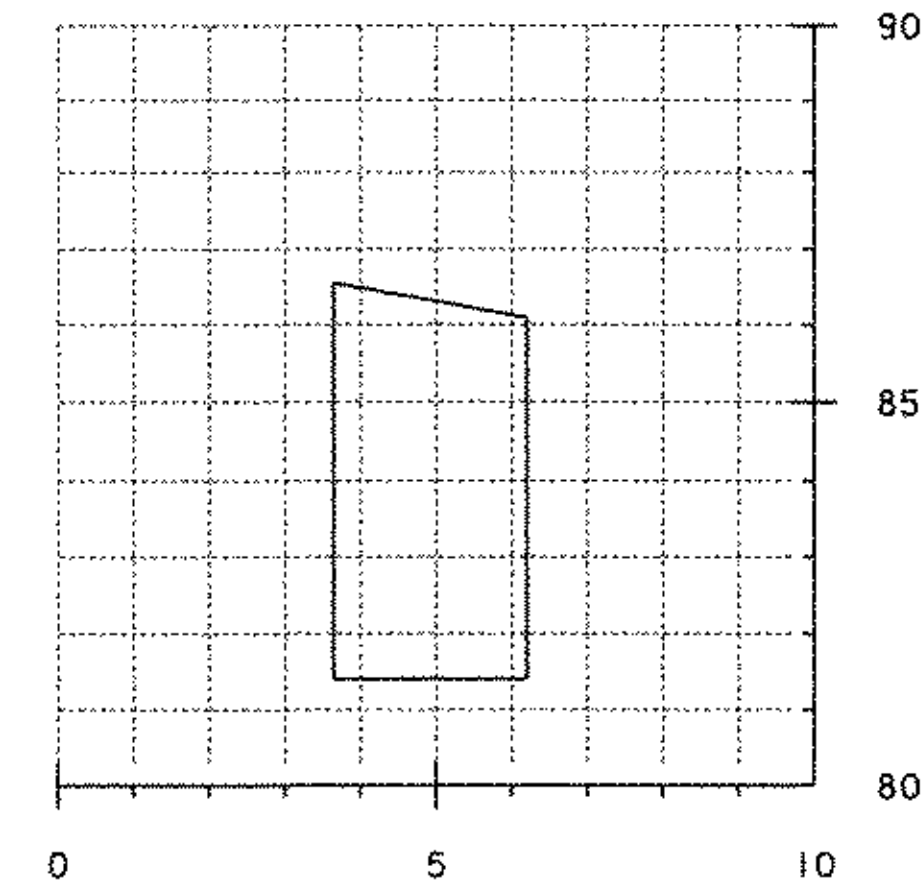


FRONT2 OF ABUTMENT FOOTING  
AREA = 12.58m<sup>2</sup>


*US 03/16/05*

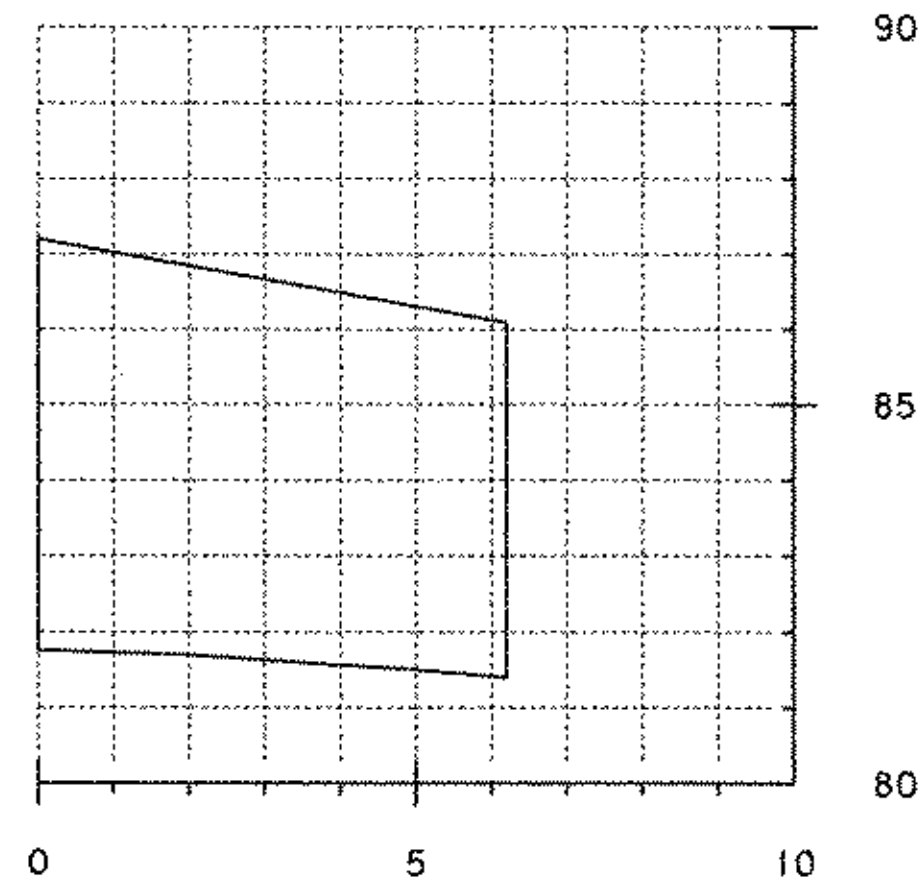

FRONT3 OF ABUTMENT FOOTING  
AREA = 31.237m<sup>2</sup>

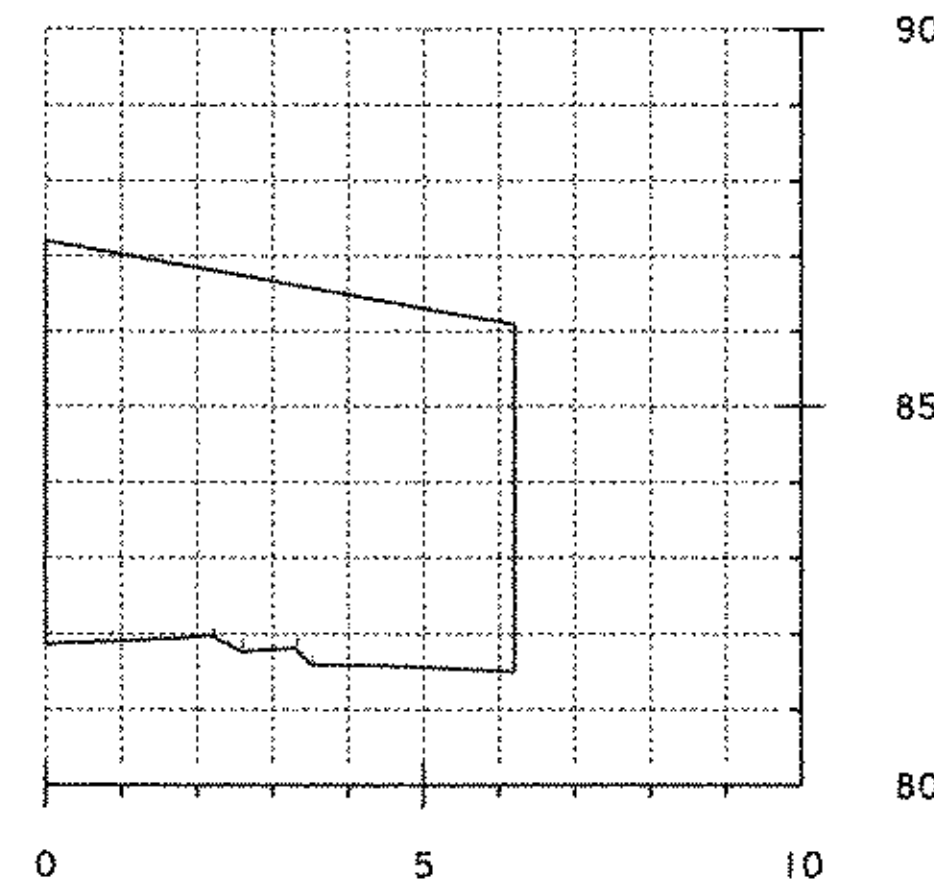

MIDDLE OF ABUTMENT FOOTING  
AREA = 30.459m<sup>2</sup>

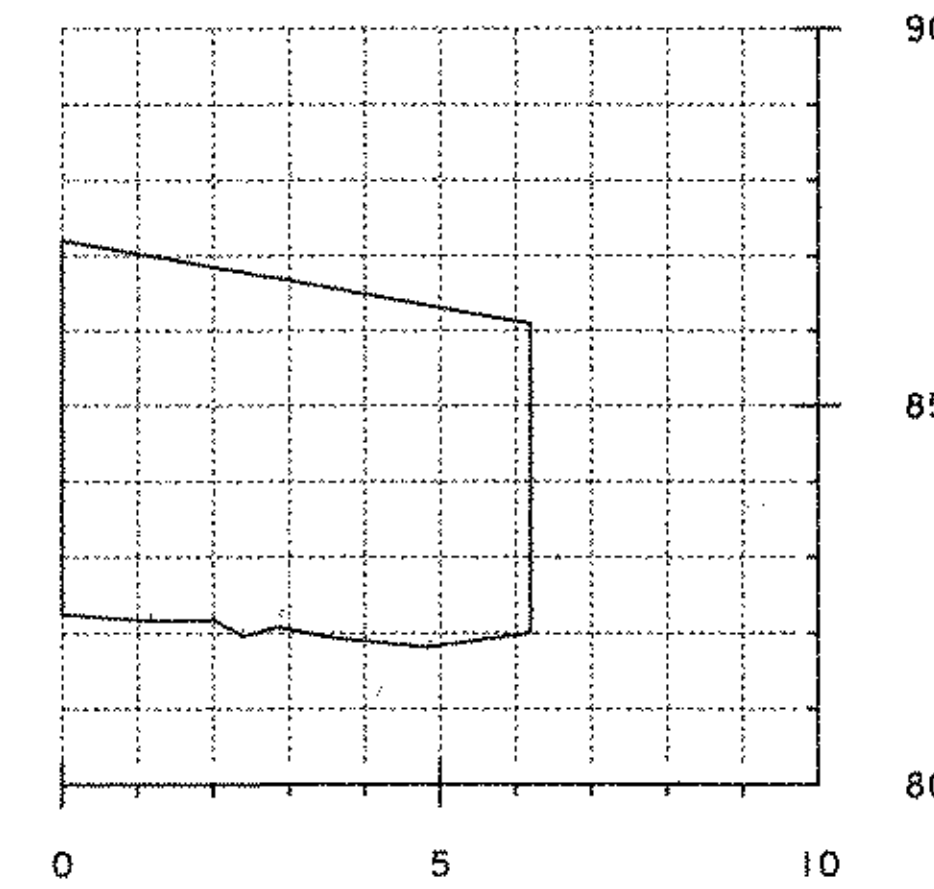

BACK OF ABUTMENT FOOTING  
AREA = 28.666m<sup>2</sup>

*US 03/16/05*

SARGENT BROOK SOUTH  
COFFERDAM EXCAVATION EARTH



PROJECT: BRATTLEBORO	PROJECT NO.: NH 010-2(2)
PLOT DATE: 25-MAR-2005	
LEDGE SECTIONS 15343	