



FRONT OF WINGWALL TWO FOOTING  
AREA = 19.992m<sup>2</sup>

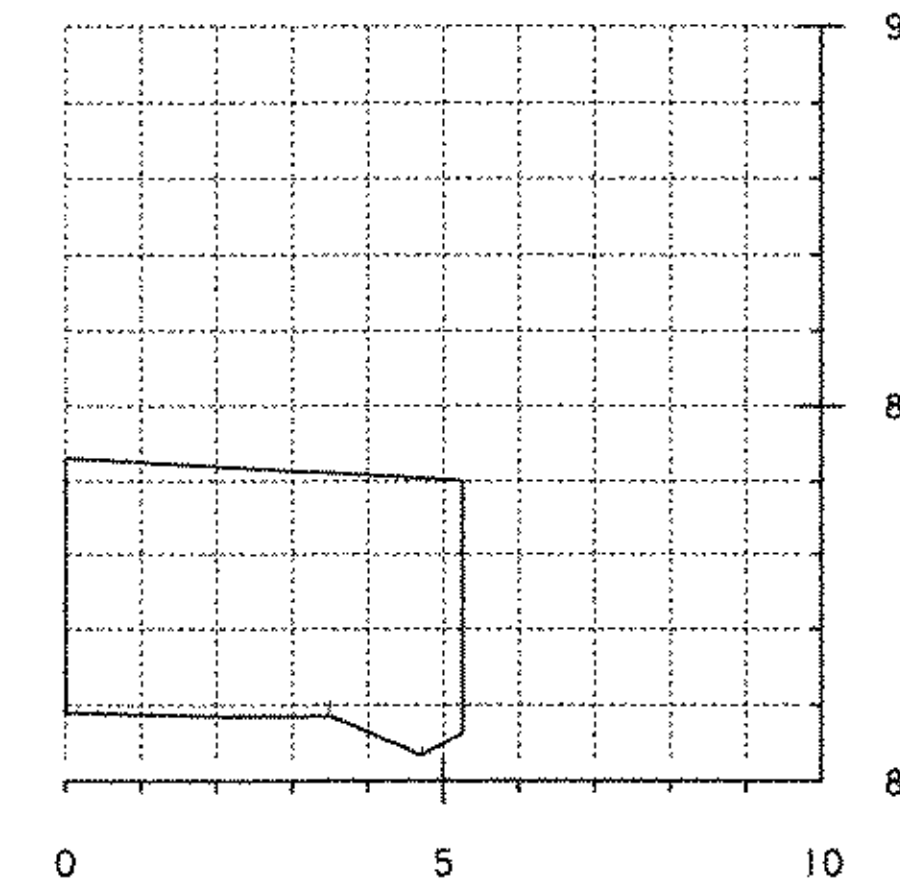


BACK OF WINGWALL TWO FOOTING  
AREA = 17.785m<sup>2</sup>


*6/25 03/20/05*

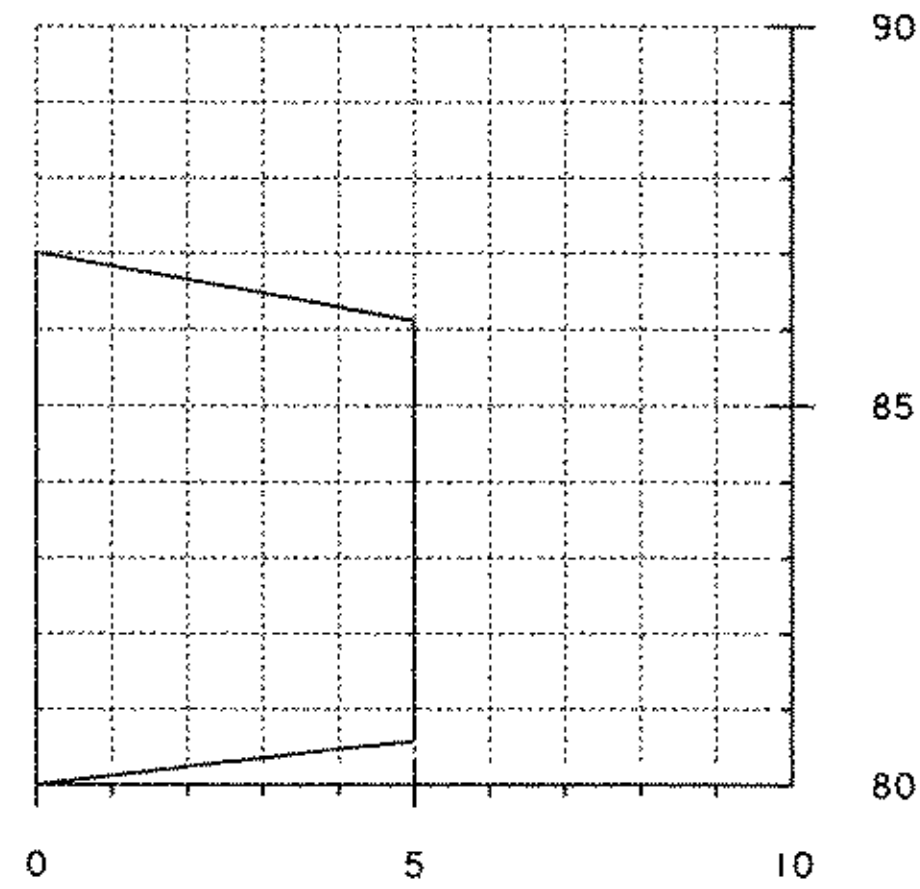

FRONT OF ABUTMENT FOOTING  
AREA = 31.280m<sup>2</sup>

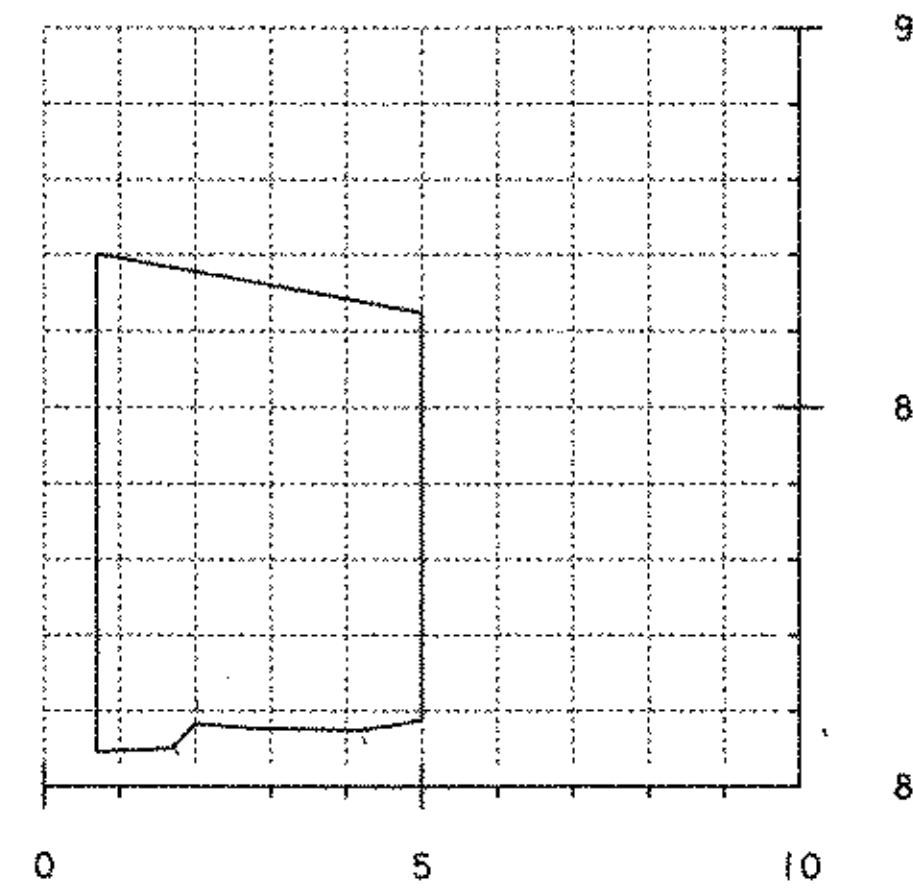


MIDDLE OF ABUTMENT FOOTING  
AREA = 25.425m<sup>2</sup>

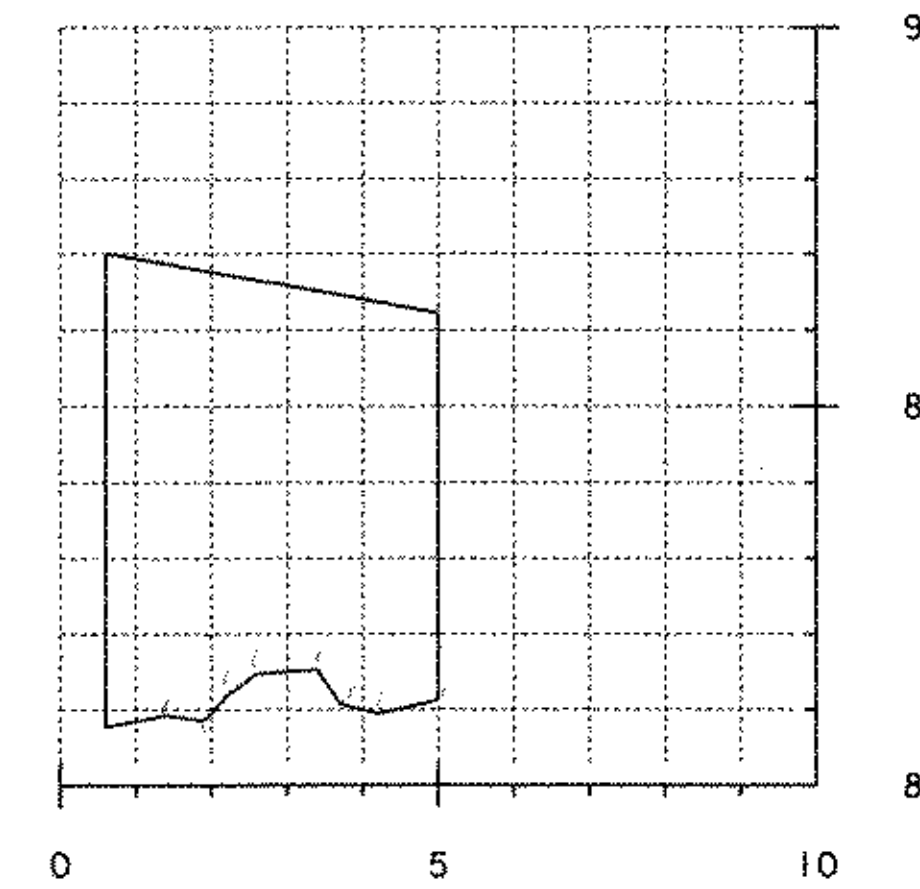

BACK OF ABUTMENT FOOTING  
AREA = 24.194m<sup>2</sup>

*6/25 03/14/05*

SARGENT BROOK NORTH  
COFFERDAM EXCAVATION EARTH

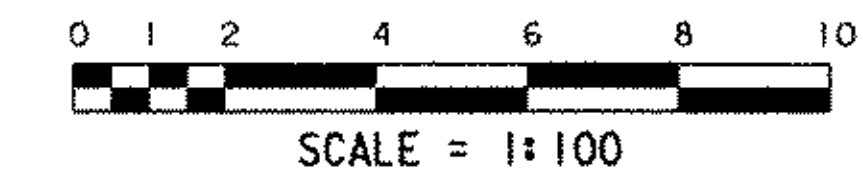

|                               |                             |
|-------------------------------|-----------------------------|
| PROJECT:<br>BRATTLEBORO       | PROJECT NO.:<br>NH 010-2(2) |
| PLOT DATE: 25-MAR-2005        |                             |
| LEDGE SECTIONS <i>154 x 5</i> |                             |