



FRONT OF WINGWALL 4A FOOTING

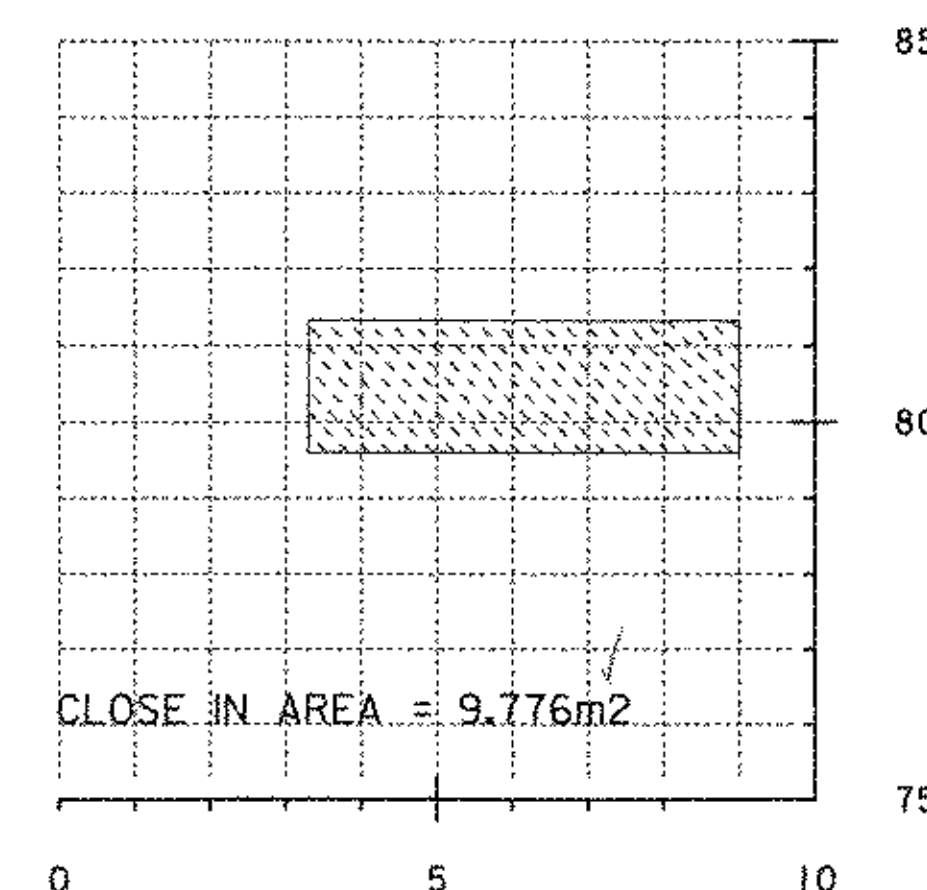

MIDDLE OF WINGWALL 4A FOOTING

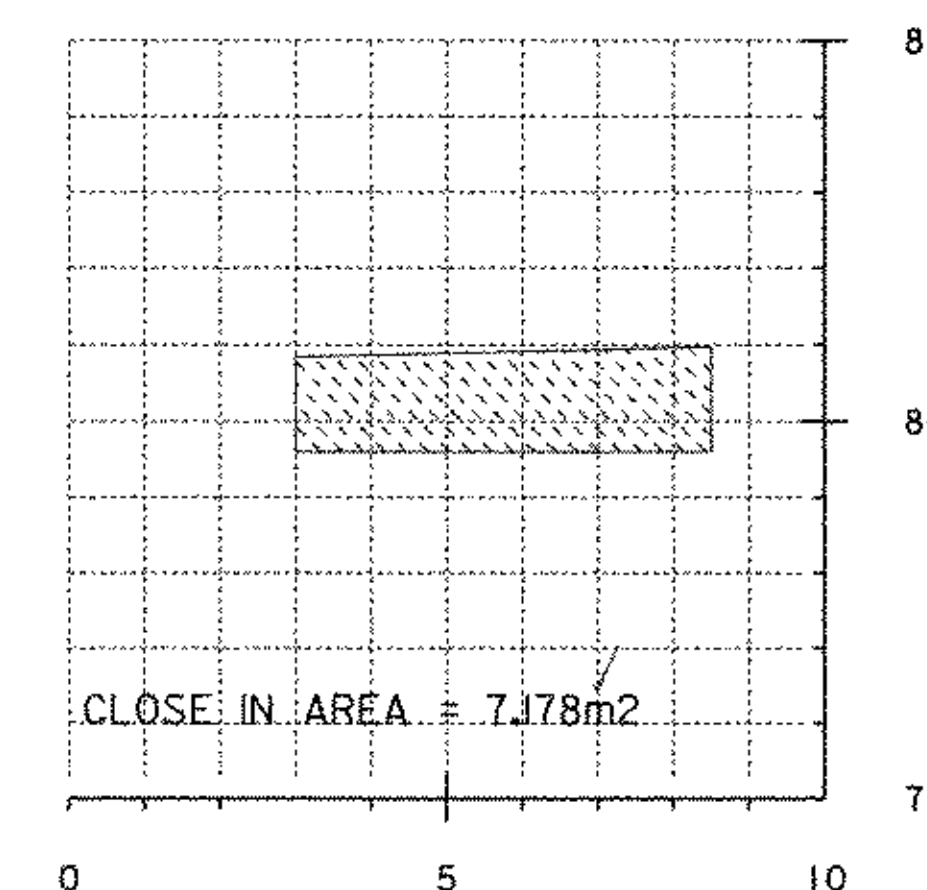


BACK OF WINGWALL 4A FOOTING

*CLB  
03/25/05*

LEGEND

- = MECHANICAL REMOVAL ZONE
- = CLOSE IN REMOVAL ZONE

ROUTE 9 BRIDGE NORTH ABUTMENT  
PHASE TWO LEDGE SECTIONS

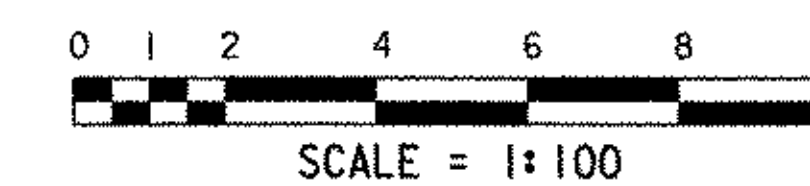

PROJECT: BRATTLEBORO	PROJECT NO.: NH 010-2(2)
PLOT DATE: 25-MAR-2005	
LEDGE SECTIONS <i>15BAS</i>	