
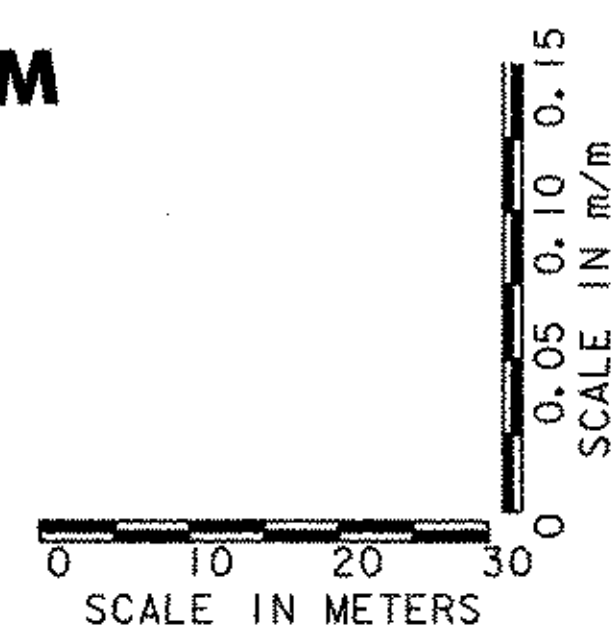


TYPICAL DITCH CHECK DAM DETAIL

(NOT TO SCALE)

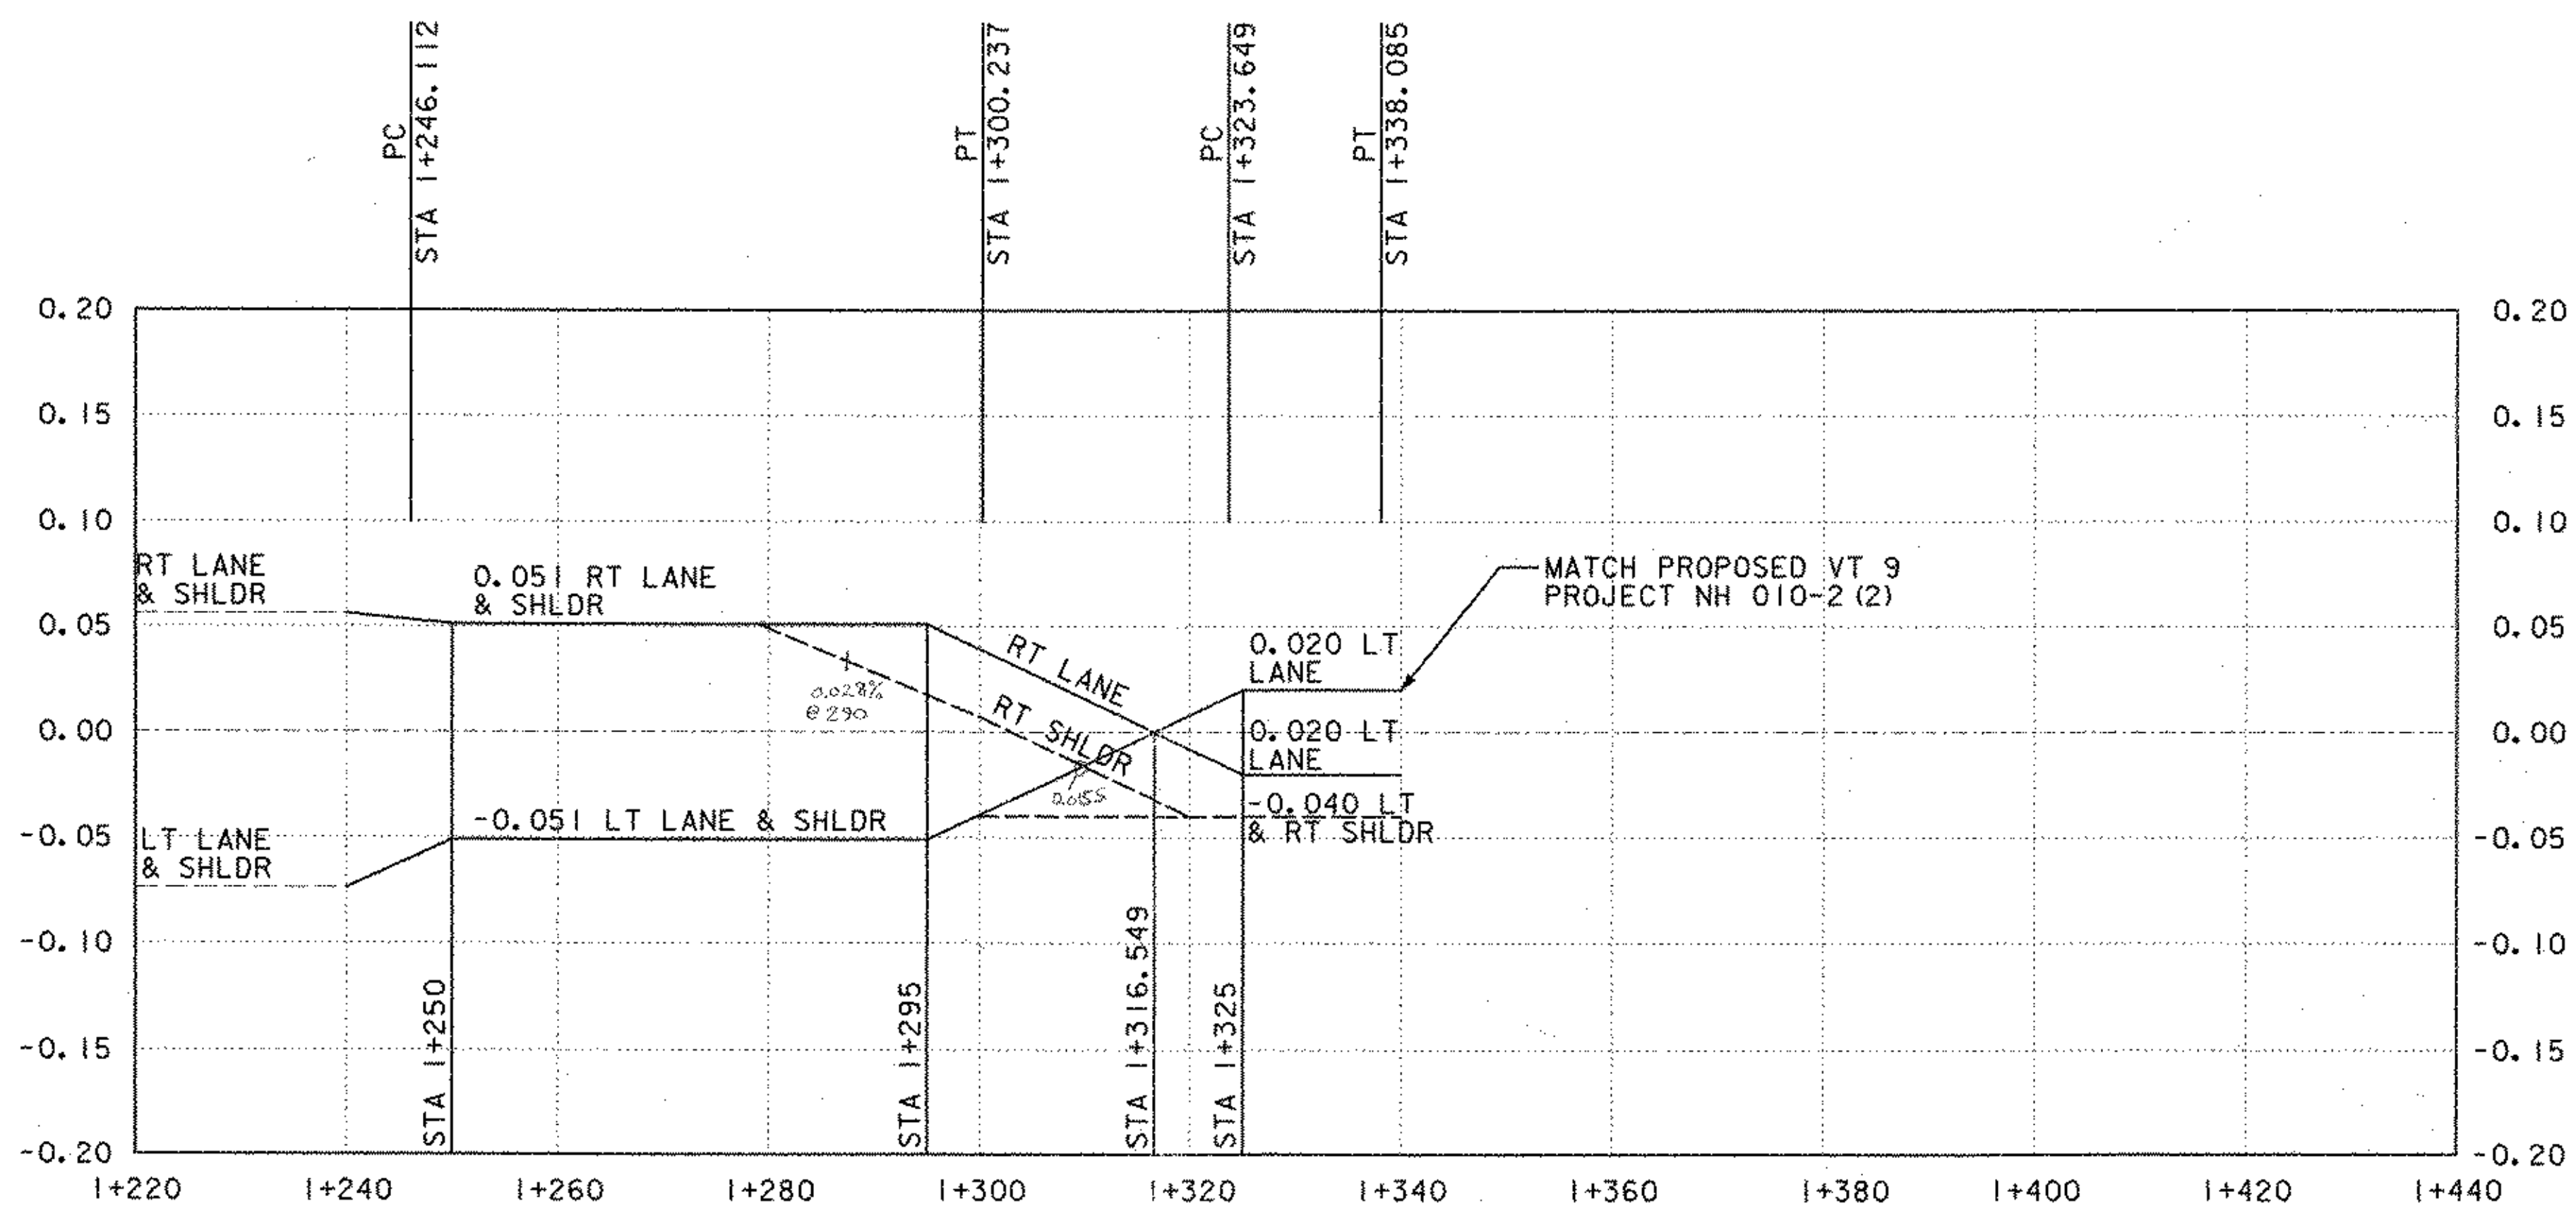

MISCELLANEOUS DETAILS

PROJECT NAME: BRATTLEBORO	PLOT DATE: 03/28/2003
PROJECT NUMBER: NH 010-2(2)	DRAWN BY: PTS
FILE NAME: ...zb270frm.dgn	CHECKED BY: JAW
PROJECT LEADER: WRH	SHEET 2 OF 13
DESIGNED BY: PTS	
CLD REF NO. 02-0439	

16/1 Percha