


I+260

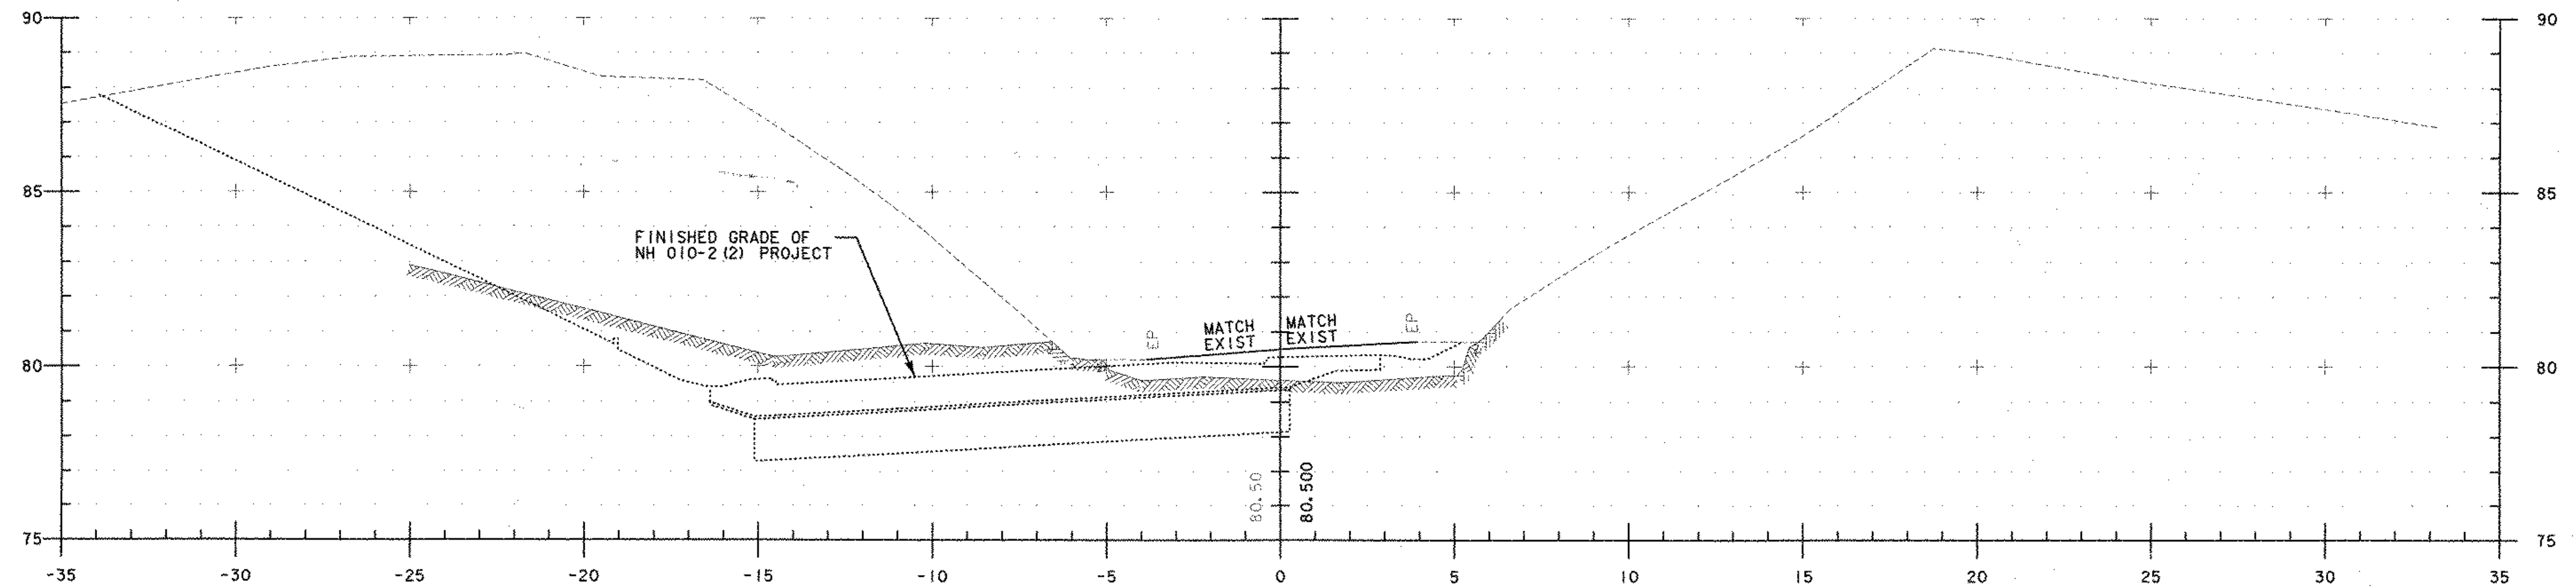

I+240

PROJECT NAME:	BRATTLEBORO
PROJECT NUMBER:	NH 010-2(2)
FILE NAME:	... \zb270xs.dgn
PROJECT LEADER:	WRH
DESIGNED BY:	PTS
CLD REF NO.	02-0439
PLOT DATE:	03/28/2003
DRAWN BY:	PTS
CHECKED BY:	JAW
SHEET	10 OF 13

169 ROCK