




ITEM 8MS1 (2 REQ'D)
SCALE 1:20

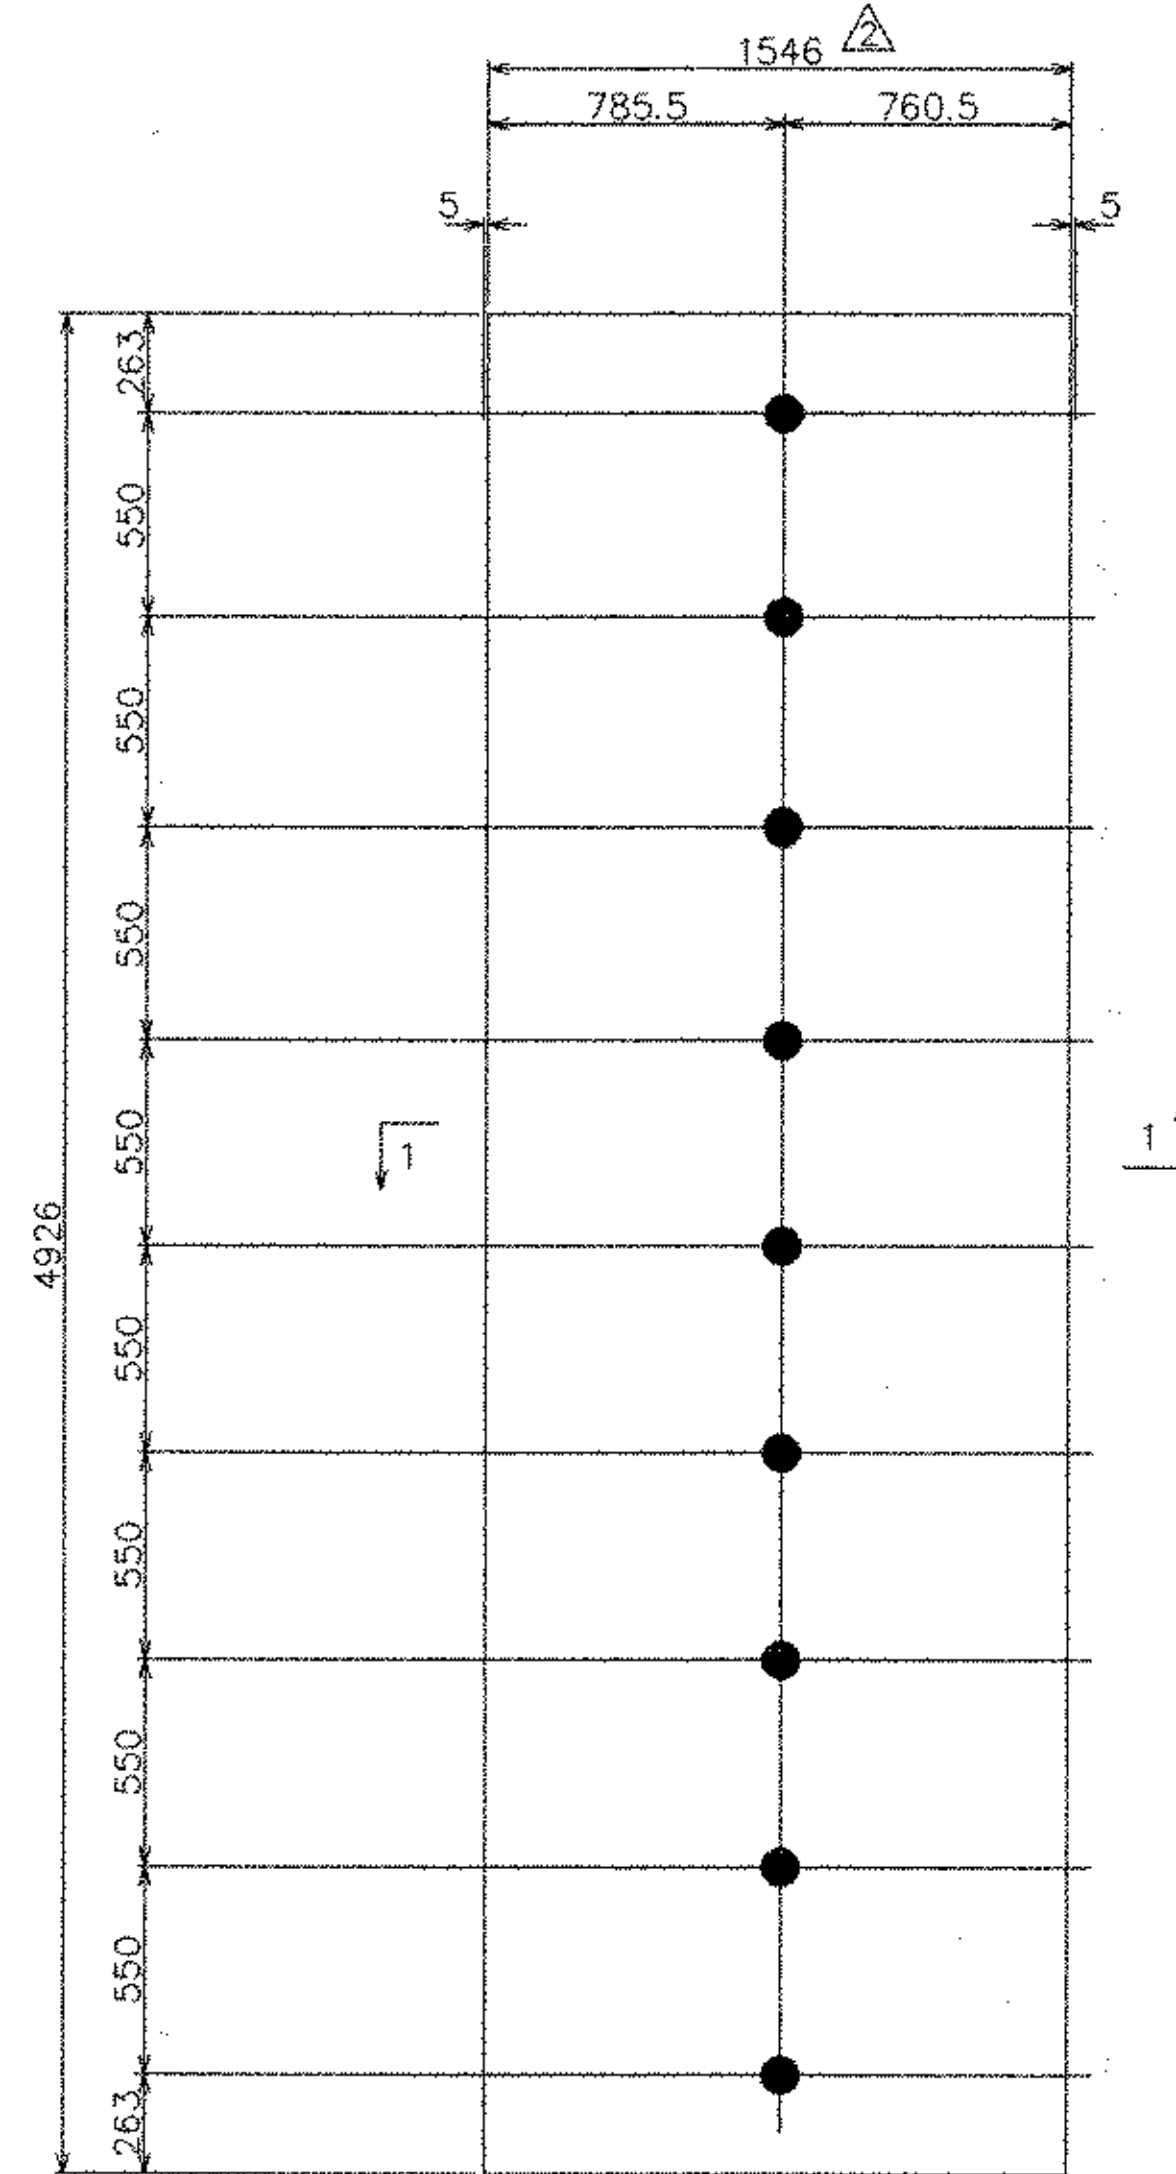

ITEM 8MS2 (2 REQ'D)
SCALE 1:20

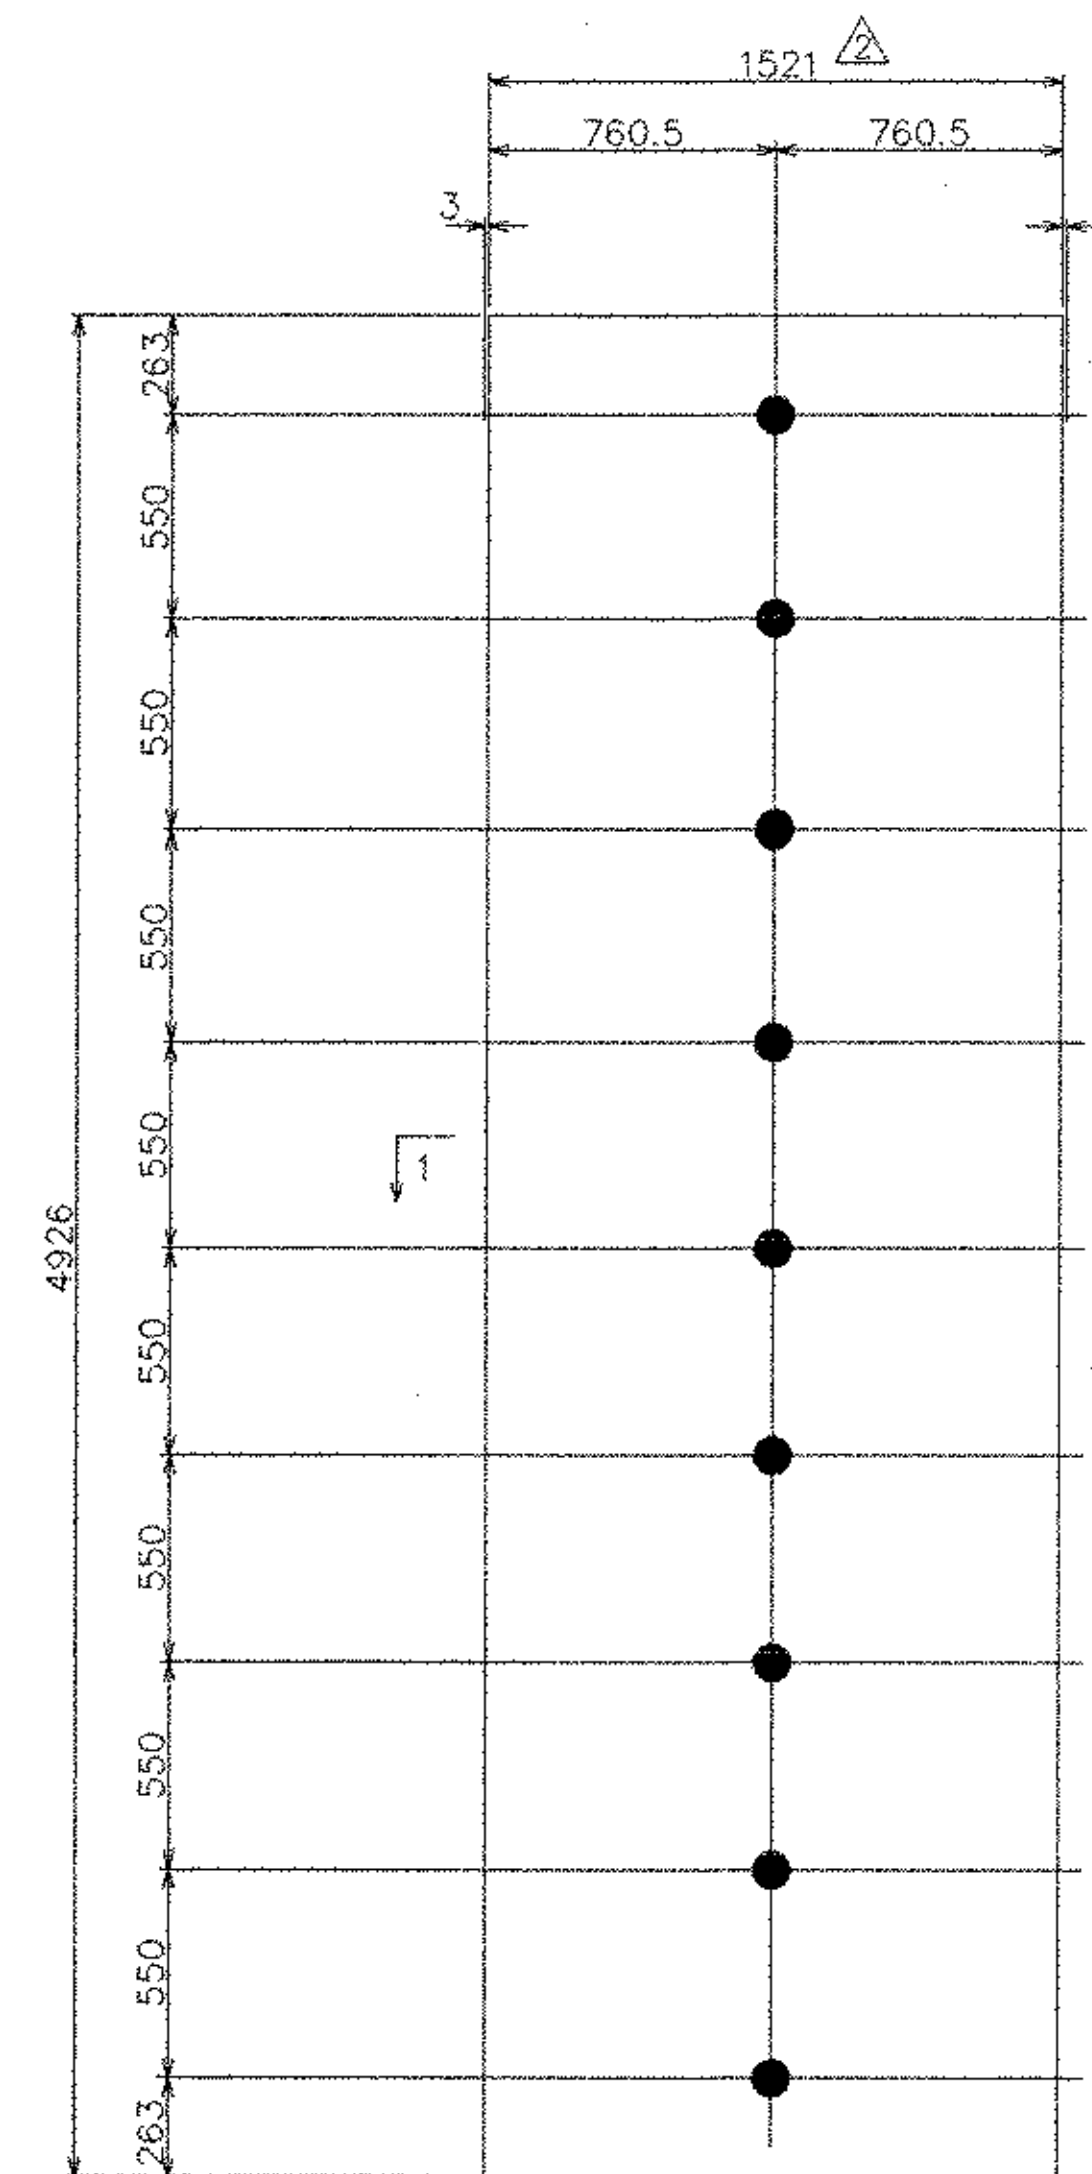


ITEM 8MS3 (17 REQ'D)
SCALE 1:20

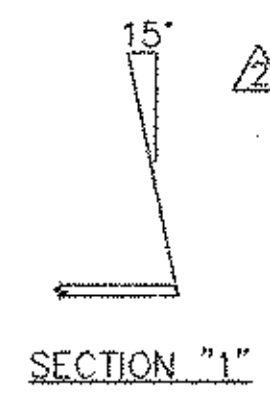

Dwg No.	Rev.	Ship Mark	Piece Mark	Qty	Type	Size of Material	Grade	Length	Finish	Wgt./Lbs.	Notes	ABM
B				2	ASSY.					7126		
			a8	2	PL	20x1935	M270M-345W	4926		6822		2-L
			b8	2	L	76x76x12.5	M270M-345W	4926		304		2-M
B				2	PL	20x1546	M270M-345W	4926		5463		2-N
B				17	PL	20x1521	M270M-345W	4926		45679		2-O

NOTES:
1 - GENERAL NOTES: SEE DRAWING GN1
2 - HOLES: 100mm

STEEL-ART, INCORPORATED
40 WEST MAIN STREET
GALETON, PA 16922
(814) 433-6997

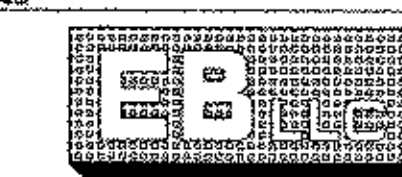

EASTERN BRIDGE LLC
RURAL RTE 2, BOX 302
CLAREMONT, NH 03743
608-542-5502

REVISIONS			STATE OF VERMONT AGENCY OF TRANSPORTATION		
NO.	DATE	DESCRIPTION	CONTRACT	PIN	
1	5/14/03	PER APPROVAL			
	5/24/03	PER APPROVAL			
	8/4/03	Approval			

PROPOSED IMPROVEMENT TO RR BRIDGE #62.56
OVER VT ROUTE 9 (PRINCIPAL ARTERIAL)
WINDHAM COUNTY, TOWN OF BRATTLEBORO

TITLE: BALLAST PLATES

DRAWN BY TJS	SHOP ORDER	DWG. NO.
3/25/03	4015	8
OK'D BY RGY	BLOCK NO.	SHEET NO.
4/8/03		14 / 20

197 SS