


PROFILE - VT ROUTE 9

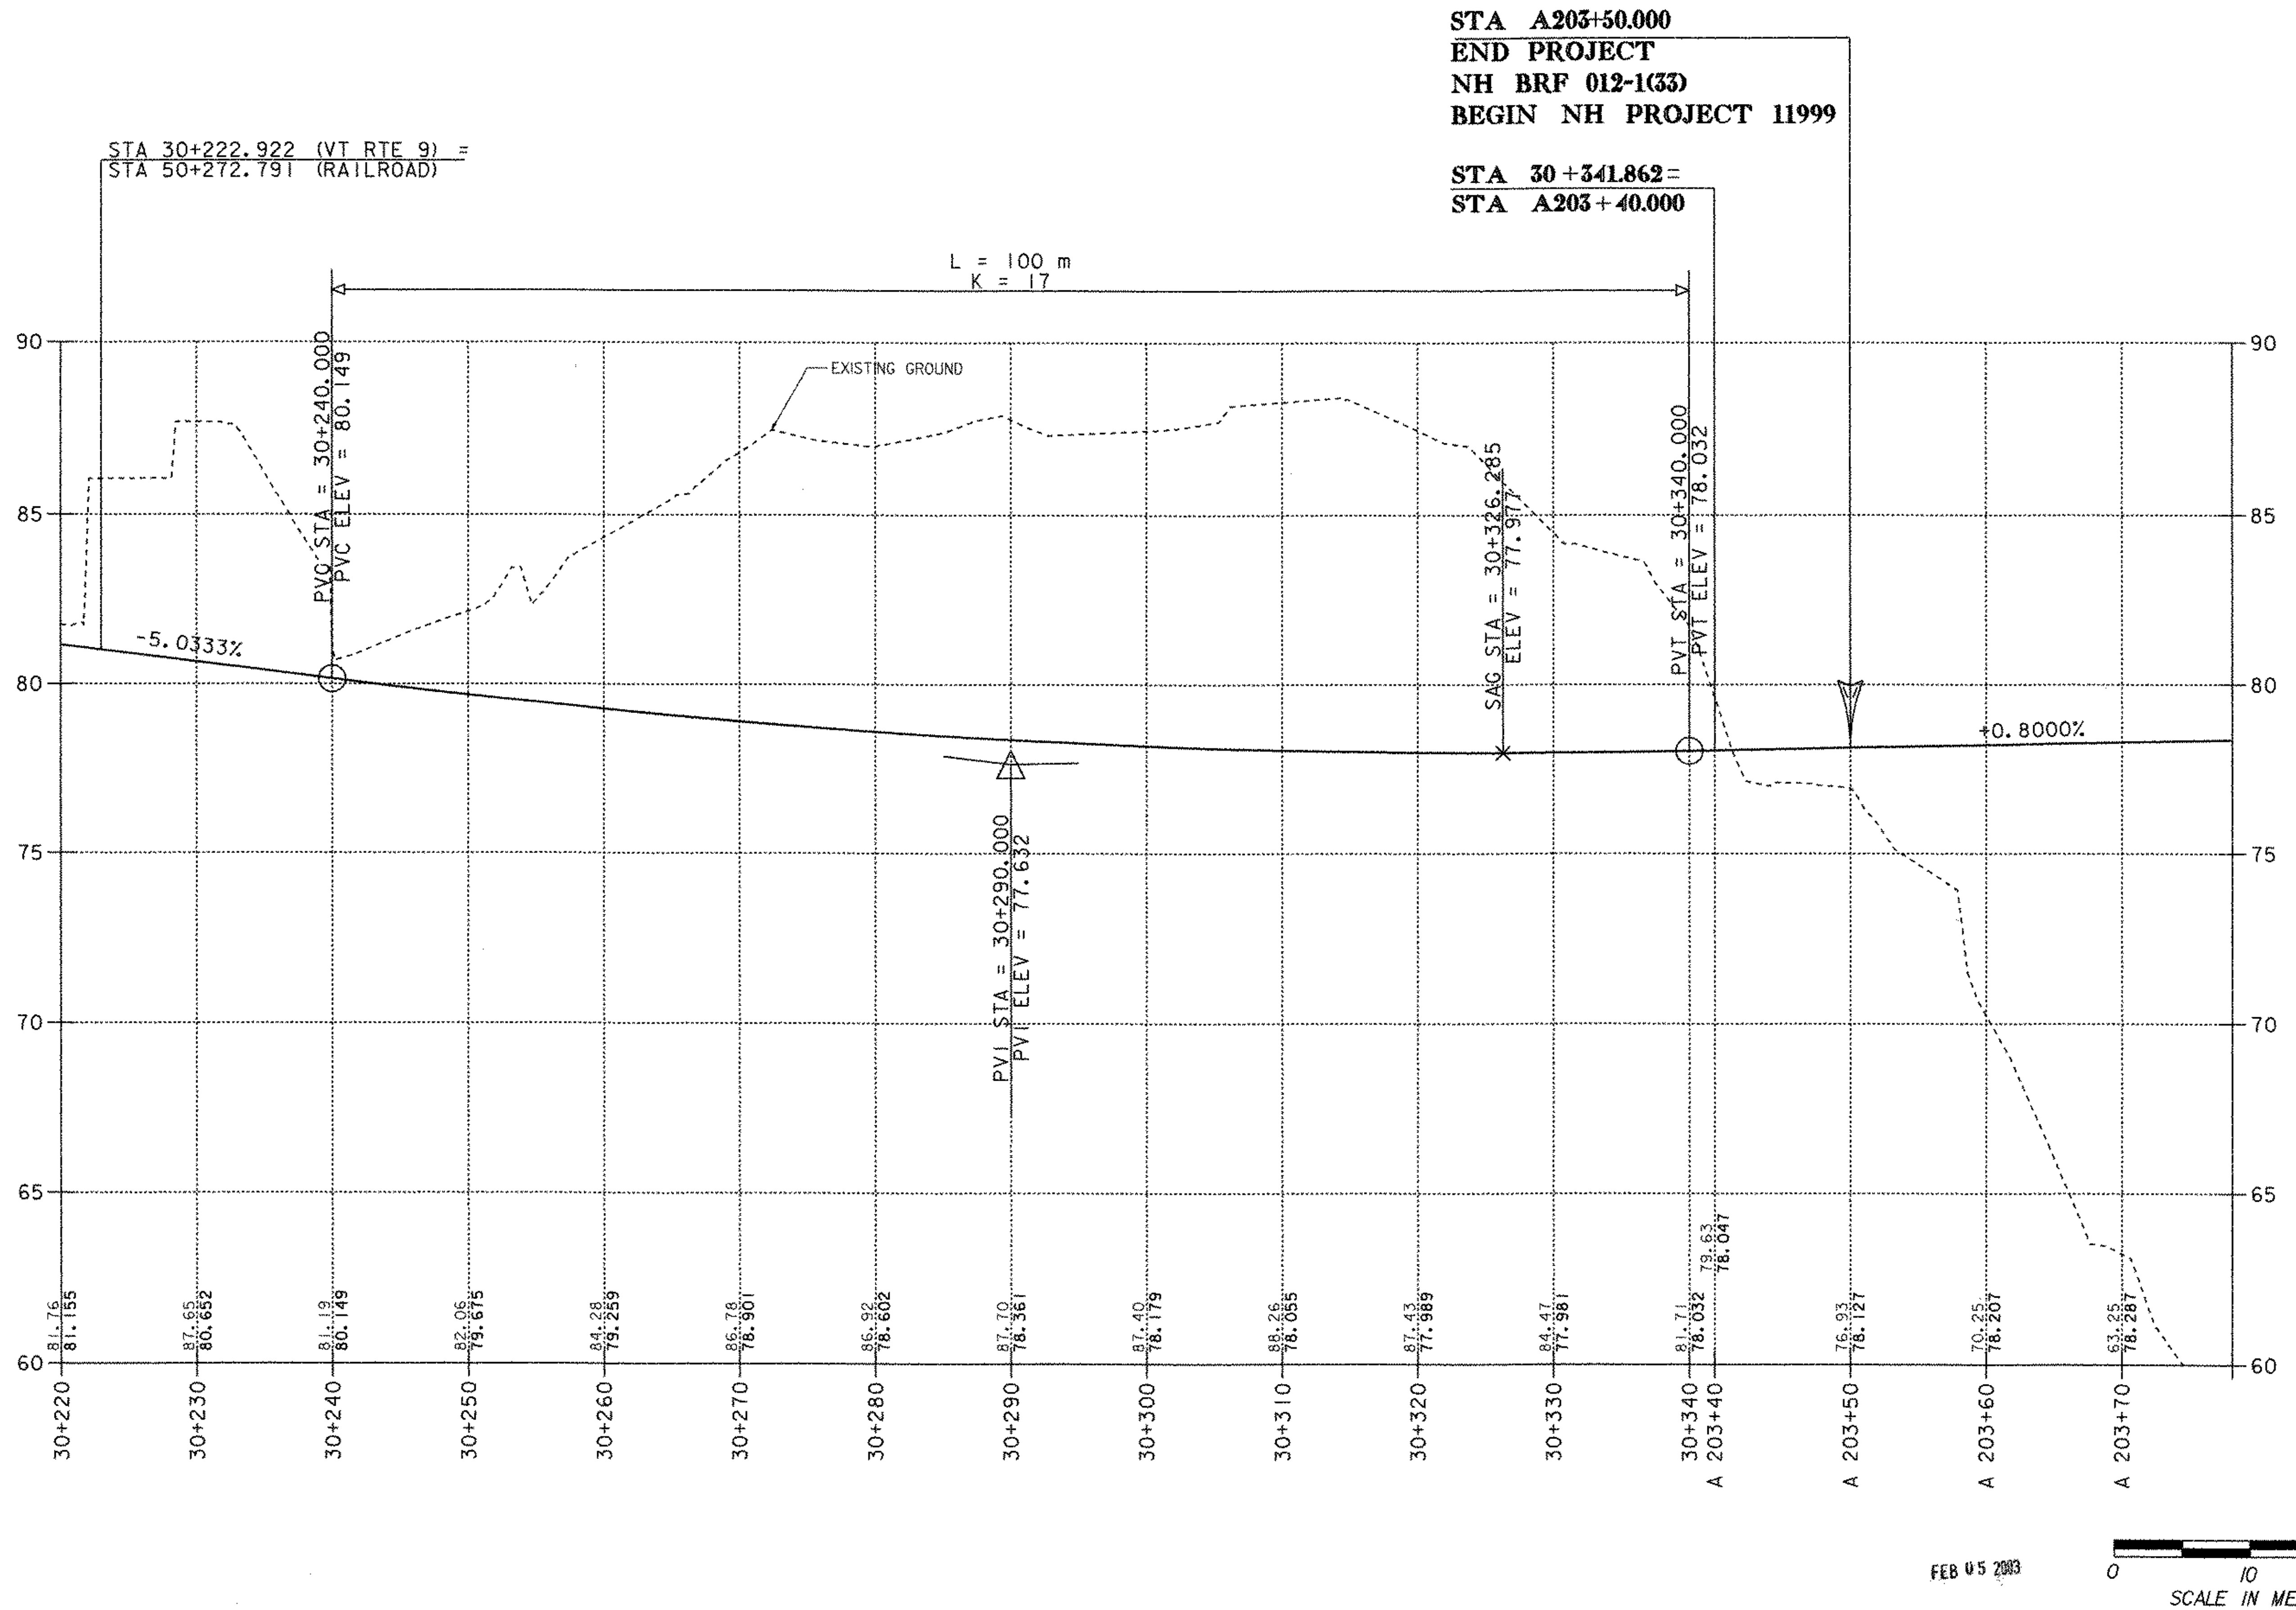

DATUM
VERTICAL NGVD 1929
HORIZONTAL NAD 1983

PROJECT: BRATTLEBORO PROJECT NO.: NH BRF 012-1(33)
DESIGN FILE NAME: 95b270\structures\sb270xs2.dgn
IPARM FILE NAME: sb270pr2.i PLOT DATE: 09-MAR-2001
SURVEYED BY: SURVEY DATE:
SQUAD LEADER: W HUSBAND DRAWN BY: P SHEDD
R.O.W. SHEET 6 OF 27 SHEETS