


RAILROAD PROFILE

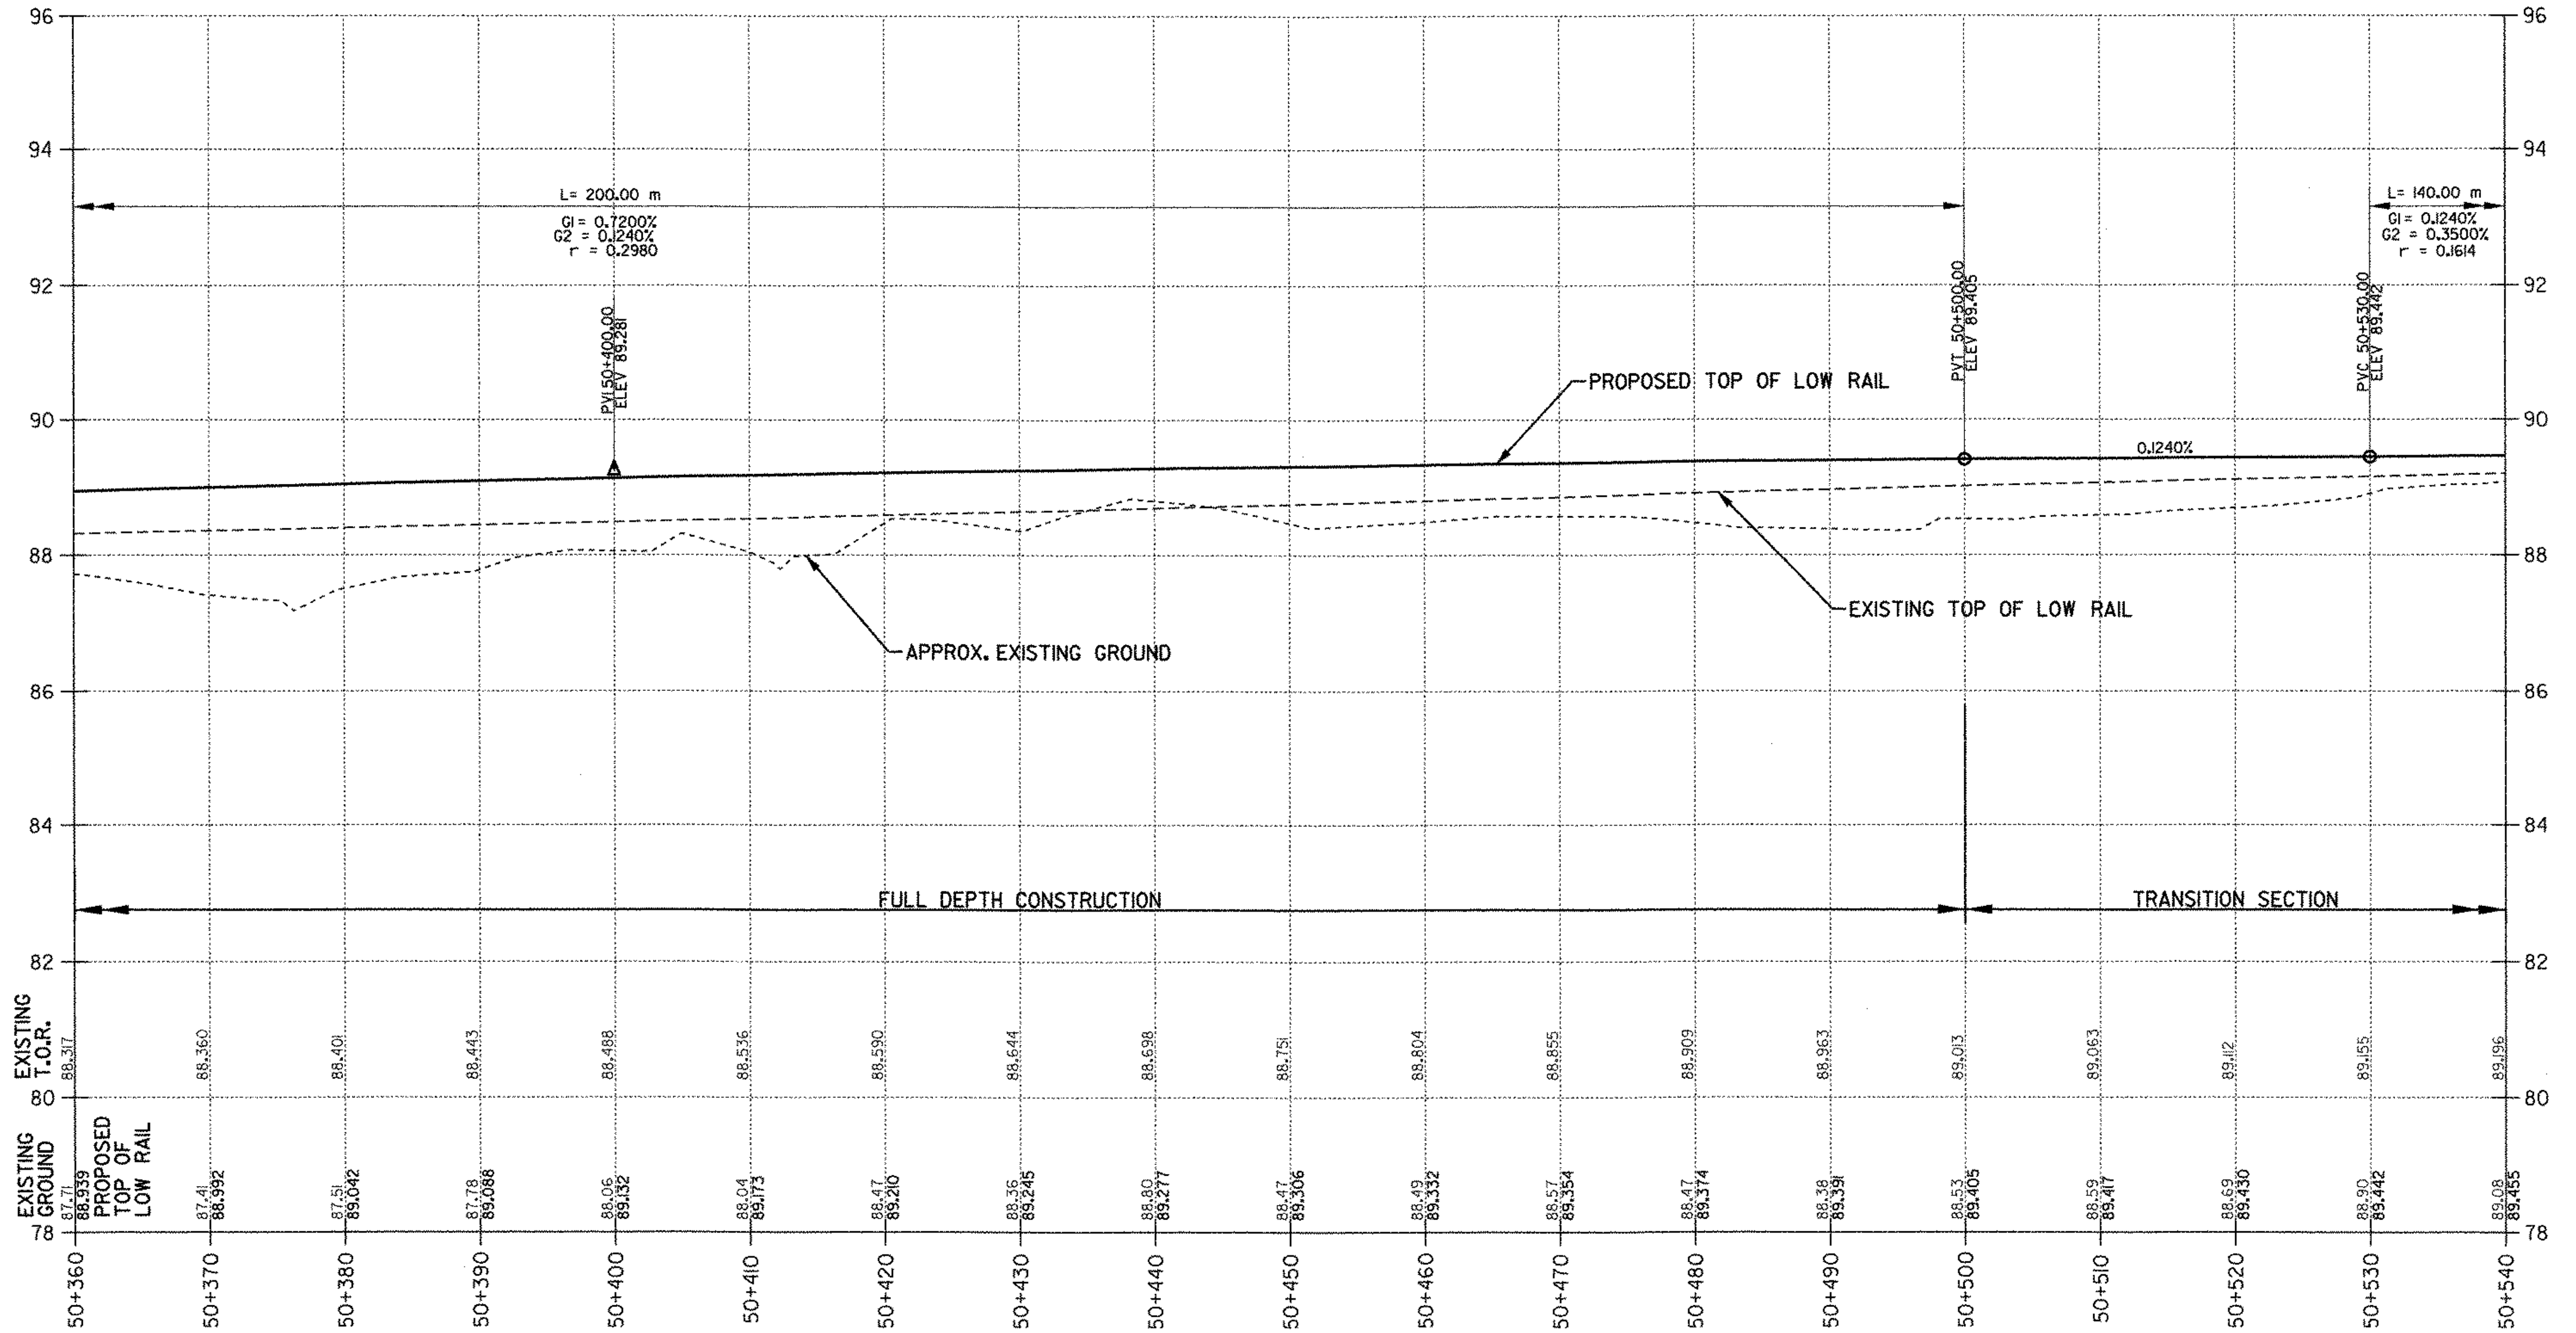

FEB 05 2003

DATUM
 VERTICAL _____
 HORIZONTAL _____

SURVEYED BY N/A DATE N/A
 DRAWN BY LB/LRD DATE _____
 SQUAD LEADER JHR
 DESIGN FILE NO. 95b270\structures\eb270xsl.dgn
 PARM FILE eb270rpp3.i DATE PLOTTED 09-MAR-2001
BRATTLEBORO
NH BR F 012-(K33)
 R.O.W. SHEET 9 OF 27 SHEETS

218 Row