


# RAILROAD PROFILE

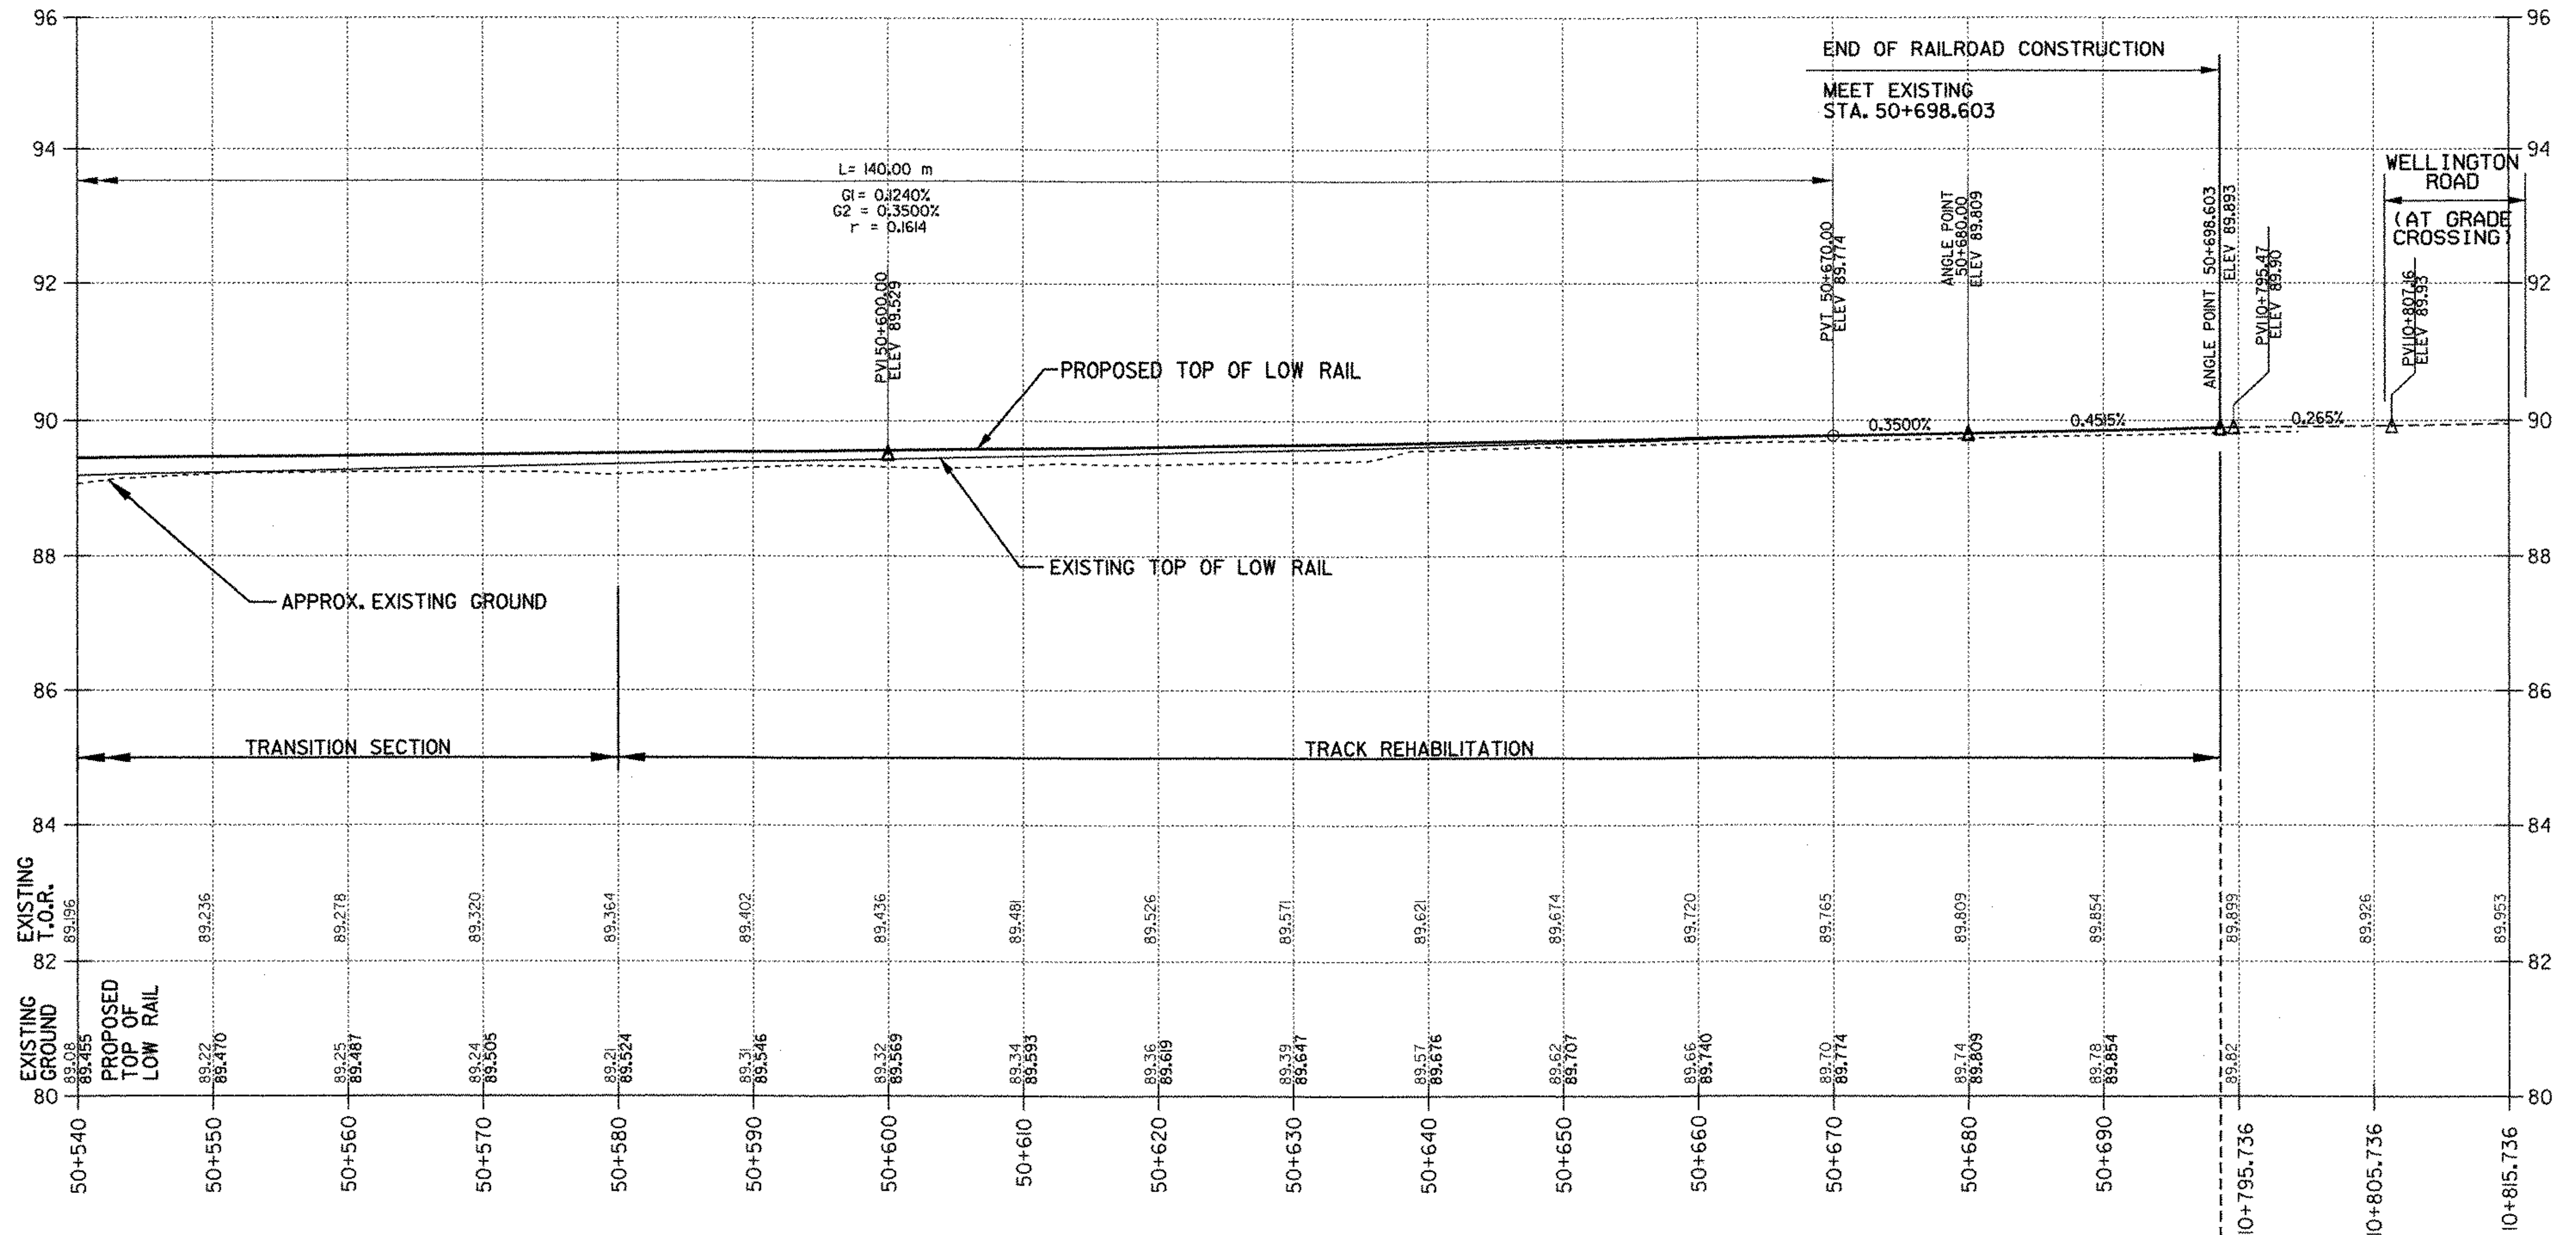

STA. 50+698.603 PROP. RR MAINLINE RELOCATION  
 STA. 10+794.364 EXISTING RR MAINLINE

DATUM  
 VERTICAL \_\_\_\_\_  
 HORIZONTAL \_\_\_\_\_

SURVEYED BY N/A DATE N/A  
 DRAWN BY LB/LRD DATE \_\_\_\_\_  
 SQUAD LEADER JHR  
 DESIGN FILE NO. 95b270\structure\sb270\sl.dgn  
 PARM FILE sb270\rrp4.l DATE PLOTTED 09-MAR-2001

FEB 05 2003

BRATTLEBORO  
 NH BR F 012-1(33)  
 R.O.W. SHEET 10 OF 27 SHEETS

219 ROW