


STATE OF VERMONT AGENCY OF TRANSPORTATION



PROPOSED IMPROVEMENT TOWN OF BRATTLEBORO COUNTY OF WINDHAM VT ROUTE 9 (PRINCIPAL ARTERIAL) RR BRIDGE #62.56

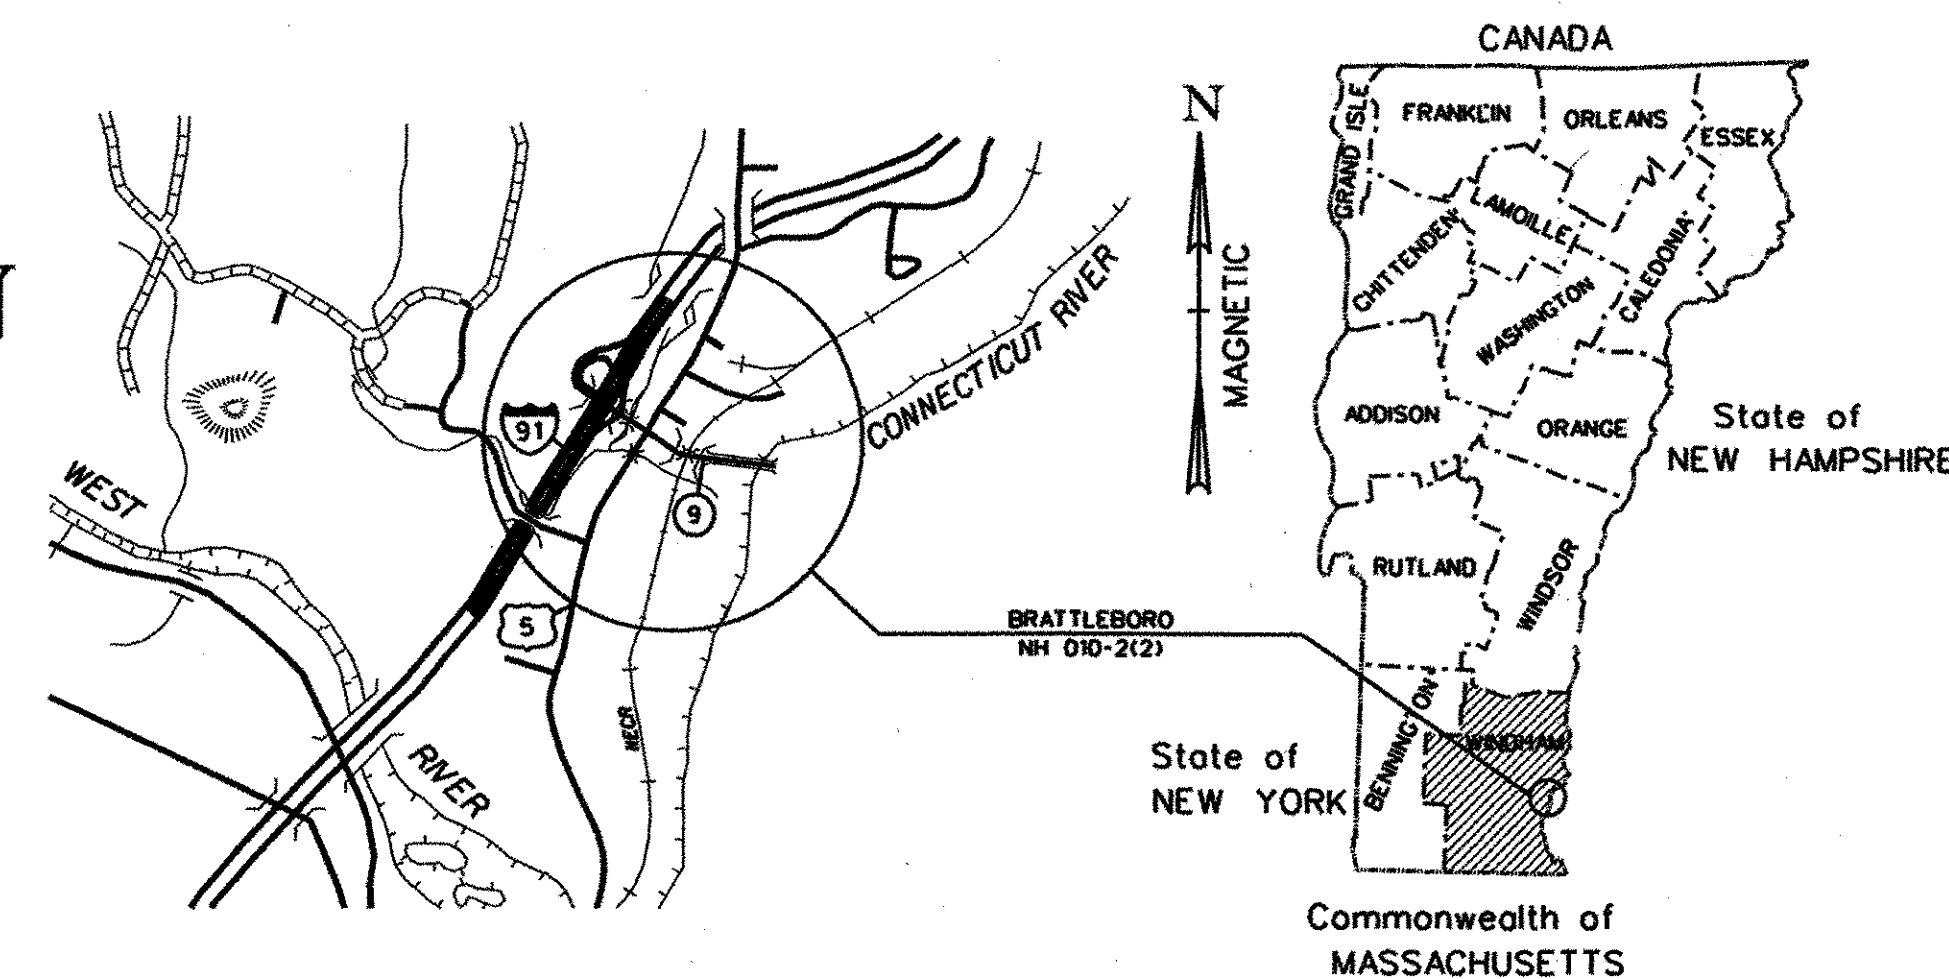

BEGINNING AT A POINT IN THE TOWN OF BRATTLEBORO APPROXIMATELY 85 METERS FROM THE INTERSECTION OF VT ROUTES 5 AND 9, EXTENDING EASTERLY ALONG ROUTE 9 TO THE CONNECTICUT RIVER A DISTANCE OF 270 METERS.

LENGTH OF ROADWAY = 270.00m
 LENGTH OF RAILWAY = 678.6m
 LENGTH OF VT ROUTE 9 BRIDGE = 32m
 LENGTH OF SARGENT BROOK BRIDGE = 8m
 LENGTH OF PROJECT = 973.53m


WORK TO BE PERFORMED UNDER THIS PROJECT CONSISTS OF REALIGNING AND WIDENING ROUTE 9, THE REPLACEMENT OF EXISTING RAILROAD BRIDGE #62.56 OVER VT ROUTE 9, THE WIDENING OF EXISTING RAILROAD BRIDGE #62.51 OVER SARGENT BROOK, AND THE ASSOCIATED SUBGRADE RAILWAY APPROACH WORK. RAILROAD SUBBALLAST, BALLAST, AND TRACK REHABILITATION AND CONSTRUCTION WILL BE PERFORMED BY OTHERS UNDER A RAILROAD FORCE ACCOUNT.

RECORD PLANS	
CONTRACTOR:	J. A. MCDONALD, INC. - LYNDON CTR., VT
RESIDENT ENGINEER:	DARREL BASSETT
CONSTRUCTION BEGAN:	MARCH 3, 2003
CONSTRUCTION COMPLETE:	NOVEMBER 8, 2004
RECORD PLANS BY:	D. BASSETT & E. FOSTER

I HEREBY CERTIFY THAT ALL THE CONSTRUCTION REQUIRED BY THIS SET OF DRAWINGS HAS BEEN ACCOMPLISHED AS INDICATED HEREIN.

BY *Darrel Bassett* RESIDENT ENGINEER
 DATE April 3, 2006

NOTE: Any further information concerning final quantities, amounts or other details relative to this project may be found at Central Files in the electronic archives.


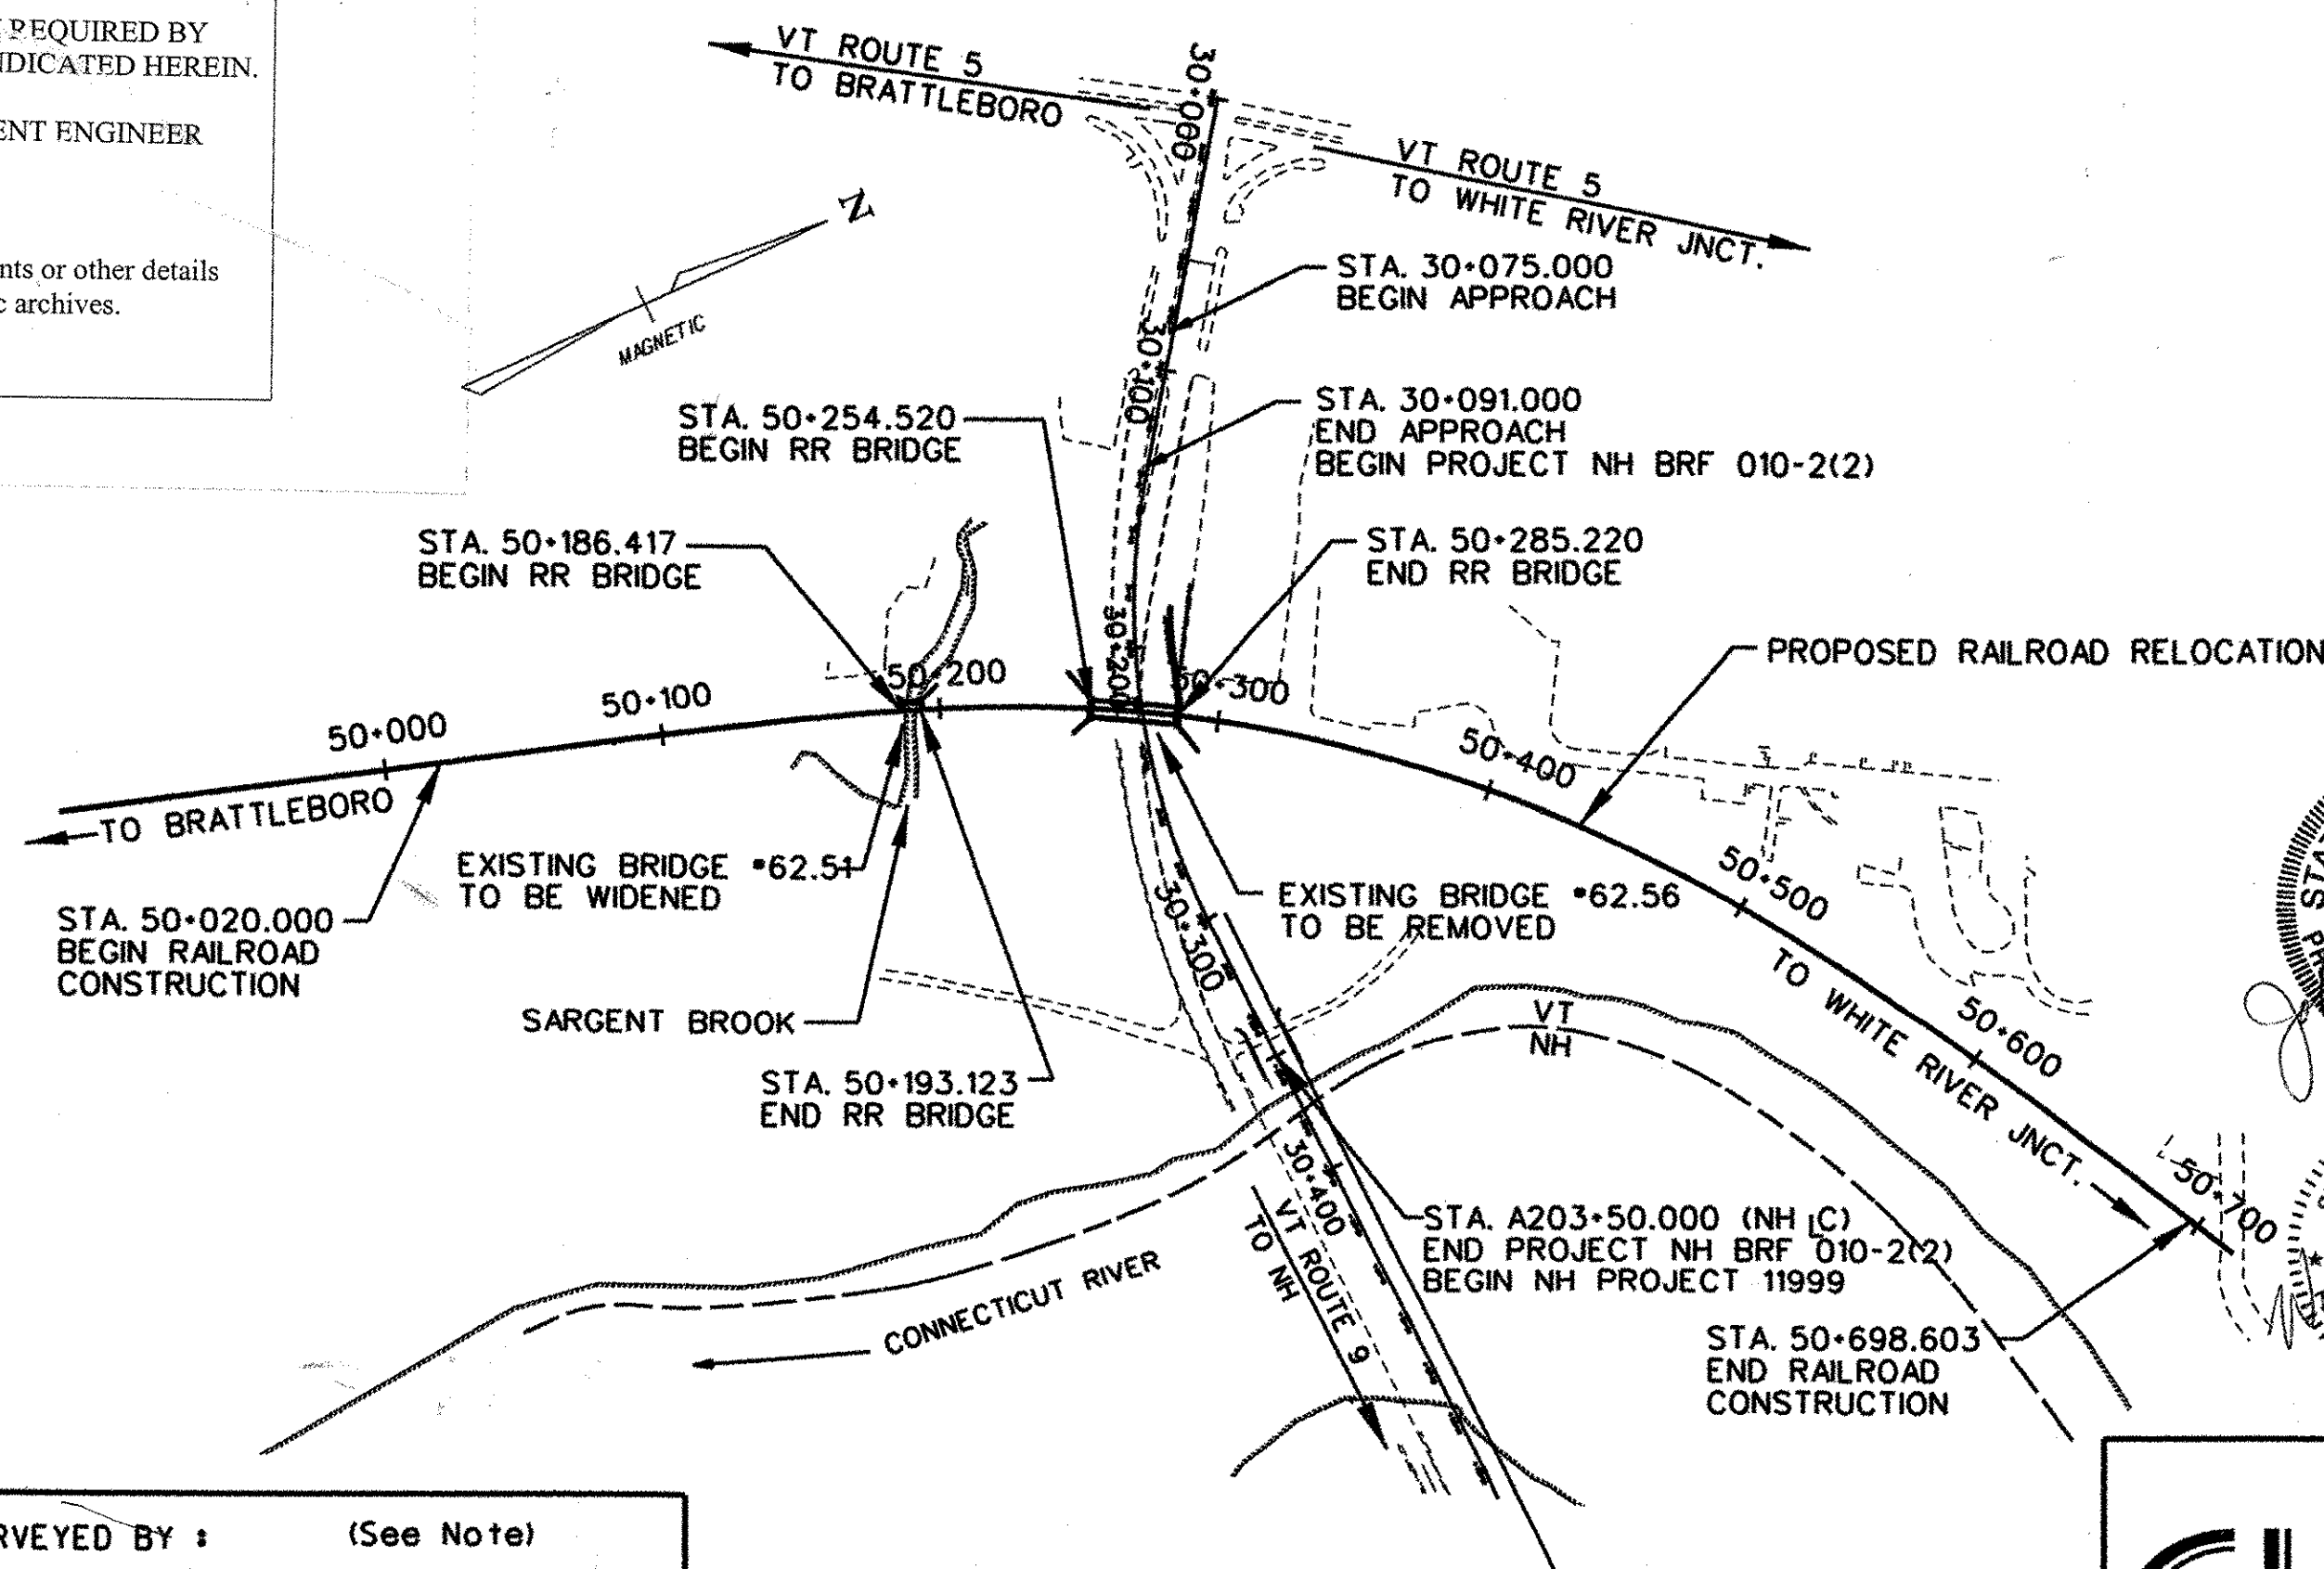


TRAFFIC DATA	
VEHICLE:	RAILROAD:
2000 ADT = 15,000	1998 ADT FREIGHT = 6 TRAINS
2020 ADT = 19,200	V = 64 KmH (40 MPH)
2020 DHV = 1,925	1998 ADT PASSENGER = 2 TRAINS
2020 ADTT = 1,555	Vexist = 95 KmH (59 MPH)
2020 %T = 4%	Vdesign = 88 KmH (55 MPH)
POSTED SPEED = 40 KmH (25MPH)	
DESIGN SPEED = 60 KmH (35 MPH)	
20 yr 18-KIP ESAL'S = 13,836,000	
40 yr 18-KIP ESAL'S = 45,693,000	
BITUMINOUS CONCRETE PAVEMENT SUPERPAVE MIXTURE DESIGN CRITERIA	
DESIGN LANE / DESIGN FILE ESAL	8,301,600
DESIGN NUMBER OF GYRATIONS	75
PERFORMANCE GRADED ASPHALT BINDER	PC 70-28

CONVENTIONAL SYMBOLS	
COUNTY LINE	
TOWN LINE	
LIMITS OF ACCESS	
POINT OF ACCESS	
FENCE LINE	
STONE WALL	
TRAVELED WAY	
GUARD RAIL	
RAILROAD	
SURVEY LINE	
CULVERT	
POWER POLE	
TELEPHONE POLE	
TREES	
CONTROL OF ACCESS	
PROPERTY LINE	
R.O.W. TAKING LINE	
SLOPE RIGHTS	
TOP OF CUT	
TOE OF SLOPE	

SURVEYED BY :	(See Note)
SURVEYED DATE :	(See Note)
DATUM	
VERTICAL	NGVD 1929
HORIZONTAL	NAD 1983

SURVEY INFORMATION OBTAINED BY NHDOT, ELECTRONICALLY TRANSLATED FROM MOSS TO MICROSTATION, AND SUPPLEMENTED BY VTRANS ADDITIONAL SURVEY.

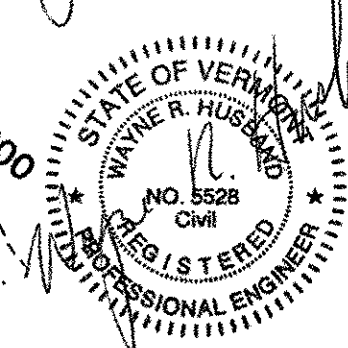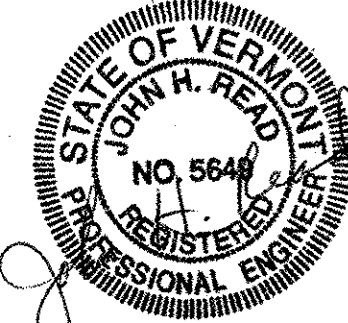

CONSULTING ENGINEERS

540 Commercial Street, Manchester, NH 03101
 603-668-9223 Fax: 603-668-4902
 email: gbr@gbread.com www.gbread.com
 50m New Hampshire Vermont

GORDON, BUA & READ, INC.
 A DIVISION OF TRANSYSTEMS CORPORATION
 34 SALEM STREET
 READING, MASSACHUSETTS 01867

THESE PLANS ARE SUBJECT TO SUCH ENGINEERING CHANGES AS MAY BE REQUIRED BY THE FEDERAL HIGHWAY ADMINISTRATION OR THE DIRECTOR OF PROJECT DEVELOPMENT.
 CONSTRUCTION IS TO BE CARRIED ON IN ACCORDANCE WITH THESE PLANS AND THE STANDARD SPECIFICATIONS FOR CONSTRUCTION DATED 2001, AS APPROVED BY THE FEDERAL HIGHWAY ADMINISTRATION ON JANUARY 4, 2001 FOR USE ON THIS PROJECT, INCLUDING ALL SUBSEQUENT REVISIONS AND SUCH REVISED SPECIFICATIONS AND SPECIAL PROVISIONS AS ARE INCORPORATED IN THESE PLANS.

Metric
 UNLESS NOTED OTHERWISE
 STATIONS ARE IN KILOMETERS
 ELEVATIONS ARE IN METERS
 DIMENSIONS ARE IN MILLIMETERS

DIRECTOR OF PROJECT DEVELOPMENT	
APPROVED <i>[Signature]</i> DATE <u>10/17/02</u>	
PROJECT MANAGER :	A. PORTALUPI
PROJECT NAME :	BRATTLEBORO
PROJECT NUMBER :	NH 010-2(2)
SHEET 1 OF 145 SHEETS	

STANDARDS LIST

A-60M	Typical for Slopes in Solid Rock	6/13/97
B-5M	Slope Grading, Ebankments	6/13/97
B-11M	Methods of Slope Stabilization	6/13/97
B-71M	Residential & Commercial Drives	6/13/97
C-1M	Vertical Granite Curb	6/13/97
C-2AM	Portland Cement Concrete Sidewalk	6/13/97
C-3M	Sidewalk Ramps	6/13/97
D-2M	Underdrain & Carrier Pipe Details	6/13/97
D-3M	Treated Gutters	6/13/97
D-4M	Flushing Basins, Pipe Elbows	6/13/97
D-11M	Cast Iron Gate Type A	6/13/97
D-15M	Precast R.C. CB W/ Cast Iron Gate W/Frame, Type D & E	6/13/97
E-100M	Construction Approach Signs	6/13/97
E-100AM	Side Road Construction Approach Signs	6/13/97
E-101M	Construction Sign Details	6/13/97
E-102M	Construction Sign Details	6/13/97
E-102AM	Construction Sign Details	6/13/97
E-103M	Traffic Control Details	9/24/98
E-106M	Traffic Control Details	6/13/97
E-107AM	Breakaway Barricade Details	6/13/97
E-108M	Construction Zone Longitudinal Drop Offs	6/13/97
E-121M	Standard Sign Placement	6/13/97
E-123M	Guide Sign Placement-Miscellaneous Details	6/13/97
E-125M	Travel Information Signs	6/13/97
E-141M	Regulatory Sign Details	6/13/97
E-142M	Regulatory Sign Details	6/13/97
E-143M	Regulatory Sign Details	6/13/97
E-151M	Warning Sign Details	6/13/97
E-160M	Flanged Channel Steel Sign Post	6/13/97
E-163M	Tubular Steel Sign Post	6/13/97
E-191M	Pavement Marking Details	6/13/97
E-192M	Pavement Marking Details	12/28/98
E-193M	Pavement Marking Details	6/13/97
F-2M	Drive Gate for Chain Link Fence	6/13/97
G-1M	Steel Beam Guardrail	6/13/97
G-1dM	Anchor for Steel Beam Guardrail	1/3/00
G-4M	Plank Rail & Yielding Marker Posts	6/13/97
G-19M	Generic Grading Plans for Guardrail End Terminals	10/21/98
T-1M	Temporary Erosion Control Details	6/13/97
T-2M	Temporary Erosion Control Detail	6/13/97



INDEX OF SHEETS

1	TITLE SHEET
2	INDEX SHEET
3	ALIGNMENT PLAN
4	ROUTE 9 - PRELIMINARY INFORMATION SHEET
5	SARGENT BROOK - PRELIMINARY INFORMATION SHEET
6-7	GENERAL NOTES
8-9	TYPICAL ROADWAY SECTIONS
10	TYPICAL RAILROAD SECTIONS
11-11A	MISCELLANEOUS DETAILS
12-12A	BRIDGE APPROACH RAIL
13-18	QUANTITY SHEET
19	ITEM DETAIL SHEET
20	DRAINAGE DETAIL SHEET
21	ROADWAY EARTHWORKS DETAIL SHEET
22	RAILROAD EARTHWORKS DETAIL SHEET
23-28	RIGHT-OF-WAY LAYOUT
29-31	RIGHT-OF-WAY DETAIL SHEET
32	TIE SHEET
33-34	ROADWAY LAYOUT SHEET
35-38	RAILROAD LAYOUT SHEET
39-40	PROFILE - VT ROUTE 9
41	PROFILE - DRIVEWAY
42	BANKING DIAGRAM / TRANSITION DETAIL
43-46	PROFILE - RAILROAD
47-48	ROADWAY DRAINAGE LAYOUT & EROSION CONTROL
49	ROADWAY DRAINAGE - SECTION A-A
50	ROADWAY GRADING PLAN
51-52	PAVEMENT MARKING & SIGNAGE
53	EXCAVATION TYPICAL LIMITS
54-56	TRAFFIC SIGN SUMMARY SHEET
57-58	ROADWAY CONSTRUCTION APPROACH SIGNING SHEET
59	BORING LAYOUT SHEET
60-68	BORING LOG SHEET
69	ROUTE 9 - BRIDGE PLAN & ELEVATION
70	ROUTE 9 - FRAMING PLAN & CONNECTION DETAILS
71	ROUTE 9 - GIRDER ELEVATION, CAMBER & DETAILS
72	ROUTE 9 - KNEEBRACE CONNECTION & DETAILS
73-74	ROUTE 9 - SUPERSTRUCTURE DETAILS
75	ROUTE 9 - BEARING DETAILS
76	ROUTE 9 - SO. ABUTMENT PLAN, ELEVATION & SECTIONS
77	ROUTE 9 - NO. ABUTMENT PLAN, ELEVATION & SECTIONS
78	ROUTE 9 - CONCRETE WINGWALL SECTIONS
79	ROUTE 9 - NORTHWEST M.S.E. WALL PLAN & ELEVATION
80	ROUTE 9 - SUBSTRUCTURE DETAILS
81	ROUTE 9 - SO. ABUTMENT REINFORCING PLAN & ELEVATION
82	ROUTE 9 - NO. ABUTMENT REINFORCING PLAN & ELEVATION
83	INTENTIONALLY LEFT BLANK
84	ROUTE 9 - BRIDGE APPROACH TIMBERS & GUARD RAIL
85-86	ROUTE 9 - CONSTRUCTION STAGING PLAN
87-88	ROUTE 9 - CONSTRUCTION STAGING ELEVATIONS
89	INTENTIONALLY LEFT BLANK
90	SARGENT BROOK - PLAN & ELEVATION
91	SARGENT BROOK - FRAMING PLAN AND BEARING LAYOUT
92	SARGENT BROOK - CONCRETE DECK SLAB
93	SARGENT BROOK - SO. ABUT. PLAN, ELEVATION & DETAILS
94	SARGENT BROOK - NO. ABUT. PLAN, ELEVATION & SECTION
95	SARGENT BROOK - CONSTRUCTION STAGING
96	REINFORCING SCHEDULE - ROUTE 9 BRIDGE
97	REINFORCING SCHEDULE - SARGENT BROOK BRIDGE
98-113	MAIN LINE CROSS SECTIONS
114-115	DRIVE CROSS SECTIONS
116-133	RAILROAD CROSS SECTIONS
134-137	SARGENT BROOK CROSS SECTIONS
138-144	TENSAR MECHANICALLY STABILIZED EARTH WALL DESIGN
145A-G	VERISON UTILITY SHEETS

△ Addendum Two, Excavation Limits Dec 6, 2002


**STATE OF VERMONT
AGENCY OF TRANSPORTATION**

Town Of	BRATTLEBORO	Bridge No.	62.56
Highway No.	VT. ROUTE 9	Log Sta.	
		Surv. Sta.	
BRIDGE NO. 62.56			
INDEX SHEET			
Designed By	Drawn By GJB		
Checked By	JHR	Date	Bridge Design Supervisor
			JHR Date
PROJECT	BRATTLEBORO	PROJECT NO.	NH 010-2(2)
I.G.C. Info.			
Bridge Sheet No.	Sheet 2 of 145		

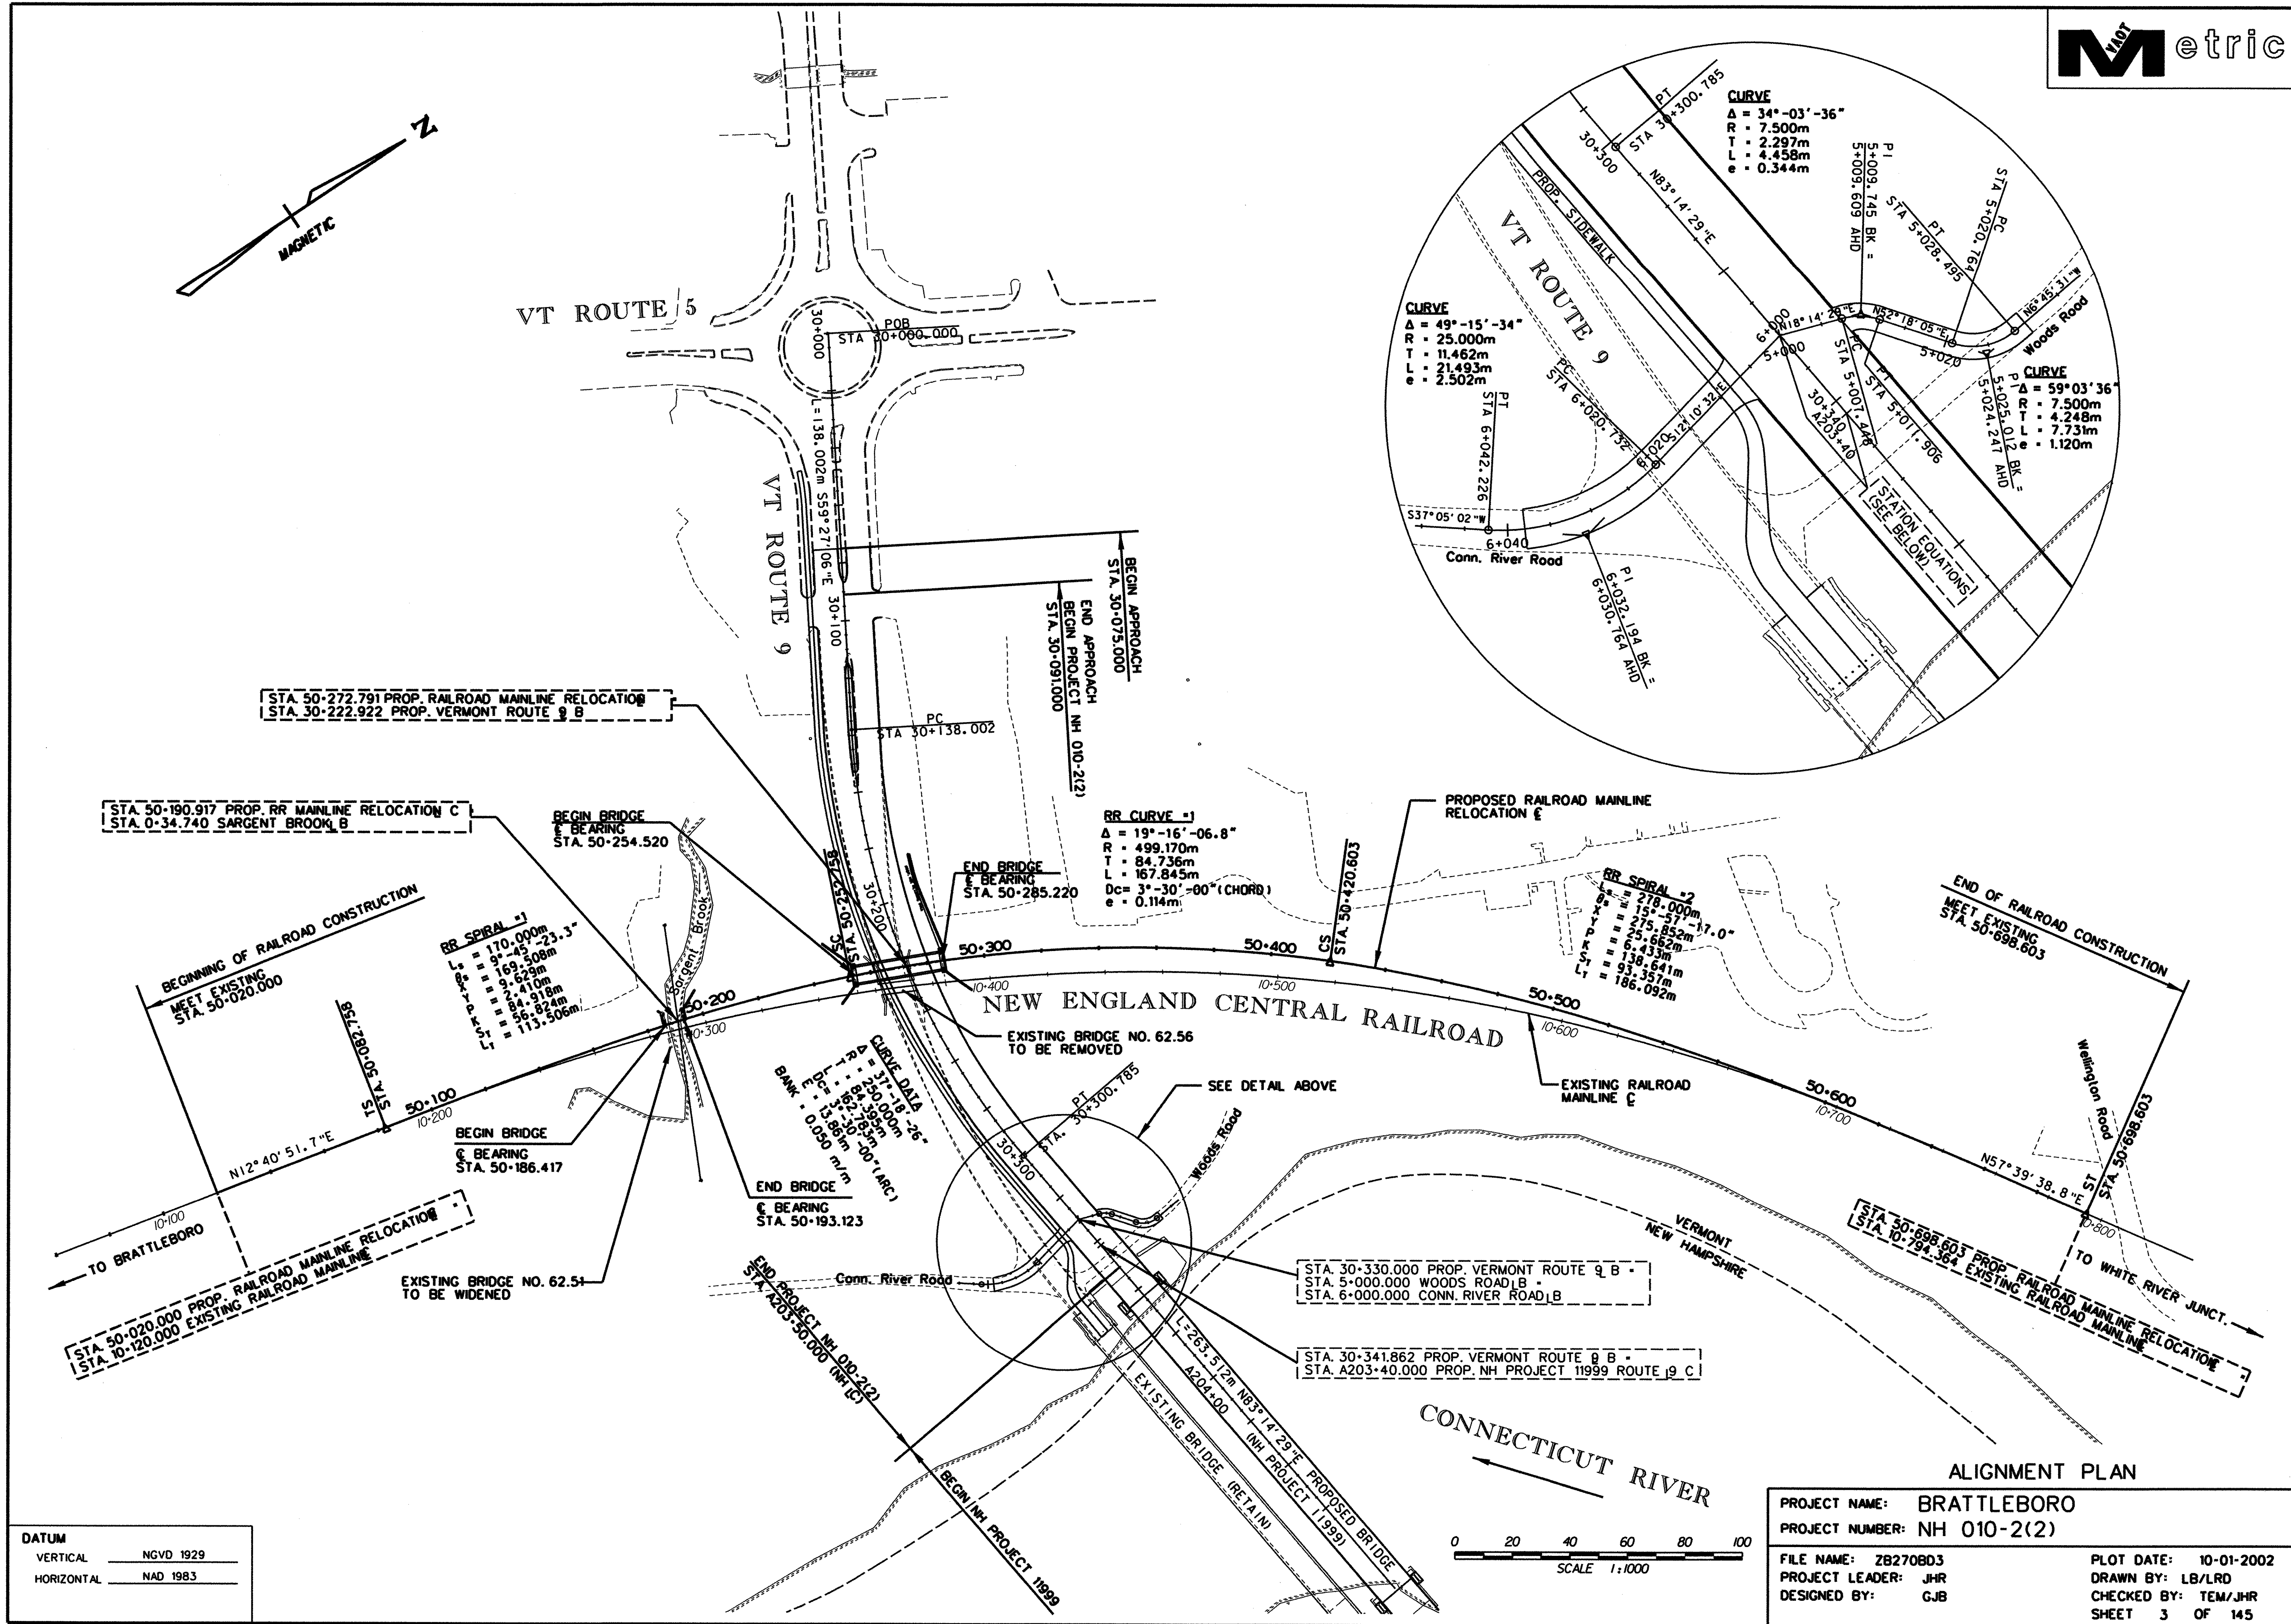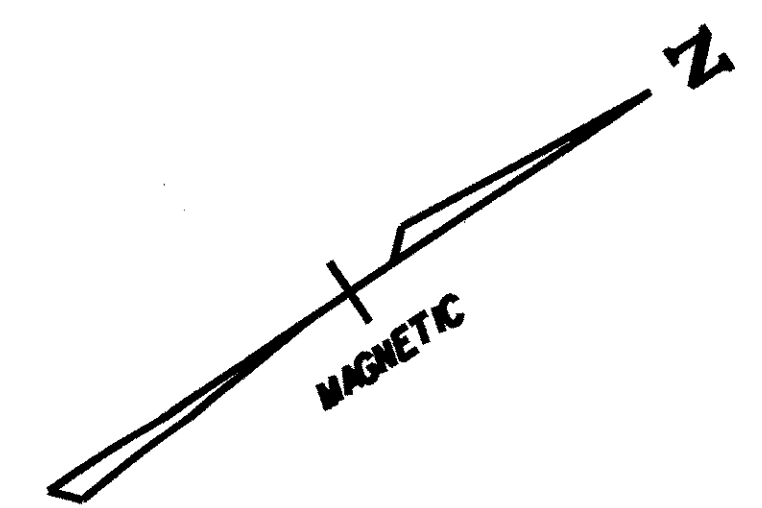


DATUM

VERTICAL	NGVD 1929
HORIZONTAL	NAD 1983

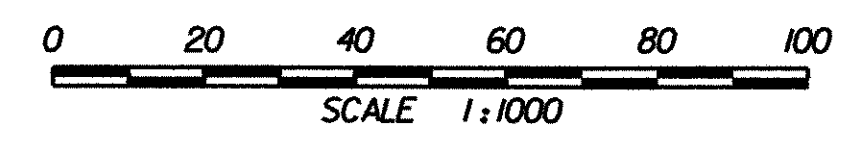


ALIGNMENT PLAN

PROJECT NAME:	BRATTLEBORO
PROJECT NUMBER:	NH 010-2(2)
FILE NAME:	ZB270BD3
PROJECT LEADER:	JHR
DESIGNED BY:	GJB
PLOT DATE:	10-01-2002
DRAWN BY:	LB/LRD
CHECKED BY:	TEM/JHR
SHEET	3 OF 145

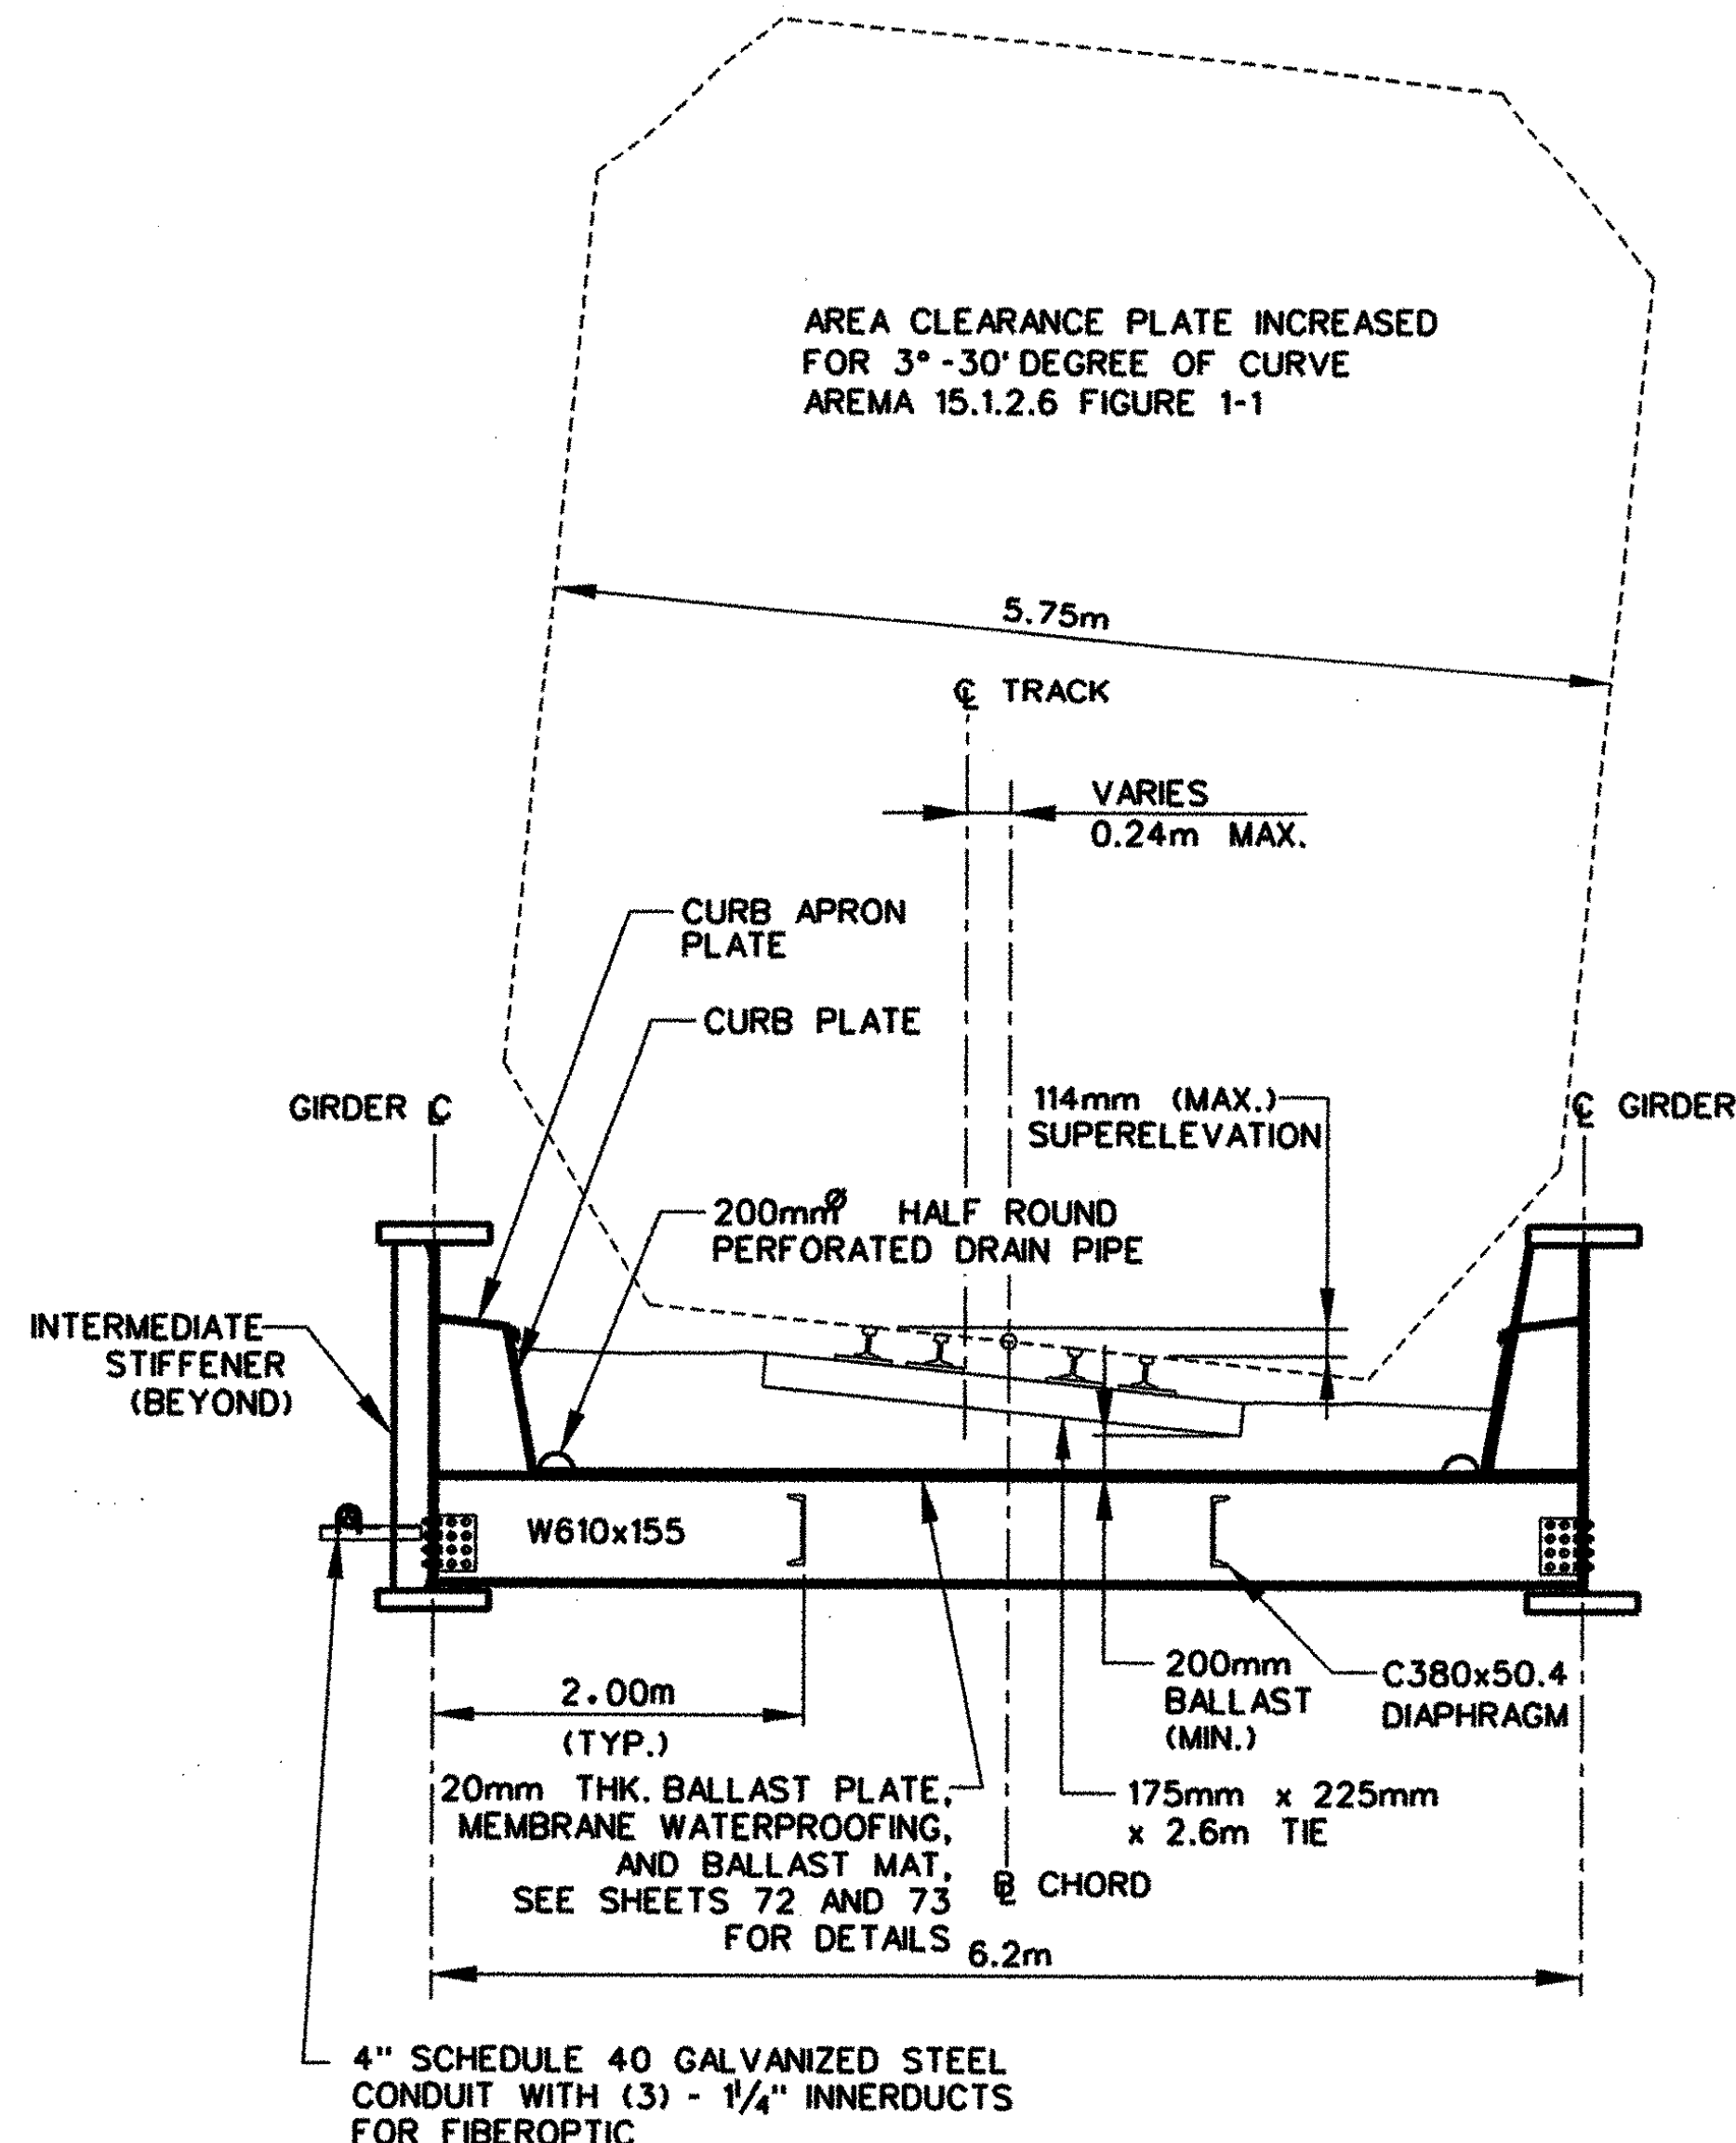

TRANSVERSE BRIDGE SECTION
SCALE 1:40

SEE PAGE 53 FOR EXCAVATION LIMITS
ITEM 203.15 COMMON EXCAVATION
ITEM 204.25 STRUCTURE EXCAVATION, AND
ITEM 529.15 REMOVAL OF STRUCTURE

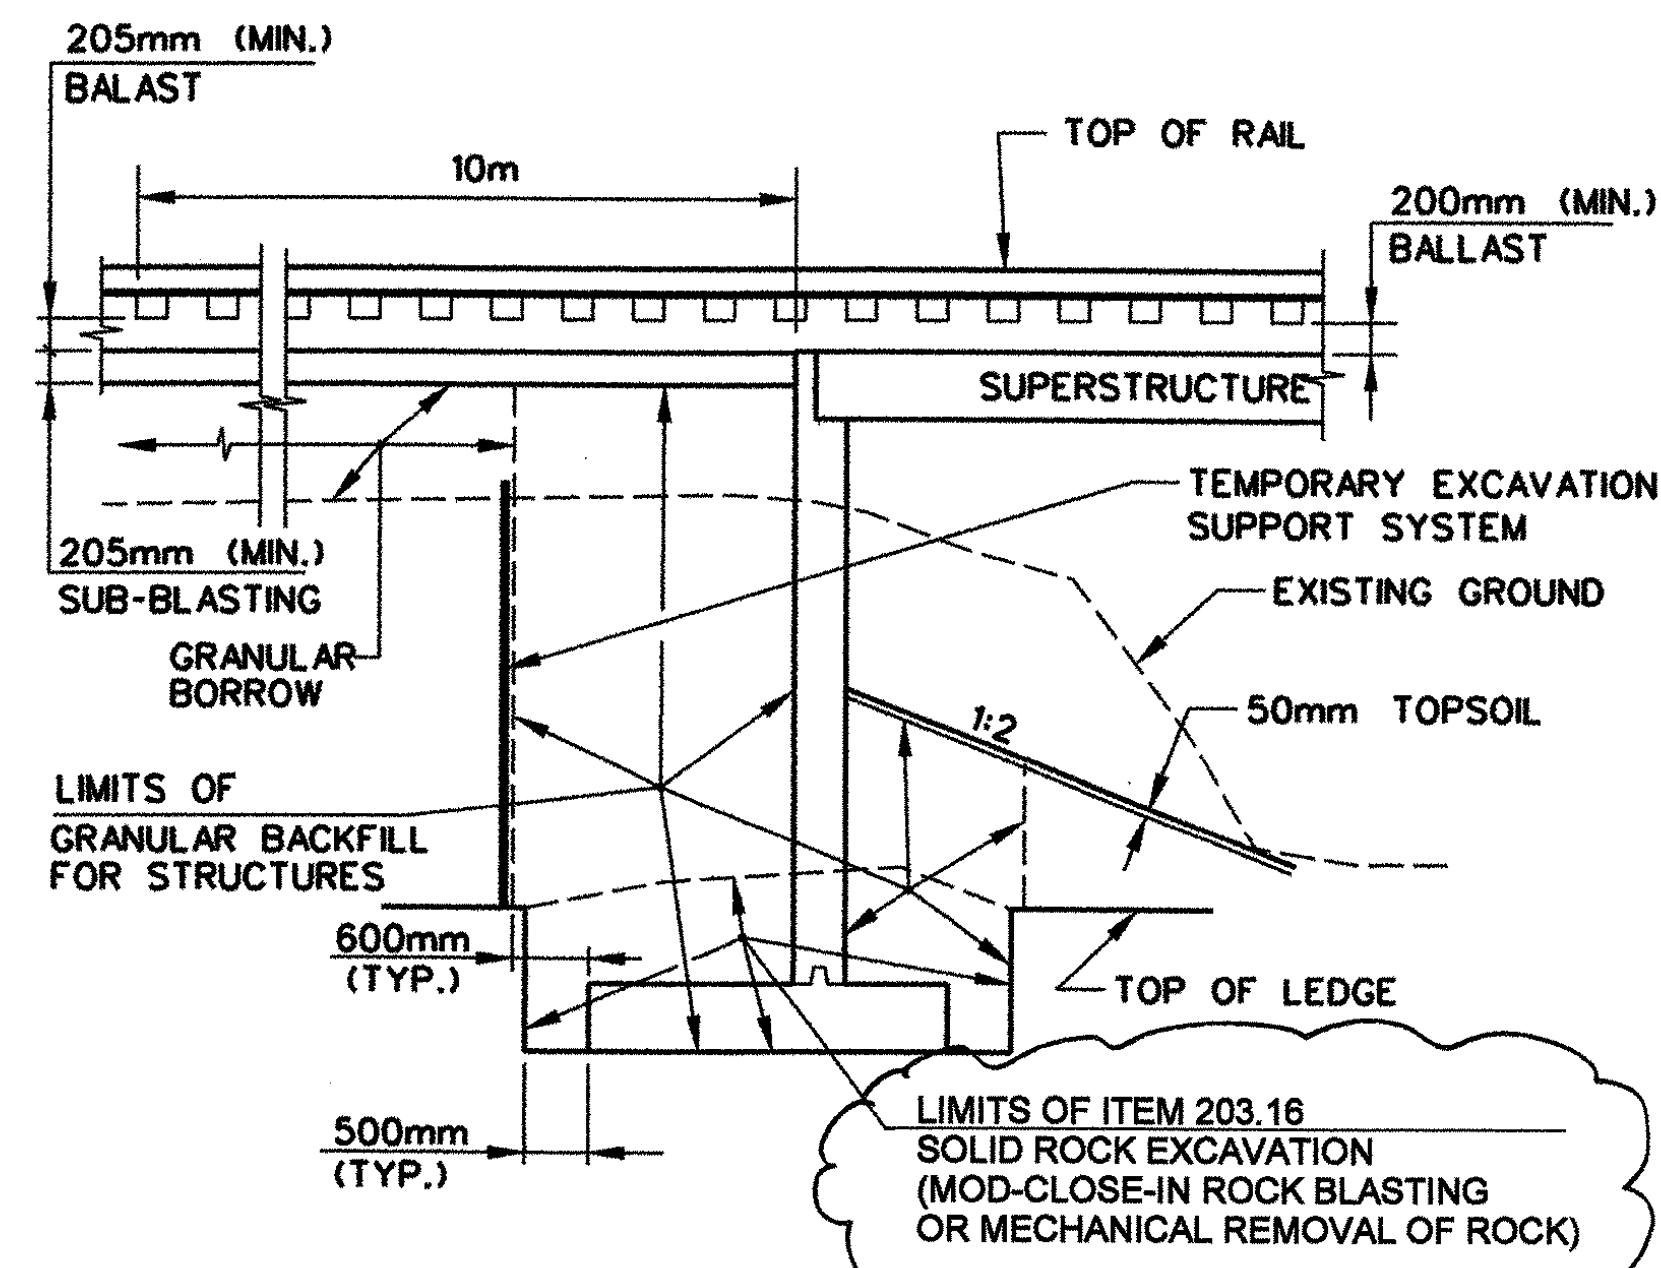

TYPICAL ABUTMENT SECTION
(NOT TO SCALE)

STRESS TABLE		
GIRDER	SPAN 30.7 meters	
	SHEARS (END OF BEAM)	MOMENTS (MIDSPAN)
DL (E80)	871 kN	7,327 kN-m
LL (E80)	1,344 kN	6,585 kN-m
IMP (40X)	537 kN	3,582 kN-m
CENTRIFUGAL	45 kN	34.3 kN-m
TOTAL	2,797 kN	17,837 kN-m

STRESS TABLE		
FLOOR BEAM	SPAN 6.2m	
	SHEARS (END OF BEAM)	MOMENTS (MIDSPAN)
DL (E80)	26.3 kN	41.7 kN-m
LL (E80)	132.6 kN	309.9 kN-m
IMP (15X)	68.0 kN	159.0 kN-m
CENTRIFUGAL	7.0 kN	n/a kN-m
TOTAL	234 kN	510.7 kN-m

PROPERTIES	
A _{web} = 47,625 mm ²	S _{topflange} = 1.323x10 ⁶ mm ³
I _{x(gross)} = 1.394x10 ¹¹ mm ⁴	S _{botflange} = 1.323x10 ⁶ mm ³
I _{x(net)} = 1.384x10 ¹¹ mm ⁴	

PROPERTIES	
A _{web} = 6780 mm ²	S _x = 4.220x10 ⁶ mm ³
I _x = 1.29x10 ⁹ mm ⁴	

STRESS		
SHEAR	BENDING (TENSION IN BOT. FLANGE)	DEFLECTION (LL-D)
f _s = 58,730 kPa	f _b = 164,870 kPa	Δ max = 45 mm
ALL f _s = 120,000 kPa	ALL f _b = 189,000 kPa	ALL Δ = 48 mm
BENDING (COMPRESSION IN TOP FLANGE)		
f _{bc} = 163,580 kPa		
ALL f _{bc} = 187,900 kPa		

STRESS		
SHEAR	BENDING (TENSION IN BOT. FLANGE)	DEFLECTION (LL-D)
f _s = 34,760 kPa	f _b = 153,900 kPa	Δ max = 7 mm
ALL f _s = 120,000 kPa	ALL f _b = 189,000 kPa	ALL Δ = 9 mm
BENDING (COMPRESSION IN TOP FLANGE)		
f _{bc} = 120,870 kPa		
ALL f _{bc} = 162,300 kPa		

FATIGUE (FRACTURE CRITICAL)	
(BASE METAL & WELD METAL FLANGE TO WEB CONNECTION)	BENDING
Max LL, MP (mean) =	79,833 kPa
STRESS RANGE	79,833 kPa
STRESS CATEGORY	B
ALLOW. STRESS RANGE	110,000 kPa


FATIGUE	
(BASE METAL BOT. FLANGE)	BENDING
Max LL, MP (mean) =	151,300 kPa
STRESS RANGE	151,300 kPa
STRESS CATEGORY	A
ALLOW. STRESS RANGE	165,500 kPa

PROPOSED STRUCTURE	
STRUCTURE GEOMETRY:	
1. STRUCTURE TYPE	SINGLE SPAN HALF-THRU GIRDER
2. CLEAR SPAN LENGTH(S)	29.5 meters
3. VERTICAL CLEARANCE ABOVE ROADWAY	4.95 meters
4. ARE PROVISIONS TO BE MADE FOR PUBLIC UTILITIES?	N/A

EXISTING STRUCTURE	
1. STRUCTURE TYPE	SINGLE SPAN STEEL DECK GIRDER YEAR BUILT: 1937
2. CLEAR SPAN (NORMAL TO ROADWAY)	9.9 meters
3. VERTICAL CLEARANCE ABOVE ROADWAY	4.35 meters

DESIGN CRITERIA

- DESIGN LIVE LOAD AREMA COOPERS E80
- DESIGN SPAN TO & BRG. 30.7m
- ALLOWABLE LOAD FOR SPREAD FOOTINGS ON SOIL 70 - 88 kPa ON LEDGE 950 kPa
- ALLOWABLE LOAD FOR PILING N/A TYPE N/A ESTIMATED LENGTH N/A
- ALLOWABLE STRESS FOR STRUCTURAL STEEL AASHTO M270M GR 345 WEATHERING STEEL TENSION 185 MPa
- ALLOWABLE STRESS FOR REINFORCING STEEL AASHTO M31M GRADE 400 TENSION 185 MPa COMPRESSION 138 MPa
- ALLOWABLE STRESS FOR CONCRETE HIGH PERFORMANCE CLASS A f_c 30 MPa f_t N/A

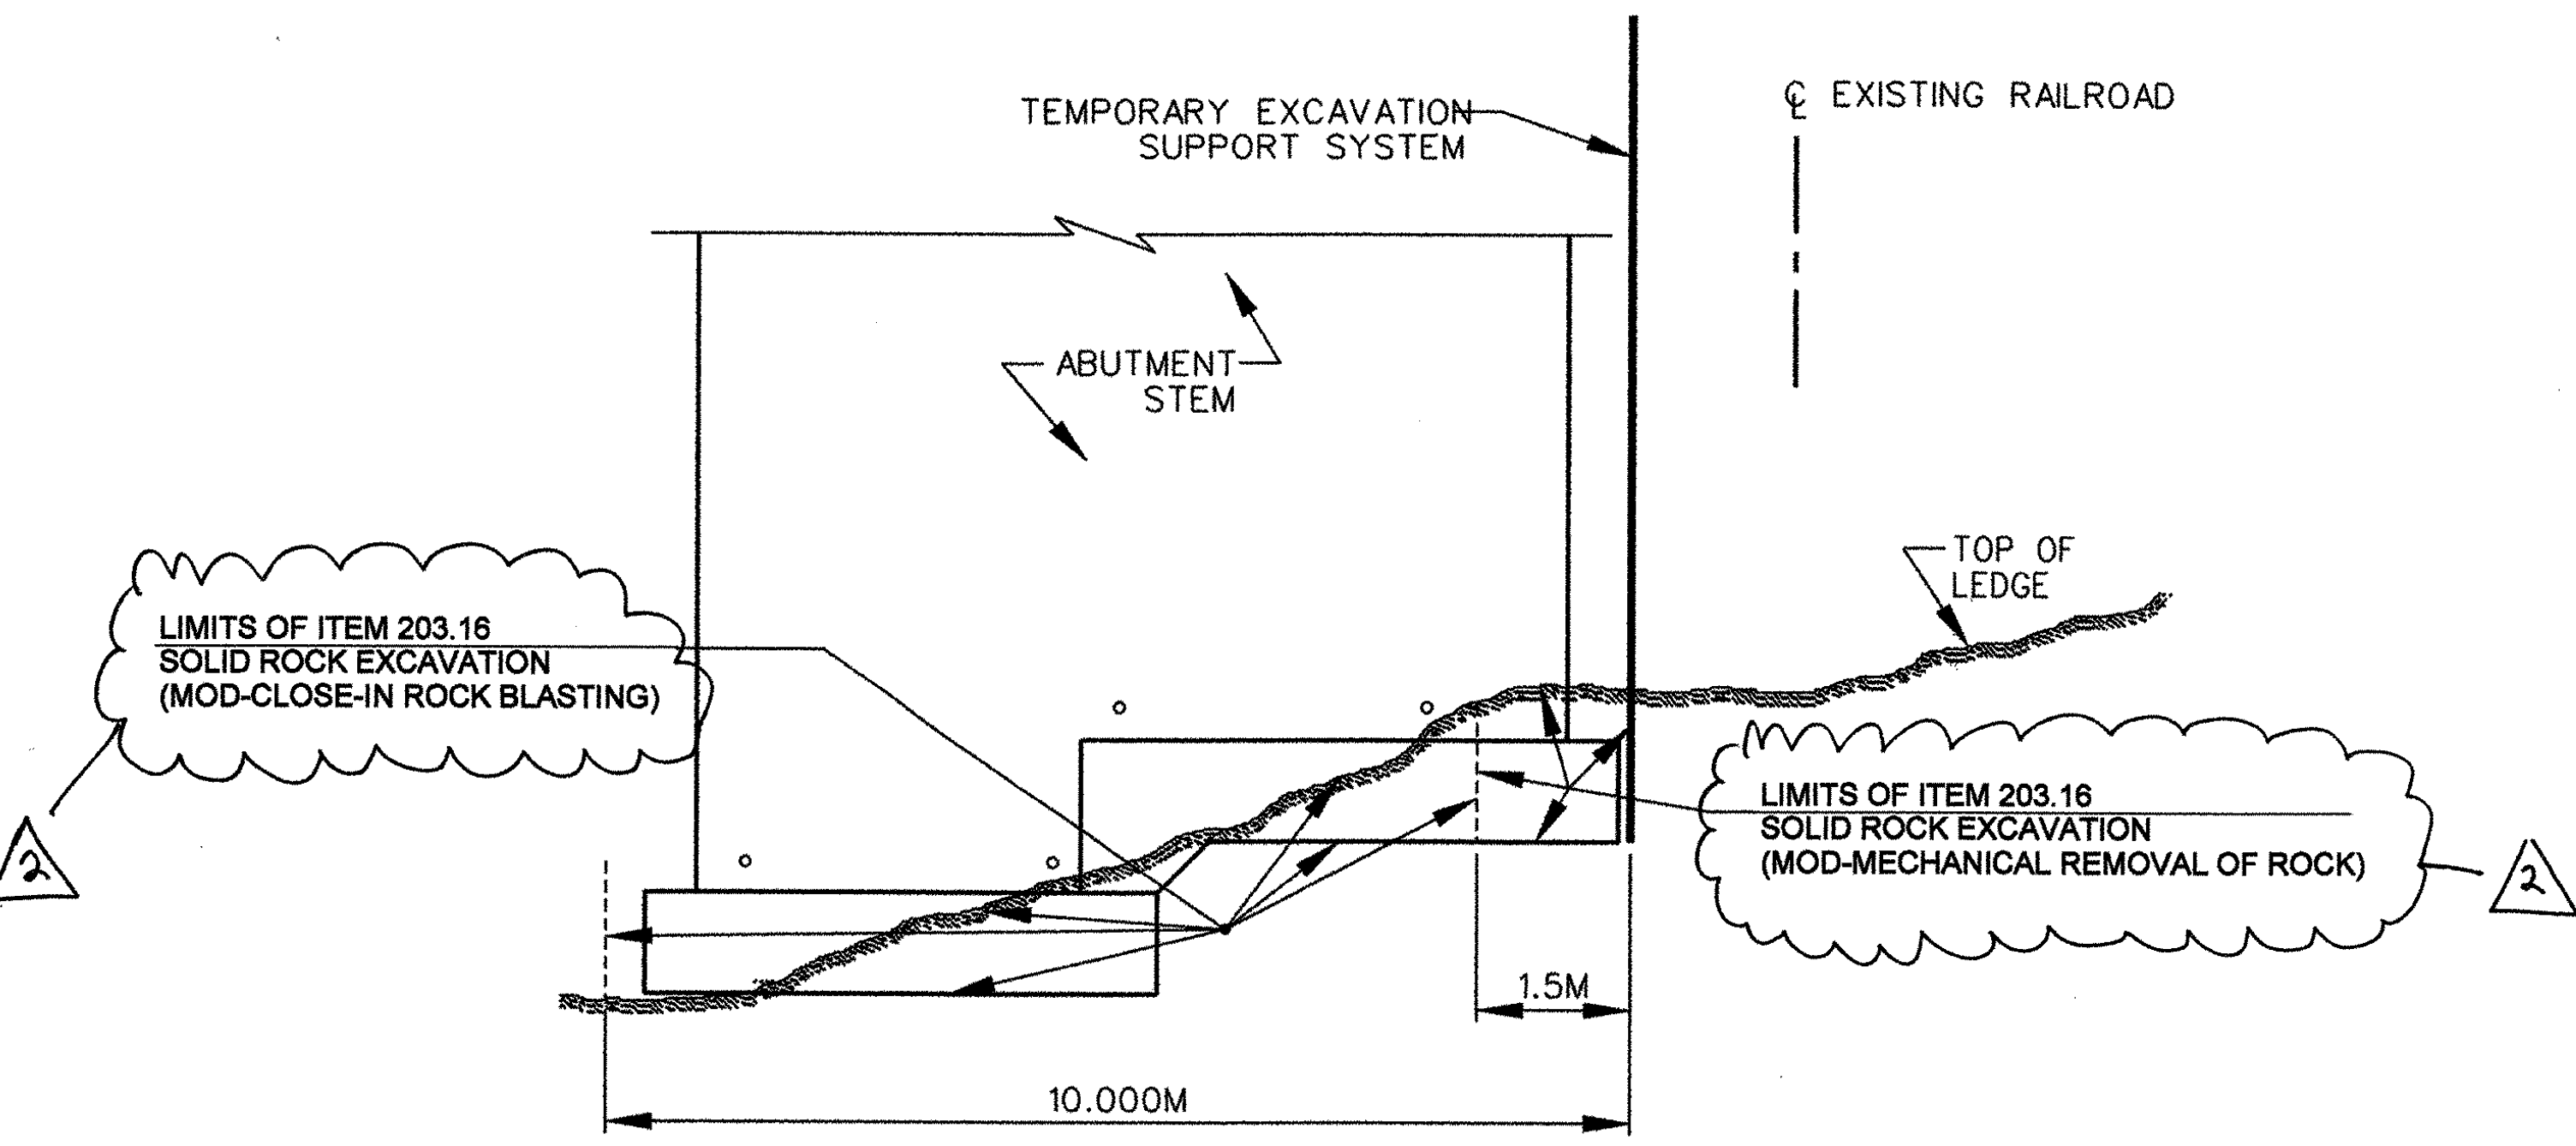

TYPICAL TRANSVERSE ABUTMENT SECTION
(NOT TO SCALE)

△ Addendum two, Excavation notes Dec 6, 2002


Plot Date: 10-10-2002
File: rt9br302

STATE OF VERMONT AGENCY OF TRANSPORTATION

Town Of	BRATTLEBORO	Bridge No.	62.56
Highway No.	VT. ROUTE 9	Log Sta.	
		Surv. Sta.	
NEW ENGLAND CENTRAL RAILROAD OVER VT. ROUTE 9			


PRELIMINARY INFORMATION			
Designed By	LM	Drawn By	DHL/LB
Checked By	GJB	Date	Bridge Design Supervisor
			JHR
PROJECT	BRATTLEBORO	PROJECT NO.	NH 010-2(2)
I.G.C. Info.			
Bridge Sheet No.		Sheet 4	of 145

HYDRAULICS REPORT

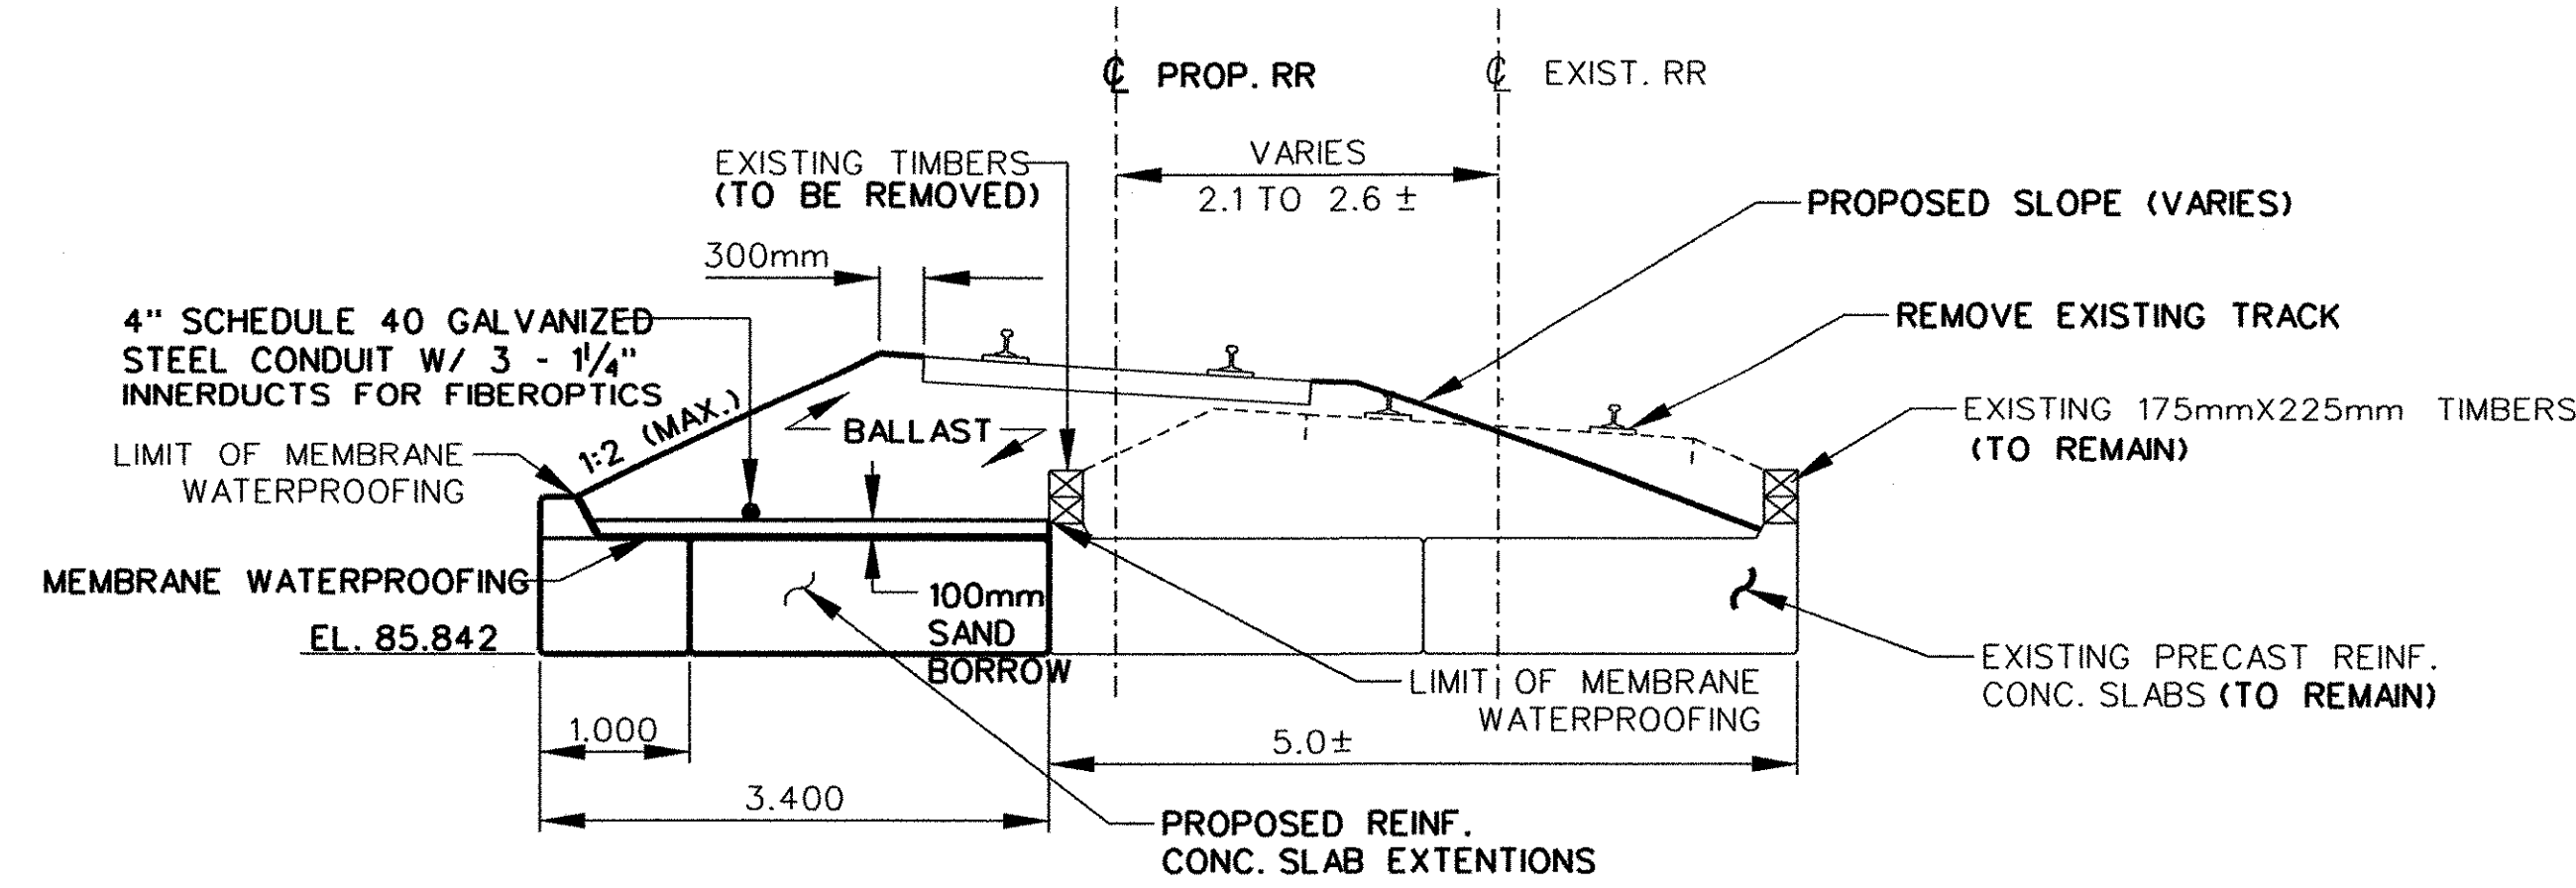


TYPICAL BRIDGE SECTION
SARGENT BROOK

SCALE 1:50

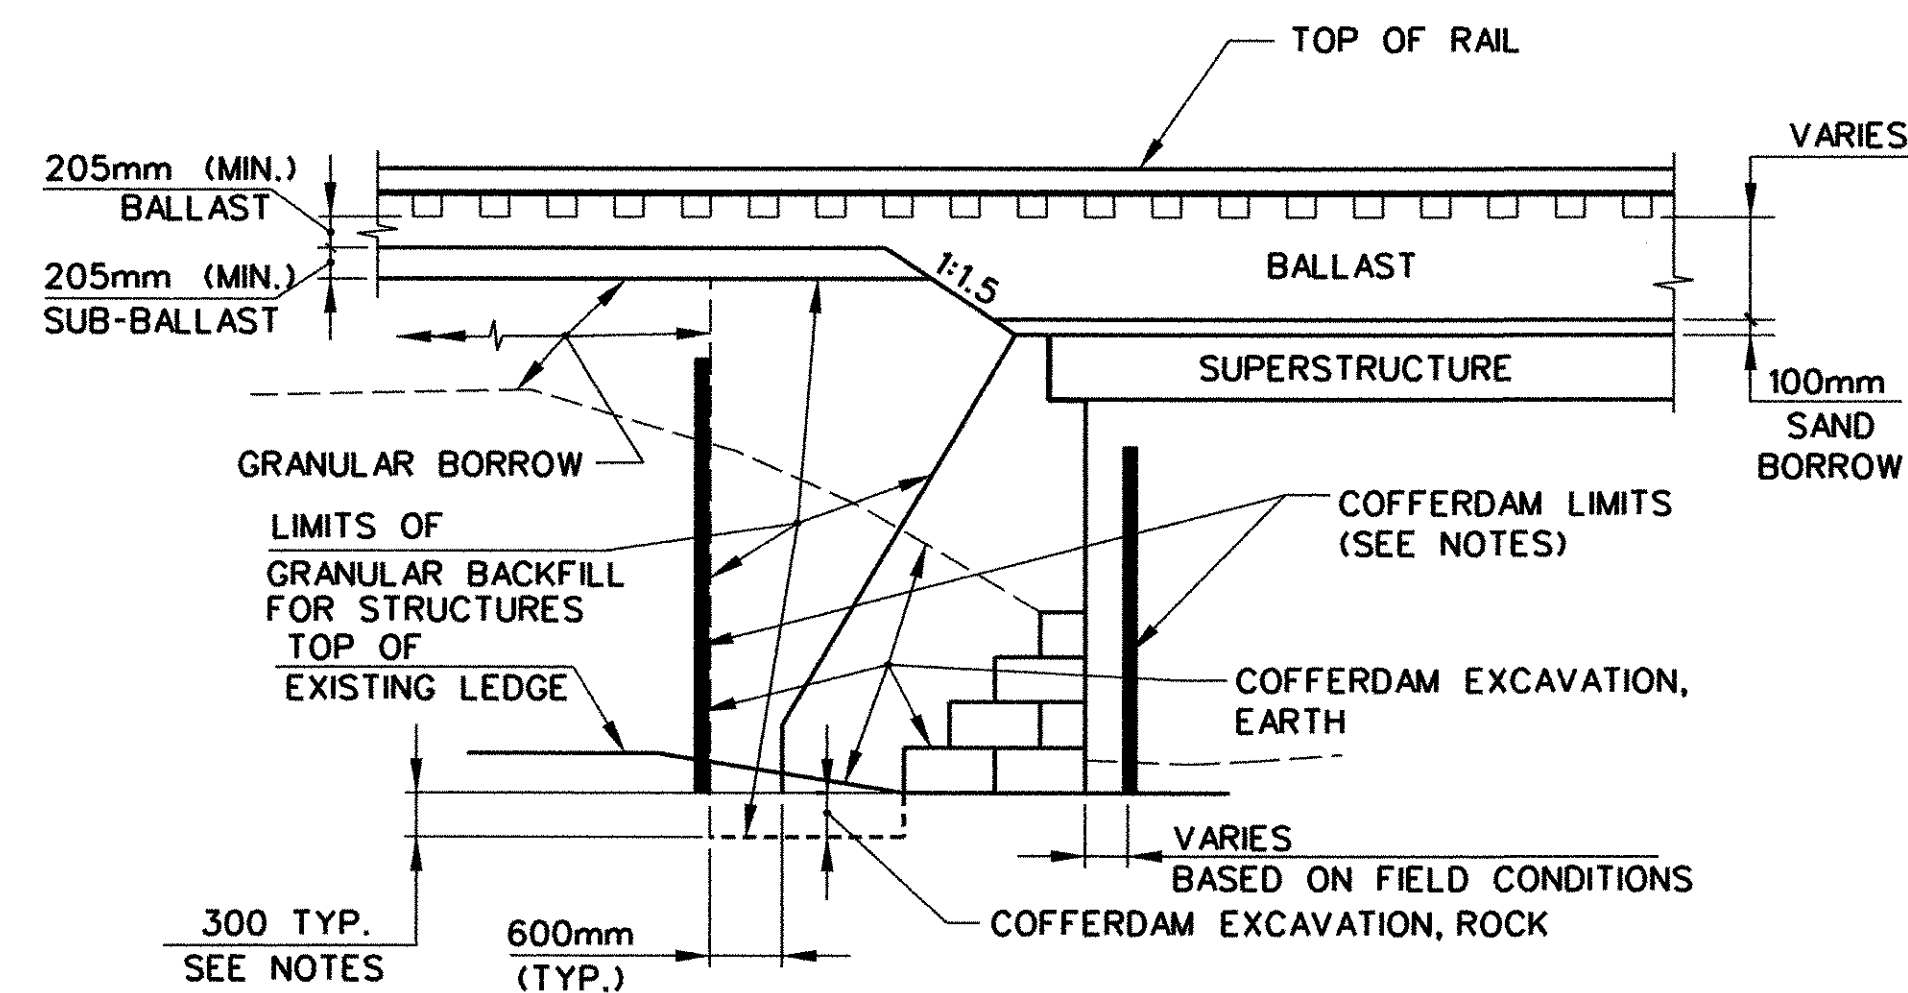

TYPICAL ABUTMENT SECTION

(NOT TO SCALE)

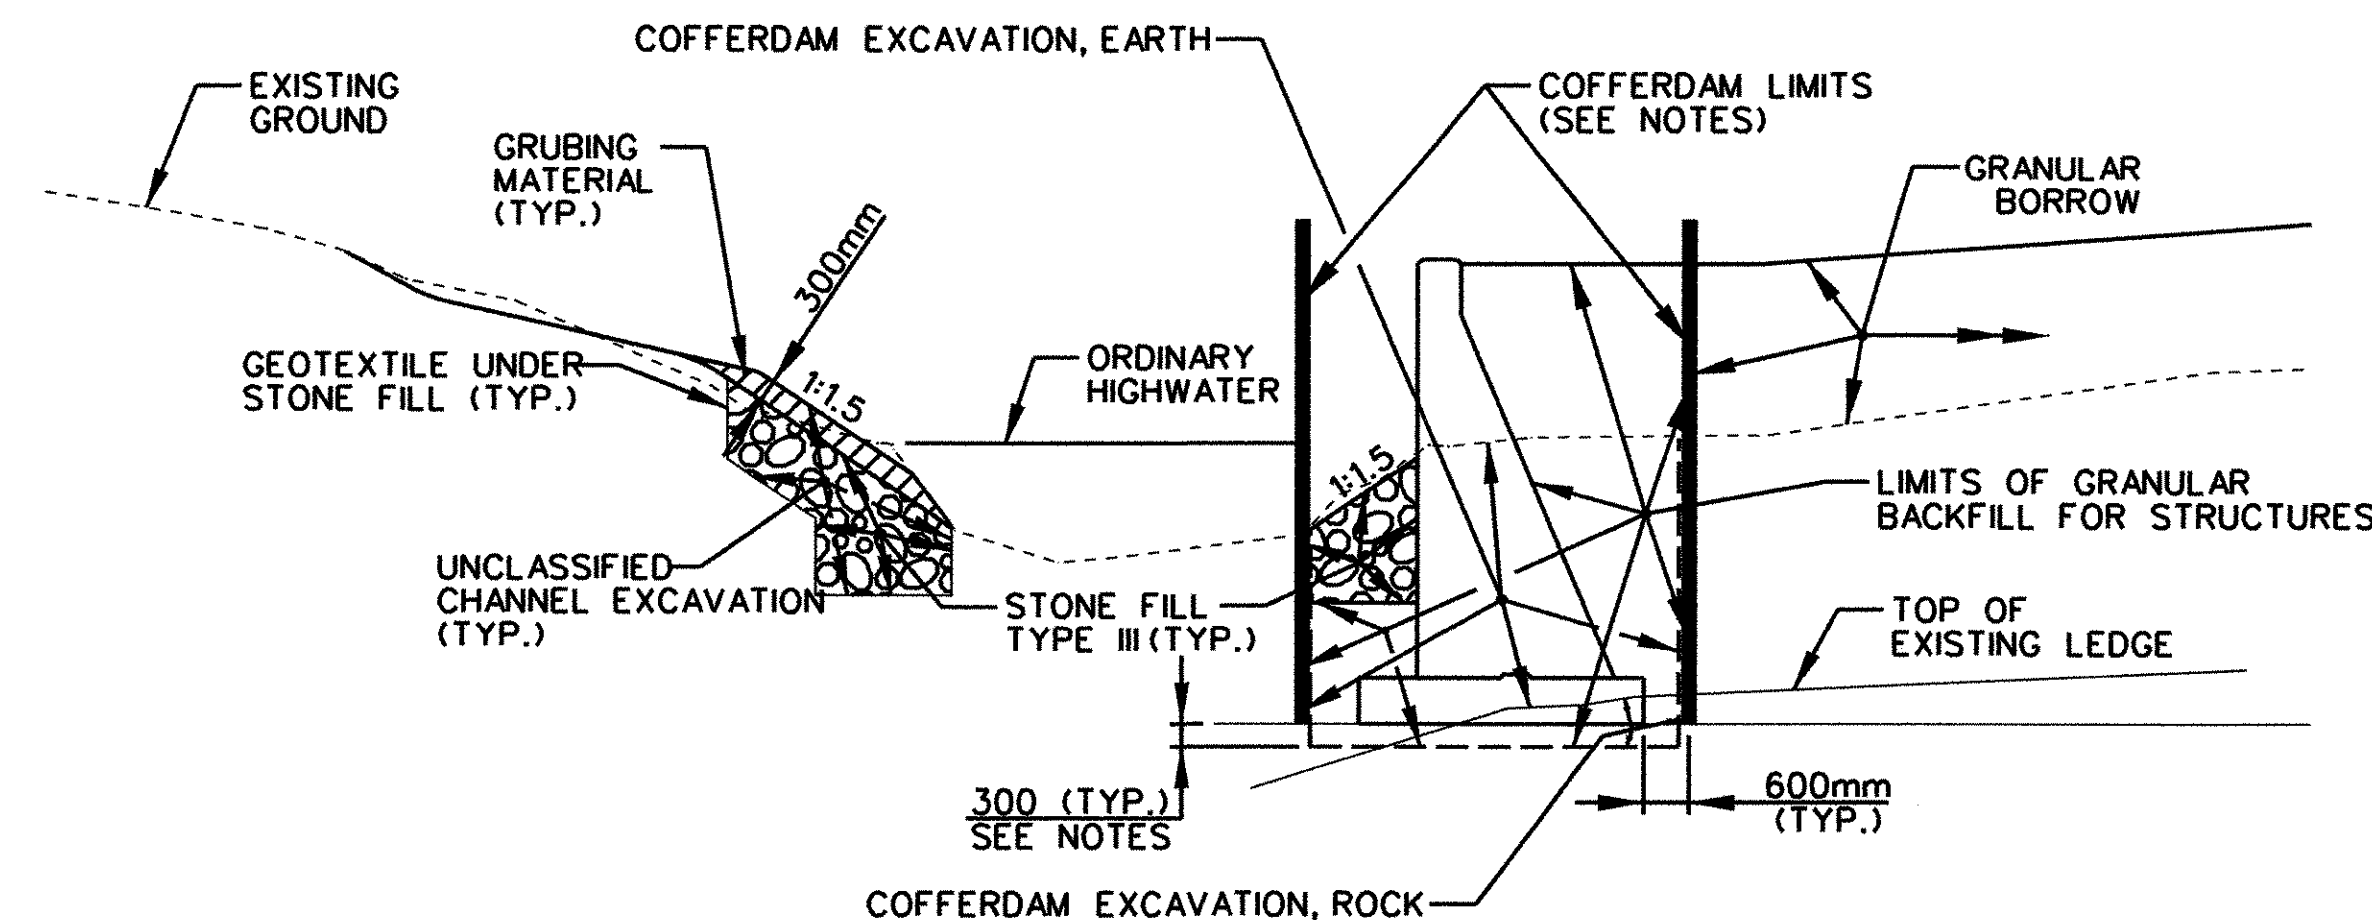

TYPICAL WINGWALL/CHANNEL SECTION

(NOT TO SCALE)

NOTES

1. COFFERDAM LIMITS TO BE DETERMINED BY THE CONTRACTOR.
2. THE PAY LIMITS OF "COFFEDAM EXCAVATION, EARTH" AND "COFFEDAM EXCAVATION, ROCK" SHALL BE 600 OUTSIDE THE PERMETER OF THE FOOTING, UP TO EXISTING GROUND OR BOTTOM OF SUBBASE, WHICHEVER IS LOWER.
3. 300 UNDERCUT AS DETERMINED NECESSARY BY THE RESIDENT ENGINEER.
4. IF A COFFERDAM IS CONSTRUCTED WHICH IS LARGER THAN THE INDICATED COFFERDAM EXCAVATION PAY LIMITS, PAYMENT FOR ALL UNCLASSIFIED CHANNEL EXCAVATION, INCLUDING THE PORTION WHICH IS INSIDE THE COFFERDAM BUT OUTSIDE THE COFFERDAM EXCAVATION PAY LIMITS, WILL BE MADE AT THE CONTRACT UNIT PRICE FOR UNCLASSIFIED CHANNEL EXCAVATION.

Plot Date: 10-03-2002
File: sgtbr302

HYDRAULIC DATA

1. DRAINAGE AREA 14.2 km²
2. CHARACTER OF TERRAIN SMALL MOUNTAINS
3. CHARACTER AND TYPE OF STREAM ALLUVIAL RANDOM VARIATION IN WIDTH
4. NATURE OF STREAMBED SAND/GRAVEL BOTTOM

Q2.33	6 m ³ /s	050	30.5 m ³ /s
Q10	18 m ³ /s	0100	35.5 m ³ /s
Q25	25.5 m ³ /s	0500	48 m ³ /s
5. DATE OF FLOOD OF RECORD UNKNOWN
6. WATER SURFACE ELEVATION NA ESTIMATED DISCHARGE NA m³/s
7. NATURAL STREAM VELOCITY @ Q 50 2.33 - 1.70 m/s
8. ICE CONDITIONS LIGHT DEBRIS MODERATE TO HEAVY
9. DOES THE STREAM REACH MAX. HIGHWATER ELEVATION RAPIDLY? YES, STREAM IS CONSIDERED FLASHY
10. IS ORDINARY RISE RAPID? YES
11. IS STAGE AFFECTED BY UPSTREAM/DOWNSTREAM CONDITIONS? YES
IF YES, DESCRIBE: AT GREATER THAN Q2.33 THE WATER OVER FLOWS STREAM BANKS AND TRAVELS ACROSS WETLANDS TO ADJACENT ROUTE 9
12. WATERSHED STORAGE < 1/2 HEADWATERS UNIFORM THROUGHOUT WATERSHED IMMEDIATELY ABOVE SITE

EXISTING STRUCTURE

1. STRUCTURE TYPE: REINFORCED CONCRETE CAPPED STONE ABUTMENT w/ CONCRETE DECK YEAR BUILT: UNKNOWN
2. CLEAR SPAN (NORMAL TO STREAM): 5.6 m
3. VERTICAL CLEARANCE ABOVE STREAMBED: 3.14 m
4. WATERWAY OF FULL OPENING: 18.0 m²
5. DISPOSITION OF STRUCTURE: EXTEND CONCRETE CAP OVER SLOPED STONE ABUTMENT WALLS
6. TYPE OF MATERIAL UNDER SUBSTRUCTURE: BEDROCK (HARDPAN)
7. WATER SURFACE ELEVATION @ Q2.33- VELOCITY-

Q2.33	83.77 m	VELOCITY-	1.70 m/s
Q10	84.77 m		2.52 m/s
Q25	85.29 m		3.66 m/s
Q50	85.49 m		3.90 m/s
Q100	85.68 m		4.11 m/s
8. LONG TERM STREAM BED CHANGES: SEDIMENT DEPOSITIS ON DOWNSTREAM CROSS SECTIONS NEAR SHARP CURVE IN STREAM
9. IS THE ROADWAY OVERTOPPED BELOW THE Q100? YES FREQUENCY: Q2.9
10. RELIEF ELEVATION: 84.25 m DISCHARGE OVER ROAD @ Q 100: 27 m³/s
11. UPSTREAM STRUCTURE: TOWN: BRATTLEBORO DISTANCE: 0.25km
HIGHWAY NO.: 5 STRUCTURE NO.: 10
STRUCTURE TYPE: WIDE-FLANGE BEAMS WITH CONCRETE DECK
CLEAR SPAN: 9.14 m CLEAR HEIGHT: 1.83 m
YEAR BUILT: 1959 FULL WATERWAY: 16.73 m²
12. DOWNSTREAM STRUCTURE: TOWN: NONE DISTANCE: _____
HIGHWAY NO.: _____ STRUCTURE NO.: _____
STRUCTURE TYPE: _____
CLEAR SPAN: _____ CLEAR HEIGHT: _____
YEAR BUILT: _____ FULL WATERWAY: _____

PROPOSED STRUCTURE

1. STRUCTURE GEOMETRY: EXISTING BRIDGE WITH DECK AND ABUTMENT CAP EXTENSION
 2. CLEAR SPAN LENGTH(S): 5.6 m
 3. VERTICAL CLEARANCE ABOVE STREAMBED: 3.14 m
 4. ARE PROVISIONS TO BE MADE FOR PUBLIC UTILITIES? NO
- HYDRAULIC DATA:
1. WATERWAY AREA OF FULL OPENING (NORMAL TO STREAM): 18 m² NA m³/s
 2. WATER SURFACE ELEVATION @ Q 2.33 - VELOCITY-

Q 10	84.68 m	VELOCITY-	1.70 m/s
Q 25	85.07 m		2.68 m/s
Q 50	85.32 m		3.90 m/s
Q 100	85.55 m		4.11 m/s
 3. IS THE ROADWAY OVERTOPPED BELOW THE Q100? YES FREQUENCY: Q2.9
 4. RELIEF ELEVATION: 84.25m DISCHARGE OVER ROAD @ Q 100: 27 m³/s
 5. AVERAGE LOW ELEVATION OF SUPERSTRUCTURE: 85.83 m
 6. VERTICAL CLEARANCE @ Q 50 - 0.73 m
 7. SCOUR: Q 100: CONTRACTION SCOUR = 5.88m, ABUTMENT 1 = 11.57m, ABUTMENT 2 = 0.67
 8. REQUIRED CHANNEL PROTECTION: STONE FILL TYPE III

PERMIT INFORMATION

AVERAGE DAILY FLOW: NA
ORDINARY LOW WATER: NA DEPTH: NA
ORDINARY HIGH WATER: NA DEPTH: NA
NA - NOT AVAILABLE

TRAFFIC DATA

FUNCTIONAL CLASSIFICATION MINOR ARTERIAL

2002 ADT	N/A
2022 ADT	N/A
2022 ADTT	N/A
2002 DHV	N/A
2022 DHV	N/A
D	N/A
T	N/A
V	N/A
2002-2022 18 KIP ESAL	N/A
2002-2042 18 KIP ESAL	N/A

TEMPORARY BRIDGE REQUIREMENTS

1. STRUCTURE TYPE NO TEMPORARY STRUCTURE
 2. CLEAR SPAN LENGTH(S) NORMAL TO STREAM: N/A
 3. VERTICAL CLEARANCE ABOVE STREAMBED: N/A
 4. WATERWAY AREA OF FULL OPENING (NORMAL TO STREAM): N/A
- NA - NOT APPLICABLE

NOTE:

- TRAFFIC MAINTENANCE:
1. IS TRAFFIC TO BE MAINTAINED? YES IF YES, ON EXISTING STRUCTURE X
OR ON TEMPORARY BRIDGE
 2. TEMPORARY BRIDGE REQUIREMENTS: ONE OR TWO WAY N/A
TRAFFIC CONTROL SIGNALS REQUIRED
ARE SIDEWALKS REQUIRED? IF SO, ON WHAT SIDE?
STRUCTURE TYPE:

DESIGN CRITERIA

1. DESIGN LIVE LOAD AREA 1936 E70 B&M STANDARD PLAN BB "REINFORCED CONCRETE SLAB"
2. DESIGN SPAN 6m
3. ALLOWABLE LOAD FOR SPREAD FOOTINGS ON SOIL N/A ON LEDGE 950kPa
4. ALLOWABLE LOAD FOR PILING N/A TYPE N/A ESTIMATED LENGTH N/A
5. ALLOWABLE STRESS FOR STRUCTURAL STEEL AASHTO M270M GR 345 WEATHERING STEEL TENSION 186 MPa
6. ALLOWABLE STRESS FOR REINFORCING STEEL AASHTO M31M GRADE 400 TENSION 165 MPa COMPRESSION 138 MPa
7. ALLOWABLE STRESS FOR CONCRETE HIGH PERFORMANCE CLASS A f_c 30 MPa f_c N/A

LOAD RATING (TONS)(LOAD FACTOR)

RATING					
INVENTORY					
POSTED					
OPERATING					

STATE OF VERMONT
AGENCY OF TRANSPORTATION

Town Of BRATTLEBORO Bridge No. 62.51
Highway No. VT. ROUTE 9 Log Sta.
Surv. Sta.

NEW ENGLAND CENTRAL RAILROAD OVER SARGENT BROOK

PRELIMINARY INFORMATION

Designed By LM Drawn By DHL
Checked By GJB Date Bridge Design Supervisor
JHR Date

PROJECT BRATTLEBORO PROJECT NO.
NH 010-2(2)

I.G.C. Info.
Bridge Sheet No. Sheet 5 of 145

GENERAL ITEMS

- ALL MATERIALS AND CONSTRUCTION SHALL CONFORM TO THE STATE OF VERMONT AGENCY OF TRANSPORTATION'S STANDARD SPECIFICATIONS FOR CONSTRUCTION, DATED 2001, AND ITS LATEST REVISIONS; AREMA'S "MANUAL FOR RAILWAY ENGINEERING", LATEST EDITION; THE AASHTO STANDARD SPECIFICATIONS FOR HIGHWAY BRIDGES, SIXTEENTH EDITION, AND ITS LATEST REVISIONS; AASHTO'S "A POLICY ON GEOMETRIC DESIGN OF HIGHWAYS AND STREETS" (AASHTO GREEN BOOK), THE 1994 METRIC VERSION; THE AASHTO "ROADSIDE DESIGN GUIDE"; THE 1988 MANUAL ON UNIFORM TRAFFIC CONTROL DEVICES (MUTCD), AS AMENDED; THE FHWA PUBLICATION "FLEXIBILITY IN HIGHWAY DESIGN"; AND THE LATEST AMENDED EDITION OF "THE AMERICAN STANDARD FOR NURSERY STOCK". THE CONTRACTOR SHALL ALSO COMPLY WITH ALL APPLICABLE FEDERAL, STATE AND LOCAL REQUIREMENTS AND SAFETY CODES, ENVIRONMENTAL AND HEALTH STATUTES AND REGULATIONS, ETC. IN THE CONSTRUCTION OF ALL IMPROVEMENTS. THE ORDER OF PRECEDENCE SHALL BE IN ACCORDANCE WITH THE STANDARD SPECIFICATIONS FOR CONSTRUCTION, DATED 2001.
- SURVEY INFORMATION OBTAINED BY NHDOT, ELECTRONICALLY TRANSLATED FROM MOSS TO MICROSTATION, AND SUPPLEMENTED BY VTRANS ADDITIONAL SURVEY.
- ELEVATIONS ARE REFERENCED TO NATIONAL GEODETIC VERTICAL DATUM OF 1929 (NGVD29). ALL SURVEY POINTS HAVE BEEN DETERMINED WITH RESPECT TO THE NEW HAMPSHIRE STATE PLANE COORDINATE SYSTEM AS REFERENCED TO THE NORTH AMERICAN DATUM OF 1983 (NAD83).
- THE EXISTING DETAIL AND TOPOGRAPHY DEPICTED ON THESE PLANS REPRESENT A COMPILATION OF DATA OBTAINED FROM VARIOUS PLANS AND RECORDS, AND A FIELD SURVEY. THE CONTRACTOR IS REQUIRED TO VERIFY ALL CONDITIONS IN THE FIELD PRIOR TO COMMENCING WORK, AND SHALL REPORT ANY DISCREPANCIES TO THE ENGINEER.
- CONTRACTOR IS RESPONSIBLE FOR COORDINATING THE WORK OF THIS CONTRACT WITH THE WORK OF ADJACENT CONTRACTS AND THE RAILROAD PERFORMING TRACK WORK UNDER RAILROAD FORCE ACCOUNT. IT IS ANTICIPATED THAT THE NHDOT CONTRACT FOR THE PROPOSED BRIDGE OVER THE CONNECTICUT RIVER WILL BE ONGOING SIMULTANEOUSLY WITH THIS CONTRACT. SAID NHDOT CONTRACT INVOLVES WORK WITHIN THE VERMONT PROJECT AREA, INCLUDING ROCK REMOVAL AND ABUTMENT CONSTRUCTION ON THE NORTH SIDE OF ROUTE 9 BETWEEN APPROXIMATE STA. 30+285 AND THE CONNECTICUT RIVER.
- FOR CENTERLINE AND BASELINE ALIGNMENT DATA, REFER TO THE ALIGNMENT PLAN.
- FOR SUBSURFACE EXPLORATION DATA, REFER TO BORING LOGS AND PROBE DATA.
- SAFETY MEASURES, DAY TO DAY CONTROL OF THE WORK, AND CONSTRUCTION METHODS SHALL BE THE RESPONSIBILITY OF THE CONTRACTOR.
- CONTRACTOR WILL MAINTAIN ROUTE 9 TRAFFIC AT ALL TIMES, AND MODIFY CONSTRUCTION PROCEDURES AND SCHEDULE ACCORDINGLY AS DIRECTED BY THE ENGINEER. CONSTRUCTION SEQUENCE SHALL BE COORDINATED TO MINIMIZE DISTURBANCE OF ROUTE 9 VEHICULAR TRAFFIC OPERATIONS.
- THE CONTRACTOR SHALL TAKE ADEQUATE PRECAUTIONS TO PROTECT ALL WALKS, STREETS, PAVEMENTS, HIGHWAY GUARD, CURBING, EDGING, TREES AND PLANTINGS ON OR OFF THE PREMISES, AND SHALL REPAIR AND REPLACE OR OTHERWISE MAKE GOOD AT HIS OWN EXPENSE AS DIRECTED BY THE ENGINEER ANY ITEMS DAMAGED AS A RESULT OF THE CONTRACTOR'S WORK.
- CONSULT ALL THE DRAWINGS AND SPECIFICATIONS FOR COORDINATION REQUIREMENTS BETWEEN ALL TRADES PRIOR TO COMMENCING BLASTING, TEMPORARY SHORING AND BRACING, DEMOLITION, SITE CLEARING, AND BRIDGE CONSTRUCTION.
- ANY ALTERATIONS TO THESE DRAWINGS MADE IN THE FIELD SHALL BE PROMPTLY REPORTED BY THE CONTRACTOR TO THE ENGINEER AND RECORDED ON "AS-BUILT" DRAWINGS.
- CONTRACTOR SHALL SUBMIT PROPOSED LOCATION OF STAGING AREA FOR APPROVAL BY THE ENGINEER PRIOR TO BEGINNING WORK OR BRINGING EQUIPMENT TO THE SITE.
- CONTRACTOR SHALL COORDINATE ALL SITE IMPROVEMENTS IN AREAS ADJACENT TO PRIVATE PROPERTY WITH THE PROPERTY OWNERS.
- THE CONTRACTOR SHALL MAINTAIN SAFE AUTOMOBILE AND PEDESTRIAN ACCESS ON ALL ADJACENT STREETS, WALKS AND DRIVEWAYS AT ALL TIMES. THE CONTRACTOR SHALL PROVIDE AND MAINTAIN ANY TRAFFIC CONTROL DEVICES, BARRICADES, AND FLAGGERS AS NECESSARY OR REQUIRED BY STATE, RAILROAD AND LOCAL REGULATIONS.
- THE MSE WALL SUPPLIED BY TENSAR EARTH TECHNOLOGIES SHALL BE A CATEGORY II EXPERIMENTAL FEATURE. THE CONTRACTOR WILL COORDINATE WITH THE AGENCY'S MATERIALS RESEARCH SECTION WHO WILL BE DOCUMENTING CONSTRUCTION OF THIS WALL SYSTEM. SEE SHEETS 138 THRU 144

RAILROAD REQUIREMENTS

- RAILROAD PROPERTY LINE INFORMATION OBTAINED FROM PLAN ENTITLED "RIGHT-OF-WAY AND TRACK MAP, VERMONT VALLEY RAILROAD, STATION 3264+60 TO STATION 3317+40", DATED JUNE 30, 1914 (VALUATION PLAN 46, MAP 4).
- WHEN WATER IS KNOWN OR EXPECTED TO BE ENCOUNTERED, PUMPS OF SUFFICIENT CAPACITY TO HANDLE THE FLOW SHALL BE MAINTAINED AT THE SITE, AND UPON APPROVAL OF THE ENGINEER TO OPERATE THEM, THEY SHALL BE IN CONSTANTLY ATTENDED OPERATION ON A 24-HOUR BASIS UNTIL, IN THE SOLE JUDGEMENT OF THE ENGINEER, THEIR OPERATION CAN BE SAFELY HALTED. WHEN DEWATERING, CLOSE OBSERVATION SHALL BE MAINTAINED TO DETECT ANY SETTLEMENT OR DISPLACEMENT OF RAILROAD EMBANKMENT, TRACKS, AND FACILITIES.
- ALL OPERATIONS SHALL BE CONDUCTED SO AS NOT TO INTERFERE WITH, INTERRUPT, OR ENDANGER THE OPERATION OF TRAINS NOR DAMAGE, DESTROY, OR ENDANGER THE INTEGRITY OF RAILROAD FACILITIES. ALL WORK ON AND NEAR RAILROAD PROPERTY SHALL BE CONDUCTED IN ACCORDANCE WITH RAILROAD SAFETY RULES AND REGULATIONS. THE CONTRACTOR SHALL SECURE AND COMPLY WITH THE RAILROAD SAFETY RULES AND SHALL GIVE WRITTEN ACKNOWLEDGMENT TO THE RAILROAD THAT THEY HAVE BEEN RECEIVED, READ AND UNDERSTOOD BY THE CONTRACTOR AND HIS EMPLOYEES. OPERATIONS WILL BE SUBJECT TO RAILROAD INSPECTION AND FLAG PROTECTION AT ANY AND ALL TIMES.
- AT ALL TIMES WHEN THE WORK IS BEING PROGRESSSED, A FIELD SUPERVISOR FOR THE WORK WITH NO LESS THAN 12 MONTHS' EXPERIENCE IN THE OPERATION OF THE EQUIPMENT BEING USED SHALL BE PRESENT.
- THE CONTRACTOR MUST SUBMIT A BLASTING PLAN FOR REVIEW AND APPROVAL BY THE ENGINEER PRIOR TO THE PERFORMANCE OF ANY BLASTING OPERATION. CONTROLLED BLASTING WITHIN CLOSE PROXIMITY TO THE RAILROAD IS NOT TO BE PERFORMED UNLESS APPROVED BY THE ENGINEER.

RAILROAD REQUIREMENTS (CONTINUED)

- WHENEVER EQUIPMENT OR PERSONNEL ARE WORKING CLOSER THAN 15 FEET TO THE CENTERLINE OF AN ADJACENT TRACK, THAT TRACK SHALL BE CONSIDERED AS BEING OBSTRUCTED. INSOFAR AS POSSIBLE, ALL OPERATIONS SHALL BE CONDUCTED OUTSIDE THIS DISTANCE. ALL OPERATIONS CLOSER THAN 15 FEET TO THE CENTERLINE OF A TRACK SHALL BE CONDUCTED ONLY WITH THE PERMISSION OF, AND AS DIRECTED BY, A DULY QUALIFIED RAILROAD EMPLOYEE PRESENT AT THE SITE OF THE WORK. CROSSING OF TRACKS AT GRADE WITH EQUIPMENT OR VEHICLES IS PROHIBITED EXCEPT BY PRIOR ARRANGEMENT WITH, AND AS DIRECTED BY, THE RAILROAD.
- THE CONTRACTOR SHALL PROVIDE ADEQUATE BRACING AND SHORING OF ALL EXCAVATIONS IN ACCORDANCE WITH REQUIREMENTS OF GOVERNING CODES AND REGULATIONS. ANY TEMPORARY TRACK SUPPORTING STRUCTURES TO BE INSTALLED MUST BE APPROVED BY THE ENGINEER. THE CONTRACTOR SHALL PREPARE AND SUBMIT A TEMPORARY SHORING AND BRACING PLAN FOR REVIEW AND APPROVAL BY THE ENGINEER PRIOR TO THE PERFORMANCE OF ANY SHORING OR BRACING WORK. THE TEMPORARY SHORING AND BRACING PLAN SHALL INCLUDE AN INSTRUMENTATION MONITORING PROGRAM TO MONITOR THE TEMPORARY SHORING AND BRACING STRUCTURE AND TRACK SURFACE THROUGHOUT CONSTRUCTION. THE PLAN SHALL BE PREPARED AND STAMPED BY A PROFESSIONAL ENGINEER REGISTERED IN THE STATE OF VERMONT.
- ANY ELEMENT OF THE TEMPORARY TRACK SUPPORTING STRUCTURES WITHIN 3M OF THE CENTERLINE OF TRACK THAT CAN NOT BE REMOVED DURING BACKFILL OPERATIONS (SUCH AS SOLDIER PILES) SHALL BE CUT OFF 1M BELOW THE PROPOSED TOP OF RAIL AND LEFT IN PLACE.
- THE CONTRACTOR SHALL PROVIDE GENERAL LIABILITY AND RAILROAD PROTECTIVE LIABILITY INSURANCE POLICIES, COVERING THE WORK OF THE CONTRACTOR AND ALL SUBCONTRACTORS. FOR COMPLETE RAILROAD INSURANCE REQUIREMENTS, REFER TO DOCUMENT ENTITLED "CONTRACTOR'S INSURANCE REQUIREMENTS FOR NEW ENGLAND CENTRAL RAILROAD, INC.", LATEST ISSUE.
- FOR ADDITIONAL RAILROAD REQUIREMENTS, REFER TO DOCUMENT ENTITLED "SPECIFICATION FOR PIPELINE OCCUPANCY OF NEW ENGLAND CENTRAL RAILROAD, INC."
- UNLESS OTHERWISE AGREED, ALL WORK INVOLVING RAIL, TIES AND OTHER TRACK MATERIAL WILL BE PERFORMED BY THE RAILROAD UNDER A SEPARATE RAILROAD FORCE ACCOUNT AGREEMENT.
- ALL VEGETATIVE GROWTH, INCLUDING BRUSH AND TREE LIMBS WHICH OVERHANG THE RAILROAD CLEAR ZONE (3 METERS EACH SIDE OF RAILROAD C) ARE TO BE REMOVED.

UTILITIES

- SOME UTILITIES MAY NOT BE SHOWN ON THE PLANS, AND OTHERS MAY NOT BE PROPERLY LOCATED. THE CONTRACTOR SHALL BE RESPONSIBLE FOR VERIFYING AND DETERMINING THE SIZE AND LOCATION OF ALL EXISTING UTILITIES PRIOR TO CONSTRUCTION. THE ENGINEER SHALL BE NOTIFIED IN WRITING OF ANY UTILITIES FOUND INTERFERING WITH THE PROPOSED CONSTRUCTION, AND APPROPRIATE REMEDIAL ACTION SHALL BE TAKEN BEFORE PROCEEDING WITH THE WORK.
- FIBER OPTIC DATA OBTAINED FROM SIGNS ON SITE AND US SPRINT PLANS DATED 09-02-86, NUMBERED NTRWK 127-880-064 AND 065, AND ENTITLED "FIBER OPTIC ROUTE RCD DWG, CABLE ROUTE DETAIL, SPRINGFIELD, MA-MONTREAL, CANADA".
- FIBER OPTIC CABLE AND ASSOCIATED FACILITIES SUCH AS SIGNS WILL BE RELOCATED BY THE OWNER, INCLUDING THE TEMPORARY RELOCATION TO AN OVERHEAD SYSTEM ON THE EAST SIDE OF THE TRACK. HOWEVER, CONTRACTOR IS TO INSTALL CONDUIT AND THREE HAND HOLES FOR NEW FIBER OPTIC SYSTEM (PVC, EXCEPT FOR BRIDGE LOCATIONS WHICH WILL BE GALVANIZED IRON PIPE). OWNER WILL INSTALL JUNCTION BOXES AT EACH END OF PROJECT. IT IS THE RESPONSIBILITY OF THE CONTRACTOR TO COORDINATE ALL WORK.
- THE CONTRACTOR SHALL EXERCISE EXTREME CARE WHEN EXCAVATING NEAR AND BACKFILLING IN THE VICINITY OF EXISTING UTILITIES, AND SHALL USE HAND EXCAVATION WHERE APPROPRIATE. CONTRACTOR SHALL REPAIR ANY DAMAGE INCURRED DURING CONSTRUCTION TO EXISTING UTILITIES SCHEDULED TO REMAIN AT NO COST TO THE OWNER.
- ALL EXISTING PIPING AND STRUCTURES EXPOSED DURING EXCAVATION SHALL BE ADEQUATELY SUPPORTED, BRACED OR OTHERWISE PROTECTED DURING CONSTRUCTION ACTIVITIES.
- UNLESS OTHERWISE NOTED OR APPROVED BY THE ENGINEER, THE CONTRACTOR SHALL MAINTAIN ALL EXISTING UTILITIES IN SERVICE AT ALL TIMES.
- EXISTING BURIED CABLE MARKERS FOR FIBER OPTIC OR OTHER UTILITIES WILL BE PROTECTED AND RESTORED OR REPLACED AS DETERMINED BY THE ENGINEER.
- PRIVATE UTILITY FACILITIES, SUCH AS ELECTRIC, TELEPHONE, FIBER OPTICS, AND CABLE TV ARE TO BE DESIGNED AND INSTALLED BY THE RESPECTIVE UTILITY COMPANY UNLESS OTHERWISE NOTED.
- RETAIN ALL EXISTING UNDERGROUND UTILITIES UNLESS OTHERWISE NOTED OR DIRECTED BY THE ENGINEER
- NO ADDITIONAL PAYMENT SHALL BE MADE FOR ABANDONING AND PLUGGING EXISTING PIPES WHERE DIRECTED BY THE ENGINEER. NO EXISTING PIPES SHALL BE ABANDONED, REMOVED OR PLUGGED WITHOUT PRIOR APPROVAL OF THE ENGINEER.

EROSION CONTROL

- THE CONTRACTOR SHALL PROVIDE EROSION CONTROL MEASURES AS INDICATED, SPECIFIED AND DIRECTED BY THE ENGINEER. TEMPORARY EROSION CONTROL MEASURES SHALL BE MAINTAINED AS DIRECTED BY THE ENGINEER. ALL EROSION CONTROL GEOTEXTILE SHALL BE CLASS A WOVEN OR UNWOVEN. TEMPORARY EROSION CONTROL BLANKET SHALL BE INSTALLED IN ALL DITCHES AND SWALES. LOAM AND SEED SHALL BE PLACED PRIOR TO THE INSTALLATION OF THE EROSION CONTROL BLANKET.
- IN-STREAM CONSTRUCTION SHALL BE RESTRICTED TO JUNE 1 TO OCTOBER 1, UNLESS THE CONTRACTOR OBTAINS WRITTEN PERMISSION FROM THE AGENCY OF NATURAL RESOURCES TO DO WORK OUTSIDE OF THAT TIME FRAME.
- THE CONTRACTOR SHALL TAKE ALL PRECAUTIONS NECESSARY TO PREVENT SILTATION OR POLLUTION, ESPECIALLY THE DISCHARGE OF RAW CONCRETE, INTO ANY BROOK, STREAM OR RIVER.

EROSION CONTROL (CONTINUED)

- THE CONTRACTOR SHALL PROVIDE EROSION PROTECTION AND SILTATION BARRIERS TO PROTECT ALL WORK IN WETLANDS AND IN THE 100 FEET WETLAND BUFFER ZONES. BARRIERS ARE TO BE PLACED 1.8 METERS FROM THE BOTTOM OR TOP OF SLOPE AND/OR AS REQUIRED BY THE SPECIFICATIONS OR DIRECTED BY THE ENGINEER.
- FOR CONSTRUCTION OF THE SARGENT BROOK BRIDGE WIDENING, THE TEMPORARY EROSION CONTROL MEASURES INDICATED ARE SUGGESTED. CONTRACTOR MUST PREPARE AN EROSION CONTROL PLAN FOR APPROVAL IN ACCORDANCE WITH STANDARD SPECIFICATIONS SECTION 105.22 ENVIRONMENTAL PROTECTION.

SUGGESTED CONSTRUCTION SEQUENCE

- THE CONTRACTOR SHALL FOLLOW THE PROJECT SEQUENCE PROVIDED BELOW OR DEVELOP ONE THAT MUST BE APPROVED BY THE ENGINEER. AN APPROVED COPY MUST BE SENT TO THE STRUCTURES SECTION FOR REFERENCE ONLY.
 - TEMPORARILY RELOCATE FIBER OPTICS ONTO AN OVERHEAD POLE LINE ON THE EAST SIDE OF THE TRACK (WORK BY OTHERS).
 - INSTALL TEMPORARY SUPPORT SYSTEM.
 - BUILD ABUTMENTS AND WESTERLY WING WALLS FOR BRIDGE NO.'S 62.51 AND 62.56. THEN CONSTRUCT EACH BRIDGE, EMBANKMENT AND FIBER OPTIC CONDUIT.
 - INSTALL BALLAST AND CONSTRUCT TRACK. (WORK BY OTHERS)
 - CUT TRACK, THROW, RECONNECT AND RELOCATE SIGNS. (WORK BY OTHERS)
 - DEMOLISH EXISTING BRIDGE NO. 62.56 (SUPERSTRUCTURE AND SUBSTRUCTURE). CONTRACTOR TO COORDINATE DEMOLITION WITH UTILITY RELOCATIONS. EXISTING TRACK TO BE REMOVED BY OTHERS
 - RELOCATE PRIVATE UTILITY FACILITIES IN ROUTE 9.
 - CONSTRUCT EASTERLY WING WALLS OF BRIDGE NO. 62.56.
 - PERFORM REMAINING BLASTING AND ROCK REMOVAL ON THE NORTH SIDE OF EXISTING ROUTE 9.
 - PERFORM ROADWAY CONSTRUCTION.
 - INSTALL FIBER OPTICS IN THEIR PERMANENT UNDERGROUND LOCATION (WORK BY OTHERS).

BRIDGE DEMOLITION AND ERECTION

- CONTRACTOR MUST SUBMIT A DEMOLITION AND DISPOSITION PLAN AND AN ERECTION PROCEDURES PLAN THAT MEET THE REQUIREMENTS OF THE SPECIAL PROVISIONS. THESE PLANS MUST BE APPROVED BY THE ENGINEER.
- CONTRACTOR SHALL COORDINATE PROTECTION OF EXISTING AND PROPOSED UTILITY FACILITIES DURING DEMOLITION OF THE SOUTH ABUTMENT OF THE ROUTE 9 RAILROAD BRIDGE.
- CONTRACTOR SHALL VERIFY ALL ITEMS TO BE REMOVED AND PROTECTED BEFORE COMMENCING ANY DEMOLITION WORK. EXISTING STRUCTURES, IMPROVEMENTS AND THEIR APPURTENANCES, AND VEGETATION TO REMAIN SHALL BE PROTECTED FROM DAMAGE.
- ALL MATERIALS TO BE REMOVED AND DISPOSED SHALL BE DISPOSED IN ACCORDANCE WITH ALL APPLICABLE CODES AND REGULATIONS.
- THE EXISTING STRUCTURAL STEEL ON THIS PROJECT WAS PAINTED WITH A MATERIAL WHICH MAY CONTAIN LEAD. THE REMOVED STRUCTURAL STEEL IS TO BECOME THE PROPERTY OF THE CONTRACTOR. THE CONTRACTOR SHALL INDEMNIFY AND HOLD THE STATE, ITS OFFICERS, AND EMPLOYEES HARMLESS CONCERNING THE CONTRACTOR'S USE OR DISPOSITION OF THE STRUCTURAL STEEL.

RAILROAD FORCE ACCOUNT TRACK WORK

- THE CONTRACTOR WILL CONSTRUCT THE RAILROAD EMBANKMENT SECTION TO THE TOP OF SUBGRADE OR BOTTOM OF SUBBALLAST.
- THE RAILROAD FORCE ACCOUNT WILL INSTALL THE SUBBALLAST, BALLAST, AND REHABILITATE AND CONSTRUCT TRACK FROM STATION 50+020.000 TO STATION 50+698.603. CLOSE COORDINATION WILL BE REQUIRED AT THOSE LOCATIONS WHERE THE SUBBALLAST/BALLAST ARE SHOWN TO BE BOXED, AND WHERE THE EXISTING BALLAST AND EMBANKMENT ARE TO BE REMOVED.
- AT THE ROUTE 9 BRIDGE THE GENERAL CONTRACTOR WILL INSTALL THE WATERPROOFING, BALLAST MAT AND DRAINAGE PIPES (HALF ROUNDS AND ASSOCIATED PIPING). THE RAILROAD FORCE ACCOUNT WILL FLOOD THE BRIDGE WITH BALLAST AND INSTALL THE TRACK (INCLUDING THE TRANSITIONAL APPROACH TIMBER PACKAGE).
- AT THE SARGENT BROOK BRIDGE THE GENERAL CONTRACTOR WILL INSTALL THE WATERPROOFING, AND 100mm OF SAND. THE RAILROAD FORCE ACCOUNT WILL FLOOD THE BRIDGE WITH BALLAST, REHABILITATE AND RELOCATE THE EXISTING TRACK TO ITS PERMANENT ALIGNMENT.
- EXISTING RAIL, TIES AND OTHER TRACK MATERIALS TO BE REMOVED WILL BE STOCKPILED AS DIRECTED BY THE ENGINEER.
- FOR ALL RAILROAD SIGNS INDICATED AS R&R, THE SIGN IS TO BE SALVAGED, CLEANED AND INSTALLED ON A NEW POST AND FOUNDATION. NEW POSTS MUST BE INSTALLED PRIOR TO THE RAILROAD OPERATING ON THE NEW TRACK. THE NEW TRACK SHALL NOT BE PLACED INTO OPERATION WITHOUT THE SIGNS BEING RELOCATED ON THE NEW POSTS.

PROJECT:	BRATTLEBORO	PROJECT NO.:	NH 010-2(2)
DESIGN FILE NAME:	U:\99123-Brattleboro\dgn\BrRR500.dgn		
IPARM FILE NAME:	PLOT DATE: 10-03-2002		
SHEET: 6 OF 145			

CONSTRUCTION

- AT LEAST 72 HOURS PRIOR TO STARTING CONSTRUCTION, THE CONTRACTOR MUST NOTIFY THE DIG SAFE CENTER AT 1-888-344-7233 OR 1-888-DIG-SAFE AND PROCURE A DIG SAFE NUMBER FOR EACH LOCATION PRIOR TO DISTURBING THE EXISTING GROUND IN ANY WAY.
- THE CONTRACTOR SHALL COMPLY WITH ALL APPLICABLE FEDERAL, STATE AND LOCAL PERMITS, LICENSES, SAFETY CODES, LEGAL REQUIREMENTS, ETC. IN THE CONSTRUCTION OF ALL IMPROVEMENTS. THE CONTRACTOR SHALL BE RESPONSIBLE FOR OBTAINING ALL CONSTRUCTION PERMITS AND LICENSES FROM THE NEW ENGLAND CENTRAL RAILROAD, TOWN OF BRATTLEBORO, VERMONT AGENCY OF TRANSPORTATION OR ANY OTHER LOCAL, STATE OR FEDERAL AGENCIES TO CONSTRUCT THE PROJECT. ALL NECESSARY FEES AND PERMITS SHALL BE PAID FOR BY THE CONTRACTOR.
- ALL SIGNS AND PAVEMENT MARKINGS SHALL CONFORM TO THE MANUAL ON UNIFORM TRAFFIC CONTROL DEVICES; THE LETTERING GUIDE OF THE U.S. D.O.T. F.H.W.A., THE VAOT TRAFFIC DESIGN MANUAL AND THE VAOT STANDARD DRAWINGS.
- ALL TREES AND STUMPS WITHIN THE LIMITS OF PROPOSED CONSTRUCTION ARE TO BE REMOVED UNLESS OTHERWISE INDICATED ON THE PLANS OR DIRECTED BY THE ENGINEER.
- ALL SURFACES DISTURBED BY THIS WORK SHALL BE RESTORED TO THEIR ORIGINAL CONDITION AS DETAILED OR AS SPECIFIED BY THE ENGINEER.
- REMOVE ENTIRELY ALL PAVEMENT, EDGES, WALLS AND OTHER MATERIALS INDICATED TO BE REMOVED. PAVEMENT SHALL BE SAW CUT AND PROTECTED FROM DAMAGE UNTIL NEW PAVEMENT IS PLACED AGAINST IT.
- STRIPPED TOPSOIL SHALL BE STOCKPILED ON THE SITE AS DIRECTED BY THE ENGINEER. NO STRIPPING OF TOPSOIL WILL BE ALLOWED IN ANY AREA WHERE THE GRADES ARE NOT TO BE ALTERED.
- PITCH EVENLY BETWEEN SPOT GRADES. ALL PAVING AREAS MUST PITCH TO DRAIN AT MIN. PITCH OF 1/8" PER FOOT UNLESS OTHERWISE SHOWN. REPORT ANY DISCREPANCIES BETWEEN EXISTING AND PROPOSED GRADES THAT DO NOT PITCH ACCORDINGLY TO THE ENGINEER BEFORE COMMENCING WORK.
- ALL EXISTING MANHOLES AND DRAINAGE STRUCTURES WITHIN THE PROJECT WORK AREA SHALL BE ADJUSTED TO GRADE OR REMODELED UNLESS OTHERWISE NOTED.
- THE MAXIMUM SIDE SLOPE SHALL BE 1:2 EXCEPT IN STONE FILL AND ROCK CUT AREAS.
- IT IS THE INTENT OF THIS CONTRACT THAT ALL EXISTING FEATURES LOCATED OUTSIDE OF SLOPE LIMIT LINES ARE TO REMAIN IN PLACE UNLESS OTHERWISE NOTED.
- IF ROCK IS ENCOUNTERED AT AN ELEVATION HIGHER THAN THE PROPOSED FOOTING THEN IT SHALL BE REMOVED TO A DEPTH THAT WILL ALLOW THE MINIMUM FOOTING THICKNESS SHOWN ON THE PLANS. IF ROCK IS ENCOUNTERED LOWER THAN PROPOSED BOTTOM OF FOOTING, THE CONTRACTOR SHALL FILL THE AREA WITH CONCRETE AS DIRECTED BY ENGINEER.

SOLID ROCK REMOVAL BY VARIOUS METHODS

- CONTROLLED BLASTING FOR SOLID ROCK EXCAVATION AND CLOSE-IN EXCAVATION INCLUDING MECHANICAL ROCK REMOVAL ADJACENT TO SENSITIVE STRUCTURES ASSOCIATED WITH THE RAILWAY BRIDGE REPLACEMENT AND ROADWAY CONSTRUCTION SHALL BE PERFORMED IN ACCORDANCE WITH THE PROJECT SPECIFICATIONS AND CONTRACTORS MEANS AND METHODS APPROVED BY THE ENGINEER.
- ROCK REMOVAL WITHIN 1.5 METERS OF SENSITIVE STRUCTURES IDENTIFIED BY THE ENGINEER SHALL BE COMPLETED USING NON-BLASTING METHODS ONLY.
- ROCK REMOVAL WITHIN 10 METERS OF SENSITIVE STRUCTURES SHALL BE COMPLETED IN ACCORDANCE WITH THE SPECIFICATIONS AND CONTRACTORS APPROVED PLAN FOR CLOSE-IN BLASTING METHODS ONLY.
- THE BLASTING SUB-CONTRACTOR SHALL SUBMIT THE FOLLOWING DOCUMENTS IN ACCORDANCE WITH THE PROJECT SPECIFICATIONS: PLANNED ROCK EXCAVATION METHOD, BLASTER AND DRILLER EXPERIENCE, WORKING DRAWINGS AND SCHEDULE, AND BLASTING PLAN.
- AS OUTLINED IN THE SPECIFICATIONS A PREBLASTING MEETING WILL BE HELD PRIOR TO THE COMMENCEMENT OF BLASTING.
- ALL BLASTING OPERATIONS, INCLUDING DRILLING WITHIN THE RAILROAD RIGHT-OF-WAY, WILL BE COORDINATED WITH THE RAILROAD. NO BLASTING OPERATIONS WILL BE ALLOWED DURING THE PASSAGE OF EITHER A FREIGHT OR PASSENGER TRAIN.

STRUCTURAL STEEL

- ALL STRUCTURAL STEEL SHALL BE DETAILED AND FABRICATED USING PROCEDURES AND TOLERANCES IN ACCORDANCE WITH APPLICABLE PUBLICATIONS OF THE AMERICAN RAILWAY ENGINEERING AND MAINTENANCE-OF-WAY ASSOCIATION (AREMA).
- ANY CONNECTIONS THAT ARE NOT DETAILED ON THE PLANS SHALL BE DETAILED BY THE FABRICATOR AND SUBMITTED TO THE STRUCTURES ENGINEER FOR APPROVAL.
- ALL STRUCTURAL STEEL SHALL CONFORM TO AASHTO M270M/M 270M-93 GRADE 345 W UNLESS OTHERWISE NOTED ON THE PLANS. ALL BOLTS SHALL BE 22MM DIAMETER AASHTO M164M-93 TYPE 3 (7/8" DIAM. ASTM A325 TYPE 3) IN 24MM HOLES UNLESS OTHERWISE NOTED. ANCHOR BOLTS FOR BRIDGE BEARINGS SHALL CONFORM TO AASHTO M164M93 (ASTM A325). NUTS SHALL BE AASHTO M291M-93, GRADE 1053 (ASTM A563 C3 AND CH3), HEAVY HEX NUTS. WASHERS SHALL BE AASHTO M 293M (ASTM F436) WEATHERING STEEL UNLESS NOTED.
- ALL WELDING SHALL CONFORM TO ANSI/AASHTO/AWS D1.5.
- FLOOR BEAMS SHALL BE FABRICATED WITH THEIR NATURAL CAMBER UP.
- ALL GIRDERS ARE FRACTURE CRITICAL MEMBERS (FCM) AND WILL REQUIRE THE FABRICATOR TO FOLLOW THE FRACTURE CONTROL PLAN AS DESCRIBED IN AREMA CHAPTER 15. THE TEST REPORTS AND SPECIMENS SHALL BE DELIVERED TO THE ENGINEER FOR EXAMINATION. ALL CERTIFICATION AND TESTING REQUIREMENTS OF AREMA SHALL BE FOLLOWED AND REPORTS AND DOCUMENTATION SHALL BE PROVIDED TO THE ENGINEER.
- A NAME PLATE SHALL BE ATTACHED, IN A VISIBLE LOCATION, AT THE SOUTH END OF THE EAST GIRDER. THE NAME PLATE SHALL SHOW THE NAME OF THE MANUFACTURER AND THE YEAR OF CONSTRUCTION.
- THE FLOOR PLATE SHALL BE SPLICED AS NECESSARY ALONG THE CENTERLINE OF THE TRANSVERSE FLOOR BEAMS.
- THE CURB PLATES SHALL BE SPLICED AS NECESSARY ALONG THE CENTERLINE OF THE KNEE BRACES.
- AFTER FIELD WELDING THE FLOOR AND CURB PLATES THE 100mm DIAMETER HOLES SHALL BE FILLED WITH NON SHRINK GROUT BEFORE APPLICATION OF THE WATERPROOF MEMBRANE. THE NON SHRINK SHALL BE TYPED IV PER VAOT STANDARD SPECIFICATION 707.03.
- THE FOLLOWING ELEMENTS ARE INCLUDED IN THE STRUCTURAL STEEL BID ITEMS:
 - 506.50 STRUCTURAL STEEL (ROLLED BEAM): FLOORBEAMS, DIAPHRAMS, STIFFENER PLATES
 - 506.55 STRUCTURAL STEEL (PLATE GIRDER): GIRDER W/KNEEBRACE, INTERMEDIATE STIFFENERS, BEARING STIFFENERS, CONNECTION PLATE, END PLATE, CURB APRON PLATE CONNECTION ANGLE, STIFFENER PLATES.
 - 506.60 STRUCTURAL STEEL CONNECTION ANGLES, BALLAST PLATE, CURB PLATE, CURB APRON PLATE, SEAL PLATE, STIFFENING ANGLE FOR BALLAST END PLATE, BOLTS, UTILITY SUPPORTS, PARAPET PLATE, GALVANIZED DRAIN PIPE W/CAPS FITTINGS AND U-BOLTS.
 - 531.10 BEARING DEVICE ASSEMBLY: FIXED BEARINGS, EXPANSION BEARINGS, BEARING PADS, AND ANCHOR BOLTS.
- TEFLON BEARING MATERIALS SHALL BE "LUBRITE F" AS MANUFACTURED BY MERRIMAN INC. 100 INDUSTRIAL PARK ROAD, WINGHAM, MA 02043, OR APPROVED EQUAL.
- BEARING SHALL BE SHOP FITTED TO GIRDER, MATCHMARKED. THEN ASSEMBLED IN UNITS FOR SHIPMENT.

CONCRETE

- NO LIVE LOAD SHALL BE ALLOWED ON NEW CONCRETE UNTIL THE CURE PERIOD IS UP AND THE 28-DAY DESIGN STRENGTH IS ATTAINED, AS EVIDENCED BY TEST CYLINDERS CURED UNDER FIELD CONDITIONS.
- THE KEY IN CONCRETE CONSTRUCTION JOINTS SHALL BE MONOLITHIC AND CONTINUOUS FOR THE FULL LENGTH OF THE JOINT; ANY UPWARD KEY SHALL BE PLACED INTEGRALLY WITH THE CONCRETE BELOW THE JOINT.
- ALL EXPOSED EDGES OF CONCRETE SHALL BE CHAMFERED 25mm BY 25mm OR AS OTHERWISE INDICATED ON THE PLANS.
- JOINTS AND SCORE MARKS IN CONCRETE SHALL BE CONSTRUCTED AS INDICATED ON THE PLANS OR AS DIRECTED BY THE ENGINEER.
- ALL CONCRETE REINFORCING STEEL SHALL BE AASHTO M31/M 31 GRADE 420 BILLET STEEL BARS.
- ALL REINFORCING STEEL SHALL BE DETAILED AND FABRICATED USING PROCEDURES AND TOLERANCES IN ACCORDANCE WITH APPLICABLE PUBLICATIONS OF THE CONCRETE REINFORCING STEEL INSTITUTE (CRSI).
- REINFORCING PLACEMENT TOLERANCES SHALL BE:
 - SPACING ±20mm
 - CLEARANCE ±5mm
- MINIMUM COVER FOR REINFORCING STEEL SHALL BE 50mm ALONG THE BACK FACE OF WALLS AGAINST EARTH, 65mm ALONG THE TOP SURFACE OF THE DECK, 40mm ALONG THE BOTTOM SURFACE OF THE DECK AND 80mm ELSEWHERE, UNLESS OTHERWISE NOTED.
- WATER REPELLENT SHALL BE APPLIED TO ALL EXPOSED CONCRETE SURFACES EXCEPT THE UNDERSIDE OF THE DECK BETWEEN THE DRIP BEADS.
- ALL CONCRETE SHALL BE CONSTRUCTED WITH CONCRETE, HIGH PERFORMANCE CLASS A. USE A 20mm STONE AGGREGATE FOR BACKWALL AND BRIDGE SEATS.
- AT LOCATIONS SHOWN ON THE PLANS, MECHANICAL SPLICES SHALL BE INSTALLED PER MANUFACTURERS RECOMMENDATIONS TO ALLOW FOR THE STAGED CONSTRUCTION OF THE ROUTE 9 BRIDGE ABUTMENTS.
- ELASTOMERIC BEARINGS FOR THE PRECAST CONCRETE SLABS AT THE SARGENT BROOK BRIDGE SHALL BE PROVIDED AS SHOWN ON THE PLANS AND IN ACCORDANCE WITH AREMA, CHAPTER 19. THE DESIGN LIVE LOAD AND IMPACT PER BEARING IS 74.3KN (167K), AND THE DESIGN DEAD LOAD PER BEARING IS 347KN (78K).

TRACK MONITORING

- THE CONTRACTOR SHALL PREPARE AND INSTITUTE AN INSTRUMENTATION MONITORING PROGRAM TO MONITOR THE TIE BACK LOAD CELLS AND TRACK SURFACE AND ALIGNMENT THROUGHOUT THE SOLID ROCK REMOVAL, AND INSTALL AND REMOVAL OF THE TEMPORARY EXCAVATION SUPPORT OF TRACK AND EMBANKMENT STRUCTURES. TWO LOAD CELLS SHALL BE INSTALLED FOR EACH WALER LEVEL (TYPICAL EACH ABUTMENT).
- THE RAILROAD HAS IDENTIFIED THE FOLLOWING INSTRUMENTATION AND MONITORING SCHEDULE:

DESCRIPTION	TIEBACK LOAD CELLS	SURFACE SURVEY POINTS	COMMENTS
INSTRUMENT INSTALLATION	X	X	SEE NOTE 3
IMMEDIATELY FOLLOWING EACH BLAST WITHIN 30m (100 feet) OF TRACK	X	X	PRIOR TO PASSING OF TRAIN
AFTER EACH EXCAVATION STAGE	X	X	PRIOR TO PASSING OF TRAIN
JUST PRIOR TO TIEBACK INSTALLATION	X	X	
JUST AFTER TIEBACK INSTALLATION	X	X	
AS DIRECTED BY THE ENGINEER	X	X	
WEEKLY UNTIL LOAD CELLS ARE REMOVED	X	X	
WEEKLY UNTIL EXCAVATION IS BACKFILLED	X	X	




- THE CONTRACTOR SHALL SUBMIT DETAILS OF AN INITIAL READING PROGRAM TO ASSURE ACCURATE READINGS FOR INITIAL ZERO MEASUREMENTS. THE CONTRACTOR SHALL PERFORM THE INITIAL READING PROGRAM IN THE PRESENCE OF THE ENGINEER AND THE RAILROAD. THE INITIAL READINGS SHALL INCLUDE LOAD CELL CALIBRATION CERTIFICATES FOR EACH LOAD CELL PRIOR TO START OF CONSTRUCTION TO SHOW ACCURACY OF THE INITIAL READINGS AND RELIABILITY OF THE INSTRUMENTS.
- THE CONTRACTOR SHALL ESTABLISH A SERIES OF SURVEY STATIONS ON 5 METER STATIONS ON THE TOP OF EACH RAIL ADJACENT TO EXCAVATION LOCATIONS AS SHOWN ON THE CONTRACT DOCUMENTS. (SEE SHEETS 85, 86, 93 & 94) SIMILARLY, SURVEY STATIONS SHALL ALSO BE ESTABLISHED ALONG THE TOP OF THE EXCAVATION SUPPORT ON 3-METER CENTERS OR ON EACH SOLDIER PILE FOR SOLDIER PILE AND LAGGING WALLS. AT THE BEGINNING AND END OF EACH DAY, THE STATIONS SHALL BE SURVEYED FOR ELEVATION AND PLAN LOCATIONS. ANY EXCAVATION SUPPORT SYSTEM OR RAIL DISPLACEMENT CAUSED BY ADVANCEMENT OF THE EXCAVATIONS OR OTHER CONSTRUCTION ACTIVITY SHALL BE REPORTED IMMEDIATELY TO THE ENGINEER. RAIL DISPLACEMENT OF 8 MM OR MORE SHALL BE REPORTED TO THE ENGINEER AND RAILROAD IMMEDIATELY SO REPAIR OF THE RAILWAY CAN BE INITIATED AND RAIL TRAFFIC CAN RESUME AS QUICKLY AS POSSIBLE. DISPLACEMENT OF RAILS OF 8 MM OR MORE WILL REQUIRE REPAIR OF THE RAILS AT CONTRACTORS SOLE COST. CHARGES FOR DELAY OF NORMAL TRAIN SERVICE WILL BE ASSESSED IN ACCORDANCE WITH THE RIGHT-OF-WAY FINANCE AND MAINTENANCE AGREEMENT, ATTACHMENT *3 GENERAL STATEMENT OF CONDITIONS CAUSING RAILROAD HAZARDS, IF THE RAILROAD IS NOT ABLE TO OPERATE TRAINS DUE TO RAIL DISPLACEMENT VARYING FROM PRE-CONSTRUCTION CONDITIONS.

PROJECT:	BRATTLEBORO	PROJECT NO.:	NH 010-2(2)
DESIGN FILE NAME:	U:\99123-Brattleboro\dgn\BrTRR500.dgn	IPARM FILE NAME:	PLOT DATE: 10-03-2002
SHEET: 7 OF 145			

TYPICAL ROADWAY SECTIONS

MATERIAL ITEM	THICKNESS TOLERANCE
PAVEMENT (TOTAL DEPTH ALL LAYERS)	+/- 5
SUBBASE	+/- 30
SAND BORROW	+/- 30

50 BITUMINOUS CONCRETE PAVEMENT (TYPE IIS) (PG 70-28)
 75 BITUMINOUS CONCRETE PAVEMENT (TYPE IIS) (PG 70-28)
 150 BITUMINOUS CONCRETE PAVEMENT (TYPE IS) (PG 70-28) (2-75 mm LIFTS)
 600 SUBBASE OF DENSE GRADED CRUSHED STONE
 250 SAND BORROW

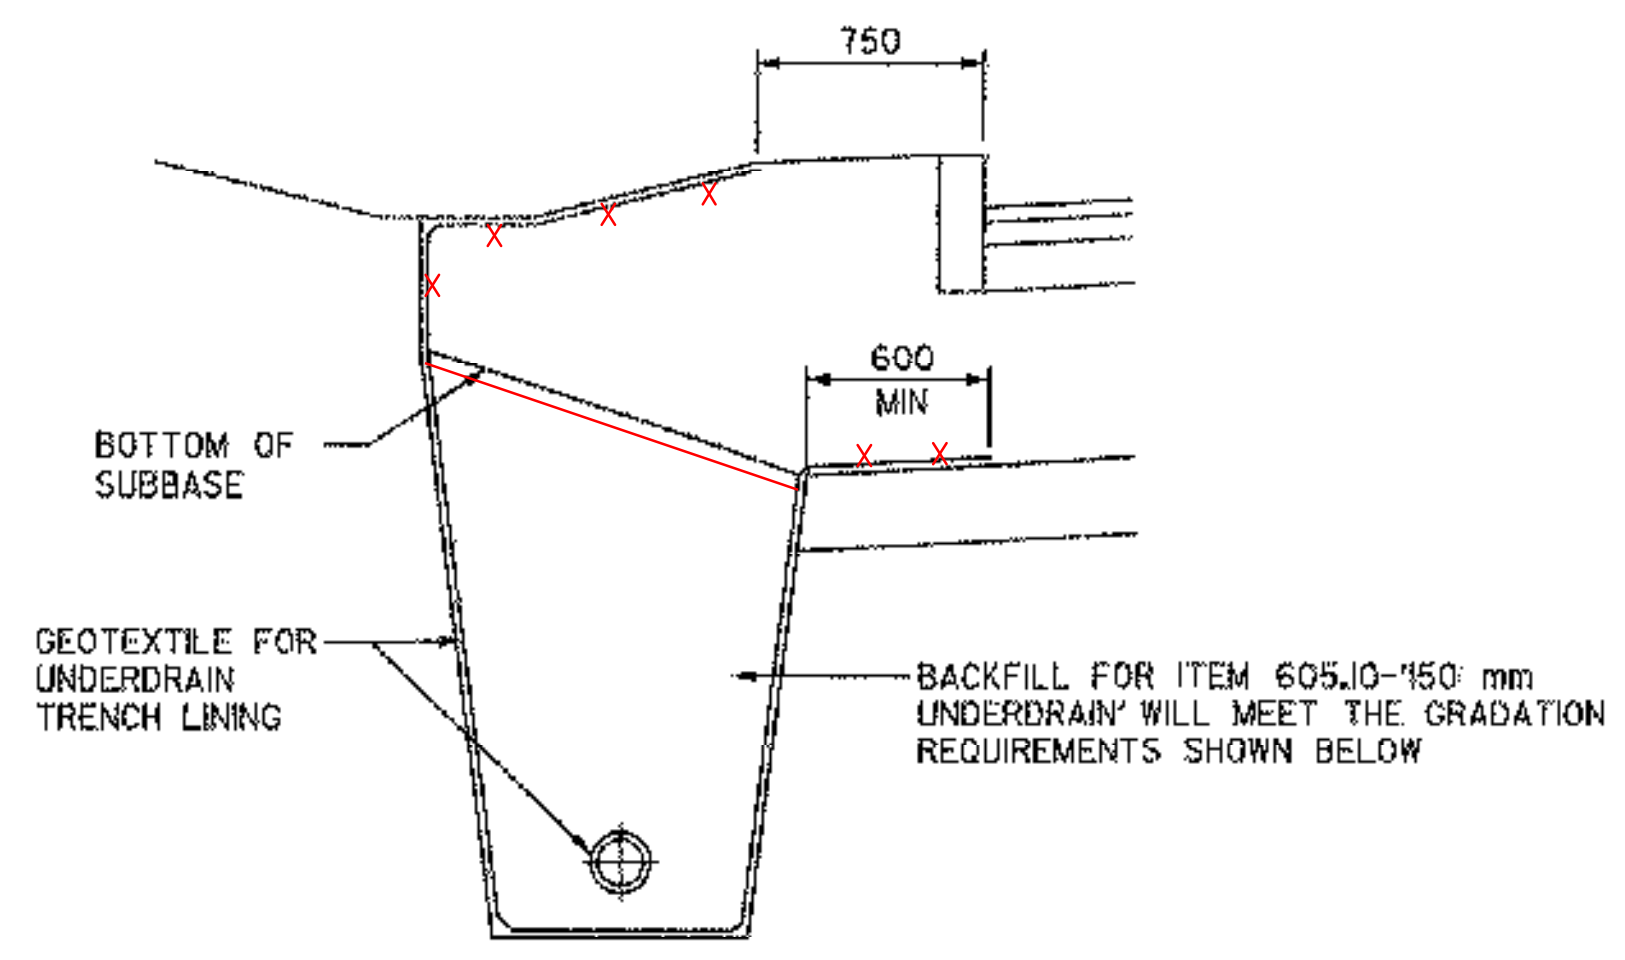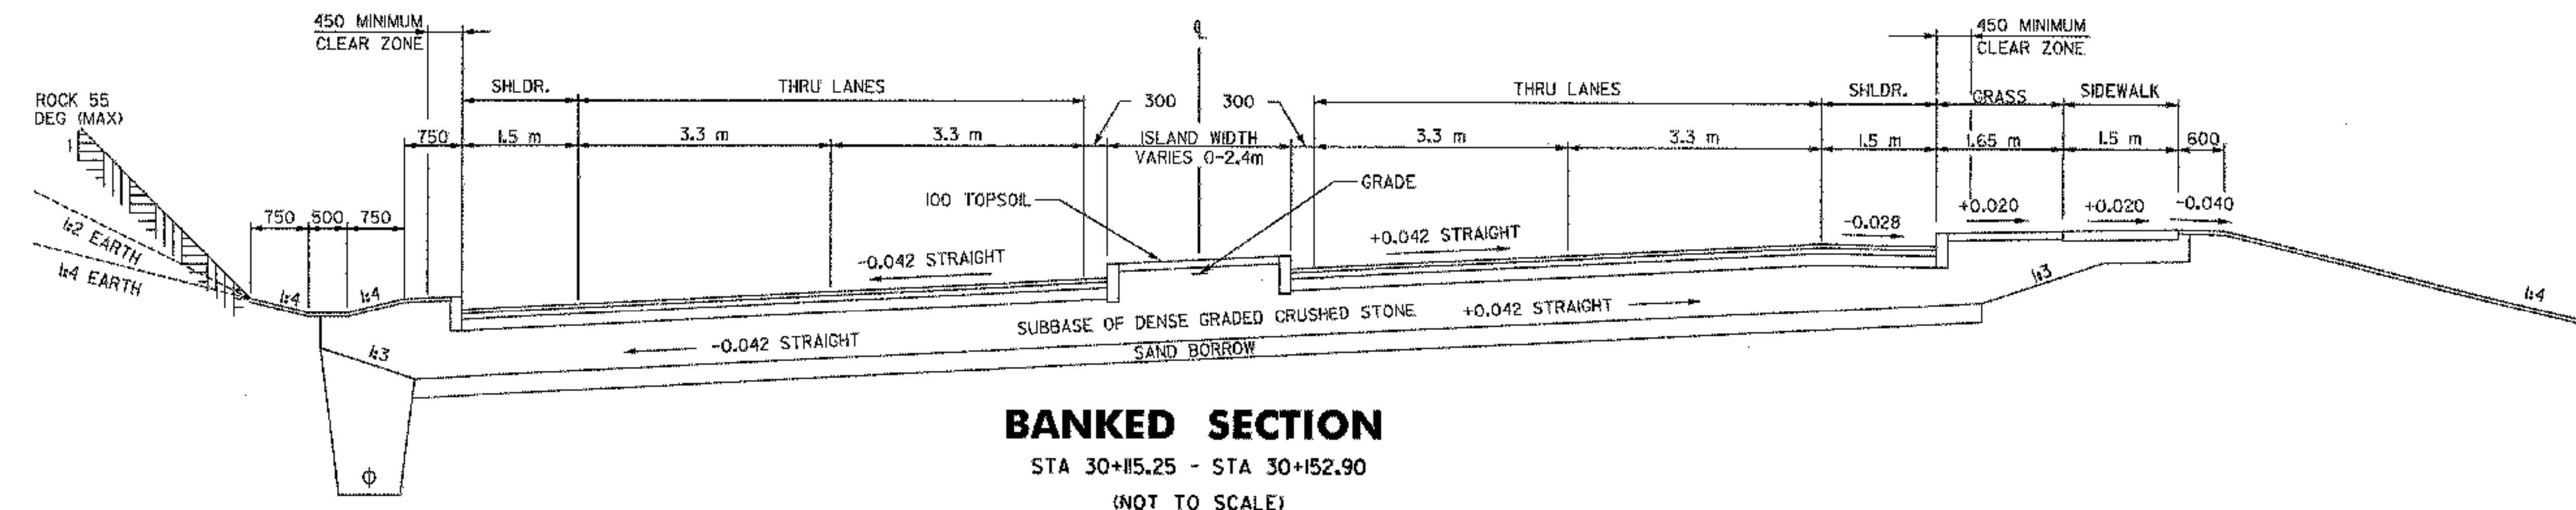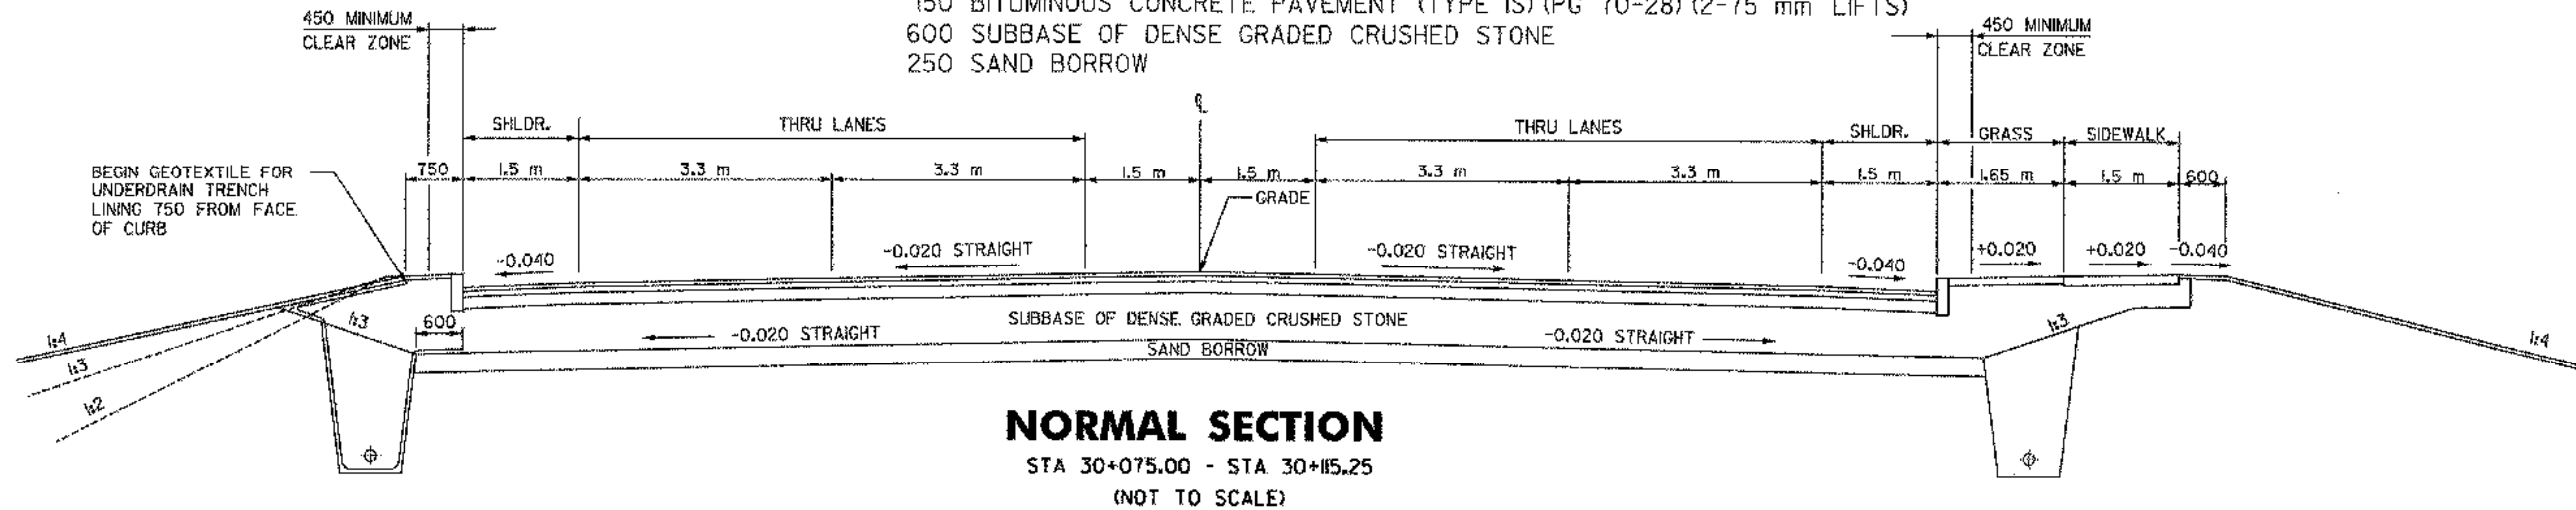

NOTE: REFER TO STANDARD D-2M FOR ADDITIONAL INFORMATION.

SIEVE SIZE (mm)	PERCENT BY WEIGHT PASSING THE SQUARE MESH SIEVE
37.5	100
25.0	95-100
12.5	60-80
4.75	40-55
2.36	5-25
1.18	0-12
300µm	0-5


DATUM	
VERTICAL	NGVD 1929
HORIZONTAL	NAD 1983

SEEDING FORMULA URBAN AREAS

% MASS	kg/ha	NAME	PUR %	GERM %
42.5	38.0	CREeping RED FESCUE	98	85
10.0	9.0	PERENNIAL RYE GRASS	95	90
42.5	38.0	KENTUCKY BLUE GRASS	85	85
5.0	5.0	ANNUAL RYE GRASS	95	85
100.0	90.0			

GENERAL NOTES

- SEED MIXTURE: SHALL NOT HAVE A WEED CONTENT EXCEEDING 0.40% BY MASS AND SHALL BE FREE OF ALL NOXIOUS SEED.
- SEED: TO BE APPLIED PER SEEDING FORMULAS OR AS DIRECTED BY THE ENGINEER.
- FERTILIZER: FORMULA 10-20-10, TO BE USED WITH SEED, APPLIED AT THE RATE OF 560 kg/ha. (HYDRO SEEDERS MAY USE 19-19-19 FORMULA).
- AGRICULTURAL LIMESTONE: TO BE APPLIED AT THE RATE OF 4500 kg/ha, OR AS DIRECTED BY THE ENGINEER.
- HAY MULCH: TO BE PLACED ON EARTH SLOPES AT THE RATE OF 4500 kg/ha, OR AS DIRECTED BY THE ENGINEER.
- TOPSOIL: TO BE USED WITH SEED AS INDICATED ON THE PLANS, OR AS DIRECTED BY THE ENGINEER.
- MARKER-POSTS: TO BE PLACED AS INDICATED OR AS DIRECTED BY THE ENGINEER.
- SLOPE ROUNDING: ALL CUT SLOPES TO BE ROUNDED IN ACCORDANCE WITH STD SHEET 8-5M. SLOPE LINES SHOWN ON THE PLANS AND CROSS SECTIONS DO NOT SHOW THE SLOPE ROUNDING.
- PAY LIMITS OF SAND BORROW: WHEN USED IN CONJUNCTION WITH UNDERDRAIN - SEE STANDARD SHEET D-2M.
- TACK COAT: EMULSIFIED ASPHALT IS TO BE APPLIED AT THE RATE OF 0.07 L/m² BETWEEN SUCCESSIVE COURSES OF PAVEMENT AS DIRECTED BY THE ENGINEER.

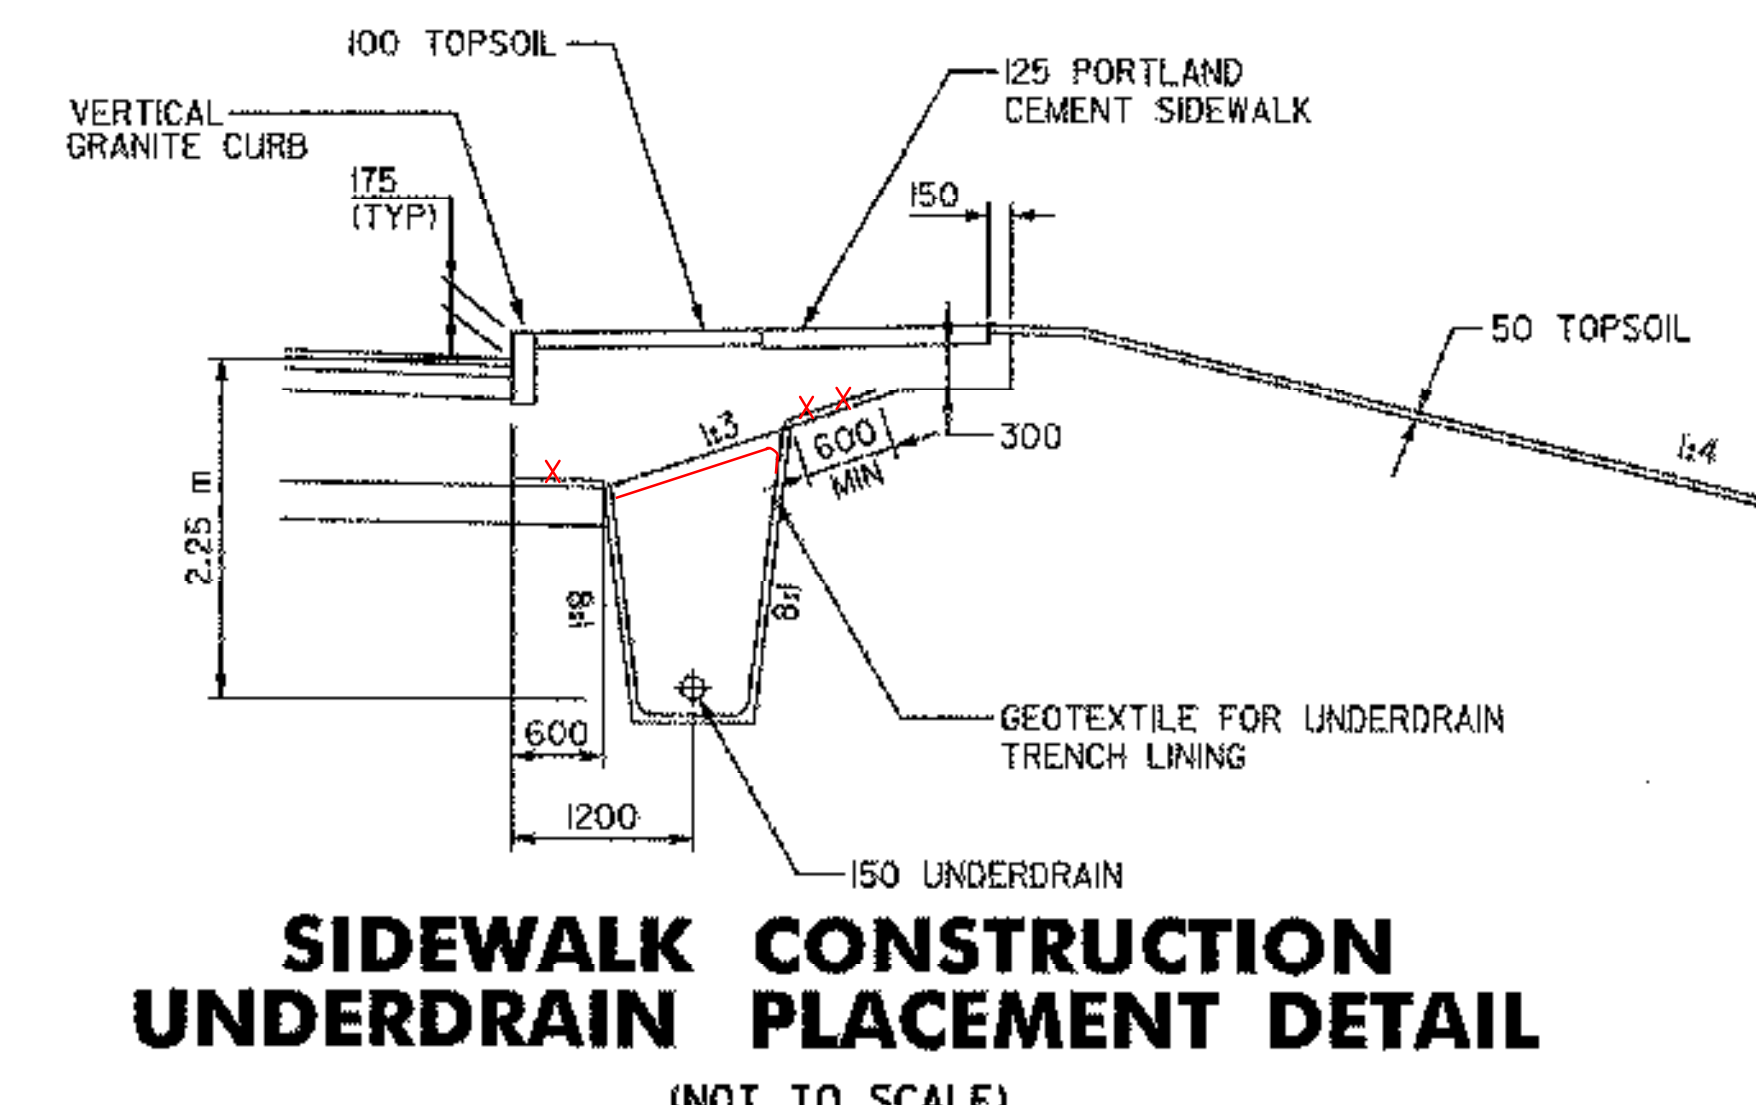






NOTE: UNLESS OTHERWISE NOTED IN THESE PLANS, ALL ELEVATIONS ARE IN METERS AND ALL DIMENSIONS ARE IN MILLIMETERS

PROJECT: BRATTLEBORO	PROJECT NO.: NH 010-2(2)
DESIGN FILE NAME: ...zb270+yp.dgn	PLOT DATE: 09/20/2002
IPARM FILE NAME:	SURVEY DATE:
SURVEYED BY:	SQUAD LEADER: W HUSBAND
CLD REF NO. 00-0358	DRAWN BY: P SHEDD
	SHEET: 8 OF 145

TYPICAL ROADWAY SECTIONS

MATERIAL ITEM	THICKNESS TOLERANCE
PAVEMENT (TOTAL DEPTH ALL LAYERS)	+/- 5
SUBBASE	+/- 30
SAND BORROW	+/- 30

- 50 BITUMINOUS CONCRETE PAVEMENT (TYPE IIS) (PG 70-28)
- 75 BITUMINOUS CONCRETE PAVEMENT (TYPE IIS) (PG 70-28)
- 150 BITUMINOUS CONCRETE PAVEMENT (TYPE IS) (PG 70-28) (2-75mm LIFTS)
- 600 SUBBASE OF DENSE GRADED CRUSHED STONE
- 250 SAND BORROW (IN EARTH AREAS)
- 75 SAND BORROW (IN ROCK AREAS)

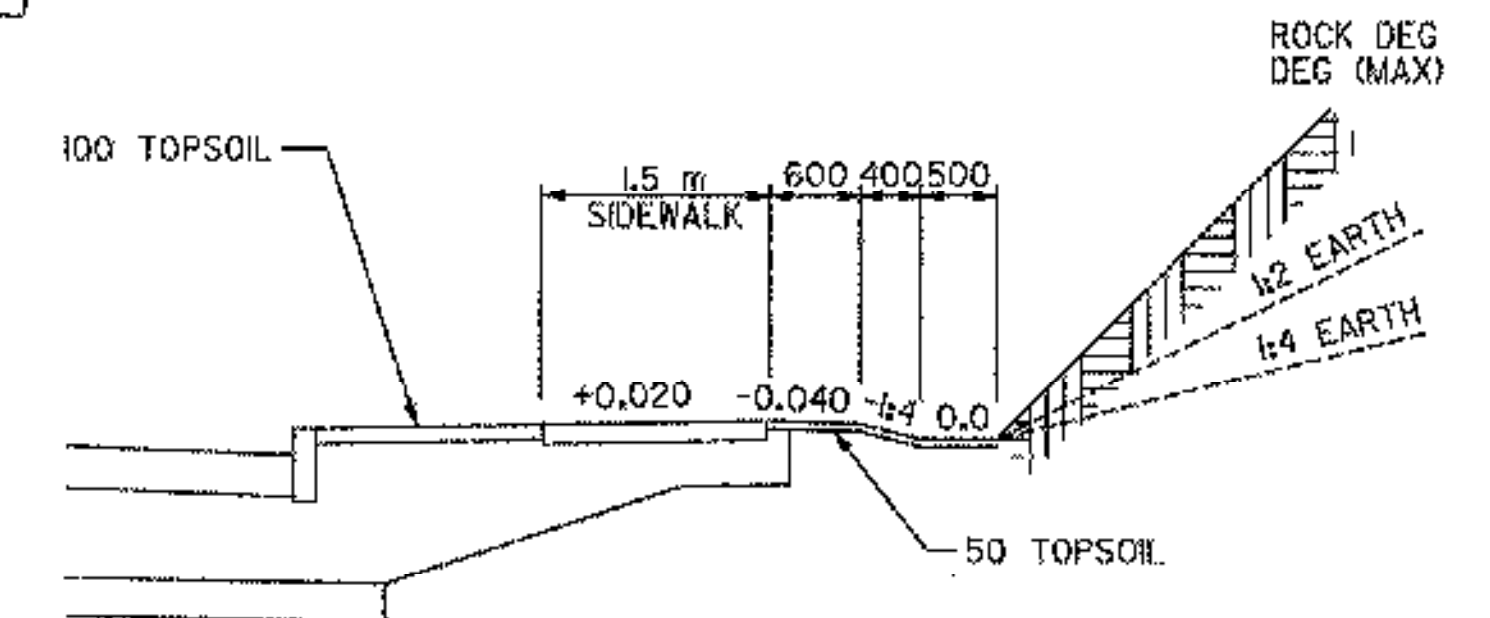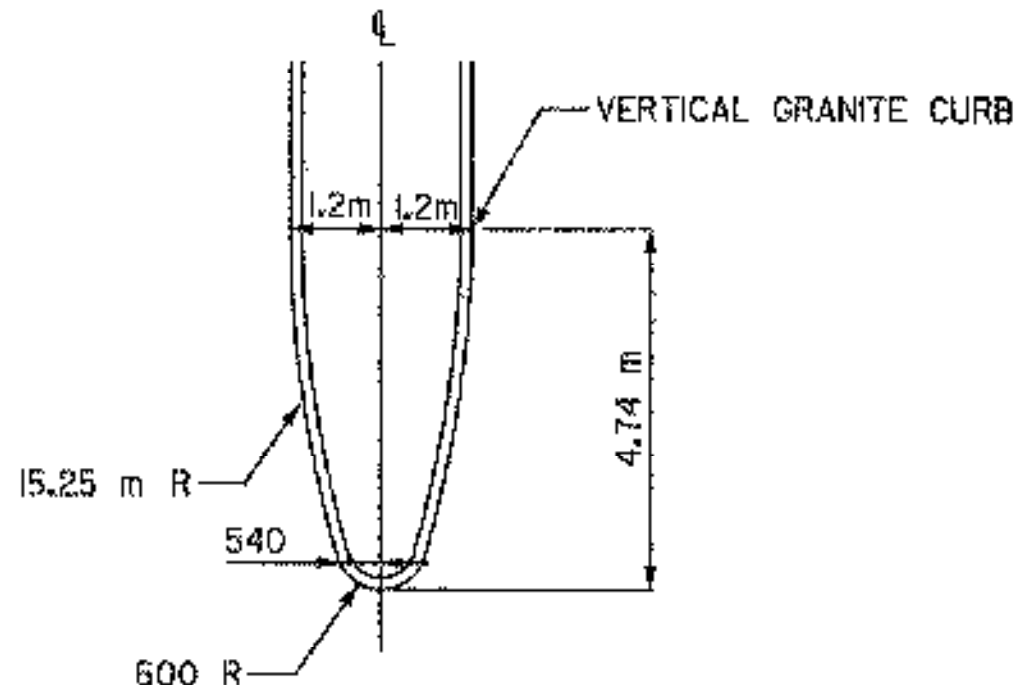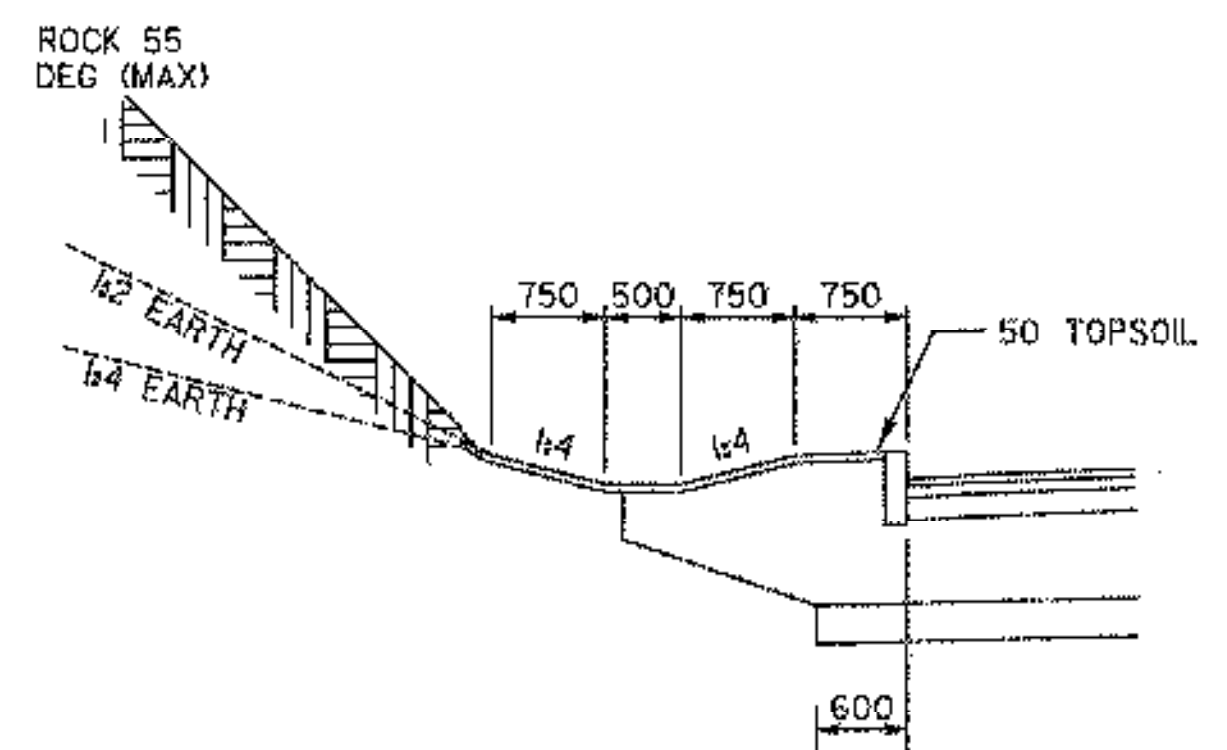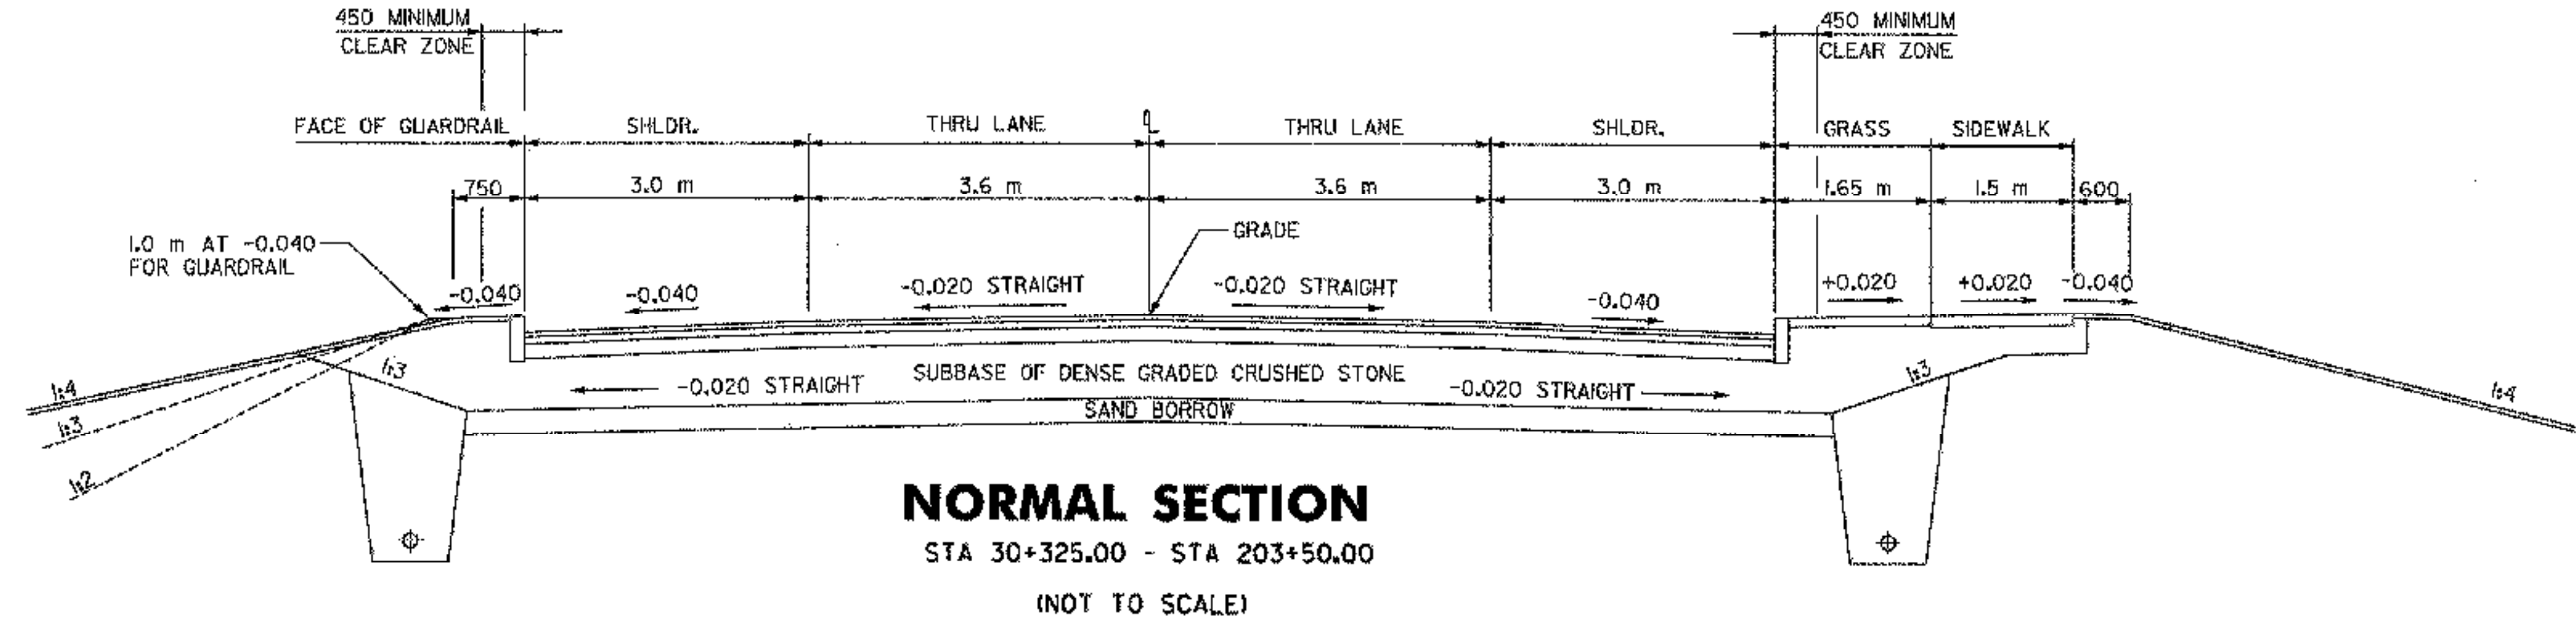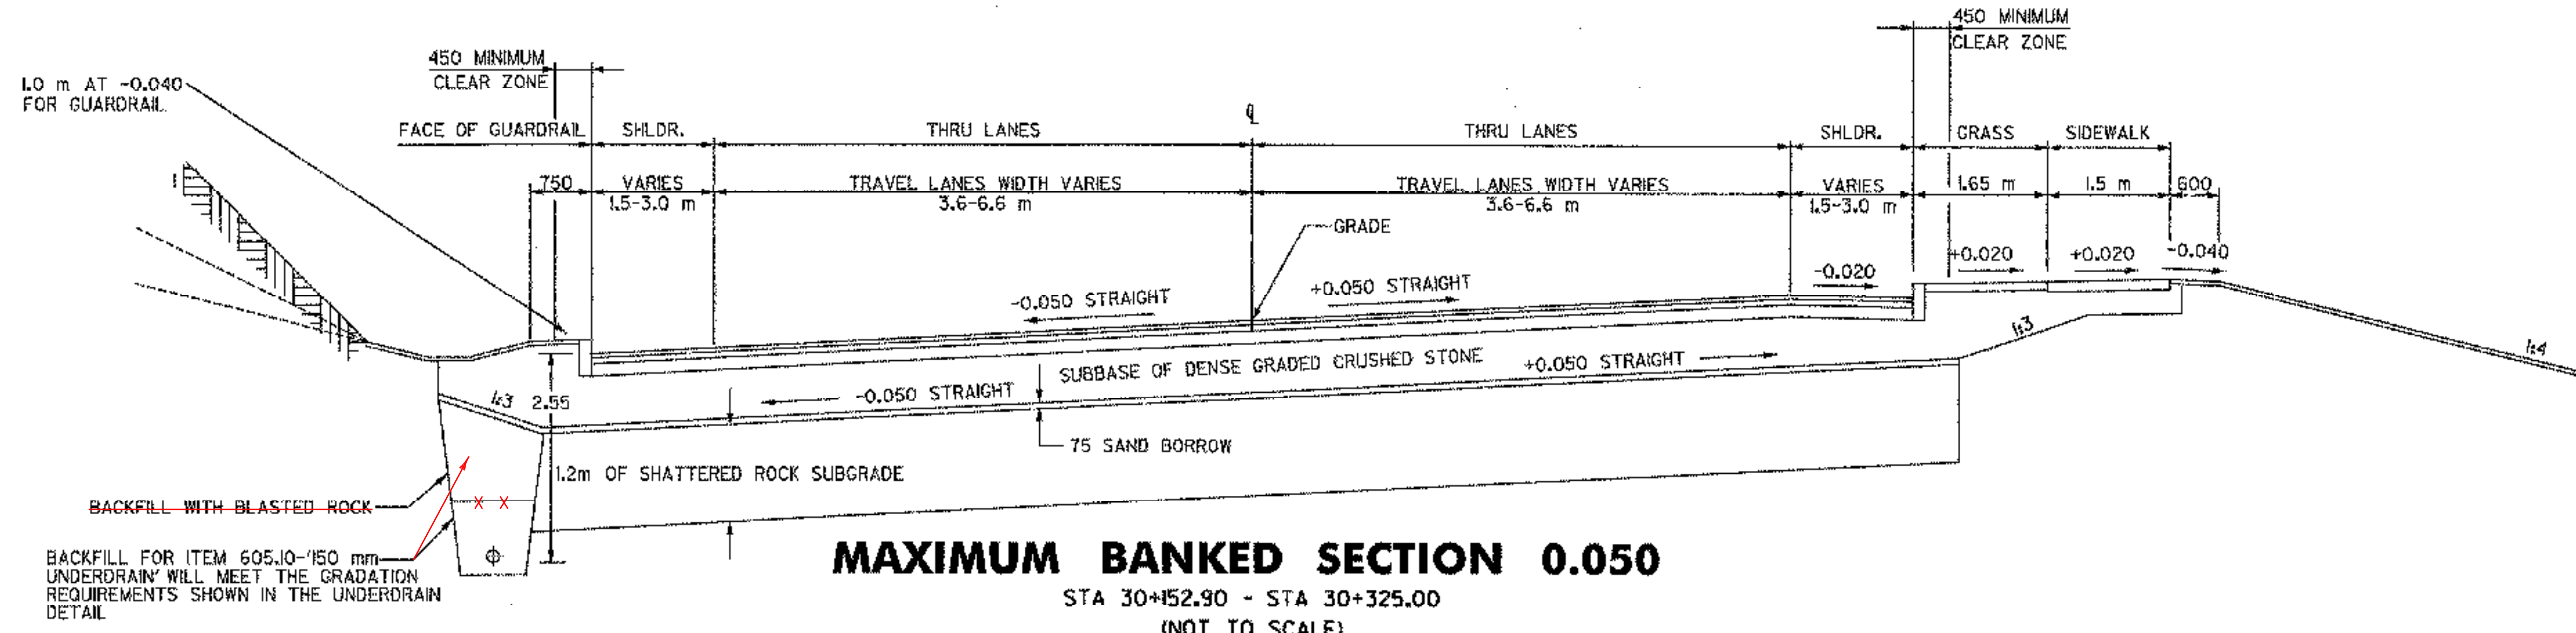


DITCH AND BACKSLOPE DETAIL FOR SIDEWALK

NOTE: UNLESS OTHERWISE NOTED IN THESE PLANS, ALL ELEVATIONS ARE IN METERS AND ALL DIMENSIONS ARE IN MILLIMETERS


DATUM	
VERTICAL	NGVD 1929
HORIZONTAL	NAD 1983

PROJECT:	BRATTLEBORO	PROJECT NO.:	NH 010-2(2)
DESIGN FILE NAME:	...zb270+yp.dgn	PLOT DATE:	09/20/2002
IPARM FILE NAME:		SURVEY DATE:	
SURVEYED BY:		DRAWN BY:	P SHEDO
SQUAD LEADER:	W HUSBAND	SHEET:	9 OF 145
CLD REF NO.:	00-0356		

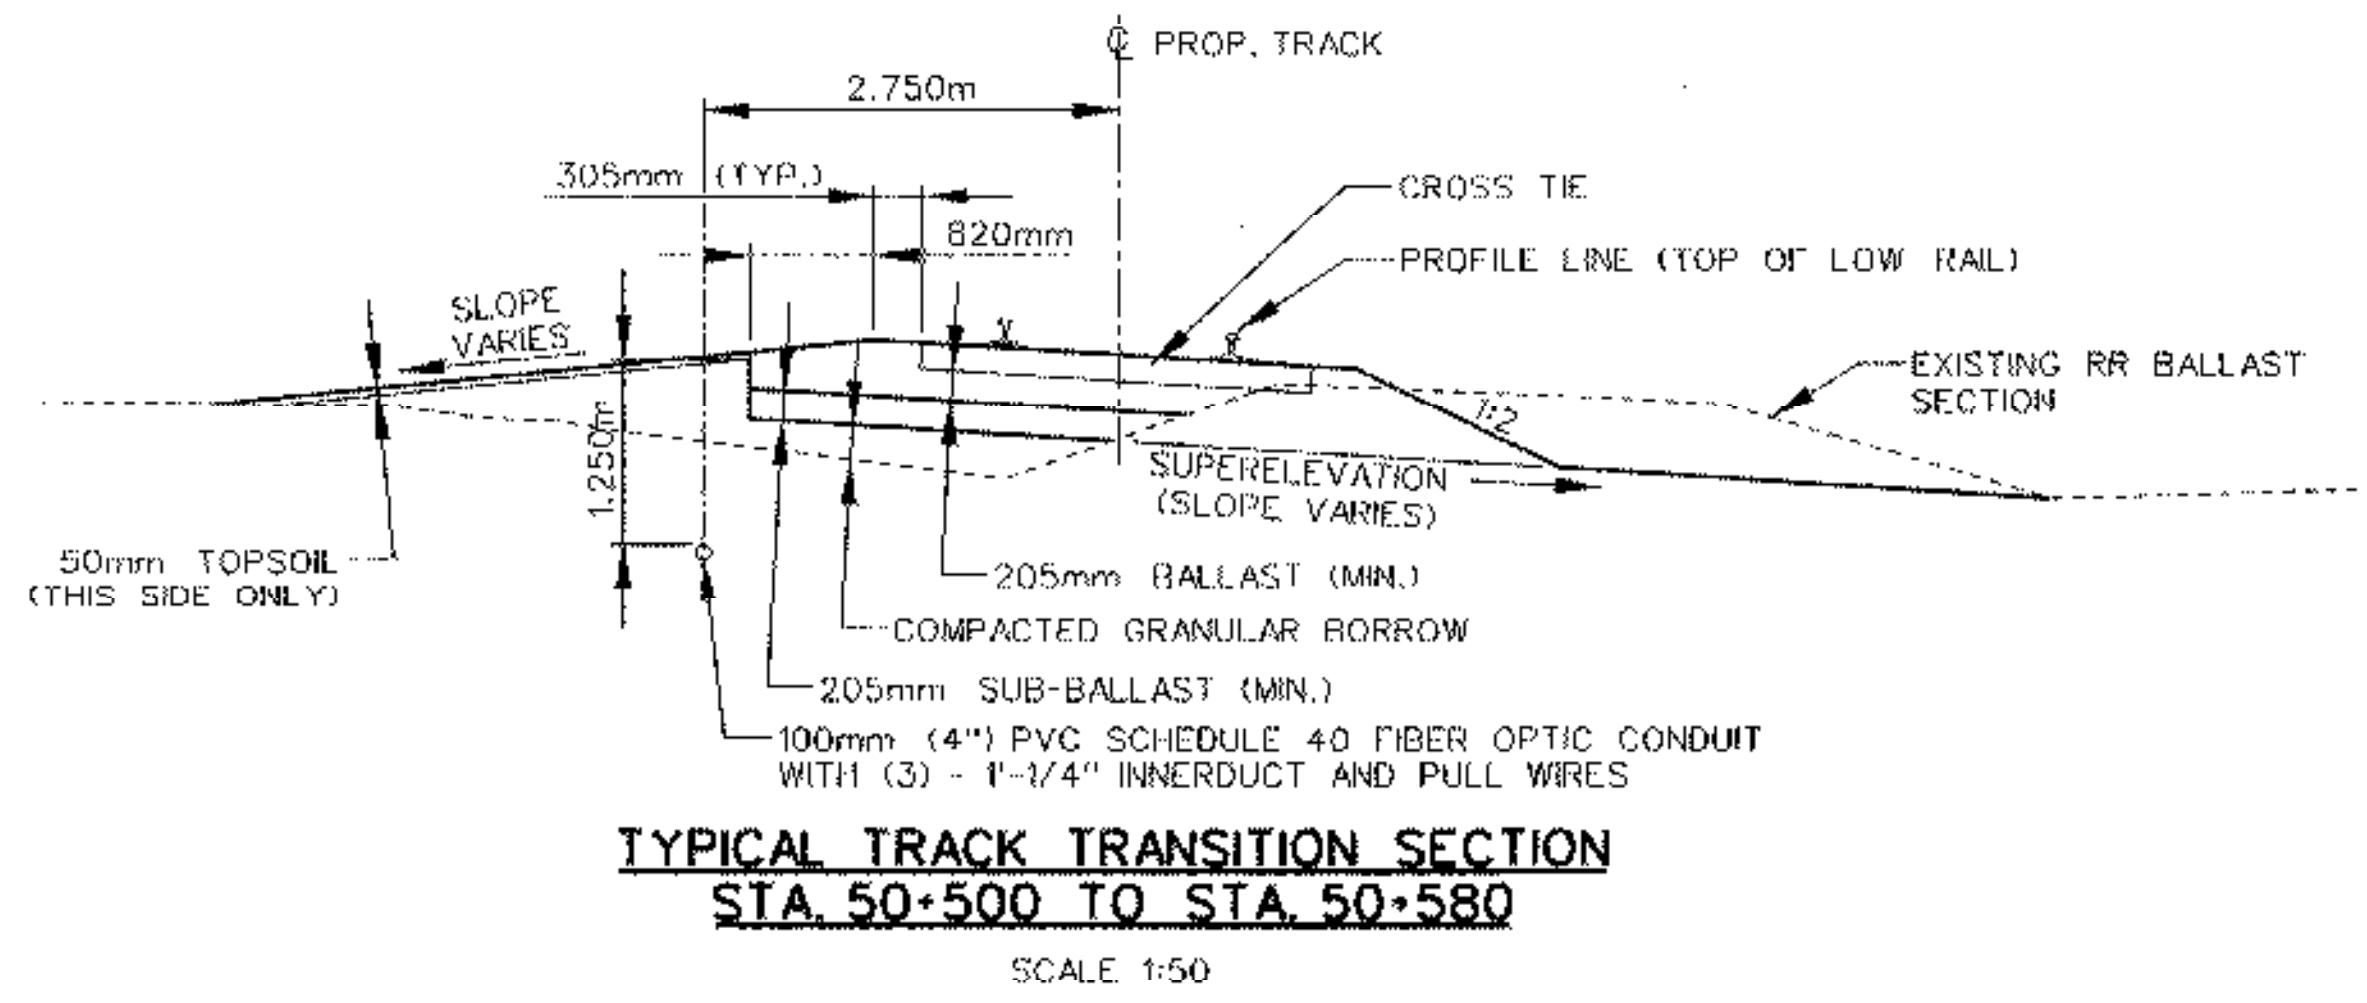


**TYPICAL TRACK TRANSITION SECTION
STA 50+500 TO STA 50+580**

SCALE 1:50

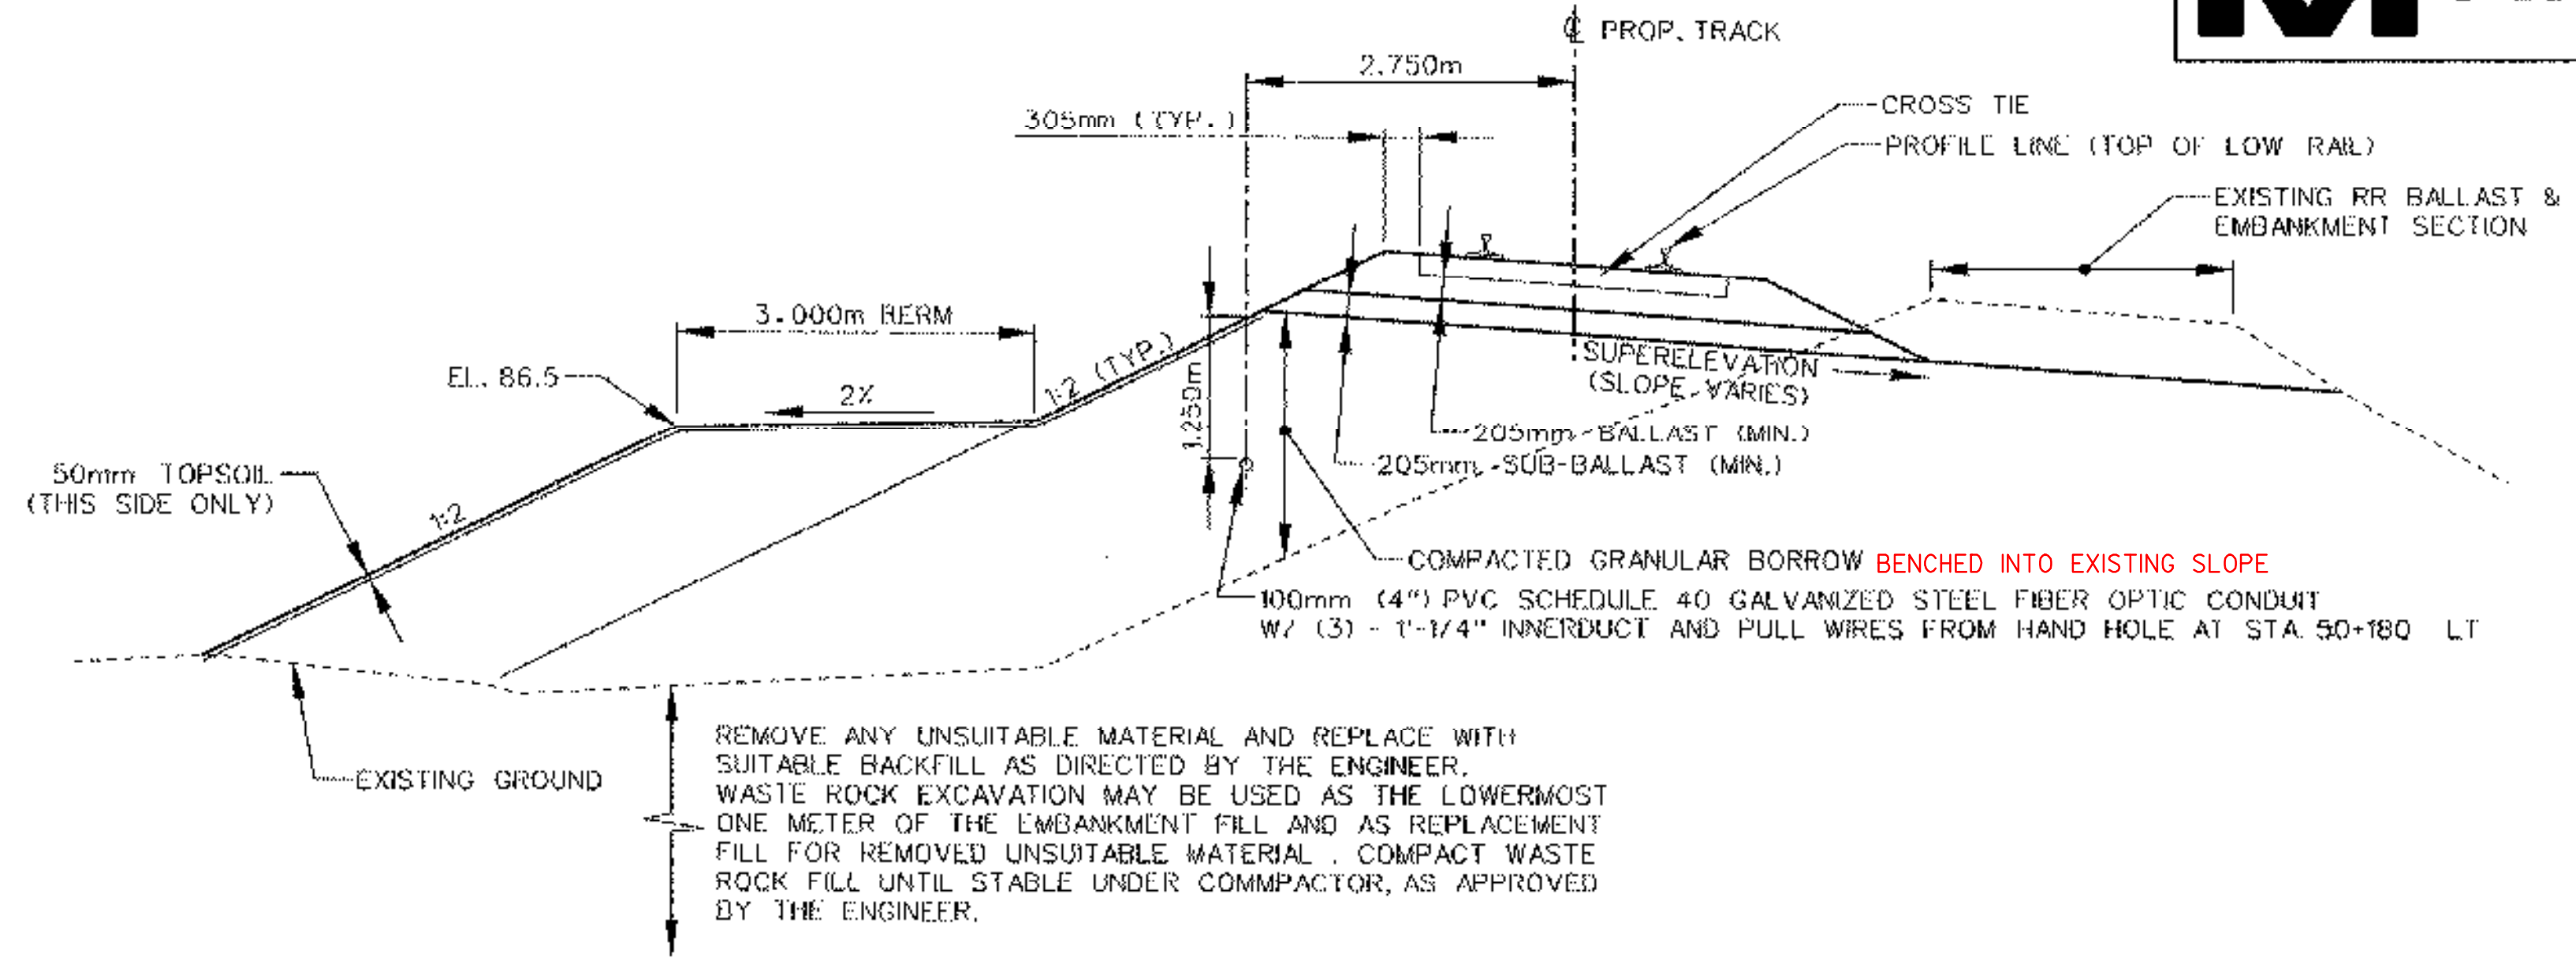

**TYPICAL BERM SECTION
FULL DEPTH CONSTRUCTION
STA 50+193.123 TO STA 50+254.520
(SARGENT BROOK TO VT ROUTE 9)**

SCALE 1:50

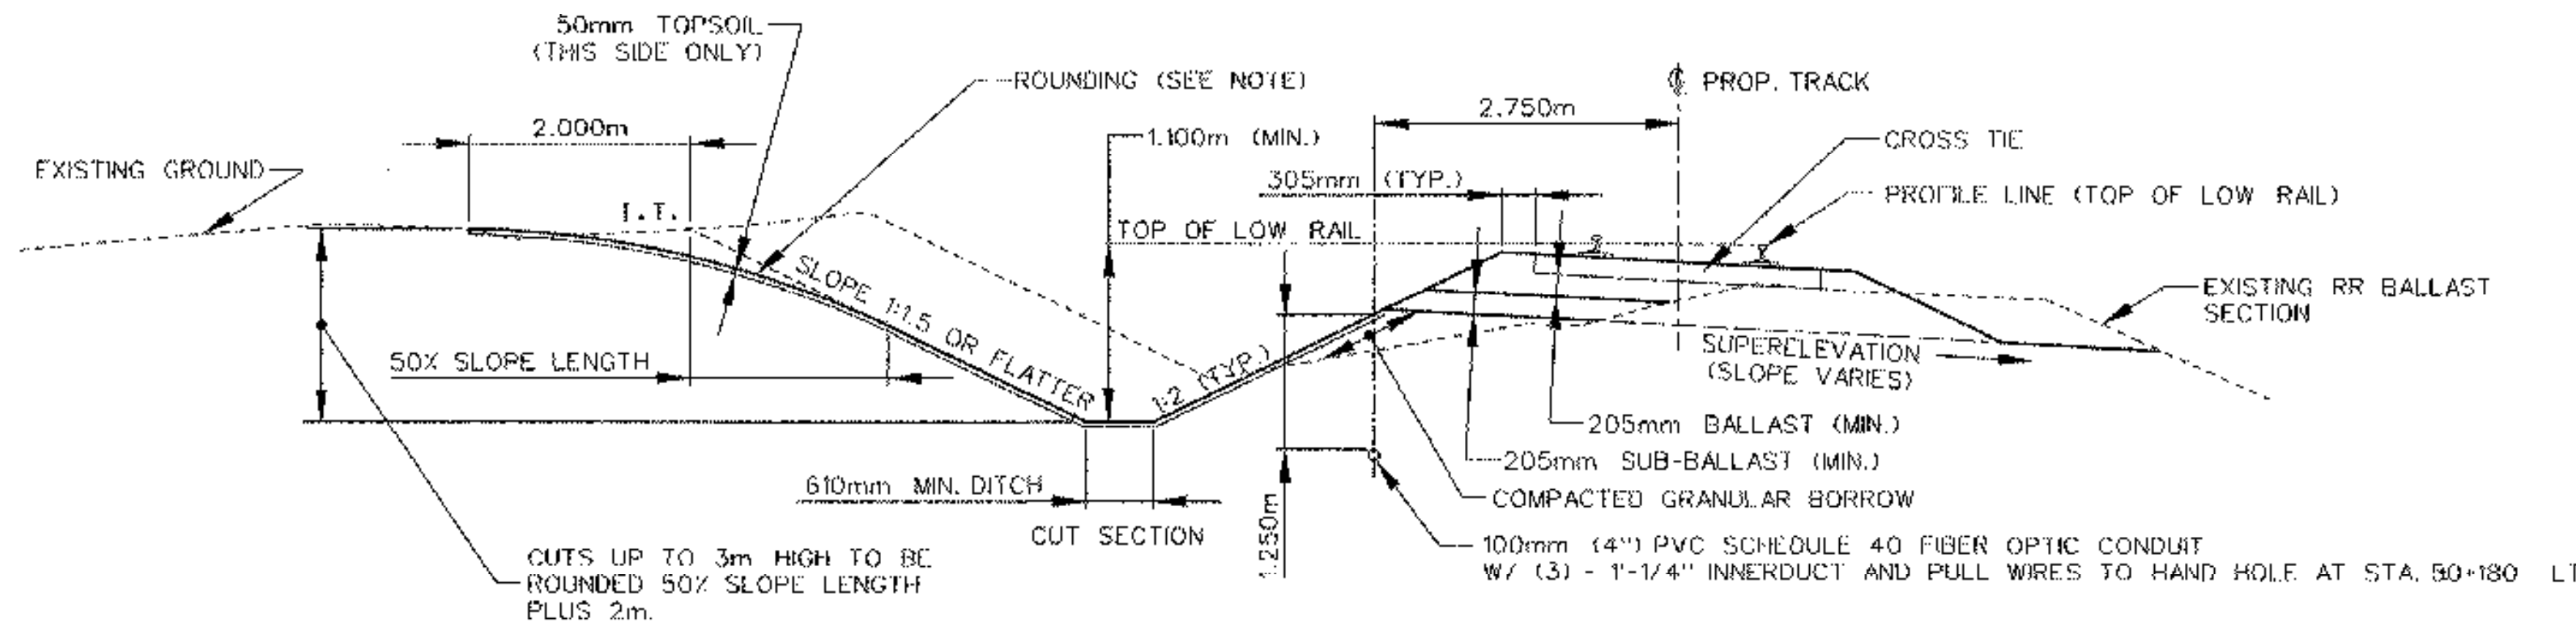


**TYPICAL TRACK TRANSITION SECTION
STA 50+120 TO STA 50+186.417**

SCALE 1:50


NOTE:

WHEN STEEPNESS OF EXISTING GROUND, SHALLOWSNESS OF CUT OR PRESENCE OF EXISTING VEGETATION OR BUILDINGS IS CONSIDERED A FACTOR PREVENTING NORMAL ROUNDING, THE EXTENT OF THE ROUNDING SHOULD BE MODIFIED TO MEET CONDITIONS. SEE NOTE 3.

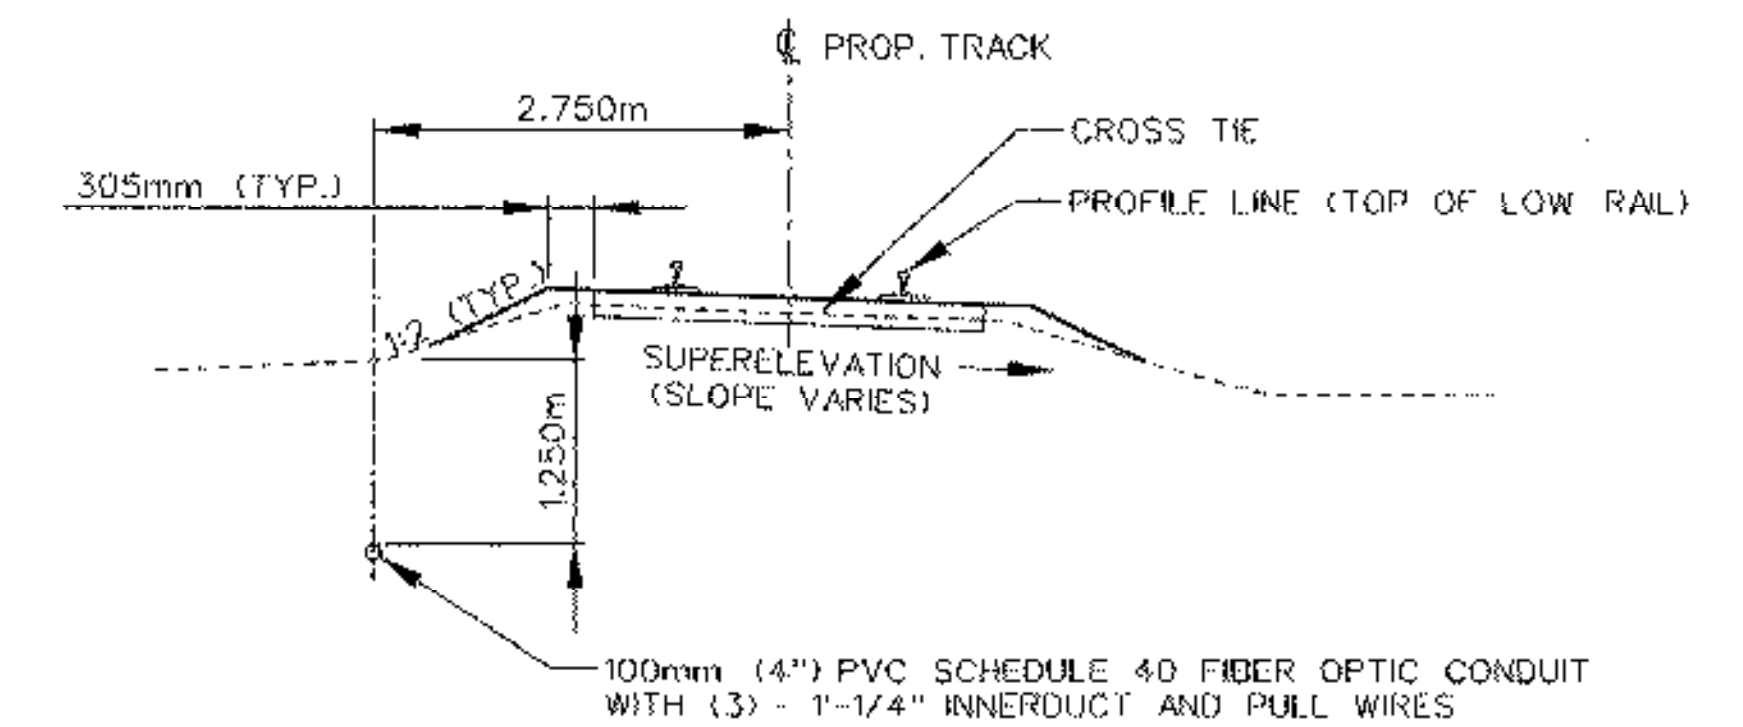

**TYPICAL TRACK REHABILITATION SECTION
STA 50+020 TO STA 50+120
STA 50+580 TO STA 50+698.603**

SCALE 1:50

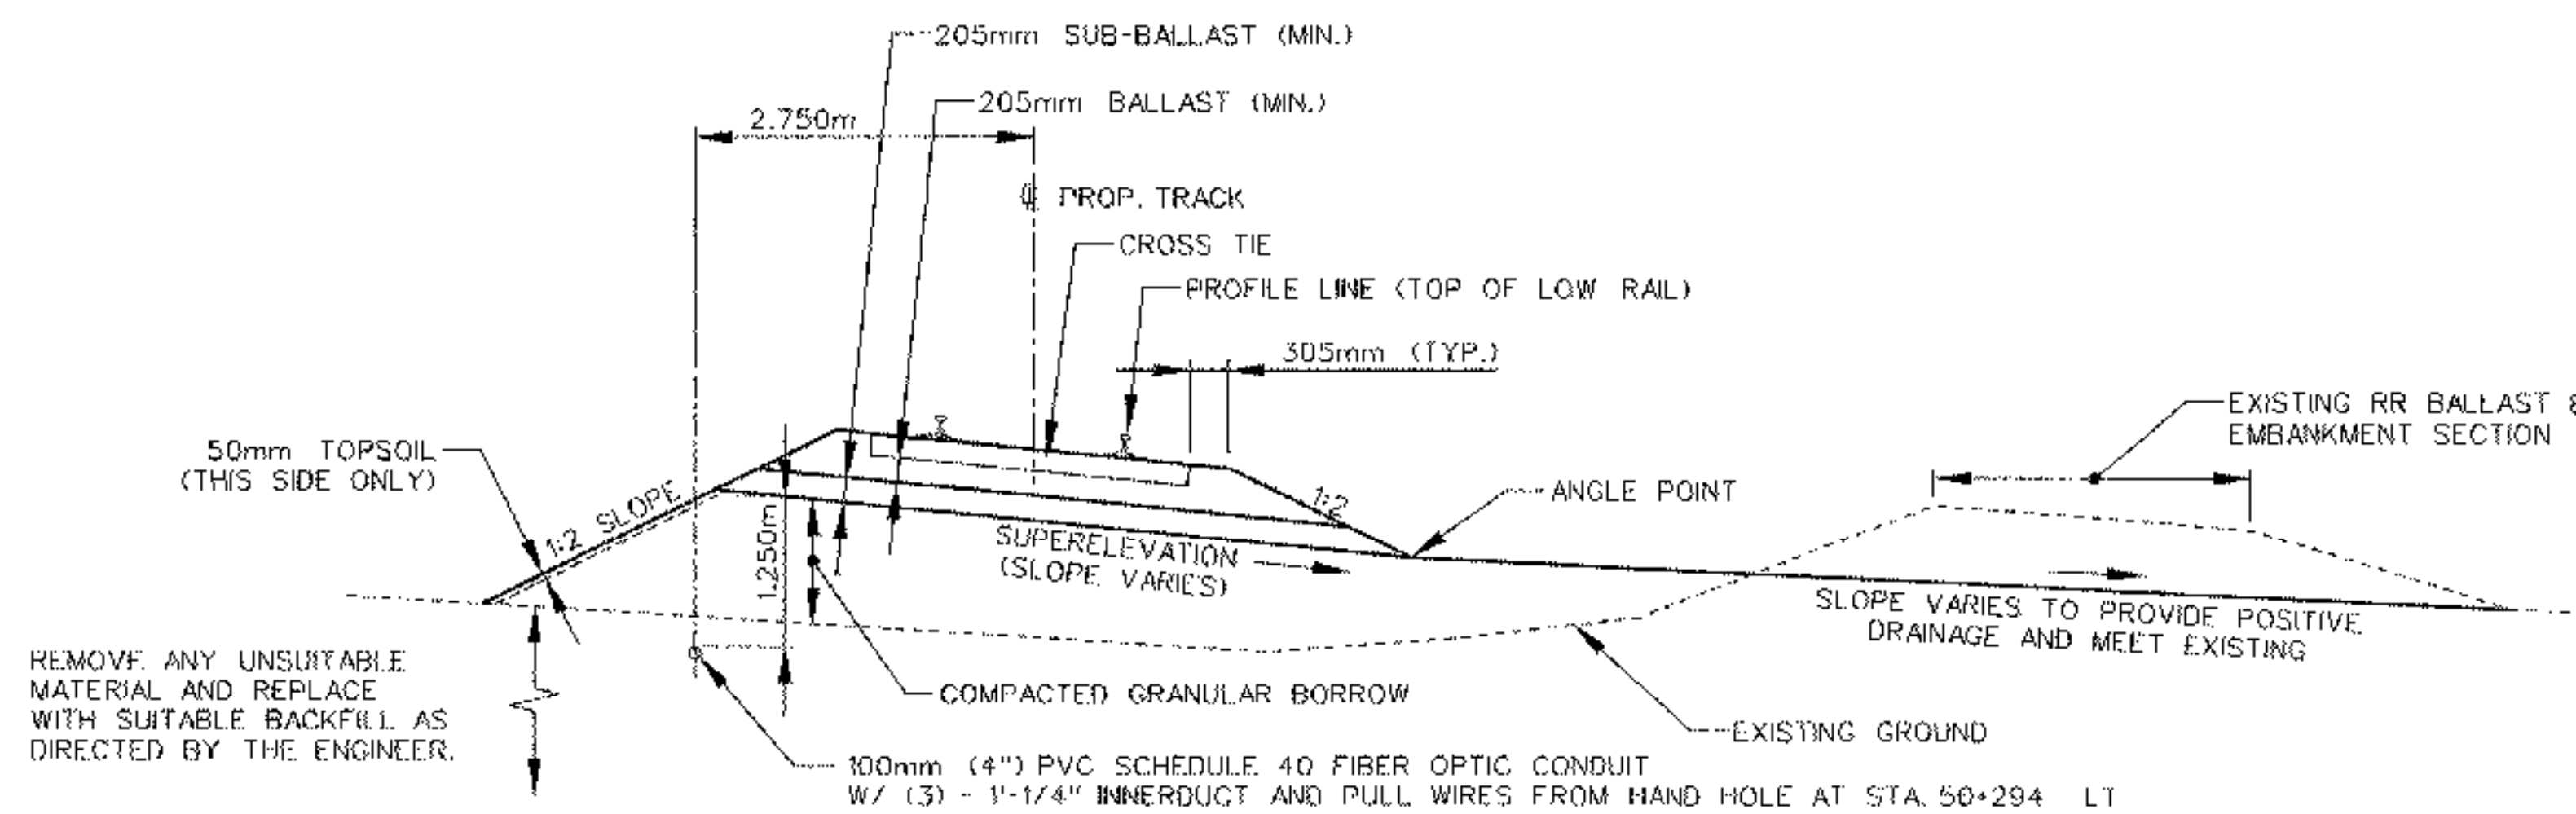

**TYPICAL SUPERELEVATED TRACK SECTION - (ON CURVE)
FULL DEPTH CONSTRUCTION
STA 50+285.220 TO STA 50+500**

SCALE 1:50

NOTES:

- REFER TO ROADWAY TYPICAL SECTIONS FOR "GENERAL NOTES FOR ROADWAY TYPICALS", AND UTILIZE AS APPLICABLE TO RAILROAD TYPICAL SECTIONS. NOTE THAT TOPSOIL AND/OR SEED IS NEVER TO BE APPLIED ABOVE RAILROAD SUBGRADE ELEVATION.
- RAIL TO BE 115 POUND CONTINUOUS WELDED RAIL. CROSS TIES TO BE 7"X9"X8'-6" TIMBER. BALLAST TO BE STONE BALLAST, SIZE #4. SUB-BALLAST TO BE SCREENED GRAVEL. ALL ABOVE MATERIALS MUST MEET THE REQUIREMENTS OF AREMA. (WORK BY OTHERS)
- ALLOWANCE FOR ROUNDING HAS NOT BEEN INDICATED ON RAILROAD PLANS AND CROSS SECTIONS. DUE TO UNTYPICAL CONDITIONS IN CUT, ROUNDINGS WILL BE AS DIRECTED BY THE ENGINEER.


DATUM
VERTICAL NGVD 1929
HORIZONTAL NAD 1983

**RAILROAD
TYPICAL
SECTIONS**

PROJECT NAME: BRATTLEBORO
PROJECT NUMBER: NH 010-2(2)



FILE NAME: track sections
PROJECT LEADER: JHR
DESIGNED BY: GJB
PLOT DATE: 10-01-2002
DRAWN BY: DHL
CHECKED BY: TEM
SHEET 10 OF 145

MISCELLANEOUS DETAILS

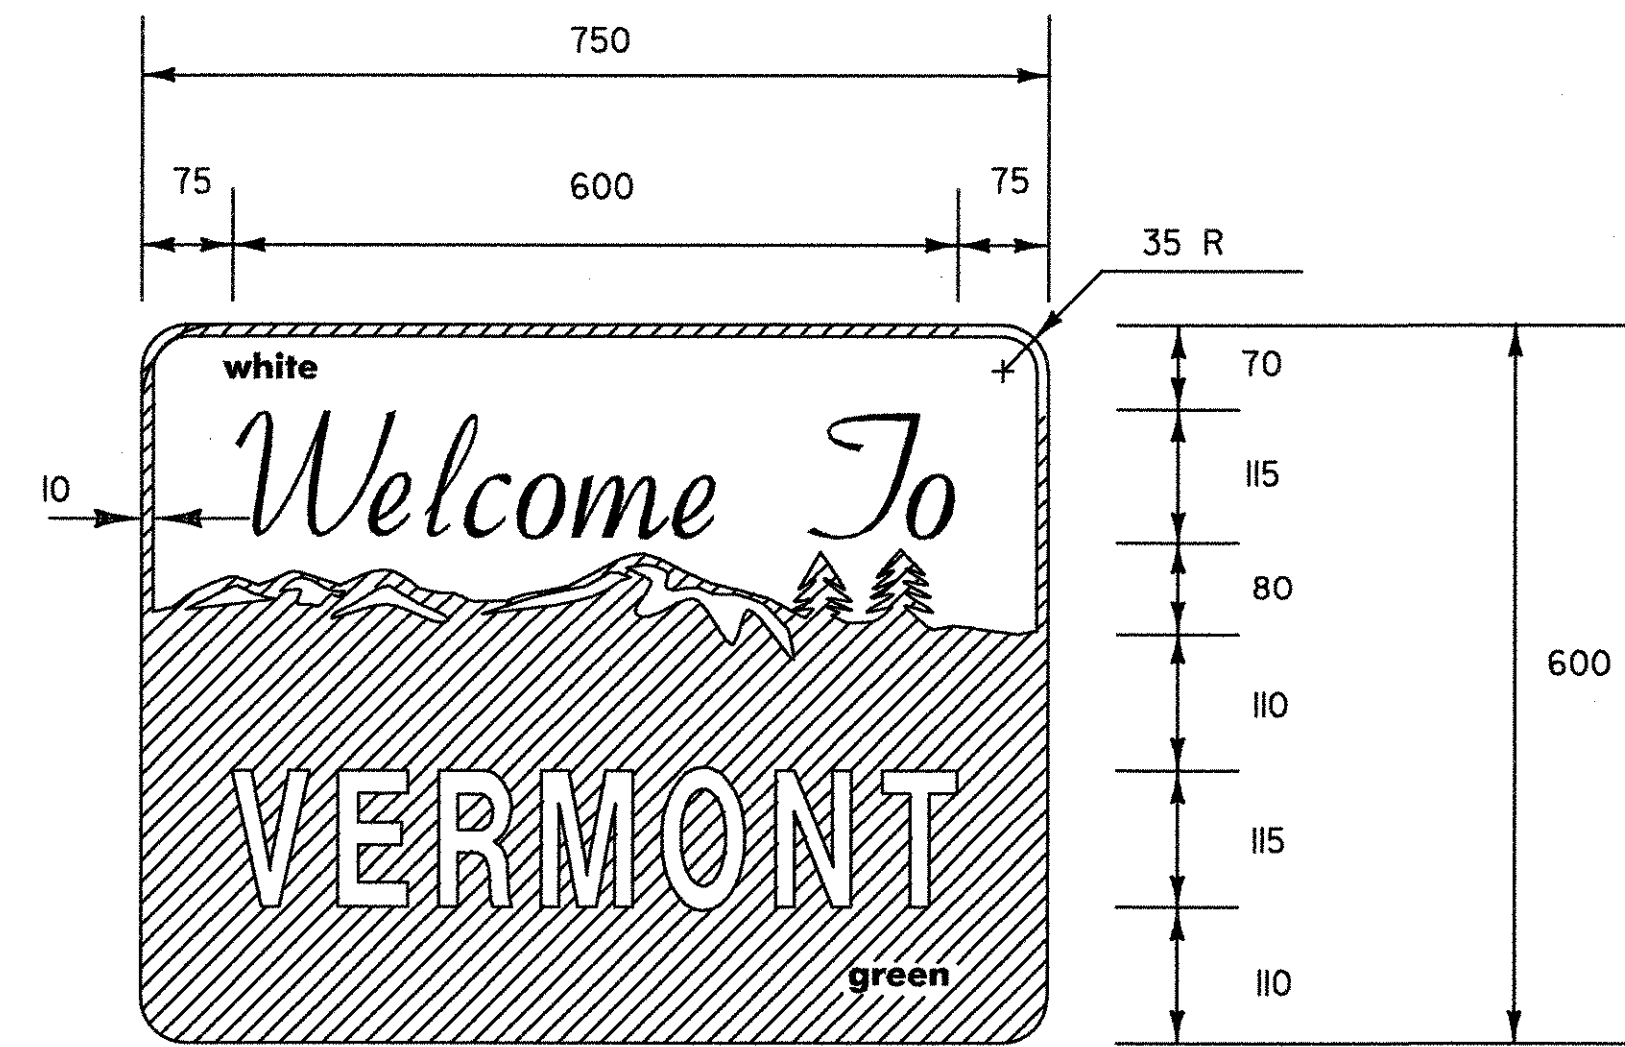





NOTE:
 FOR THE WORDS "WELCOME TO" USE GERBER FONT MURRAY HILL BOLD OR EQUIVALENT. TEXT COLOR IS GREEN.
 ALL OTHER TEXT USE GERBER FONT SOUVENIR DEMIBOLD OR EQUIVALENT. TEXT COLOR IS WHITE.
 REFER TO STD. E-131M FOR COLORS.

MATERIALS:
 SEE STD. E-136M FOR MATERIALS

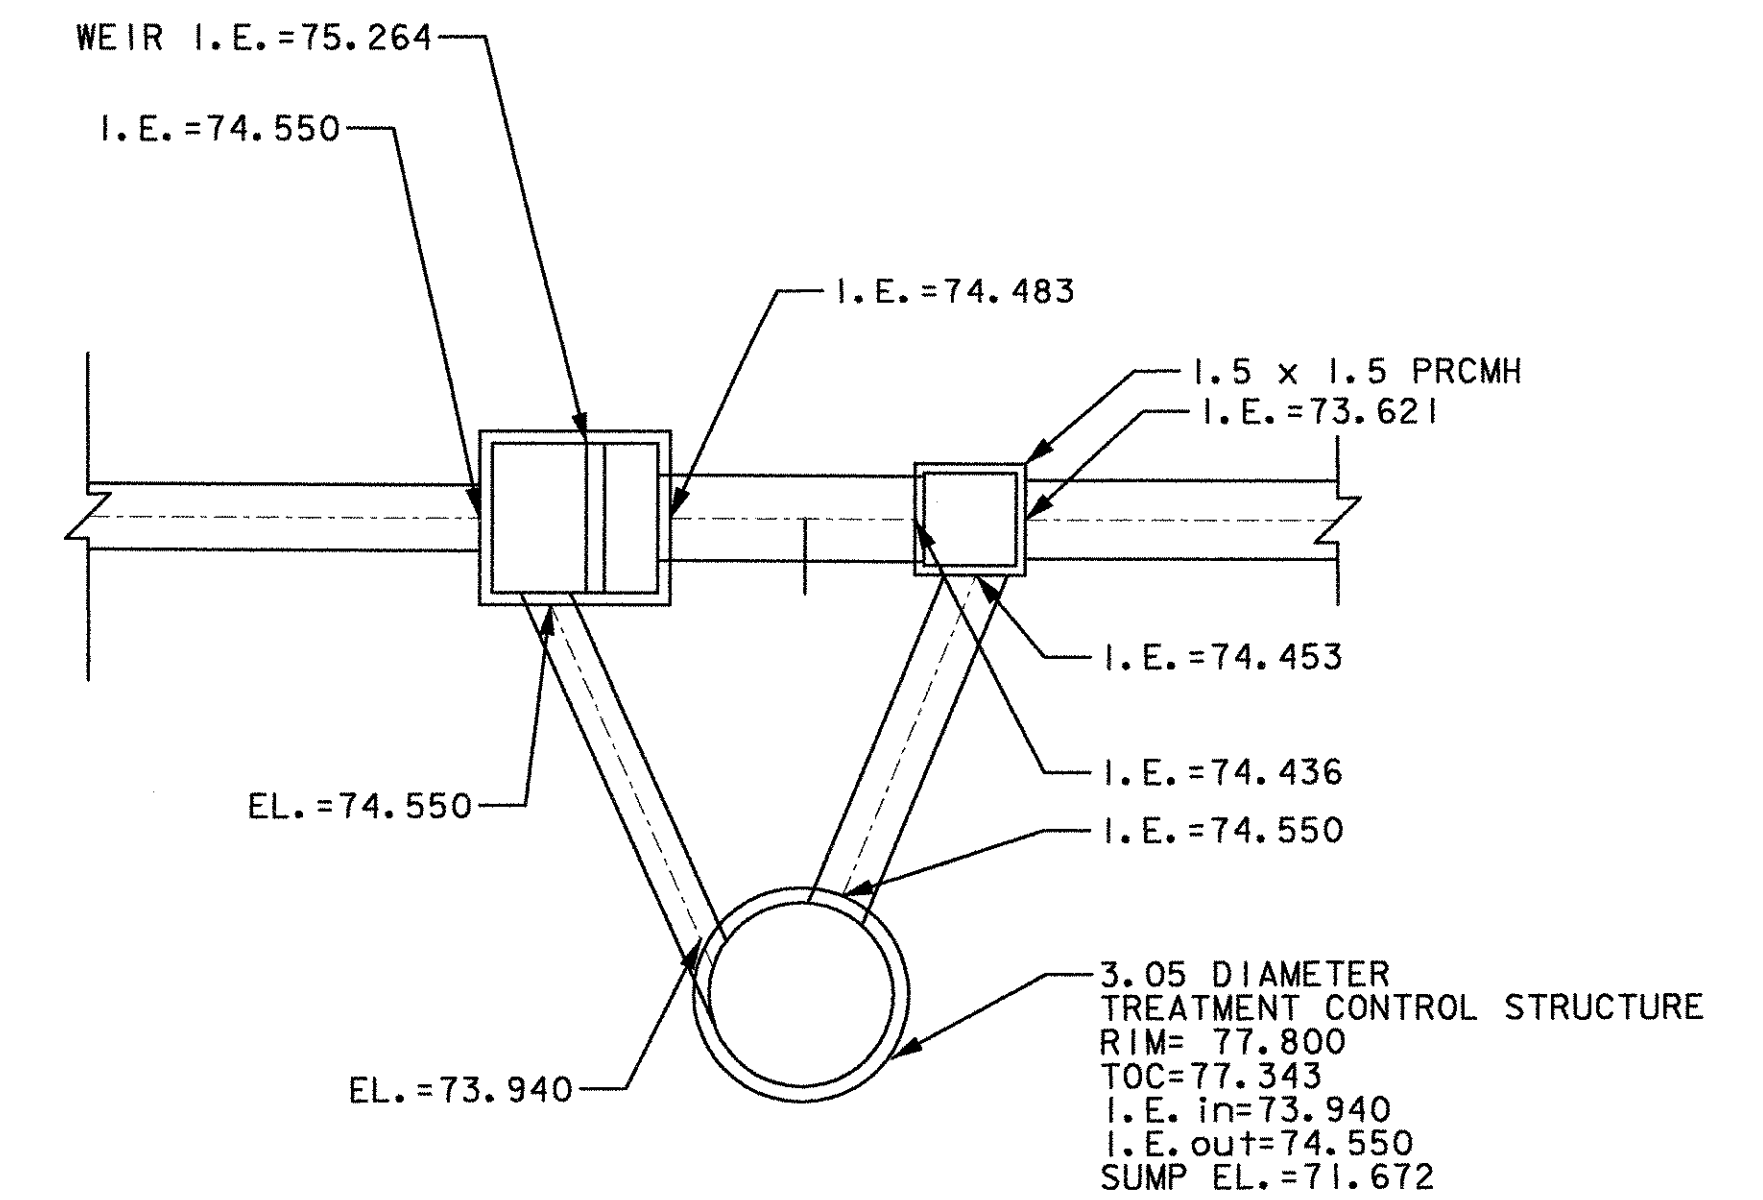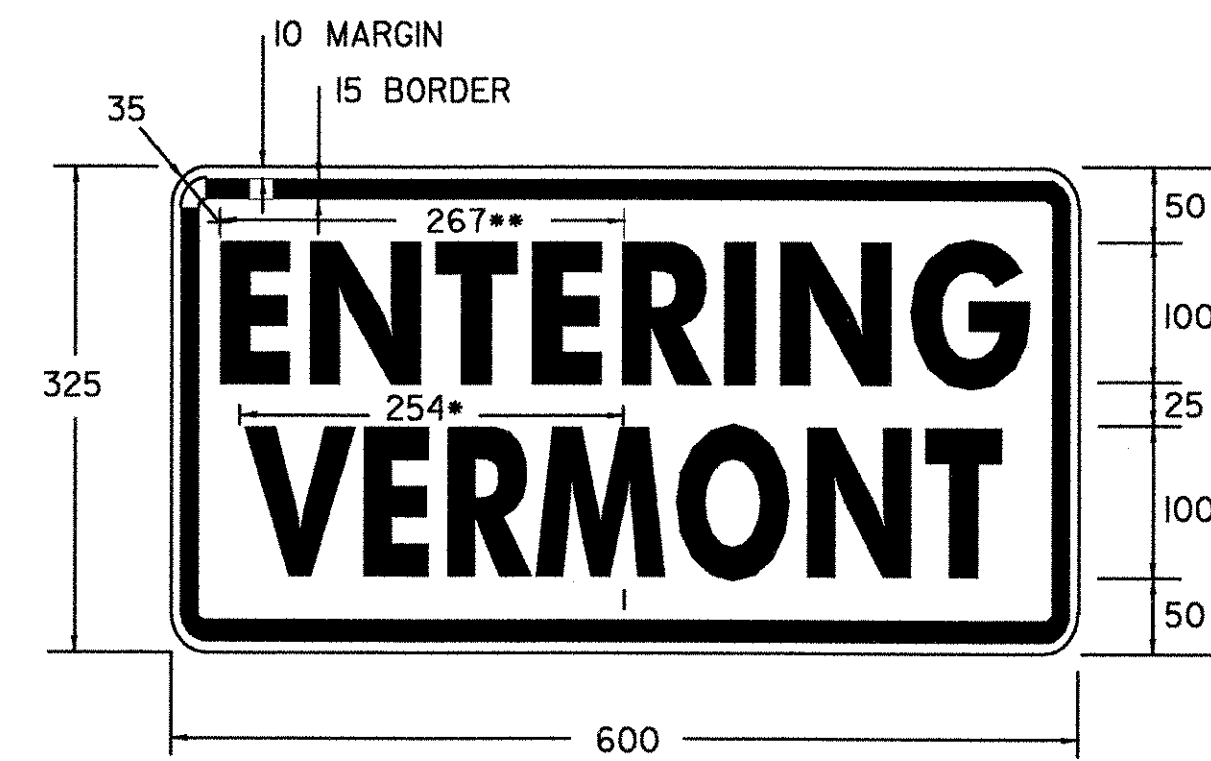

SEDIMENTATION CONTROL STRUCTURE DETAIL


(NOT TO SCALE)

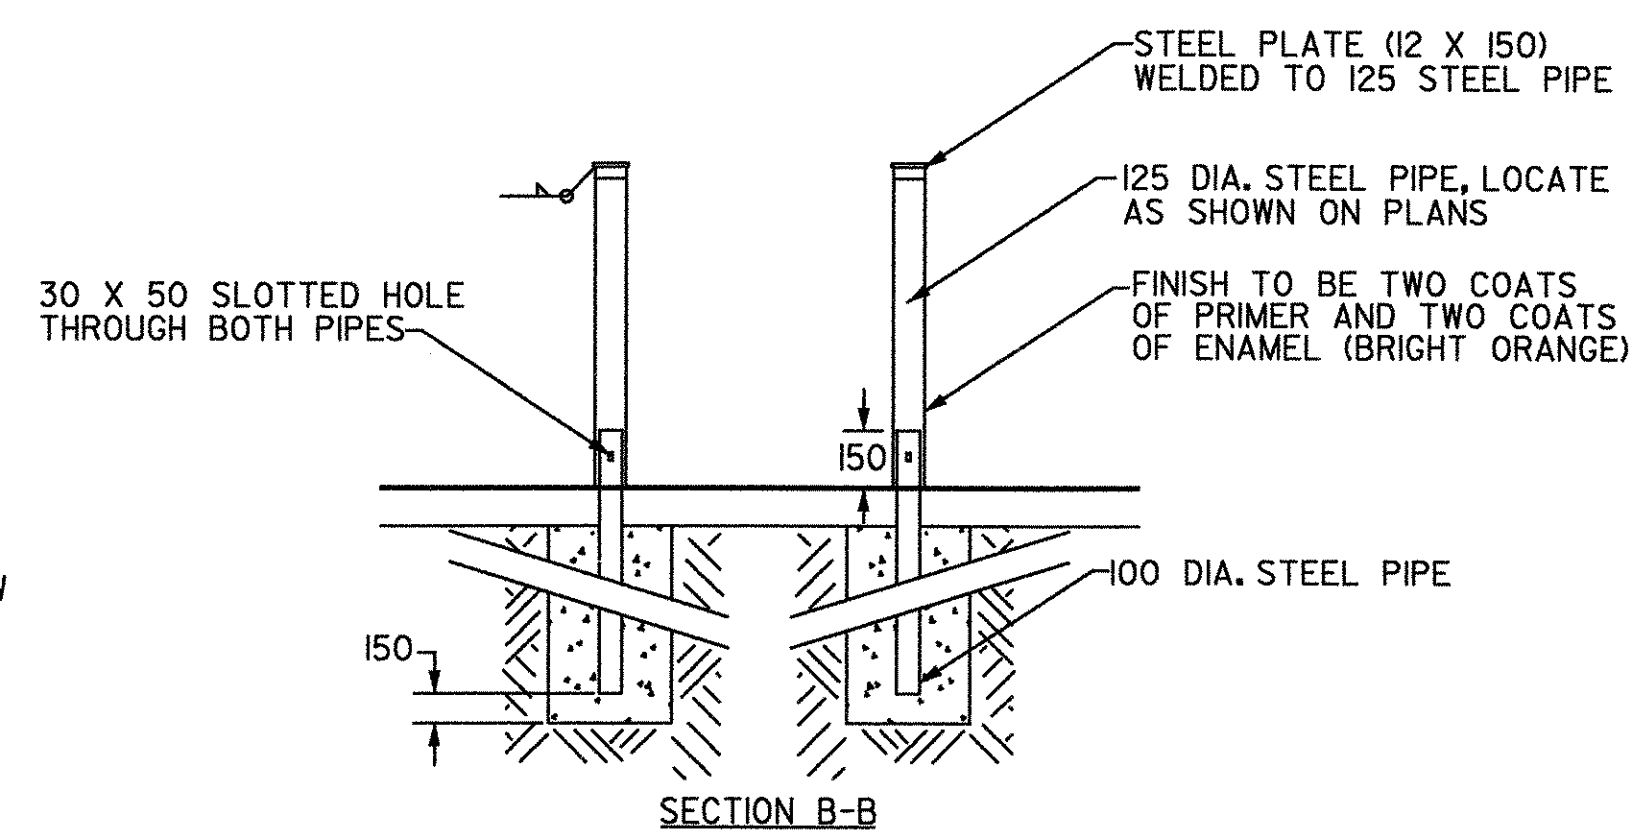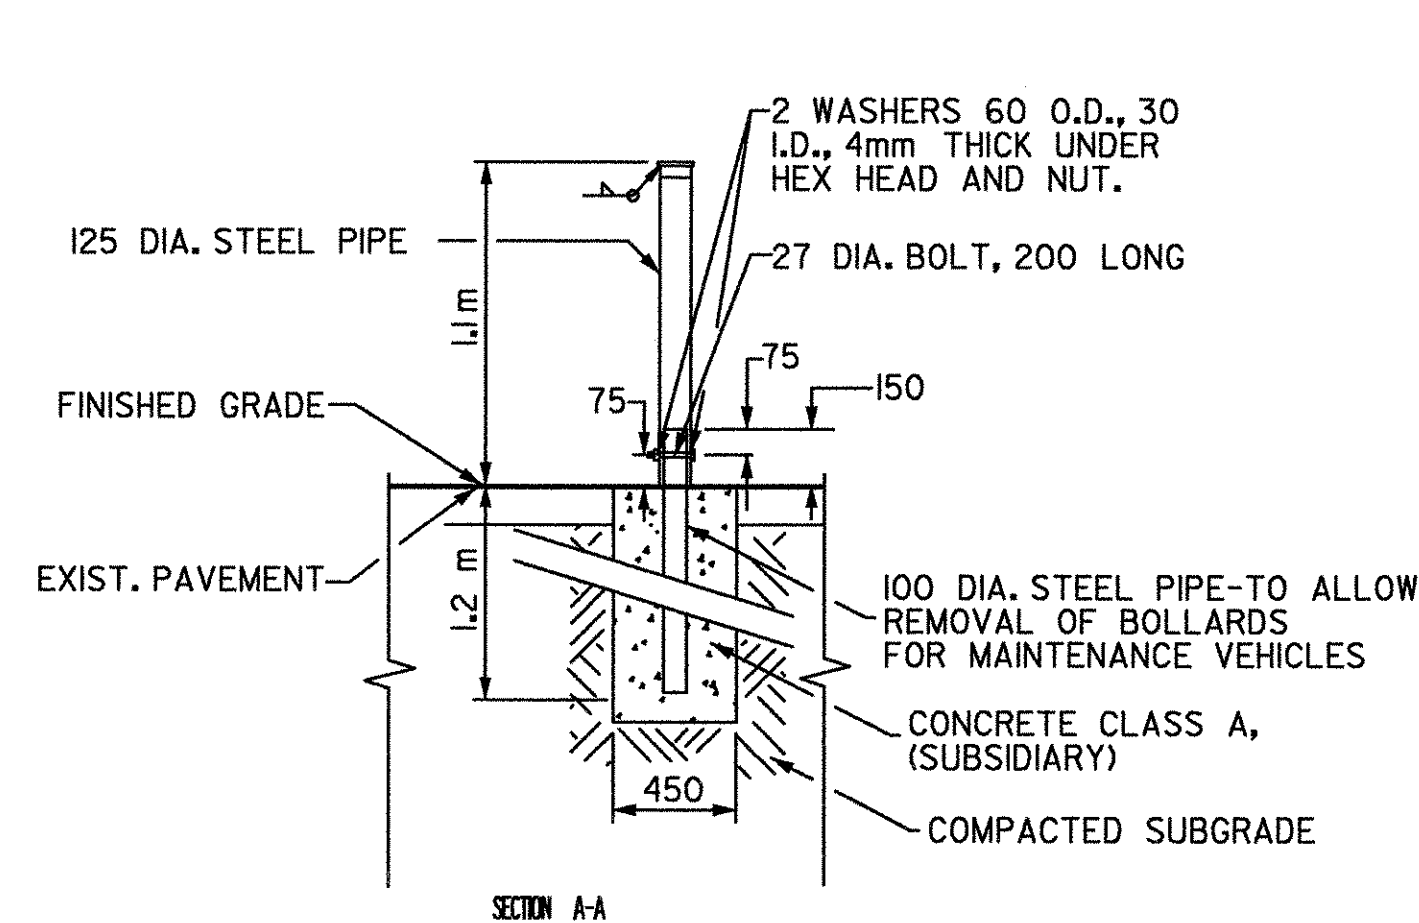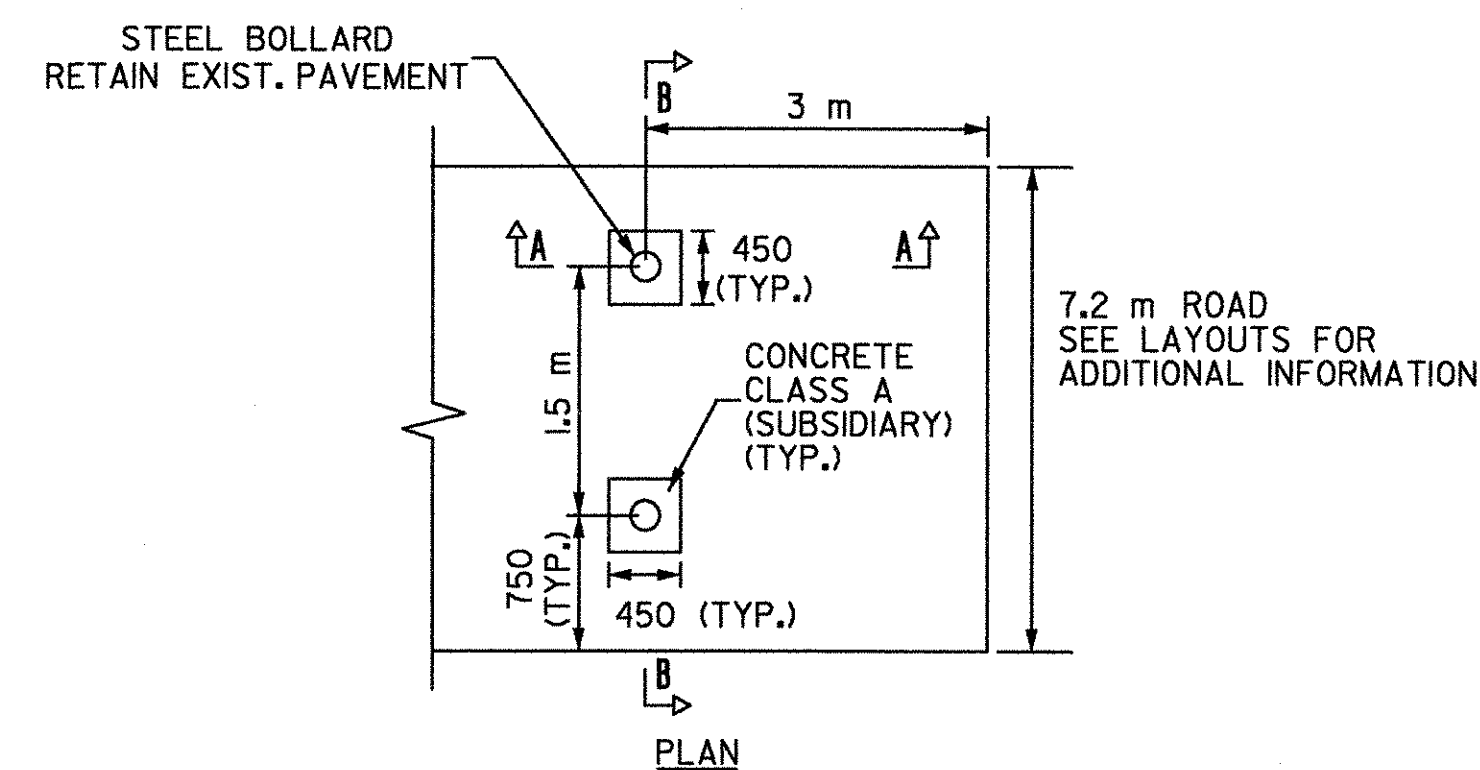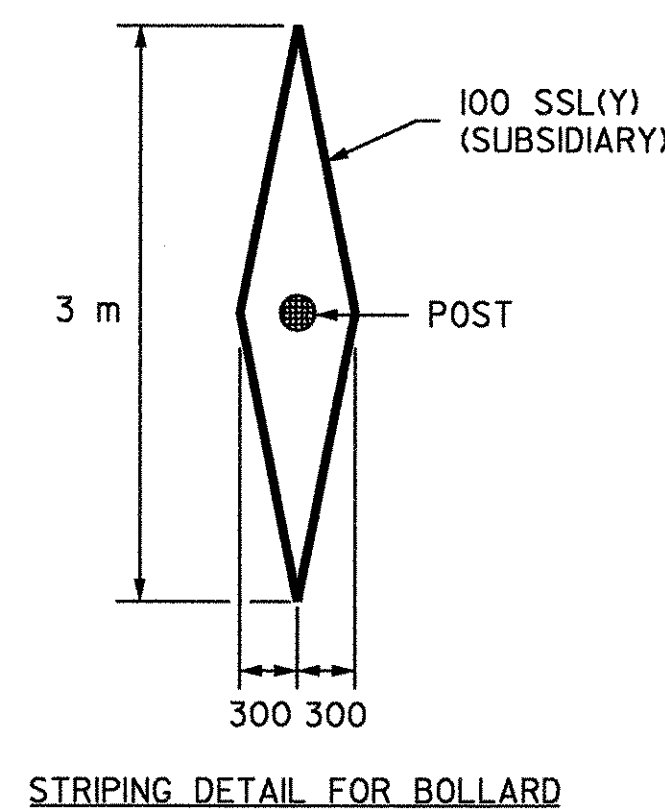

STEEL BOLLARD DETAIL (REMOVABLE)

ITEM 619.16 - STEEL MARKER POSTS (MOD)
 (NOT TO SCALE)

DATUM	
VERTICAL	NGVD 1929
HORIZONTAL	NAD 1983

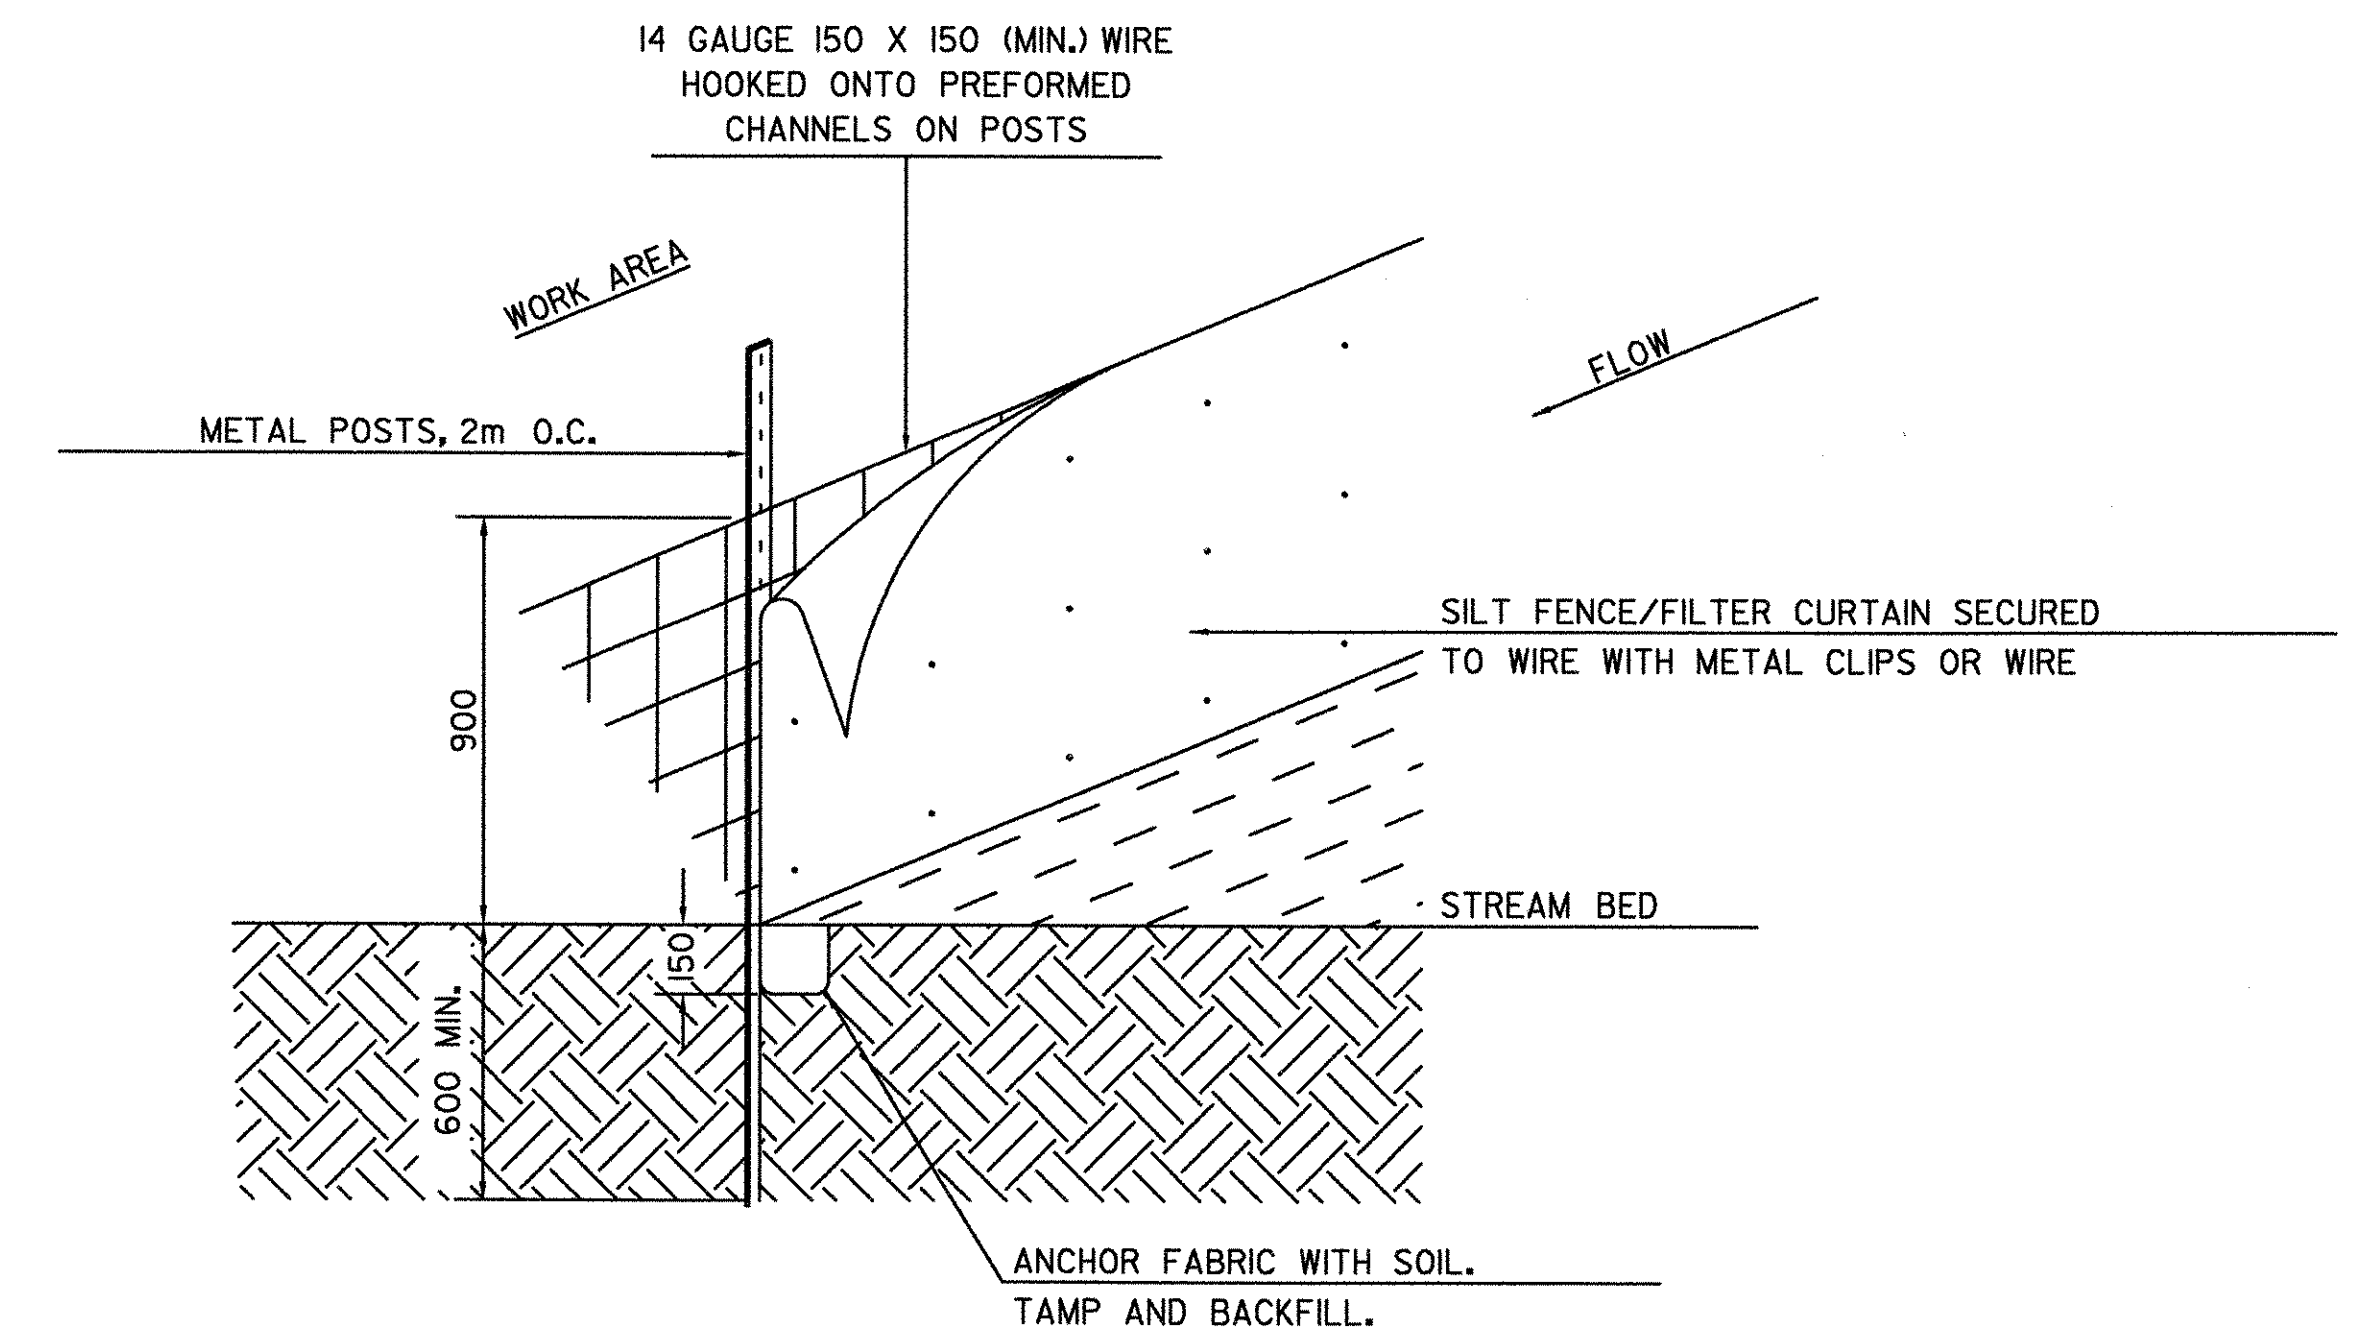

PLACEMENT OF SILT FENCE/FILTER CURTAIN IN STREAM

NOT TO SCALE



NOTE: UNLESS OTHERWISE NOTED IN THESE PLANS, ALL ELEVATIONS ARE IN METERS AND ALL DIMENSIONS ARE IN MILLIMETERS

PROJECT: BRATTLEBORO	PROJECT NO. : NH 010-2(2)
DESIGN FILE NAME: ...zb270+yp.dgn	PLOT DATE: 09/20/2002
IPARM FILE NAME:	SURVEY DATE:
SURVEYED BY:	DRAWN BY: P SHEDD
SQUAD LEADER: W HUSBAND	SHEET: II OF 145
CLD REF NO. 00-0358	

MISCELLANEOUS DETAILS

GENERAL NOTES

1. ALL CATCH BASINS SHALL BE CONSTRUCTED WITH PRECAST CONCRETE BASE SECTIONS, RISER SECTIONS AND FLAT SLAB TOPS CONFORMING TO SECTION 705.04 OF THE VERMONT STANDARD SPECIFICATIONS FOR CONSTRUCTION.
2. PRECAST CONCRETE BASE SECTIONS AS SHOWN ON THIS SHEET SHALL BE USED FOR EACH CATCH BASIN. FOOTINGS (CAST-IN-PLACE OR PRECAST) FOR CATCH BASINS ARE NOT ALLOWED.
3. PRECAST SECTIONS SHALL HAVE A TONGUE AND GROOVE JOINT 100 mm HIGH AT AN 11° ANGLE CENTERED IN THE WIDTH OF THE WALL AND SHALL BE ASSEMBLED USING AN APPROVED FLEXIBLE SEALANT IN JOINTS.
4. ALL STRUCTURES WITH MULTIPLE PIPES SHALL HAVE A MINIMUM OF 300 mm OF OUTSIDE SURFACE BETWEEN HOLES, NO MORE THAN 75% OF A HORIZONTAL CROSS-SECTION SHALL BE HOLES, AND THERE SHALL BE NO HOLES CLOSER THAN 75 mm TO JOINTS.

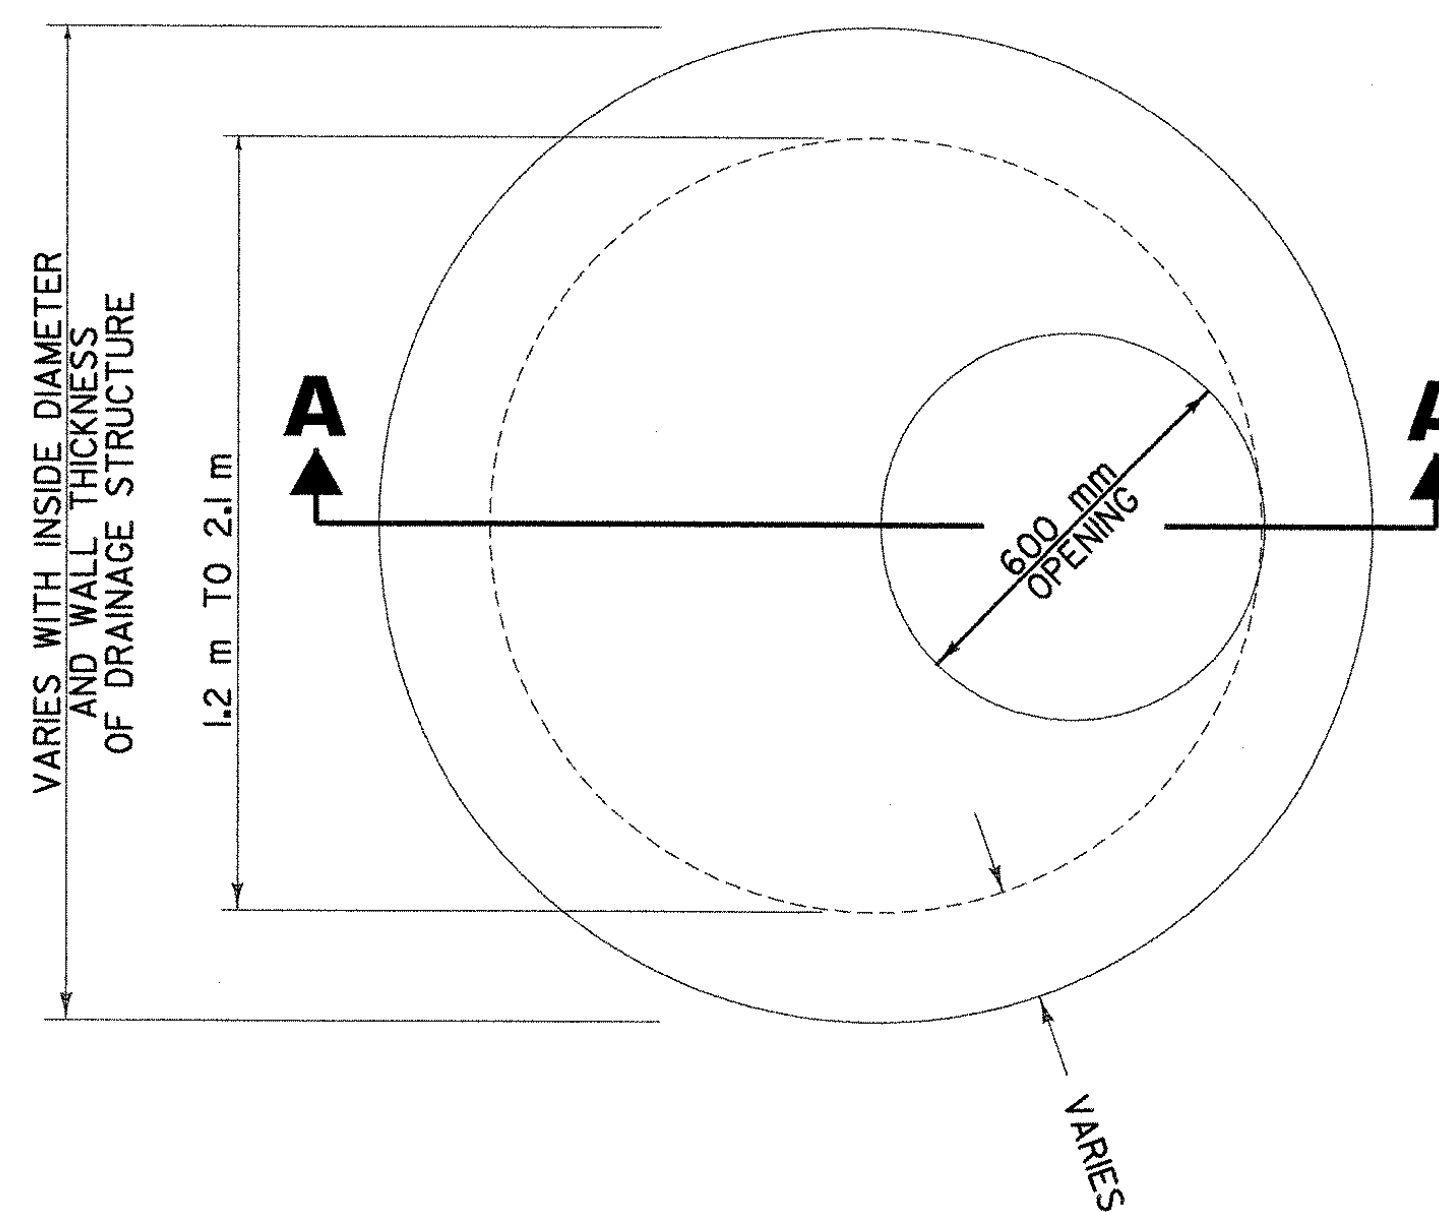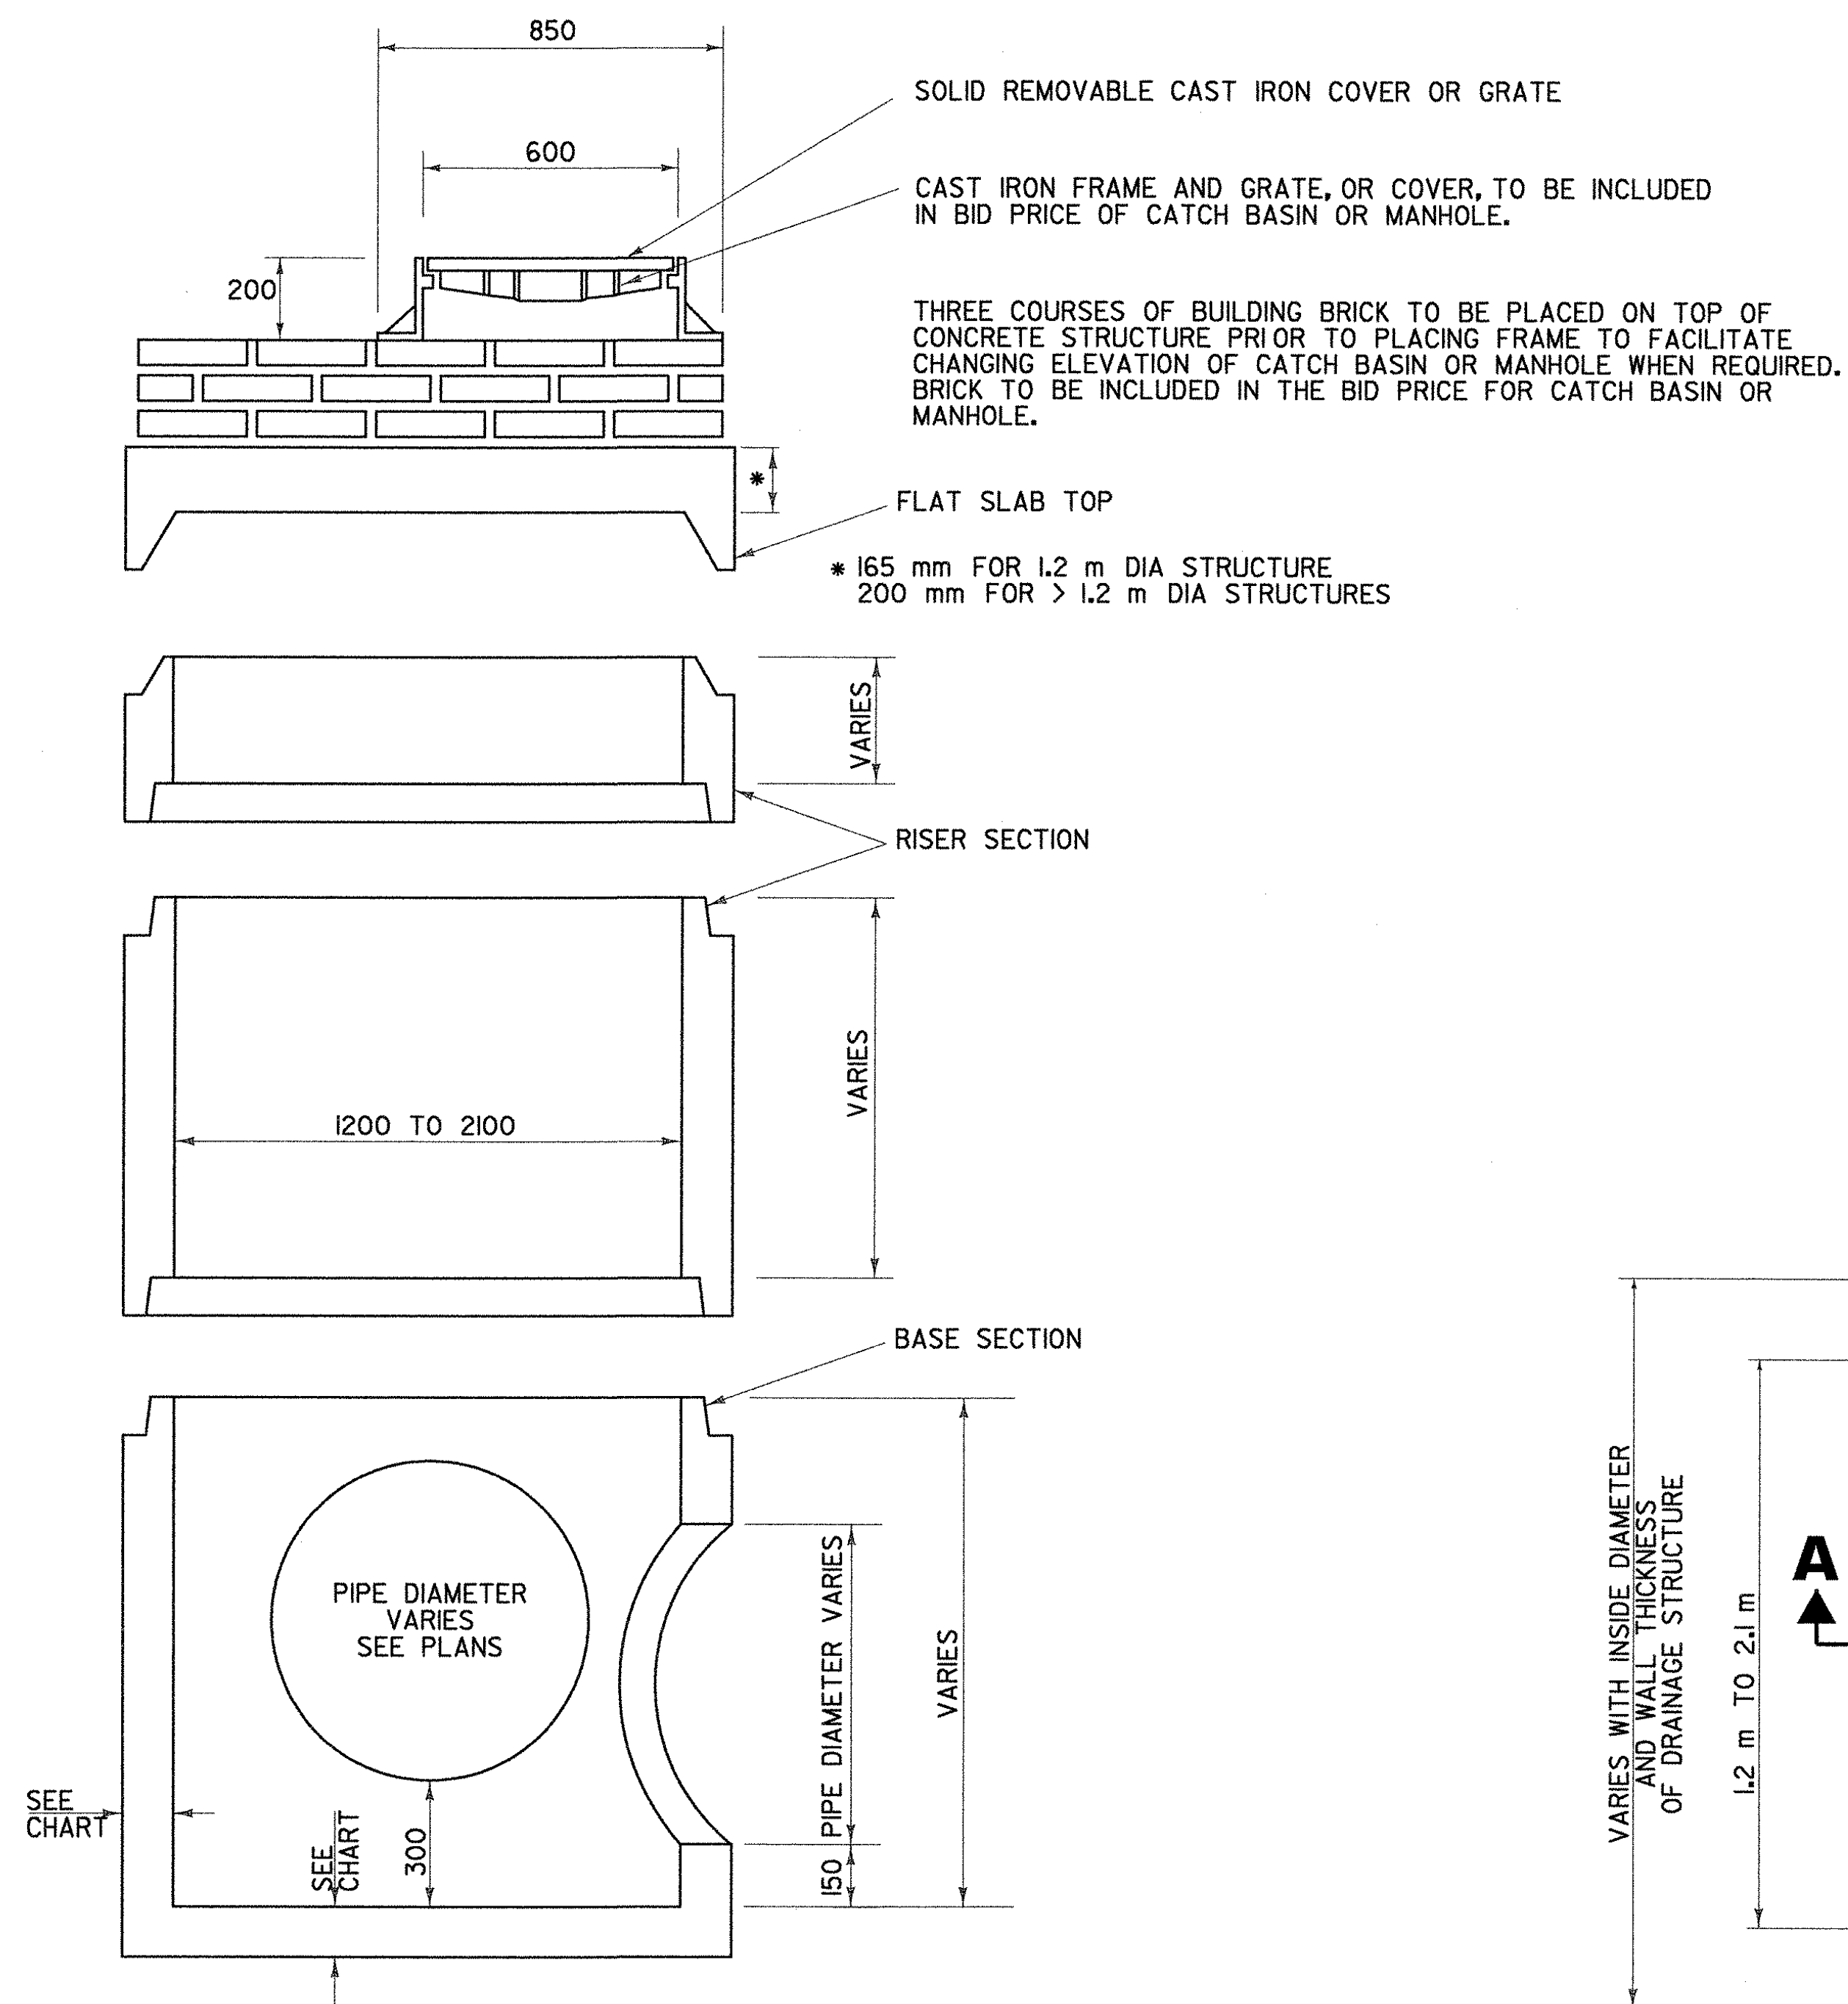

DIAMETER	WALL THICKNESS (MIN.)	FLOOR THICKNESS (MIN.)
1.2 m	125 mm	150 mm
1.5 m	150 mm	200 mm
1.8 m	175 mm	200 mm
2.1 m	200 mm	250 mm

SECTION A-A

PLAN




PRECAST REINFORCED CONCRETE CATCH BASIN DETAIL

(NOT TO SCALE)


NOTE: UNLESS OTHERWISE NOTED IN THESE PLANS, ALL ELEVATIONS ARE IN METERS AND ALL DIMENSIONS ARE IN MILLIMETERS

DATUM	
VERTICAL	NGVD 1929
HORIZONTAL	NAD 1983



PROJECT: BRATTLEBORO	PROJECT NO.: NH 010-2(2)
DESIGN FILE NAME: ...zb270+yp.dgn	PLOT DATE: 09/25/2002
IPARM FILE NAME:	SURVEYED BY:
SQUAD LEADER: W HUSBAND	DRAWN BY: P SHEDD
CLD REF NO. 00-0358	SHEET: IIA OF 145

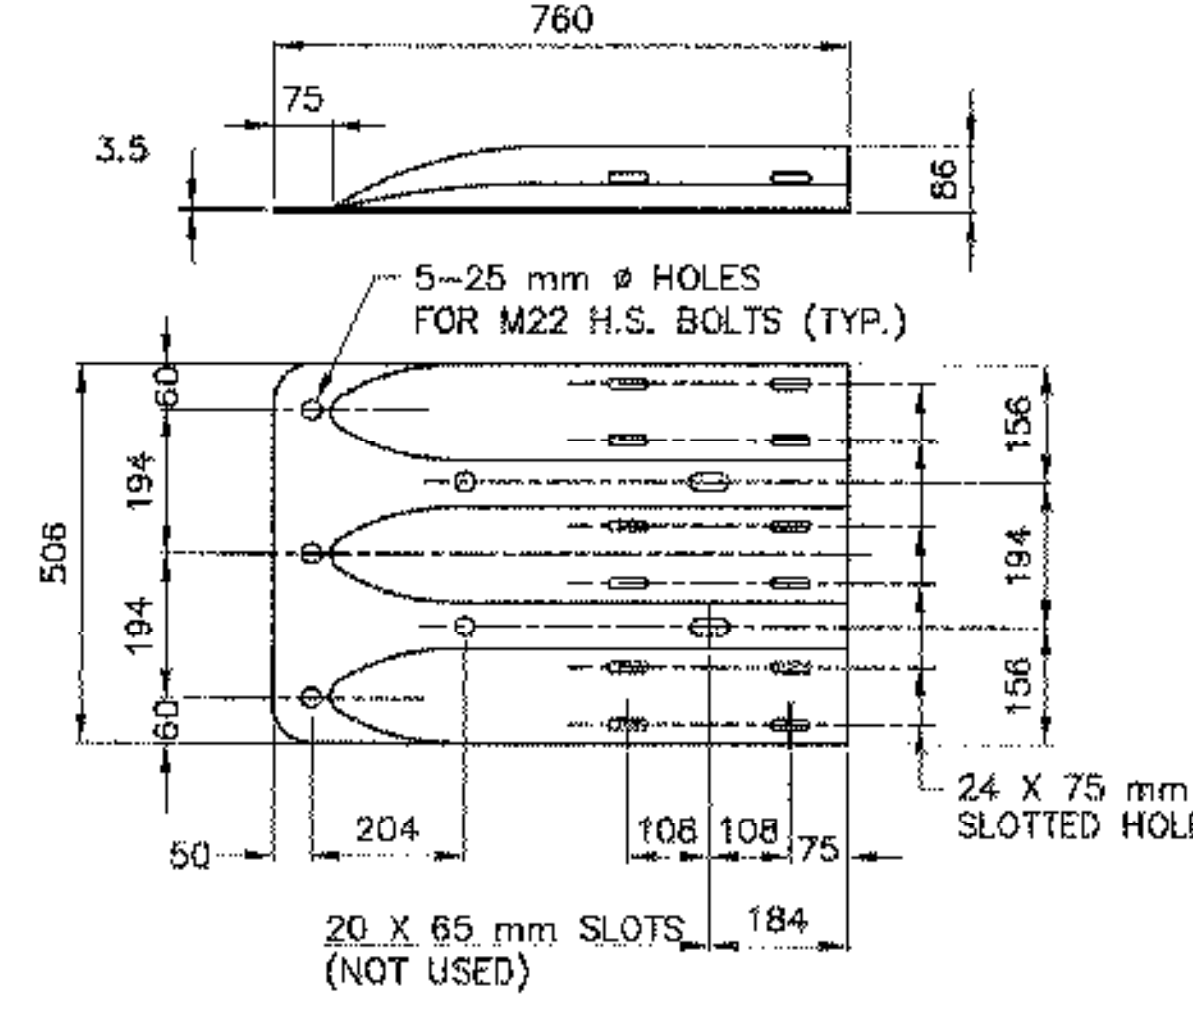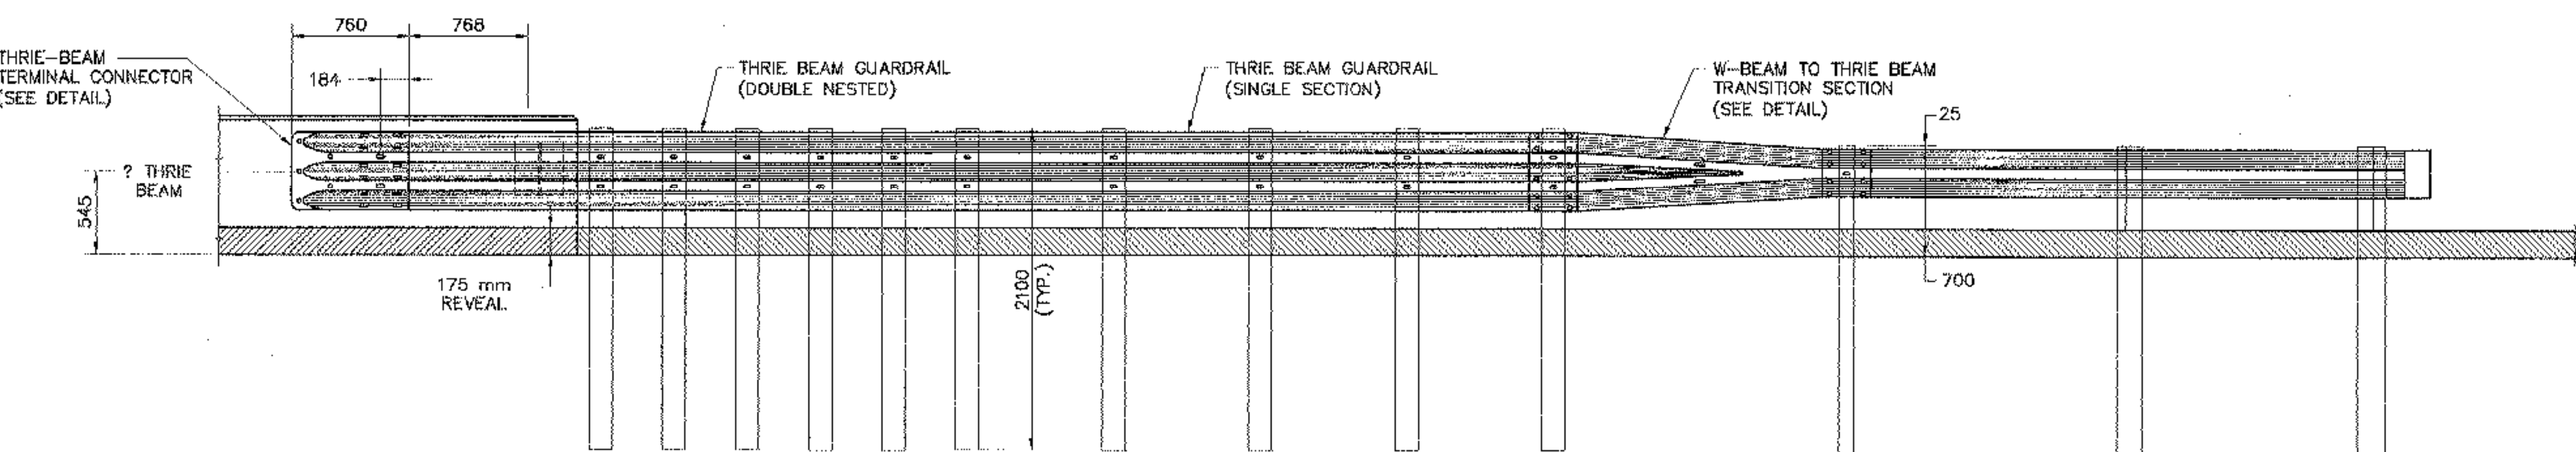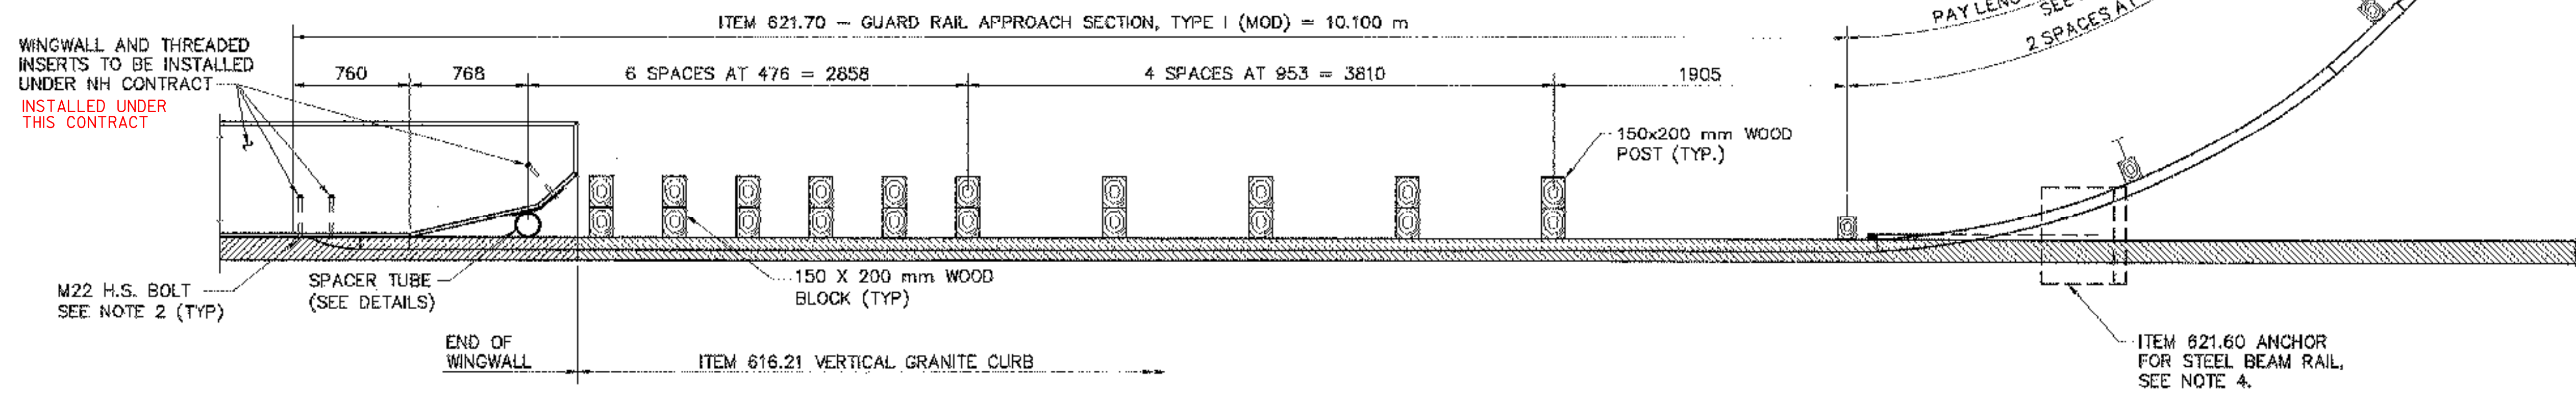

THRIE-BEAM TERMINAL CONNECTOR
(ARTBA RTE01b)
SCALE 1:10

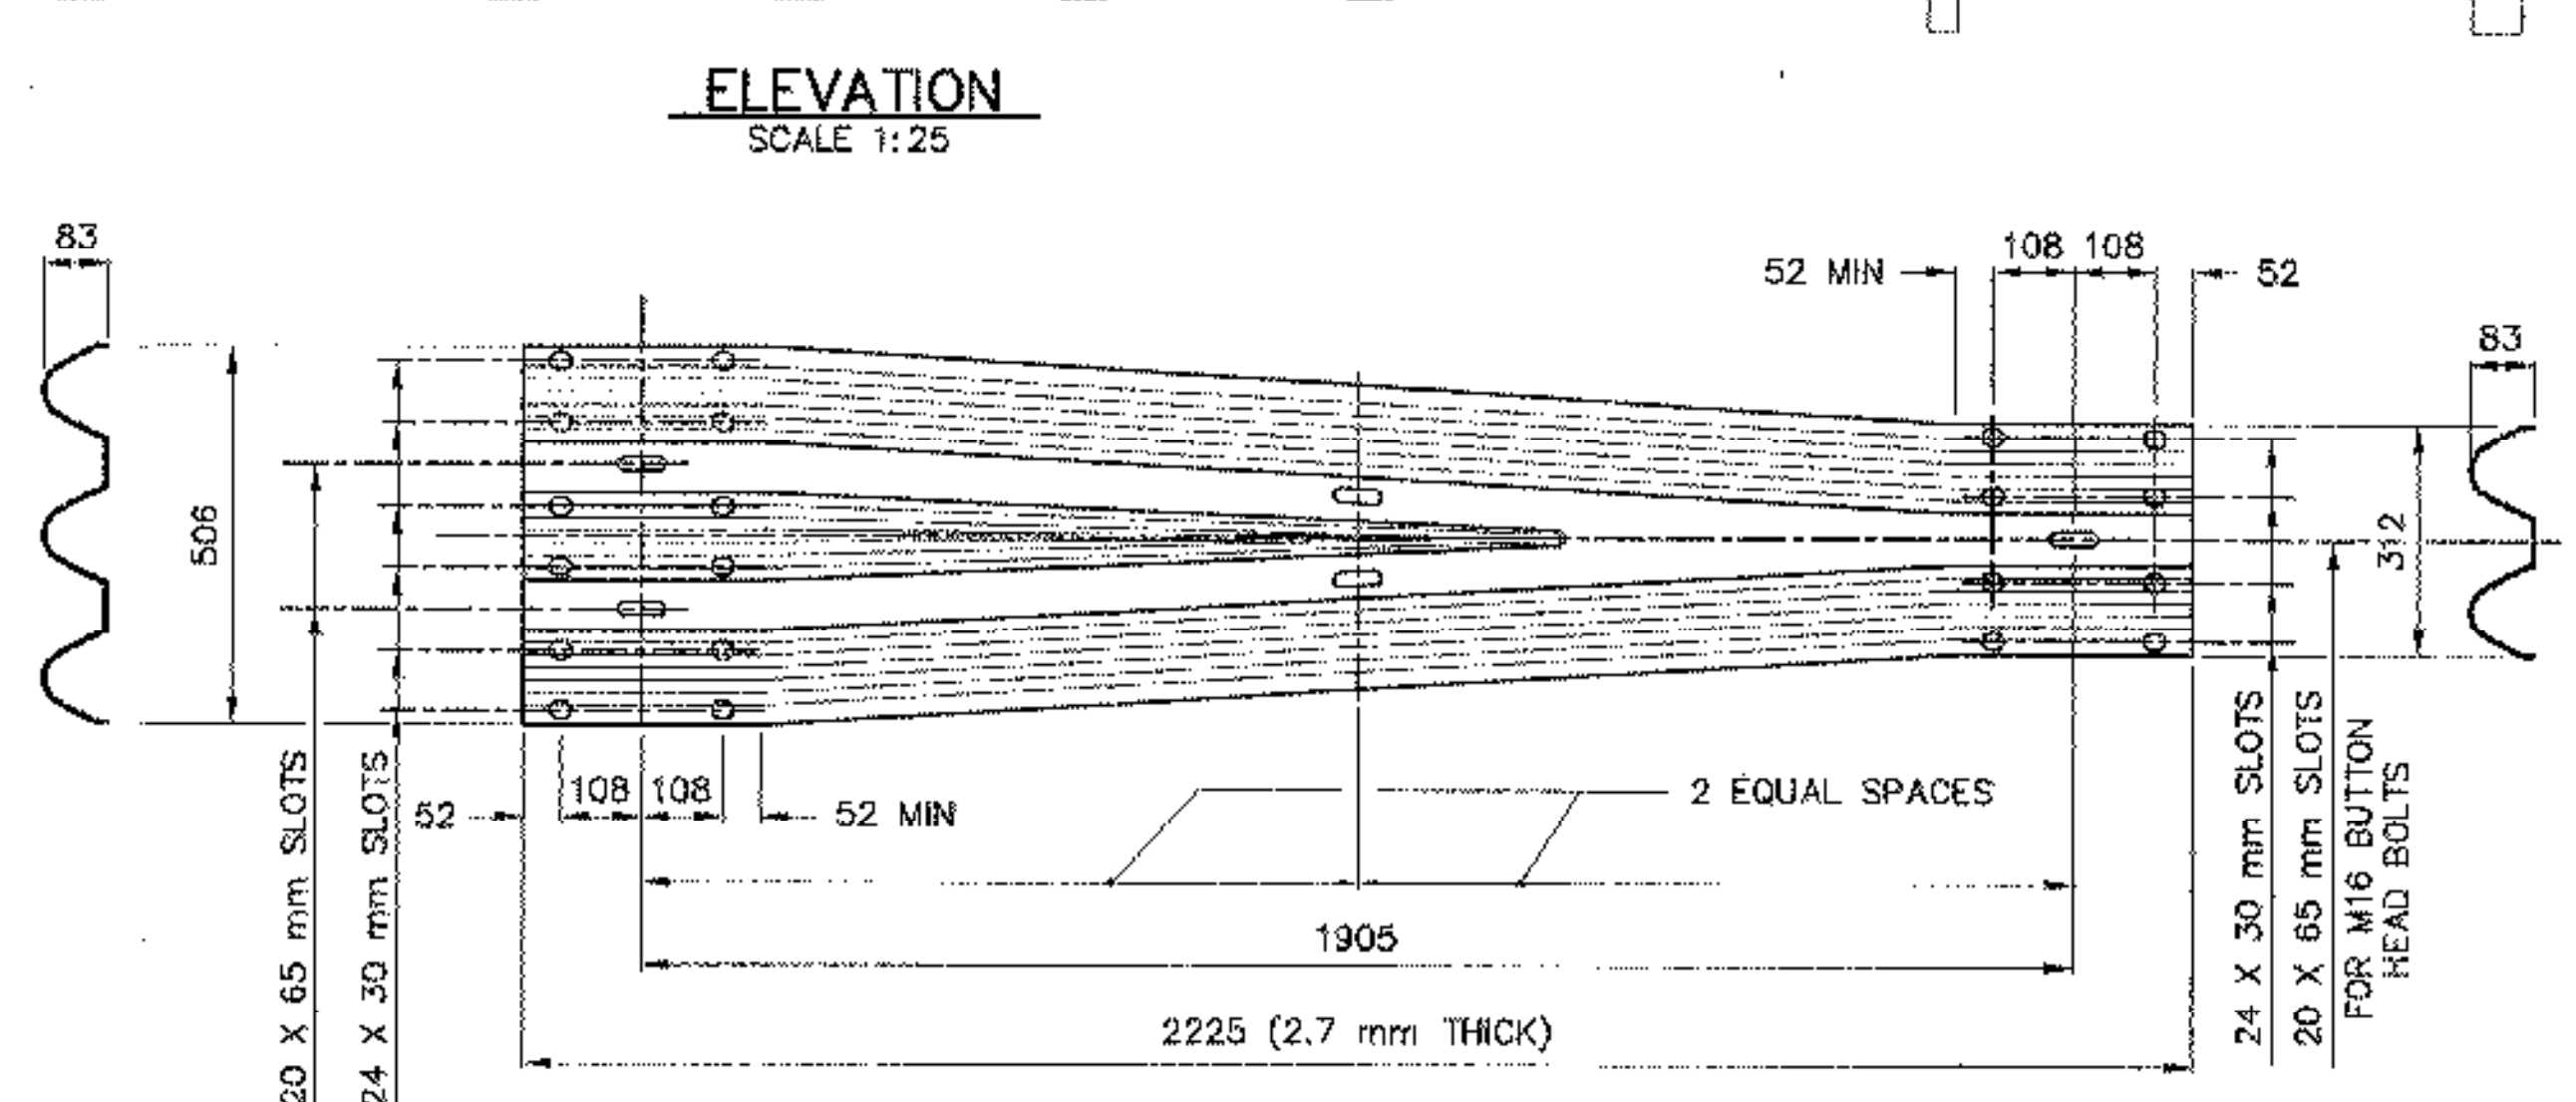

THRIE-BEAM TO W-BEAM TRANSITION SECTION
(ARTBA RWT01a)
SCALE 1:10

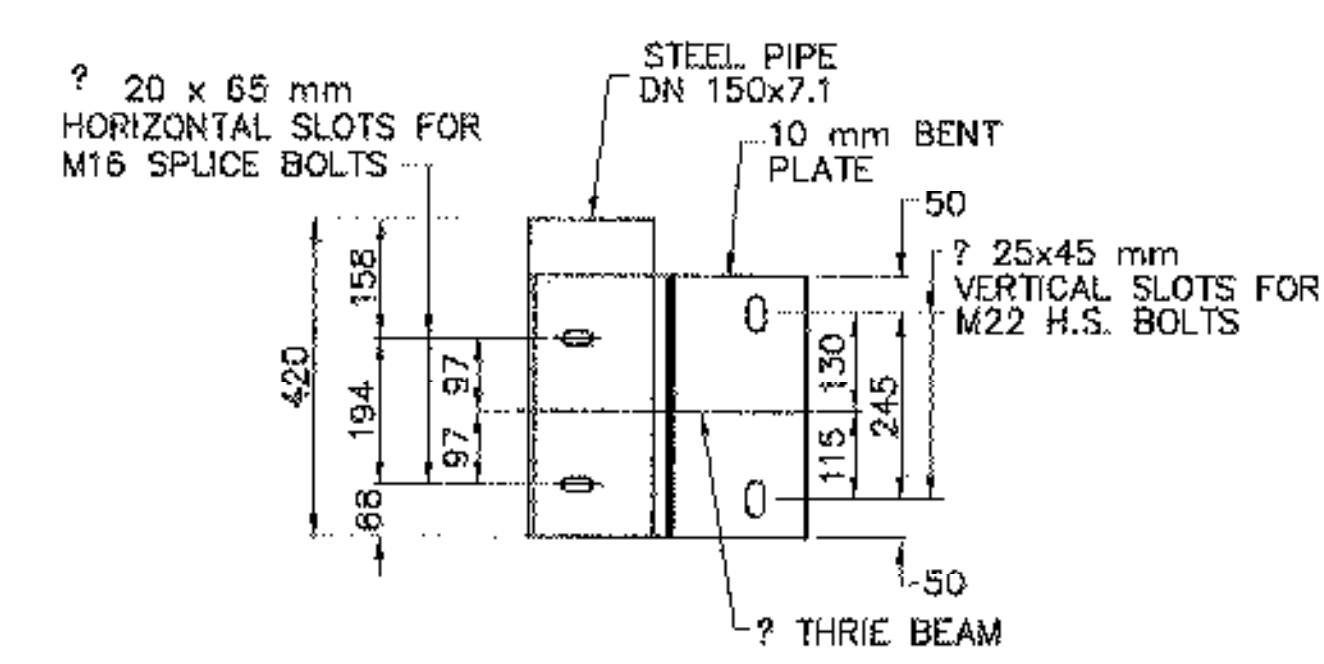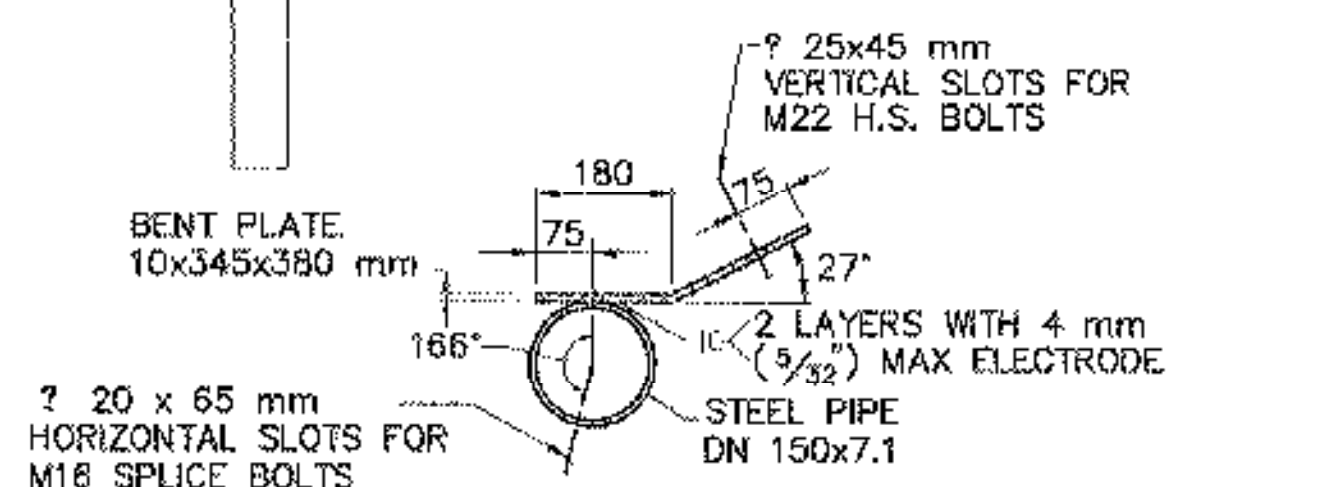

SECTION

NOTE: STEEL PIPE (ASTM A53 GRADE B)/ BENT PLATE (ASTM A36) ASSEMBLY SHALL BE HOT DIPPED GALVANIZED

SPACER TUBE ASSEMBLY DETAILS
SCALE N.T.S.

- NOTES:**
- ALL THRIE BEAM RAIL, INCLUDING TRANSITION SECTION, SHALL BE GALVANIZED 2.7 mm. ALL TERMINAL CONNECTORS SHALL BE GALVANIZED 3.5 mm.
 - H.S. BOLTS SHALL CONFORM TO ASTM A 325M TYPE 1, GALVANIZED.
 - ALL CONNECTIONS FOR THE THRIE BEAM RAIL AND TERMINAL CONNECTOR SHALL LAP IN THE DIRECTION OF TRAFFIC.
 - SEE VAOT STANDARD G-1dM FOR GUARDRAIL TERMINAL AND ANCHOR DETAILS.


- SEE SHEET 12A OF 145 FOR ADDITIONAL THRIE-BEAM STANDARD DETAILS.
- FOR DESCRIPTION AND SPECIFICATION OF PARTS IDENTIFIED BY "(ARTBA ...)" AND OTHER DETAILS OF POSTS, POST ACCESSORIES, FASTENERS, AND RAIL ELEMENTS, SEE AASHTO-AGC-ARYBA JOINT TASK FORCE NO. 13 TITLED "A GUIDE TO STANDARDIZED HIGHWAY BARRIER HARDWARE," LATEST EDITION.

DATUM


VERTICAL _____

HORIZONTAL _____



PROJECT: BRATTLEBORD	PROJECT NO. 1: NH 010-2(2)
DESIGN FILE NAME: IPARM FILE NAME: SURVEYED BY: SQUAD LEADER: W. HUSBAND	PLOT DATE: 1/2002 SURVEY DATE: DRAWN BY: PHL SHEET: 12 OF 145

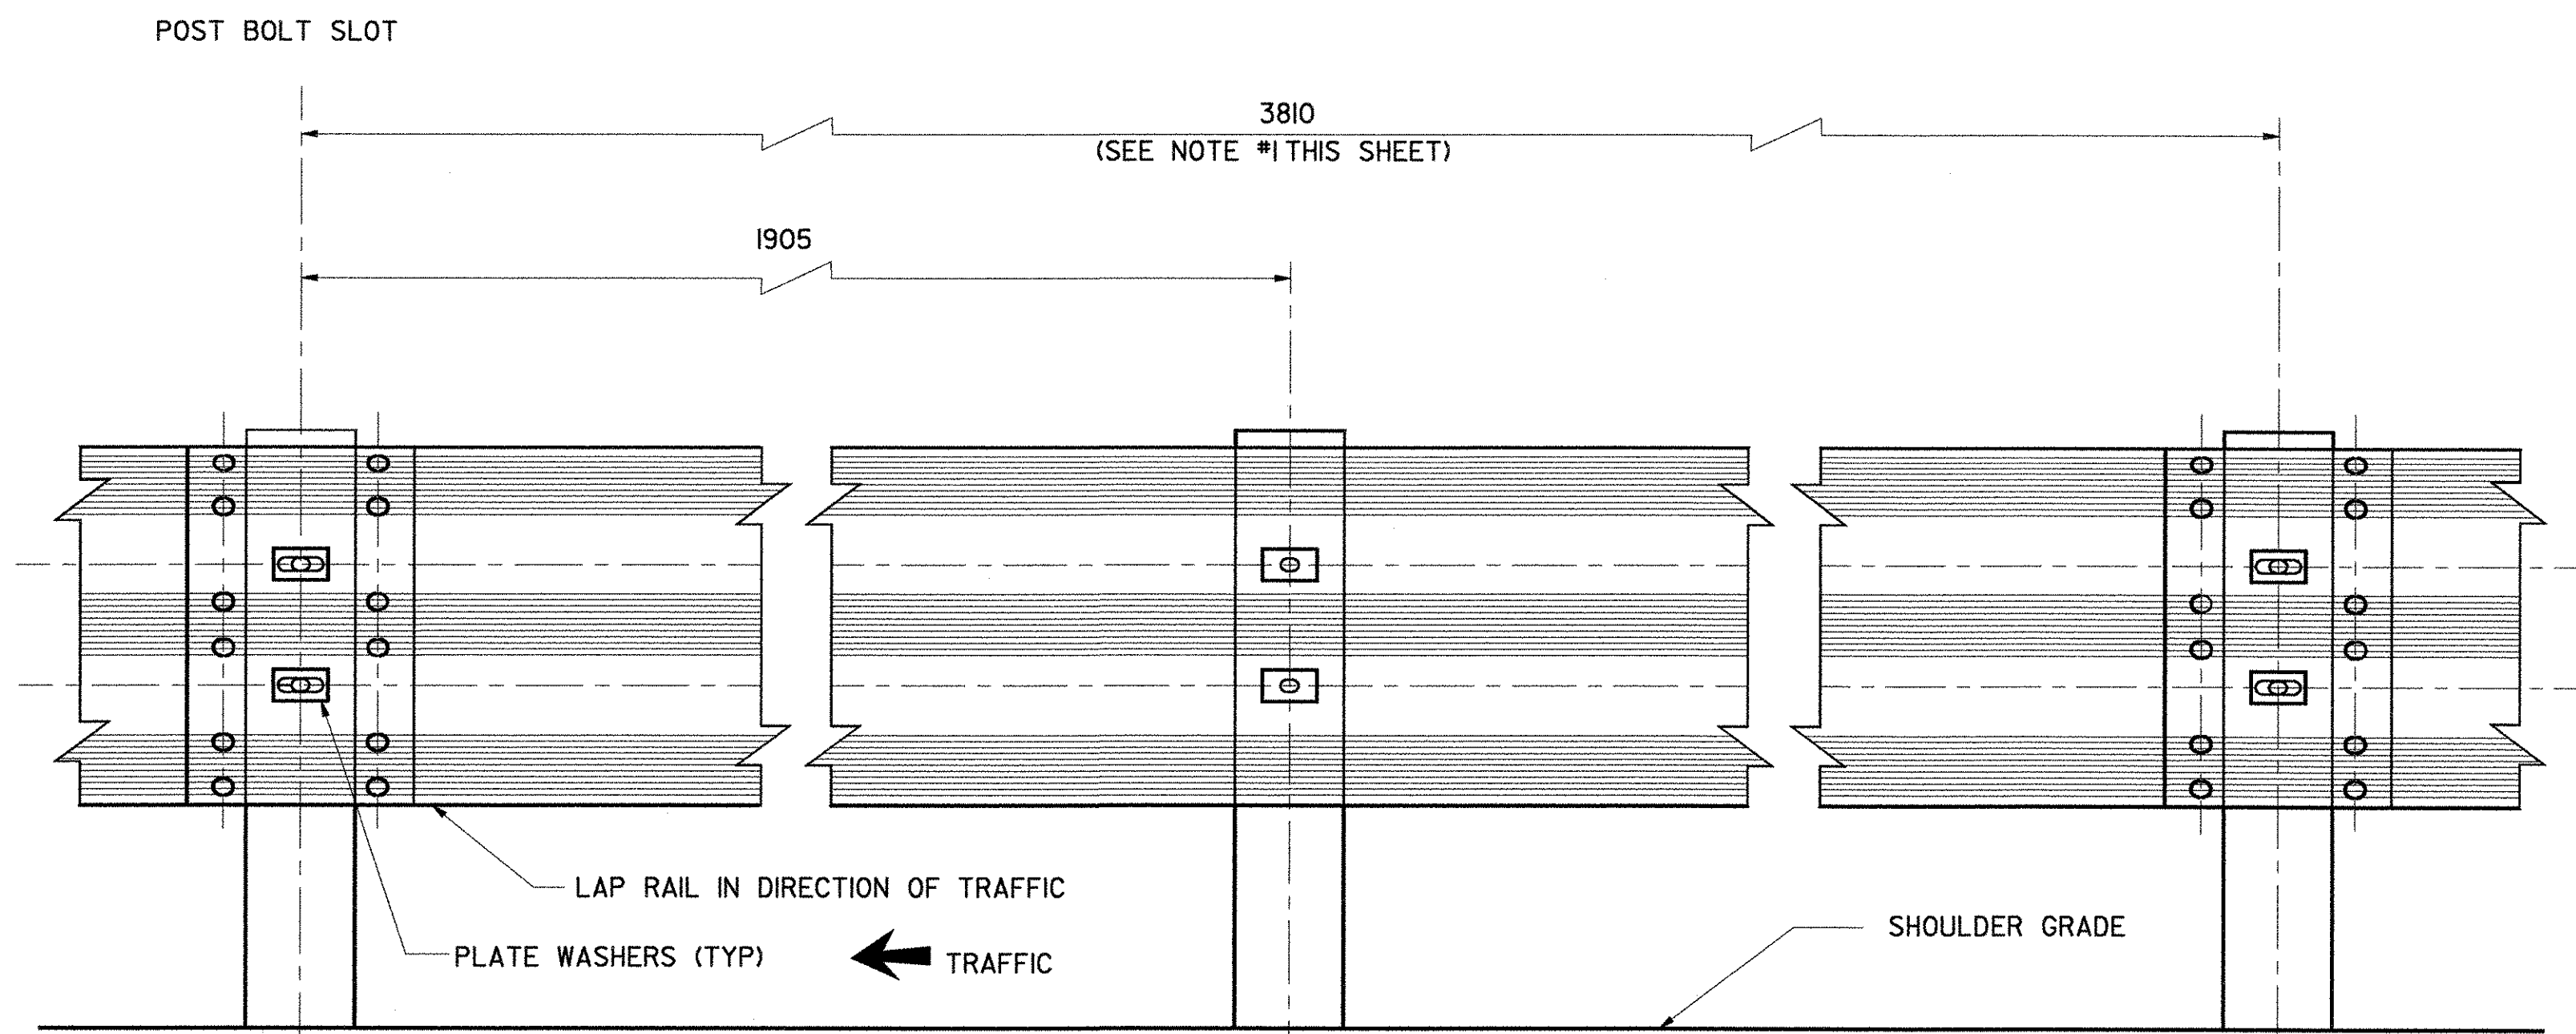


ELEVATION VIEW

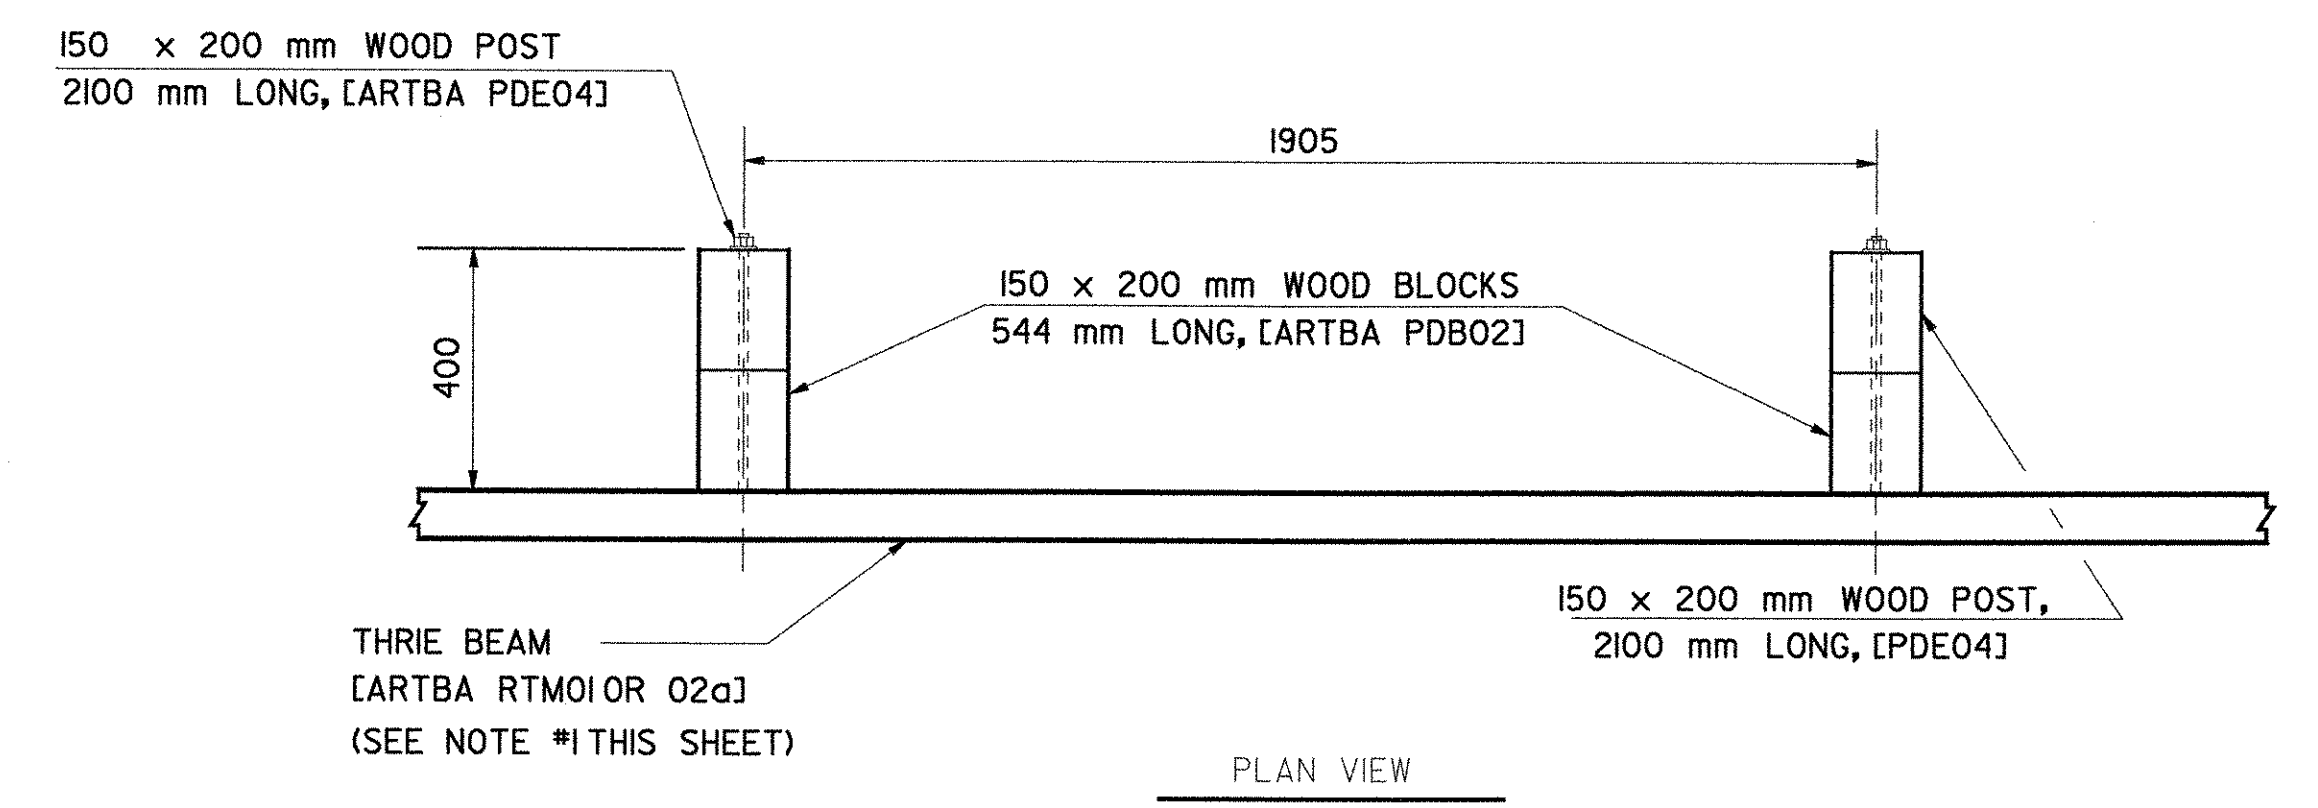


PLAN VIEW

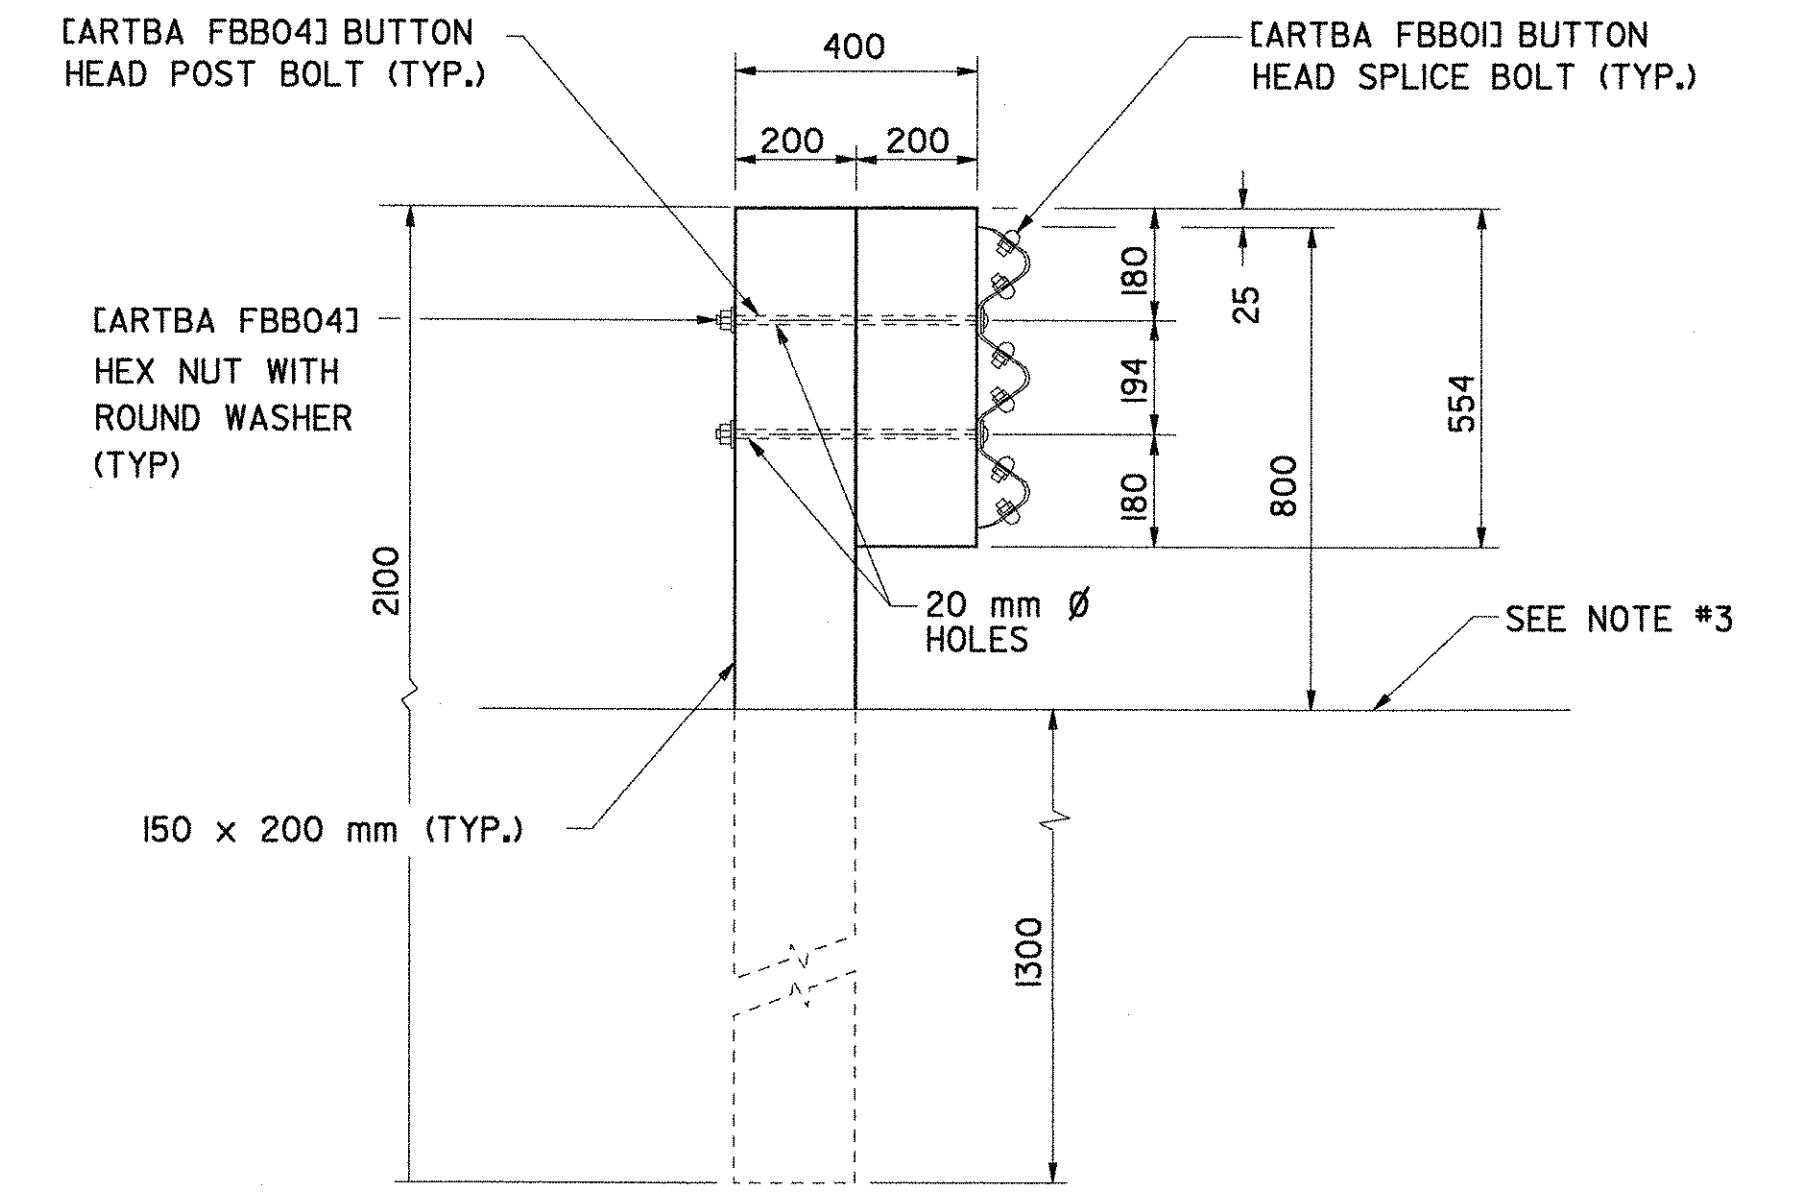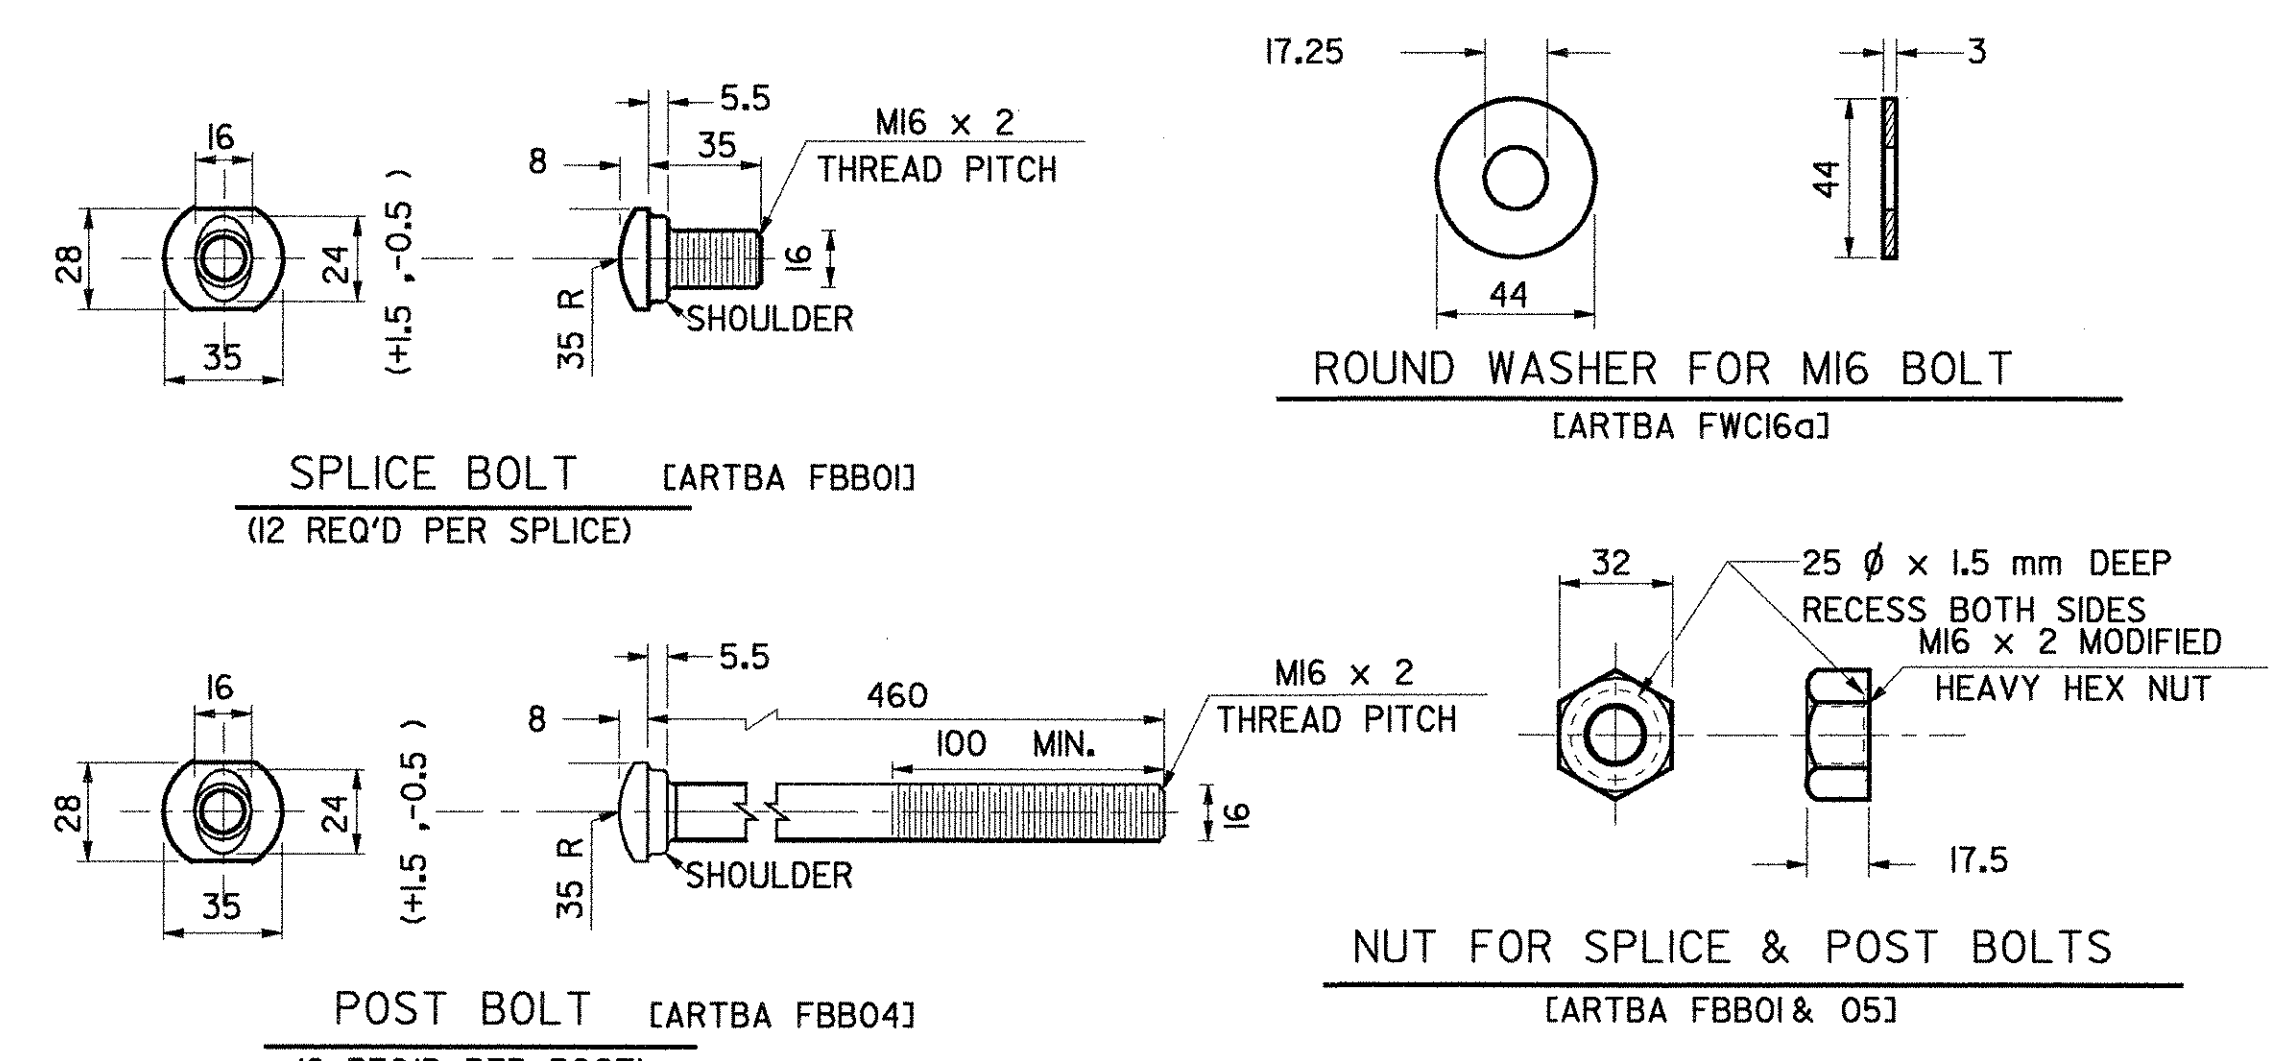

SIDE VIEW AT SPLICE POST

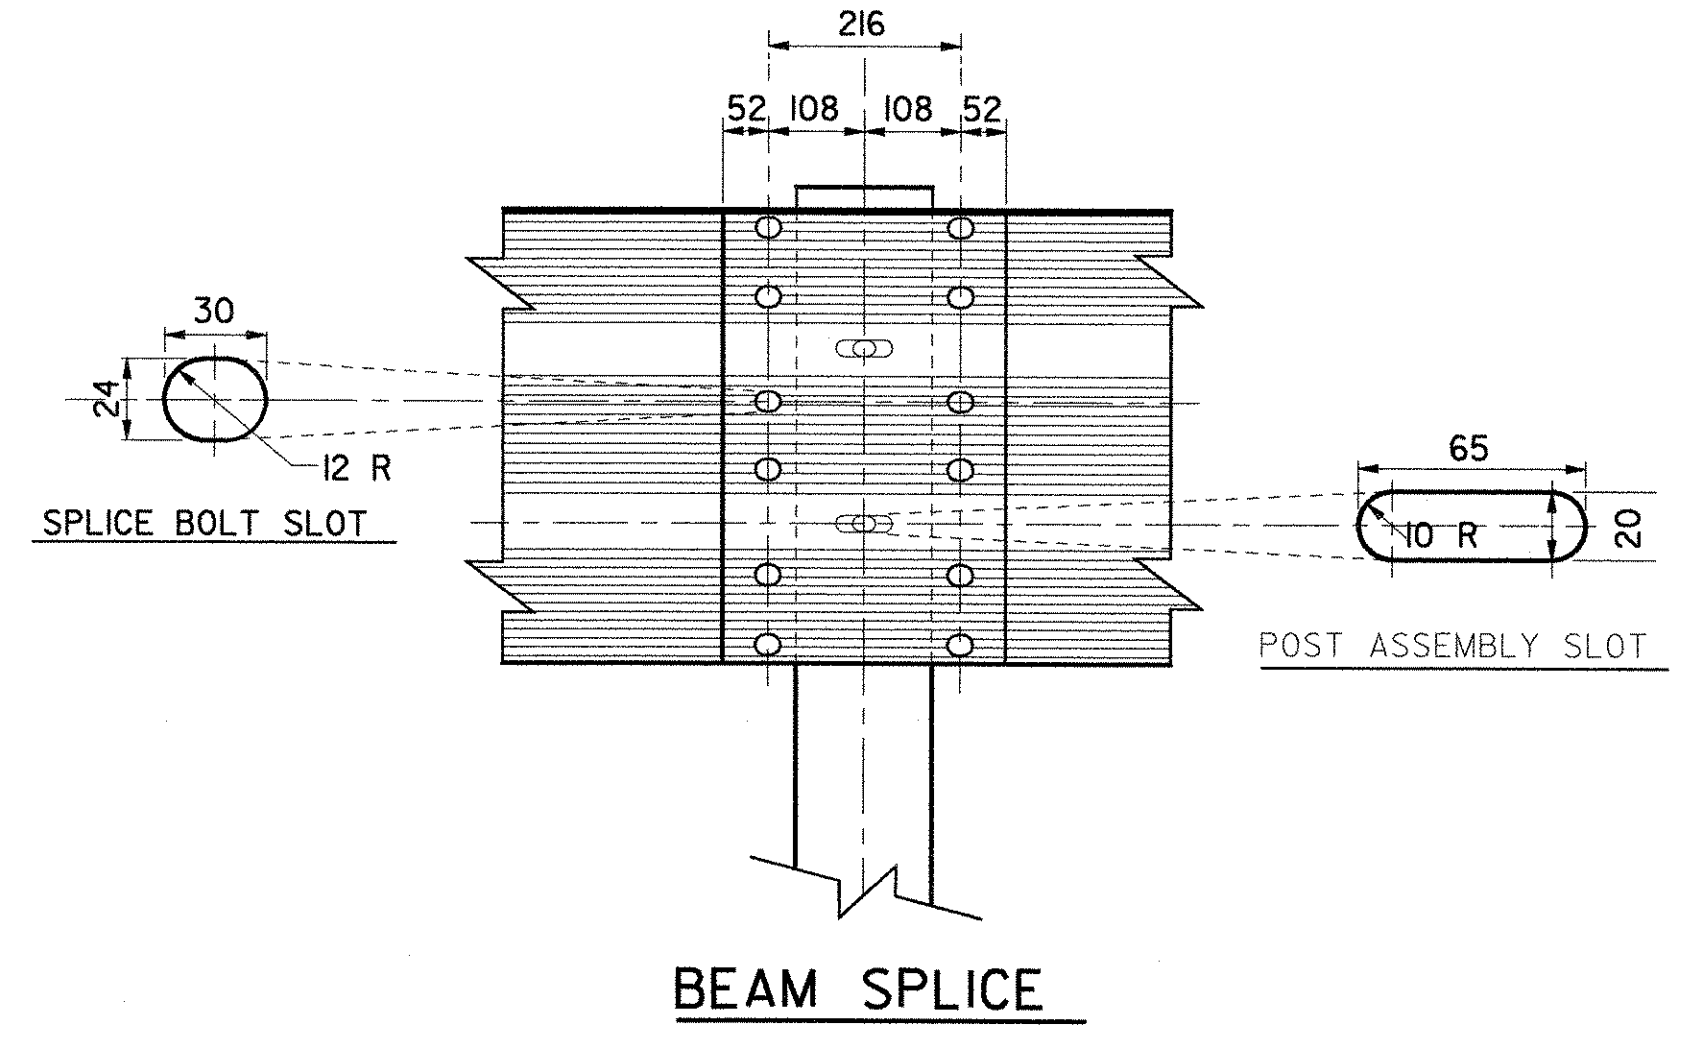

BEAM SPLICE

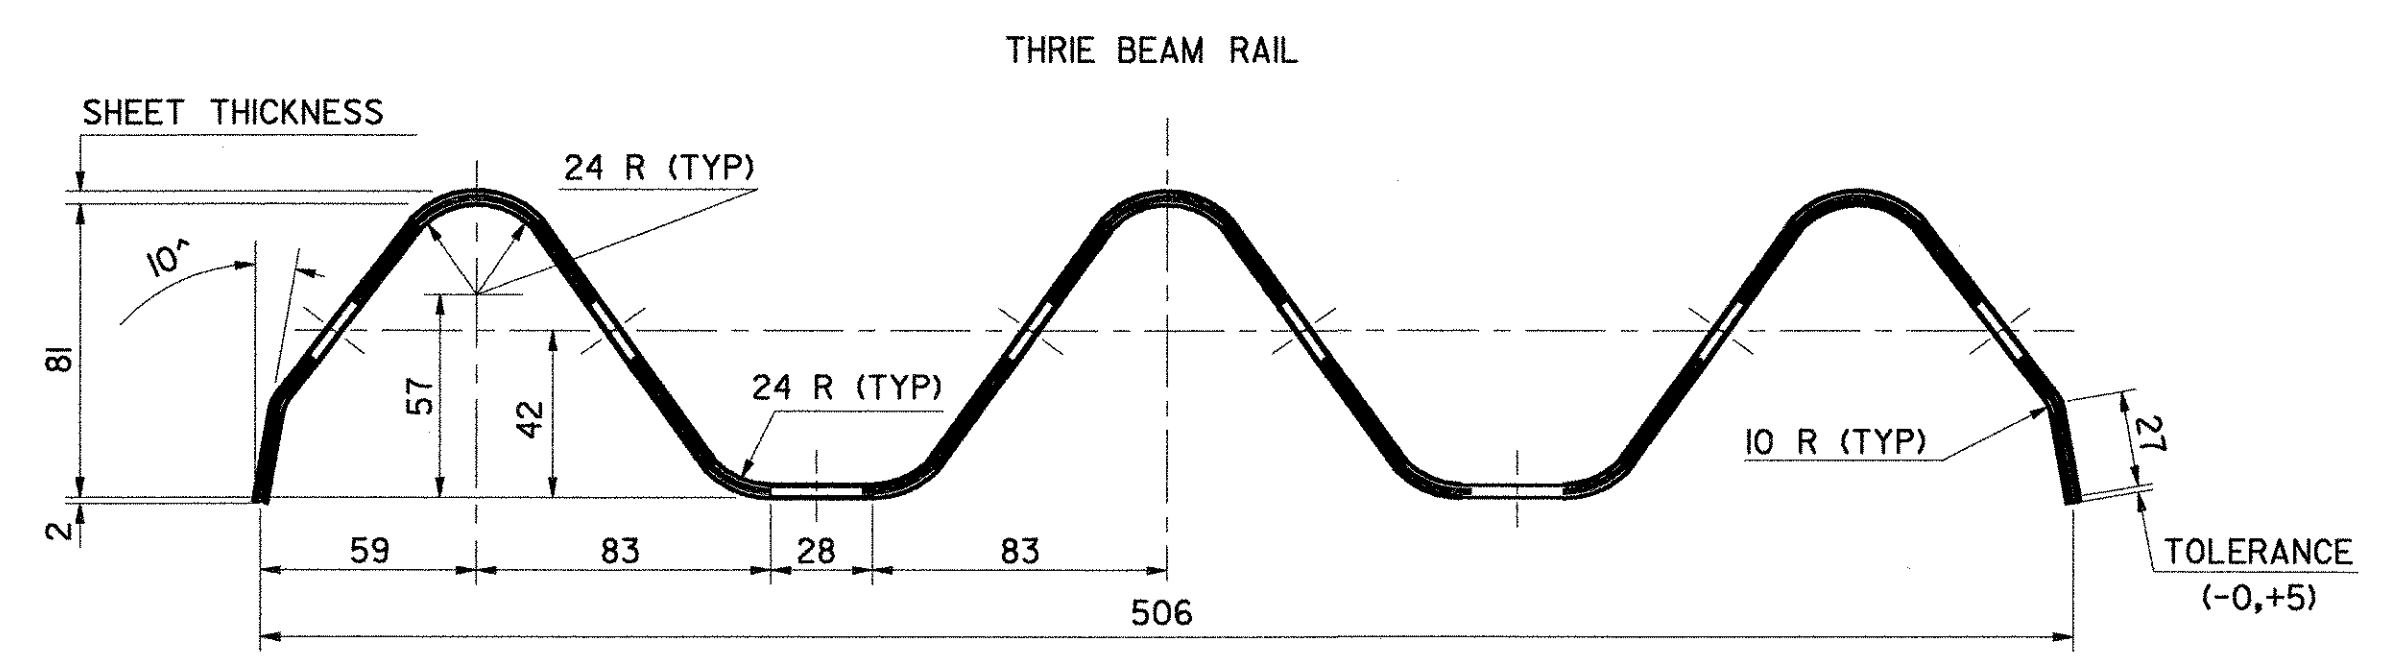

THRIE BEAM RAIL SECTION
[ARTBA RTM01a & RTM02a]

GENERAL NOTES

- (1) 7.6 m RAIL PANELS MAY BE USED IN PLACE OF 3.8 m PANELS, EXCEPT ON CURVES WITH A RADIUS OF LESS THAN 100 M.
- (2) ALL DIMENSIONS SUBJECT TO MANUFACTURER'S TOLERANCES.
- (3) GUARDRAIL HEIGHT SHALL BE SET FROM THE GRADE AT THE FACE OF RAIL.
- (4) FOR DESCRIPTION AND SPECIFICATION OF PARTS IDENTIFIED BY "ARTBA..." AND OTHER DETAILS OF POSTS, POST ACCESSORIES, FASTENERS, AND RAIL ELEMENTS, SEE AASHTO-ACC-ARTBA JOINT TASK FORCE NO. 13 TITLED "A GUIDE TO STANDARDIZED HIGHWAY BARRIER HARDWARE," LATEST EDITION.

DATUM	
VERTICAL	_____
HORIZONTAL	_____

PROJECT: BRATTLEBORO	PROJECT NO. : NH 010-2(2)
DESIGN FILE NAME: ...guardrail.dgn	PLOT DATE: 09/23/2002
IPARM FILE NAME:	SURVEY DATE:
SURVEYED BY:	DRAWN BY: PHL
SQUAD LEADER: W HUSBAND	SHEET: 12A OF 145
CLD REF NO. 00-0358	

QUANTITY SHEET



SUMMARY OF ESTIMATED QUANTITIES														TOTALS			DESCRIPTIONS			DETAILED SUMMARY OF QUANTITIES	
PART. UTILITY	NONPART. UTILITY	TRACK SUBGRADE	RT 9 RR BRG	RT 9 SO ABUT	RT 9 NO ABUT	SGT BK BRIDGE	SGT BK SO ABUT	SGT BK NO ABUT	SGT BK CHANNEL	ROADWAY	EROSION	TEMP EROSION	E & C ITEMS	ROUND	GRAND TOTAL	FINAL	UNIT	ITEMS	QUANTITIES	ITEMS	
		0.06								0.4					0.46		HA	Clearing and Grubbing		201.11	
		4													4		Each	Removing Medium Trees		201.15	
		1												EST	1		Each	Removing Large Trees		201.16	
		0.5													0.5		HA	Thinning and Trimming (MOD)		201.30	
		798								11033					11831		CM	Common Excavation		203.15	
										1228					1228		CM	Solid Rock Excavation		203.16	
				452	254										706		CM	Solid Rock Excavation (MOD - Close-In Rock Blasting)		203.16	
				28	4										32		CM	Solid Rock Excavation (MOD - Mechanical Removal of Rock)		203.16	
										50				EST	50		CM	Unclassified Excavation		203.17	
										50				EST	50		CM	Muck Excavation		203.20	
										130					130		CM	ChannelExcavation of Earth		203.25	
										290					290		CM	ChannelExcavation of Rock		203.26	
										138					138		CM	Unclassified ChannelExcavation		203.27	
										45					45		CM	Excavation of Surfaces and Pavements		203.28	
										819					819		CM	Sand Borrow		203.31	
		2345			160					13					2518		CM	Granular Borrow		203.32	
										3914					3914		SM	Fine Grading - Subgrade		203.40	
	240	50								1793		55			2138		CM	Trench Excavation of Earth		204.20	
										1612					1612		CM	Trench Excavation of Rock		204.21	
				532	2560					560					3652		CM	Structure Excavation		204.25	
				475	1625		100	200		143					2543		CM	Granular Backfill for Structures		204.30	
										1538					1538		SM	Drilling and Blasting of Solid Rock		205.20	
															497		CM	Cofferdam Excavation, Earth		208.30	
														EST.	4		CM	Cofferdam Excavation, Rock		208.35	
															1		LS	Cofferdam (Sta. 50+185.50)		208.40	
															1		LS	Cofferdam (Sta. 50+194.00)		208.40	
										320					320		SM	Cold Planing - Bituminous Pavement		210.10	

PROJECT NAME :	PROJECT NO. :
BRATTLEBORO	NH 010-2(2)
DESIGN FILE NAME: sf270qty.dgn	PLOT DATE: 10-03-2002
IPARM FILE NAME:	SURVEY DATE:
SURVEYED BY:	DRAWN BY: LB/LD/TT
SQUAD LEADER: JHR	SHEET: 13 OF 145

QUANTITY SHEET



SUMMARY OF ESTIMATED QUANTITIES															TOTALS			DESCRIPTIONS			DETAILED SUMMARY OF QUANTITIES	
PART. UTILITY	NONPART. UTILITY	TRACK SUBGRADE	RT 9 RR BRG	RT 9 SO ABUT	RT 9 NO ABUT	SGT BK BRIDGE	SGT BK SO ABUT	SGT BK NO ABUT	SGT BK CHANNEL	ROADWAY	EROSION	TEMP EROSION	E & C ITEMS		ROUND	GRAND TOTAL	FINAL	UNIT	ITEMS		QUANTITIES	ITEMS
										3338		274				3612		CM	Subbase of Dense Graded Crushed Stone		301.35	
										5						5		CM	Aggregate Surface Course		401.0	
										573						573		Kg	Emulsified Asphalt		404.65	
										1						1		LU	Price Adjustment Asphalt Cement		406.50	
										2630						2630		MT	Superpave Bituminous Concrete Pavement (PG 70-28)		490.30	
				263	247		63	119								692		CM	Concrete, High Performance Class A		501.33	
			42496													42496		Kg	Structural Steel (Rolled Beam)		506.50	
			89924													89924		Kg	Structural Steel (Plate Girder)		506.55	
			41335													41335		Kg	Structural Steel		506.60	
				13955	12838		463	946								28202		Kg	Reinforcing Steel		507.15	
							26	26								52		M	Drilling and Grouting Dowels		507.16	
									1							1		Each	Prestressed Concrete Member (MOD1-Precast Slab, LOM)		510.20	
									1							1		Each	Prestressed Concrete Member (MOD2-Precast Slab, 2.4M)		510.20	
										1						1		Each	Corrugated Gal. Metal Plate Pipe (MOD)		511.15	
			215			26										241		SM	Sheet Membrane Waterproofing (MOD 1)		519.20	
			216													216		SM	Sheet Membrane Waterproofing (MOD 2)		519.20	
					35											35		M	Metal Hand Railing (MOD)		525.15	
					216											216		SM	Mechanically Stabilized Earth (MSE) Wall		526.30	
			1													1		Each	Removal of Structure		529.15	
				220	220		15	15								470		CM	Removal of Concrete or Masonry		529.25	
			4													4		Each	Bearing Device Assembly		531.0	
			1													1		Each	Concrete Vault, Type 1 (3.6m x 1.8m x 2.1m)		540.21	
																			BEGIN PIPE OPTIONS			
										7						7		M	300mm CAAP 1.52 mm (68mm x 12mm)		601.0205	
										7						7		M	300mm PCCSP 1.63 mm (68mm x 12mm)		601.0405	
										7						7		M	300mm RCP Class III		601.0805	
										7						7		M	300mm CPEP (SL)		601.2605	
										85						85		M	450mm CAAP 1.52 mm (68mm x 12mm)		601.0215	
										85						85		M	450mm PCCSP 1.63 mm (68mm x 12mm)		601.0415	
										85						85		M	450mm RCP Class III		601.0815	
										85						85		M	450mm CPEP (SL)		601.2615	

PROJECT NAME : BRATTLEBORO PROJECT NO. : NH 010-2(2)

DESIGN FILE NAME: sf270qty.dgn PLOT DATE: 10-10-2002
 IPARM FILE NAME: SURVEYED BY: DRAWN BY: LB/LD/TT
 SURVEYED BY: SQUAD LEADER: JHR SHEET: 14 OF 145

QUANTITY SHEET



SUMMARY OF ESTIMATED QUANTITIES														TOTALS			DESCRIPTIONS			DETAILED SUMMARY OF QUANTITIES	
PART. UTILITY	NONPART. UTILITY	TRACK SUBGRADE	RT 9 RR BRG	RT 9 SO ABUT	RT 9 NO ABUT	SGT BK BRIDGE	SGT BK SO ABUT	SGT BK NO ABUT	SGT BK CHANNEL	ROADWAY	EROSION	TEMP EROSION	E & C ITEMS	ROUND	GRAND TOTAL	FINAL	UNIT	ITEMS		QUANTITIES	ITEMS
										206					206		M	750mm CAAP 1.52 mm (75mm x 25mm)	60L0305		
										206					206		M	750mm PCCSP 2.01mm (68mm x 12mm)	60L0436		
										34					34		M	900mm CAAP 1.52 mm (75mm x 25mm)	60L0310		
										34					34		M	900mm PCCSP 2.01mm (68mm x 12mm)	60L0446		
										61					61		M	450mm RCP Class III	60L0815		
										61					61		M	450mm CPEP (SL)	60L2615		
										6					6		M	600mm RCP Class III	60L0825		
										6					6		M	600mm CPEP (SL)	60L2620		
										128					128		M	750mm RCP Class III	60L0835		
										128					128		M	750mm CPEP (SL)	60L2625		
										86					86		M	900mm RCP Class III	60L0845		
										86					86		M	900mm CPEP (SL)	60L2630		
										1					1		Each	750mm RCPEP Class III	60L6835		
										1					1		Each	750mm CPEPES	60L7025		
										1					1		Each	900mm RCPEP Class III	60L6845		
										1					1		Each	900mm CPEPES	60L7030		
																		END PIPE OPTIONS			
										14					14		Each	Precast Reinf. Conc. Catch Basin w/ CIG	604.20		
										2					2		Each	Precast Reinf. Conc. Catch Basin w/ CIG (1.5m)	604.20		
										4					4		Each	Precast Reinf. Conc. Catch Basin w/ CIG (1.8m)	604.20		
										1					1		Each	Precast Reinf. Conc. Catch Basin w/ CIG (2.1m)	604.20		
										1					1		Each	Precast Reinf. Conc. C.B. w/CIG 2.7m x 2.4m	604.20		
										1					1		Each	Precast Reinf. Conc. C.B. w/ CIG (1.5m x 1.5m)	604.20		
										5					5		Each	Precast Reinf. Conc. Manhole w/ CIG (1.5m)	604.21		
										1					1		Each	Precast Reinf. Conc. Manhole w/ CIG (1.8m)	604.21		
										3					3		Each	*Changing Elev. of D.I., C. B. or M.H.*	604.40		
										311					311		M	150mm Underdrain	605.10		
										7					7		M	150mm Underdrain Carrier Pipe	605.20		
										9					9		Each	Underdrain Flushing Basins	605.95		
										1					1		Hour	*Bulldozer Rental, Type I*	608.10		
										1					1		Hour	Power Grader Rental	608.15		
										1					1		Hour	*All Purpose Excavator Rental, Type I*	608.25		
										1					1		Hour	Power Broom Rental	608.30		

PROJECT NAME :	PROJECT NO. :
BRATTLEBORO	NH 010-2(2)
DESIGN FILE NAME: sf270qty.dgn	PLOT DATE: 10-01-2002
IPARM FILE NAME:	SURVEY DATE:
SURVEYED BY:	DRAWN BY: LB/LD/TT
SQUAD LEADER: JHR	SHEET: 15 OF 145

SUMMARY OF ESTIMATED QUANTITIES														TOTALS			DESCRIPTIONS		DETAILED SUMMARY OF QUANTITIES	
PART. UTILITY	NONPART. UTILITY	TRACK SUBGRADE	RT 9 RR BRG	RT 9 SO ABUT	RT 9 NO ABUT	SGT BK BRIDGE	SGT BK SO ABUT	SGT BK NO ABUT	SGT BK CHANNEL	ROADWAY	EROSION	TEMP EROSION	E & C ITEMS	ROUND	GRAND TOTAL	FINAL	UNIT	ITEMS	QUANTITIES	ITEMS
										1					1		Hour	*Power Broom Rental, Type II*	608.31	
										1					1		Hour	Truck Rental	608.37	
										1					1		Hour	*Loader Rental, Type I*	608.40	
			249							662					911		CM	Dust Control with Water	609.10	
										212		27			239		CM	*Stone Fill, Type I*	613.10	
					14					112					126		CM	*Stone Fill, Type II*	613.11	
									107						107		CM	*Stone Fill, Type III*	613.12	
										120					120		CM	*Stone Fill, Type IV*	613.13	
										568					568		M	Vertical Granite Curb	616.21	
										2					2		M	Removing and Resetting Curb	616.40	
										469					469		SM	*Portland Cement Concrete Sidewalk, 125mm*	618.10	
										22					22		SM	*Portland Cement Concrete Sidewalk, 200mm*	618.11	
										5					5		Each	Steel Marker Posts (MOD)	619.16	
										22					22		Each	Yielding Marker Posts	619.17	
										3					3		EACH	Removing and Resetting Property Markers	619.20	
										1					1		Each	Removing and Resetting Property Markers (MOD)	619.20	
										26					26		M	Chain Link Fence, 1.8M	620.12	
										8					8		M	*Gate for Chain-Link Fence, 1.8m*	620.16	
										6					6		Each	*Bracing Assembly for Chain-Link Fence, 1.8m*	620.21	
			52							7					59		M	Removal of Existing Fence	620.55	
			191							105					296		M	Snow Fence (MOD)	620.70	
										35					35		M	Plank Rail	621.15	
										8					8		M	Steel Beam Guard Rail	621.20	
										2					2		Each	Anchor for Steel Beam Rail	621.60	
										2					2		Each	Guardrail Approach Section, Type I (MOD)	621.70	
																	M	Removal and Disposal of Guard Rail	621.80	
																	M	Temporary Traffic Barrier	621.90	
															0.90		M	Ducts, Concrete Encased	624.20	
				0.45	0.45										200		M	Ducts, Concrete Encased (6-100mm PVC, Type C)	624.20	
															40		M	Ducts, Concrete Encased (4-100mm PVC, Type C)	624.20	

2 Addendum two, New Item Added
Dec 6, 2002

13
2-260

13
2-260

PROJECT NAME : BRATTLEBORO	PROJECT NO. : NH 010-2(2)
DESIGN FILE NAME: sf270qty.dgn	PLOT DATE: 10-03-2002
IPARM FILE NAME:	SURVEY DATE:
SURVEYED BY:	DRAWN BY: LB/LD/TT
SQUAD LEADER: JHR	SHEET: 16 OF 145

QUANTITY SHEET



SUMMARY OF ESTIMATED QUANTITIES														TOTALS			DESCRIPTIONS			DETAILED SUMMARY OF QUANTITIES	
PART. UTILITY	NONPART. UTILITY	TRACK SUBGRADE	RT 9 RR BRG	RT 9 SO ABUT	RT 9 NO ABUT	SGT BK BRIDGE	SGT BK SO ABUT	SGT BK NO ABUT	SGT BK CHANNEL	ROADWAY	EROSION	TEMP EROSION	E & C ITEMS	ROUND	GRAND TOTAL	FINAL	UNIT	ITEMS	QUANTITIES	ITEMS	
										1					1		Each	Adjust Elevation of Valve Box		629.20	
										1041					1041		Hour	Uniformed Traffic Officers		630.10	
										1727					1727		Hour	Flaggers		630.15	
			1360												1360		Hour	Flaggers (MOD-Railroad)		630.15	
													1		1		LS	Field Office - Engineers		631.10	
													1		1		LS	Testing Equipment - Concrete		631.16	
													1		1		LS	Testing Equipment - Bituminous		631.17	
													1		1		LU	Field Office Telephone (NABI)		631.25	
										1040					1040		Hour	Employee Traineeship		634.10	
										1					1		LS	Mobilization		635.10	
										1					1		LS	Traffic Control		641.10	
										2					2		Each	Portable Changeable Message Sign		641.15	
										617					617		M	Durable 100mm White Line		646.40	
										606					606		M	Durable 100mm Yellow Line		646.41	
										28					28		M	Durable 200mm Yellow Line		646.43	
										10					10		Each	Durable Letter or Symbol		646.50	
										617					617		M	Temporary 100mm White Line		646.60	
										606					606		M	Temporary 100mm Yellow Line		646.61	
										10					10		Each	Temporary Letters or Symbols		646.70	
										99					99		Each	Line Striping Targets		646.76	
					66			48		1364					1478		SM	Geotextile Under Stone Fill		649.31	
										3053					3053		SM	Geotextile for Underdrain Trench Lining		649.41	
			583								36	227			846		SM	Geotextile for Silt Fence		649.51	
							36	38		36					110		SM	Geotextile for Filter Curtains		649.61	
										24	15				39		Kg	Seed		651.15	
												48			48		Kg	Seed - Winter Rye		651.17	
										150	89				239		Kg	Fertilizer		651.18	

PROJECT NAME :	PROJECT NO. :
BRATTLEBORO	NH 010-2(2)
DESIGN FILE NAME: sf270qty.dgn	PLOT DATE: 10-11-2002
IPARM FILE NAME:	SURVEY DATE:
SURVEYED BY:	DRAWN BY: LB/LD/TT
SQUAD LEADER: JHR	SHEET: 17 OF 145

QUANTITY SHEET



SUMMARY OF ESTIMATED QUANTITIES														TOTALS			DESCRIPTIONS			DETAILED SUMMARY OF QUANTITIES	
PART. UTILITY	NONPART. UTILITY	TRACK SUBGRADE	RT 9 RR BRG	RT 9 SO ABUT	RT 9 NO ABUT	SGT BK BRIDGE	SGT BK SO ABUT	SGT BK NO ABUT	SGT BK CHANNEL	ROADWAY	EROSION	TEMP EROSION	E & C ITEMS	ROUND	GRAND TOTAL	FINAL	UNIT	ITEMS	ITEM #	QUANTITIES	ITEMS
										2	1	1			4		MT	Agricultural Limestone	651.20		
										2	1	1			4		MT	Hay Mulch	651.25		
												747			747		Each	Hay Bales for Erosion Control	651.26		
										150	80				230		CM	Topsoil	651.35		
								50		200					250		SM	Grubbing Material	651.40		
											185	270			455		SM	Erosion Matting	654.10		
										6					6		Each	Transplanting Trees	656.45		
										4					4		SM	Traffic Signs, Type A	675.20		
			15							245					260		M	Flanged Channel Sign Post	675.301		
										61					61		Kg	Tubular Steel Sign Posts	675.33		
										2					2		Each	Foundation for Tubular Steel Posts	675.43		
										49					49		Each	Removing Signs	675.50		
										32					32		Each	Erecting Salvaged Signs	675.60		
640															640		M	Electrical Conduit (MOD-Fiber Optic)	678.21		
										1					1		SM	Travel Information Signs	680.20		
				1											1		LS	Maintenance of Rail Traffic (Temporary Excavation Support of Track and Embankment - Route 9)	960.10		
							1								1		LS	Maintenance of Rail Traffic (Temporary Excavation Support of Track and Embankment - Sargent Brook)	960.10		

PROJECT NAME :	PROJECT NO. :
BRATTLEBORO	NH 010-2(2)
DESIGN FILE NAME: sf270qty.dgn	PLOT DATE: 10-01-2002
IPARM FILE NAME:	SURVEY DATE:
SURVEYED BY:	DRAWN BY: LB/LD/TT
SQUAD LEADER: JHR	SHEET: 18 OF 145

ITEM DETAIL SHEET




CURB				
BEGIN STATION km + m	END STATION km + m	POSITION		REMARKS
		LEFT m	RIGHT m	
30+099.7	30+331.5	231.8		
30+101.5	30+327.9		226.4	
30+115.3	30+152.8	37.5	37.5	ISLAND
30+334.0	A 203+50.0		17.9	
30+335.1	A 203+50.0	16.8		
TOTAL		286.1 +	281.8 =	567.9

SIDEWALK				
BEGIN STATION km + m	END STATION km + m	POSITION		REMARKS
		LEFT m ²	RIGHT m ²	
30+047.2	30+091.5		66.4	125 mm
30+091.5	30+101.5		15	200 mm
30+101.5	30+328.6		340.6	125 mm
30+328.6	30+333.1		6.8	200 mm
30+333.1	A 203+64.1		92.9	125 mm Width Varies
TOTAL			521.7 =	521.7

GUARD RAIL					
BEGIN STATION km + m	END STATION km + m	POSITION		END TREATMENT	
		LEFT m	RIGHT m	BEGIN ea	END ea
30+175.9	30+210.6	34.7			
30+340.1	A 203+42.2	3.9		G1-d	
30+340.1	A 203+42.1		3.8	G1-d	
A 203+42.1	A 203+52.2	1			
A 203+42.1	A 203+52.2		1		
TOTAL	PLANK	34.7 +	0.0 =	34.7	
TOTAL	STEEL BEAM	3.9 +	3.8 =	7.7	
TOTAL	APPR RAIL SECT TYPE I (MOD)	1. +	1. =	2	

UNDERDRAIN										
BEGIN STATION km + m	END STATION km + m	TYPE	POSITION	DIA. mm	LENGTH m	TRENCH		GRAN BK FILL m ³	FB ea	MKR PST ea
						EARTH m ³	ROCK m ³			
30+089	30+151	U	LT	150	62	123			1	1
30+089	30+144	U	RT	150	55	111			1	1
30+144	30+151	C	RT	150	7	9				
30+154	30+180	U	LT	150	26	47			1	1
30+182	30+250	U	LT	150	68	77	26		1	1
30+252	30+285	U	LT	150	33		71		1	1
30+287	30+326	U	LT	150	39		85		1	1
30+310	30+326	U	RT	150	16		33		1	1
30+326	A 203+50	U	LT	150	6	9	39		1	1
30+326	A 203+50	U	RT	150	6	9	42		1	1
TOTAL	UNDERDRAIN					311	376	296	0	9
TOTAL	CARRIER PIPE					7	9	0	0	

PROJECT NAME: BRATTLEBORO
 PROJECT NUMBER: NH 010-2(2)
 FILE NAME: zb270ids.xls
 PROJECT LEADER: W HUSBAND
 DESIGNED BY: P SHEDD
 ITEM DETAIL SHEET #1
 PLOT DATE: 1/17/2002
 DRAWN BY: P SHEDD
 CHECKED BY: J WARNER
 SHEET 19 OF 145

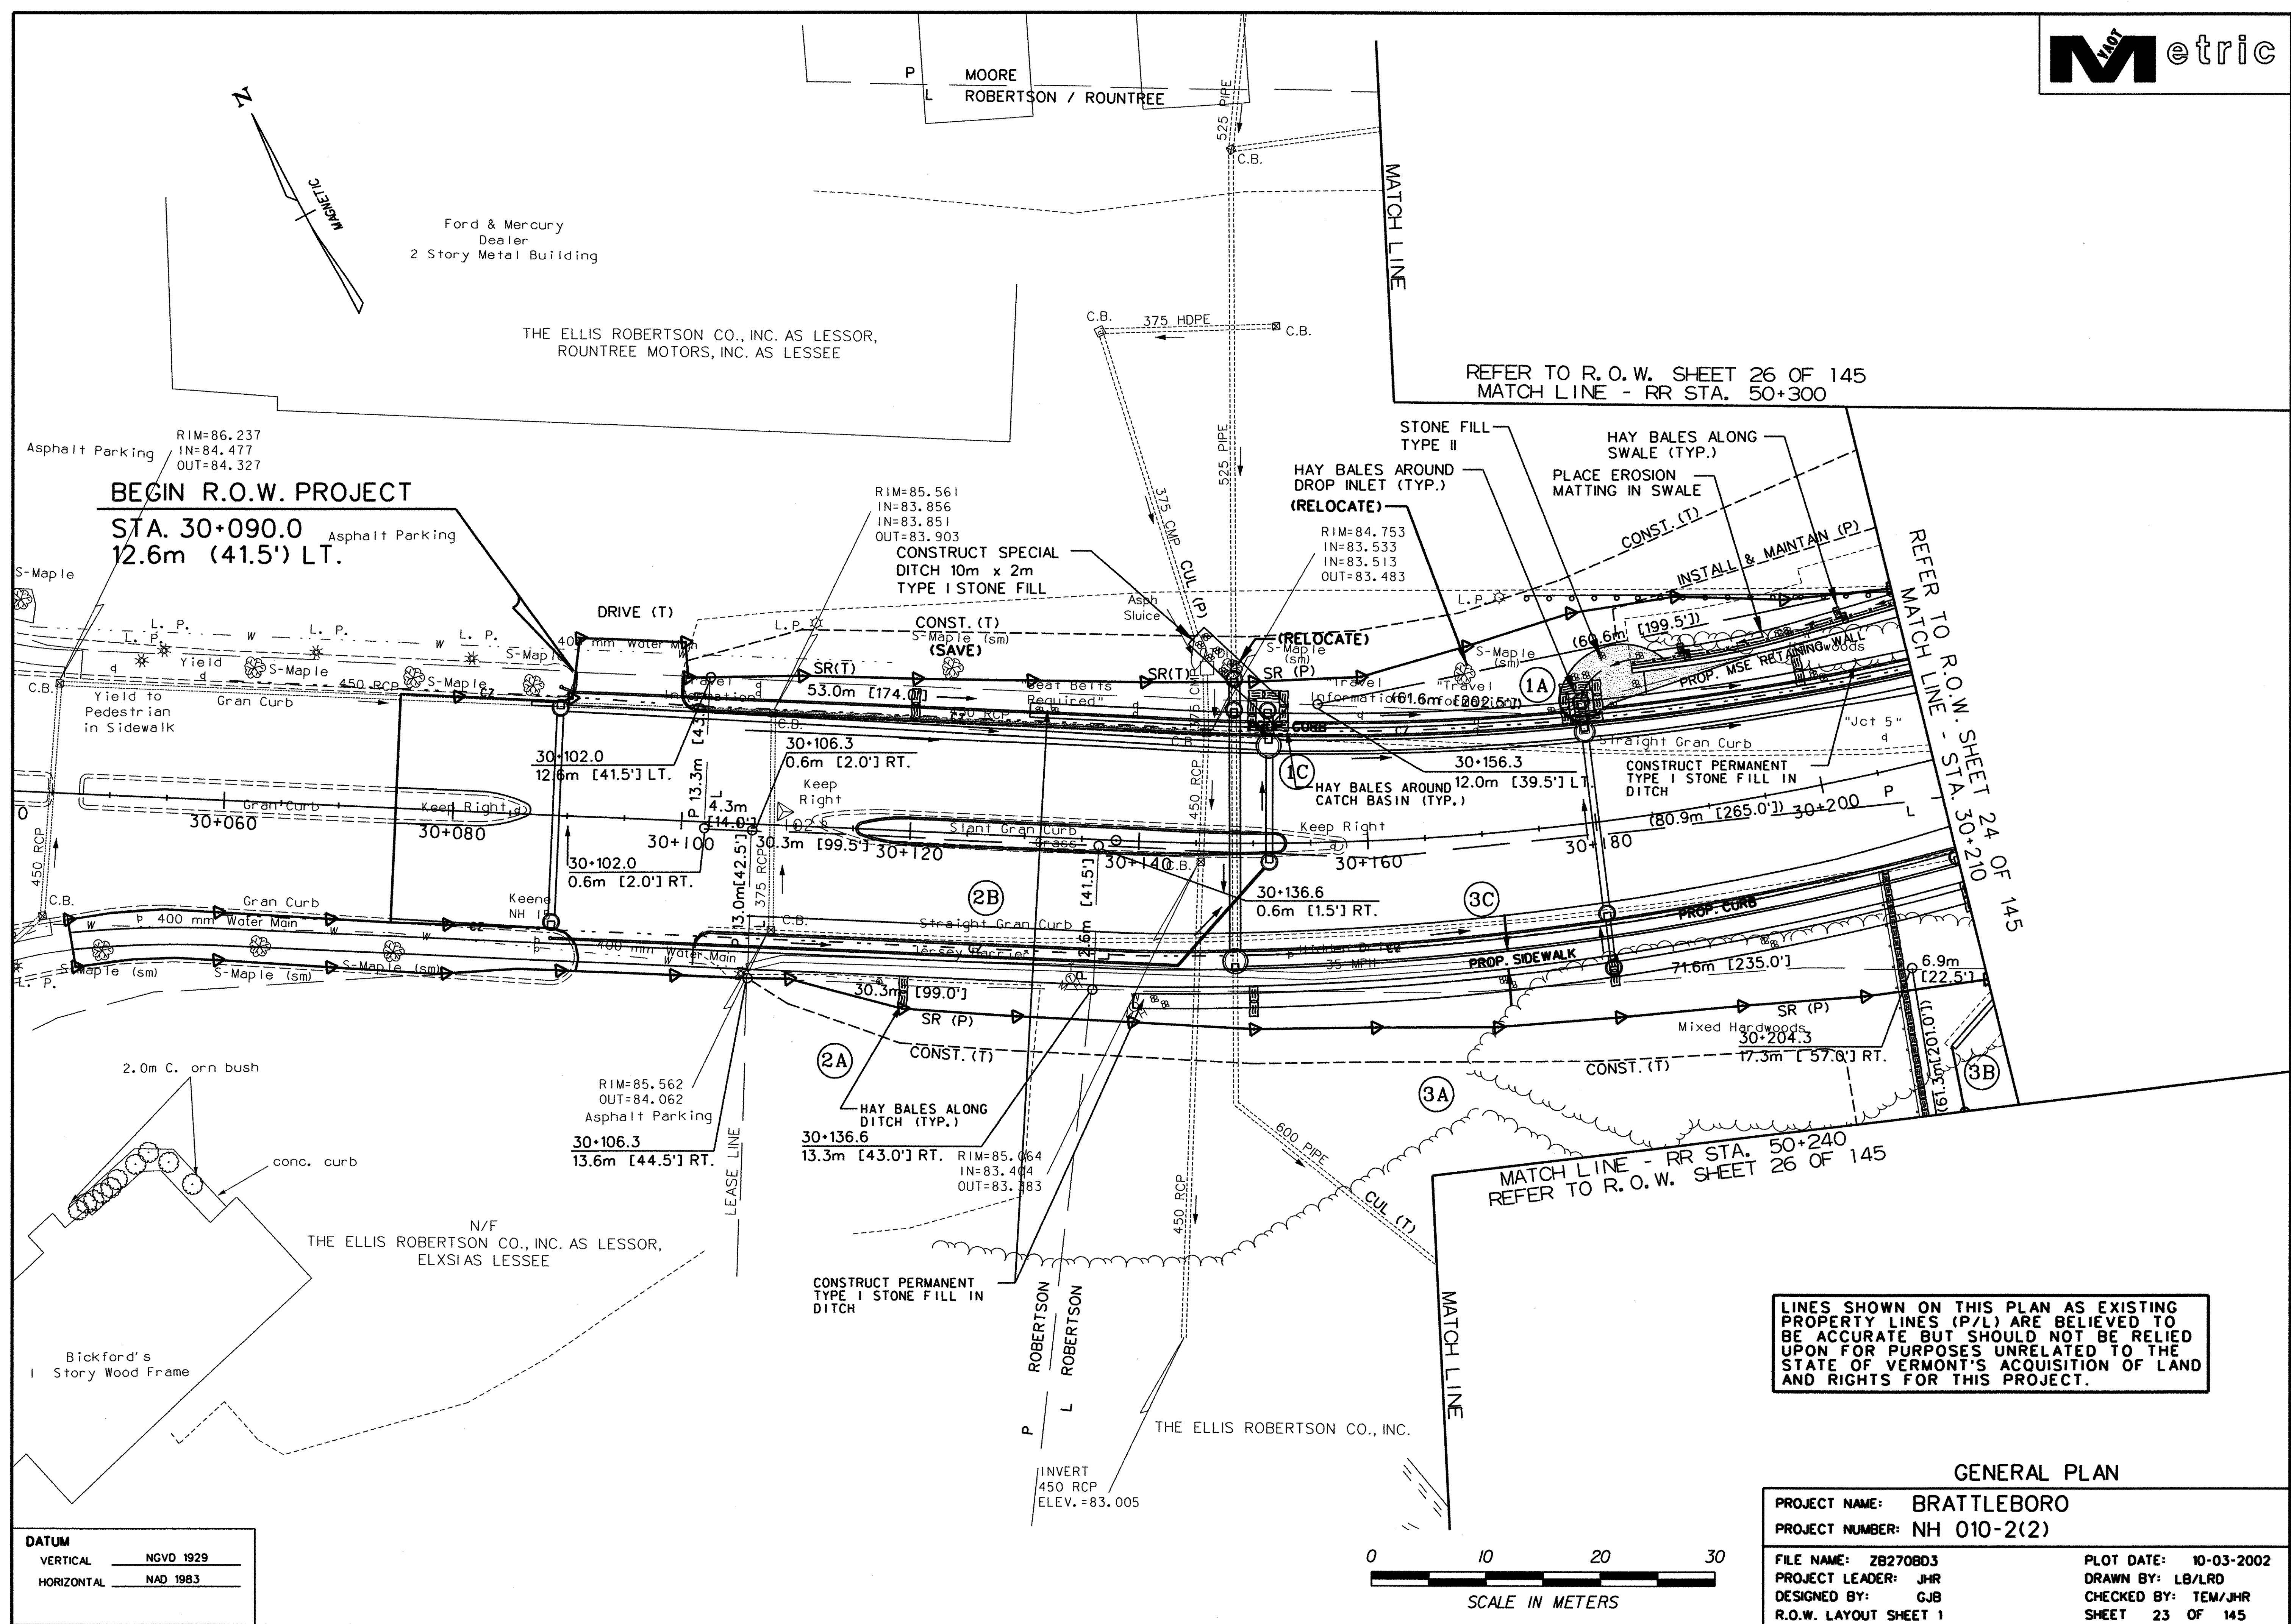

BEGIN R.O.W. PROJECT
STA. 30+090.0
12.6m (41.5') LT.

REFER TO R.O.W. SHEET 26 OF 145
 MATCH LINE - RR STA. 50+300

MATCH LINE - RR STA. 50+240
 REFER TO R.O.W. SHEET 26 OF 145

LINES SHOWN ON THIS PLAN AS EXISTING PROPERTY LINES (P/L) ARE BELIEVED TO BE ACCURATE BUT SHOULD NOT BE RELIED UPON FOR PURPOSES UNRELATED TO THE STATE OF VERMONT'S ACQUISITION OF LAND AND RIGHTS FOR THIS PROJECT.

DATUM


VERTICAL	NGVD 1929
HORIZONTAL	NAD 1983



GENERAL PLAN

PROJECT NAME:	BRATTLEBORO	PLOT DATE:	10-03-2002
PROJECT NUMBER:	NH 010-2(2)	DRAWN BY:	LB/LRD
FILE NAME:	ZB270BD3	CHECKED BY:	TEM/JHR
PROJECT LEADER:	JHR	R.O.W. LAYOUT SHEET	1
DESIGNED BY:	GJB	SHEET	23 OF 145

THE ELLIS ROBERTSON CO., INC., AS LESSOR
 ROUNTREE MOTORS, INC., AS LESSEE

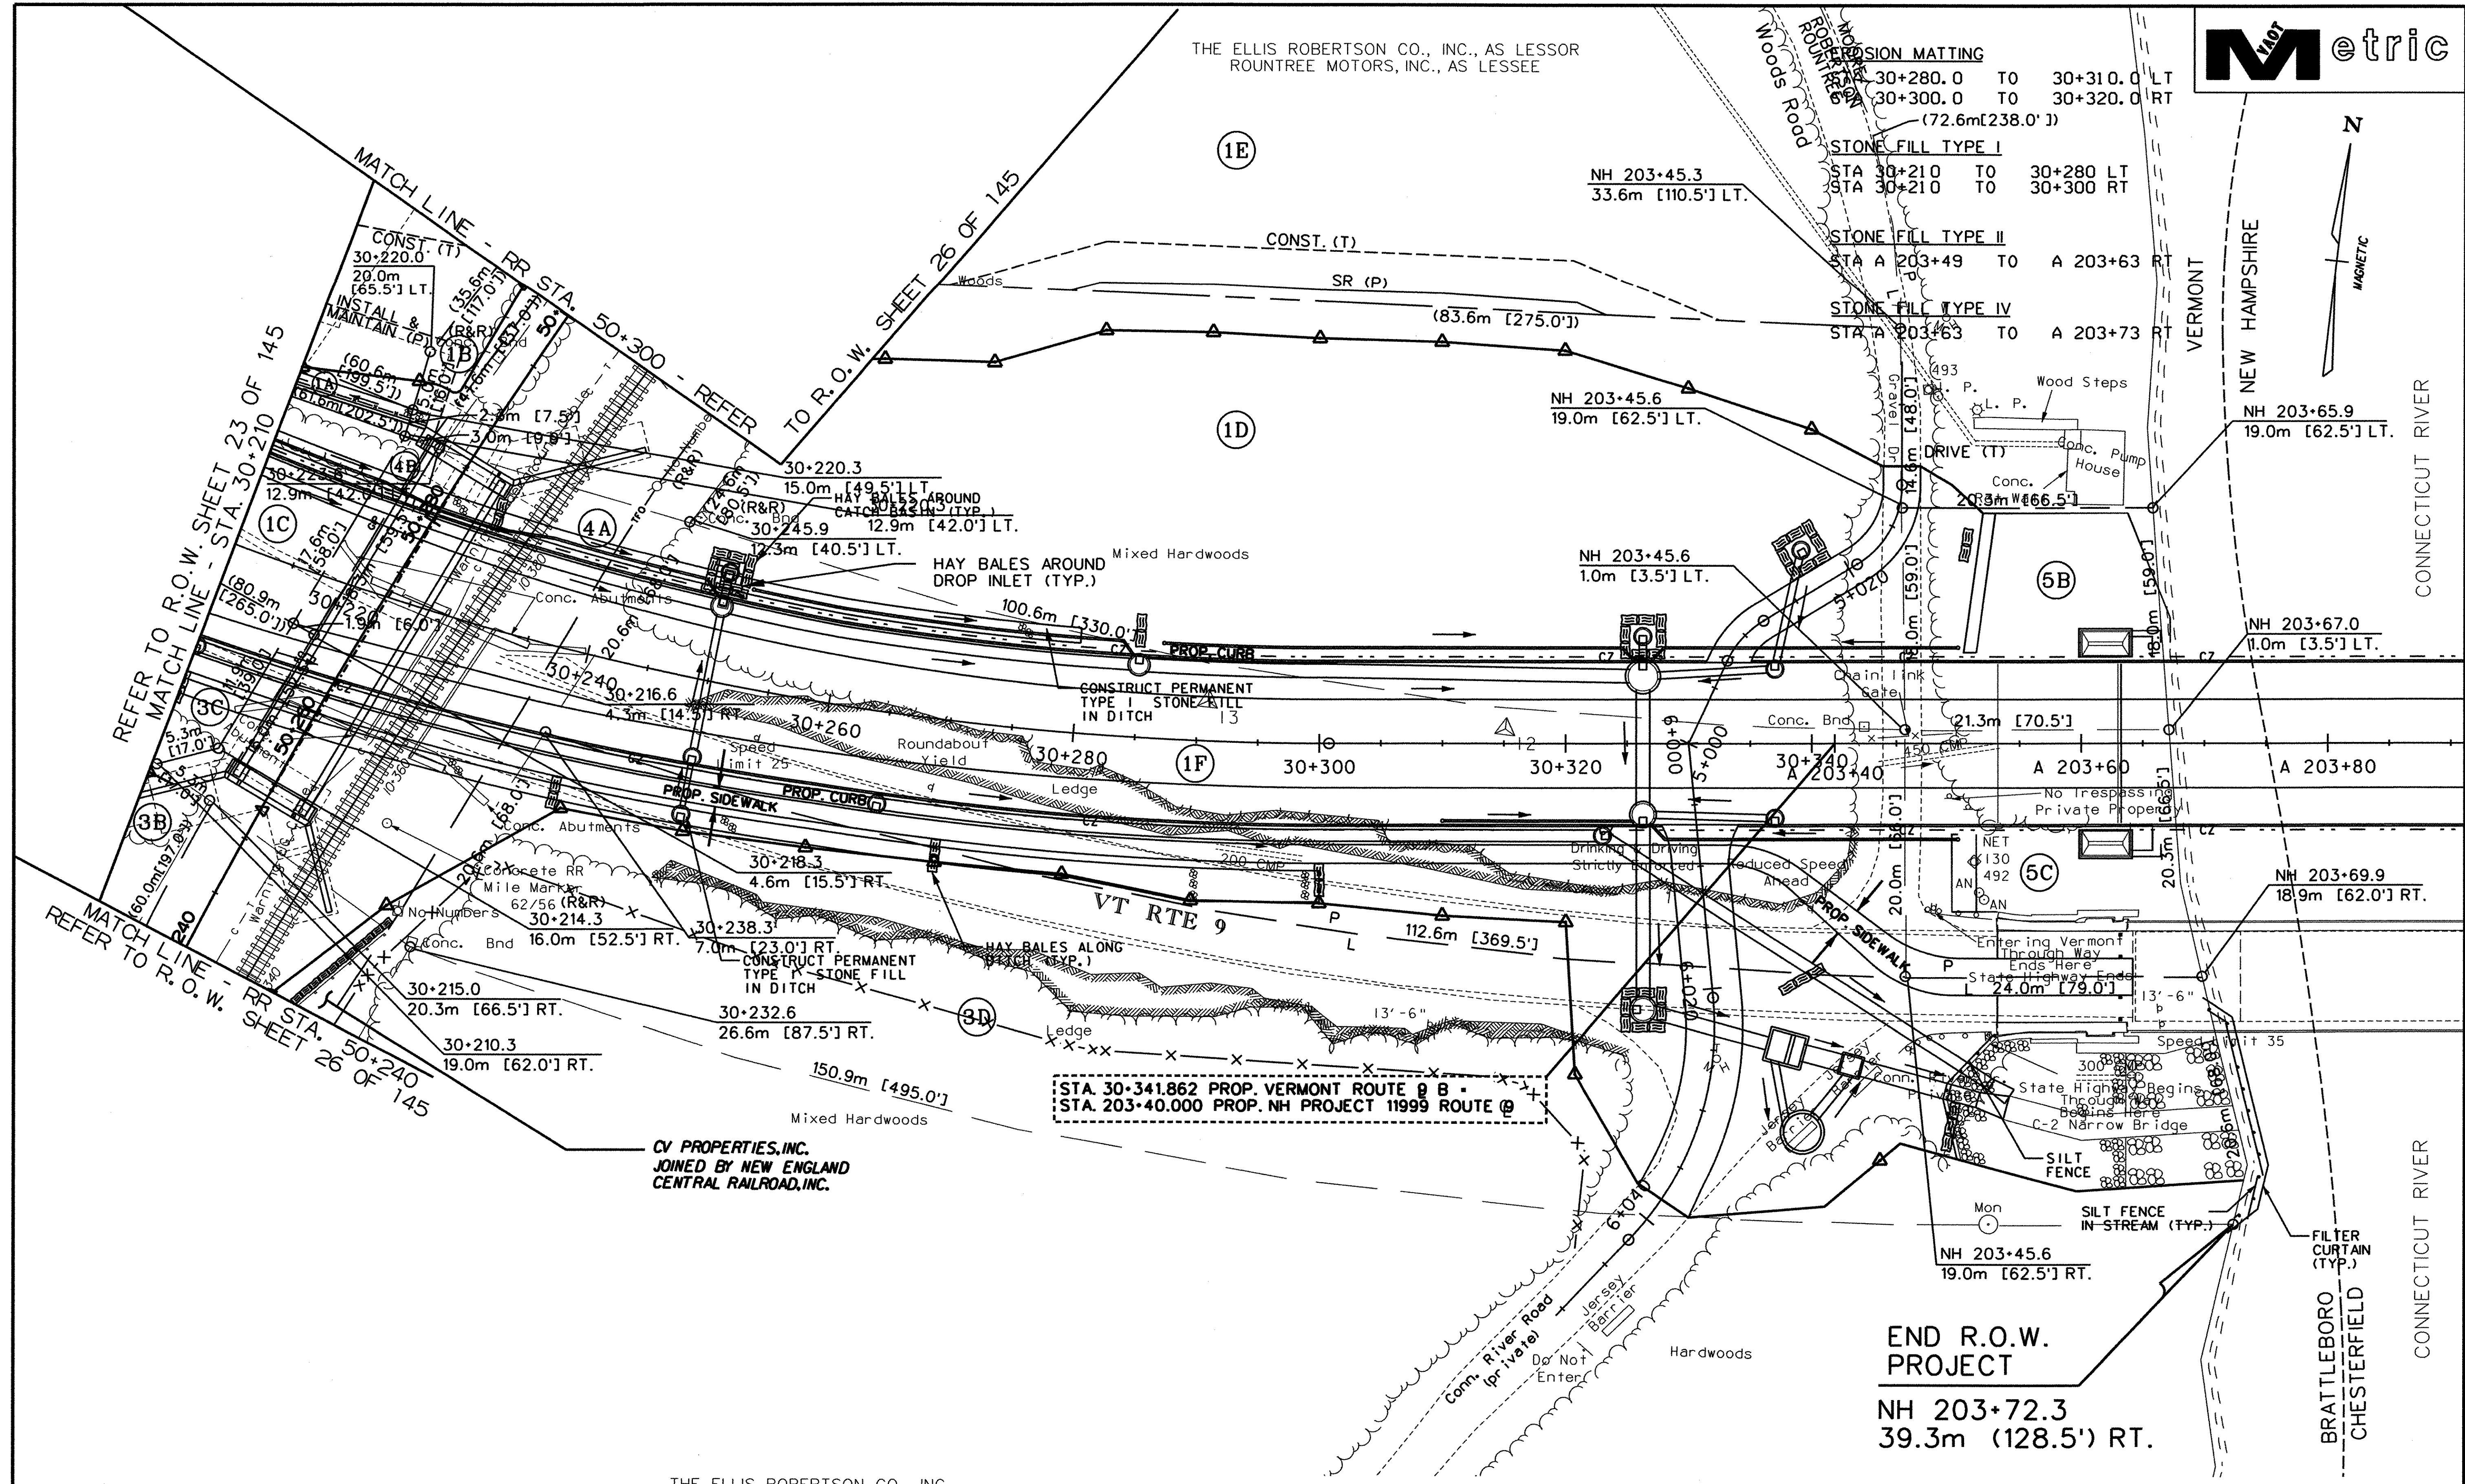

DATUM
 VERTICAL NGVD 1929
 HORIZONTAL NAD 1983

LINES SHOWN ON THIS PLAN AS EXISTING PROPERTY LINES (P/L) ARE BELIEVED TO BE ACCURATE BUT SHOULD NOT BE RELIED UPON FOR PURPOSES UNRELATED TO THE STATE OF VERMONT'S ACQUISITION OF LAND AND RIGHTS FOR THIS PROJECT.




GENERAL PLAN
 PROJECT NAME: BRATTLEBORO
 PROJECT NUMBER: NH 010-2(2)
 FILE NAME: ZB270BD3
 PROJECT LEADER: JHR
 DESIGNED BY: GJB
 R.O.W. LAYOUT SHEET 2
 PLOT DATE: 10-03-2002
 DRAWN BY: LB/LRD
 CHECKED BY: TEM/JHR
 SHEET 24 OF 145

THE ELLIS ROBERTSON CO., INC.

CV PROPERTIES, INC.
 JOINED BY NEW ENGLAND
 CENTRAL RAILROAD, INC.

END R.O.W. PROJECT
 NH 203+72.3
 39.3m (128.5') RT.

JACK T ARMEY
REVOCABLE TRUST

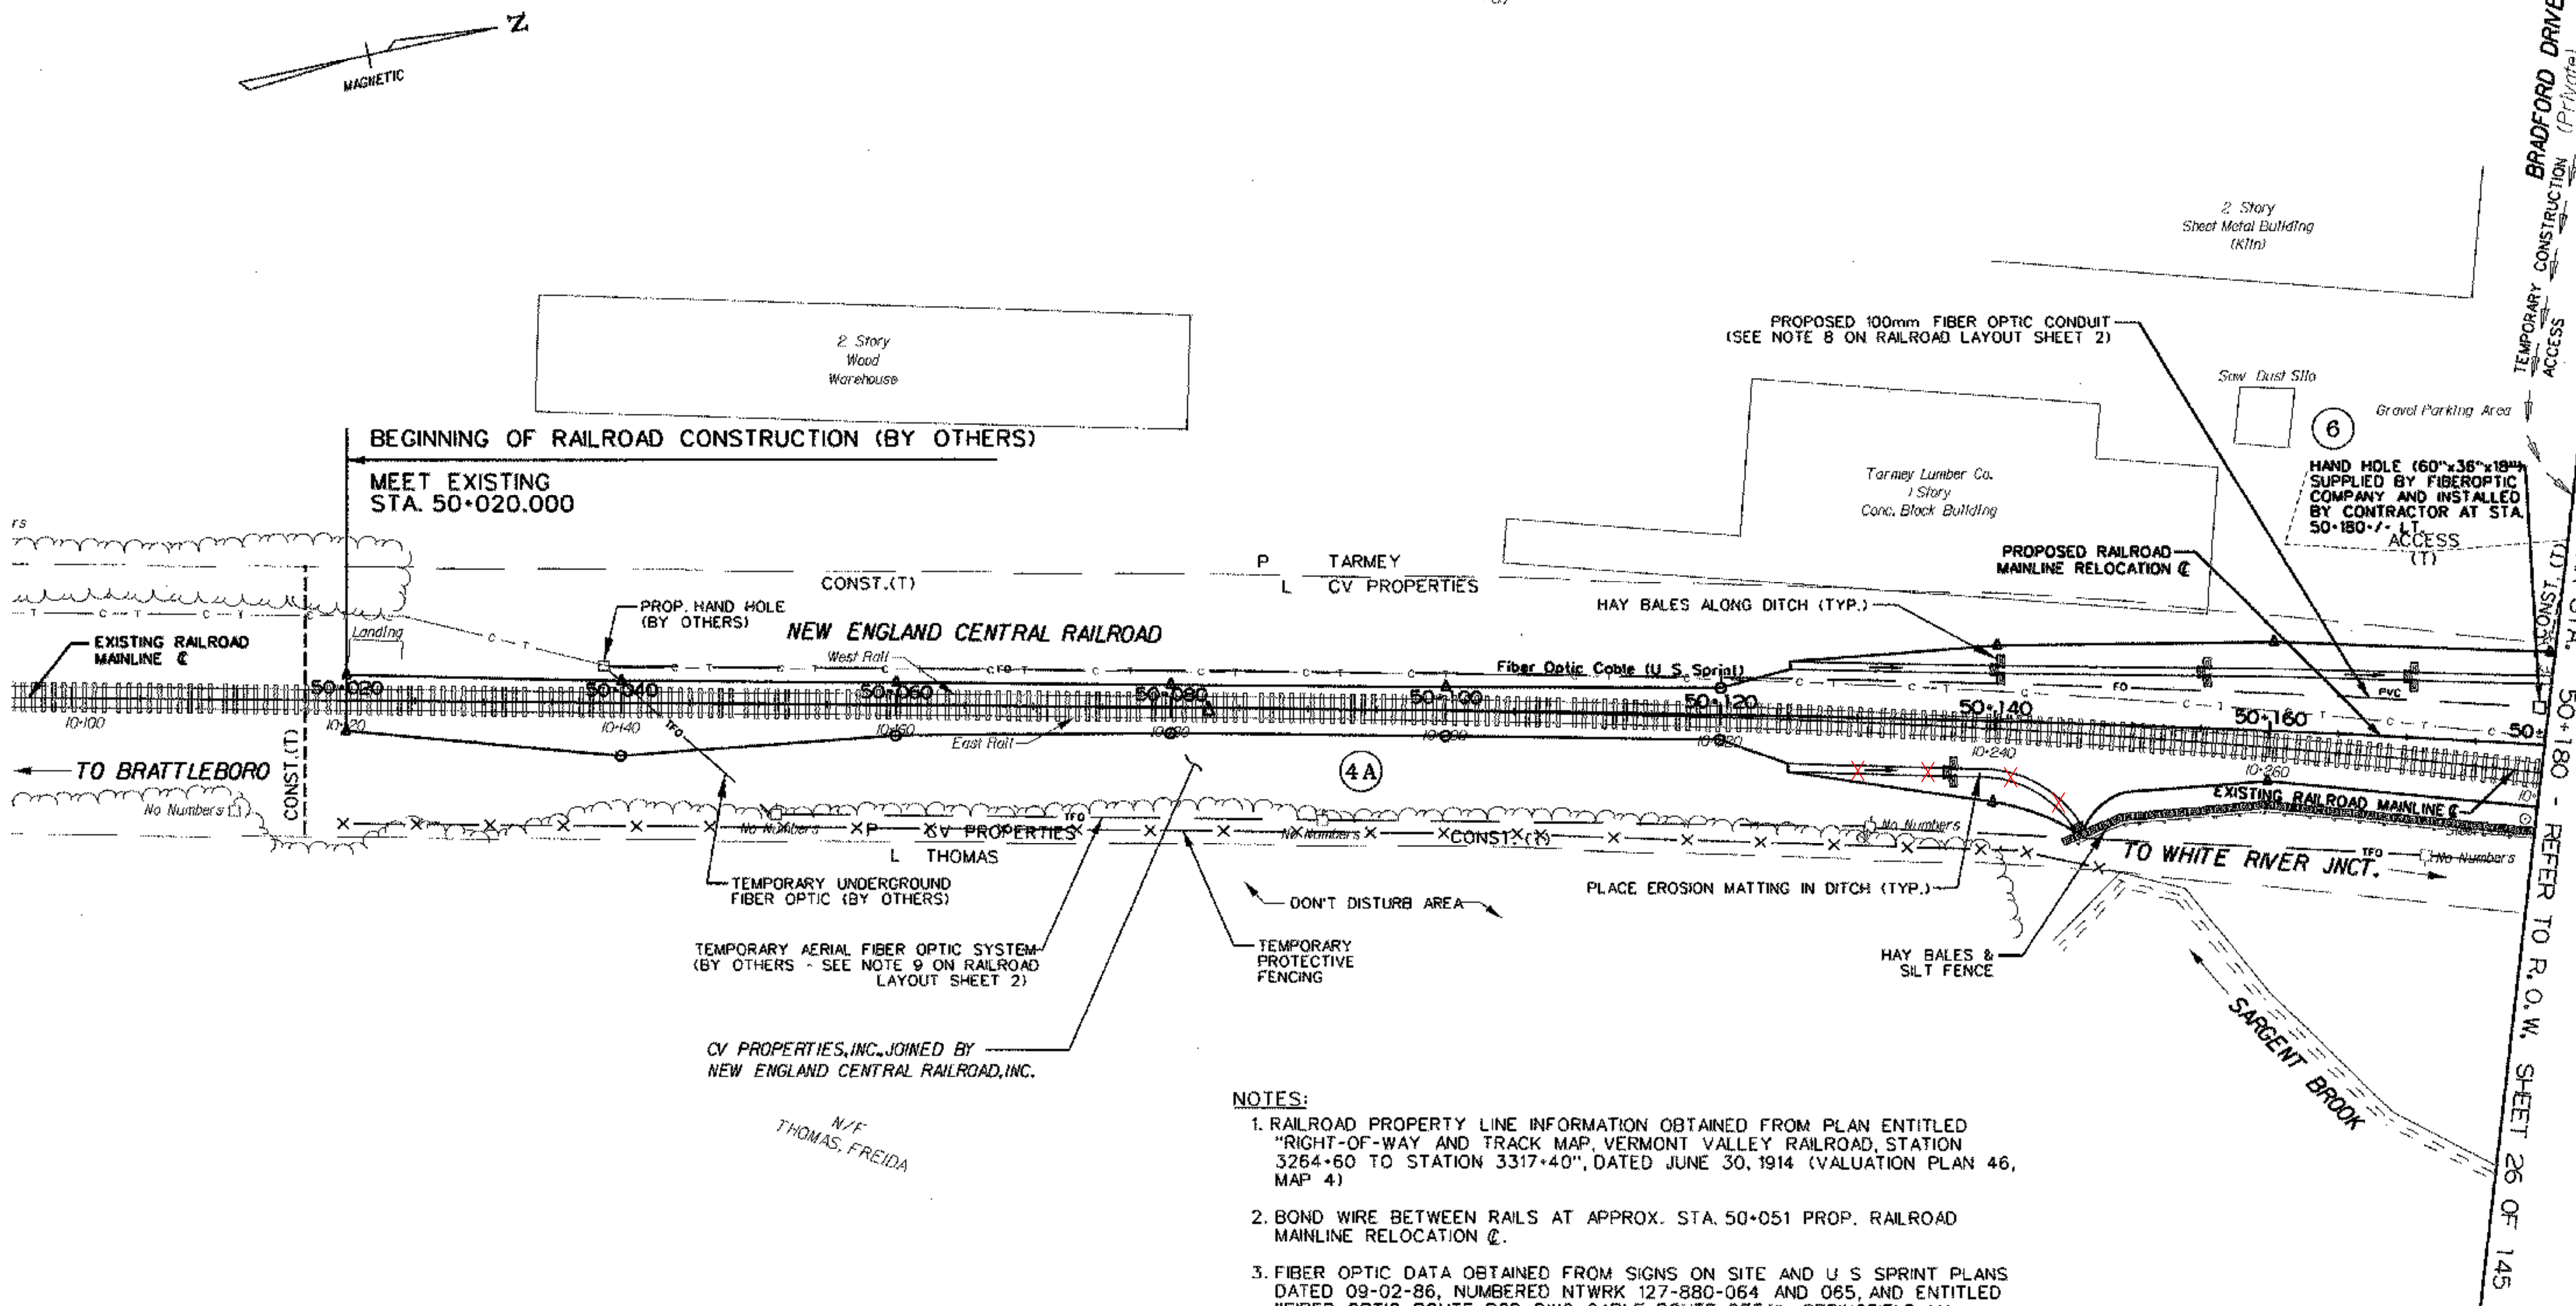

NOTES:



1. RAILROAD PROPERTY LINE INFORMATION OBTAINED FROM PLAN ENTITLED "RIGHT-OF-WAY AND TRACK MAP, VERMONT VALLEY RAILROAD, STATION 3264+60 TO STATION 3317+40", DATED JUNE 30, 1914 (VALUATION PLAN 46, MAP 4)
2. BOND WIRE BETWEEN RAILS AT APPROX. STA. 50+051 PROP. RAILROAD MAINLINE RELOCATION.
3. FIBER OPTIC DATA OBTAINED FROM SIGNS ON SITE AND U S SPRINT PLANS DATED 09-02-86, NUMBERED NTRK 127-880-064 AND 065, AND ENTITLED "FIBER OPTIC ROUTE RCD DWG, CABLE ROUTE DETAIL, SPRINGFIELD, MA - MONTREAL, CANADA."
4. SURVEY INFORMATION OBTAINED BY NHDOT, ELECTRONICALLY TRANSLATED FROM MOSS TO MICROSTATION, AND SUPPLEMENTED BY VTRANS ADDITIONAL SURVEY.
5. SEE VAOT STANDARD DRAWINGS T-1M AND T-2M FOR TEMPORARY EROSION CONTROL DETAILS.

LINES SHOWN ON THIS PLAN AS EXISTING PROPERTY LINES (P/L) ARE BELIEVED TO BE ACCURATE BUT SHOULD NOT BE RELIED UPON FOR PURPOSES UNRELATED TO THE STATE OF VERMONT'S ACQUISITION OF LAND AND RIGHTS FOR THIS PROJECT.

DATUM	
VERTICAL	NGVD 1929
HORIZONTAL	NAD 1983



GENERAL PLAN	
PROJECT NAME:	BRATTLEBORO
PROJECT NUMBER:	NH 010-2(2)
FILE NAME:	ZB270803
PROJECT LEADER:	JHR
DESIGNED BY:	GJB
R.O.W. LAYOUT SHEET	3
PLOT DATE:	10-04-2002
DRAWN BY:	LB/LRD
CHECKED BY:	TEM/JHR
SHEET	25 OF 145

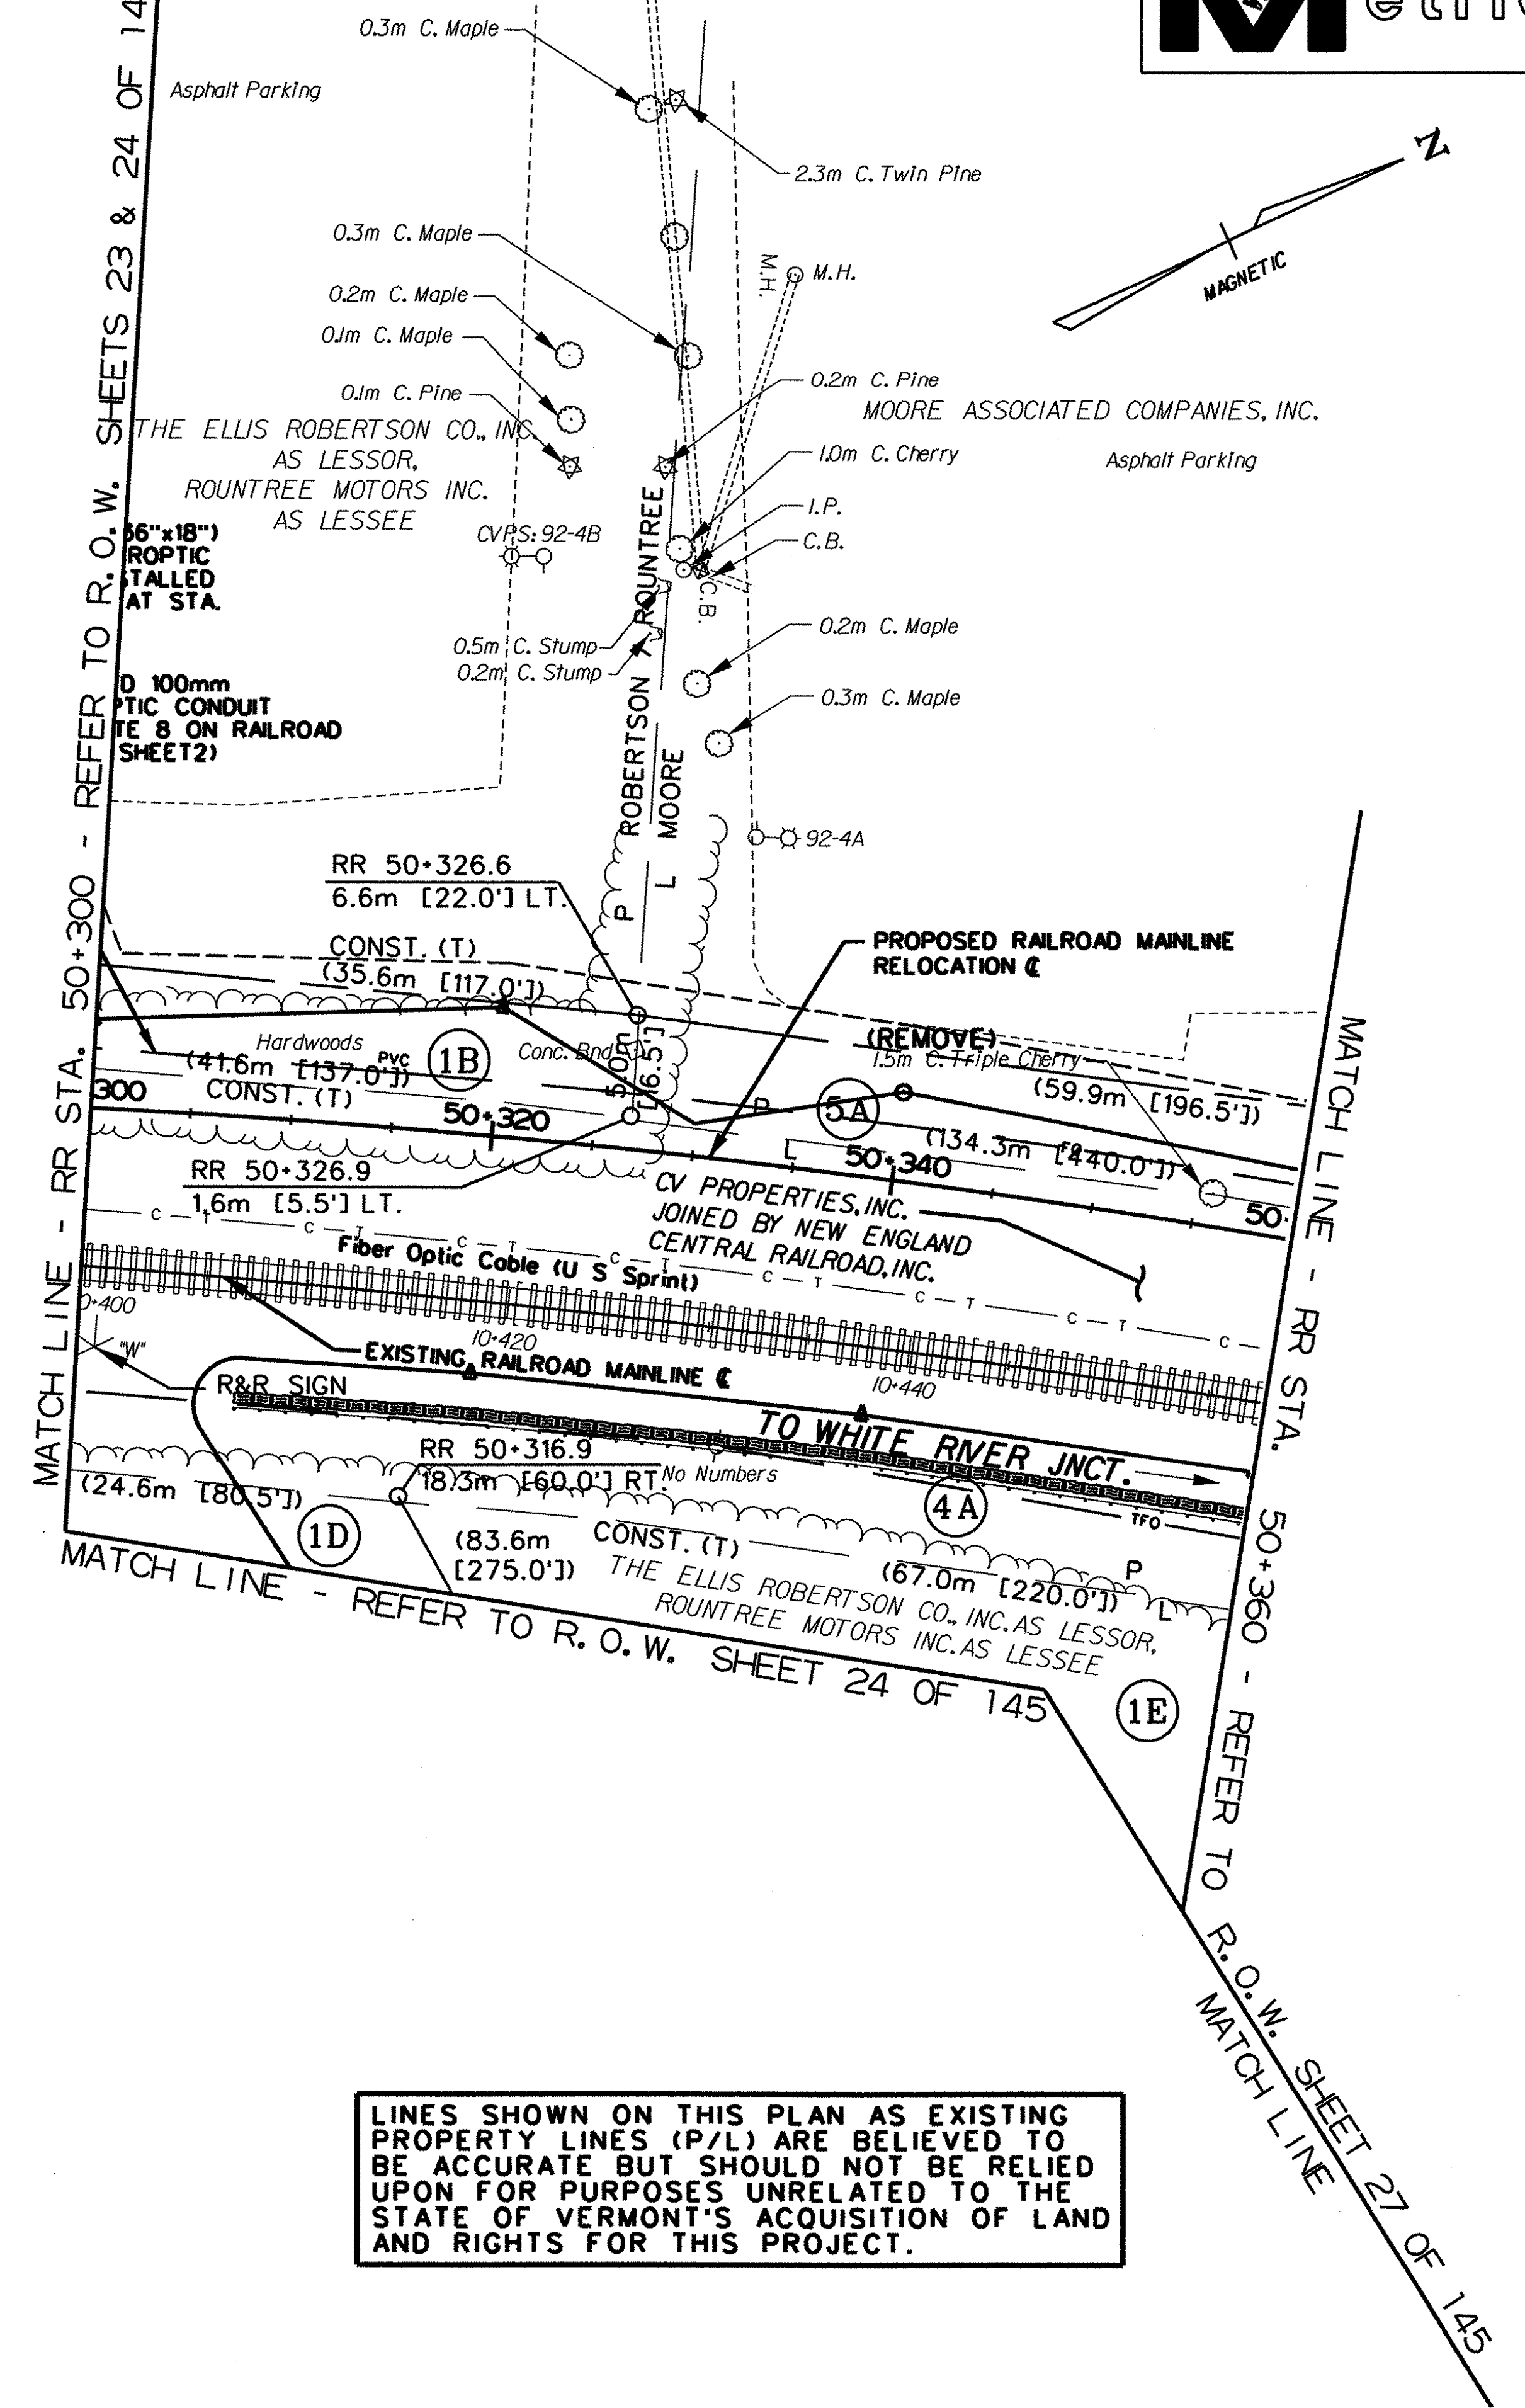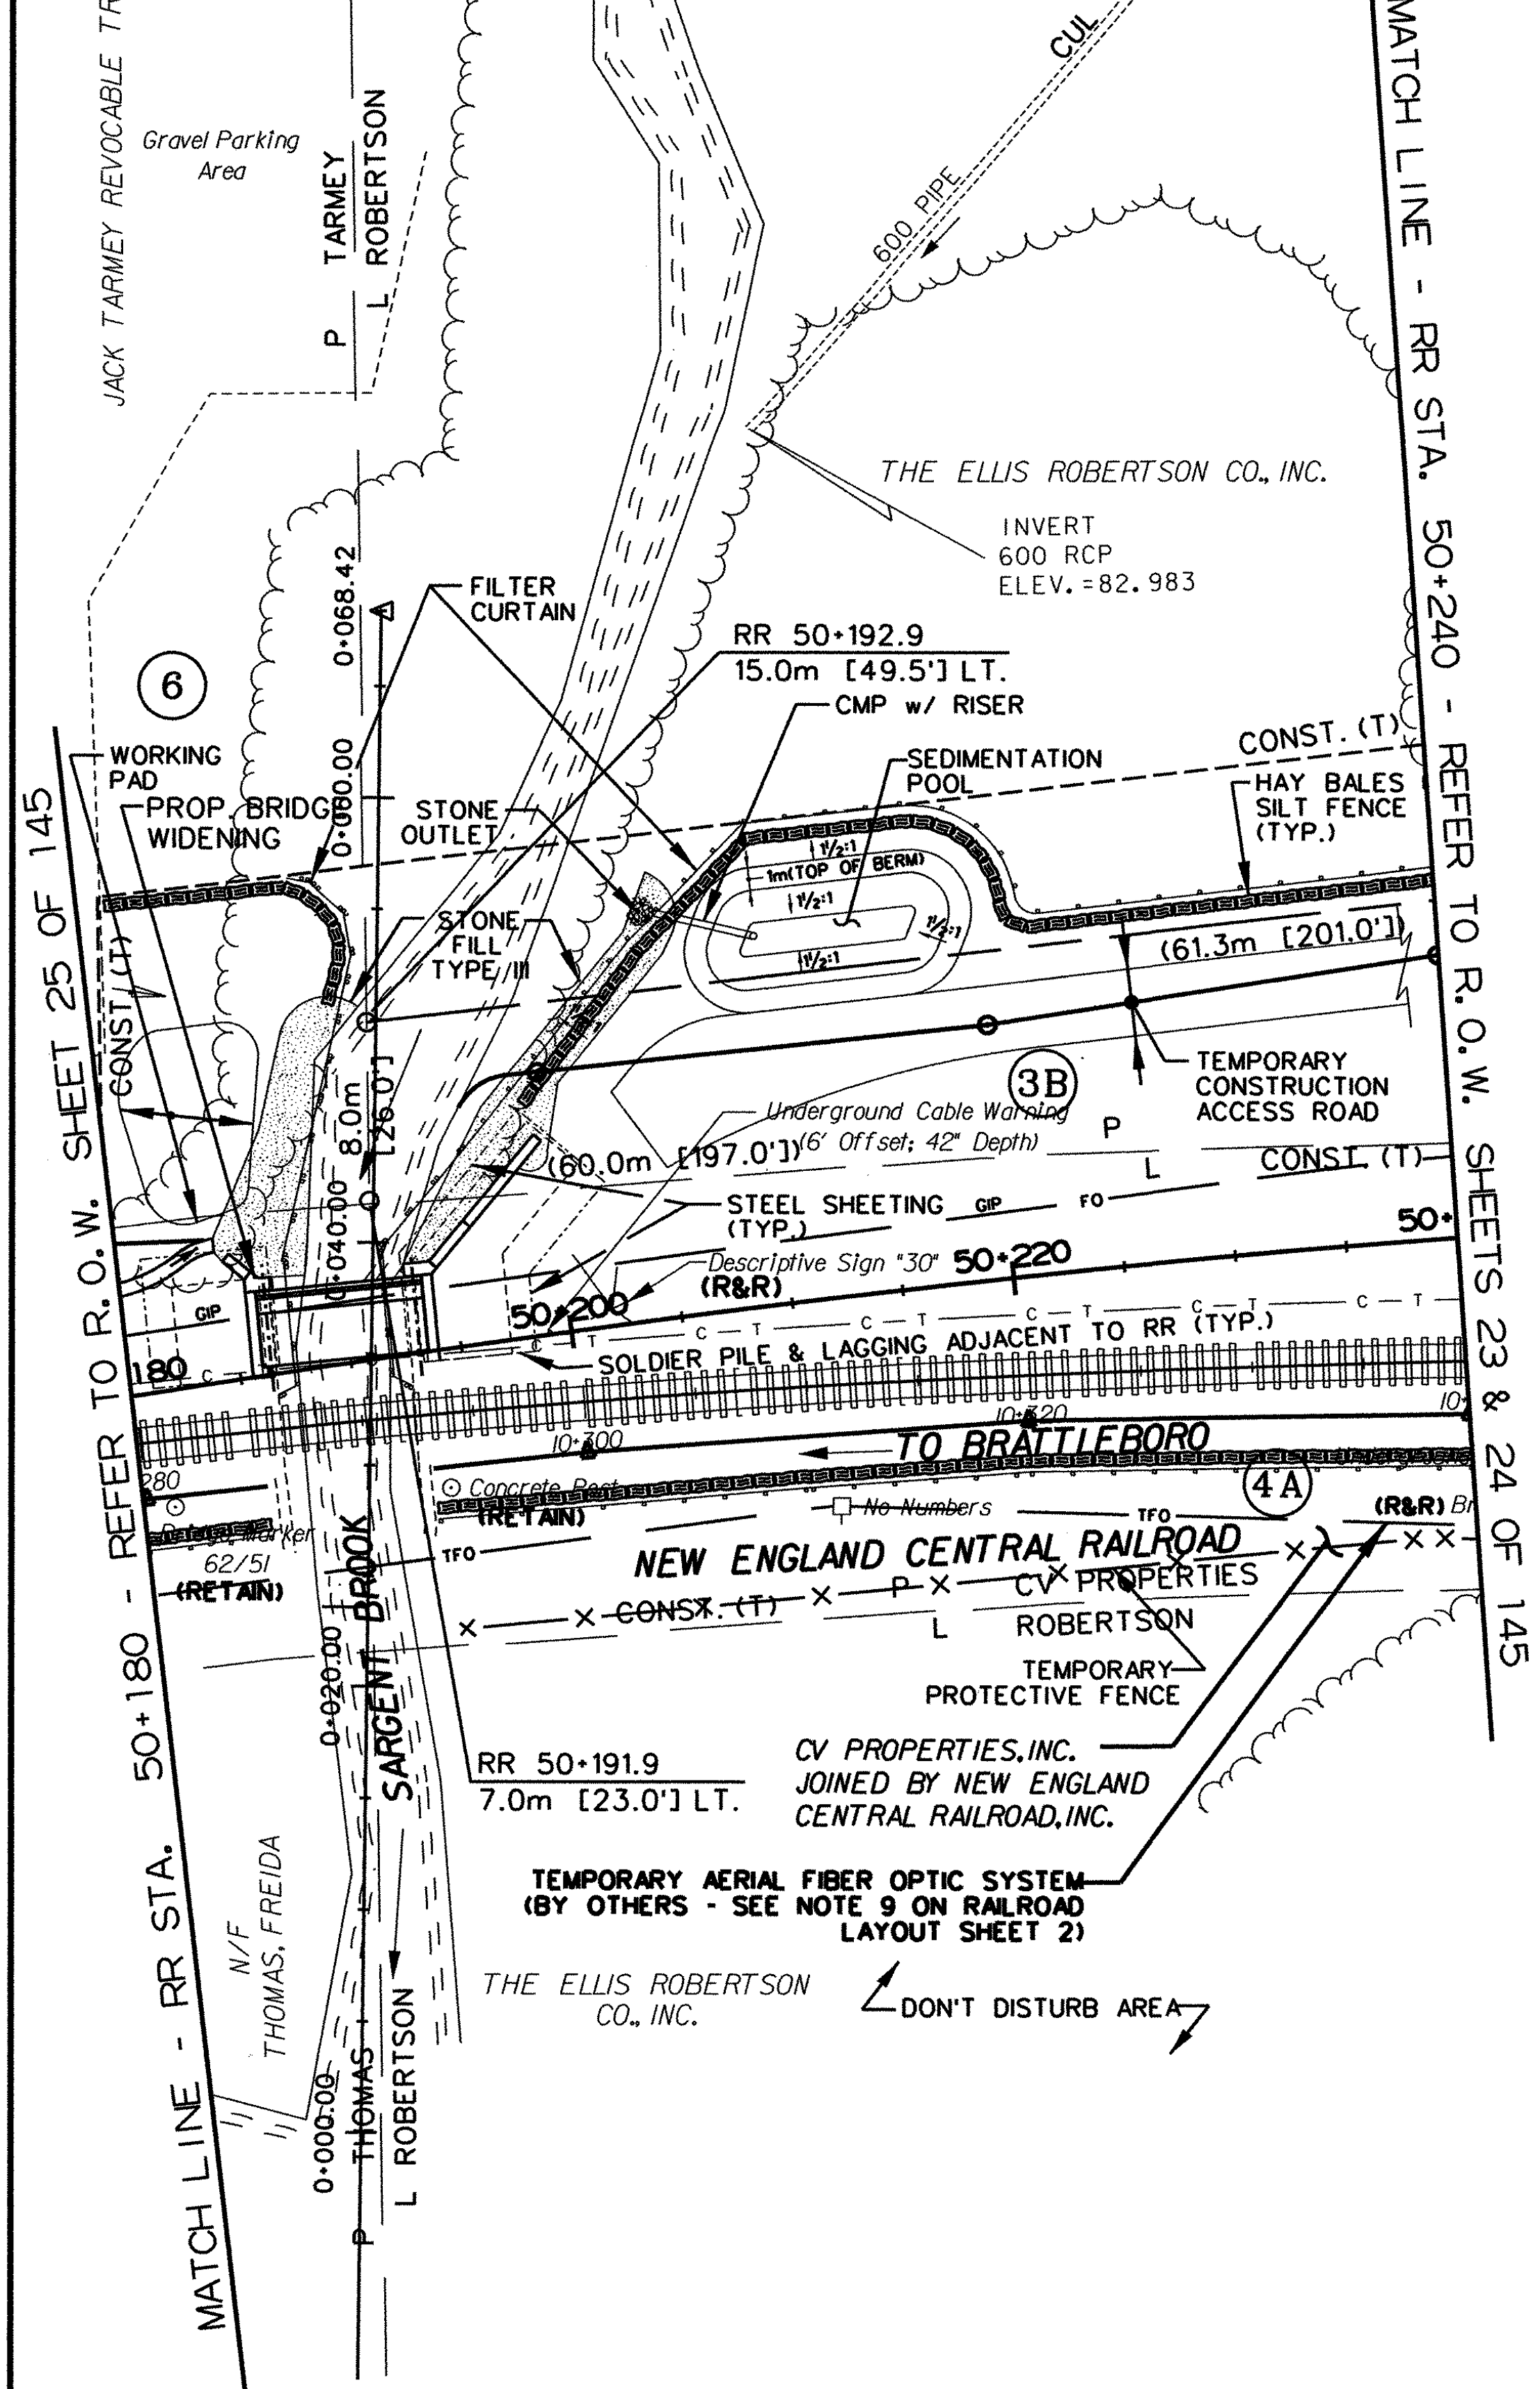

LINES SHOWN ON THIS PLAN AS EXISTING PROPERTY LINES (P/L) ARE BELIEVED TO BE ACCURATE BUT SHOULD NOT BE RELIED UPON FOR PURPOSES UNRELATED TO THE STATE OF VERMONT'S ACQUISITION OF LAND AND RIGHTS FOR THIS PROJECT.


DATUM

VERTICAL	NGVD 1929
HORIZONTAL	NAD 1983



GENERAL PLAN

PROJECT NAME:	BRATTLEBORO
PROJECT NUMBER:	NH 010-2(2)
FILE NAME:	ZB270BD3
PROJECT LEADER:	JHR
DESIGNED BY:	GJB
R.O.W. LAYOUT SHEET 4	
PLOT DATE:	10-04-2002
DRAWN BY:	LB/LRD
CHECKED BY:	TEM/JHR
SHEET	26 OF 145

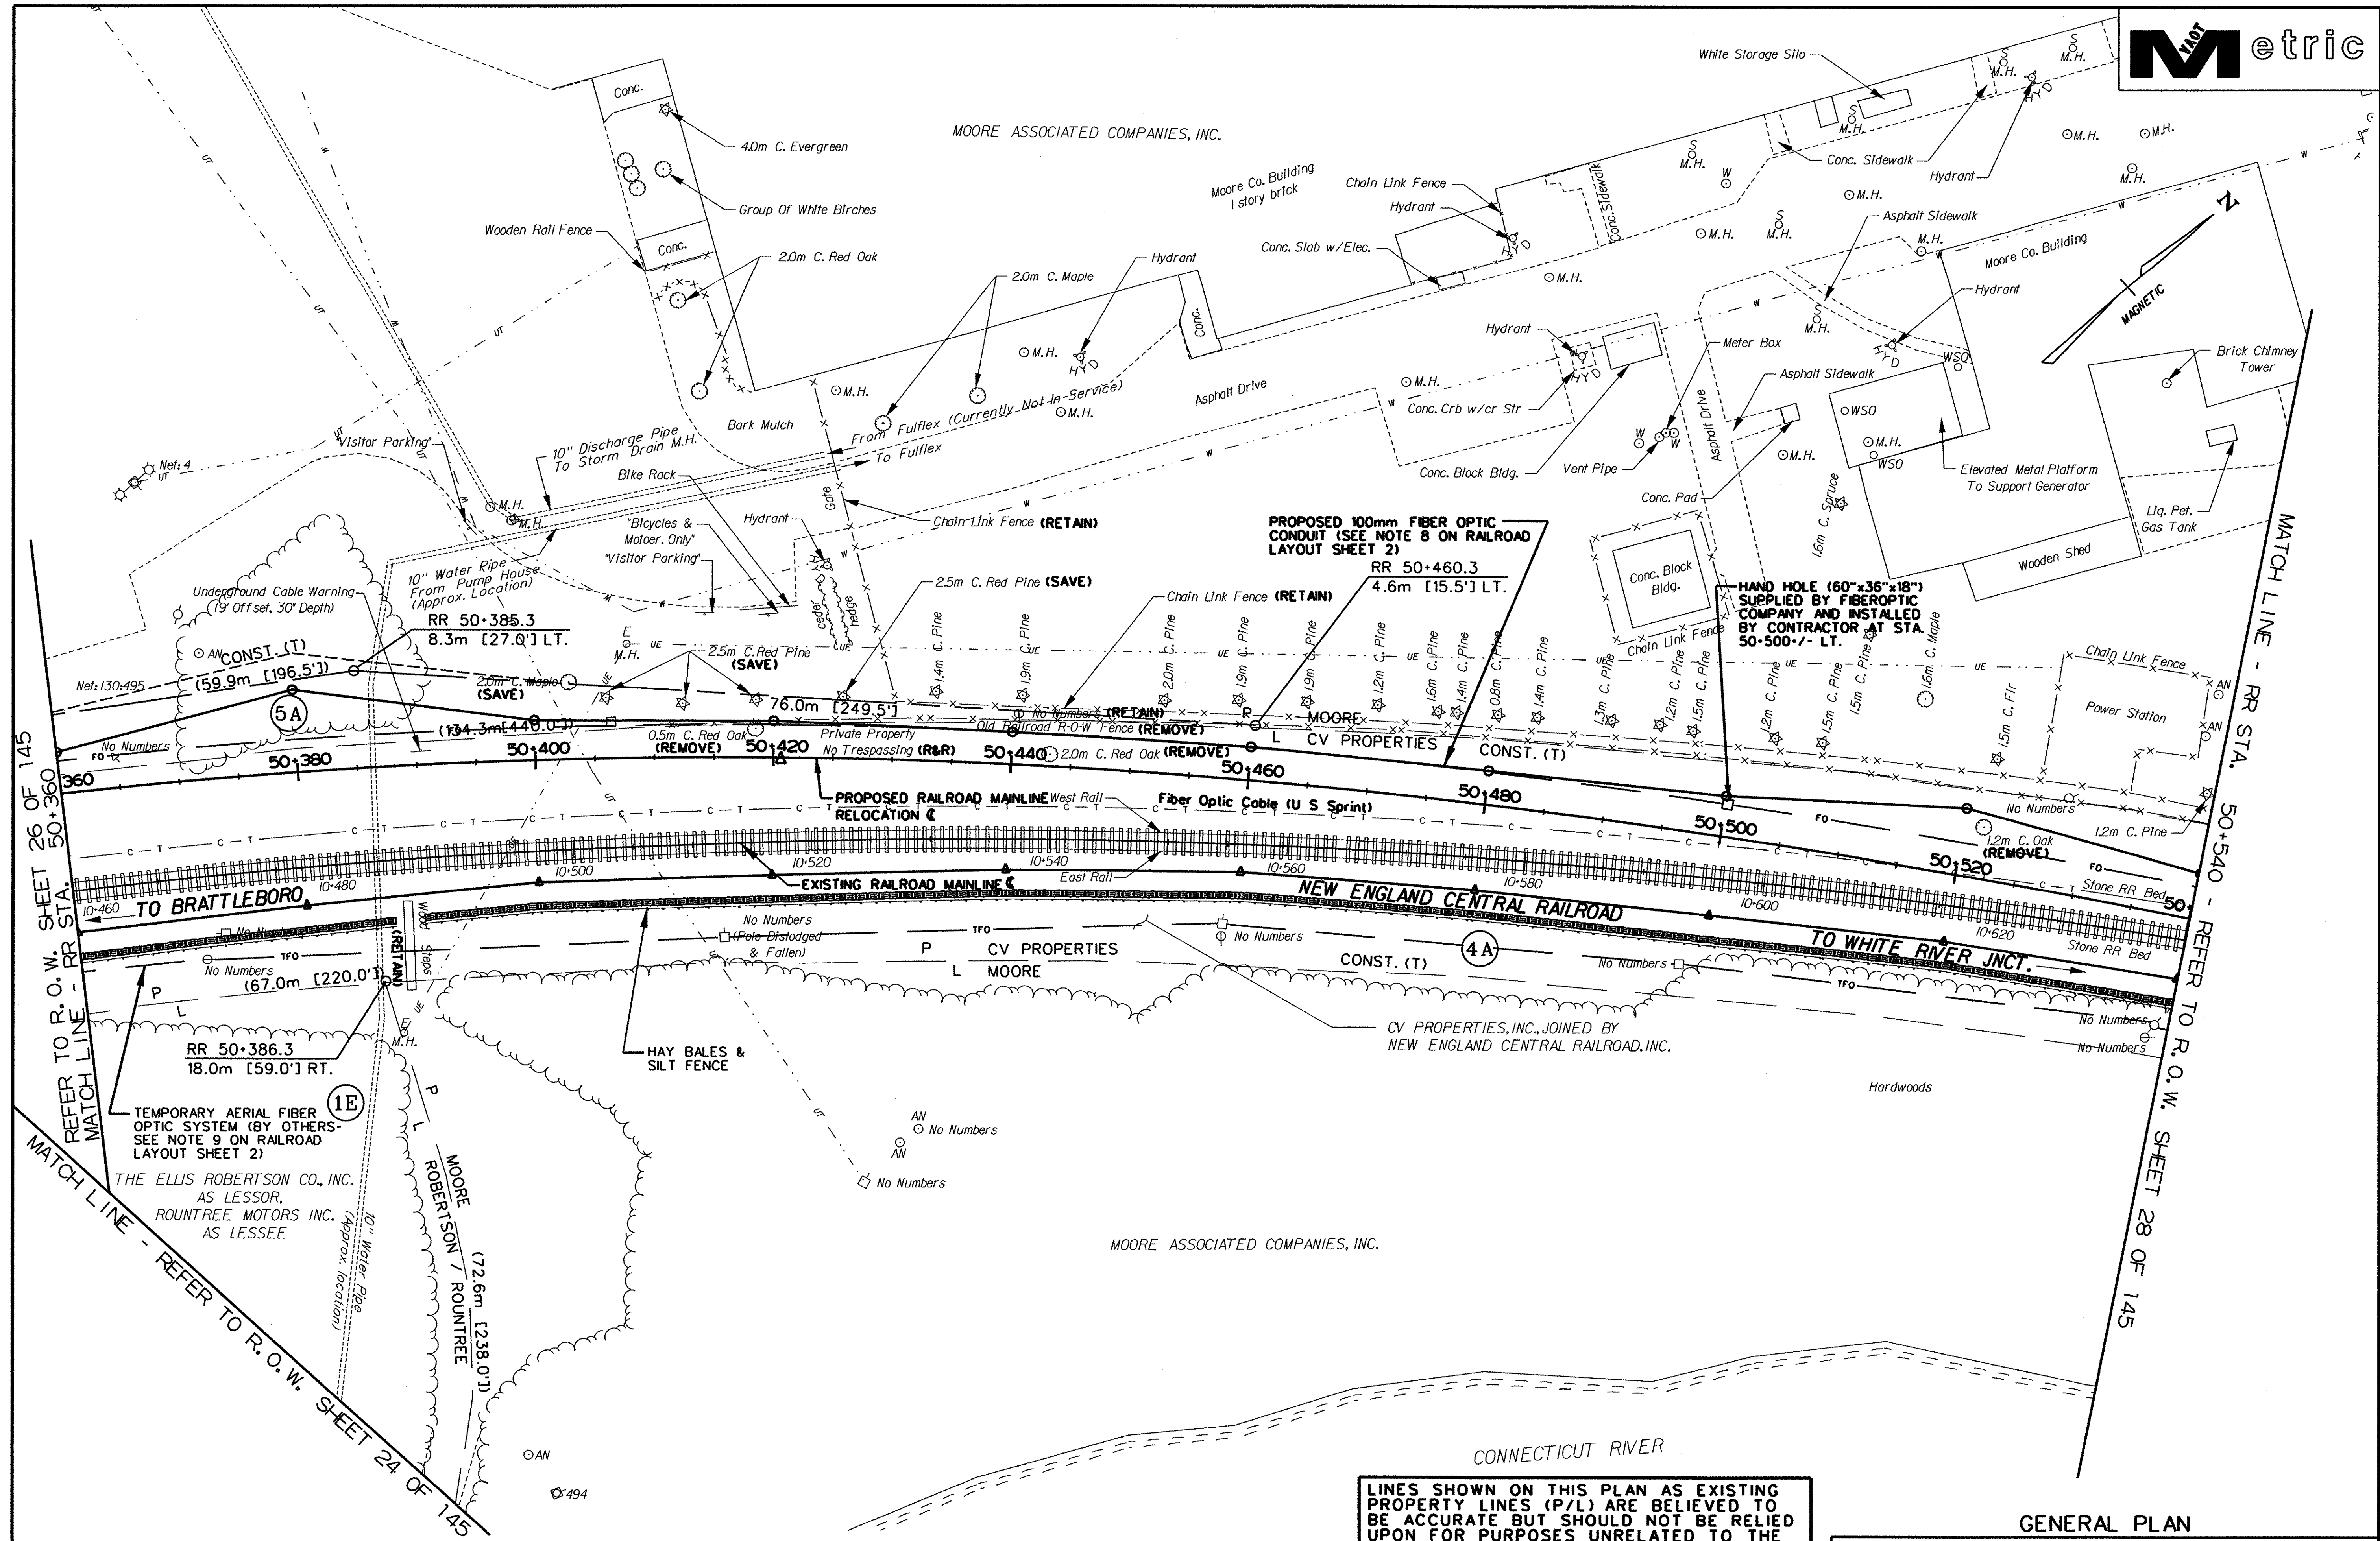

DATUM



VERTICAL	NGVD 1929
HORIZONTAL	NAD 1983

LINES SHOWN ON THIS PLAN AS EXISTING PROPERTY LINES (P/L) ARE BELIEVED TO BE ACCURATE BUT SHOULD NOT BE RELIED UPON FOR PURPOSES UNRELATED TO THE STATE OF VERMONT'S ACQUISITION OF LAND AND RIGHTS FOR THIS PROJECT.



GENERAL PLAN

PROJECT NAME:	BRATTLEBORO	PLOT DATE:	10-04-2002
PROJECT NUMBER:	NH 010-2(2)	DRAWN BY:	LB/LRD
FILE NAME:	ZB270BD3	CHECKED BY:	TEM/JHR
PROJECT LEADER:	JHR	R.O.W. LAYOUT SHEET 5	SHEET 27 OF 145
DESIGNED BY:	GJB		

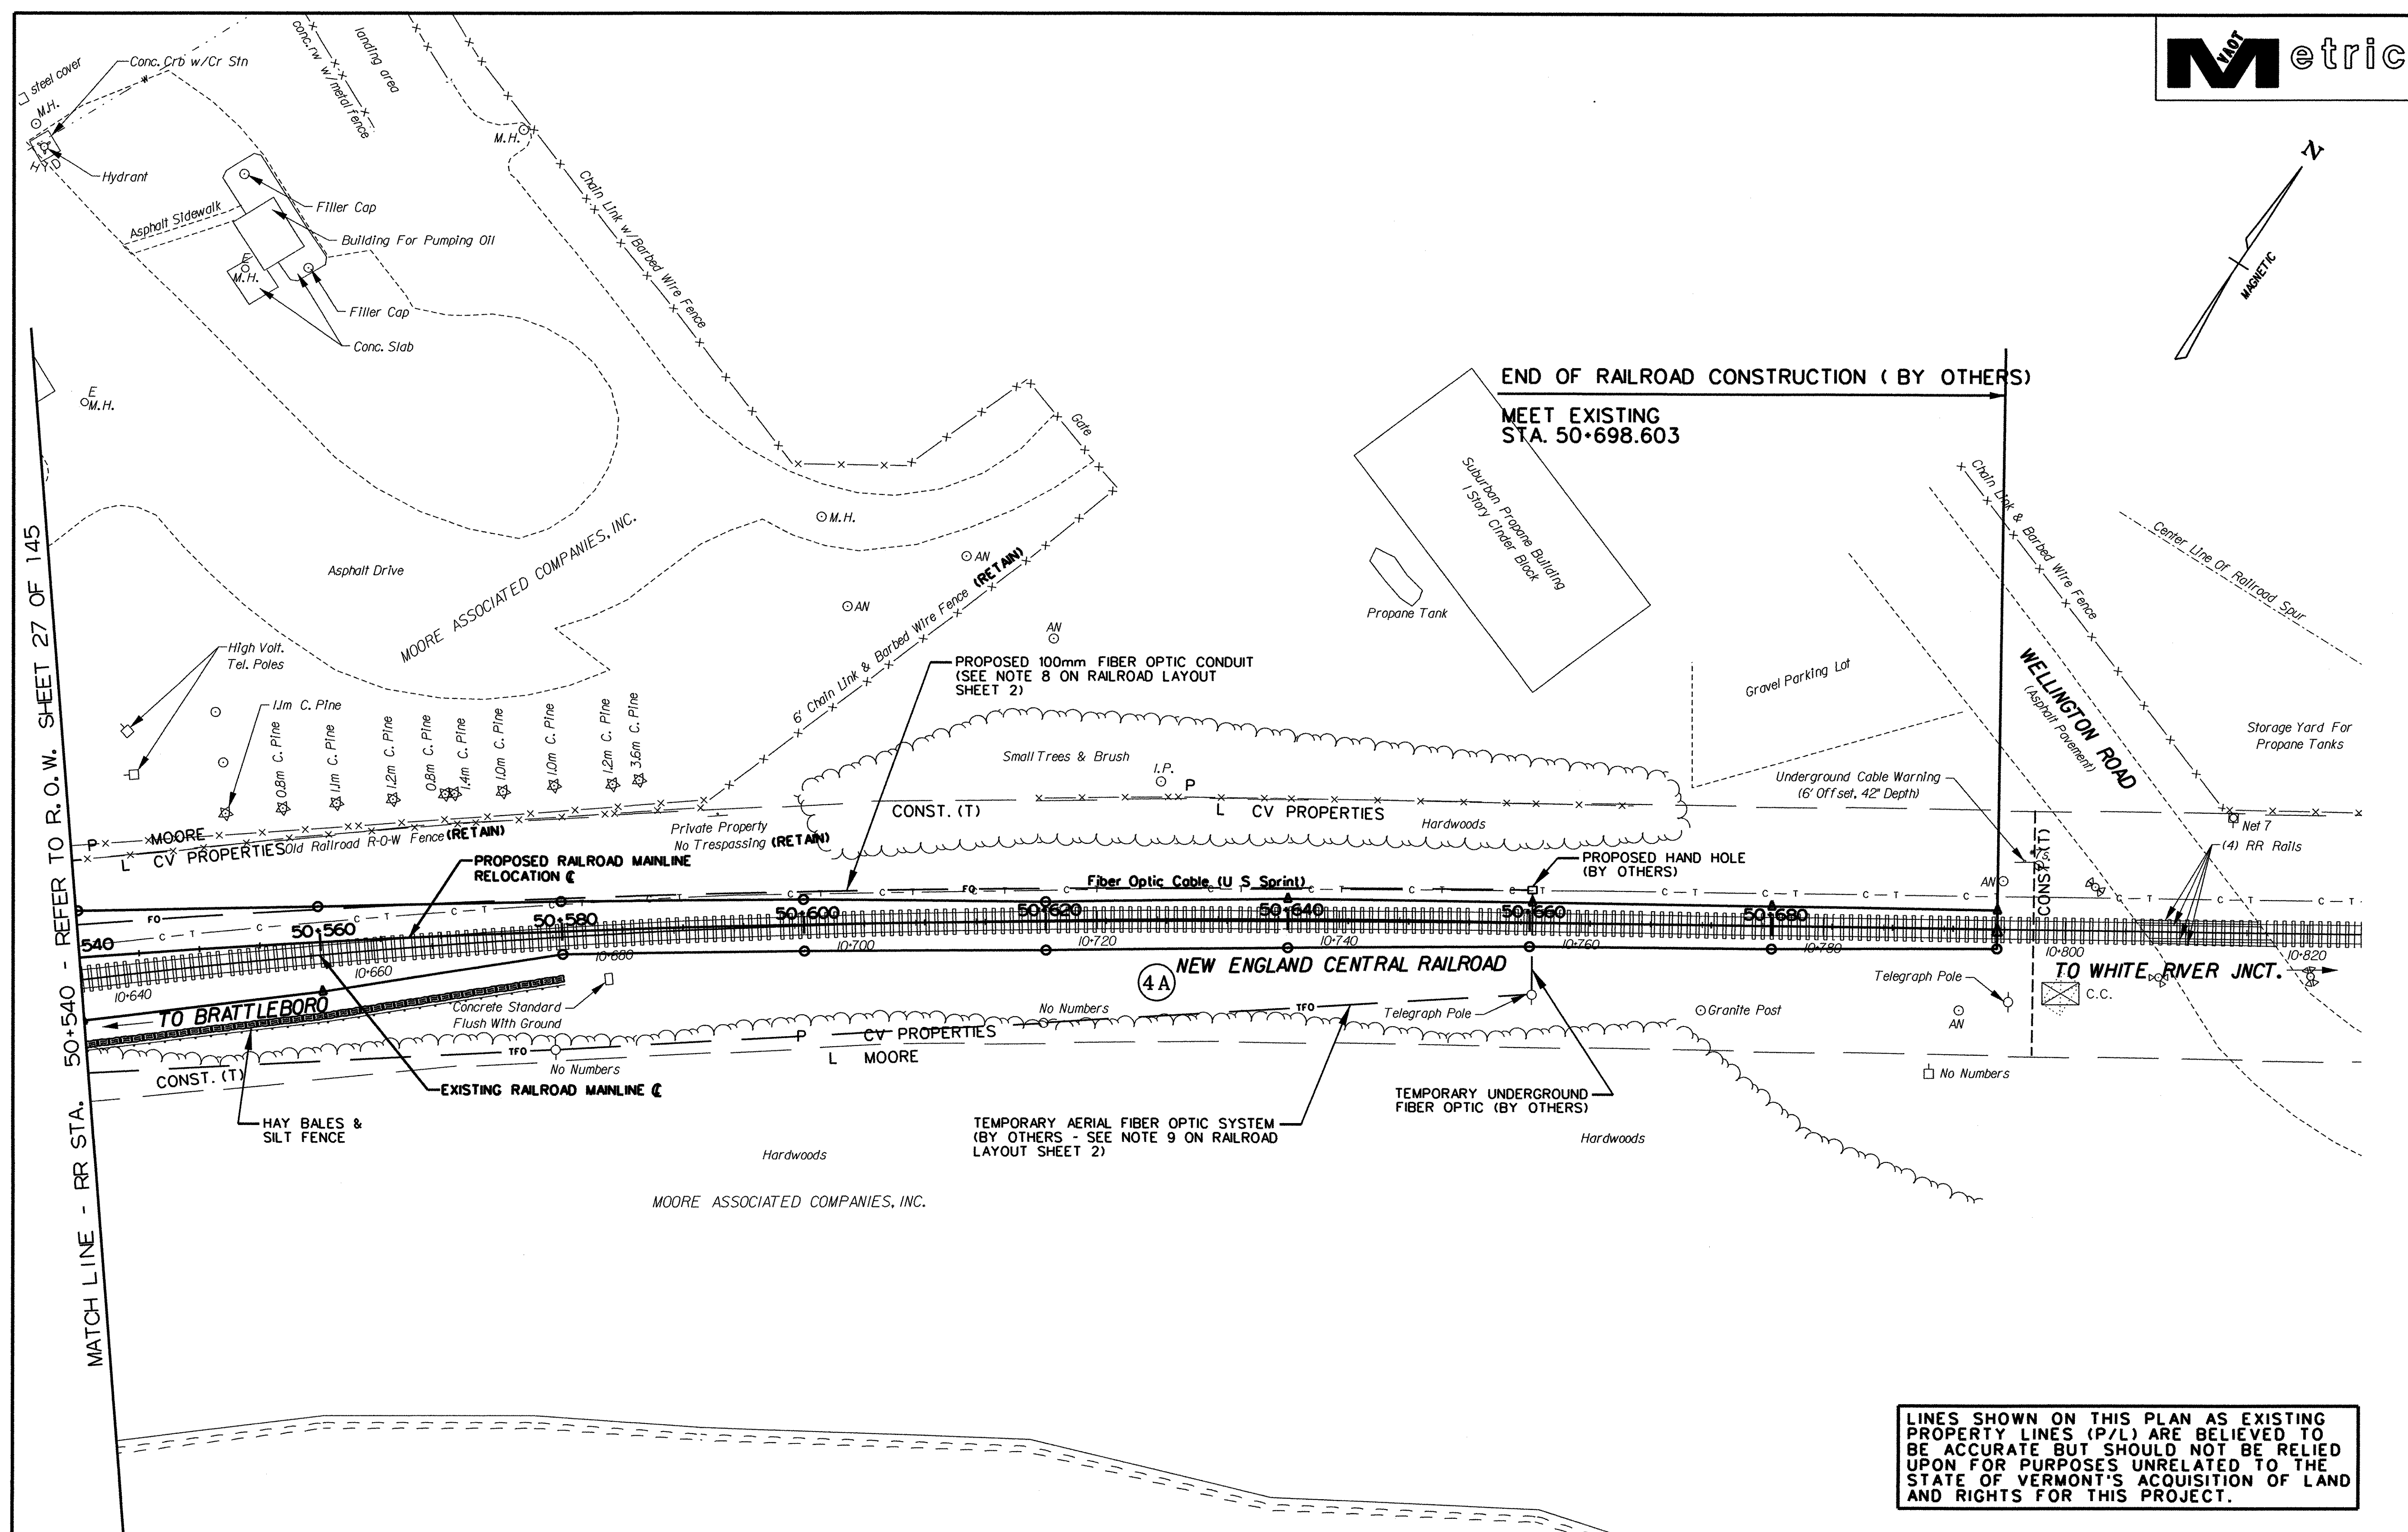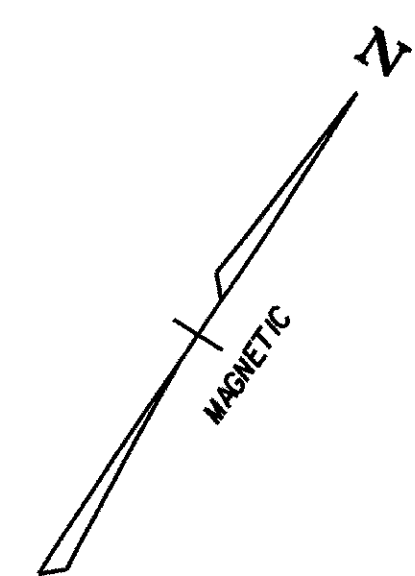

DATUM

VERTICAL	NGVD 1929
HORIZONTAL	NAD 1983



GENERAL PLAN

PROJECT NAME:	BRATTLEBORO
PROJECT NUMBER:	NH 010-2(2)
FILE NAME:	ZB270BD3
PROJECT LEADER:	JHR
DESIGNED BY:	GJB
R.O.W. LAYOUT SHEET	6
PLOT DATE:	10-04-2002
DRAWN BY:	LB/LRD
CHECKED BY:	TEM/JHR
SHEET	28 OF 145

**STATE OF VERMONT
AGENCY OF TRANSPORTATION
TABLE OF PROJECT PROPERTY ACQUISITION**

**STATE OF VERMONT
AGENCY OF TRANSPORTATION
RIGHT OF WAY PLANS
DETAIL SHEET**

PARCEL NO.	GRANTOR	SHEET NO.	BEGINNING STATION	ENDING STATION	TAKING	REM.	RIGHTS	TITLE TAKEN	DATE	TOWN OR CITY RECORDED	BK.	PG.	REMARKS	REVISION NO.	SHEET	DESCRIPTION OF REVISION	DATE	MADE BY	APPROVED BY
1A	THE ELLIS ROBERTSON COMPANY INC. - LESSOR ROUNTREE MOTORS INC. - D/B/A/ ROUNTREE FORD-MERCURY - LESSEE	22, 23	30+156.3 LT. 30+095.0 LT. 30+100.0 LT.	30+220.3 LT. RR 50+326.6 LT.	191.5 SM±		DRIVE (T) CONST. (T) 0.05HA±			BRATTLEBORO			2,061.4 S.F.± 9.3M (31') PAVED MM 0711 INCLUDES EROSION CONTROL & GUARDRAIL 0.12A± 370.3 S.F.±	1	19, 23	PARCEL NO. 1 ROBERTSON & ROUNTREE. ADD EXCEPT AND RESERVE FOR WATERLINE AT THE FOLLOWING STATIONS: NH 203+44.2 LT. ~ NH 203+45.3 LT. AND NH 203+44.2 LT. ~ RR 50+386.3 RT. PER C.O. 9206.	08-27-01	M. J. R.	R. P. D.
			30+100.0 LT. 30+143.6 LT. 30+145.0 LT. 30+184.0 LT.	30+145.0 LT. 30+220.0 LT. 30+152.6 LT. 30+220.3 LT. 30+220.6 LT.			SLOPE (T) 34.4 SM± LANDSCAPING (T) DITCH (P) SLOPE (P) 136.2SM± INSTALL & MAINT. (P) 108.1SM±						1,466.1 S.F.± 1,164 S.F.± RETAINING WALL & APPURTENANCE	2	20, 26	PARCEL NO. 5 MOORE ASSOCIATED COMPANIES, INC. ADD EXCEPT AND RESERVE FOR WATERLINE AT THE FOLLOWING STATIONS: RR 50+386.4 LT. ~ RR 50+386.9 LT. PER C.O. 9207.	08-27-01	M. J. R.	R. P. D.
			30+145.5 LT. 30+148.6 LT. 30+152.5 LT.				REMOVE (T) CULVERT (T) CULVERT (P)						CULVERT, D.I. & ASPHALT SLUICE CONNECT TO EXISTING CULVERT	3	19	PARCEL NO. 1C ELLIS ROBERTSON COMPANY, INC. CHANGE THE BEGINNING STATION OF THE ALL R.T. & I. IN THE RTE. 9 HWY. EASE. FROM 30+120.0 RT. TO 30+102.0 RT. PER C.O. 9209.	10-05-01	M. J. R.	R. P. D.
1B		23, 25	30+220.0 LT.	RR 50+326.9 LT.	199.45M±								2,146.4 S.F.± TO BE CONVEYED TO PARCEL #4 RR AFTER PROJECT COMPLETION						
1C		22, 23	30+102.0 RT. 30+145.5 LT. & RT.	30+223.6 LT.	0.16HA±		ALL R. T. & I. ALL R. T. & I.						VT. RTE. 9 HWY. EASE. 0.40A± CULVERT, CAP PIPE RIGHT						
1D		23, 25	30+245.9 LT. 30+332.3 LT.	NH 203+45.6 LT.	0.27HA±		DRIVE (T)						0.67A± 3.0M (30') GRAVEL MM 0725 IN COMMON/PARCEL #5B						
			30+263.5 LT. 30+276.9 LT. NH 203+44.2 LT.	30+332.3 LT. 30+324.0 LT. NH 203+45.3 LT.			CONST. (T) 156.6SM± SLOPE (P) 35.6 SM± EXCEPT & RESERVE						1,685.7 S.F.± 383.2 S.F.± APPROXIMATE LOCATION OF WATERLINE						
1E		23, 25 26	RR 50+316.9 RT. NH 203+44.2 LT.	NH 203+45.3 LT. RR 50+386.3 RT.	0.27HA±		EXCEPT & RESERVE						BY OPTION ONLY 0.67A± APPROXIMATE LOCATION OF WATERLINE						
1F		23	30+238.3 RT.	NH 203+45.6 RT.	0.21HA±		ALL R. T. & I.						VT. RTE. 9 HWY. EASE. 0.52A±						
2A	THE ELLIS ROBERTSON COMPANY INC.	22	30+106.3 RT. 30+106.3 RT.	30+136.3 RT. 30+136.6 RT.			CONST. (T) 80.0 SM± SLOPE (P) 50.0 SM±			BRATTLEBORO			961.1 S.F.± 538.1 S.F.±						
2B		22	30+106.3 RT.	30+136.6 RT.	0.04HA±		ALL R. T. & I.						VT. RTE. 9 HWY. EASE. 0.10A±						
3A	THE ELLIS ROBERTSON COMPANY INC.	22	30+135.0 RT. 30+136.3 RT. 30+140.0 RT. 30+148.6 RT.	RR 50+192.9 LT. 30+204.3 RT. 30+172.0 RT.			CONST. (T) 0.06HA± SLOPE (P) 214.4SM± DITCH (P) EASEMENT (T)			BRATTLEBORO			INCLUDES EROSION CONTROL 0.15A± INCLUDES EROSION CONTROL 2,307.8 S.F.± REMOVE PORTION OF CULVERT & CAP.						
3B		22, 23 25	30+204.3 RT.	RR 50+191.9 LT.	0.06HA±								0.15A± TO BE CONVEYED BACK TO PARCEL #4 RR AFTER PROJECT COMPLETION						

DR. (P)- DRAINAGE RIGHT
DIT. (P)- DITCHING RIGHT
CH. (P)- CHANNEL RT.
DRIVE (T)- DRIVE RIGHT
CUL. (P)- CULVERT RIGHT
[W]- WATER SOURCES

PRESENT R.O.W.
TAKING WITHOUT ACCESS
TAKING WITHOUT ACCESS ALONG PROPERTY LINE
TAKING WITH ACCESS
PERMANENT EASEMENT
TEMPORARY EASEMENT

LEGEND
C&T (P) --- CLEARING & TRIMMING
CZ (P) CLEAR ZONE
CONST. (T) --- CONSTRUCTION EASEMENT
SR --- SLOPE RIGHTS
P --- PROPERTY LINE
L --- TOP OF CUT
O --- TOE OF SLOPE

APPROVED: ROGER P. DUMAS DATE: 02-02-01
CHIEF, PLANS & TITLES

R. O. W. PLANS


BRATTLEBORO
NH BRF 010-2(2)
SHEET 29 OF 145


**STATE OF VERMONT
AGENCY OF TRANSPORTATION
RIGHT OF WAY PLANS
DETAIL SHEET**

TABLE OF PROJECT PROPERTY ACQUISITION

PARCEL NO.	GRANTOR	SHEET NO.	BEGINNING STATION	ENDING STATION	TAKING	REM.	RIGHTS	TITLE TAKEN	DATE	TOWN OR CITY RECORDED	BK.	PG.	REMARKS	REVISION NO.	SHEET	DESCRIPTION OF REVISION	DATE	MADE BY	APPROVED BY
3C		22, 23	30+136.6 RT.	30+218.3 RT.	0.11HA±		ALL R. T. & I.						VT. RTE. 9 HWY. EASE 0.27A±						
3D		23	30+232.6 RT. 30+330.0 RT.	NH 203+72.3 RT.	0.30HA±		ALL R. T. & I.						VT. RTE. 9 HWY. EASE. 0.74A± DRIVE 4.6M (15') MM 0725						
4	CV PROPERTIES, INC. JOINED BY NEW ENGLAND CENTRAL RAILROAD, INC.	23, 24 25, 26, 27	RR 50+017.0 CL. 30+214.3 RT.	RR 50+701.6 CL. 30+223.6 LT.			CONST. (T) 1.37HA±			BRATTLEBORO			REALIGN RR TRACKS AND NEW OVERPASS. 3.39A± CROSSING EASE OVER VT RTE. 9 9,888 S.F. ± TO BE CONVEYED TO RR AFTER PROJECT COMPLETION						
5A	MOORE ASSOCIATED COMPANIES INC. (A/K/A THE MOORE COMPANY) (D/B/A/ FULFLEX, INC.)	25, 26	RR 50+326.6 LT. RR 50+326.6 LT. RR 50+386.4 LT.	RR 50+460.3 LT. RR 50+403.0 LT. RR 50+386.9 LT.	0.05HA±		CONST. (T) 76.2 SM± EXCEPT & RESERVE			BRATTLEBORO			0.12A± TO BE CONVEYED BACK TO PARCEL #4 RR 820.2 S.F. ± APPROXIMATE LOCATION OF WATERLINE						
5B		23	NH 203+45.6 LT. 30+332.3 LT.	NH 203+67.0 LT.	374.4 SM±		DRIVE (T)						4,030.1 S.F. ± 3.0M (30') GRAVEL MM 0725 IN COMMON PARCEL 1D						
5C		23	NH 203+45.6 RT.	NH 203+69.9 RT.	0.04HA±		ALL R. T. & I.						RTE. 9 HWY. EASE. 0.10A±						
5D		22	30+148.6 LT. & RT. 30+148.6 LT.				ALL R. T. & I. CULVERT (T)						CULVERT, CAP PIPE RT. CONNECT TO EXISTING CULVERT						
6	JACK TARMY REVOCABLE TRUST, JONATHAN BUMP, TRUSTEE, LESSOR AND ETTA E. TARMY REVOCABLE TRUST, JONATHAN BUMP, TRUSTEE, LESSOR AND JACK TARMY LUMBER COMPANY, INC. - LESSEE	24, 25	RR 50+177.0 LT. RR 50+179.5 LT.	RR 50+180.0 LT. RR 50+193.6 LT.			ACCESS (T) CONST. (T) 165.0 SM±						FROM RTE. 5 FOR EQUIPMENT INCLUDES EROSION CONTROL 1808.4 S.F. ±						

DR. (P)- DRAINAGE RIGHT
DIT. (P)- DITCHING RIGHT
CH. (P)- CHANNEL RT.
DRIVE (T)- DRIVE RIGHT
CUL. (P)- CULVERT RIGHT
[W]- WATER SOURCES

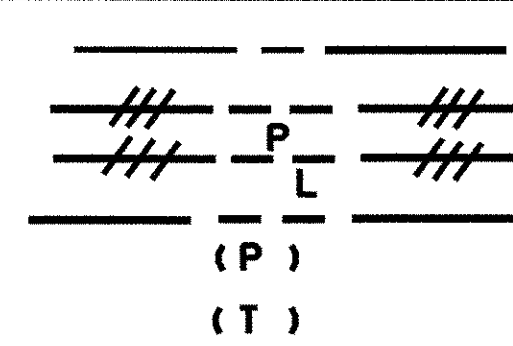
 PRESENT R.O.W.
 TAKING WITHOUT ACCESS
 TAKING WITHOUT ACCESS ALONG PROPERTY LINE
 TAKING WITH ACCESS
 PERMANENT EASEMENT
 TEMPORARY EASEMENT

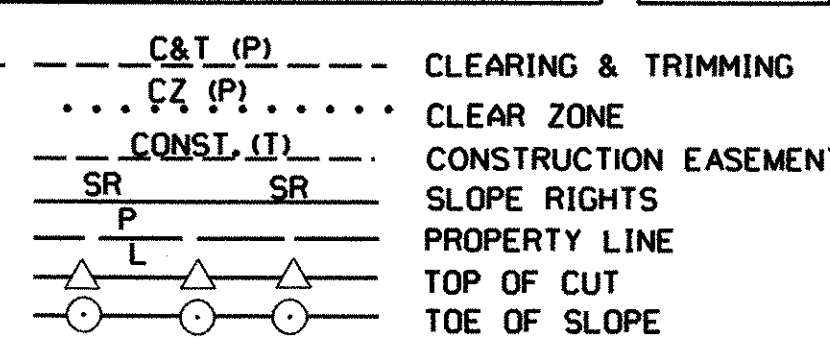LEGEND

 C&T (P)
 CLEARING & TRIMMING
 CLEAR ZONE
 CONSTRUCTION EASEMENT
 SLOPE RIGHTS
 PROPERTY LINE
 TOP OF CUT
 TOE OF SLOPE

APPROVED: ROGER P. DUMAS DATE: 02-02-01
CHIEF, PLANS & TITLES

R. O. W. PLANS
BRATTLEBORO
NH BRF 010-2(2)
SHEET 30 OF 145

GPS CONTROL POINTS

* NO GPS POINTS USED

BENCHMARKS

BM-CHS1 ELEV 111.862
THE STATION IS LOCATED IN CHESTERFIELD, NH

TO REACH THE STATION FROM THE NEW HAMPSHIRE/VERMONT STATE LINE AT THE WEST END OF THE STATE ROUTE 9 BRIDGE OVER THE CONNECTICUT RIVER, GO EAST FOR 0.89 km (0.55 mi) ON ROUTE 9 TO THE STATION ON THE LEFT IN THE NORTHWEST CORNER OF AN ASPHALT APRON.





THE STATION IS A STANDARD CENTER-PUNCHED RAILROAD SPIKE DRIVEN FLUSH WITH THE PAVEMENT. LOCATED 10.5 m (34.5 ft) NORTH FROM THE CENTER OF ROUTE 9 AT THE NORTHERN YELLOW LINE, 28.3 m (93.0 ft) EAST FROM POWER POLE 9.5-1/PSNH/101/156X-1, 12.8 m (42.0 ft) WEST FROM THE END OF A 12-INCH METAL PIPE, 3.0 m (10.0 ft) NORTHEAST FROM THE END OF A 12-INCH METAL PIPE, 0.5 m (1.5 ft) SOUTH FROM THE NORTH EDGE OF PAVEMENT.

BM-CHS2 ELEV 117.426
THE STATION IS LOCATED IN CHESTERFIELD, NH





TO REACH THE STATION FROM THE NEW HAMPSHIRE/VERMONT STATE LINE AT THE WEST END OF THE STATE ROUTE 9 BRIDGE OVER THE CONNECTICUT RIVER, GO EAST FOR 1.05 km (0.65 mi) ON ROUTE 9 TO SPAULDING HILL ROAD AND THE STATION ON THE RIGHT.

THE STATION IS A STANDARD NHDOT DISK STAMPED ---087 0340 ---, SET INTO THE TOP OF A 5-INCH SQUARE GRANITE MONUMENT PROJECTING 0.1 ft ABOVE GROUND AND 0.1 ft ABOVE THE LEVEL OF THE HIGHWAY. LOCATED 6.7 m (22.0 ft) SOUTH FROM THE SOUTH EDGE OF PAVEMENT OF ROUTE 9, 57.3 m (188 ft) EAST FROM THE CENTER OF SPAULDING HILL ROAD, 10.4 m (34.0 ft) WEST FROM POLE 2/15T/PSNH/101/154, 0.8 m (2.5 ft) NORTH FROM A DELINEATOR POST.

TRAVERSE TIES

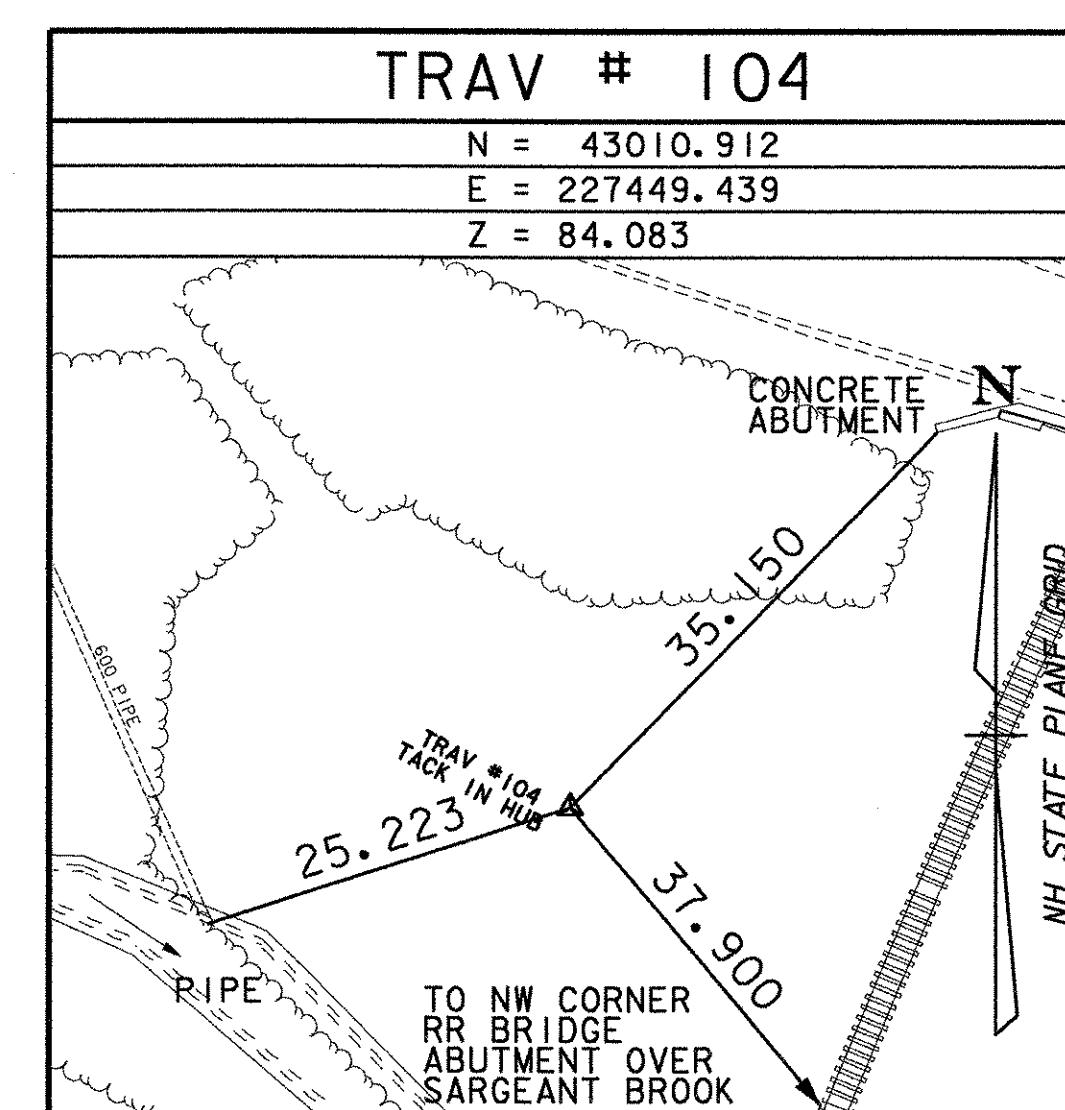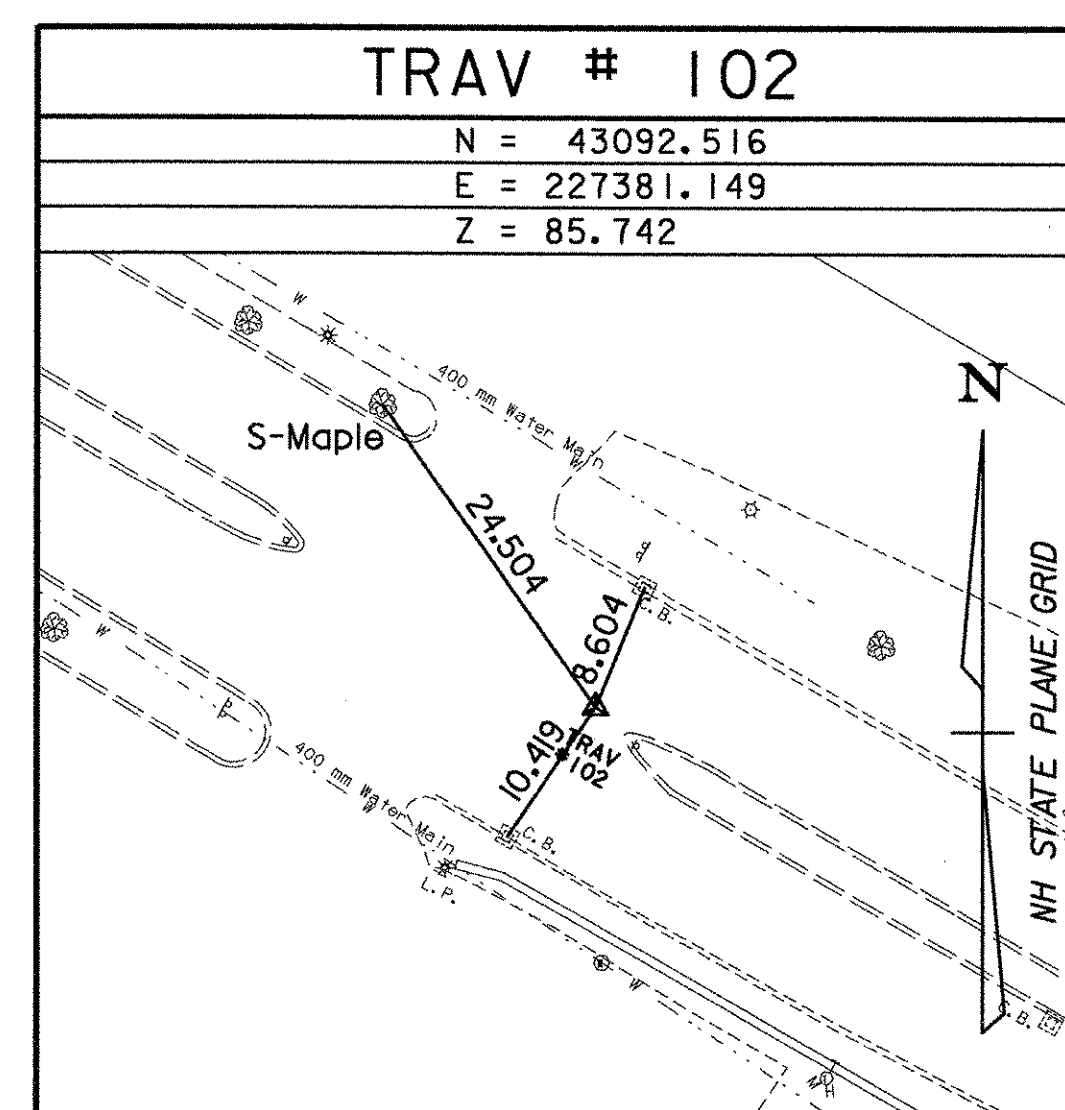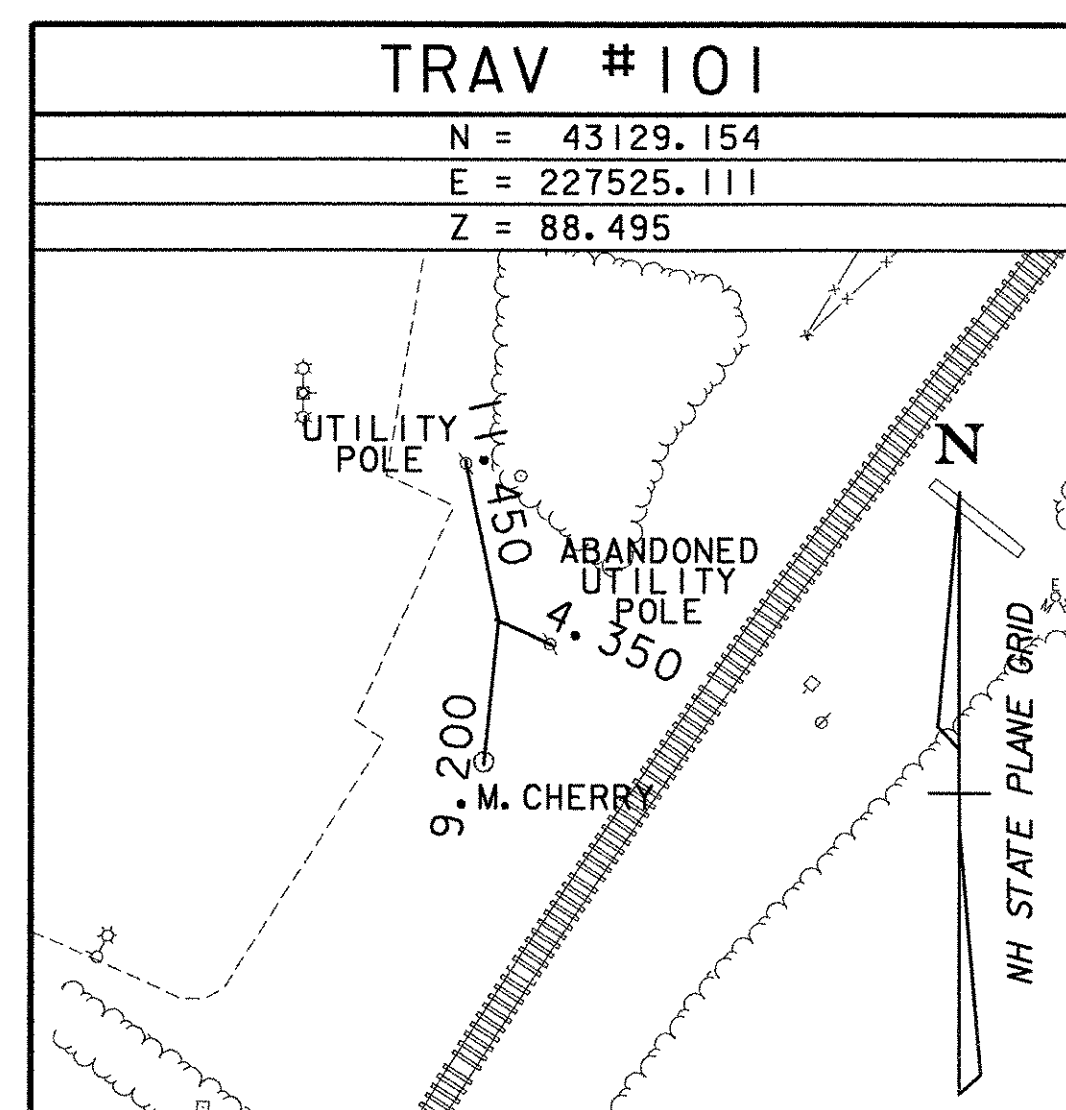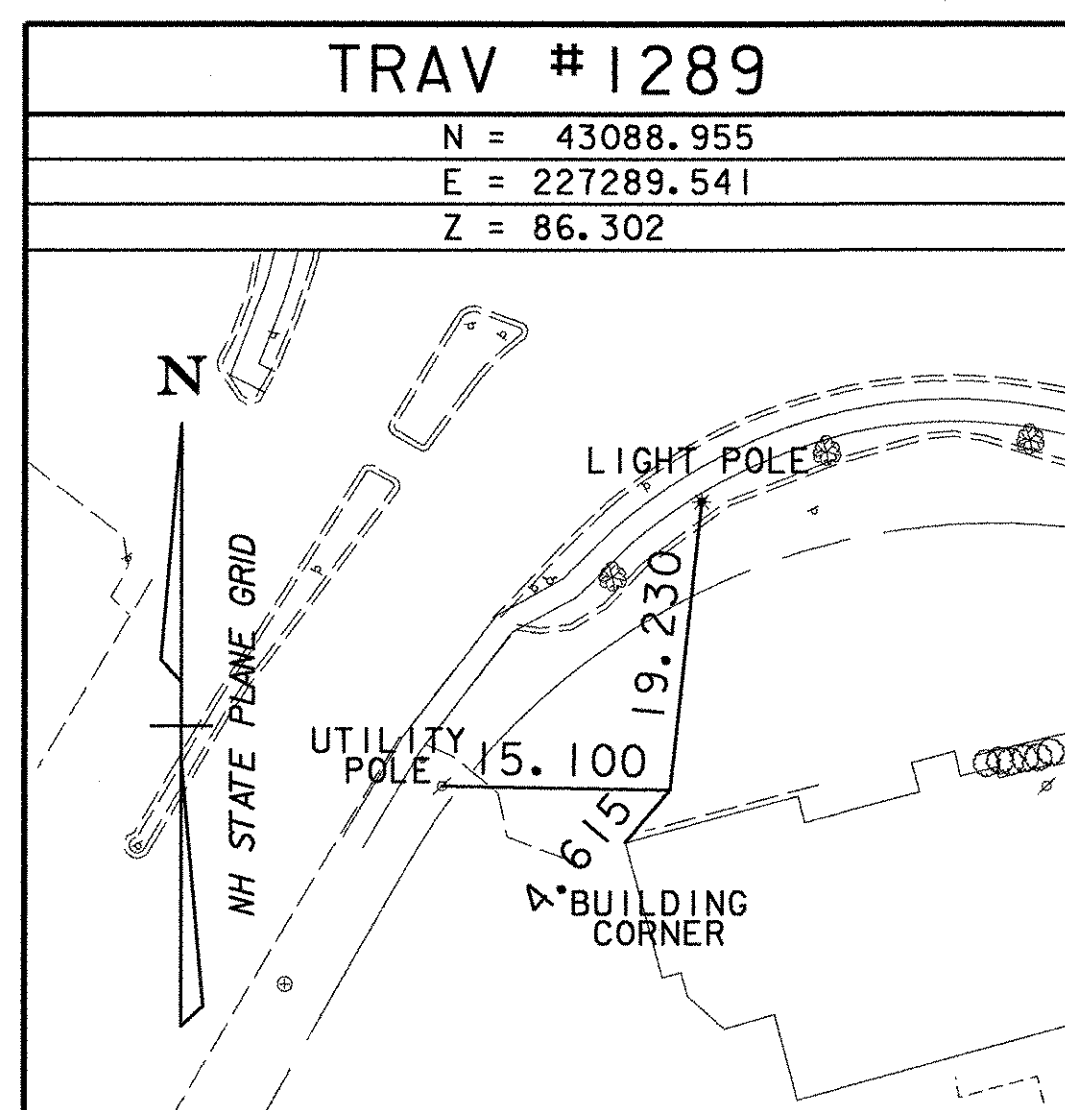

ALIGNMENT TIES

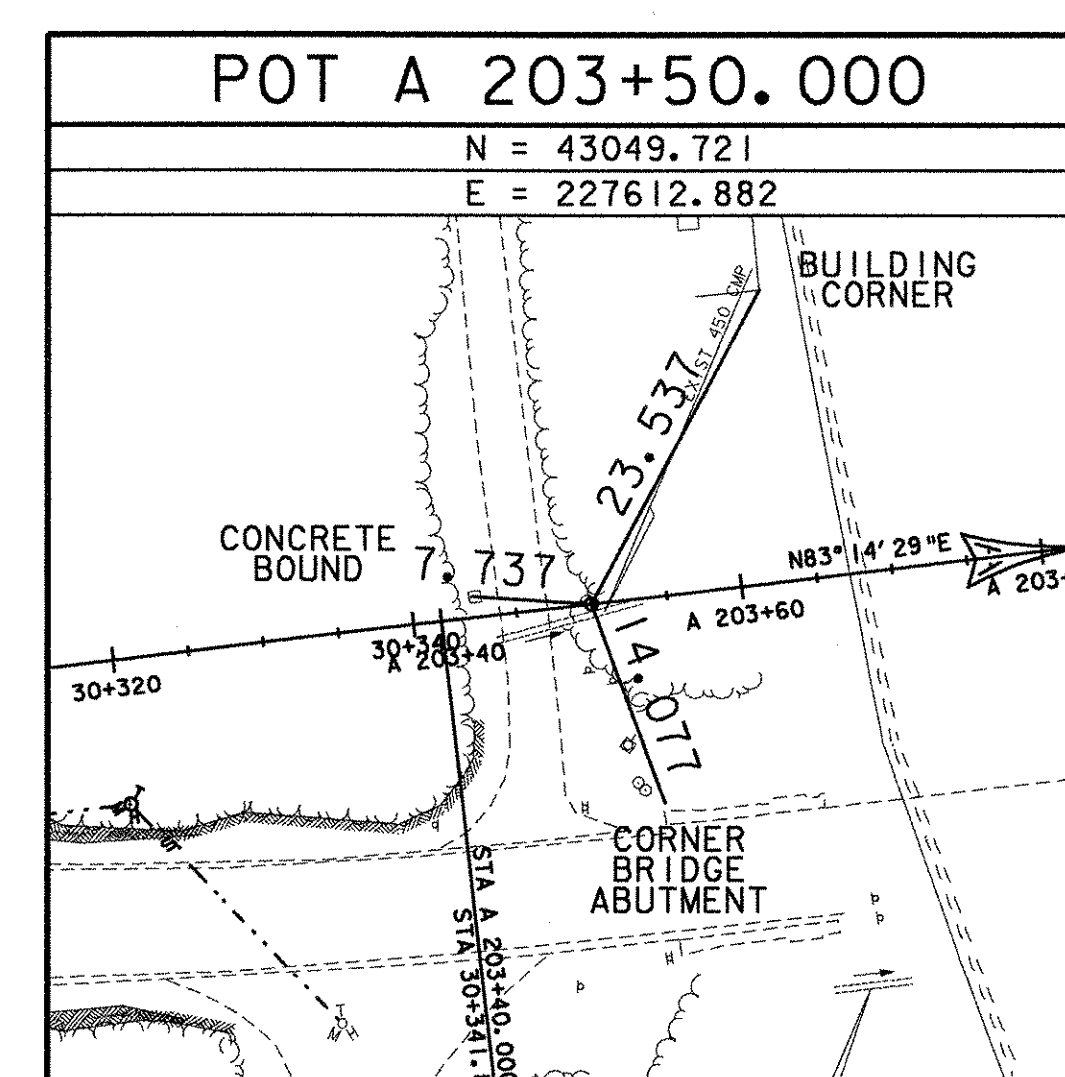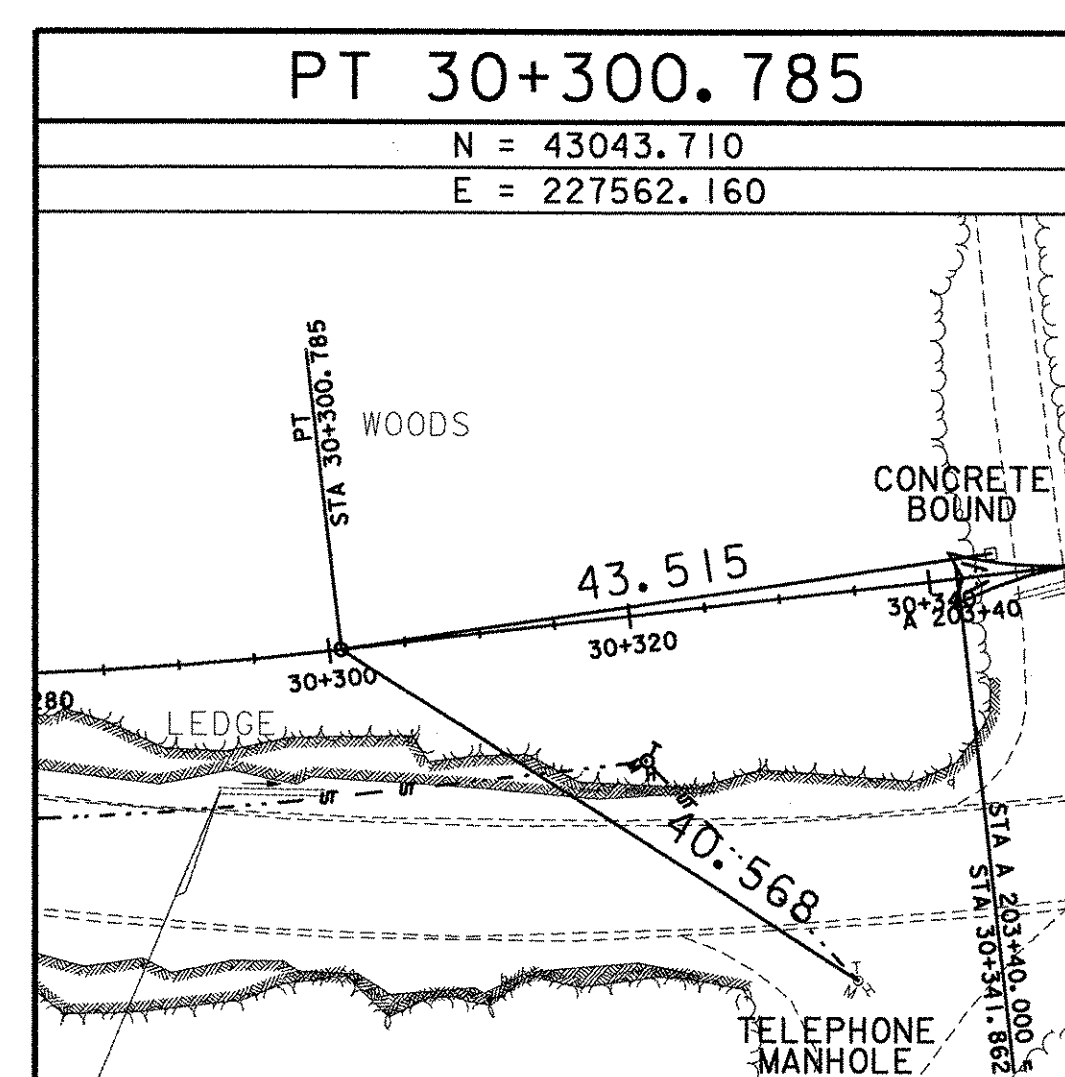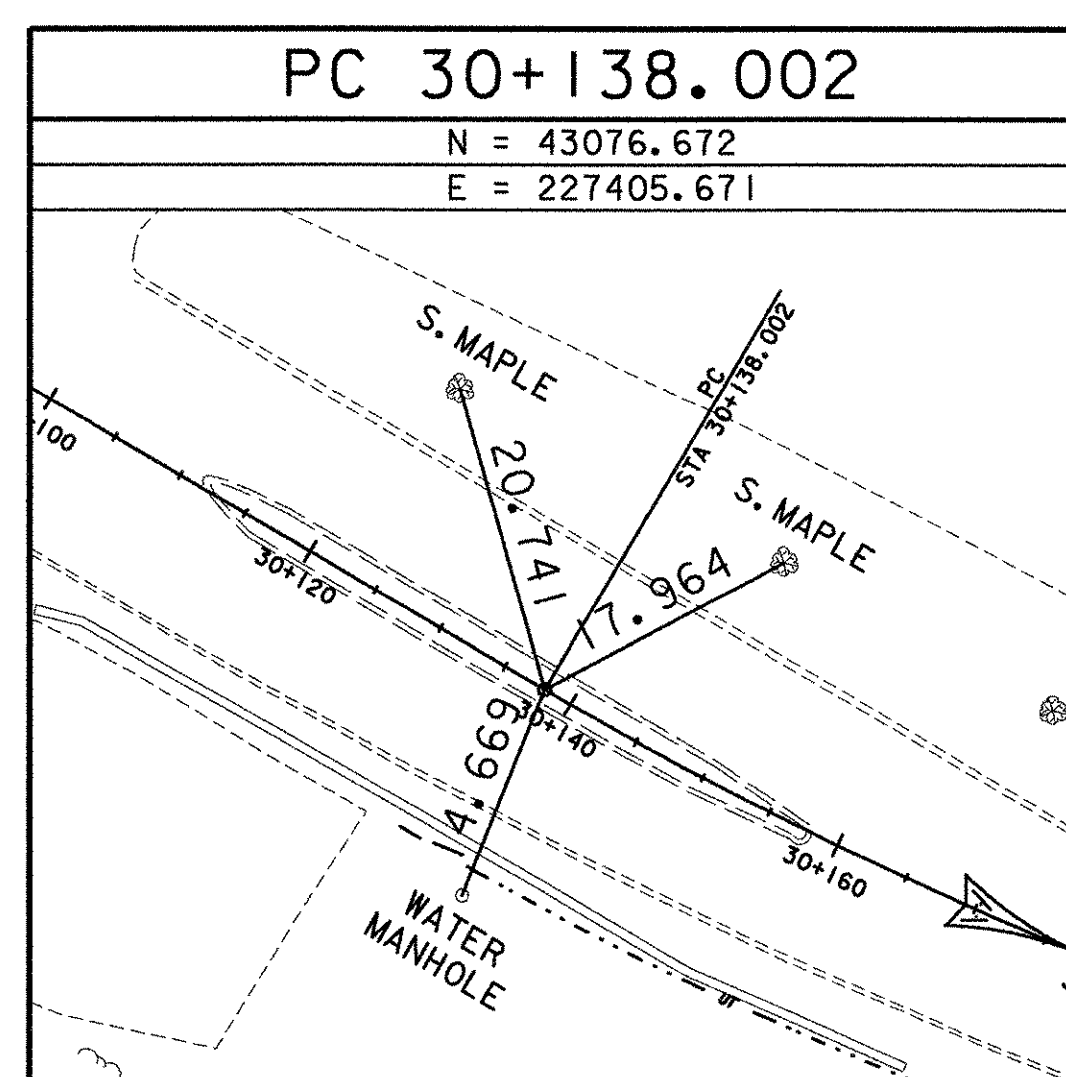
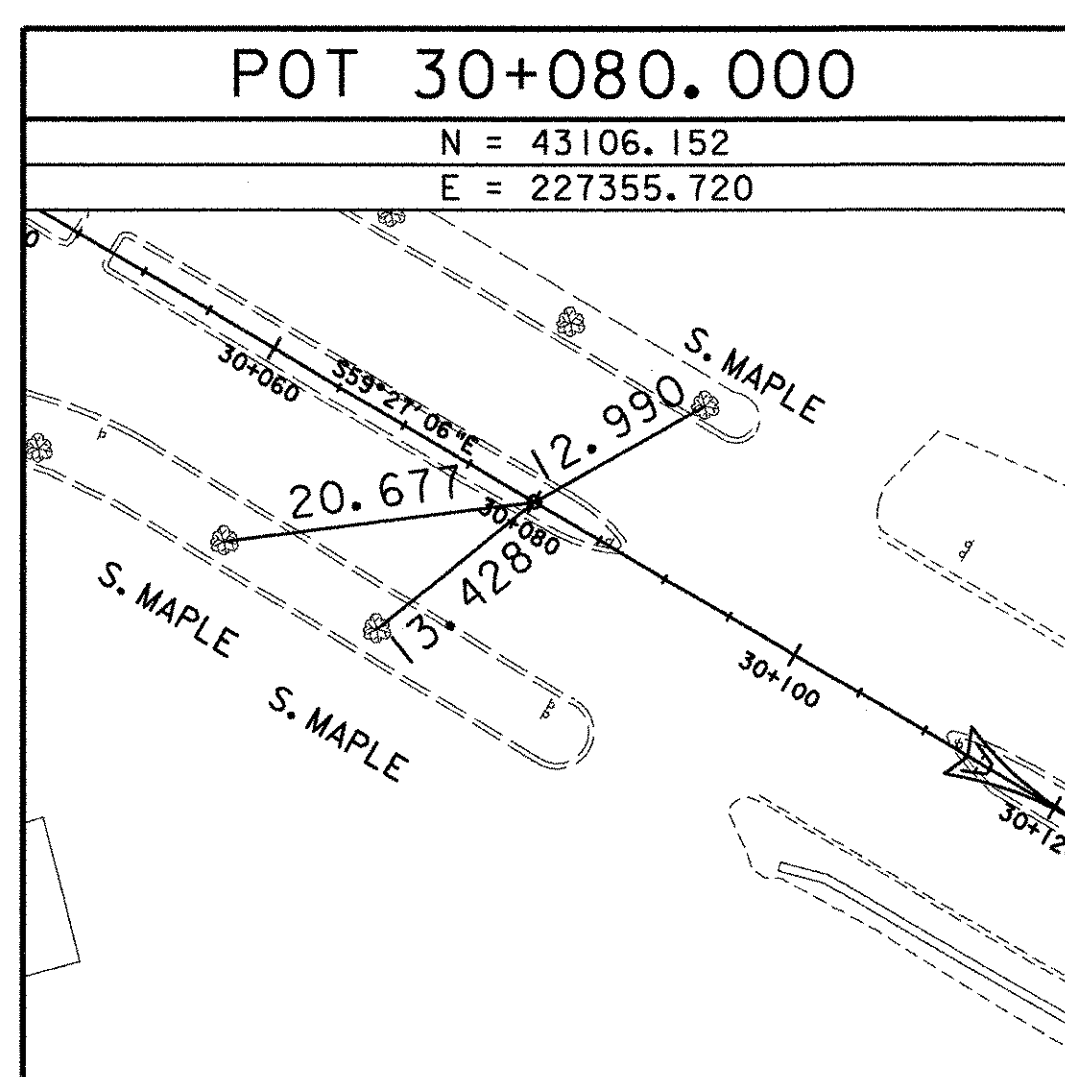


DATUM	
VERTICAL	NGVD 1929
HORIZONTAL	NAD 1983

PROJECT NAME: BRATTLEBORO
PROJECT NUMBER: NH 010-2(2)

FILE NAME: ...zb2701e.dgn
PROJECT LEADER: W HUSBAND
DESIGNED BY: P SHEDD
CLD REF NO. 00-0358

PLOT DATE: 09/20/2002
DRAWN BY: S COHEN
CHECKED BY: J WARNER
SHEET 32 OF 145

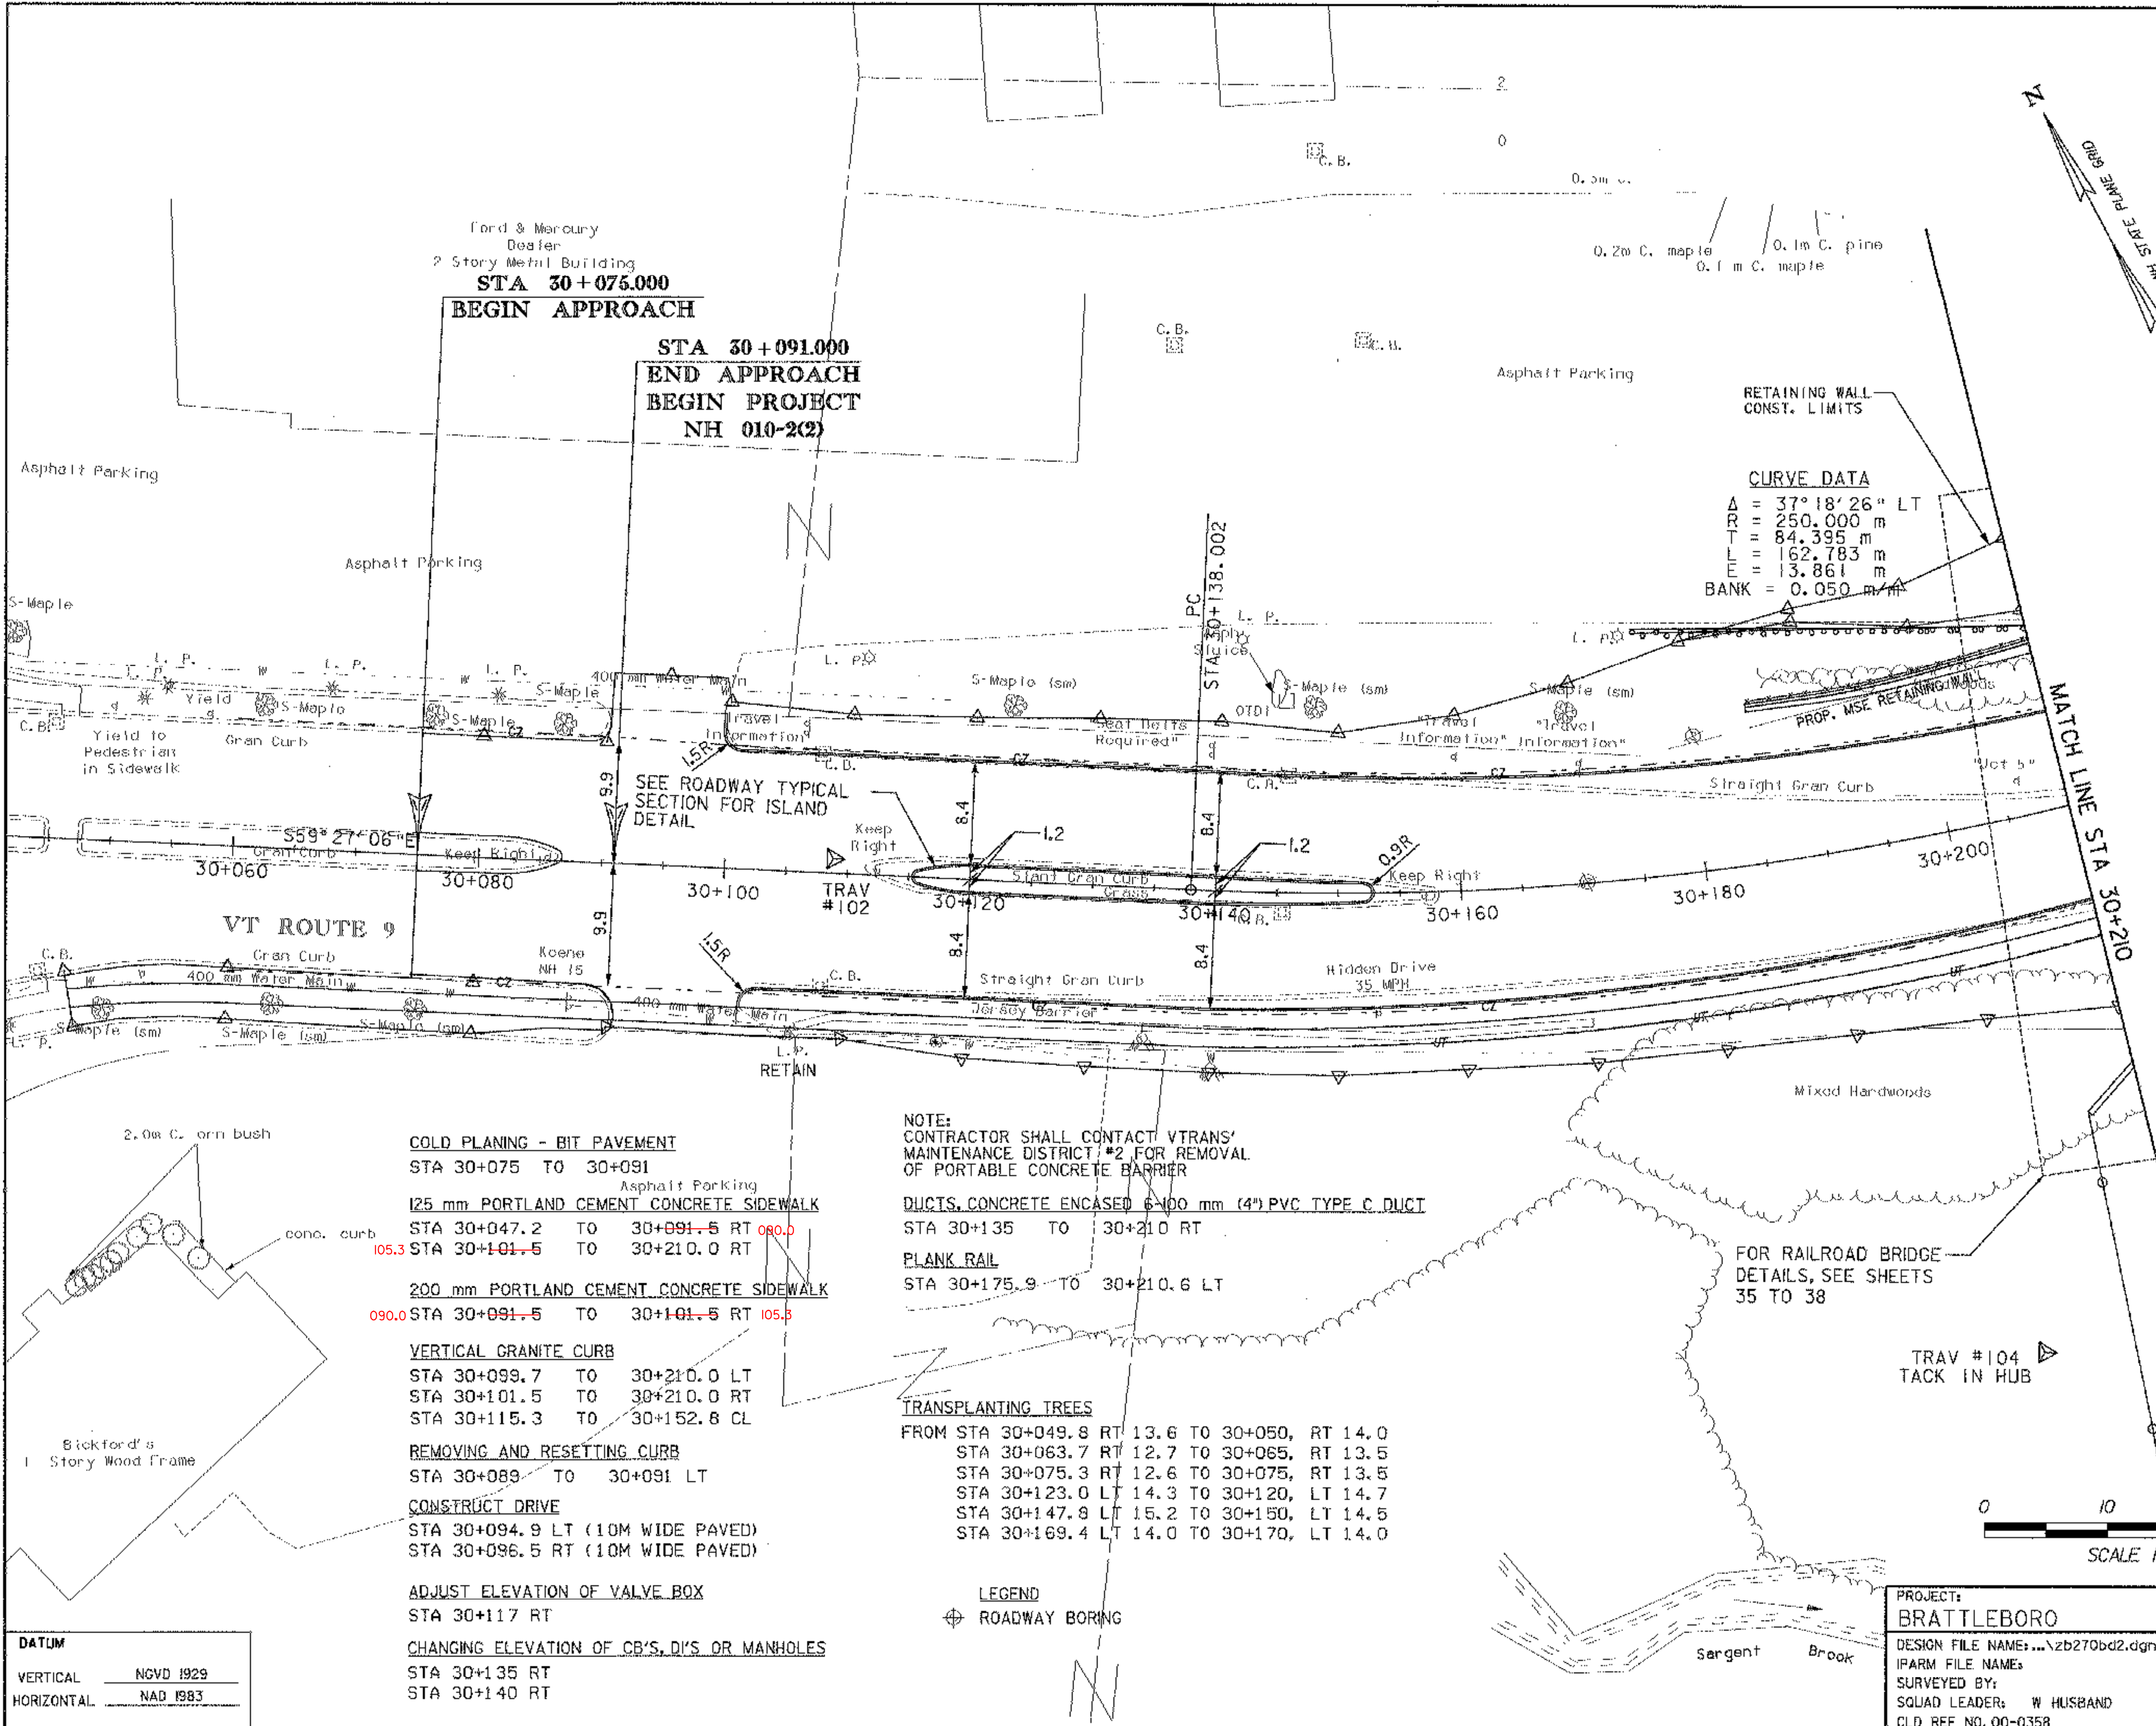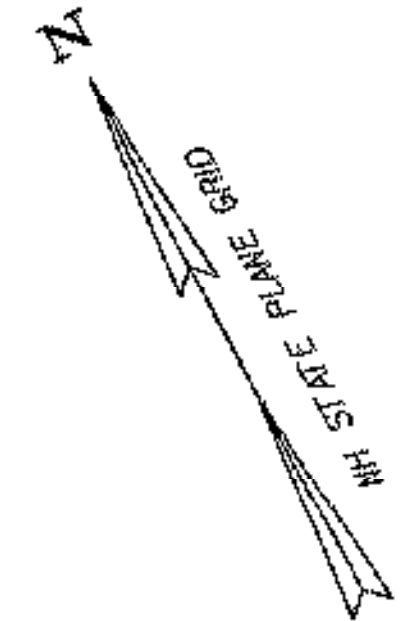

CURVE DATA
 $\Delta = 37^\circ 18' 26''$ LT
 $R = 250.000$ m
 $T = 84.395$ m
 $L = 162.783$ m
 $E = 13.861$ m
 $BANK = 0.050$ m/m

SEE ROADWAY TYPICAL SECTION FOR ISLAND DETAIL

NOTE:
 CONTRACTOR SHALL CONTACT VTRANS' MAINTENANCE DISTRICT #2 FOR REMOVAL OF PORTABLE CONCRETE BARRIER

- COLD PLANING - BIT PAVEMENT**
 STA 30+075 TO 30+091
- 125 mm PORTLAND CEMENT CONCRETE SIDEWALK**
 STA 30+047.2 TO 30+091.5 RT 080.0
 STA 30+101.5 TO 30+210.0 RT
- 200 mm PORTLAND CEMENT CONCRETE SIDEWALK**
 STA 30+091.5 TO 30+101.5 RT 105.5
- VERTICAL GRANITE CURB**
 STA 30+099.7 TO 30+210.0 LT
 STA 30+101.5 TO 30+210.0 RT
 STA 30+115.3 TO 30+152.8 CL
- REMOVING AND RESETTING CURB**
 STA 30+089 TO 30+091 LT
- CONSTRUCT DRIVE**
 STA 30+094.9 LT (10M WIDE PAVED)
 STA 30+096.5 RT (10M WIDE PAVED)
- ADJUST ELEVATION OF VALVE BOX**
 STA 30+117 RT
- CHANGING ELEVATION OF CB'S, DI'S OR MANHOLES**
 STA 30+135 RT
 STA 30+140 RT

- DUCTS, CONCRETE ENCASED 6-100 mm (4") PVC TYPE C DUCT**
 STA 30+135 TO 30+210 RT
- PLANK RAIL**
 STA 30+175.9 TO 30+210.6 LT


- TRANSPLANTING TREES**
- FROM STA 30+049.8 RT 13.6 TO 30+050, RT 14.0
 - STA 30+063.7 RT 12.7 TO 30+065, RT 13.5
 - STA 30+075.3 RT 12.6 TO 30+075, RT 13.5
 - STA 30+123.0 LT 14.3 TO 30+120, LT 14.7
 - STA 30+147.9 LT 15.2 TO 30+150, LT 14.5
 - STA 30+169.4 LT 14.0 TO 30+170, LT 14.0

LEGEND
 ROADWAY BORING

DATUM
 VERTICAL NGVD 1929
 HORIZONTAL NAD 1983



PROJECT: BRATTLEBORO	PROJECT NO.: NH 010-2(2)
DESIGN FILE NAME: ... \zb270bd2.dgn	PLOT DATE: 09/20/2002
IPARM FILE NAME:	SURVEY DATE:
SURVEYED BY:	DRAWN BY: P SHEDD
SQUAD LEADER: W HUSBAND	SHEET: 33 OF 145
CLD REF NO. 00-0358	

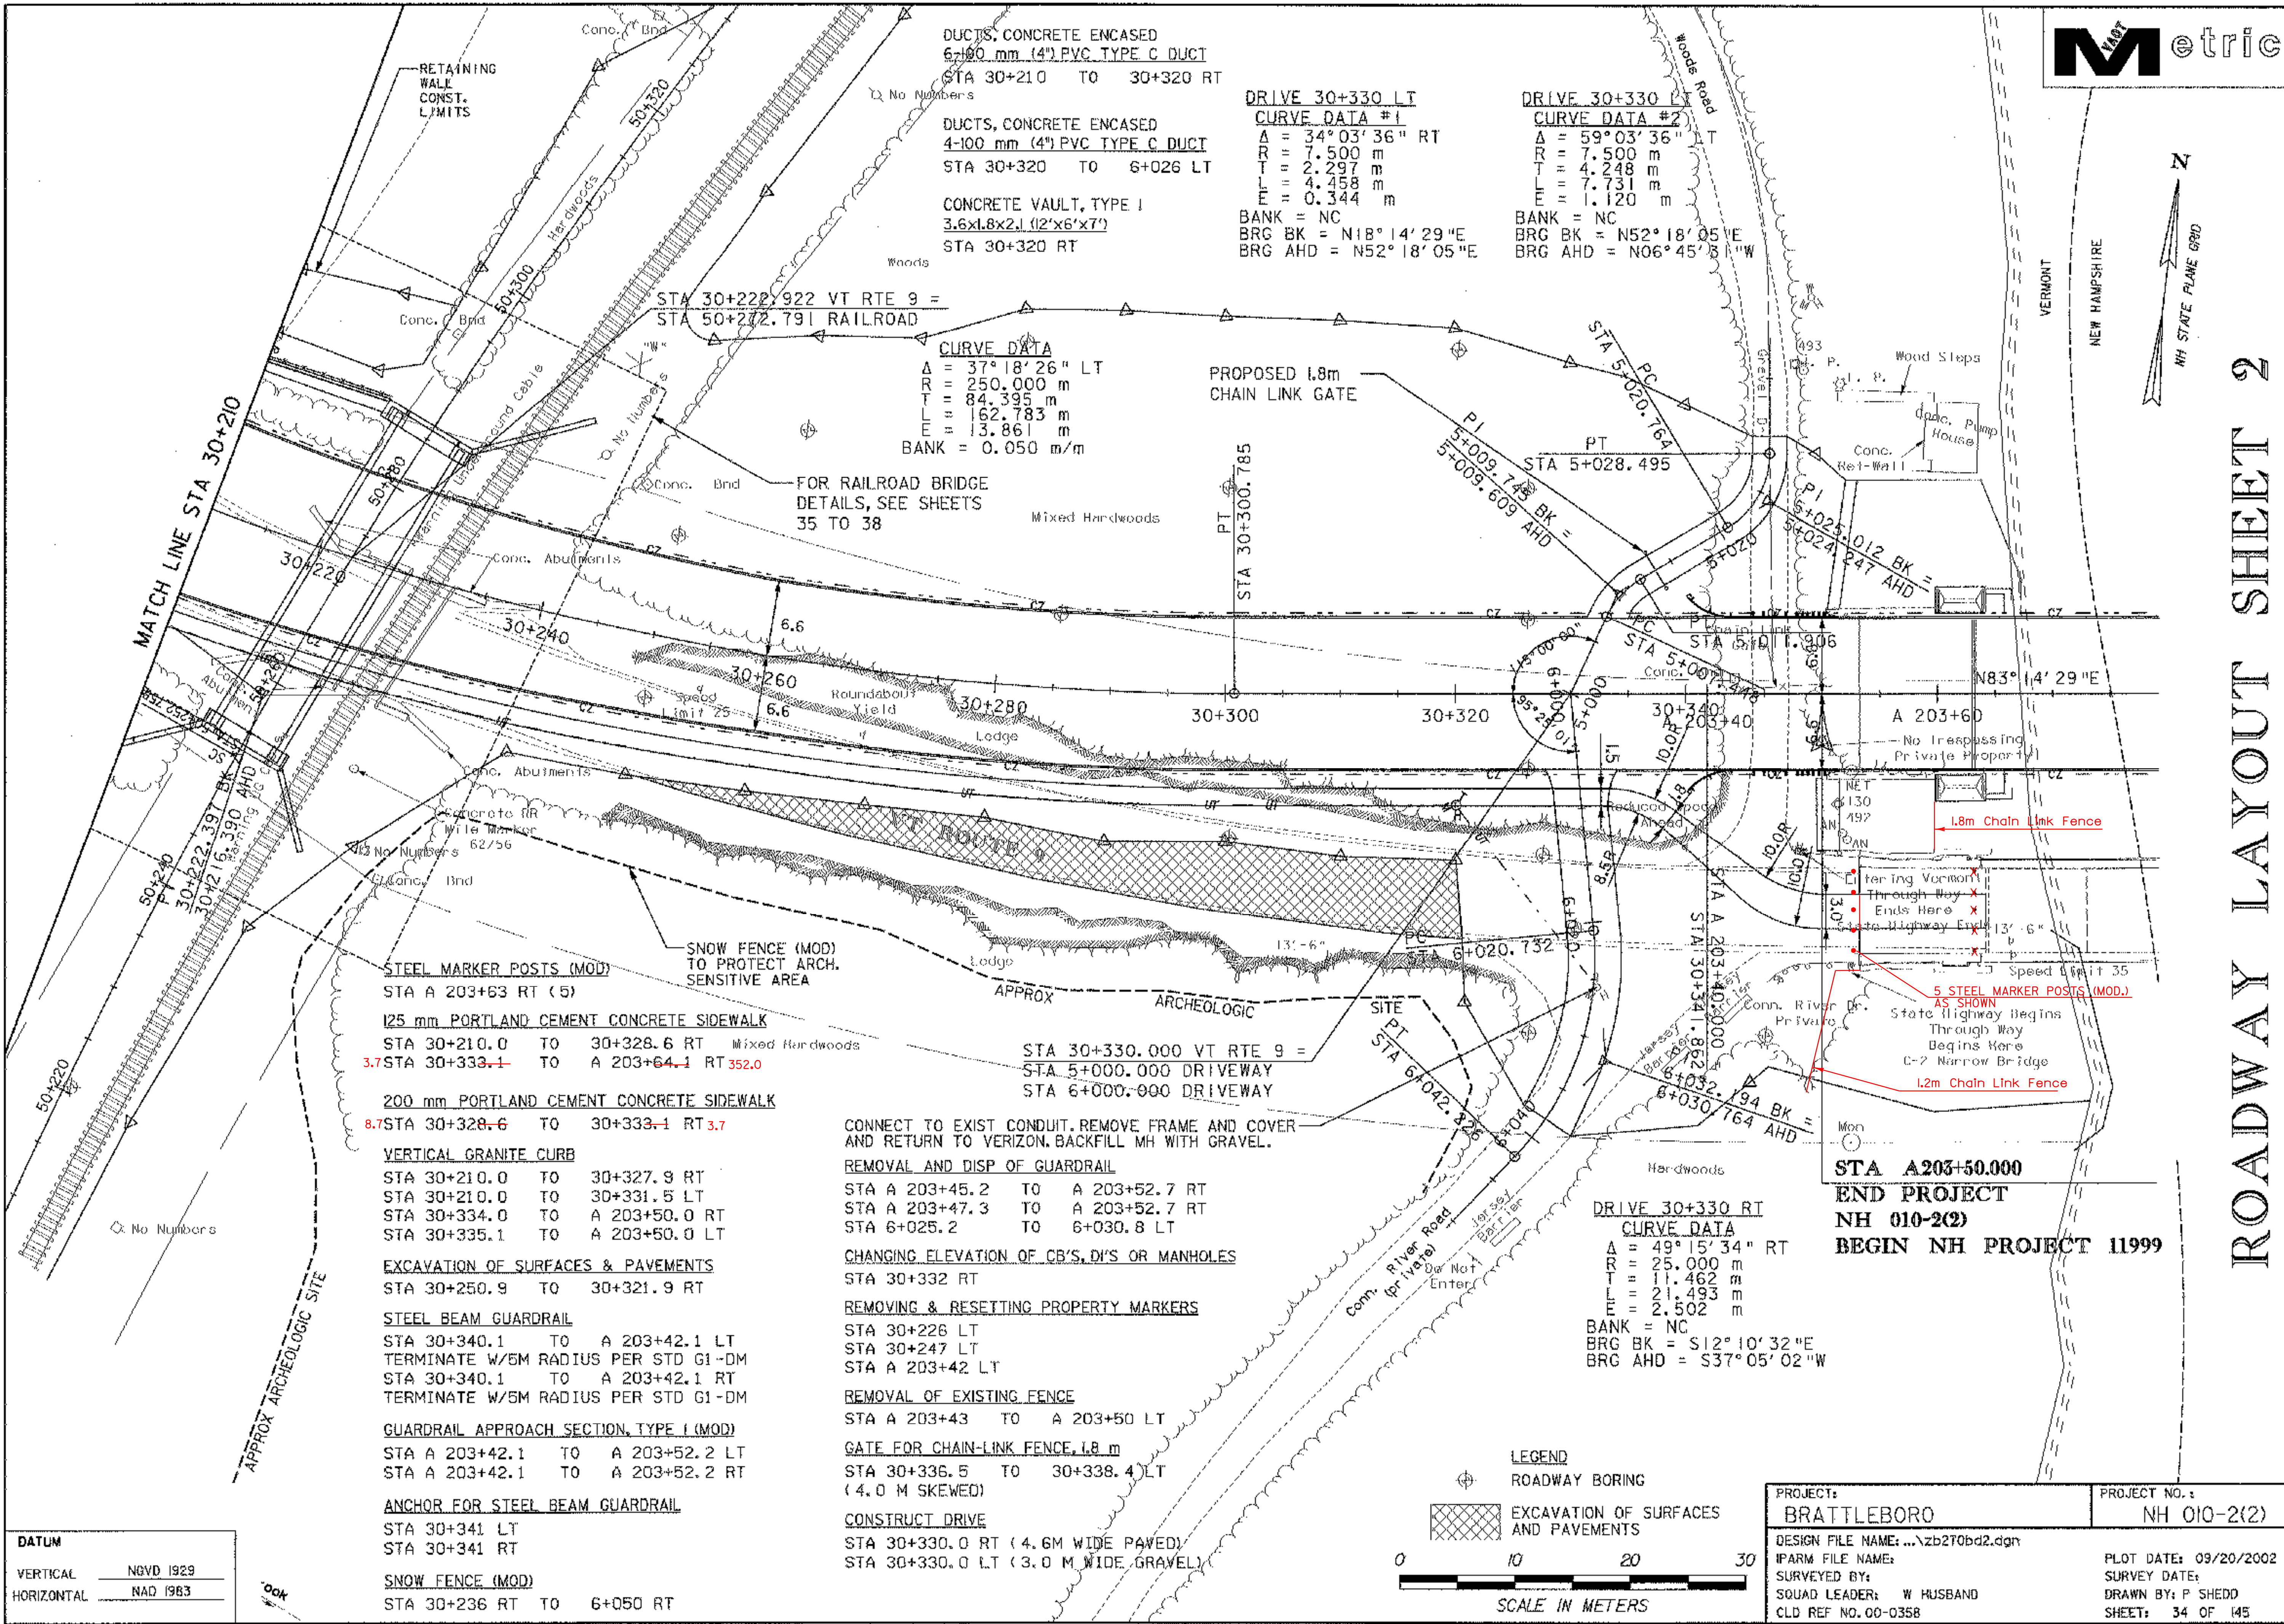

DUCTS, CONCRETE ENCASED
6-100 mm (4") PVC TYPE C DUCT
STA 30+210 TO 30+320 RT

DUCTS, CONCRETE ENCASED
4-100 mm (4") PVC TYPE C DUCT
STA 30+320 TO 6+026 LT

CONCRETE VAULT, TYPE I
3.6x1.8x2.1 (12'x6'x7')
STA 30+320 RT

DRIVE 30+330 LT
CURVE DATA #1
A = 34° 03' 36" RT
R = 7.500 m
T = 2.297 m
L = 4.458 m
E = 0.344 m
BANK = NC
BRG BK = N18° 14' 29" E
BRG AHD = N52° 18' 05" E

DRIVE 30+330 LT
CURVE DATA #2
A = 59° 03' 36" RT
R = 7.500 m
T = 4.248 m
L = 7.731 m
E = 1.120 m
BANK = NC
BRG BK = N52° 18' 05" E
BRG AHD = N06° 45' 8" W

CURVE DATA
A = 37° 18' 26" LT
R = 250.000 m
T = 84.395 m
L = 162.783 m
E = 13.861 m
BANK = 0.050 m/m

DRIVE 30+330 RT
CURVE DATA
A = 49° 15' 34" RT
R = 25.000 m
T = 11.462 m
L = 21.493 m
E = 2.502 m
BANK = NC
BRG BK = S12° 10' 32" E
BRG AHD = S37° 05' 02" W

STEEL MARKER POSTS (MOD)
STA A 203+63 RT (5)

125 mm PORTLAND CEMENT CONCRETE SIDEWALK
STA 30+210.0 TO 30+328.6 RT Mixed Hardwoods
3.7 STA 30+333.1 TO A 203+64.1 RT 352.0

200 mm PORTLAND CEMENT CONCRETE SIDEWALK
8.7 STA 30+328.6 TO 30+333.1 RT 3.7

VERTICAL GRANITE CURB
STA 30+210.0 TO 30+327.9 RT
STA 30+210.0 TO 30+331.5 LT
STA 30+334.0 TO A 203+50.0 RT
STA 30+335.1 TO A 203+50.0 LT

EXCAVATION OF SURFACES & PAVEMENTS
STA 30+250.9 TO 30+321.9 RT

STEEL BEAM GUARDRAIL
STA 30+340.1 TO A 203+42.1 LT
TERMINATE W/5M RADIUS PER STD G1-DM
STA 30+340.1 TO A 203+42.1 RT
TERMINATE W/5M RADIUS PER STD G1-DM

GUARDRAIL APPROACH SECTION, TYPE I (MOD)
STA A 203+42.1 TO A 203+52.2 LT
STA A 203+42.1 TO A 203+52.2 RT

ANCHOR FOR STEEL BEAM GUARDRAIL
STA 30+341 LT
STA 30+341 RT

SNOW FENCE (MOD)
STA 30+236 RT TO 6+050 RT

CONNECT TO EXIST CONDUIT, REMOVE FRAME AND COVER AND RETURN TO VERIZON, BACKFILL MH WITH GRAVEL.

REMOVAL AND DISP OF GUARDRAIL
STA A 203+45.2 TO A 203+52.7 RT
STA A 203+47.3 TO A 203+52.7 RT
STA 6+025.2 TO 6+030.8 LT

CHANGING ELEVATION OF CB'S, DI'S OR MANHOLES
STA 30+332 RT

REMOVING & RESETING PROPERTY MARKERS
STA 30+226 LT
STA 30+247 LT
STA A 203+42 LT

REMOVAL OF EXISTING FENCE
STA A 203+43 TO A 203+50 LT

GATE FOR CHAIN-LINK FENCE, 1.8 m
STA 30+336.5 TO 30+338.4 LT (4.0 M SKEWED)

CONSTRUCT DRIVE
STA 30+330.0 RT (4.6 M WIDE PAVED)
STA 30+330.0 LT (3.0 M WIDE GRAVEL)


DATUM

VERTICAL	NGVD 1929
HORIZONTAL	NAD 1983

00K



BRADFORD DRIVE
TEMPORARY CONSTRUCTION ACCESS (Private)

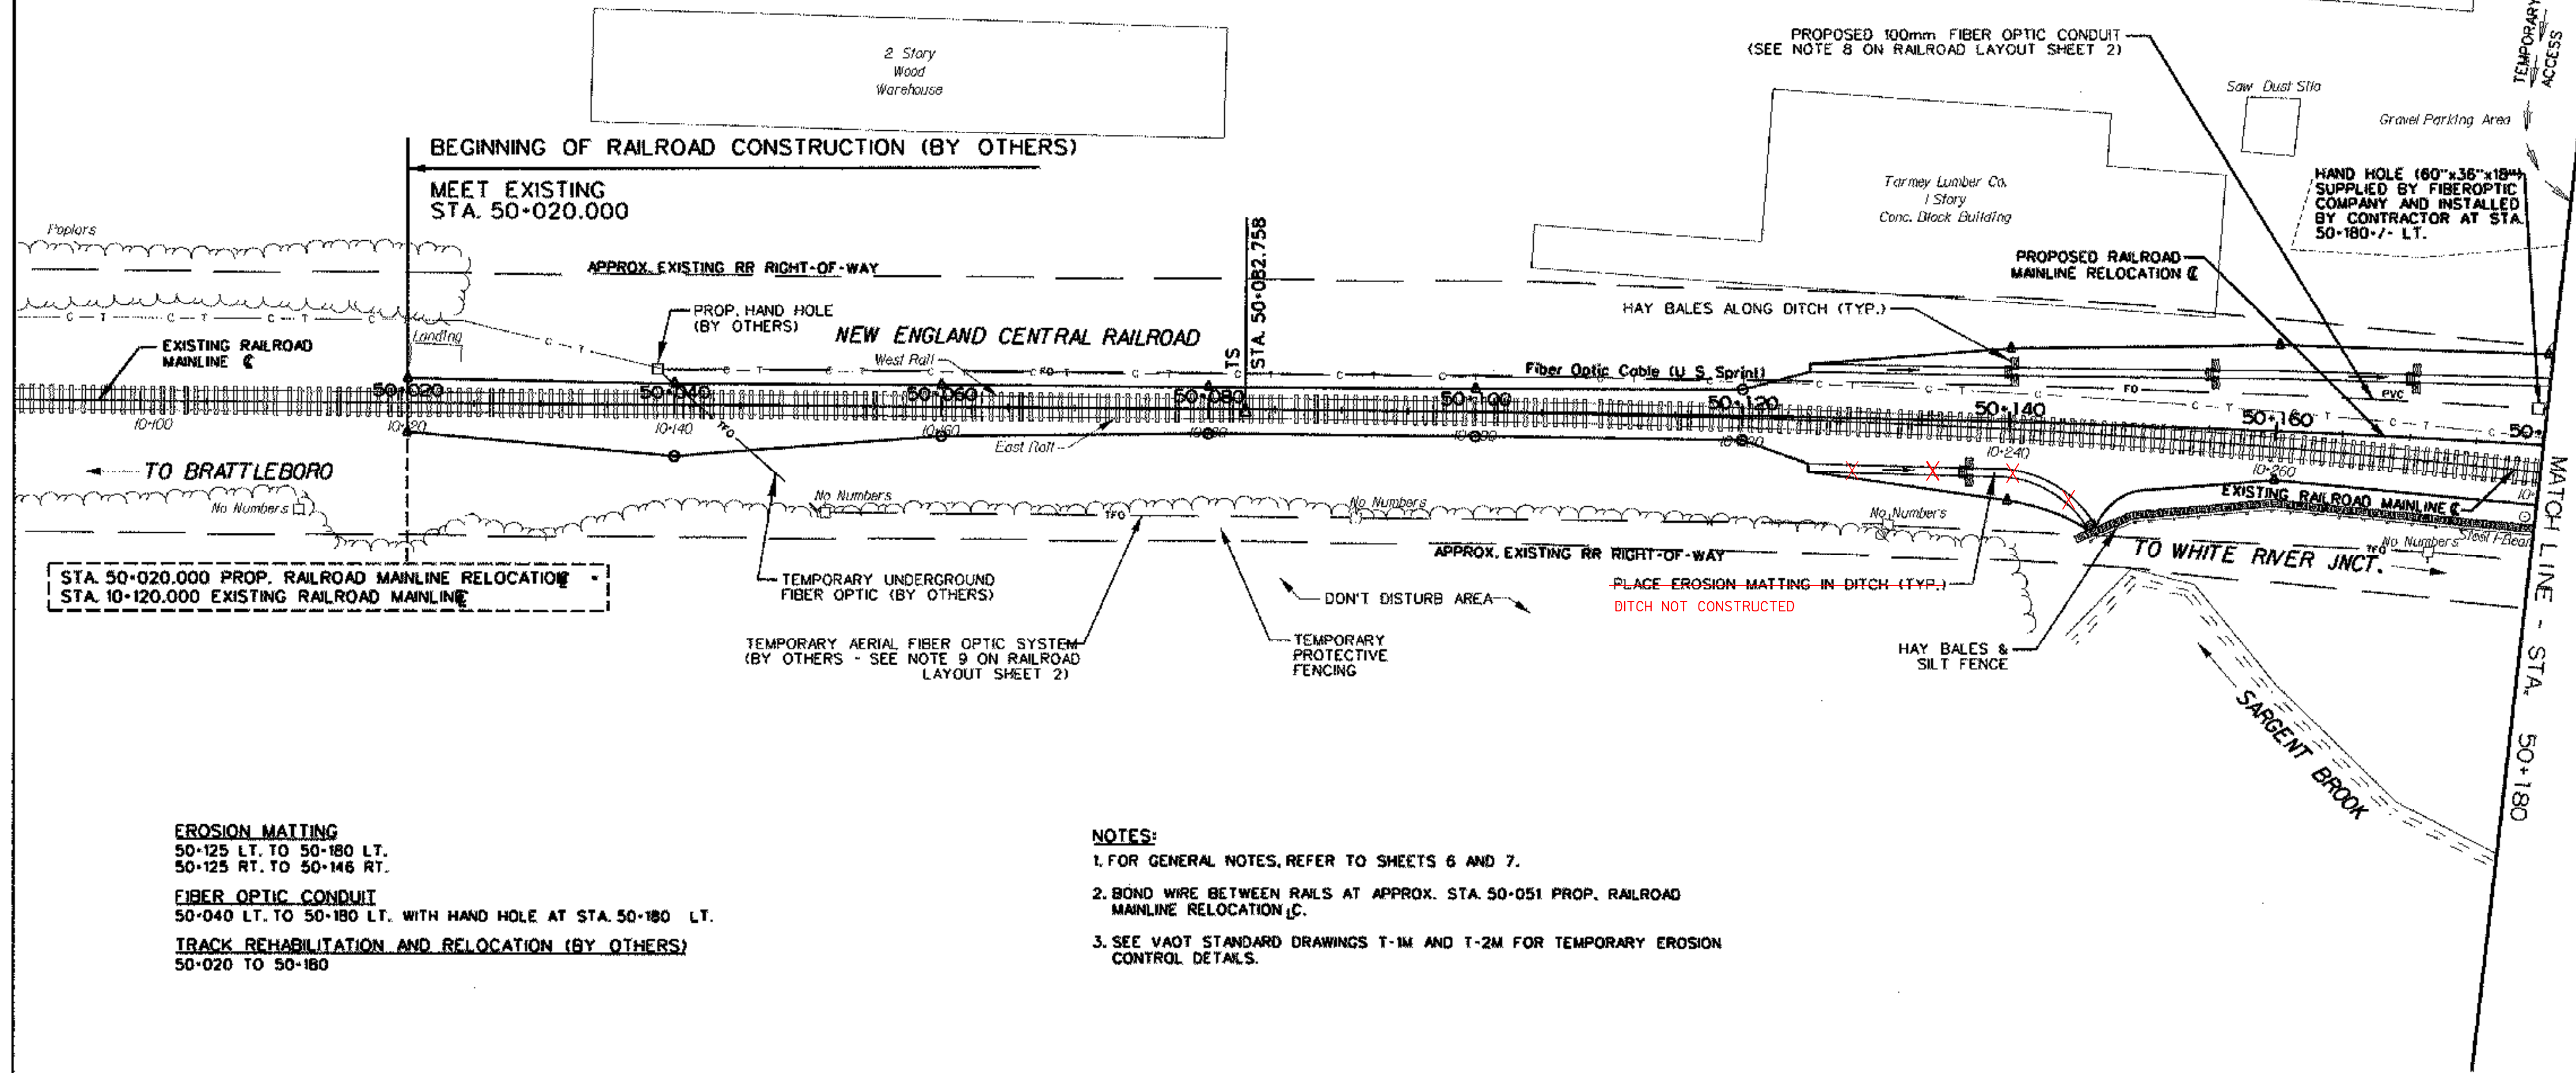

STA. 50+020.000 PROP. RAILROAD MAINLINE RELOCATION
STA. 10+120.000 EXISTING RAILROAD MAINLINE

EROSION MATTING
50+125 LT. TO 50+180 LT.
50+125 RT. TO 50+146 RT.

FIBER OPTIC CONDUIT
50+040 LT. TO 50+180 LT. WITH HAND HOLE AT STA. 50+180 LT.

TRACK REHABILITATION AND RELOCATION (BY OTHERS)
50+020 TO 50+180


NOTES:

1. FOR GENERAL NOTES, REFER TO SHEETS 6 AND 7.
2. BOND WIRE BETWEEN RAILS AT APPROX. STA. 50+051 PROP. RAILROAD MAINLINE RELOCATION, C.
3. SEE VAOT STANDARD DRAWINGS T-1M AND T-2M FOR TEMPORARY EROSION CONTROL DETAILS.



PROJECT NAME:	BRATTLEBORO	PLOT DATE:	10-02-2002
PROJECT NUMBER:	NH 010-2(2)	DRAWN BY:	DHL/LB/LRD
FILE NAME:	zb270bdr.dgn	CHECKED BY:	TEM
PROJECT LEADER:	JHR	SHEET	35 OF 145
DESIGNED BY:	GJB		

RAILROAD LAYOUT SHEET 1

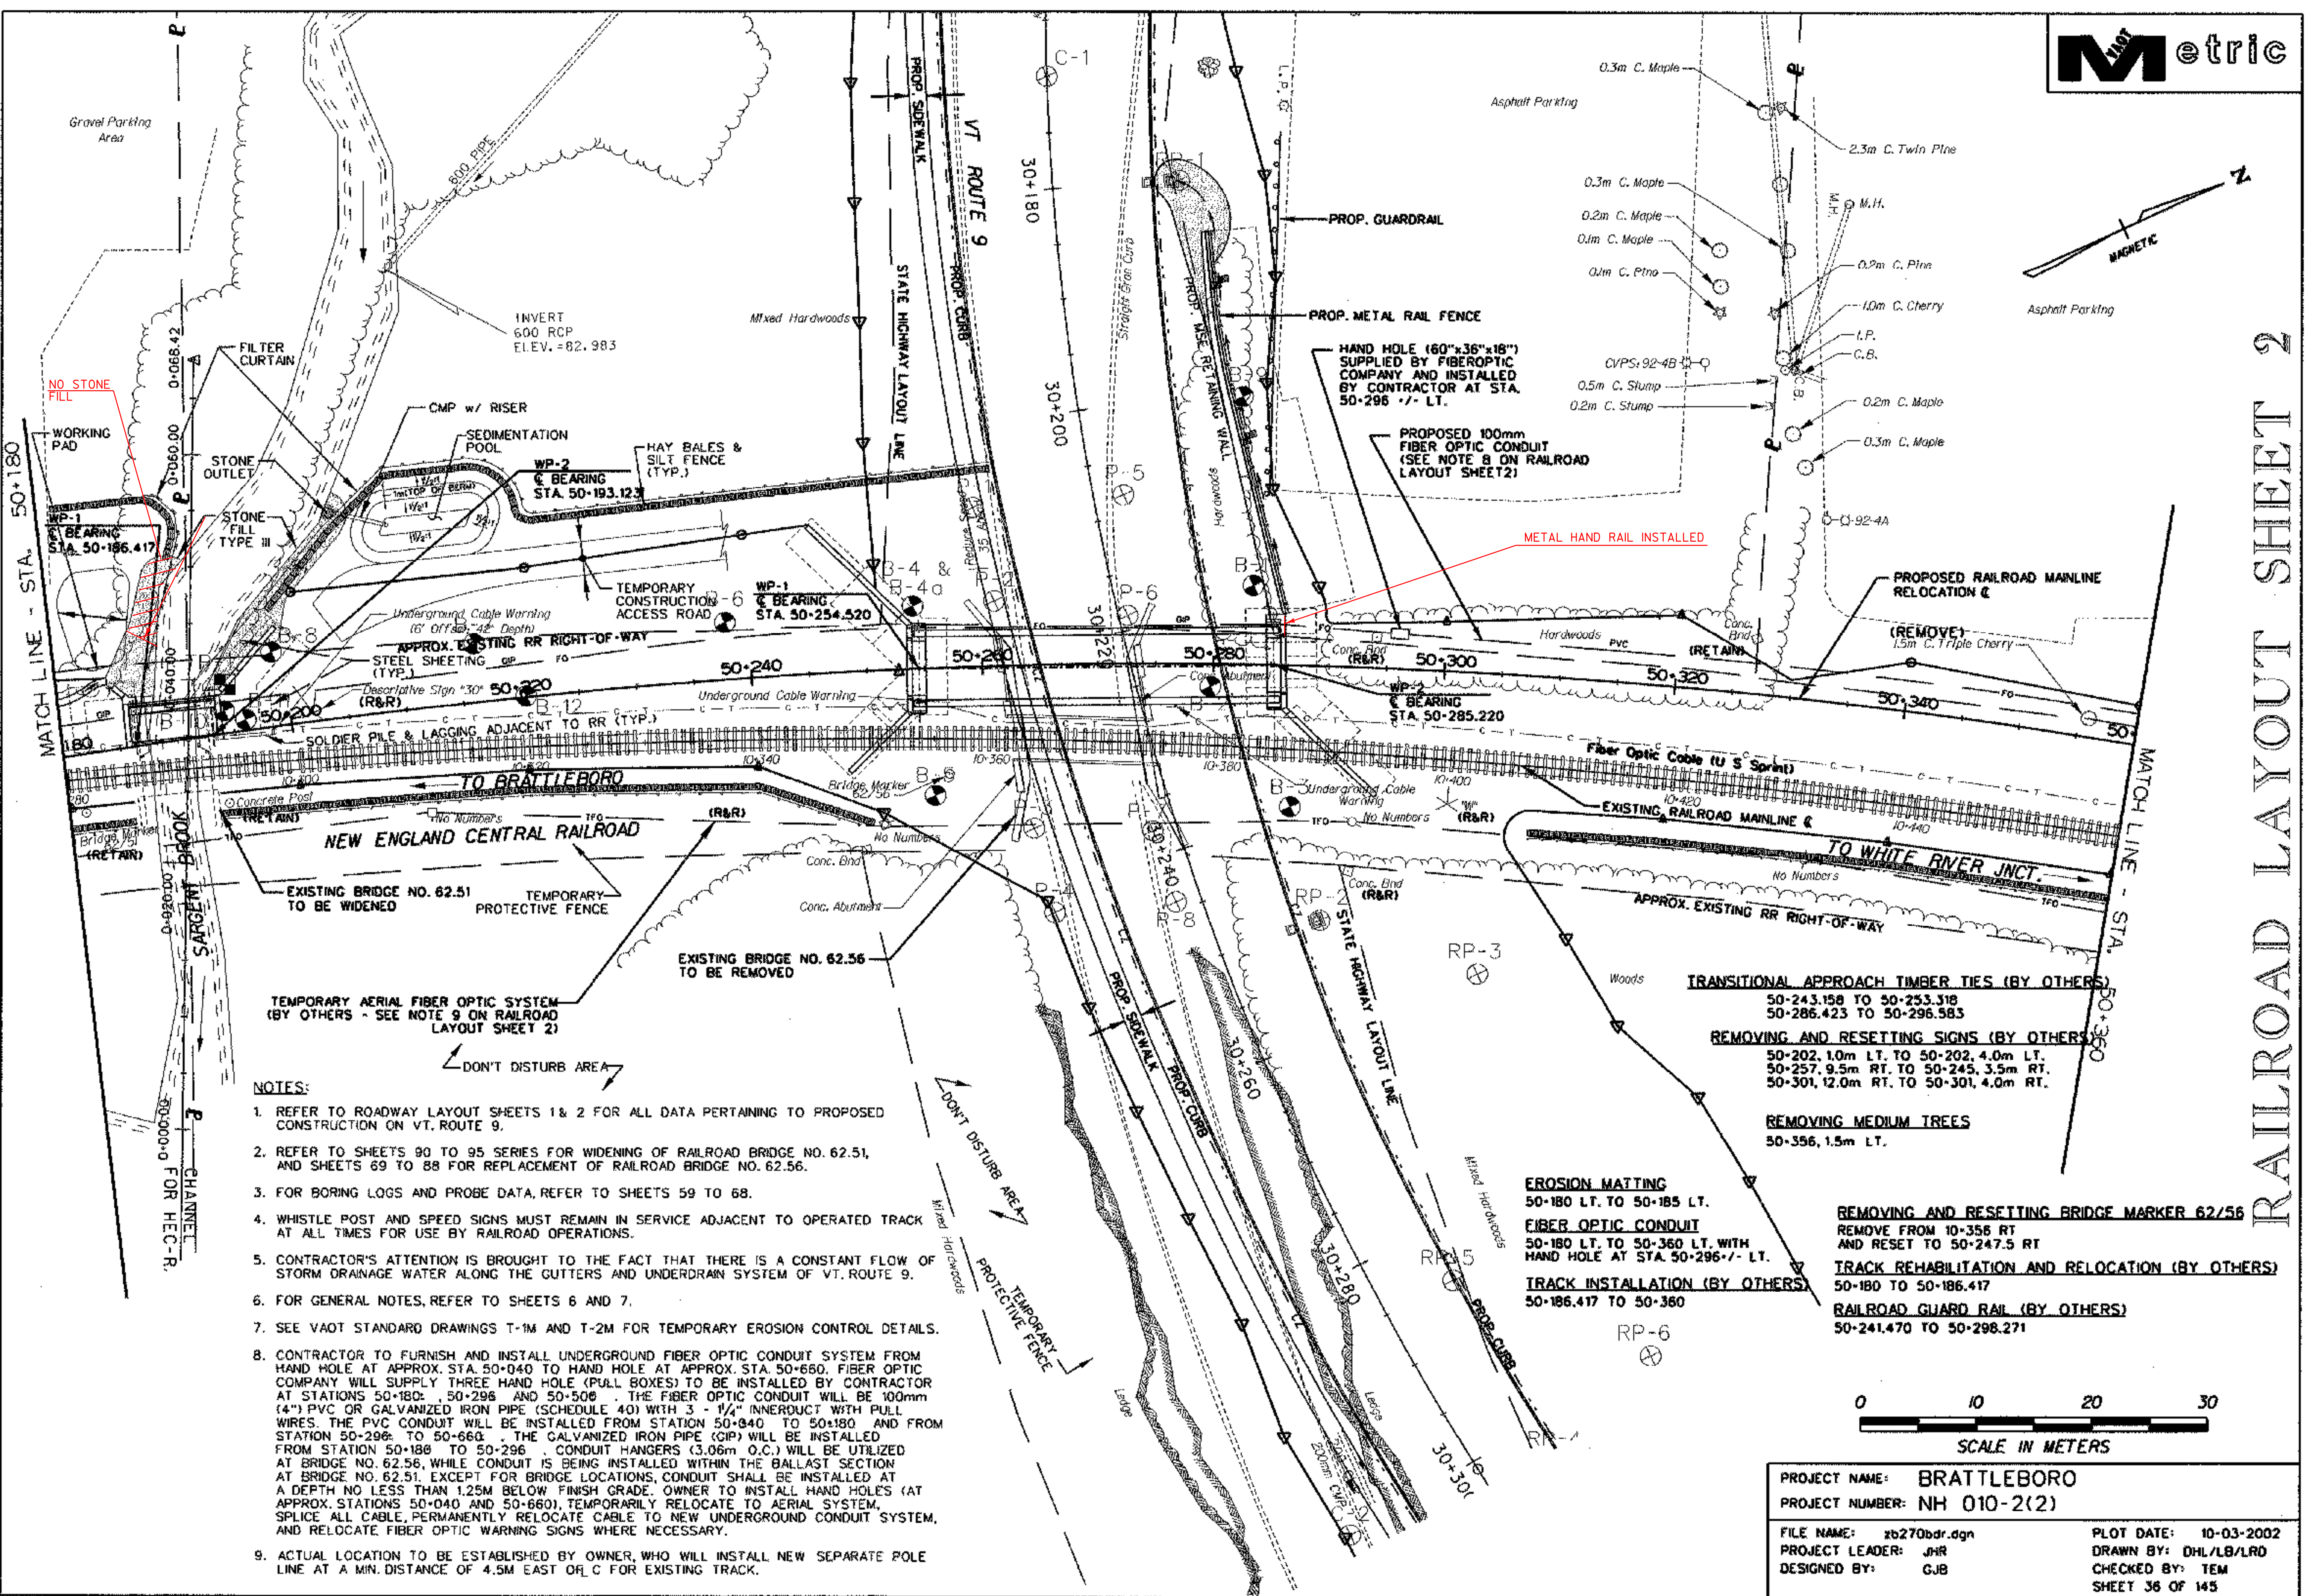

NOTES:

1. REFER TO ROADWAY LAYOUT SHEETS 1 & 2 FOR ALL DATA PERTAINING TO PROPOSED CONSTRUCTION ON VT. ROUTE 9.
2. REFER TO SHEETS 90 TO 95 SERIES FOR WIDENING OF RAILROAD BRIDGE NO. 62.51, AND SHEETS 69 TO 88 FOR REPLACEMENT OF RAILROAD BRIDGE NO. 62.56.
3. FOR BORING LOGS AND PROBE DATA, REFER TO SHEETS 59 TO 68.
4. WHISTLE POST AND SPEED SIGNS MUST REMAIN IN SERVICE ADJACENT TO OPERATED TRACK AT ALL TIMES FOR USE BY RAILROAD OPERATIONS.
5. CONTRACTOR'S ATTENTION IS BROUGHT TO THE FACT THAT THERE IS A CONSTANT FLOW OF STORM DRAINAGE WATER ALONG THE GUTTERS AND UNDERDRAIN SYSTEM OF VT. ROUTE 9.
6. FOR GENERAL NOTES, REFER TO SHEETS 6 AND 7.
7. SEE VAOT STANDARD DRAWINGS T-1M AND T-2M FOR TEMPORARY EROSION CONTROL DETAILS.
8. CONTRACTOR TO FURNISH AND INSTALL UNDERGROUND FIBER OPTIC CONDUIT SYSTEM FROM HAND HOLE AT APPROX. STA. 50+040 TO HAND HOLE AT APPROX. STA. 50+660. FIBER OPTIC COMPANY WILL SUPPLY THREE HAND HOLE (PULL BOXES) TO BE INSTALLED BY CONTRACTOR AT STATIONS 50+180, 50+296 AND 50+500. THE FIBER OPTIC CONDUIT WILL BE 100mm (4") PVC OR GALVANIZED IRON PIPE (SCHEDULE 40) WITH 3 - 1/4" INNERDUCT WITH PULL WIRES. THE PVC CONDUIT WILL BE INSTALLED FROM STATION 50+040 TO 50+180 AND FROM STATION 50+296 TO 50+660. THE GALVANIZED IRON PIPE (GIP) WILL BE INSTALLED FROM STATION 50+180 TO 50+296. CONDUIT HANGERS (3.06m O.C.) WILL BE UTILIZED AT BRIDGE NO. 62.56, WHILE CONDUIT IS BEING INSTALLED WITHIN THE BALLAST SECTION AT BRIDGE NO. 62.51. EXCEPT FOR BRIDGE LOCATIONS, CONDUIT SHALL BE INSTALLED AT A DEPTH NO LESS THAN 1.25M BELOW FINISH GRADE. OWNER TO INSTALL HAND HOLES (AT APPROX. STATIONS 50+040 AND 50+660), TEMPORARILY RELOCATE TO AERIAL SYSTEM. SPLICE ALL CABLE, PERMANENTLY RELOCATE CABLE TO NEW UNDERGROUND CONDUIT SYSTEM, AND RELOCATE FIBER OPTIC WARNING SIGNS WHERE NECESSARY.
9. ACTUAL LOCATION TO BE ESTABLISHED BY OWNER, WHO WILL INSTALL NEW SEPARATE POLE LINE AT A MIN. DISTANCE OF 4.5M EAST OF C FOR EXISTING TRACK.



- TRANSITIONAL APPROACH TIMBER TIES (BY OTHERS)**
50+243.158 TO 50+253.318
50+286.423 TO 50+296.583
- REMOVING AND RESETTING SIGNS (BY OTHERS)**
50+202.10m LT. TO 50+202.40m LT.
50+257.95m RT. TO 50+245.35m RT.
50+301.120m RT. TO 50+301.40m RT.
- REMOVING MEDIUM TREES**
50+356, 1.5m LT.
- REMOVING AND RESETTING BRIDGE MARKER 62/56**
REMOVE FROM 10+355 RT
AND RESET TO 50+247.5 RT
- TRACK REHABILITATION AND RELOCATION (BY OTHERS)**
50+180 TO 50+186.417
- RAILROAD GUARD RAIL (BY OTHERS)**
50+241.470 TO 50+298.271

EROSION MATTING
50+180 LT. TO 50+185 LT.

FIBER OPTIC CONDUIT
50+180 LT. TO 50+360 LT. WITH
HAND HOLE AT STA. 50+296 +/- LT.

TRACK INSTALLATION (BY OTHERS)
50+186.417 TO 50+380

PROJECT NAME: BRATTLEBORO	
PROJECT NUMBER: NH 010-2(2)	
FILE NAME: zb270bdr.dgn	PLOT DATE: 10-03-2002
PROJECT LEADER: JHR	DRAWN BY: DHL/LB/LRO
DESIGNED BY: GJB	CHECKED BY: TEM
SHEET 36 OF 145	

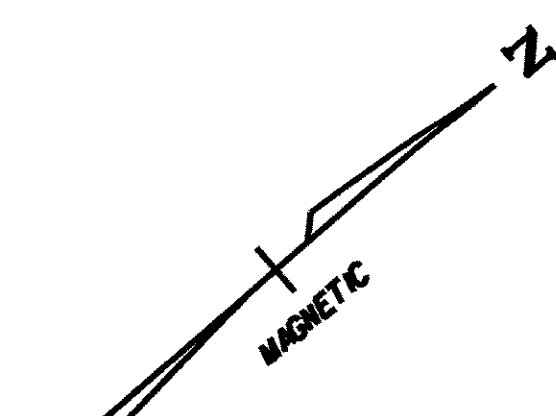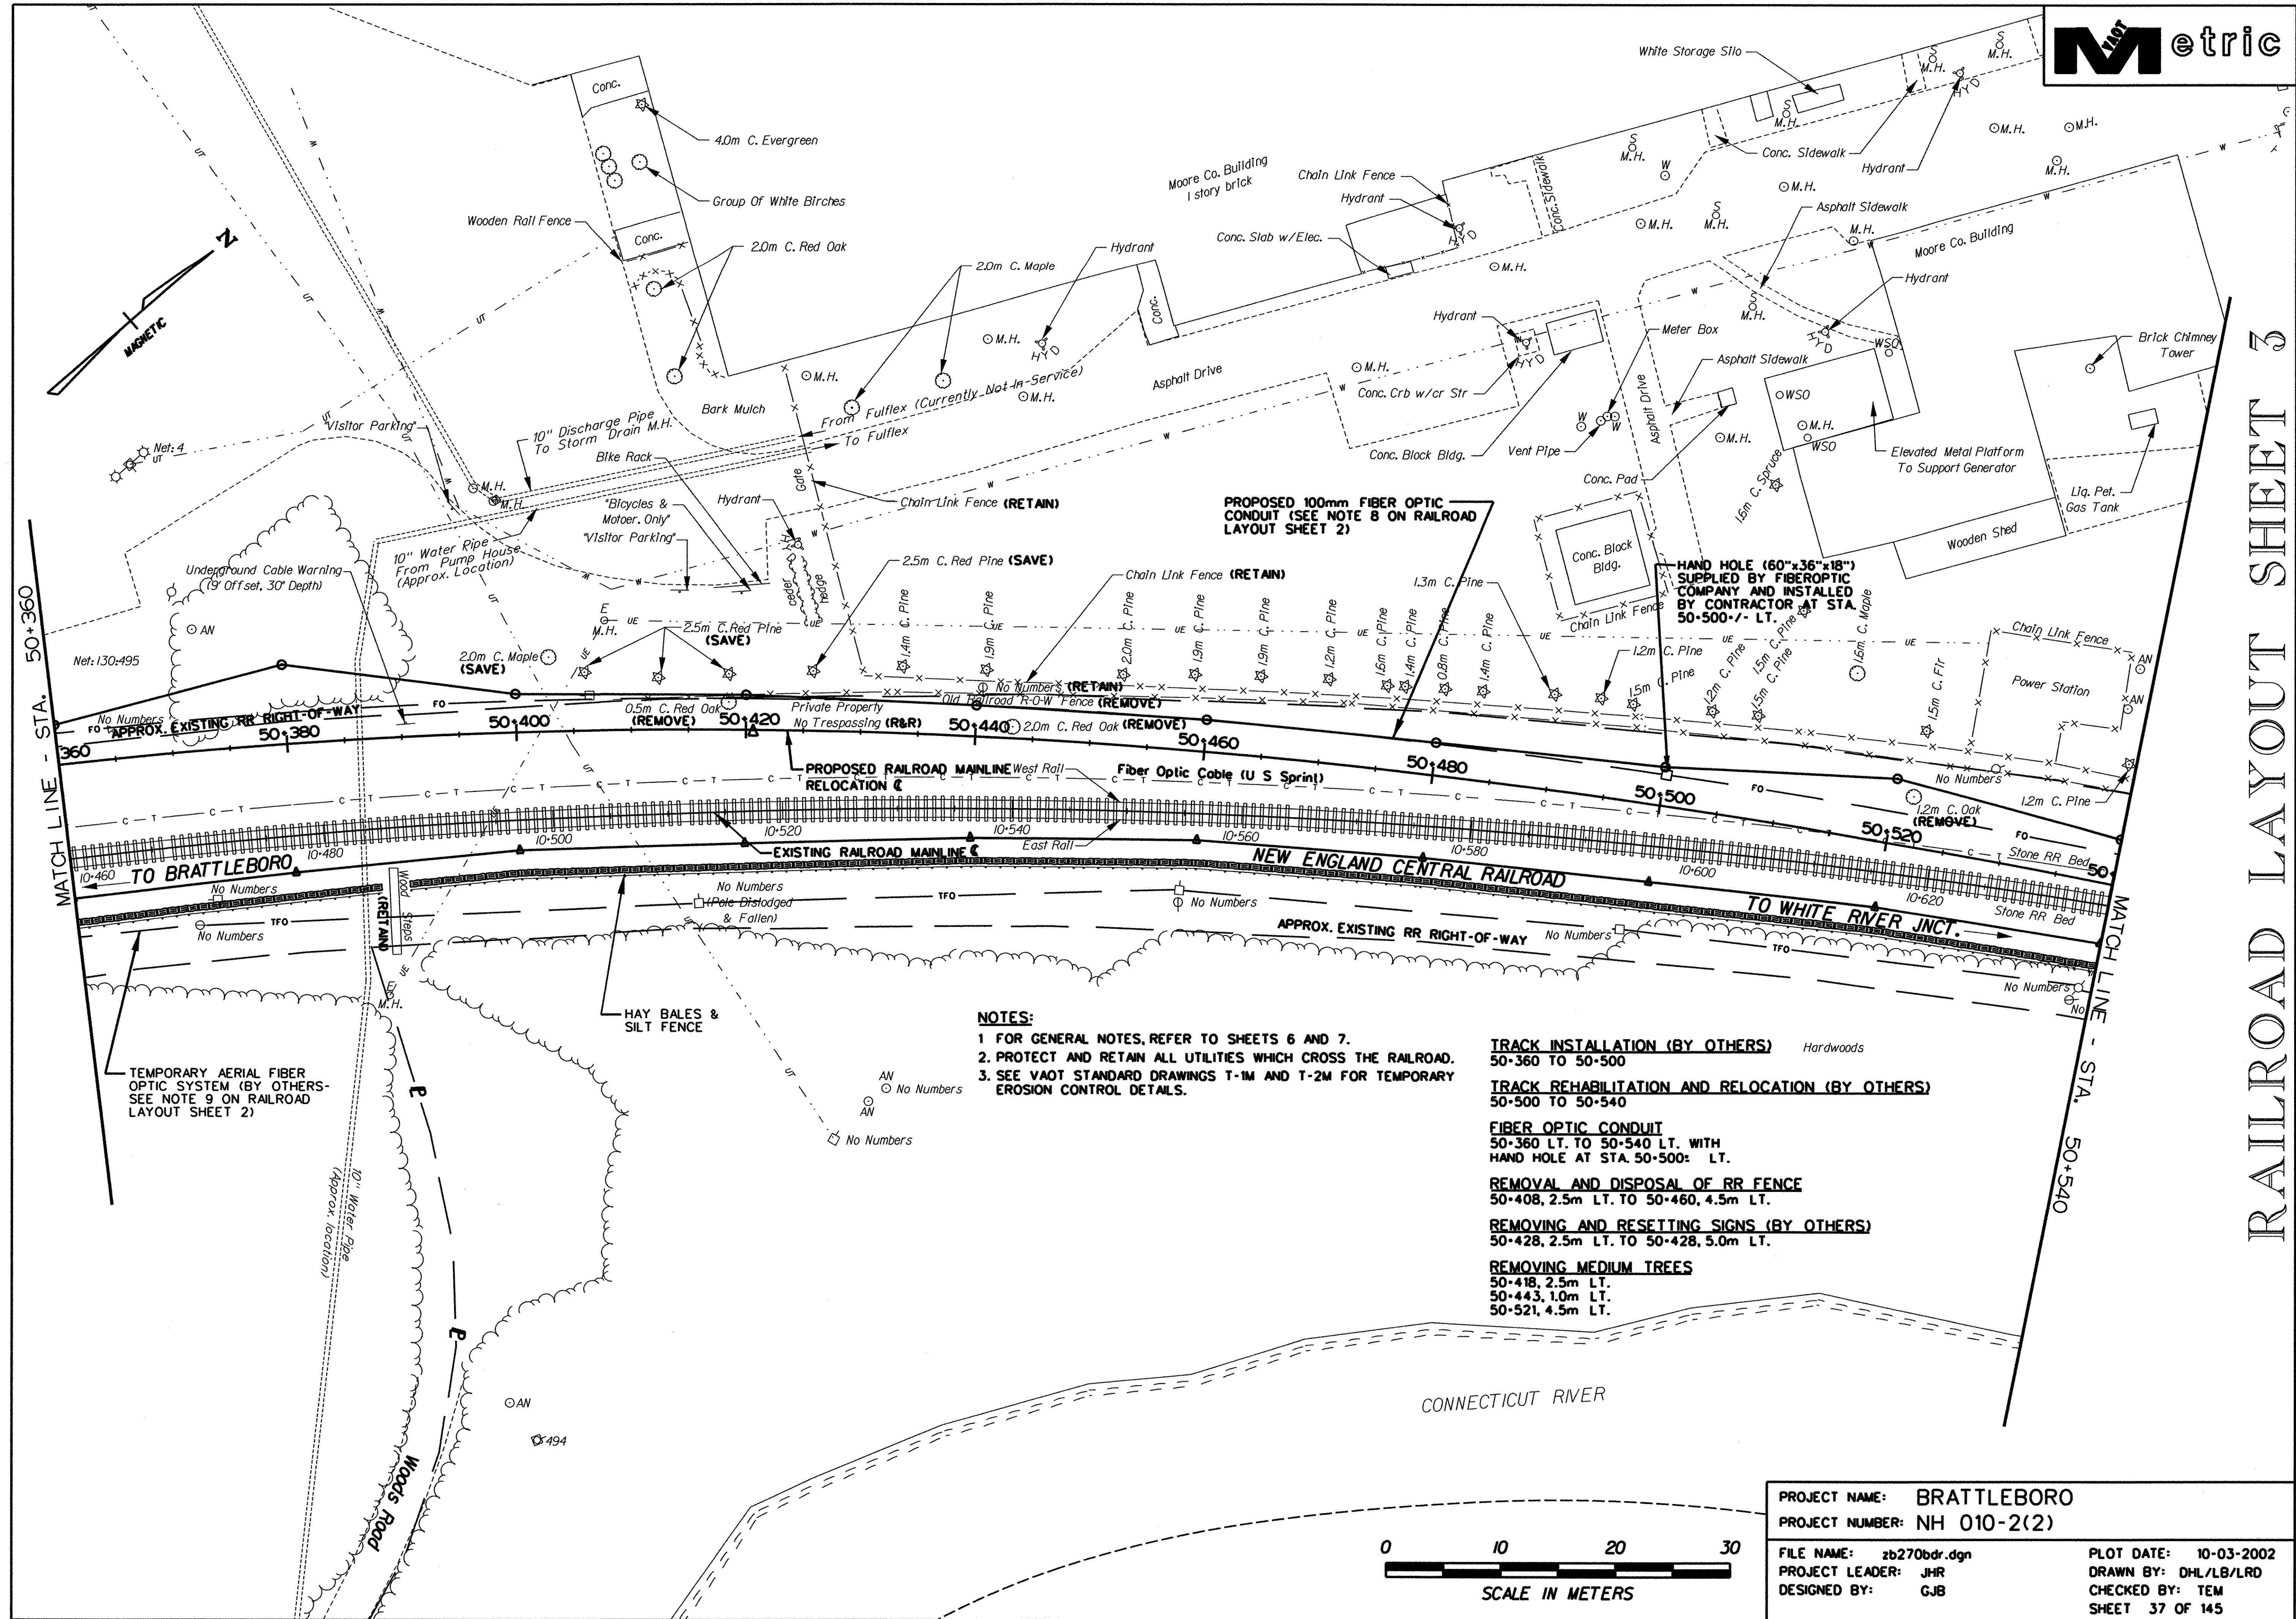

PROPOSED 100mm FIBER OPTIC CONDUIT (SEE NOTE 8 ON RAILROAD LAYOUT SHEET 2)

HAND HOLE (60"x36"x18") SUPPLIED BY FIBEROPTIC COMPANY AND INSTALLED BY CONTRACTOR AT STA. 50+500 +/- LT.


- NOTES:**
1. FOR GENERAL NOTES, REFER TO SHEETS 6 AND 7.
 2. PROTECT AND RETAIN ALL UTILITIES WHICH CROSS THE RAILROAD.
 3. SEE VAOT STANDARD DRAWINGS T-1M AND T-2M FOR TEMPORARY EROSION CONTROL DETAILS.

- TRACK INSTALLATION (BY OTHERS)**
50+360 TO 50+500
- TRACK REHABILITATION AND RELOCATION (BY OTHERS)**
50+500 TO 50+540
- FIBER OPTIC CONDUIT**
50+360 LT. TO 50+540 LT. WITH HAND HOLE AT STA. 50+500: LT.
- REMOVAL AND DISPOSAL OF RR FENCE**
50+408, 2.5m LT. TO 50+460, 4.5m LT.
- REMOVING AND RESETTING SIGNS (BY OTHERS)**
50+428, 2.5m LT. TO 50+428, 5.0m LT.
- REMOVING MEDIUM TREES**
50+418, 2.5m LT.
50+443, 1.0m LT.
50+521, 4.5m LT.

TEMPORARY AERIAL FIBER OPTIC SYSTEM (BY OTHERS - SEE NOTE 9 ON RAILROAD LAYOUT SHEET 2)



PROJECT NAME:	BRATTLEBORO	PLOT DATE:	10-03-2002
PROJECT NUMBER:	NH 010-2(2)	DRAWN BY:	DHL/LB/LRD
FILE NAME:	zb270bdr.dgn	CHECKED BY:	TEM
PROJECT LEADER:	JHR	SHEET	37 OF 145
DESIGNED BY:	GJB		

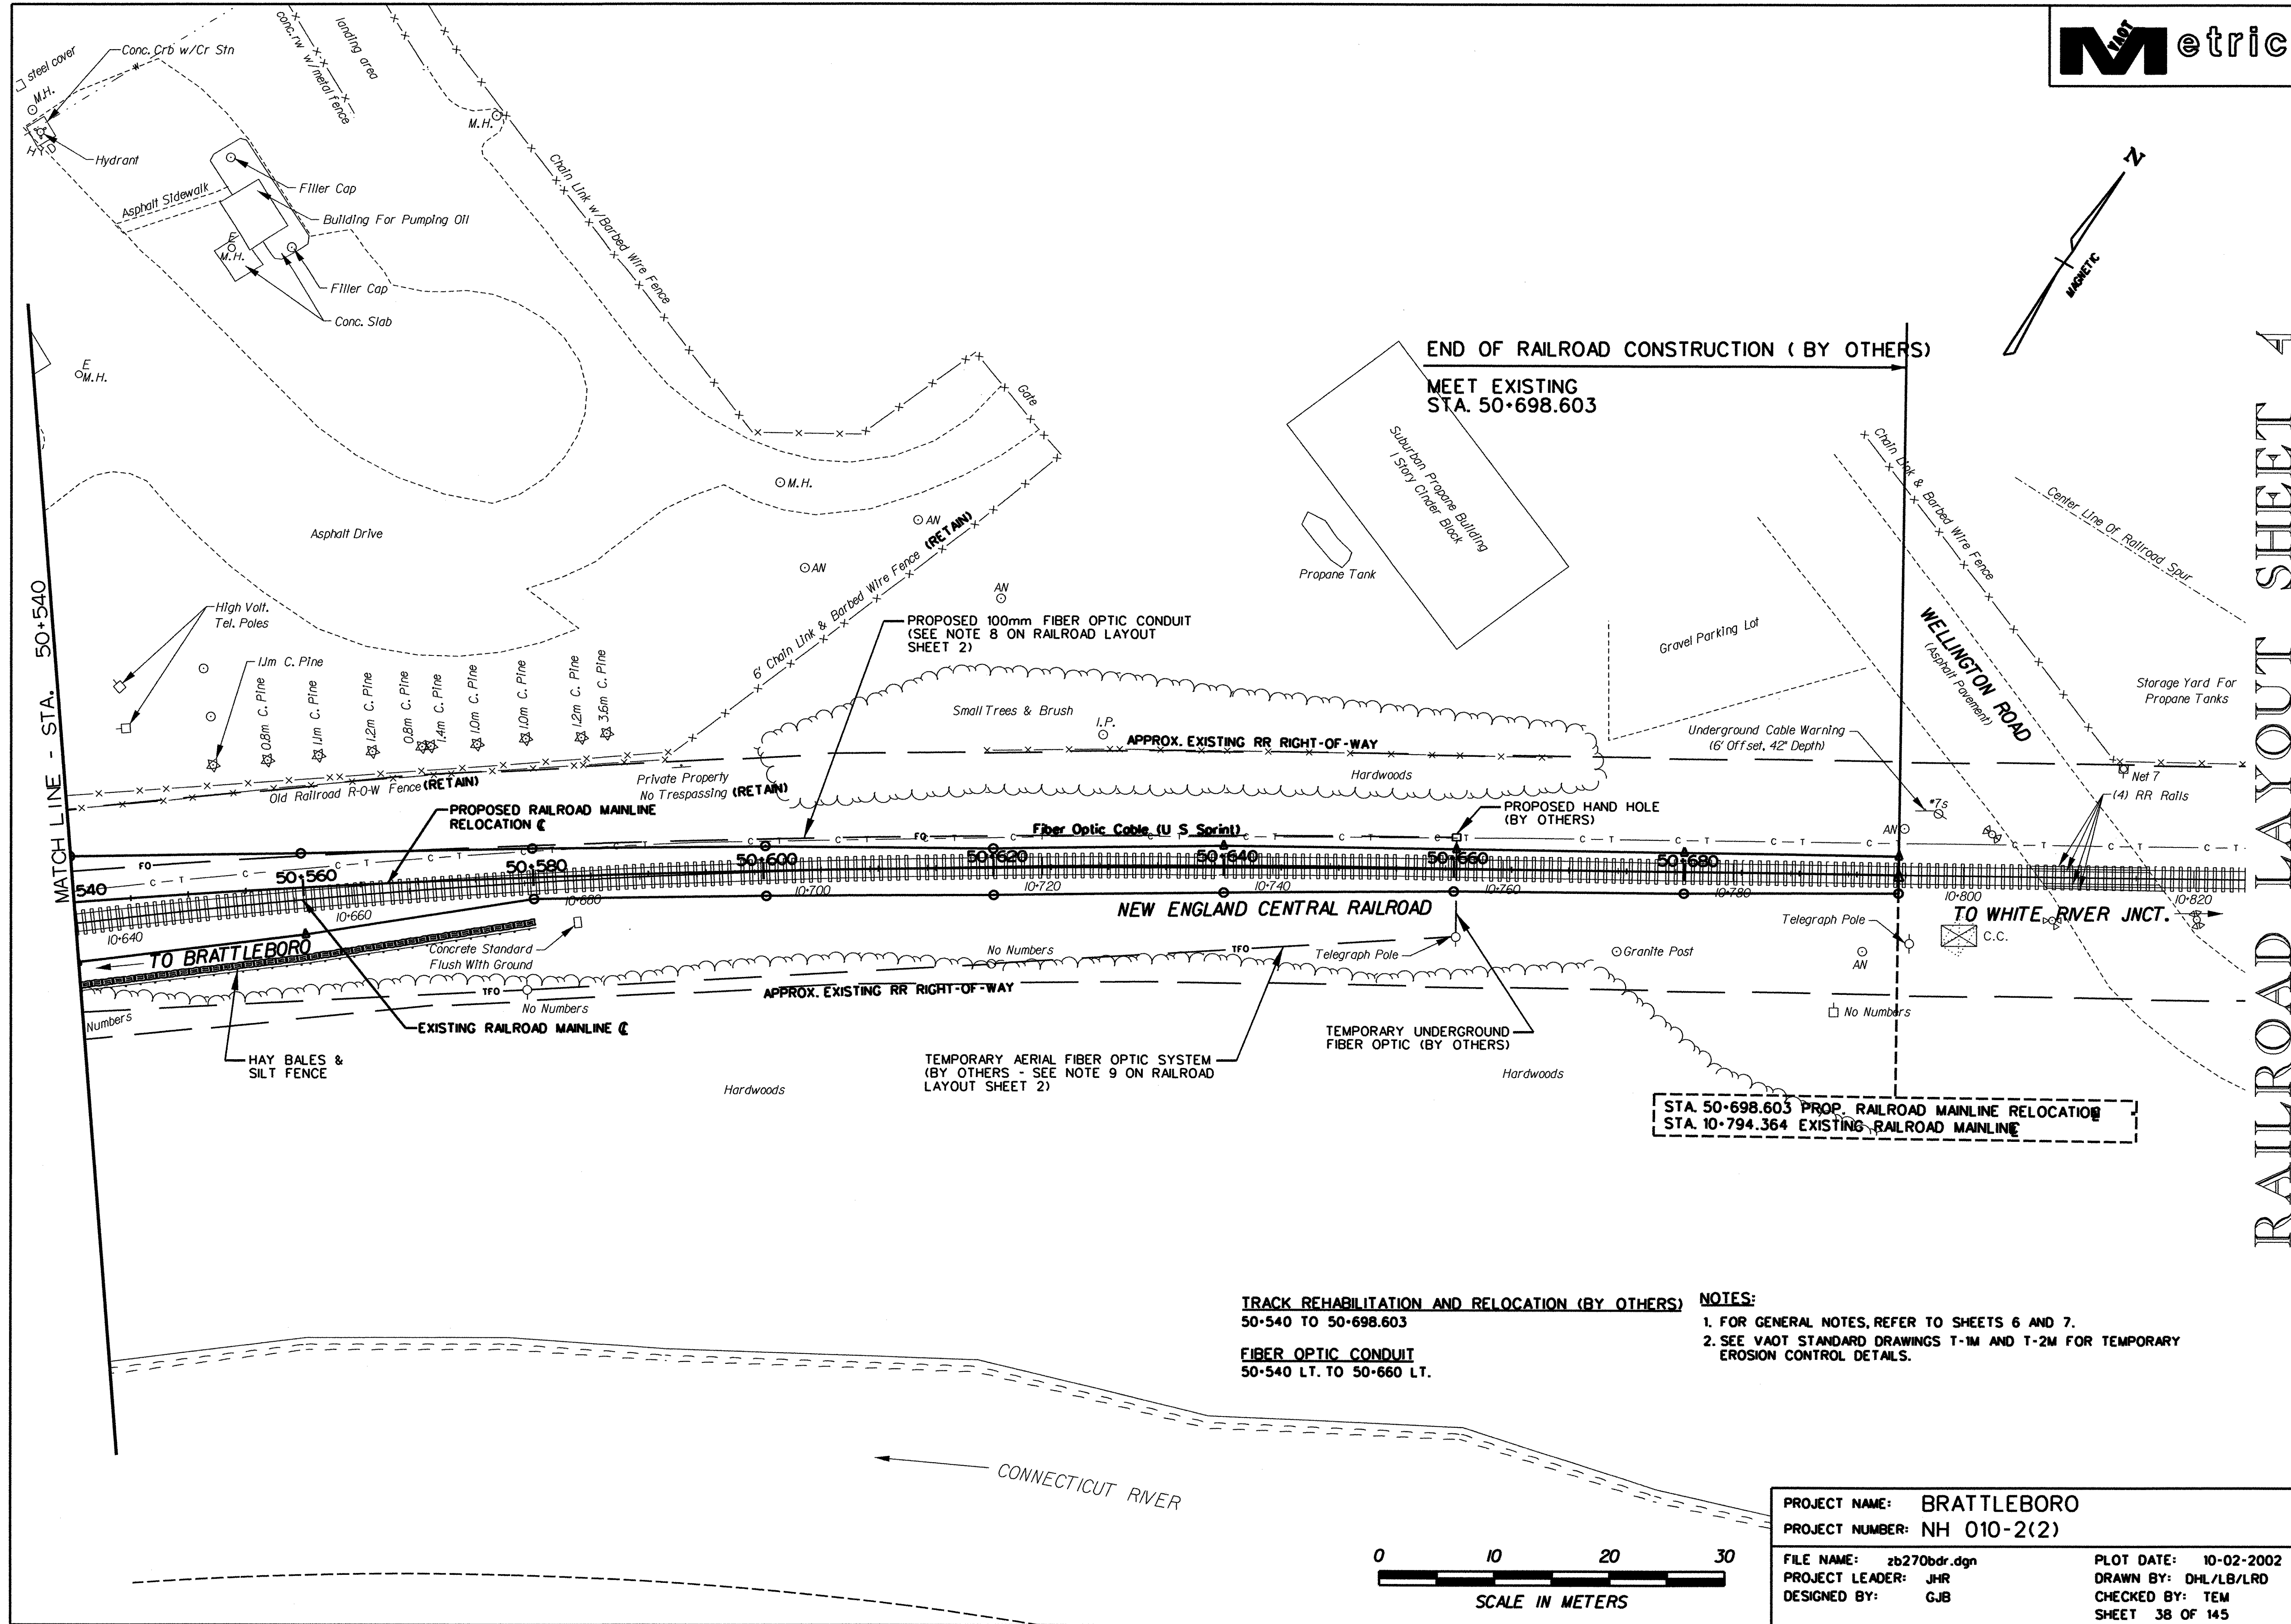

END OF RAILROAD CONSTRUCTION (BY OTHERS)
MEET EXISTING
STA. 50+698.603

STA. 50+698.603 PROP. RAILROAD MAINLINE RELOCATION
STA. 10+794.364 EXISTING RAILROAD MAINLINE

TRACK REHABILITATION AND RELOCATION (BY OTHERS)
50+540 TO 50+698.603



FIBER OPTIC CONDUIT
50+540 LT. TO 50+660 LT.

- NOTES:**
1. FOR GENERAL NOTES, REFER TO SHEETS 6 AND 7.
 2. SEE VAOT STANDARD DRAWINGS T-1M AND T-2M FOR TEMPORARY EROSION CONTROL DETAILS.



PROJECT NAME:	BRATTLEBORO	PLOT DATE:	10-02-2002
PROJECT NUMBER:	NH 010-2(2)	DRAWN BY:	DHL/LB/LRD
FILE NAME:	zb270bdr.dgn	CHECKED BY:	TEM
PROJECT LEADER:	JHR	SHEET	38 OF 145
DESIGNED BY:	GJB		

PROFILE - VT ROUTE 9

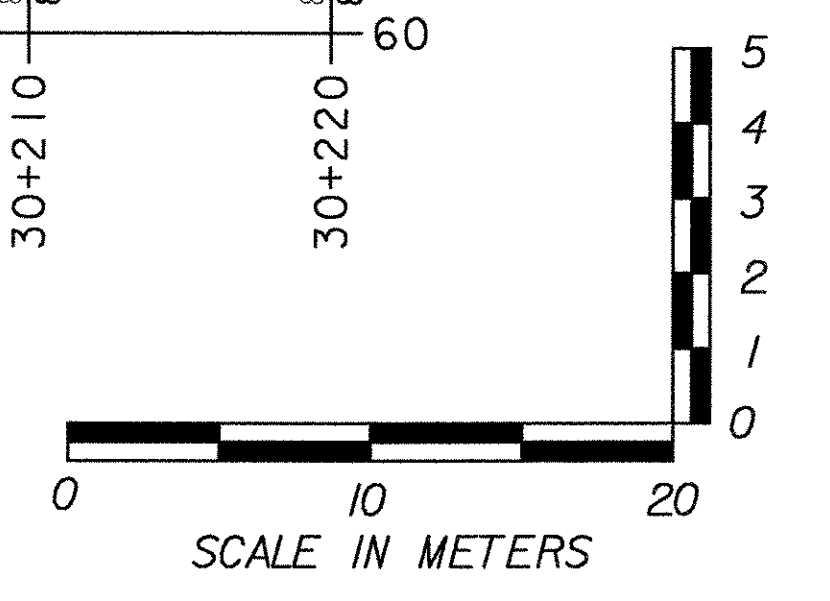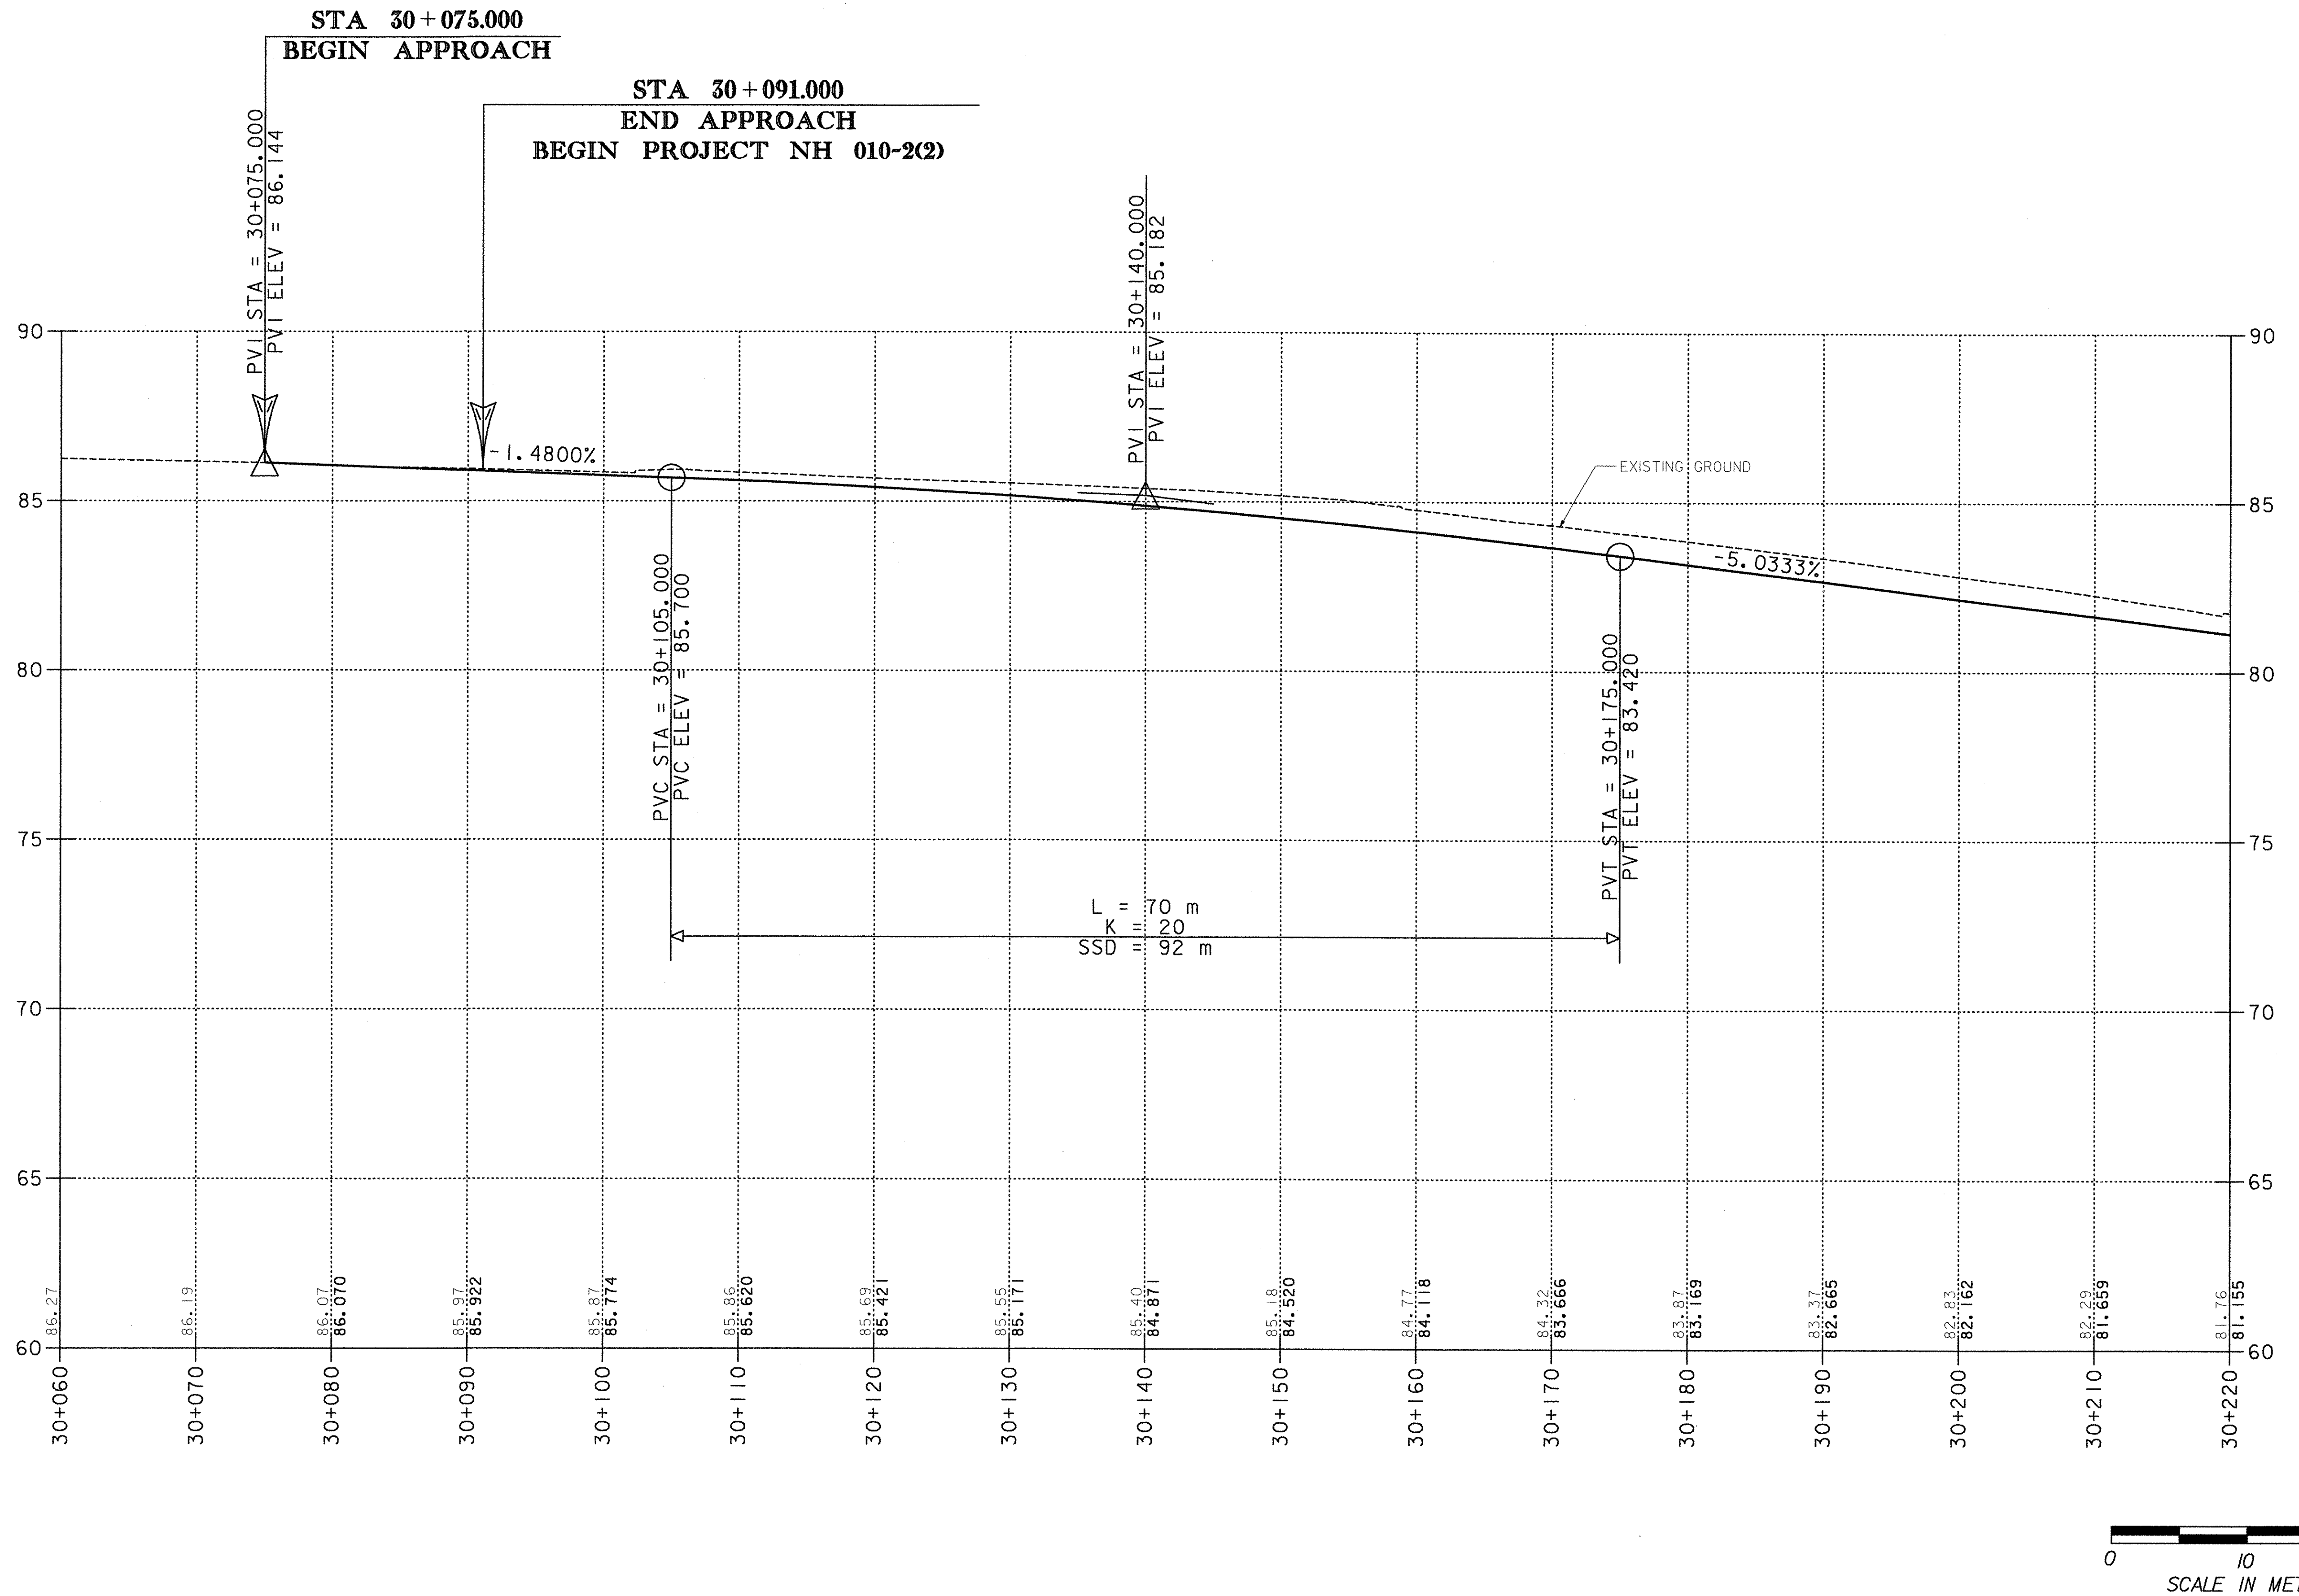

DATUM
 VERTICAL NGVD 1929
 HORIZONTAL NAD 1983

PROJECT: BRATTLEBORO	PROJECT NO. : NH 010-2(2)
DESIGN FILE NAME: ... \zb270xs2.dgn	PLOT DATE: 09/20/2002
IPARM FILE NAME:	SURVEY DATE:
SURVEYED BY:	DRAWN BY: P SHEDD
SQUAD LEADER: W HUSBAND	SHEET: 39 OF 145
CLD REF NO. 00-0358	

PROFILE - VT ROUTE 9





STA A203+50.000
 END PROJECT
 NH 010-2(2)
 BEGIN NH PROJECT 11999

STA 30+341.862 =
 STA A203+40.000

STA 30+222.922 (VT RTE 9) =
 STA 50+272.791 (RAILROAD)




L = 100 m
 K = 17

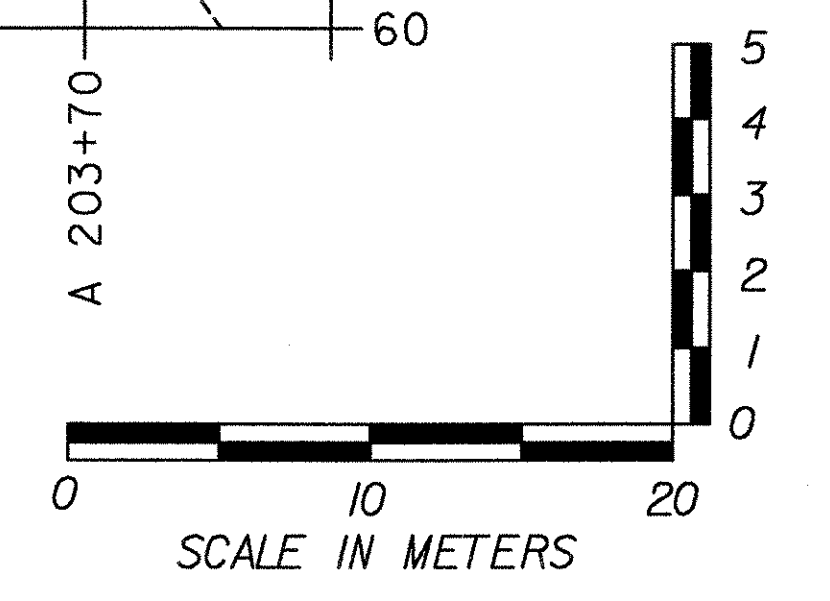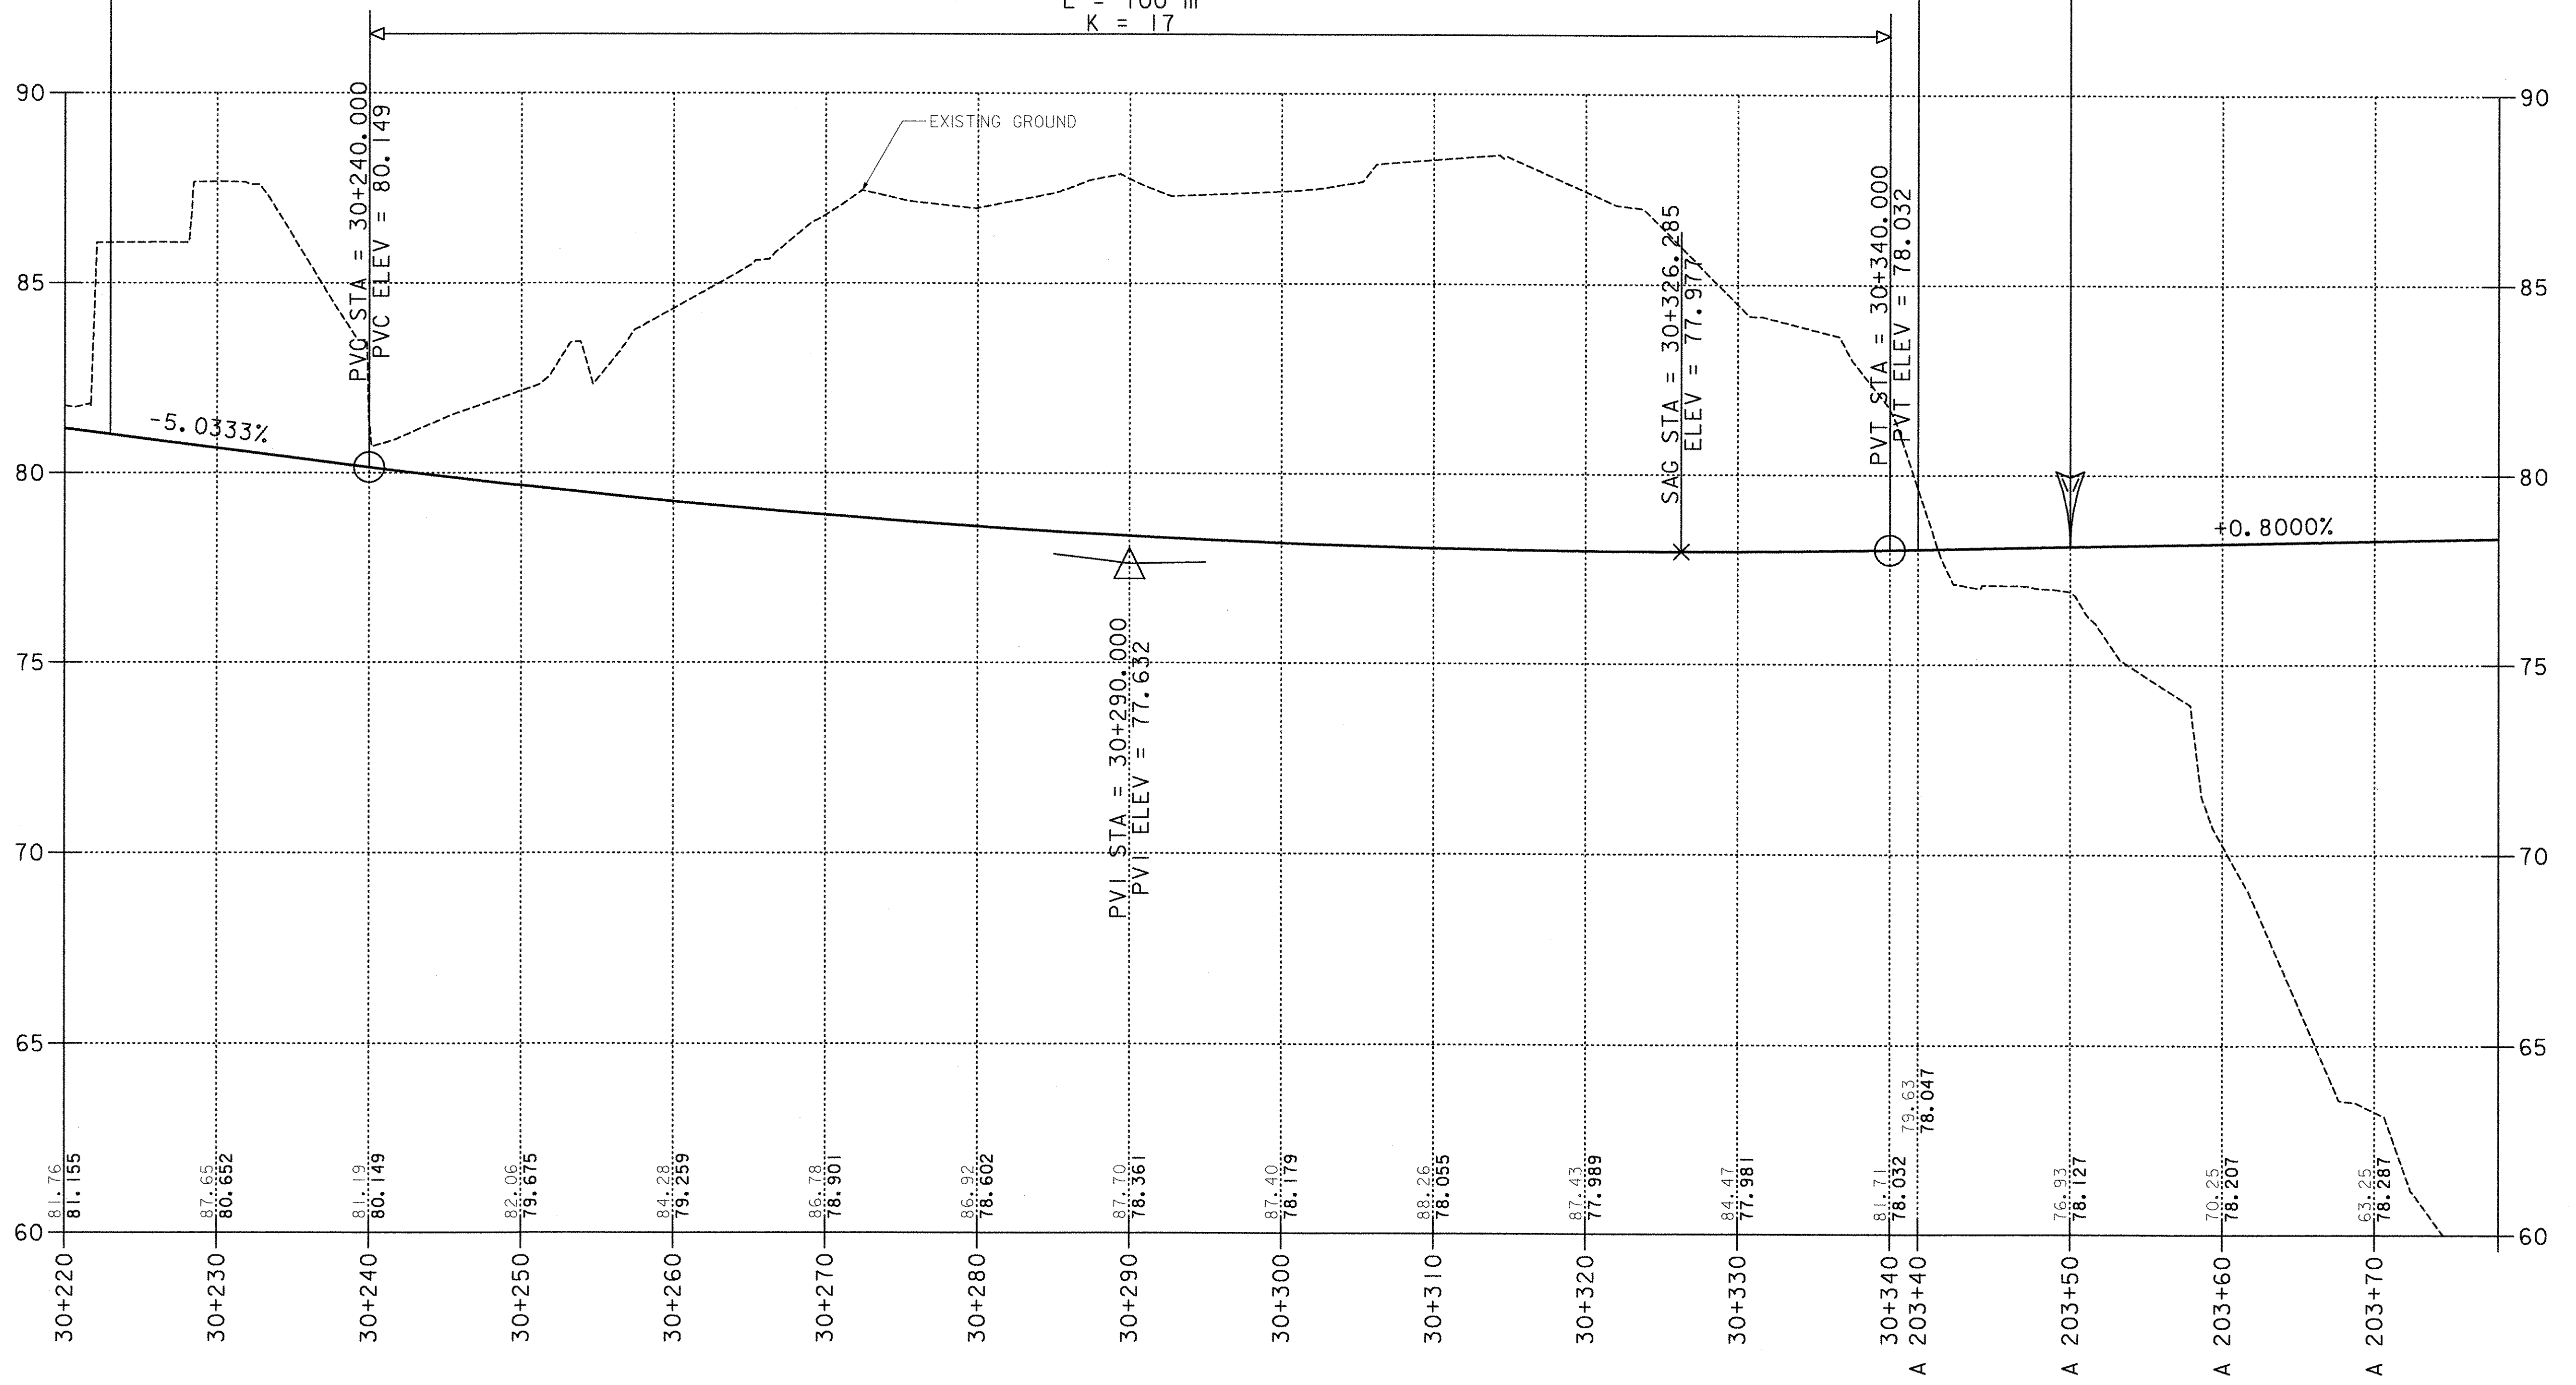

DATUM
 VERTICAL NGVD 1929
 HORIZONTAL NAD 1983

PROJECT: BRATTLEBORO	PROJECT NO. : NH 010-2(2)
DESIGN FILE NAME: ...zb270xs2.dgn	PLOT DATE: 09/20/2002
IPARM FILE NAME:	SURVEY DATE:
SURVEYED BY:	DRAWN BY: P SHEDD
SQUAD LEADER: W HUSBAND	SHEET: 40 OF 145
CLD REF NO. 00-0358	



PROFILE - DRIVEWAY

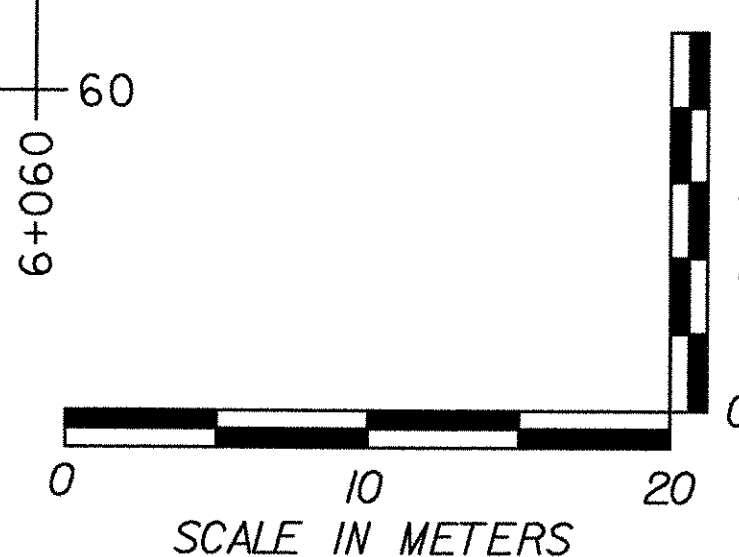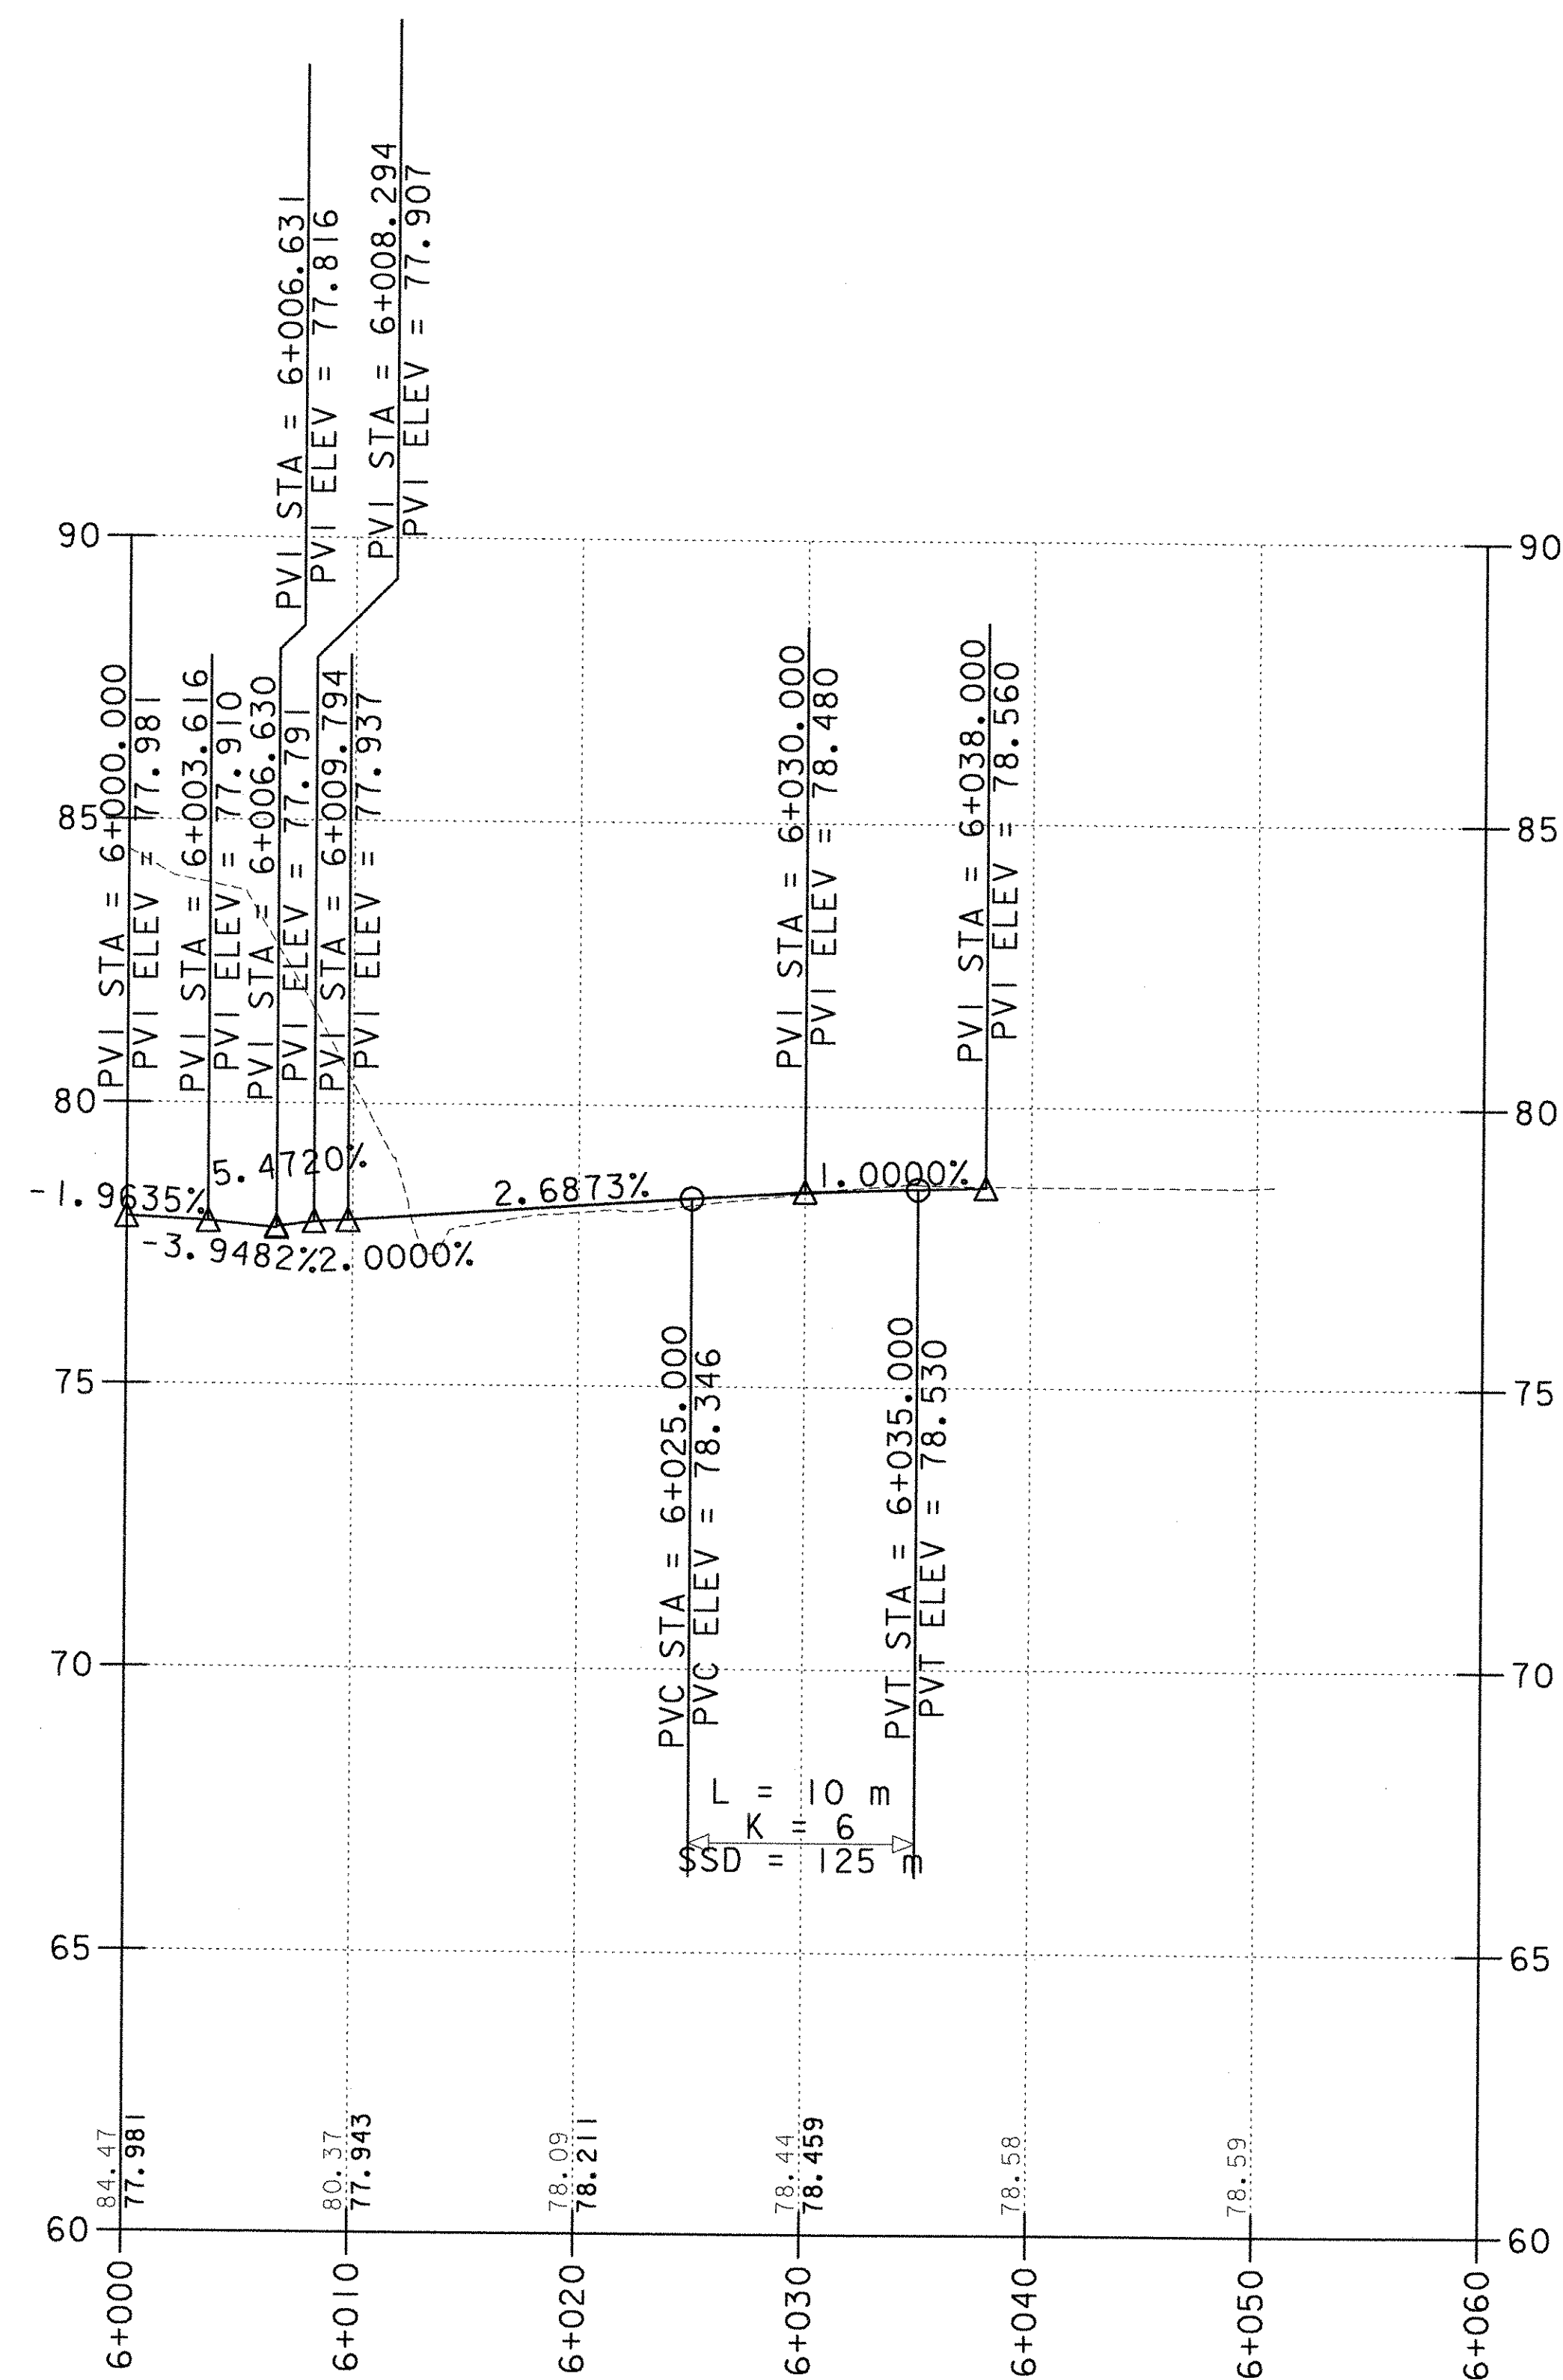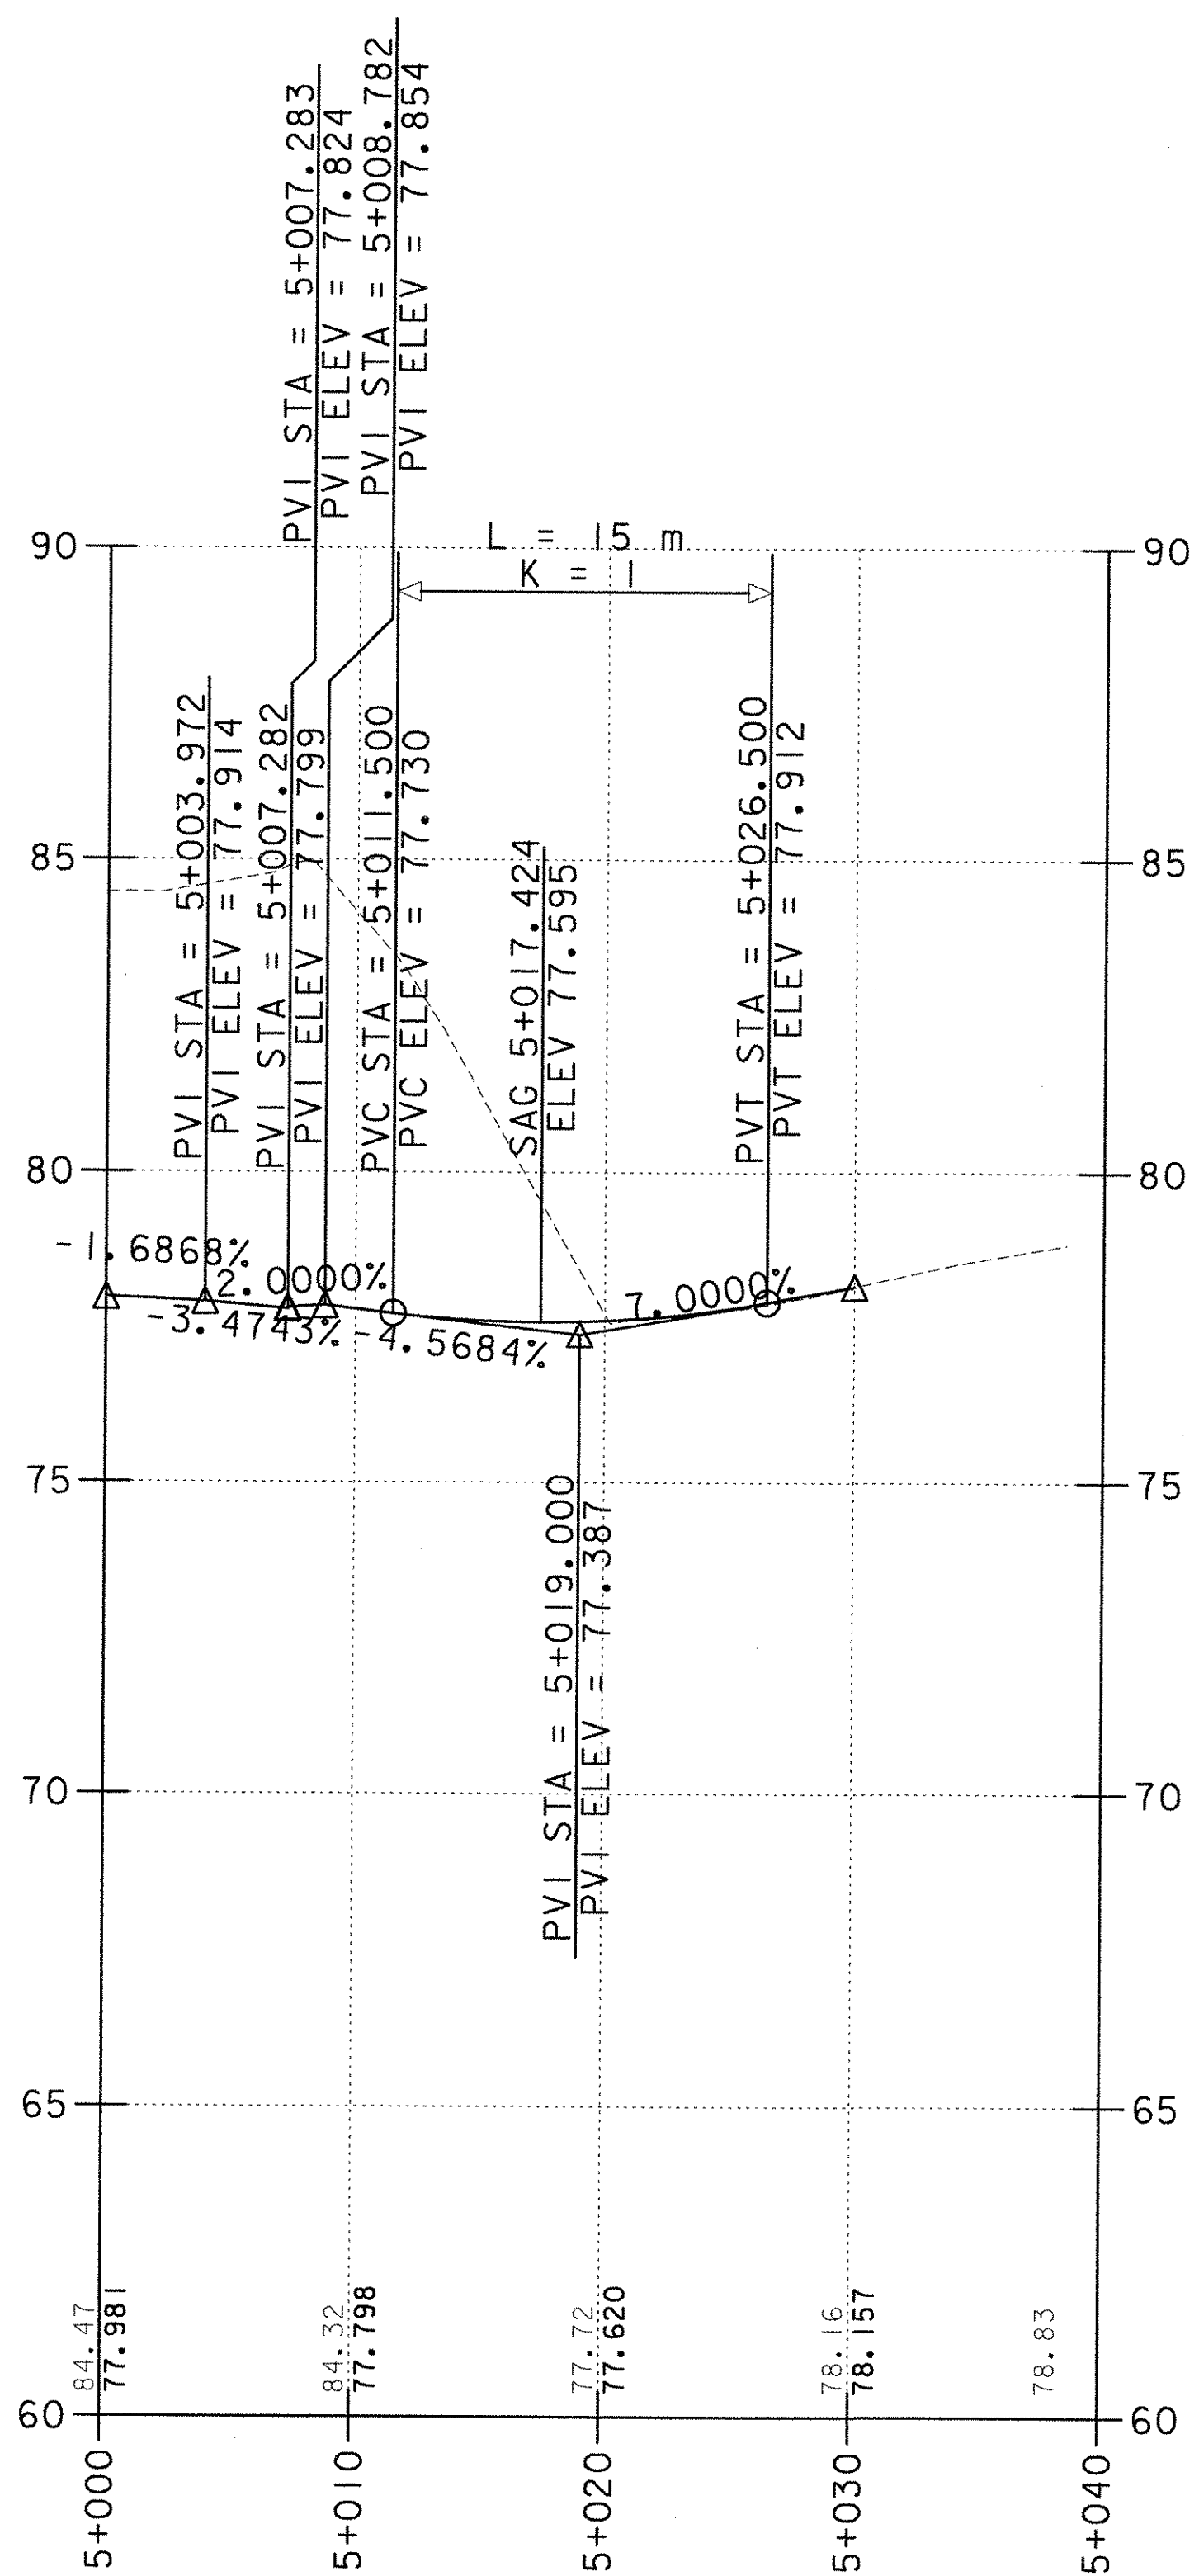



DATUM	
VERTICAL	NGVD 1929
HORIZONTAL	NAD 1983

PROJECT: BRATTLEBORO	PROJECT NO.: NH 010-2(2)
DESIGN FILE NAME: ...\\zb270xs2.dgn	PLOT DATE: 09/20/2002
IPARM FILE NAME:	SURVEY DATE:
SURVEYED BY:	DRAWN BY: P SHEDD
SQUAD LEADER: W HUSBAND	SHEET: 41 OF 145
CLD REF NO. 00-0358	

BANKING DIAGRAM

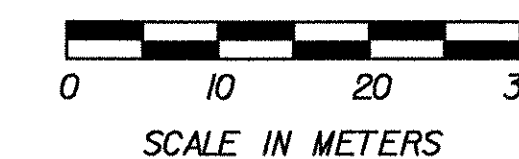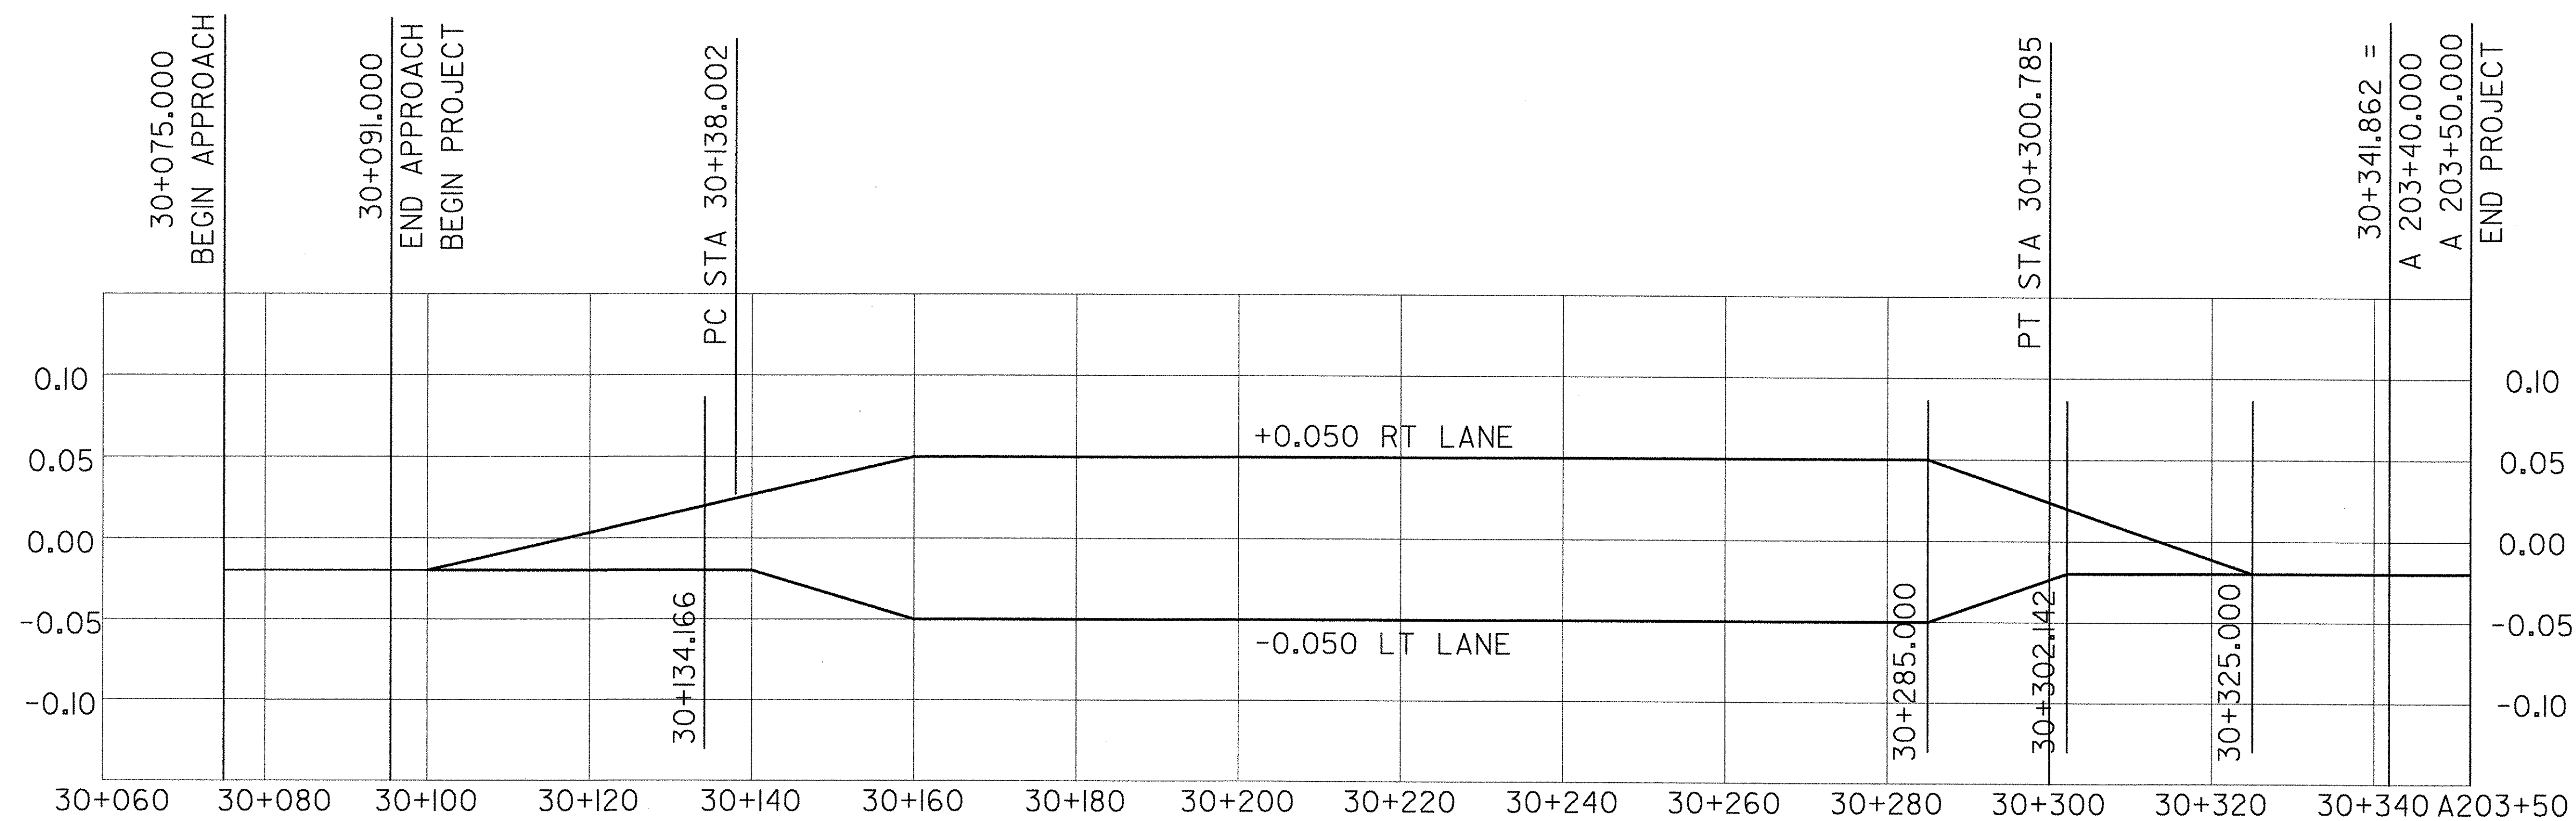


MATERIAL TRANSITION DETAIL

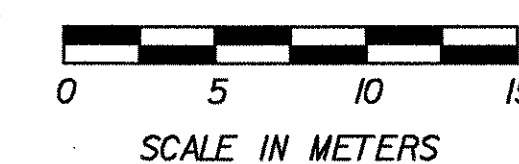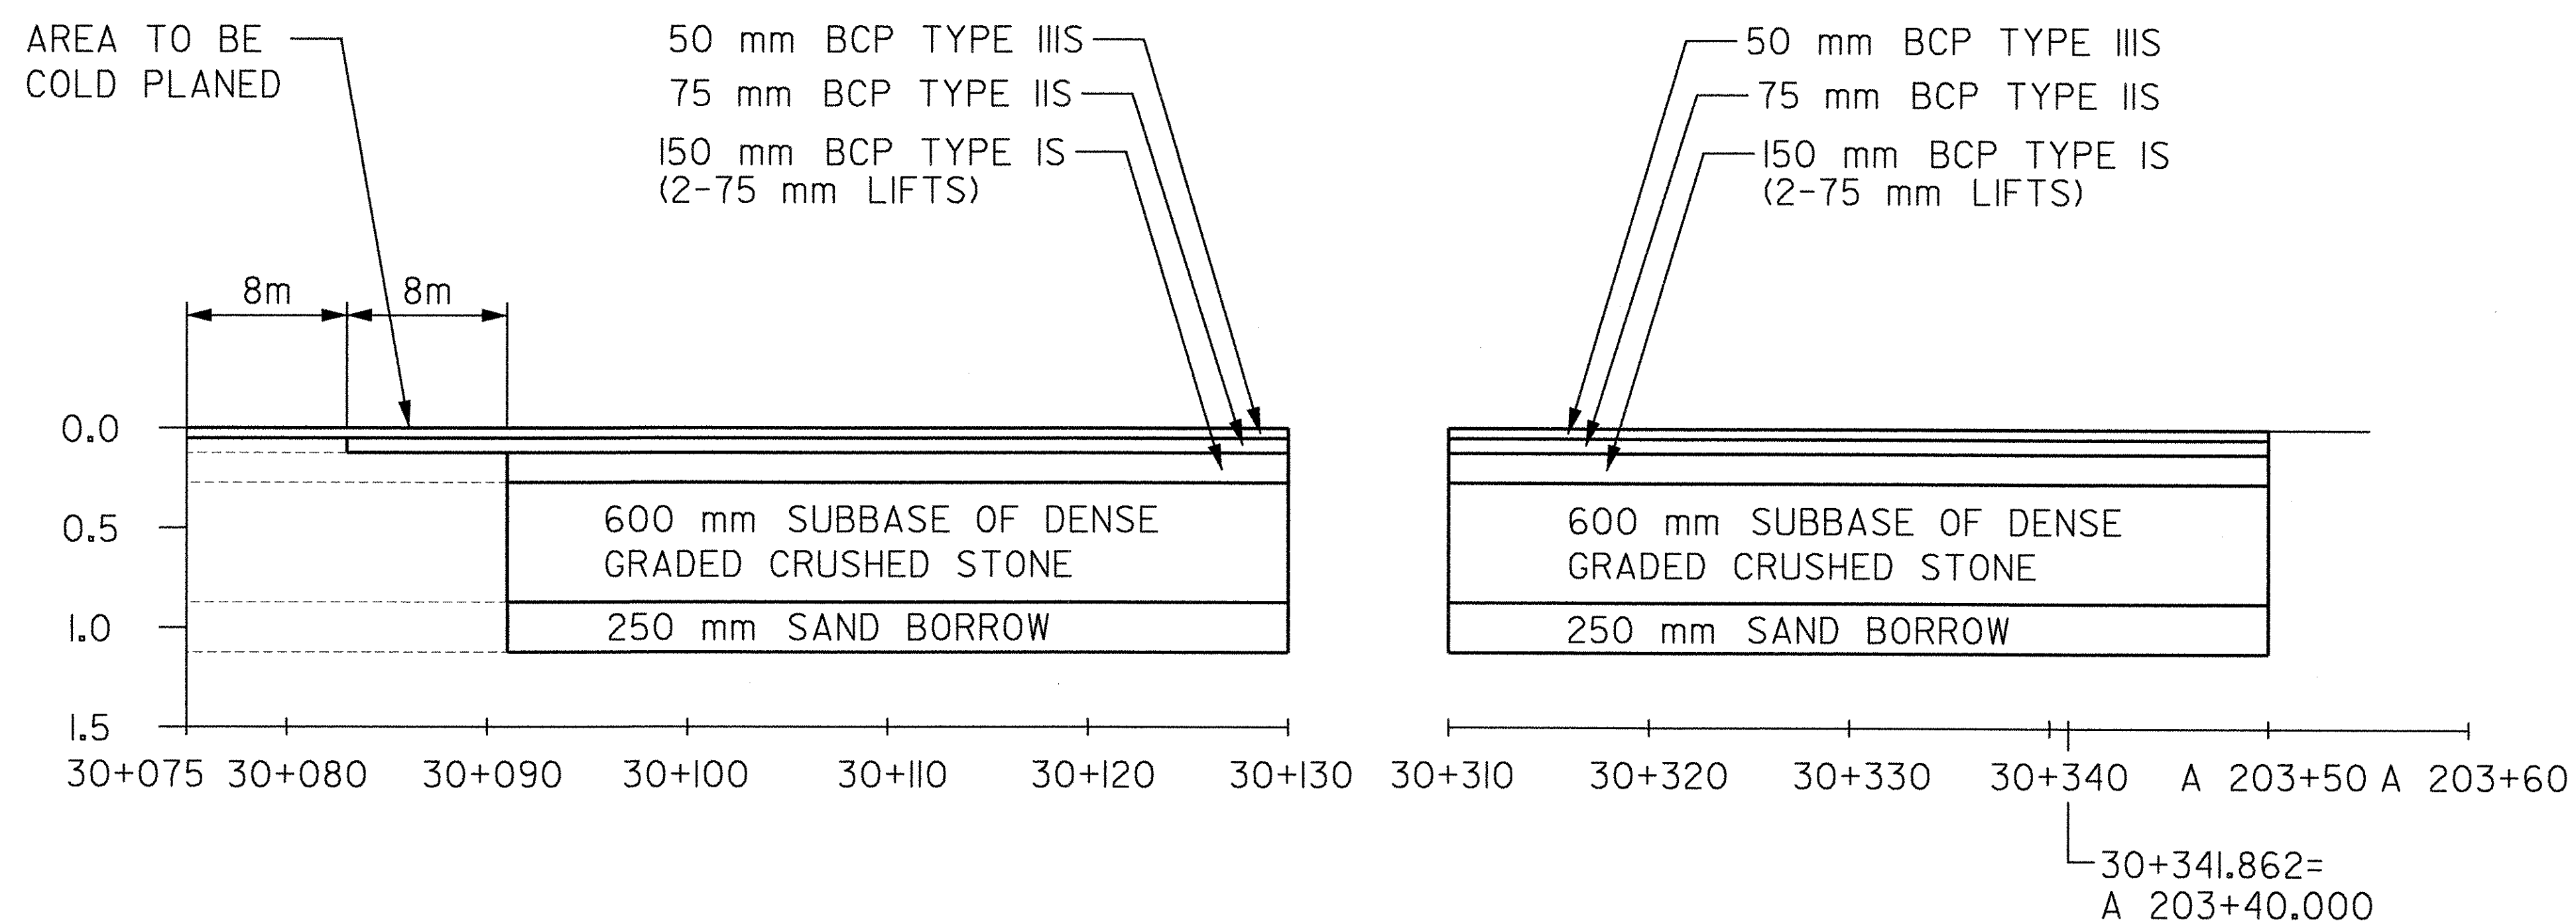


DATUM
 VERTICAL NGVD 1929
 HORIZONTAL NAD 1983

PROJECT: BRATTLEBORO	PROJECT NO.: NH 010-2(2)
DESIGN FILE NAME: ...zb270xs2.dgn	PLOT DATE: 09/20/2002
IPARM FILE NAME:	SURVEY DATE:
SQUAD LEADER: W HUSBAND	DRAWN BY: N LEMAY
CLD REF NO. 00-0358	SHEET: 42 OF 145

RAILROAD PROFILE

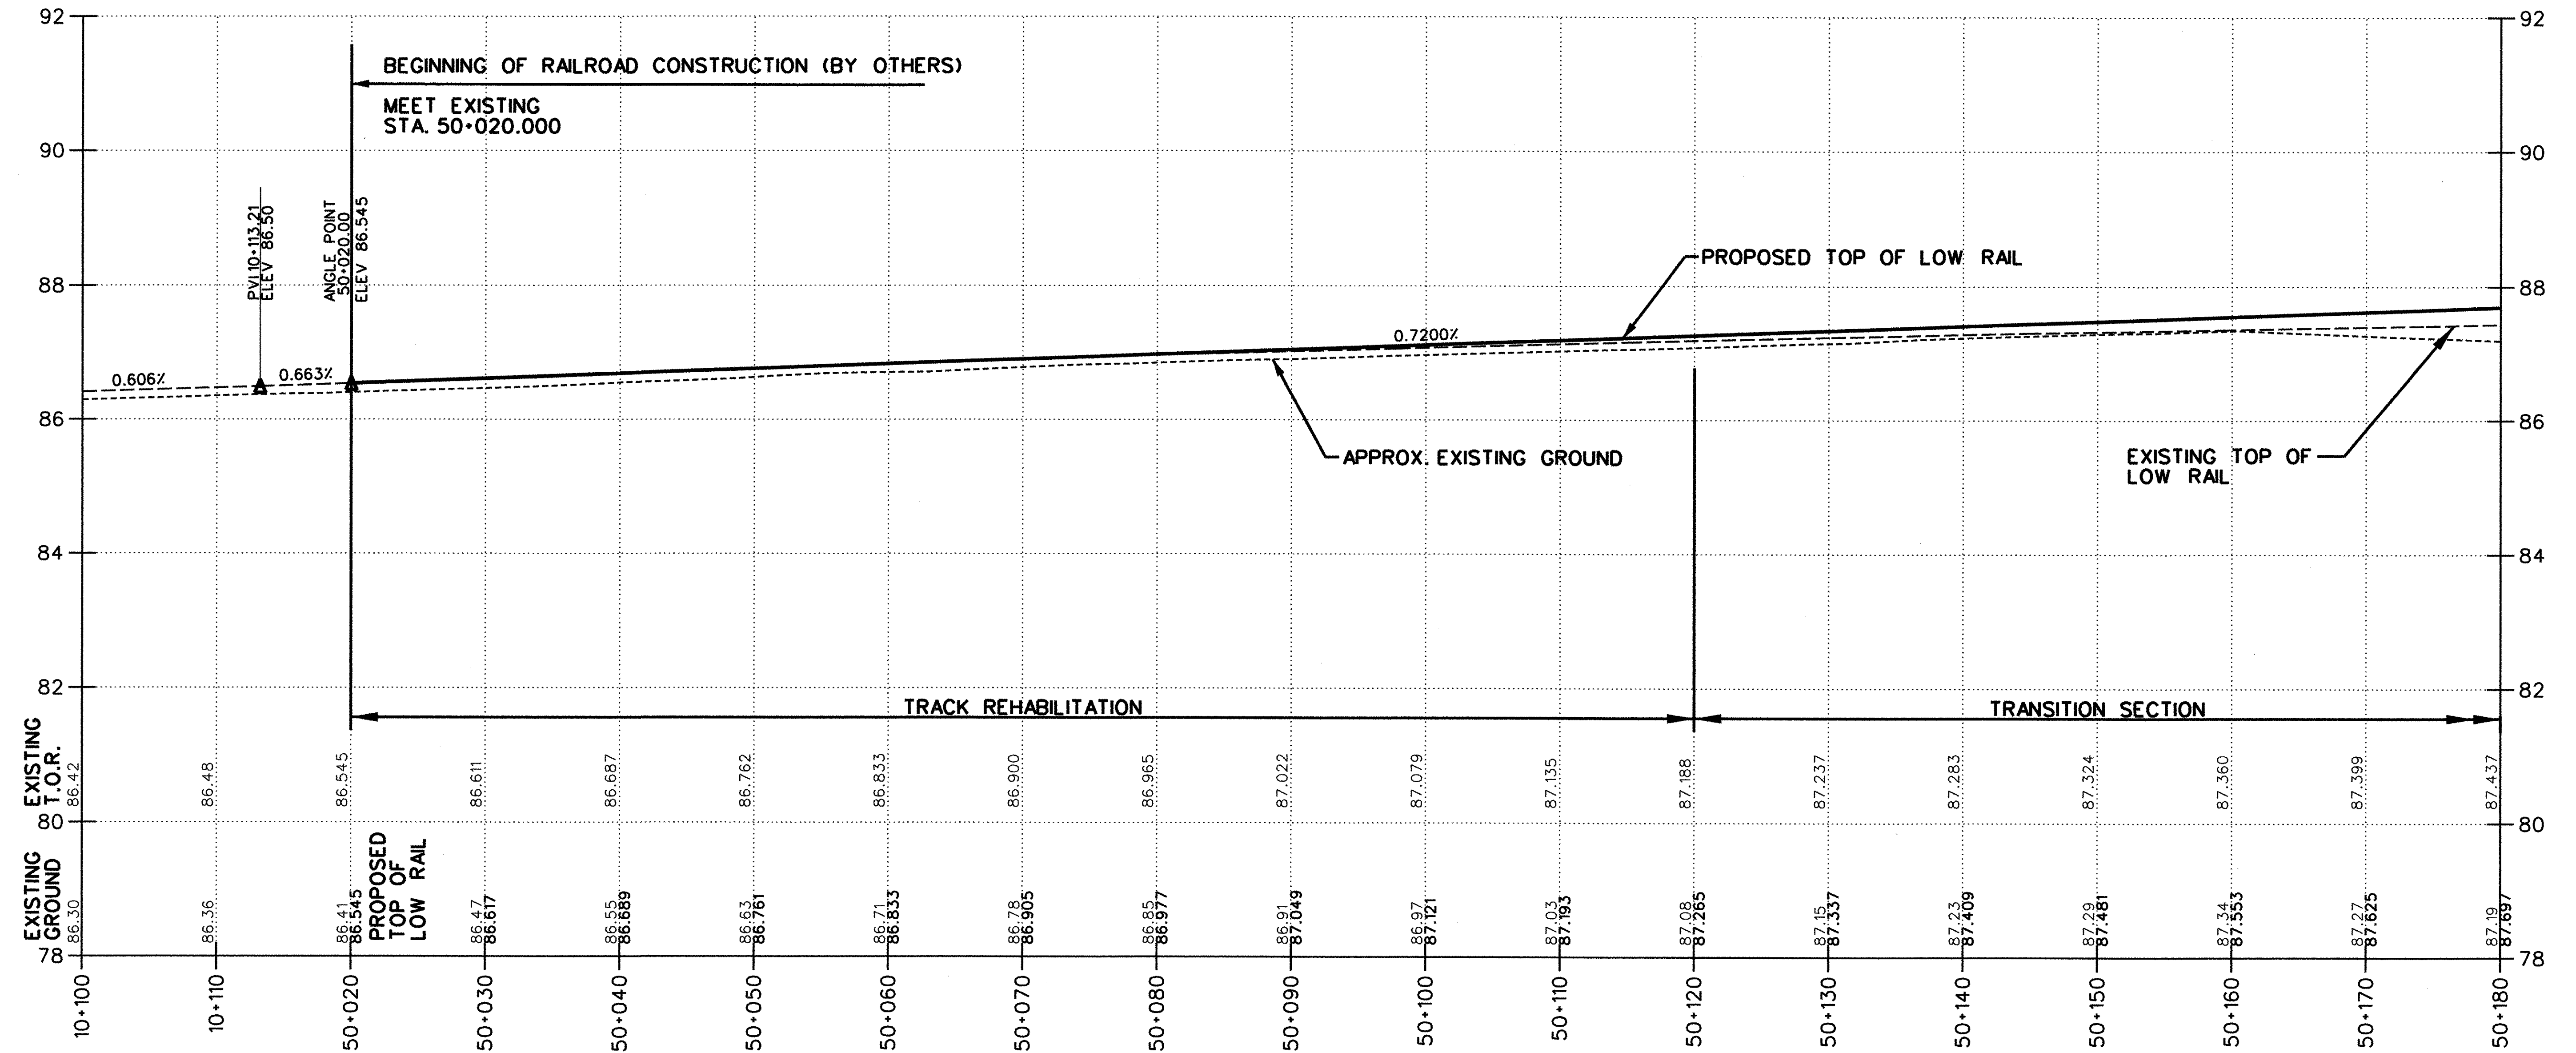


STA. 50+020.000 PROP. RR MAINLINE RELOCATION_L C
 STA. 10+120.000 EXISTING RR MAINLINE_L C

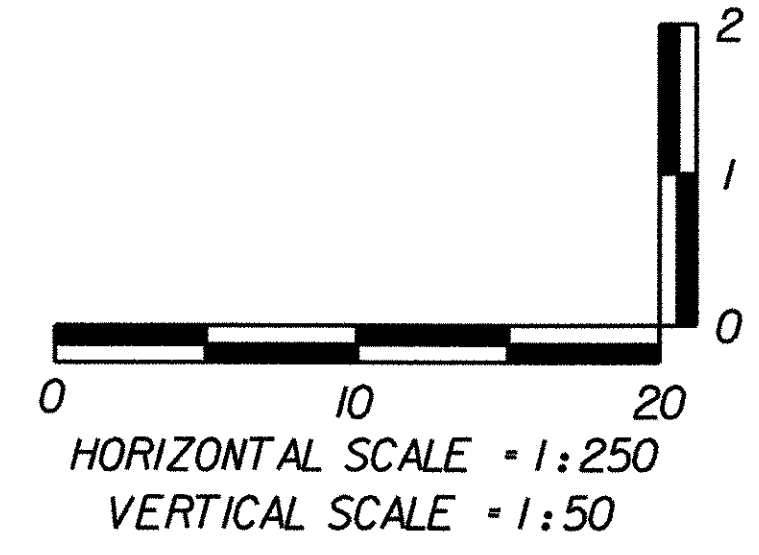


PROJECT:	BRATTLEBORO	PROJECT NO.:	NH 010-2(2)
DESIGN FILE NAME:	U:\99123-Brattleboro\dgn\zb270xs1.dgn		
IPARM FILE NAME:	PLOT DATE: 10-02-2002		
NEW ENGLAND CENTRAL RAILROAD			
FROM STA: 50+020.000 TO STA: 50+180.000 SHEET: 43 OF 145			

RAILROAD PROFILE

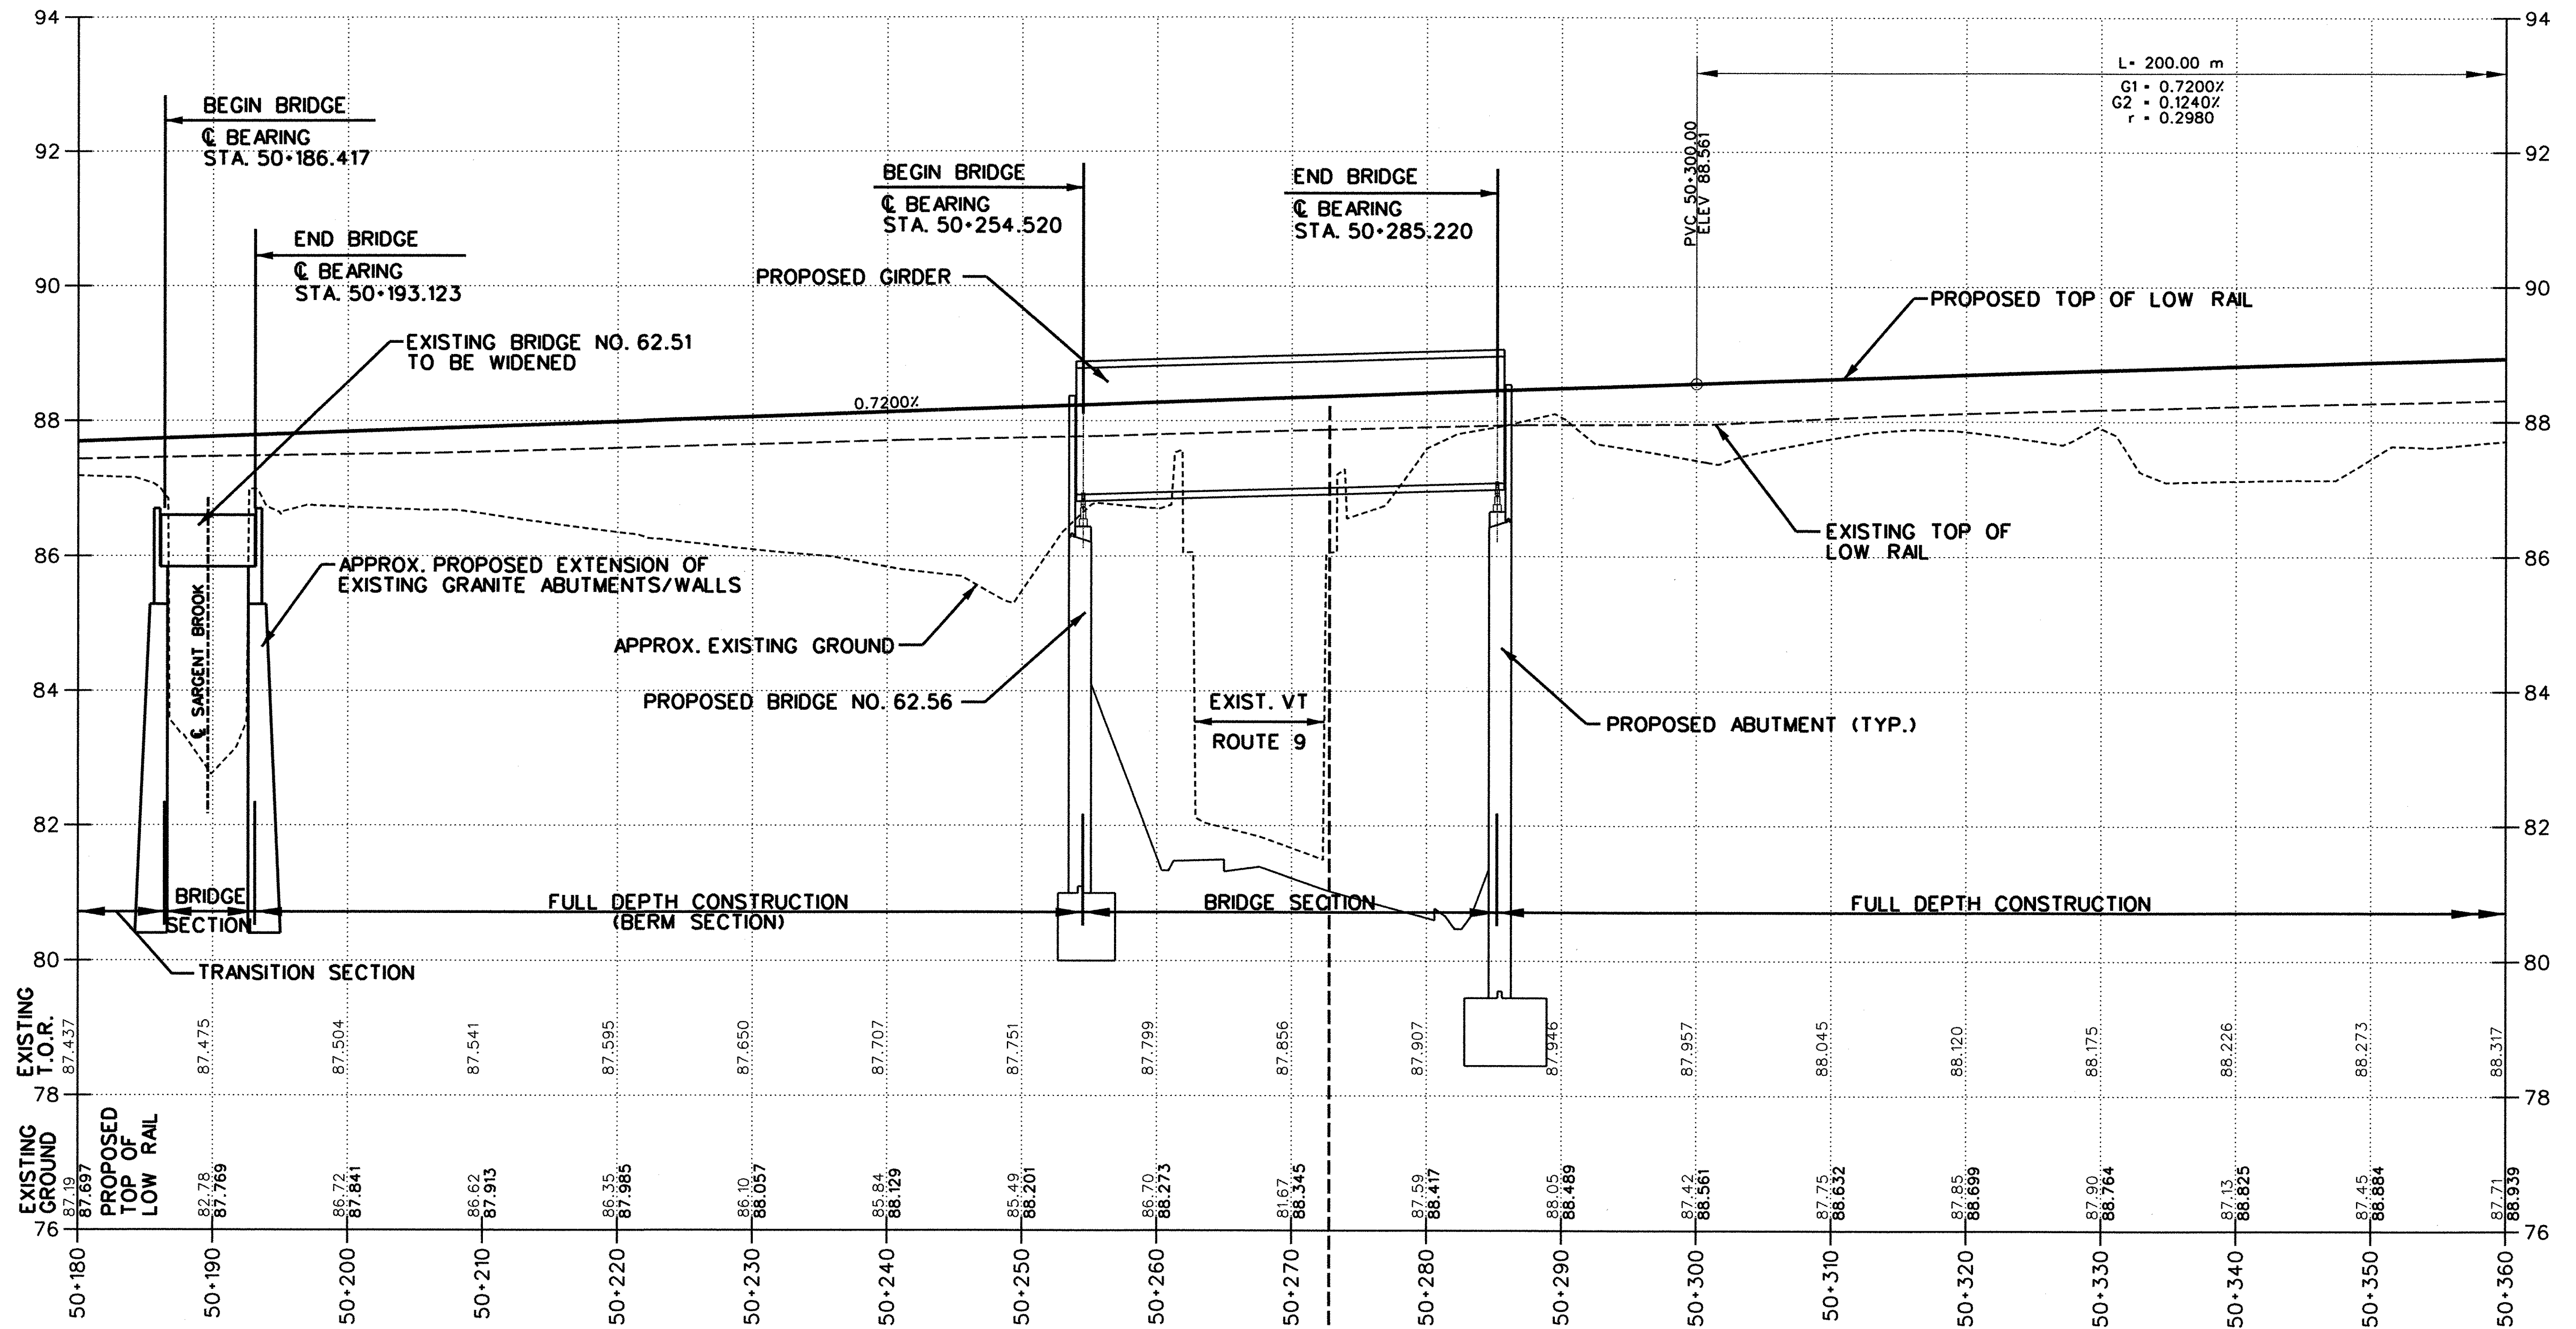



EXISTING GROUND
EXISTING T.O.R.

STA. 50+272.791 PROP. RAILROAD MAINLINE RELOCATION
STA. 30+222.922 PROP. VERMONT ROUTE 9 HIGHWAY 8

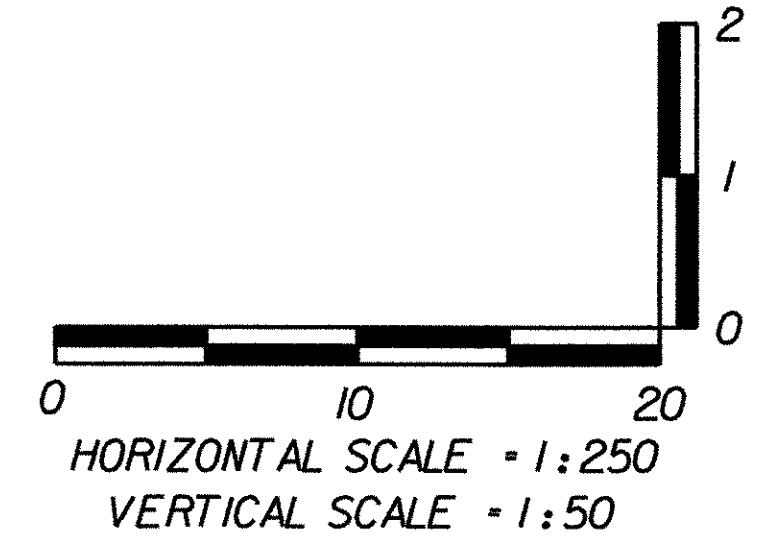


PROJECT:	BRATTLEBORO	PROJECT NO.:	NH 010-2(2)
DESIGN FILE NAME:	U:\99123-Brattleboro\dgn\zb270xs1.dgn		
IPARM FILE NAME:	PLOT DATE: 10-02-2002		
NEW ENGLAND CENTRAL RAILROAD			
FROM STA: 50+180.000 TO STA: 50+360.000 SHEET: 44 OF 145			

RAILROAD PROFILE

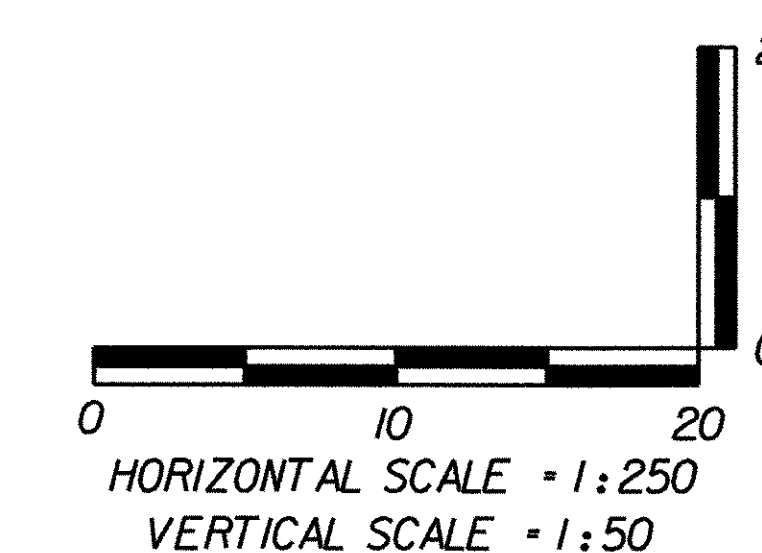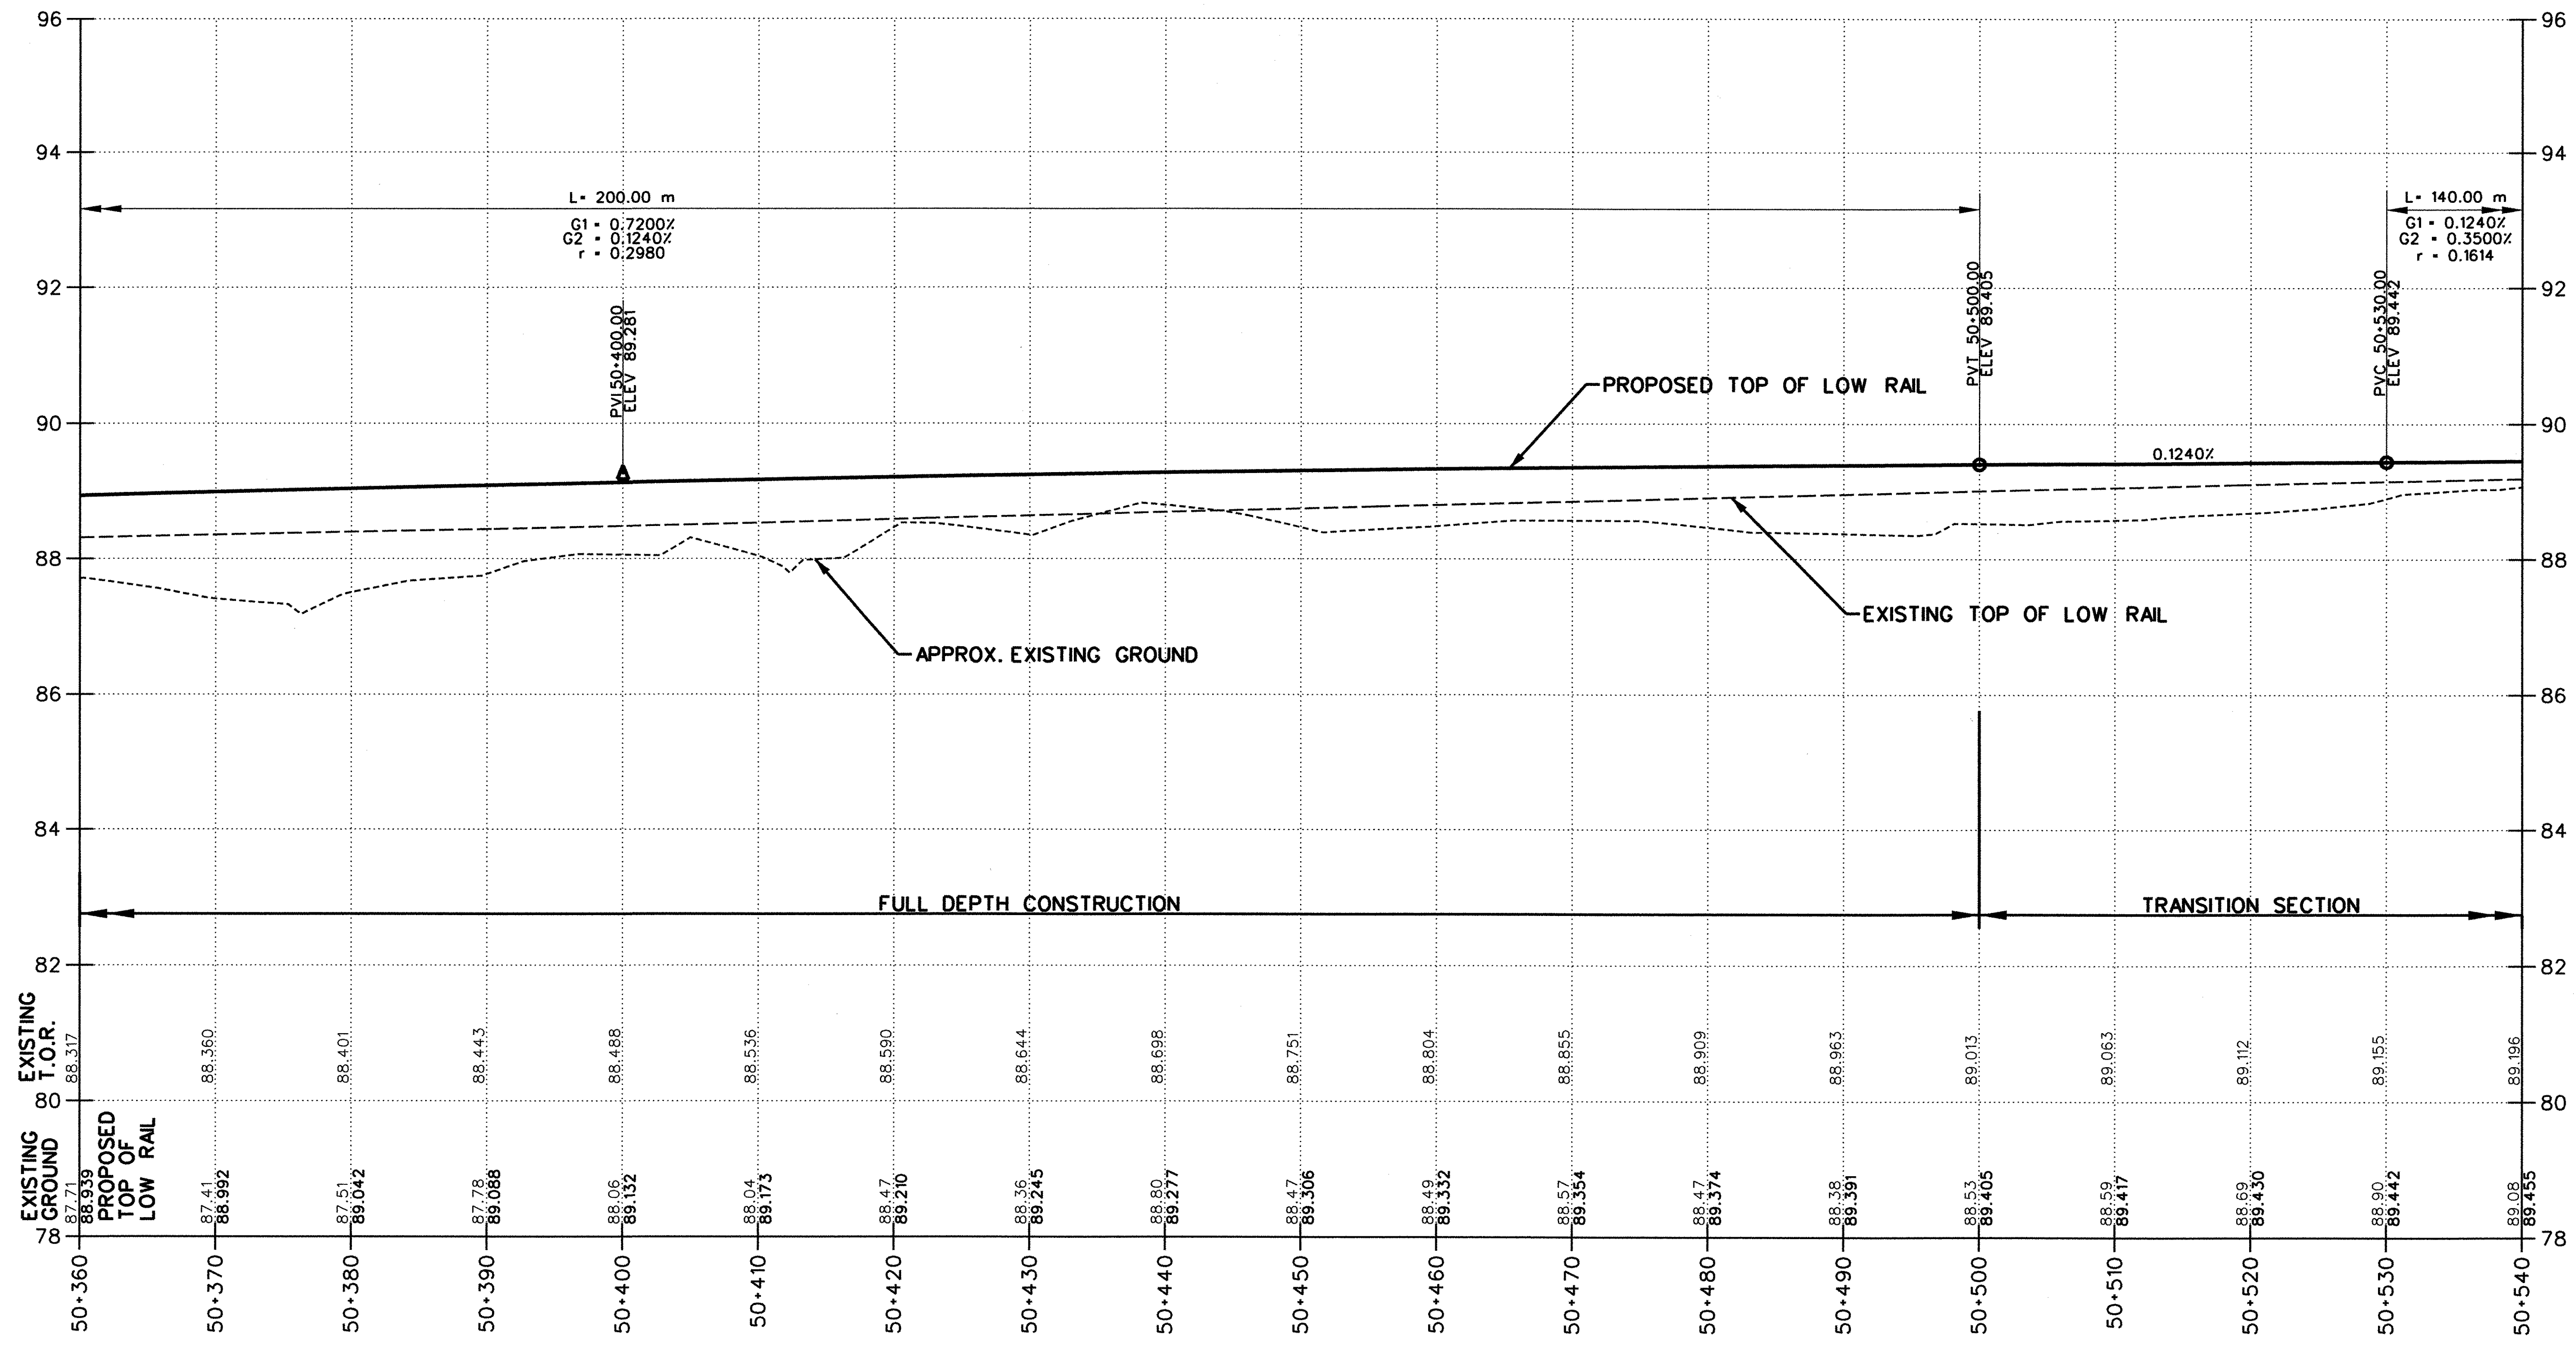


PROJECT: BRATTLEBORO	PROJECT NO.: NH 010-2(2)
DESIGN FILE NAME: U:\99123-Brattleboro\dgn\b270xs1.dgn	IPARM FILE NAME: PLOT DATE: 10-02-2002
NEW ENGLAND CENTRAL RAILROAD	
FROM STA: 50+360.000 TO STA: 50+540.000 SHEET: 45 OF 145	

RAILROAD PROFILE

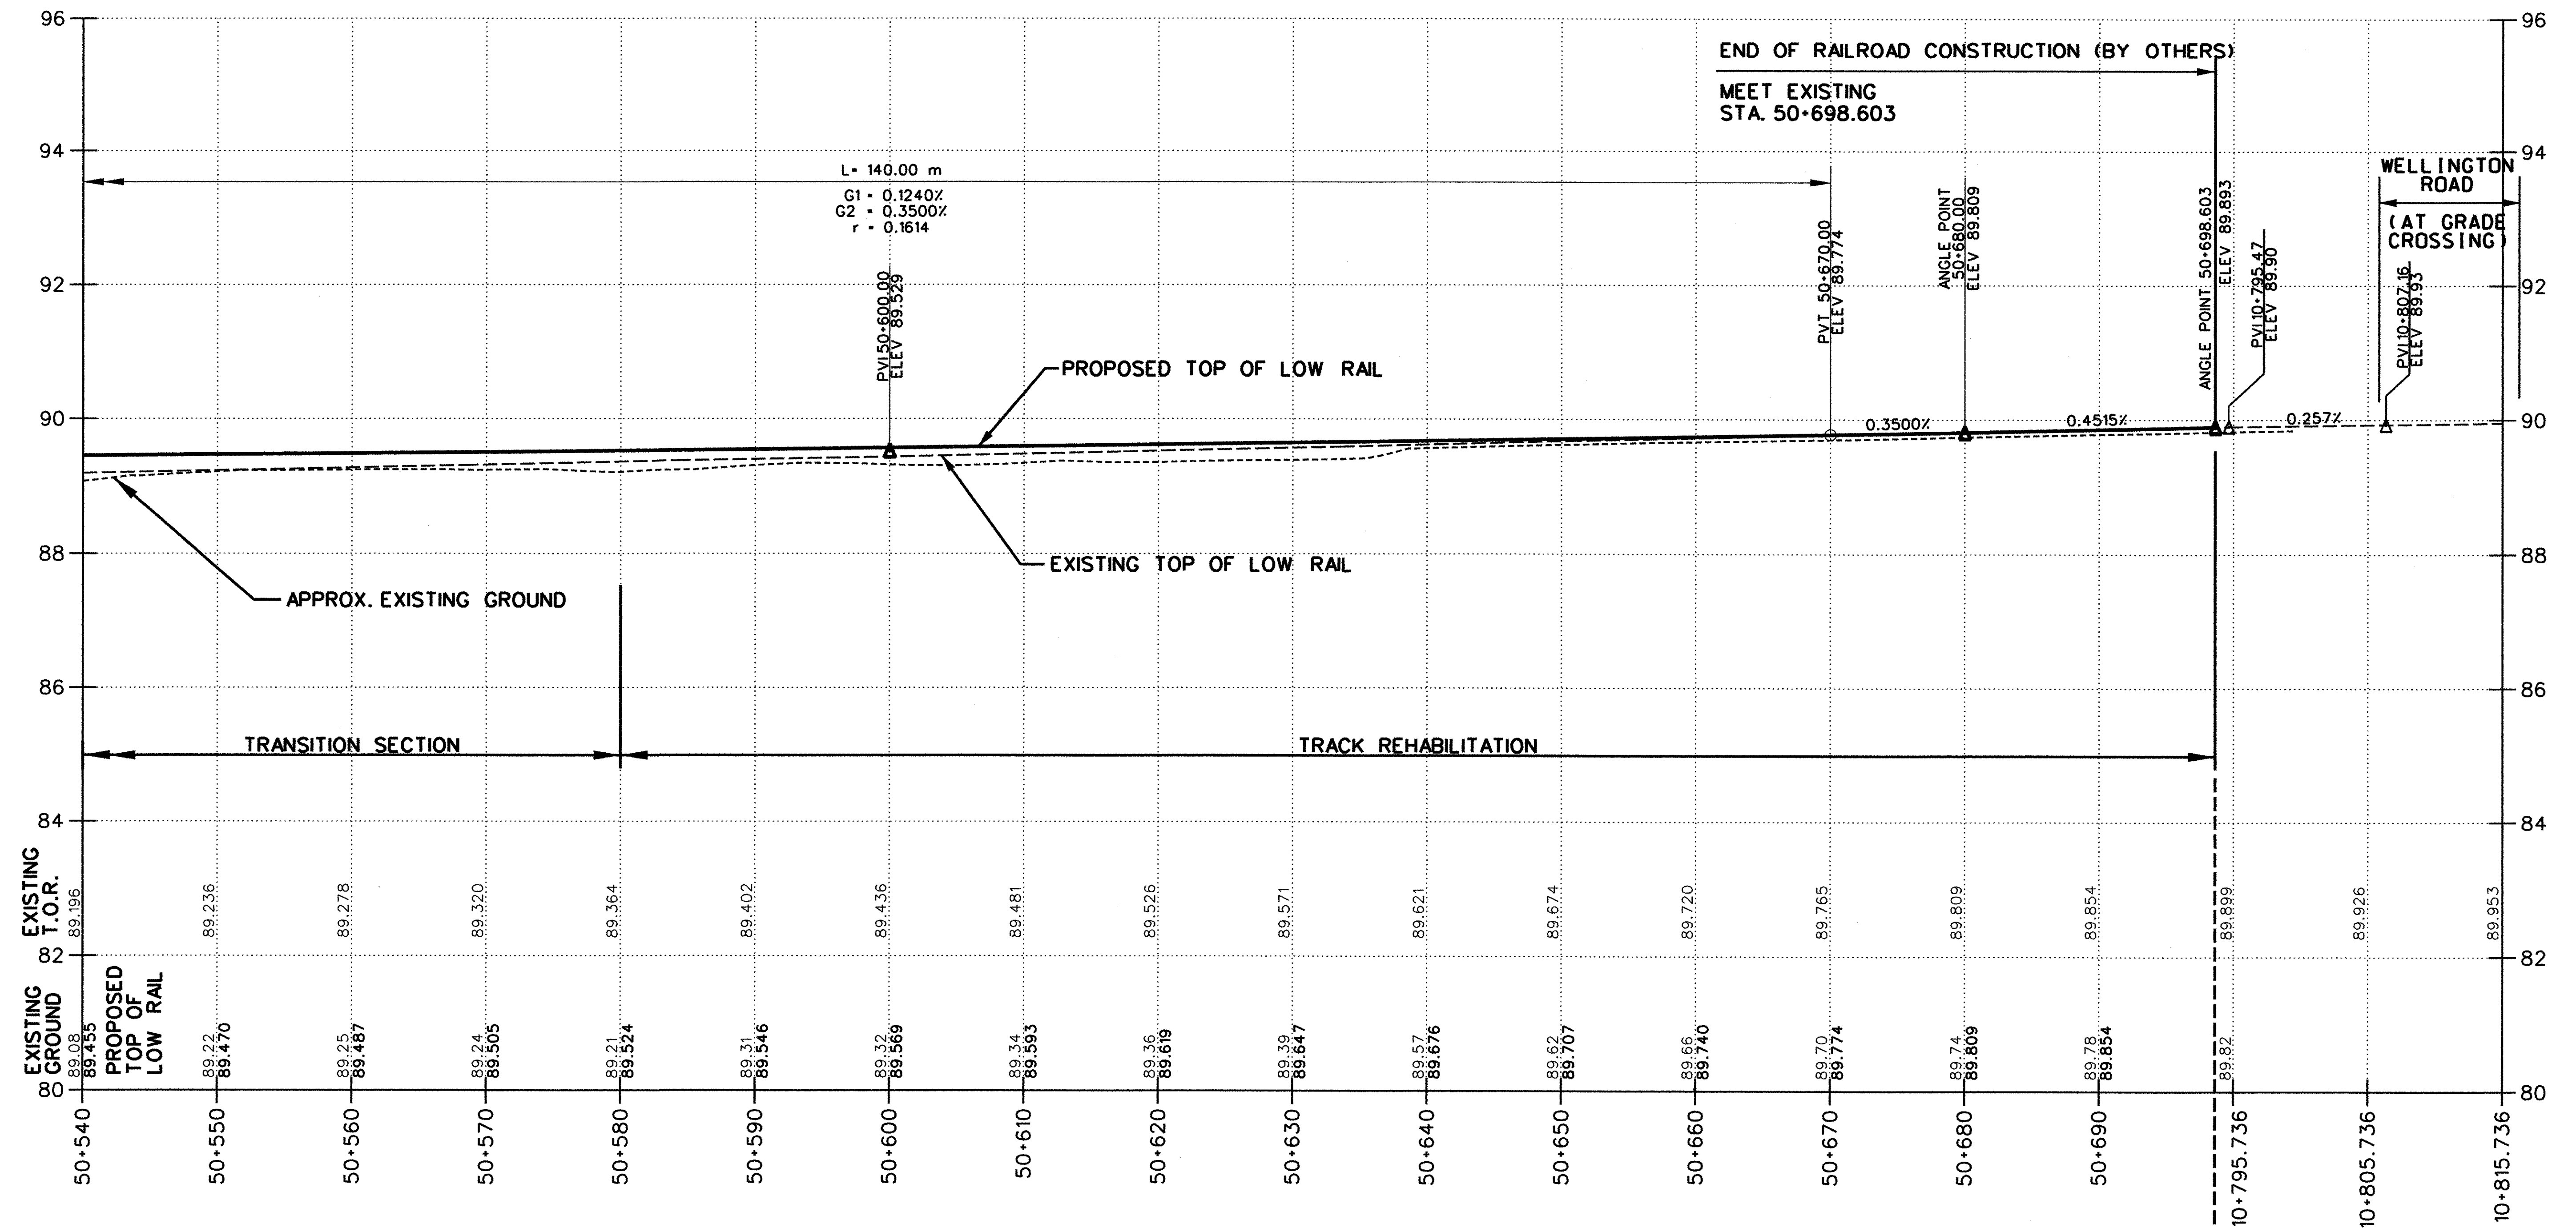

STA. 50+698.603 PROP. RR MAINLINE RELOCATION C
 STA. 10+794.364 EXISTING RR MAINLINE C

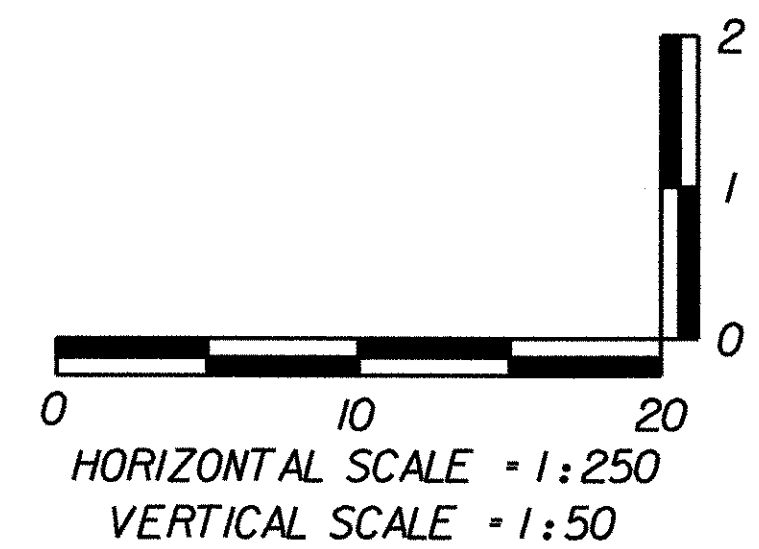

PROJECT:	BRATTLEBORO	PROJECT NO.:	NH 010-2(2)
DESIGN FILE NAME:	U:\99123-Brattleboro\dgn\zb270xs1.dgn		
IPARM FILE NAME:	PLOT DATE: 10-02-2002		
NEW ENGLAND CENTRAL RAILROAD			
FROM STA: 50+540.000 TO STA: 50+698.603 SHEET: 46 OF 145			

DRAINAGE LAYOUT & EROSION CONTROL SHEET I


- (D1) STA. 30+147 LT
CONST SPECIAL DITCH
8 m x 2 m TYPE I STONE FILL
- (P32) STA. 30+148 RT TO STA. 30+148 LT
NEW 750 mm x 2.4 m RCP (CLASS III) OR CPEP (SL)
NEW PRCMH AT INLET (1.5 m DIA.)
W/ CI COVER
- (P33) STA. 30+148 LT TO STA. 30+148 LT
NEW 750 mm x 2.4 m RCP (CLASS III) OR CPEP (SL)
RELAYING PIPE CULVERT 525 mm x 2.4 m RCP
NEW PRCMH AT INLET (1.5 m DIA.)
PRCMH IS TO BE PLACED TO INTERCEPT EXISTING
CULVERT FROM STA 30+148 LT
W/ CI COVER

- (D2) STA. 30+180 TO STA. 30+220 LT
CONST SPECIAL DITCH
TYPE I STONE FILL
- (P7) STA. 30+180 LT
NEW 450 mm x 1.5 m RCP (CLASS III) OR CPEP (SL)
OR PCCSP (1.63) OR CAAP (1.52)
NEW PRCCB AT INLET (1.2 m DIA.)
W/ CI GRATE TYPE A

- (P8) STA. 30+180 LT TO STA. 30+250 LT
NEW 750 mm x 68.5 m PCCSP (1.63) OR CAAP (1.52)
NEW PRCCB AT INLET (1.5 m DIA.)
W/ CI GRATE TYPE E

- (U5) STA. 30+182 LT TO STA. 30+250 LT
NEW 150 mm UD W/ FLUSHING BASIN AT STA 30+182

STA 30+075.000
BEGIN APPROACH
STA 30+091.000
END APPROACH
BEGIN PROJECT
NH 010-2(2)

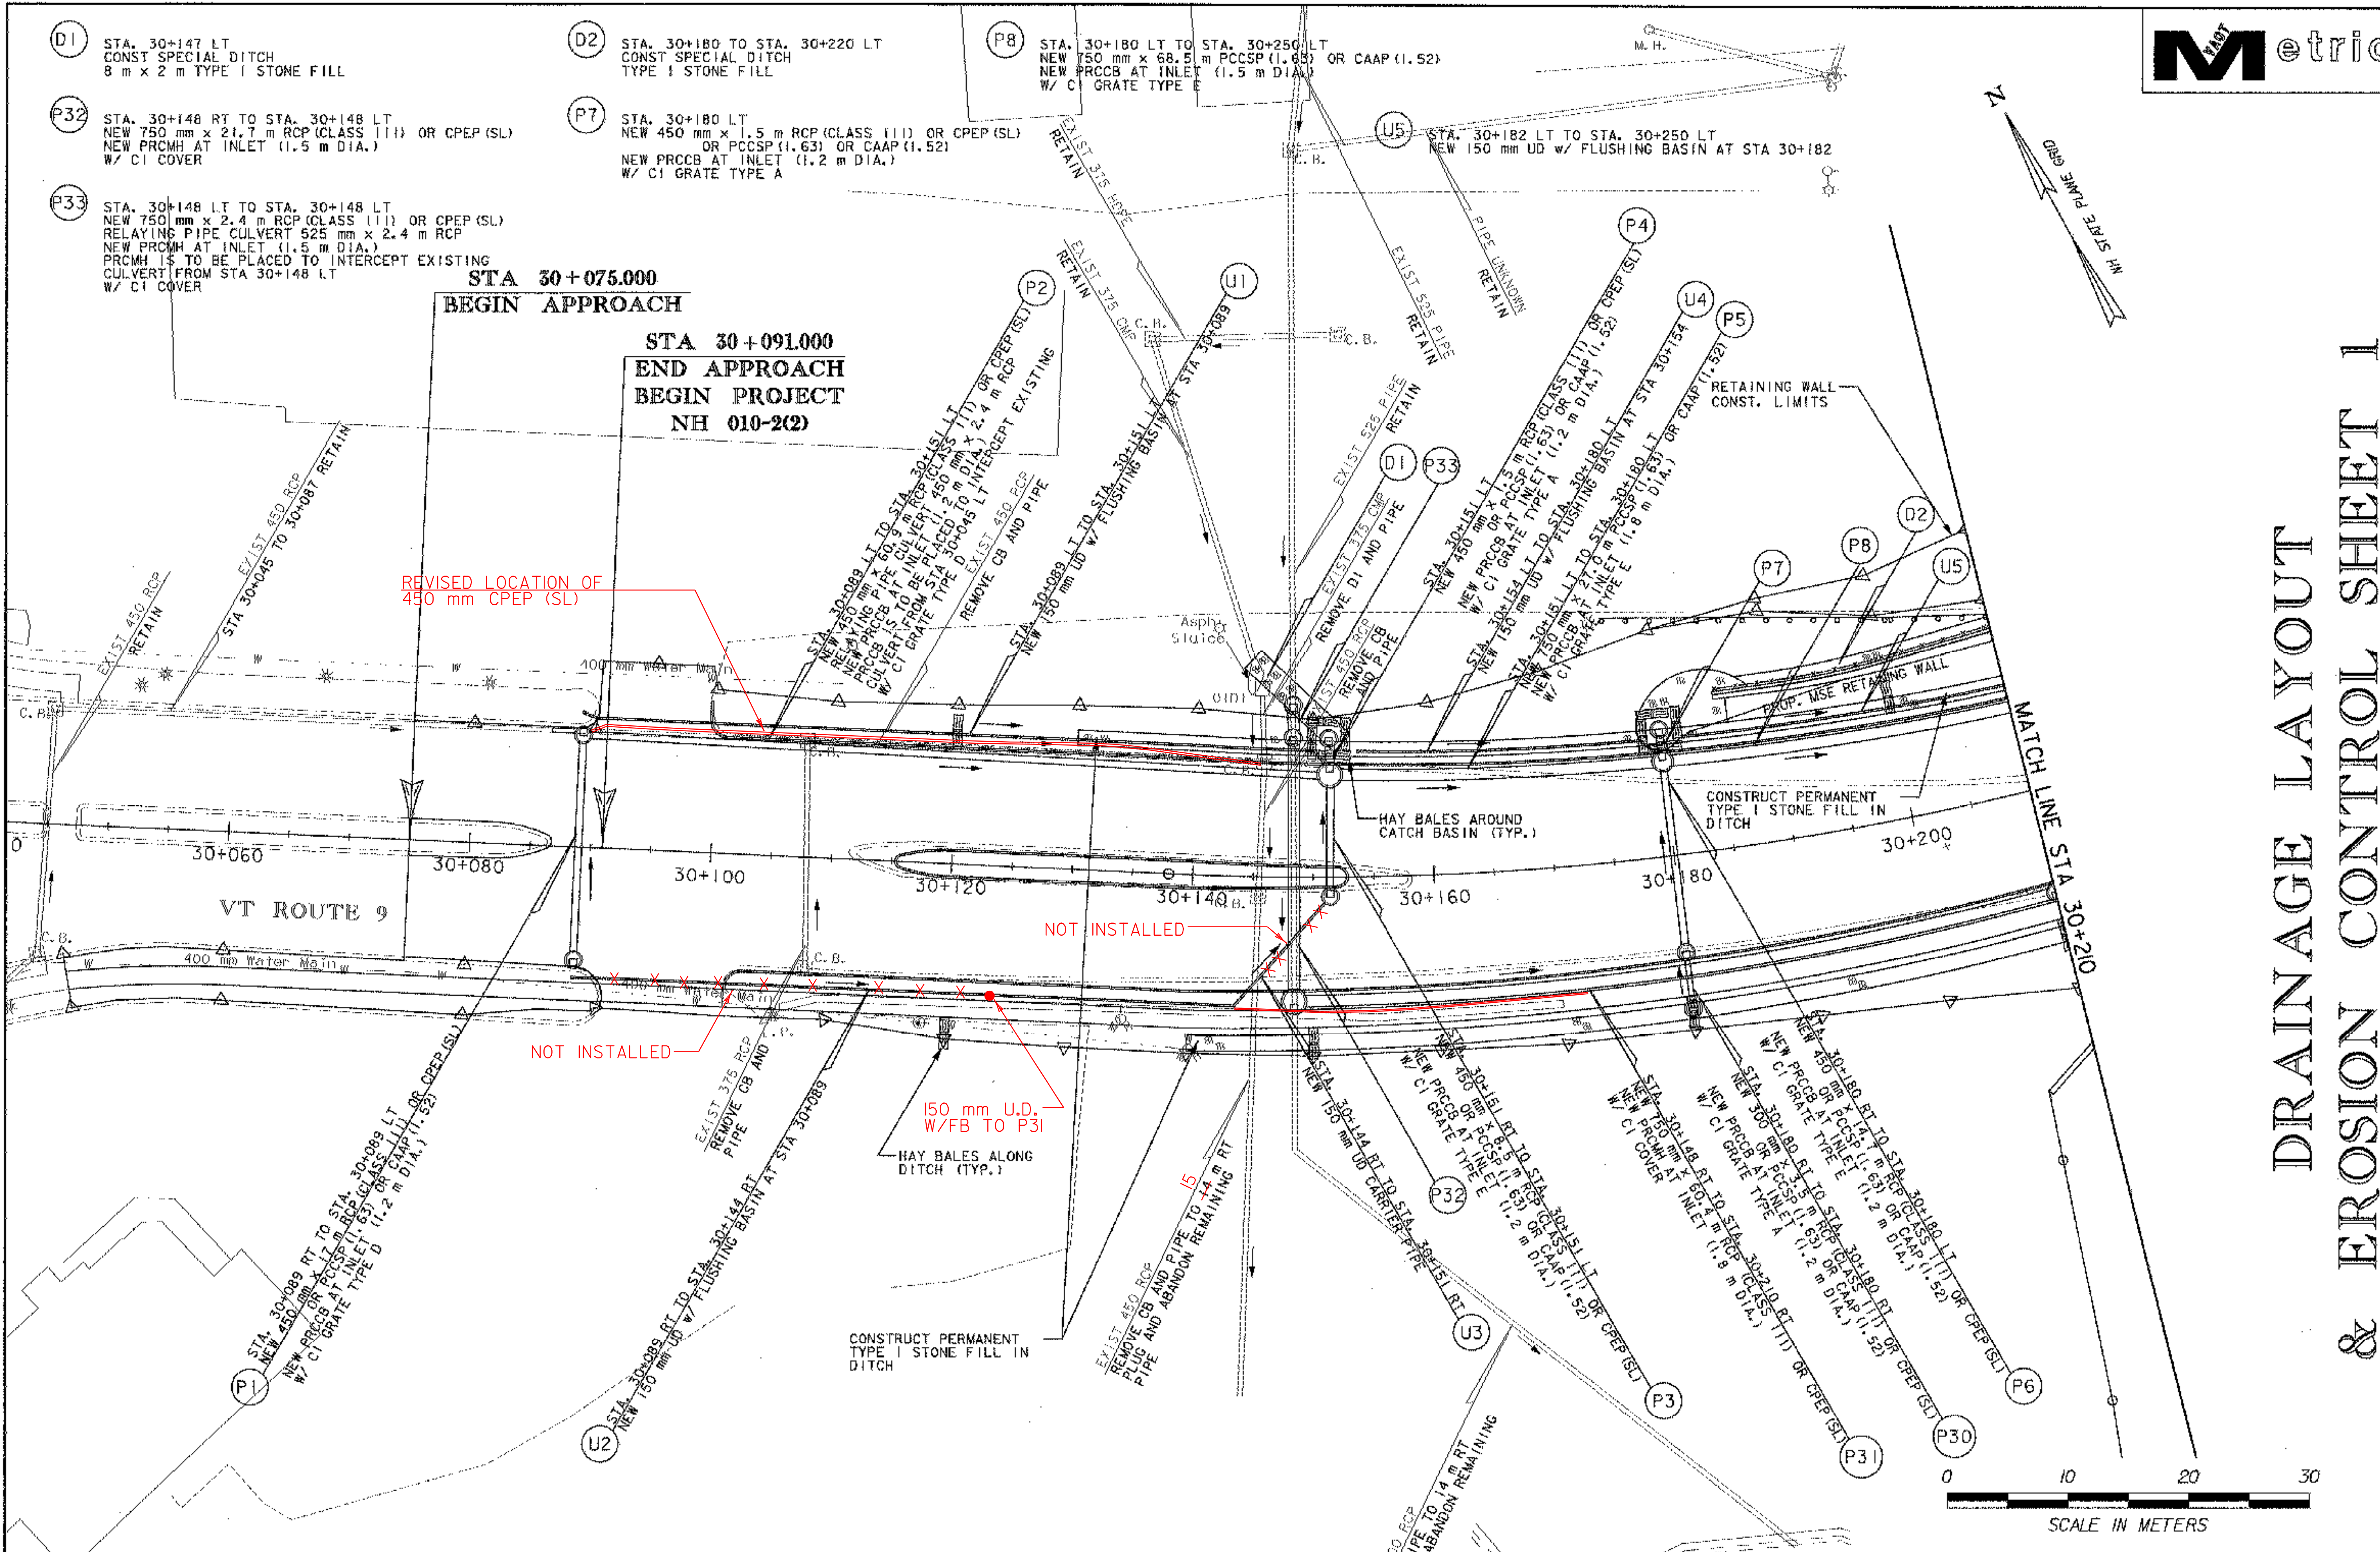

REVISED LOCATION OF
450 mm CPEP (SL)

NOT INSTALLED

NOT INSTALLED

150 mm U.D.
W/FB TO P31

DATUM	
VERTICAL	NGVD 1923
HORIZONTAL	NAD 1983

EROSION MATTING		STONE FILL TYPE I	
STA 30+100 TO	30+130 LT	STA 30+130 TO	30+210 LT
STA 30+110 TO	30+140 RT	STA 30+140 TO	30+210 RT



PROJECT: BRATTLEBORO	PROJECT NO.: NH 010-2(2)
DESIGN FILE NAME: ... \zb270bd2.dgn	PLOT DATE: 09/20/2002
IPARM FILE NAME:	SURVEY DATE:
SURVEYED BY:	DRAWN BY: P SHEDD
SQUAD LEADER: W HUSBAND	SHEET: 47 OF 145
CLD REF NO. 00-0358	



DRAINAGE LAYOUT & EROSION CONTROL SHEET 2

EROSION MATTING
 STA 30+280.0 TO 30+310.0 LT
 STA 30+300.0 TO 30+320.0 RT

STONE FILL TYPE I
 STA 30+210 TO 30+280 LT
 STA 30+210 TO 30+300 RT

STONE FILL TYPE II
 STA A 203+49 TO A 203+63 RT

STONE FILL TYPE IV
 STA A 203+63 TO A 203+73 RT

RETAINING WALL CONST. LIMITS

STA 30+252 LT TO STA. 30+285 LT
 NEW 150 mm UD w/ FLUSHING BASIN AT STA 30+252

STA 30+287 LT TO STA. 30+326 LT
 NEW 150 mm UD w/ FLUSHING BASIN AT STA 30+287

STA 30+310 RT TO STA. 30+326 RT
 NEW 150 mm UD w/ FLUSHING BASIN AT STA 30+310

STA 30+326 LT TO STA. A203+50 LT
 NEW 150 mm UD w/ FLUSHING BASIN AT STA A203+50

STA 30+326 RT TO STA. A203+50 RT
 NEW 150 mm UD w/ FLUSHING BASIN AT STA A203+50

STA 30+222.922 VT RTE 9 =
 STA 50+272.791 RAILROAD


P9 STA. 30+250 RT TO STA. 30+250 LT
 NEW 450 mm x 11.2 m RCP (CLASS III) OR CPEP (SL)
 OR PCCSP (1.63) OR CAAP (1.52)
 NEW PRCCB AT INLET (1.2 m DIA.)
 W/ CI GRATE TYPE E

P10 STA. 30+250 LT
 NEW 450 mm x 1.5 m RCP (CLASS III) OR CPEP (SL)
 OR PCCSP (1.63) OR CAAP (1.52)
 NEW PRCCB AT INLET (1.2 m DIA.)
 W/ CI GRATE TYPE A

P11 STA. 30+250 LT TO STA. 30+285 LT
 NEW 900 mm x 33.5 m PCCSP (1.63) OR CAAP (1.52)
 NEW PRCCB AT INLET (1.8 m DIA.)
 W/ CI GRATE TYPE E

P12 STA. 30+285 LT TO STA. 30+326 LT
 NEW 900 mm x 39.3 m RCP (CLASS III) OR CPEP (SL)
 NEW PRCCB AT INLET (1.5 m DIA.)
 W/ CI GRATE TYPE D

P13 STA. 30+326 LT
 NEW 450 mm x 1.5 m RCP (CLASS III) OR CPEP (SL)
 OR PCCSP (1.63) OR CAAP (1.52)
 NEW PRCCB AT INLET (1.2 m DIA.)
 W/ CI GRATE TYPE A

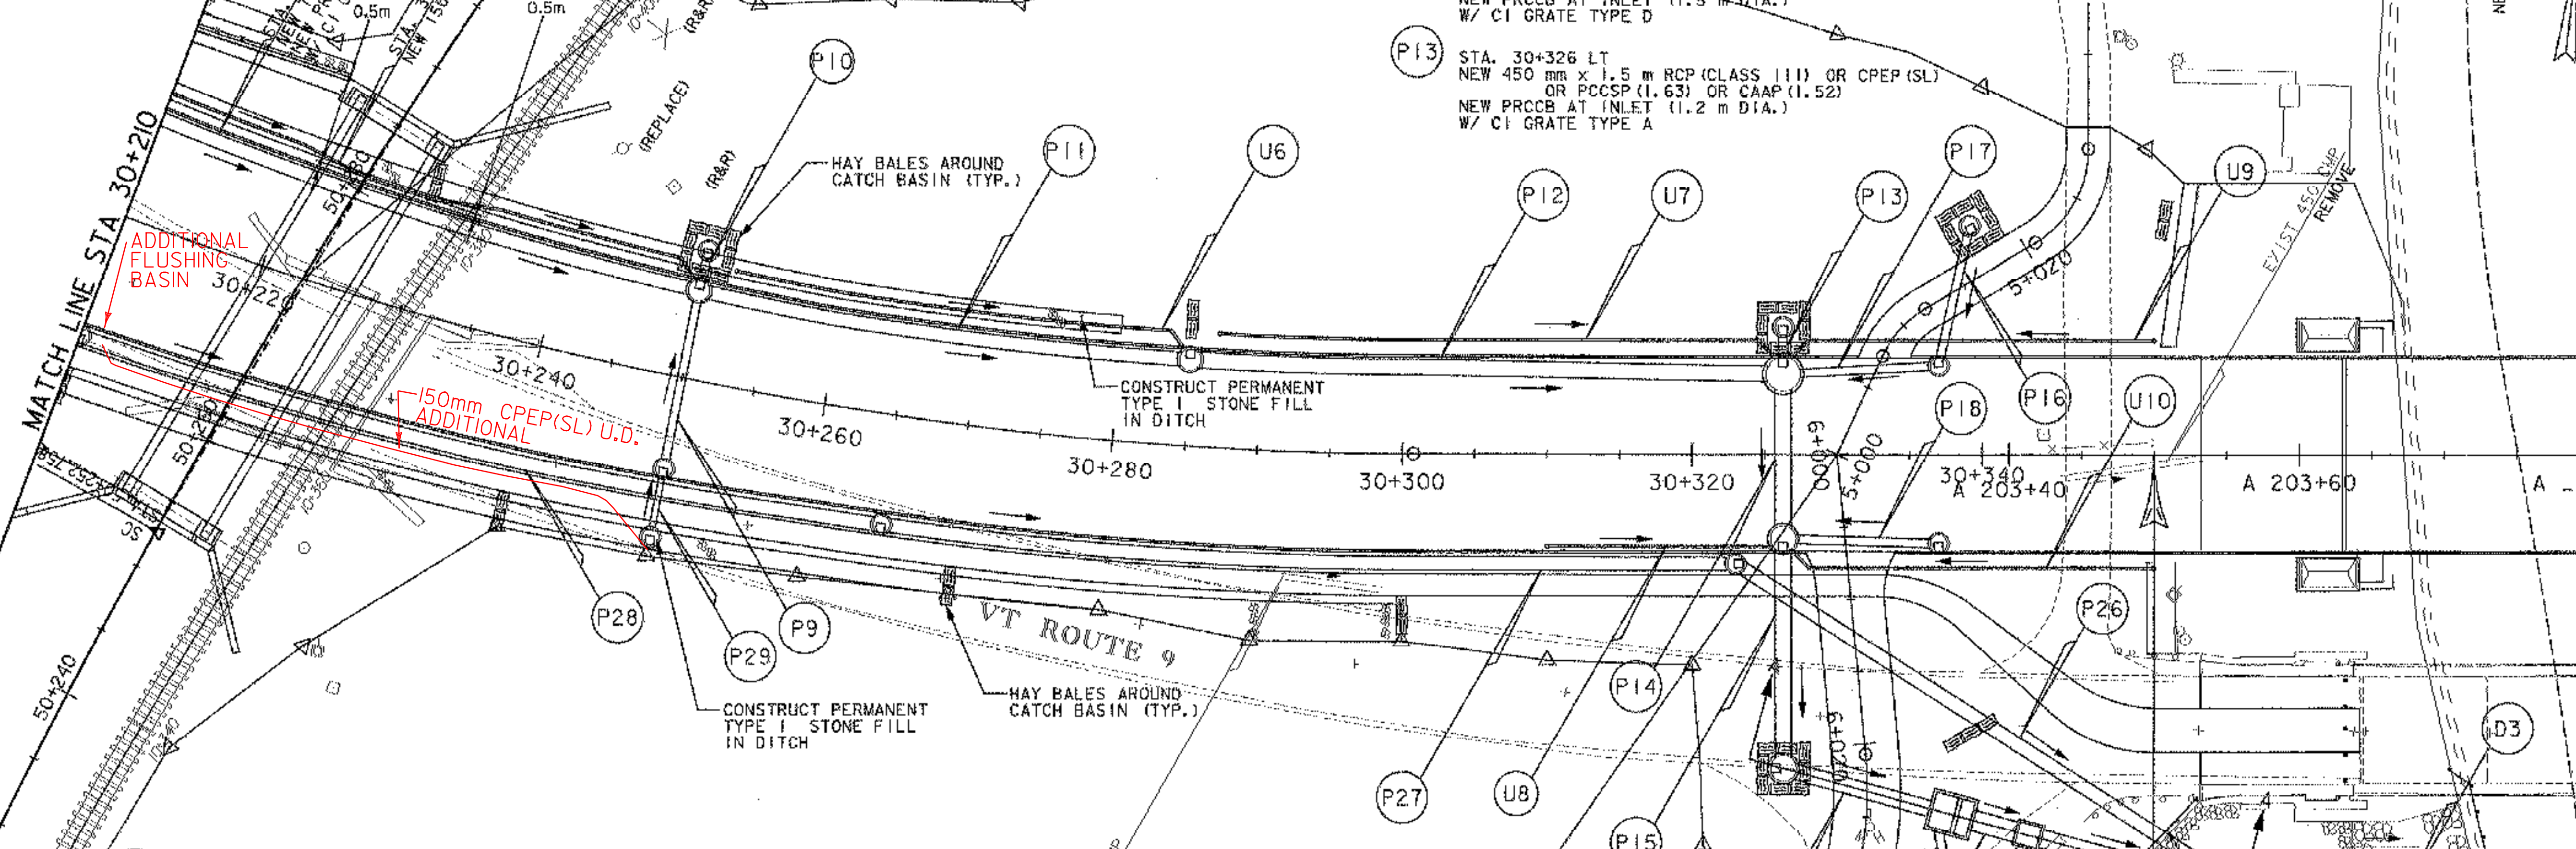

P14 STA. 30+326 LT TO STA. 30+326 RT
 NEW 900 mm x 9.2 m RCP (CLASS III) OR CPEP (SL)
 NEW PRCCB AT INLET (2.1 m DIA.)
 W/ CI GRATE TYPE D

P15 STA. 30+326 RT
 NEW 900 mm x 14.4 m RCP (CLASS III) OR CPEP (SL)
 NEW PRCCB AT INLET (1.8 m DIA.)
 W/ CI GRATE TYPE D

P16 STA. 30+337 LT TO STA. 5+016 LT
 NEW 450 mm x 8.8 m RCP (CLASS III) OR CPEP (SL)
 OR PCCSP (1.63) OR CAAP (1.52)
 NEW PRCCB AT INLET (1.2 m DIA.)
 W/ CI GRATE TYPE A

P17 STA. 30+326 LT TO STA. 30+337 LT
 NEW 450 mm x 9.0 m RCP (CLASS III) OR CPEP (SL)
 OR PCCSP (1.63) OR CAAP (1.52)
 NEW PRCCB AT INLET (1.2 m DIA.)
 W/ CI GRATE TYPE D

P18 STA. 30+326 RT TO STA. 30+337 RT
 NEW 450 mm x 9.2 m RCP (CLASS III) OR CPEP (SL)
 OR PCCSP (1.63) OR CAAP (1.52)
 NEW PRCCB AT INLET (1.2 m DIA.)
 W/ CI GRATE TYPE D

P19 STA. 30+326 RT TO STA. 30+338 RT
 NEW 900 mm x 9.7 m RCP (CLASS III) OR CPEP (SL)
 NEW PRCCB AT INLET (1.8 m DIA.)
 W/ CI GRATE TYPE A

P21 STA. 30+338 RT TO STA. 30+339 RT
 NEW 600 mm x 5.1 m RCP (CLASS III) OR CPEP (SL)

P22 STA. 30+338 RT TO STA. A203+43 RT
 NEW 900 mm x 3.4 m RCP (CLASS III) OR CPEP (SL)
 NEW PRCMH AT INLET (2.7 m x 2.4 m)
 W/ CI COVER

P23 INTENTIONALLY LEFT BLANK

P24 STA. 30+339 RT TO STA. A203+43 RT
 NEW 750 mm x 4.8 m RCP (CLASS III) OR CPEP (SL)
 INSTALL TREATMENT CONTROL STRUCTURE AT INLET

P25 STA. A203+43 RT TO STA. A203+52 RT
 NEW 900 mm x 9.7 m RCP (CLASS III) OR CPEP (SL)
 W/ RCPES (CLASS III) OR CPEPES AT OUTLET
 NEW PRCMH AT INLET (1.5 m x 1.5 m)
 W/ CI COVER

P26 STA. 30+323 RT TO STA. A203+52 RT
 NEW 750 mm x 38.8 m RCP (CLASS III) OR CPEP (SL)
 W/ RCPES (CLASS III) OR CPEPES AT OUTLET
 NEW PRCMH AT INLET (1.5 m)
 W/ CI COVER

P27 STA. 30+265 RT TO STA. 30+323 RT
 NEW 750 mm x 56.5 m PCCSP (1.63) OR CAAP (1.52)
 NEW PRCMH AT INLET (1.5 m DIA.)
 W/ CI COVER

P28 STA. 30+210 RT TO STA. 30+265 RT
 NEW 750 mm x 53.8 m PCCSP (1.63) OR CAAP (1.52)
 NEW PRCMH AT INLET (1.5 m DIA.)
 W/ CI COVER

P29 STA. 30+250 RT TO STA. 30+250 RT
 NEW 300 mm x 3.5 m RCP (CLASS III) OR CPEP (SL)
 OR PCCSP (1.63) OR CAAP (1.52)
 NEW PRCCB AT INLET (1.2 m DIA.)
 W/ CI GRATE TYPE A

STA A203+50.000
END PROJECT
NH 010-2(2)
BEGIN NH PROJECT 11999

SILT FENCE IN STREAM (TYP.)
 SILT FENCE IN STREAM (TYP.)
 FILTER CURTAIN (TYP.)

D3 STA. A203+53.5 TO A203+72 RT
 CONST. SPECIAL DITCH TO RIVER.
 EXCAVATE TO LEDGE. IF LEDGE IS NOT FOUND,
 CONST. DITCH TO RIVER w/ TYPE IV STONE FILL




DATUM

VERTICAL NGVD 1929
 HORIZONTAL NAD 1983


PROJECT: BRATTLEBORO	PROJECT NO. 1: NH 010-2(2)
DESIGN FILE NAME: ... \ZB270B02.DGN	PLOT DATE: 09/20/2002
IPARM FILE NAME:	SURVEY DATE:
SQUAD LEADER: W HUSBAND	DRAWN BY: P SHEDD
CLD REF NO. 00-0358	SHEET: 48 OF 145

SECTION A-A

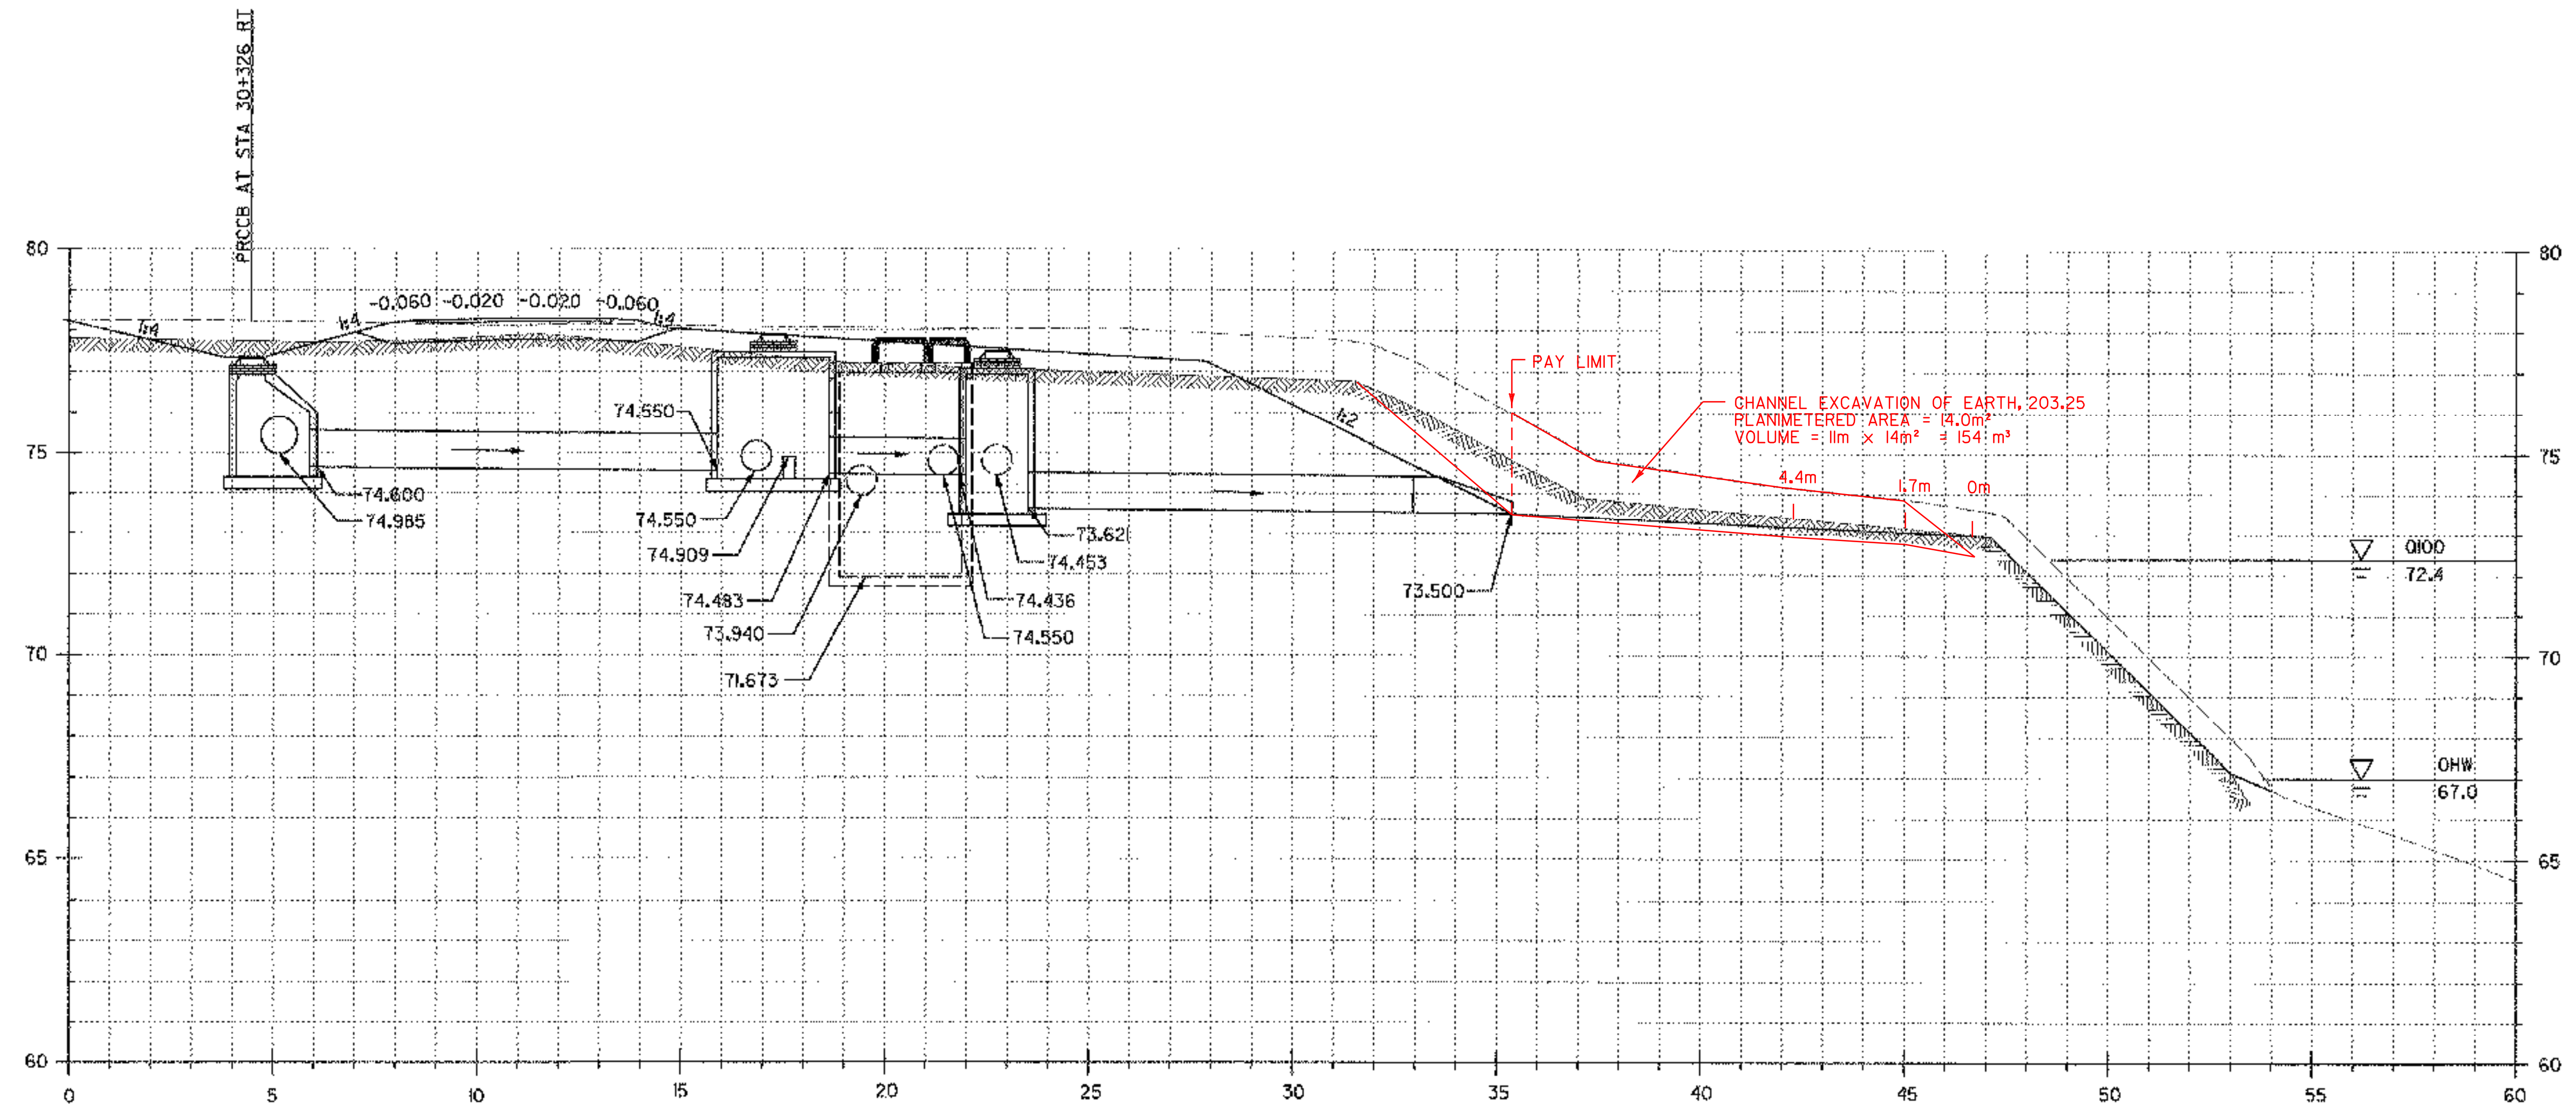

DATUM	
VERTICAL	NGVD 1929
HORIZONTAL	NAD 1983

PROJECT: BRATTLEBORO	PROJECT NO.: NH 010-2(2)
DESIGN FILE NAME: ... \zb270xs2.dgn	PLOT DATE: 09/20/2002
IPARM FILE NAME:	SURVEY DATE:
SURVEYED BY:	DRAWN BY: JAC
SQUAD LEADER: W HUSBAND	SHEET: 49 OF 145
CLD REF NO. 00-0358	


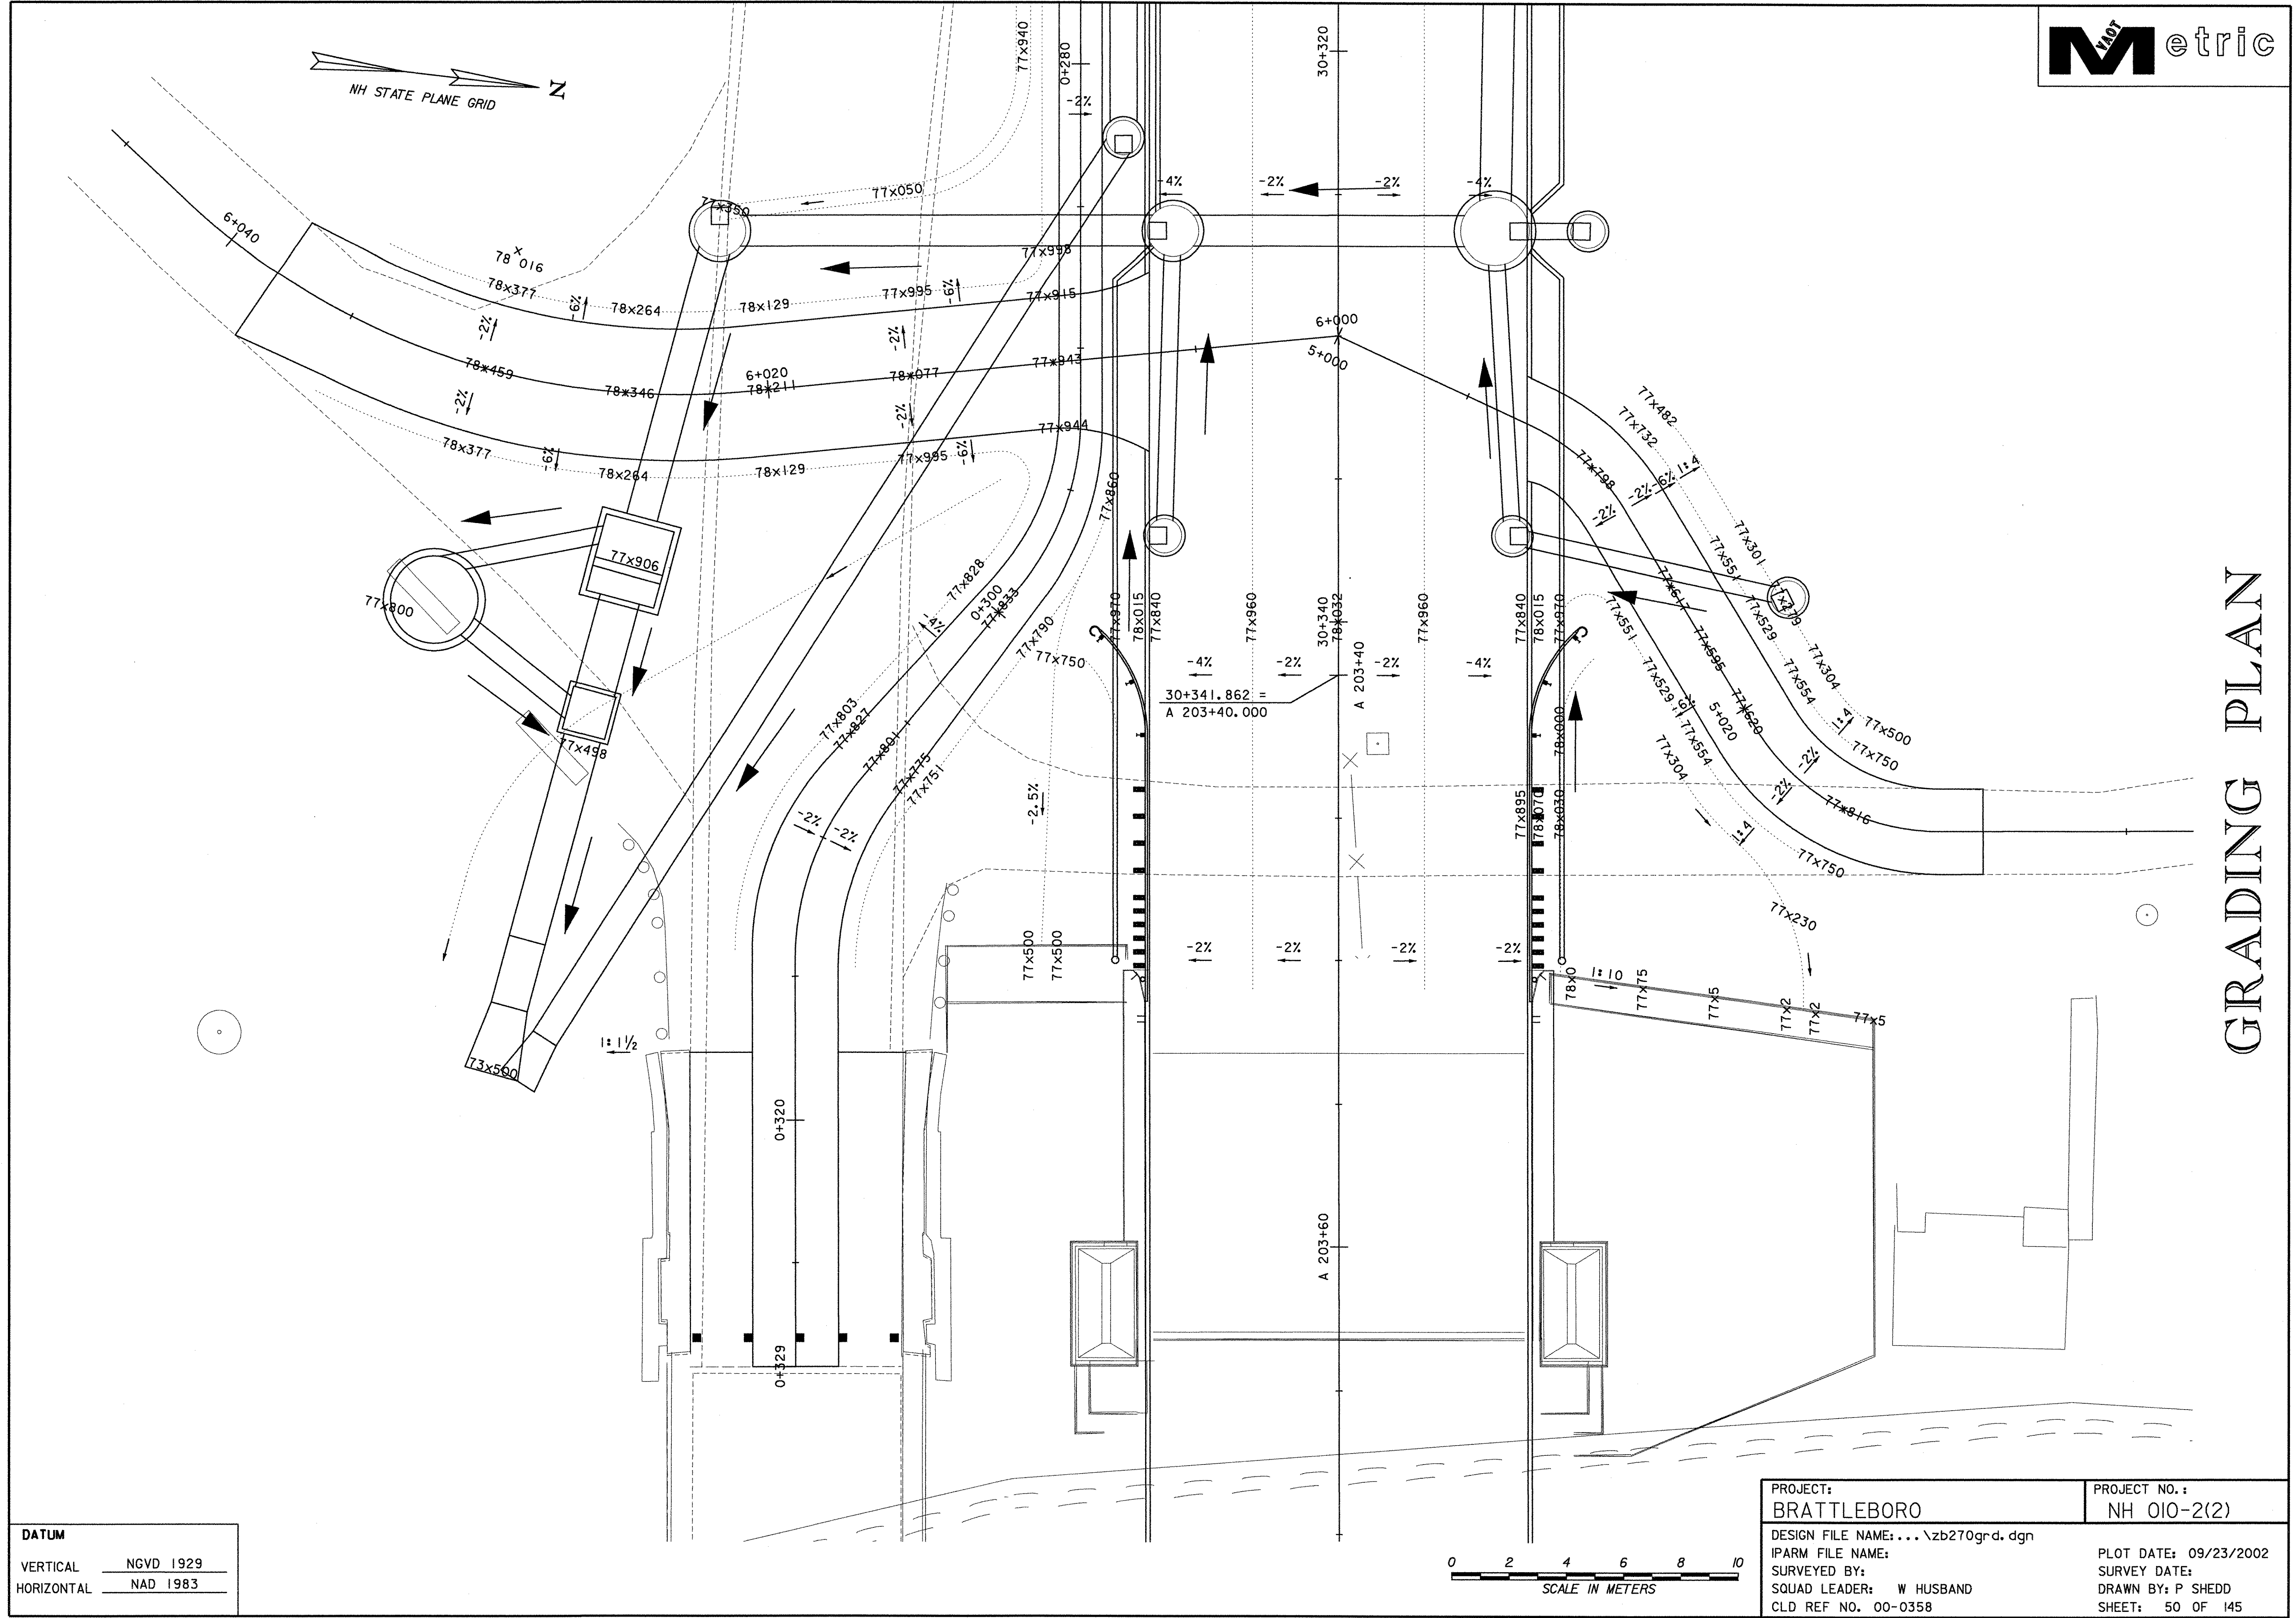


GRADING PLAN

DATUM	
VERTICAL	NGVD 1929
HORIZONTAL	NAD 1983



PROJECT: BRATTLEBORO	PROJECT NO. : NH 010-2(2)
DESIGN FILE NAME: ... \zb270gr.d.dgn	PLOT DATE: 09/23/2002
IPARM FILE NAME:	SURVEY DATE:
SURVEYED BY:	DRAWN BY: P SHEDD
SQUAD LEADER: W HUSBAND	SHEET: 50 OF 145
CLD REF NO. 00-0358	

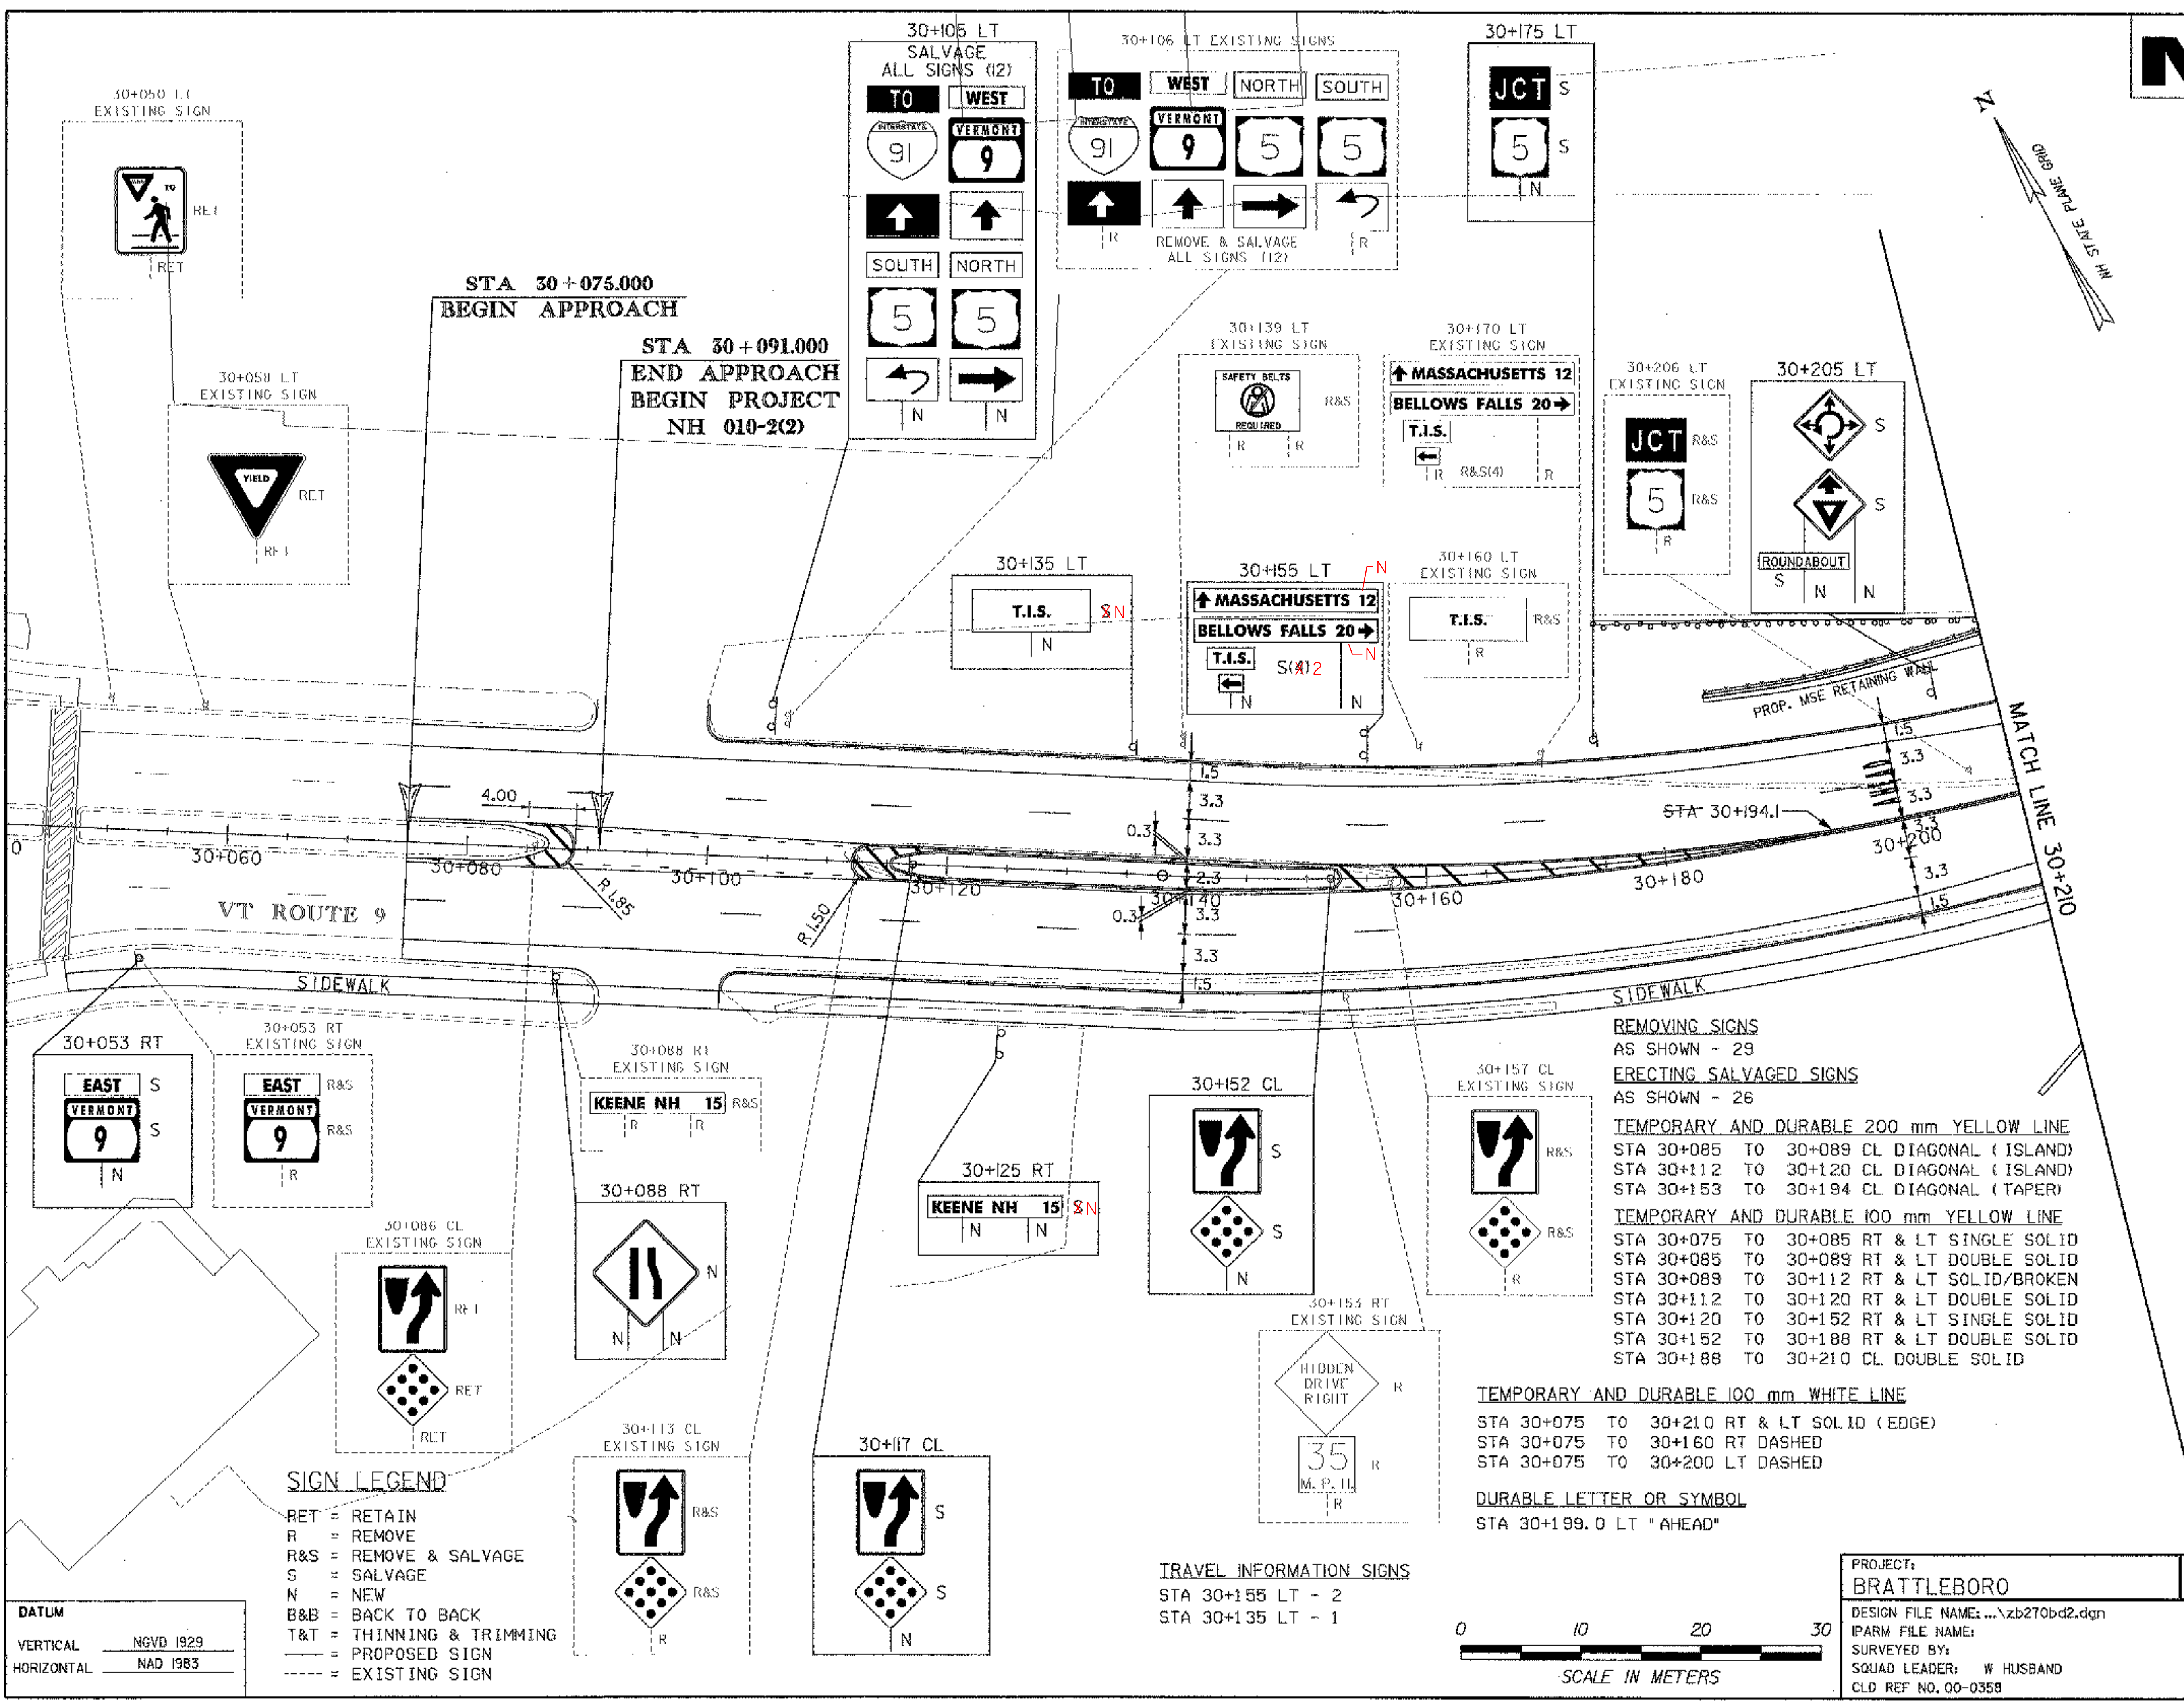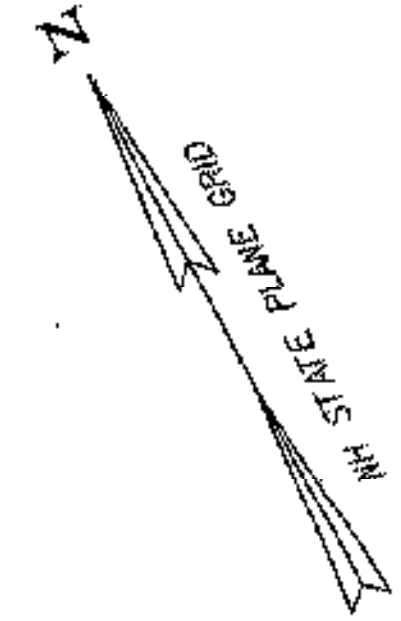

STA 30+075.000
BEGIN APPROACH

STA 30+091.000
END APPROACH
BEGIN PROJECT
NH 010-2(2)

30+105 LT
SALVAGE ALL SIGNS (12)

TO WEST	TO WEST
VERMONT 91	VERMONT 9
↑	↑
SOUTH	NORTH
5	5
↶	↷
N	N

30+106 LT EXISTING SIGNS

TO WEST	NORTH	SOUTH
VERMONT 91	VERMONT 9	5
↑	↑	→
REMOVE & SALVAGE ALL SIGNS (12)		

30+175 LT

JCT S
5 S
N

30+139 LT EXISTING SIGN

SAFETY BELTS REQUIRED
R&S

30+170 LT EXISTING SIGN

↑ MASSACHUSETTS 12
BELLOWS FALLS 20 →
T.I.S.
R&S(4)

30+206 LT EXISTING SIGN

JCT R&S
5 R&S
N

30+205 LT

ROUNDABOUT
S
N
N

30+135 LT

T.I.S.
S(N)
N

30+155 LT

↑ MASSACHUSETTS 12
BELLOWS FALLS 20 →
T.I.S.
S(N)2
N

30+160 LT EXISTING SIGN

T.I.S.
R&S

SIGN LEGEND

RET = RETAIN
 R = REMOVE
 R&S = REMOVE & SALVAGE
 S = SALVAGE
 N = NEW
 B&B = BACK TO BACK
 T&T = THINNING & TRIMMING
 --- = PROPOSED SIGN
 - - - = EXISTING SIGN

REMOVING SIGNS
AS SHOWN - 29

ERECTING SALVAGED SIGNS
AS SHOWN - 26

TEMPORARY AND DURABLE 200 mm YELLOW LINE
 STA 30+085 TO 30+089 CL DIAGONAL (ISLAND)
 STA 30+112 TO 30+120 CL DIAGONAL (ISLAND)
 STA 30+153 TO 30+194 CL DIAGONAL (TAPER)

TEMPORARY AND DURABLE 100 mm YELLOW LINE
 STA 30+075 TO 30+085 RT & LT SINGLE SOLID
 STA 30+085 TO 30+089 RT & LT DOUBLE SOLID
 STA 30+089 TO 30+112 RT & LT SOLID/BROKEN
 STA 30+112 TO 30+120 RT & LT DOUBLE SOLID
 STA 30+120 TO 30+152 RT & LT SINGLE SOLID
 STA 30+152 TO 30+188 RT & LT DOUBLE SOLID
 STA 30+188 TO 30+210 CL DOUBLE SOLID

TEMPORARY AND DURABLE 100 mm WHITE LINE
 STA 30+075 TO 30+210 RT & LT SOLID (EDGE)
 STA 30+075 TO 30+160 RT DASHED
 STA 30+075 TO 30+200 LT DASHED


DURABLE LETTER OR SYMBOL
STA 30+199.0 LT "AHEAD"

TRAVEL INFORMATION SIGNS
 STA 30+155 LT - 2
 STA 30+135 LT - 1

DATUM
 VERTICAL NGVD 1929
 HORIZONTAL NAD 1983



PROJECT: BRATTLEBORO	PROJECT NO.: NH 010-2(2)
DESIGN FILE NAME: ...zb270bd2.dgn	PLOT DATE: 09/23/2002
IPARM FILE NAME:	SURVEY DATE:
SURVEYED BY:	SQUAD LEADER: W HUSBAND
CLD REF NO. 00-0358	SHEET: 51 OF 145

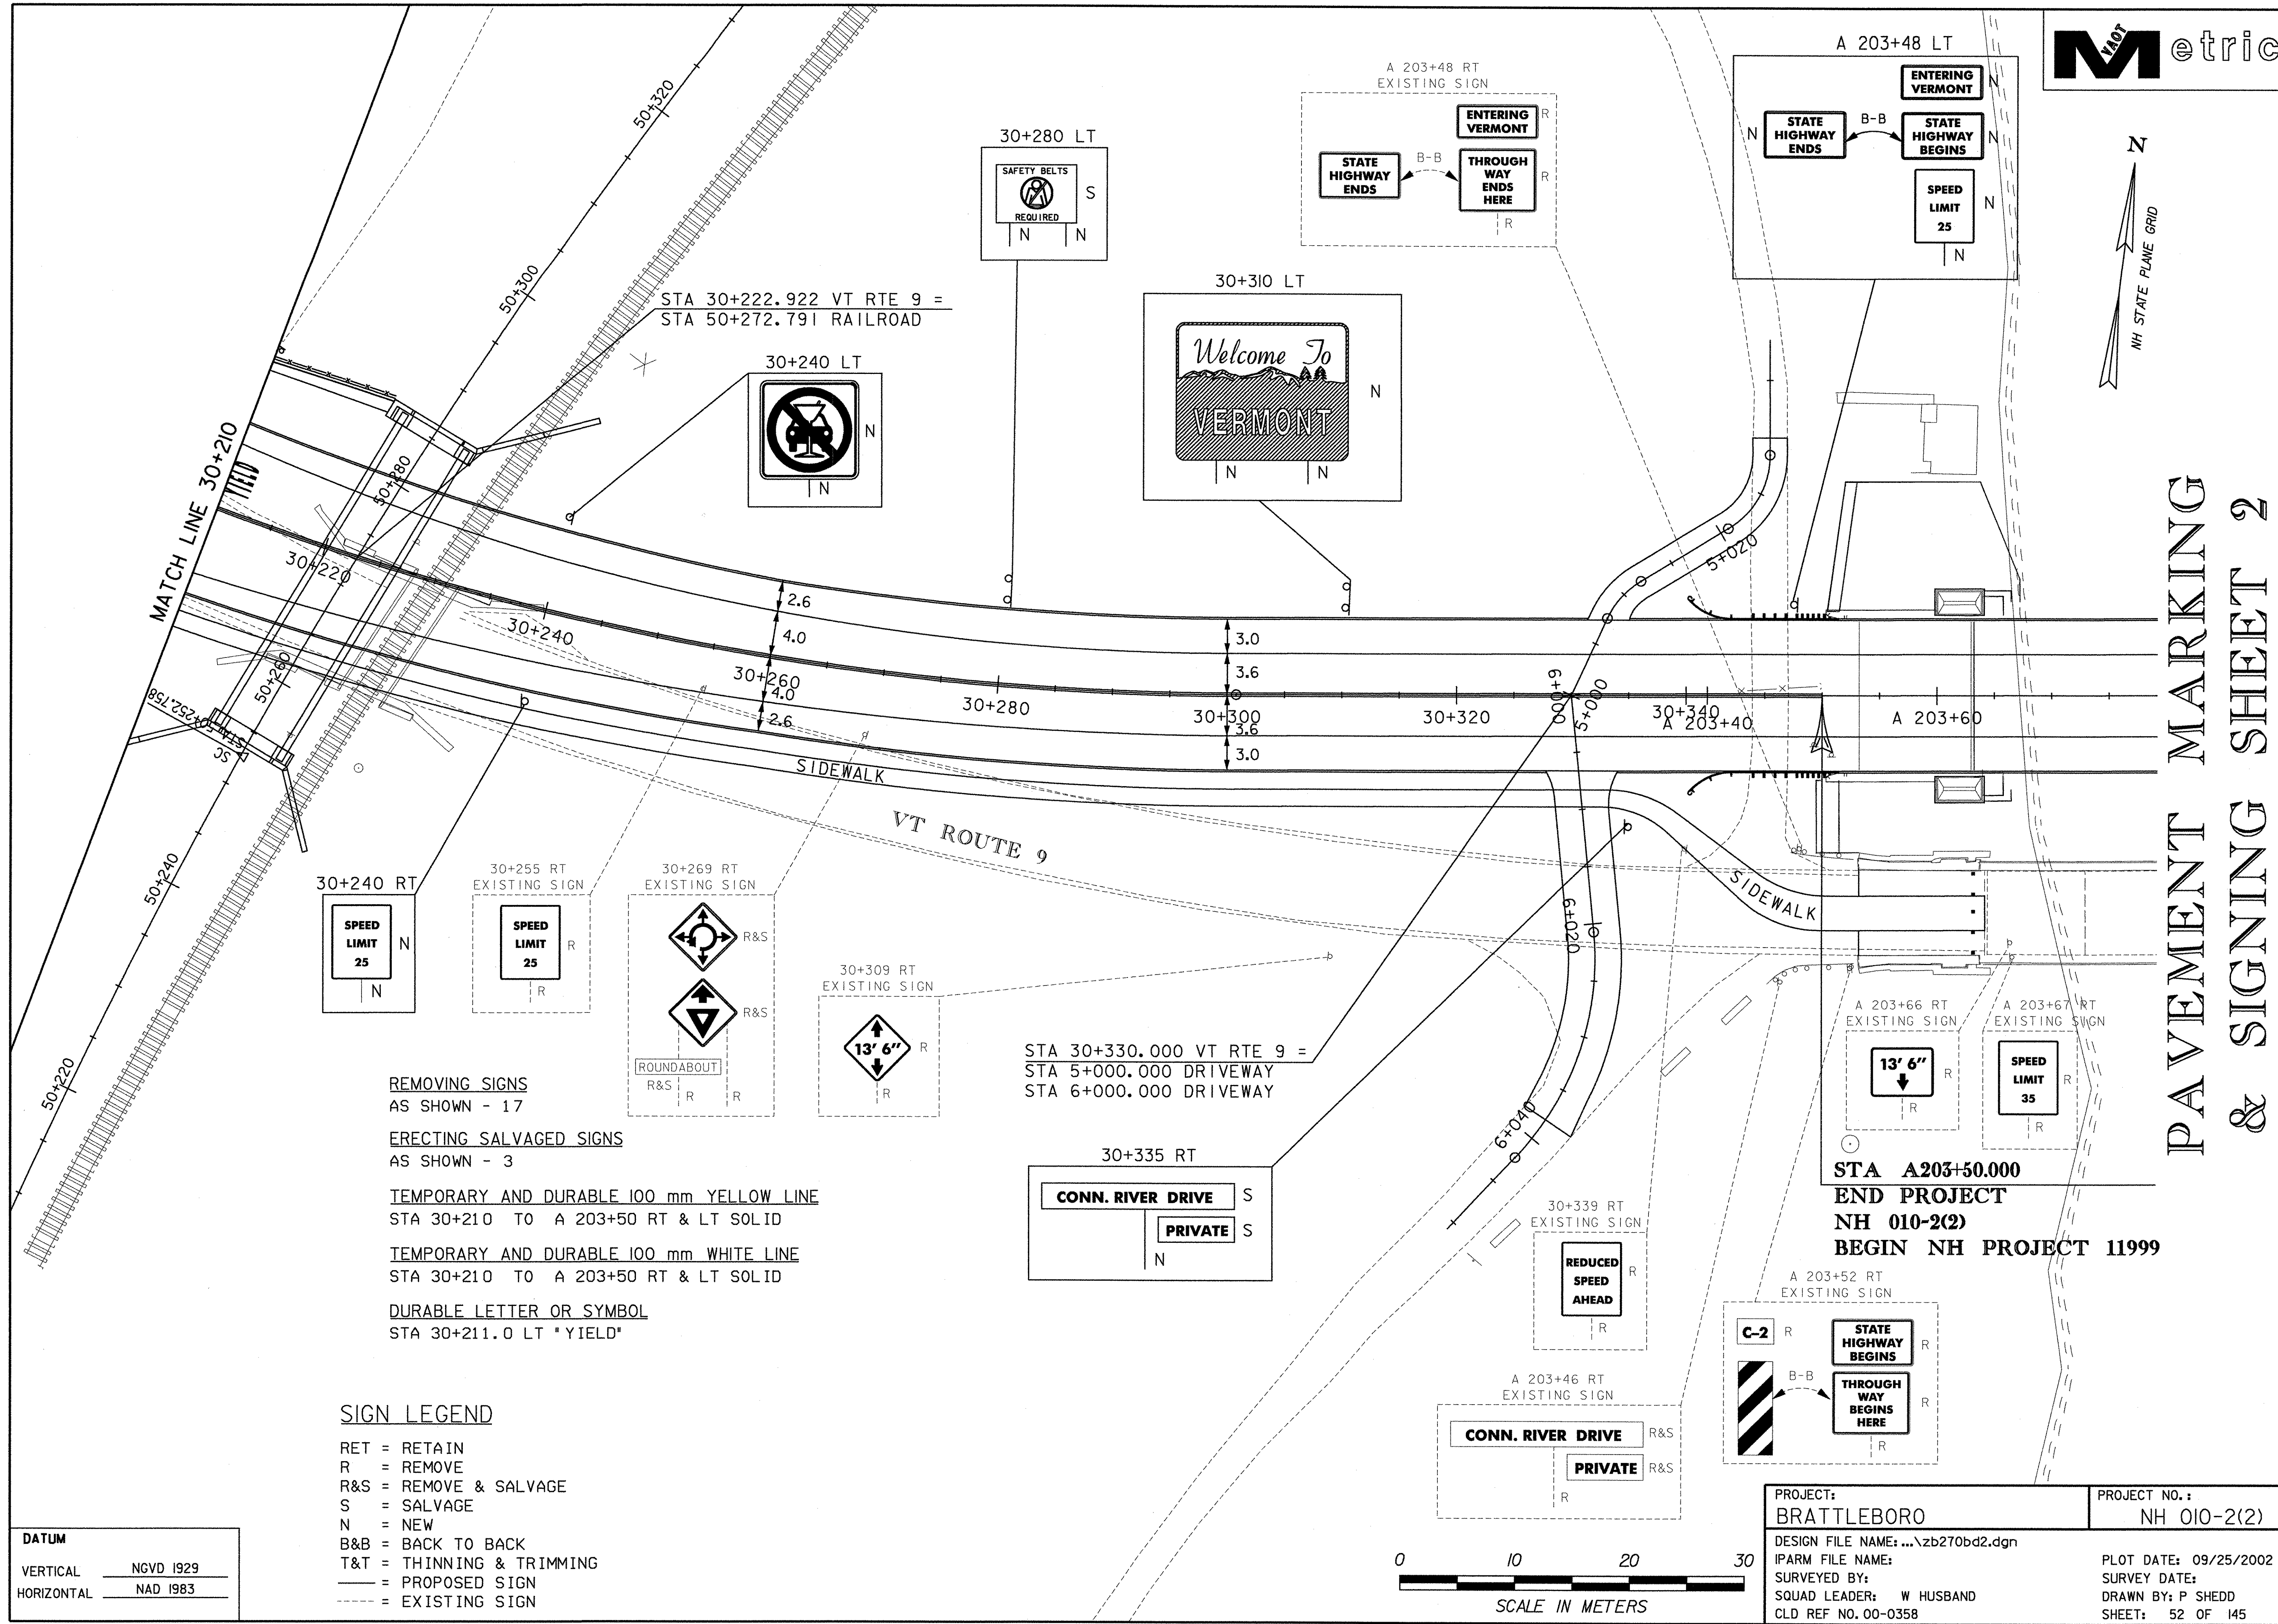

REMOVING SIGNS
AS SHOWN - 17

ERECTING SALVAGED SIGNS
AS SHOWN - 3

TEMPORARY AND DURABLE 100 mm YELLOW LINE
STA 30+210 TO A 203+50 RT & LT SOLID

TEMPORARY AND DURABLE 100 mm WHITE LINE
STA 30+210 TO A 203+50 RT & LT SOLID

DURABLE LETTER OR SYMBOL
STA 30+211.0 LT "YIELD"

SIGN LEGEND


- RET = RETAIN
- R = REMOVE
- R&S = REMOVE & SALVAGE
- S = SALVAGE
- N = NEW
- B&B = BACK TO BACK
- T&T = THINNING & TRIMMING
- = PROPOSED SIGN
- - - = EXISTING SIGN

DATUM	
VERTICAL	NGVD 1929
HORIZONTAL	NAD 1983




PROJECT: BRATTLEBORO	PROJECT NO. : NH 010-2(2)
DESIGN FILE NAME: ...zb270bd2.dgn	PLOT DATE: 09/25/2002
IPARM FILE NAME:	SURVEY DATE:
SURVEYED BY:	DRAWN BY: P SHEDD
SQUAD LEADER: W HUSBAND	SHEET: 52 OF 145
CLD REF NO. 00-0358	

2

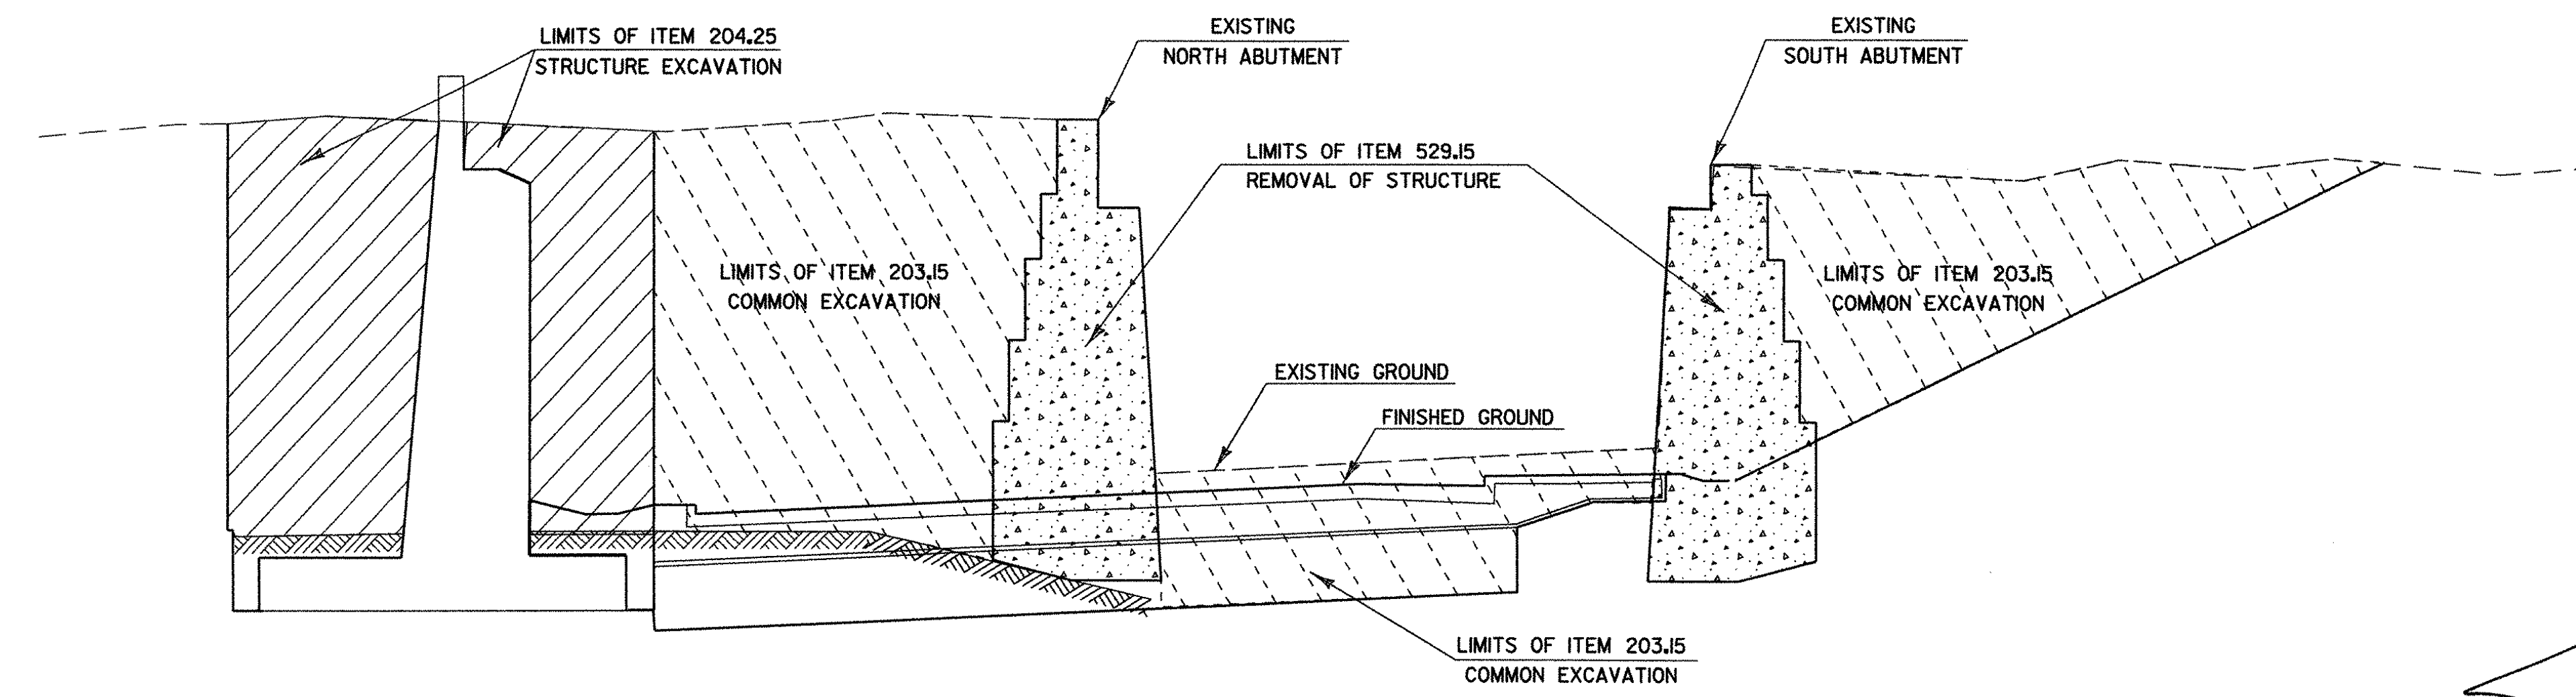

TYPICAL EXCAVATION LIMITS

NOT TO SCALE

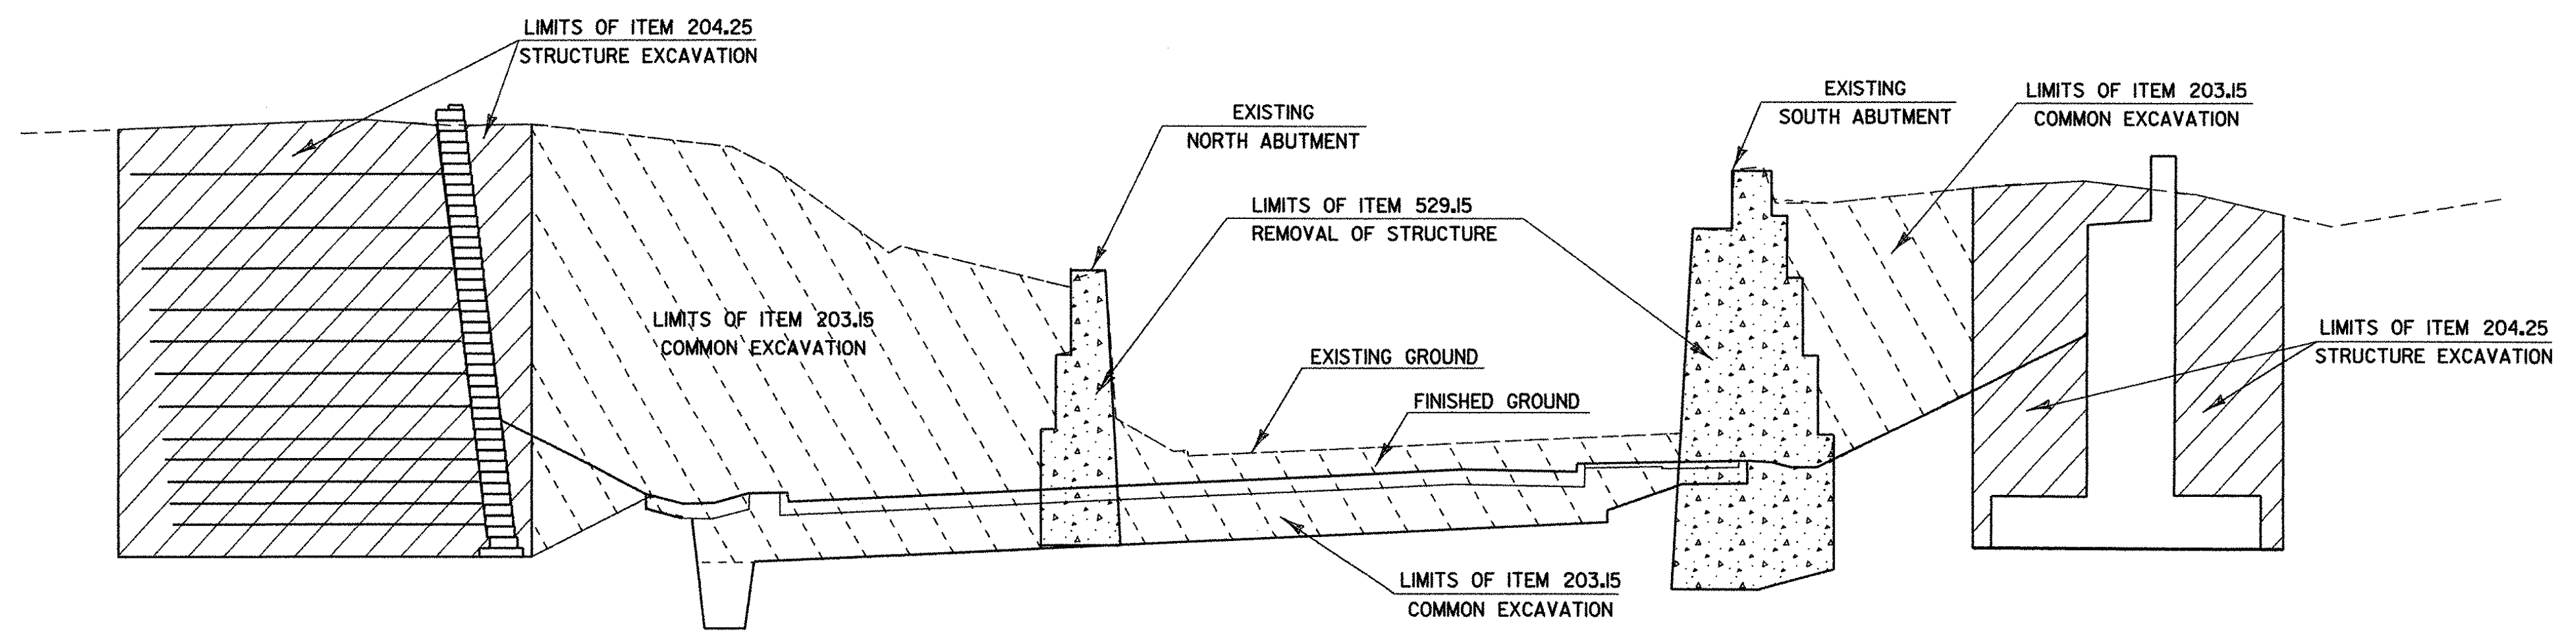

2 Addendum Two, New sheet, Removal / Excavation Limits Dec 6, 2002

PROJECT NAME:	BRATTLEBORO
PROJECT NUMBER:	NH_BRE_012-1(33)
FILE NAME:	\\BRAI_CHANGES.DGN
PROJECT MANAGER:	
DESIGNED BY:	
PLOT DATE:	04-DEC-2002
DRAWN BY:	G.BOKES
CHECKED BY:	
SHEET	_53_ OF 145

KILOMETER MARKER, STATION, OR SIGN NUMBER	SIGN LEGEND	SIGN DIMENSIONS		NEW & SALVAGED SIGNS				EXISTING POSTS REMAINING	NO. OF POSTS	NEW SIGN POSTS																REMARKS	SIGN DETAIL			
		EA	WIDTH (mm)	HEIGHT (mm)	"A"	"B"	SALV SIGN			SALV TIS	FLANGED CHANNEL			SQUARE STEEL (mm)			TUBULAR ALUMINUM (mm)			TUBULAR STEEL (mm)			W-SHAPE STEEL				DETAIL ON SHEET NUMBER	STD. SHEET NUMBER		
											1.7	3.0	4.5	44	50	63	75	100	100 MOD	75	89	100	125	FTG. SIZE					WEIGHT	POST SIZE
30+053 RT	EAST						1		1																			SEE STD E-123M		
							1																							
30+086 CL		1	600	750	0.45																									
		1	450	450	0.20																									
30+088 RT		1	900	900	0.81					2																				E-151M
30+105 LT	TO WEST						2		2												2	X								SEE STD E-123M
							2																							
							2																							
	SOUTH NORTH						2																							
							2																							
							2																							
30+117 CL							1		1																					
							1																							
30+125 RT	KEENE NH 15	1	1350	190	0.26		X		2																					SEE STD E-123M
							0																							

FINAL POST LENGTHS ARE TO BE DETERMINED IN THE FIELD. POST SIZES ARE COMPUTED BASED ON INFORMATION FURNISHED ON THE STANDARD SHEETS AND THE TRAFFIC & SAFETY DIVISION'S "SIGN POST DESIGN GUIDELINE."

SHEET TOTALS

m ²	m ²	EA.	m ²	EA.	m	m	EA.	kg	kg	kg	kg	kg	kg	kg	EA.	kg	EA.	EA.	kg
0.81	17.16	17	16	17	64.5	26.84	2	61.0											



PROJECT : BRATTLEBORO	PROJECT NO. : NH 010-2(2)
DESIGN FILE NAME: ...zb270frm.dgn	PLOT DATE: 09/20/2002
IPARM FILE NAME: -	SURVEY DATE: -
SURVEYED BY: -	DRAWN BY: P SHEDD
SQUAD LEADER: W HUSBAND	SHEET: 54 OF 145
CLD REF NO. 00-0358	

KILOMETER MARKER, STATION, OR SIGN NUMBER	SIGN LEGEND	SIGN DIMENSIONS		NEW & SALVAGED SIGNS				EXIST POST RETAIN	NO. OF POSTS	NEW SIGN POSTS												REMARKS	SIGN DETAIL						
		E	A	WIDTH (mm)	HEIGHT (mm)	"A"	"B"			SALV SIGN	SALV TIS	FLANGED CHANNEL			SQUARE STEEL (mm)			TUBULAR ALUMINUM (mm)			TUBULAR STEEL (mm)				W-SHAPE STEEL		DETAIL ON SHEET NUMBER	STD. SHEET NUMBER	
												1.7	3.0	4.5	44	50	63	75	100	100 MOD.	FOUNDATION		75	89	100	125			FTG. SIZE
30+135 LT		1	1800	200				0.36			X															SEE STD E-125M			
30+152 CL							1		1		X																		
							1																						
30+155 LT		1	1524	190	0.29		X		2		X																SEE STD E-123M		
		1	1524	190	0.29		X																				SEE STD E-123M		
							1	0.36																			SEE STD E-125M		
							1	0.09																			SEE STD E-125M		
30+175 LT							1		1		X																SEE STD E-123M		
							1																						
30+205 LT							1		2		X																		
							1																						
							1																						

FINAL POST LENGTHS ARE TO BE DETERMINED IN THE FIELD. POST SIZES ARE COMPUTED BASED ON INFORMATION FURNISHED ON THE STANDARD SHEETS AND THE TRAFFIC & SAFETY DIVISION'S "SIGN POST DESIGN GUIDELINE."										m	m	m	m	m	m	EA	kg	kg	kg	kg	kg	kg	kg	kg	EA.	EA.	kg
										82.4																	
SHEET TOTALS			m ²	m ²	EA.	m ²				m							kg	EA.	kg	EA.	EA.	kg					
			0.94		9	0.81				32.33																	

PROJECT : BRATTLEBORO	PROJECT NO. : NH 010-2(2)
DESIGN FILE NAME: ...z270frm.dgn	PLOT DATE: 09/20/2002
IPARM FILE NAME: -	SURVEYED BY:
SQUAD LEADER: W HUSBAND	DRAWN BY: P SHEDD
CLD REF NO. 00-0358	SHEET: 55 OF 145

KILOMETER MARKER, STATION, OR SIGN NUMBER	SIGN LEGEND	SIGN DIMENSIONS		NEW & SALVAGED SIGNS				EXIST POST NO. OF POSTS	NEW SIGN POSTS												REMARKS	SIGN DETAIL							
		EA	WIDTH (mm)	HEIGHT (mm)	"A"	"B"	SALV SIGN		SALV TIS	FLANGED CHANNEL			SQUARE STEEL (mm)			TUBULAR ALUMINUM (mm)			TUBULAR STEEL (mm)			W-SHAPE STEEL			DETAIL ON SHEET NUMBER	STD. SHEET NUMBER			
										1.7	3.0	4.5	44	50	63	75	100	100 MOD	75	89		100	125	600			750	WEIGHT	POST SIZE
30+240 LT		1	600	600	0.36			1	X																	E-143M			
30+240 RT		1	600	750	0.45			1	X																	E-142M			
30+280 LT							1	2		X																			
30+310 LT		1	750	600	0.45			2		X																11			
30+335 RT							1	1		X																			
							1																						
A 203+48 LT		1	600	325	0.20			1		X														BACK TO BACK	11				
		1	600	450	0.27																					E-141M			
		1	600	450	0.27																								
		1	600	750	0.45																					E-142M			
SUBTOTAL THIS SHEET						2.45																							
SUBTOTAL SHEET 54						0.81					39.6	58.2																	
SUBTOTAL SHEET 55						1.72					19.8	44.7																	
						0.94					---	82.4																	
FINAL POST LENGTHS ARE TO BE DETERMINED IN THE FIELD. POST SIZES ARE COMPUTED BASED ON INFORMATION FURNISHED ON THE STANDARD SHEETS AND THE TRAFFIC & SAFETY DIVISION'S "SIGN POST DESIGN GUIDELINE."																													
	PROJECT TOTALS	m ²	5.11	3.26	m ²		EA.	28	29	0.81																			
		m			m																								
		m			m																								
		EA.			EA.																								
		kg			kg																								
		EA.			EA.																								
		kg			kg																								
		PROJECT :	BRATTLEBORO										PROJECT NO. :	NH 010-2(2)															
		DESIGN FILE NAME :	...zsb270frm.dgn										PLOT DATE: 09/20/2002																
		IPARM FILE NAME :	-										SURVEY DATE:																
		SURVEYED BY :	-										DRAWN BY: P SHEDD																
		SQUAD LEADER :	W HUSBAND										SHEET: 56 OF 145																
		CLD REF NO. 00-0358																											

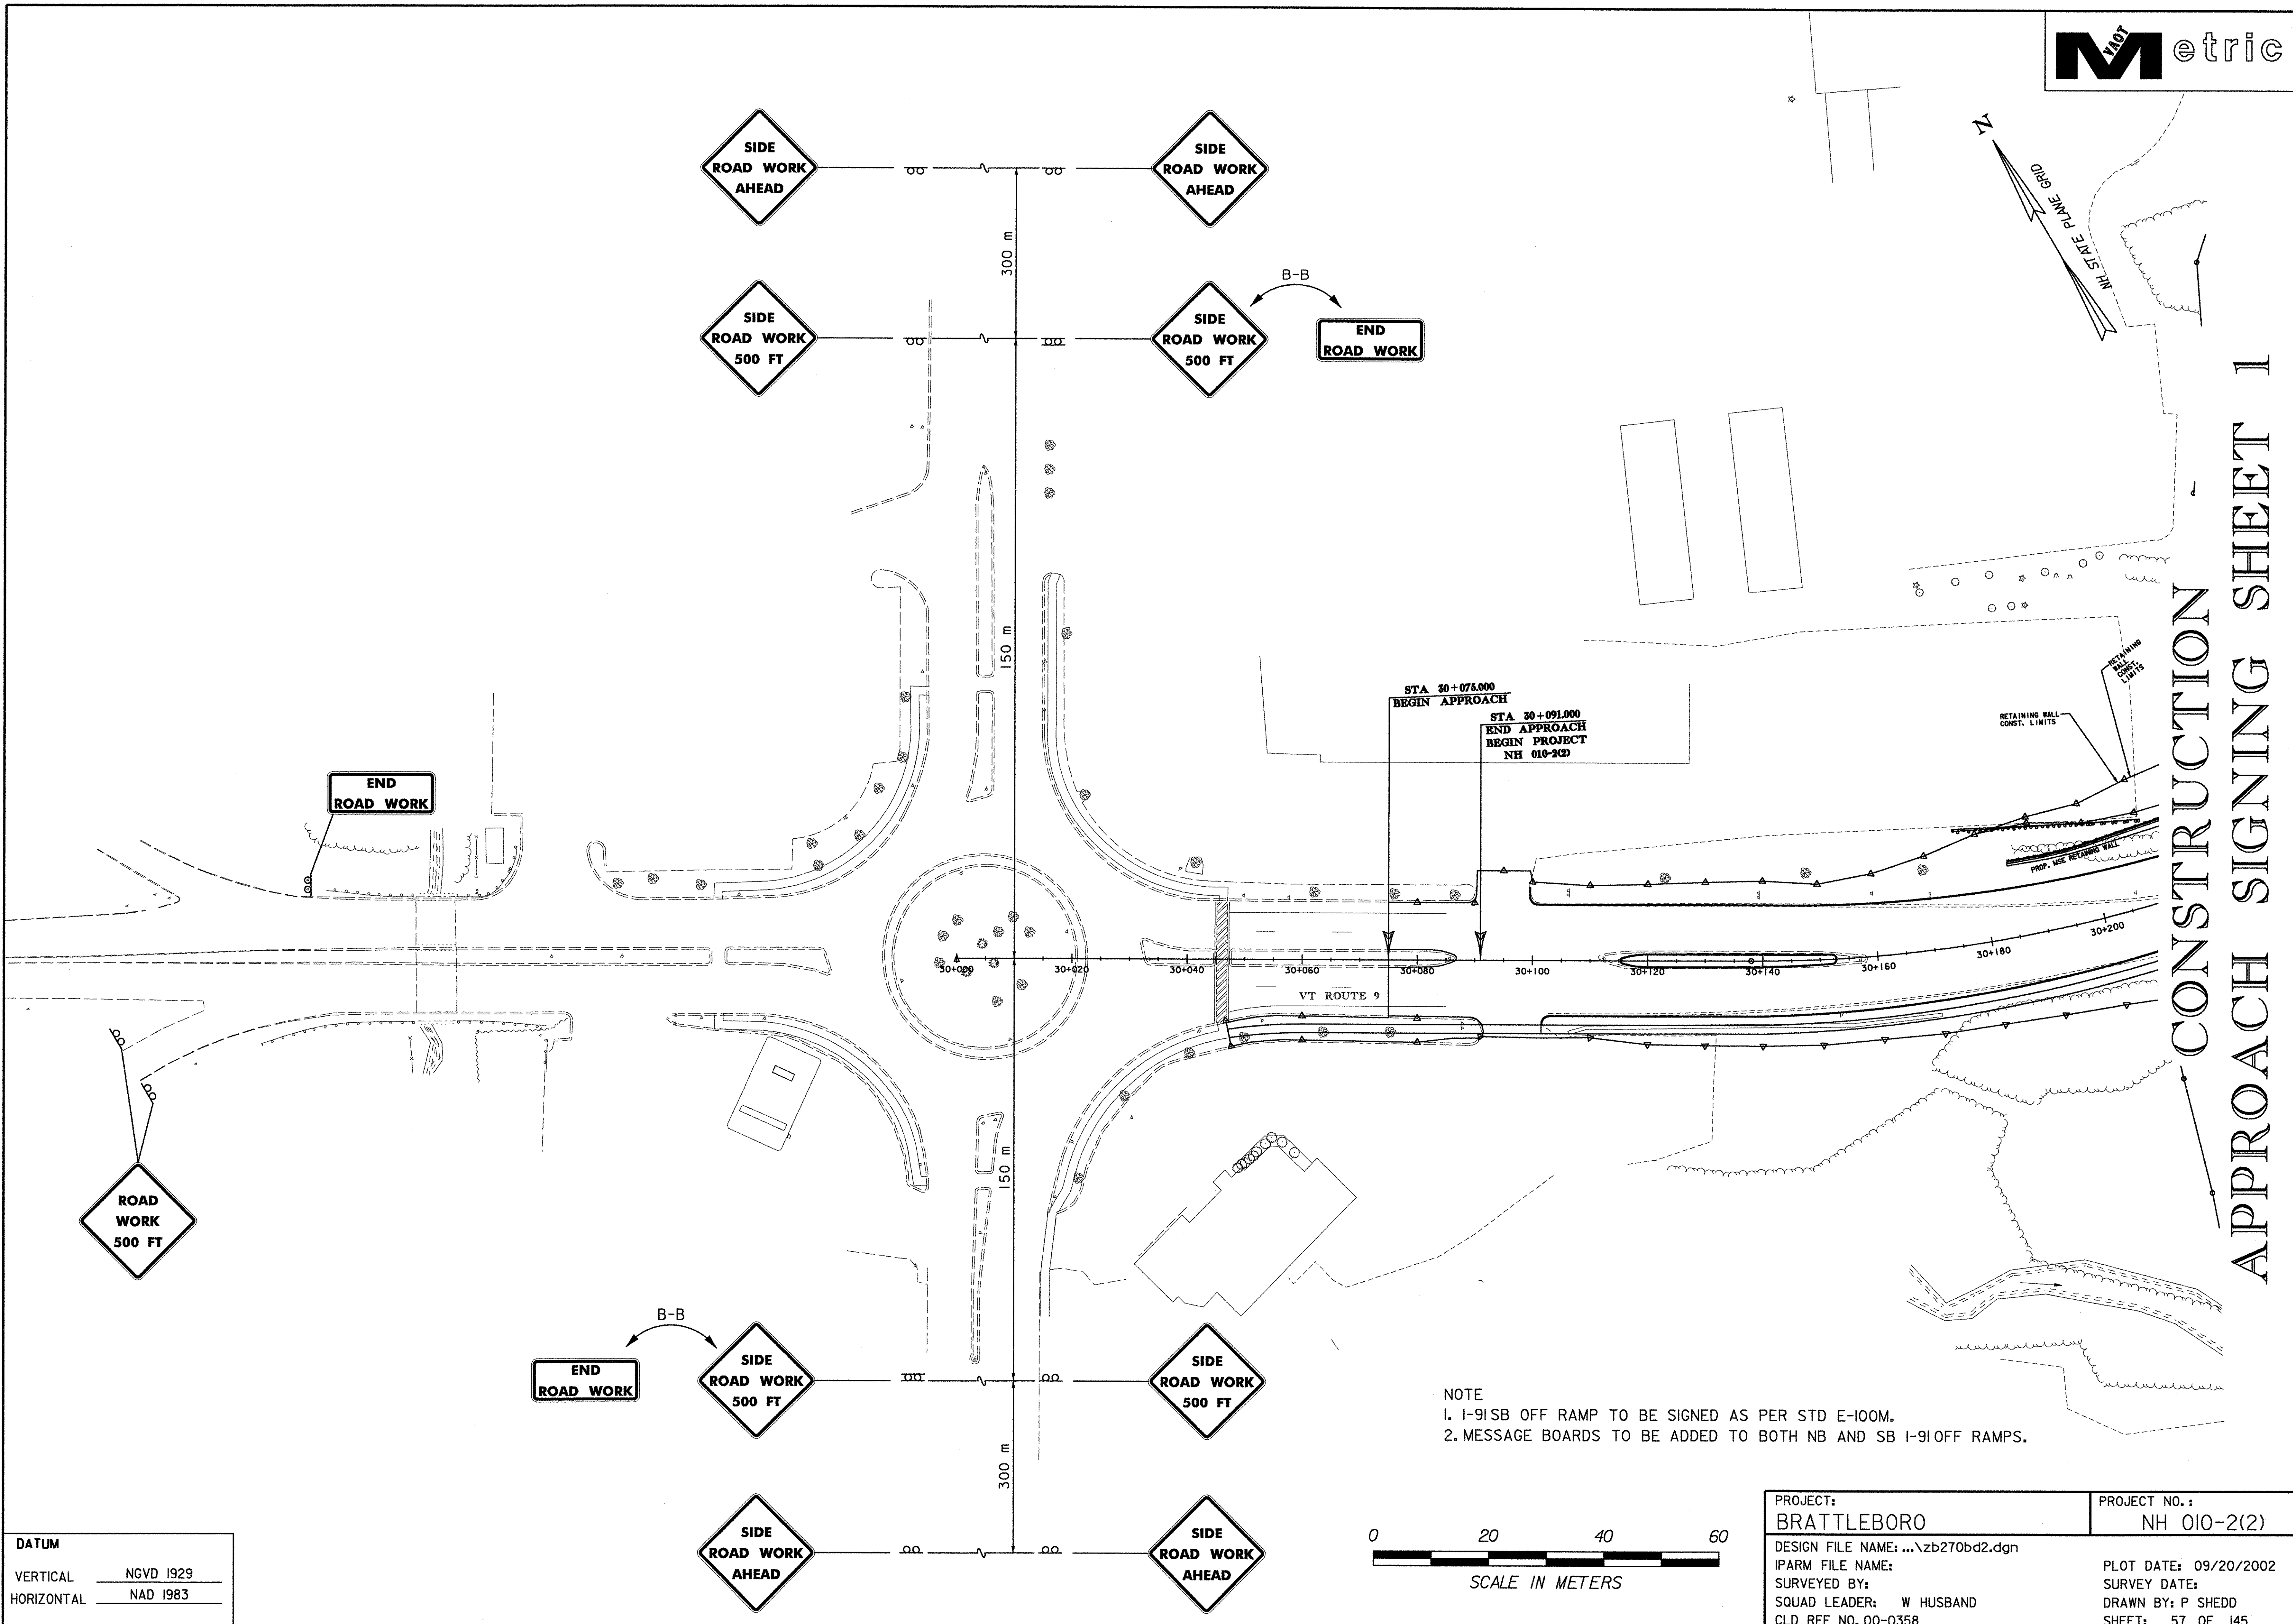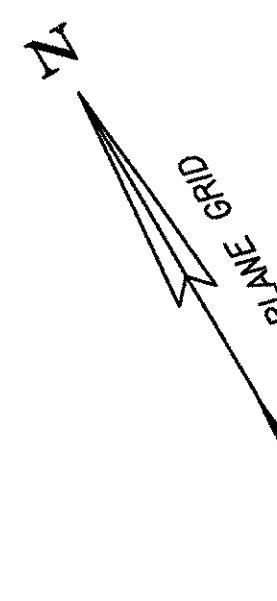


CONSTRUCTION SIGNING SHEET 1
APPROACH SIGNING SHEET 1

NOTE
 1. I-91SB OFF RAMP TO BE SIGNED AS PER STD E-100M.
 2. MESSAGE BOARDS TO BE ADDED TO BOTH NB AND SB I-91 OFF RAMP.

DATUM	
VERTICAL	NGVD 1929
HORIZONTAL	NAD 1983



PROJECT: BRATTLEBORO	PROJECT NO.: NH 010-2(2)
DESIGN FILE NAME: ... \zb270bd2.dgn	PLOT DATE: 09/20/2002
IPARM FILE NAME:	SURVEY DATE:
SURVEYED BY:	DRAWN BY: P SHEDD
SQUAD LEADER: W HUSBAND	SHEET: 57 OF 145
CLD REF NO. 00-0358	

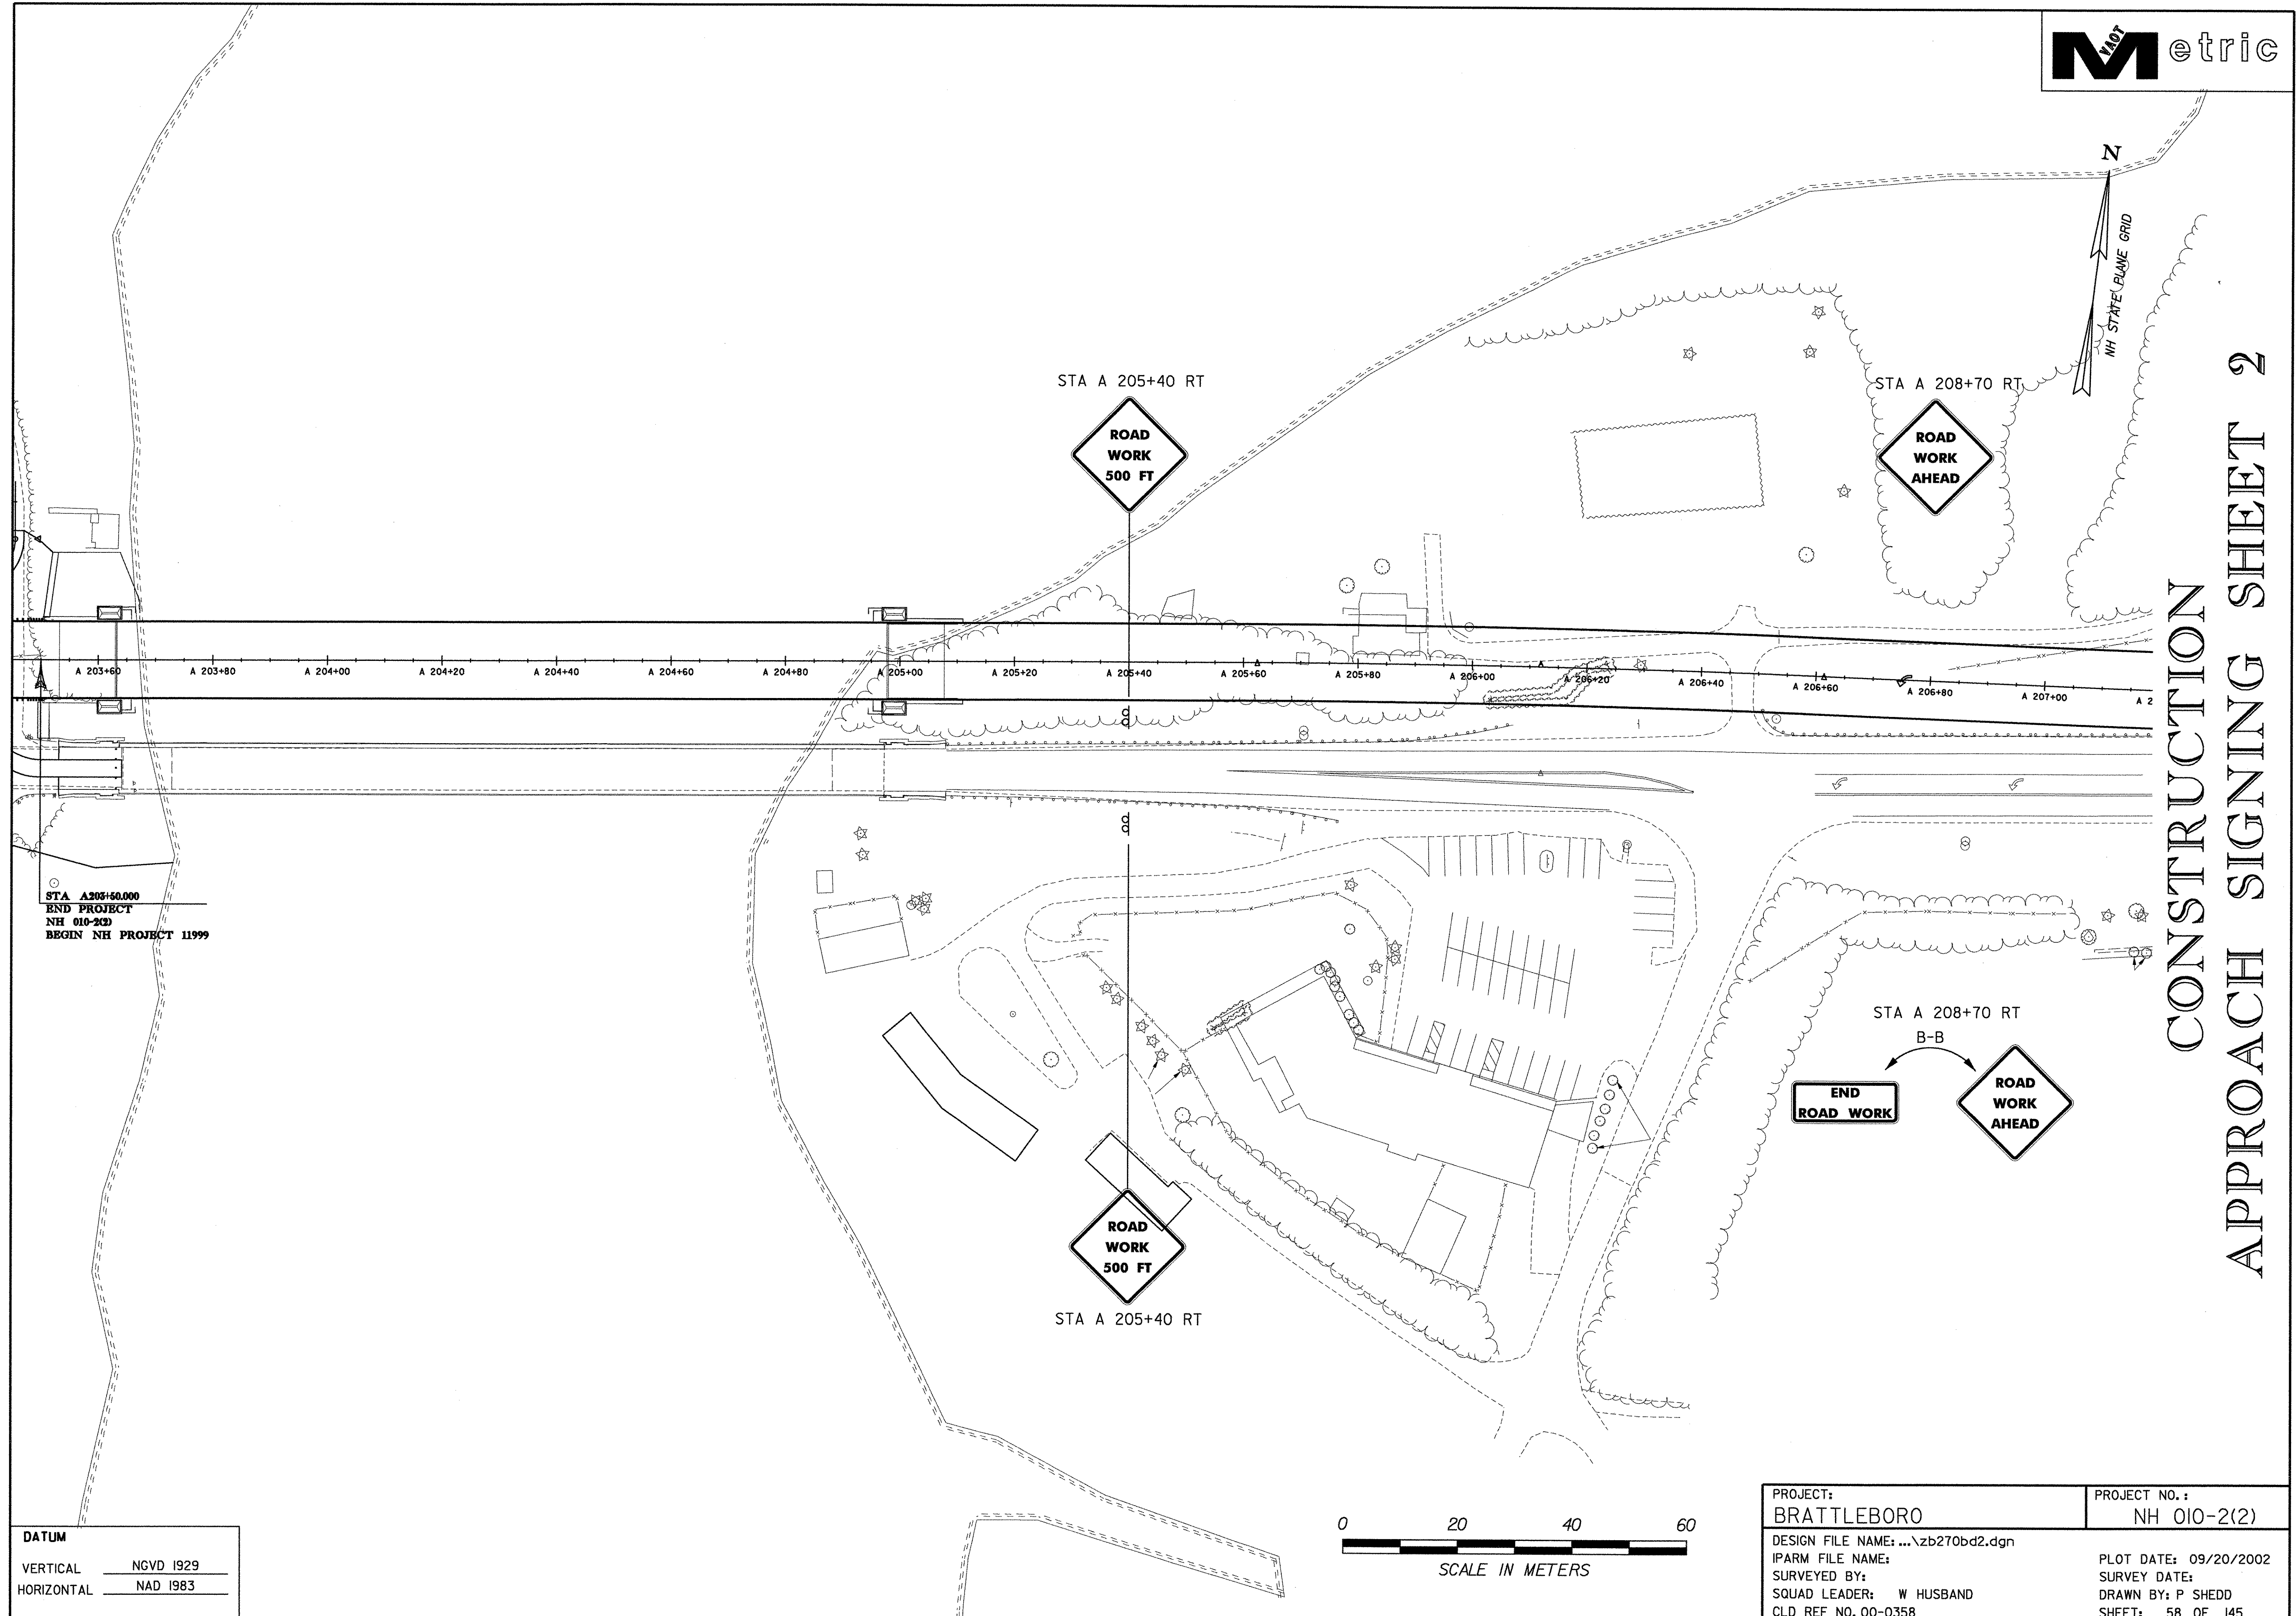

STA A 205+60.000
 END PROJECT
 NH 010-2(2)
 BEGIN NH PROJECT 11999

DATUM	
VERTICAL	NGVD 1929
HORIZONTAL	NAD 1983



PROJECT: BRATTLEBORO	PROJECT NO.: NH 010-2(2)
DESIGN FILE NAME: ...zb270bd2.dgn	PLOT DATE: 09/20/2002
IPARM FILE NAME:	SURVEY DATE:
SURVEYED BY:	DRAWN BY: P SHEDD
SQUAD LEADER: W HUSBAND	SHEET: 58 OF 145
CLD REF NO. 00-0358	

CONSTRUCTION APPROACH SIGNING SHEET 2

SOIL CLASSIFICATION

AASHTO

A1	Gravel and Sand
A2	Fine Sand
A2	Silty or Clayey Gravel and Sand
A4	Silty Soil - Low Compressibility
A5	Silty Soil - Highly Compressible
A6	Clayey Soil - Low Compressibility
A7	Clayey Soil - Highly Compressible

ROCK QUALITY DESIGNATION

R.Q.D. (%)	ROCK DESCRIPTION
<25	Very Poor
25 to 50	Poor
51 to 75	Fair
76 to 90	Good
>90	Excellent

SHEAR STRENGTH

UNDRAINED SHEAR STRENGTH IN kPa	CONSISTENCY
<12	Very Soft
12-24	Soft
24-48	Med. Stiff
48-96	Stiff
96-192	Very Stiff
>192	Hard

CORRELATION GUIDE OF "N" TO DENSITY/CONSISTENCY

DENSITY (GRANULAR SOILS)		CONSISTENCY (COHESIVE SOILS)	
N	DESCRIPTIVE TERM	N	DESCRIPTIVE TERM
<5	Very Loose	<2	Very Soft
5-10	Loose	2-4	Soft
11-24	Med. Dense	5-8	Med. Stiff
25-50	Dense	9-15	Stiff
>50	Very Dense	16-30	Very Stiff
		31-60	Hard
		>60	Very Hard

COMMONLY USED SYMBOLS


- ▼ Water Elevation
- ⊕ Standard Penetration Boring
- ⊕ Auger Boring
- Rod Sounding
- S Sample
- N Standard Penetration Test
- Blow Count Per 300 mm For:
 - 50.8 mm O. D. Sampler
 - 35.0 mm I. D. Sampler
 - Hammer Weight Of 63.5 kg.
 - Hammer Fall Of 762 mm
- VS Field Vane Shear Test
- US Undisturbed Soil Sample
- B Blast
- DC Diamond Core
- MD Mud Drill
- WA Wash Ahead
- HSA Hollow Stem Auger
- AX Core Size 30.1 mm
- BX Core Size 42.0 mm
- NX Core Size 54.7 mm
- M Double Tube Core Barrel Used
- LL Liquid Limit
- PL Plastic Limit
- PI Plasticity Index
- NP Non Plastic
- w Moisture Content (Dry Wgt. Basis)
- D Dry
- M Moist
- MTW Moist To Wet
- W Wet
- Sat Saturated
- Bo Boulder
- Gr Gravel
- Sa Sand
- Si Silt
- Cl Clay
- HP Hardpan
- Le Ledge
- NLTD No Ledge To Depth
- CNPF Can Not Penetrate Further
- TLOB To Ledge Or Boulder
- NR No Recovery
- Rec. Recovery
- %Rec. Percent Recovery
- RQD Rock Quality Designation
- CBR California Bearing Ratio
- < Less Than
- > Greater Than
- R Refusal (N > 100)

COLOR


blk	Black	pnk	Pink
bl	Blue	pu	Purple
brn	Brown	rd	Red
dk	Dark	tn	Tan
gry	Gray	wh	White
gn	Green	yel	Yellow
lt	Light	mltc	Multicolored
or	Orange		

DEFINITIONS (AASHTO)

- BEDROCK (LEDGE)** - Rock in its native location of indefinite thickness.
- BOULDER** - A rock fragment with an average dimension > 304.8 mm.
- COBBLE** - Rock fragments with an average dimension between 76.2 and 304.8 mm.
- GRAVEL** - Rounded particles of rock < 76.2 mm and > 2 mm (*10 sieve).
- SAND** - Particles of rock < 2 mm (*10 sieve) and > 75 μm (*200 sieve).
- SILT** - Soil < 75 μm (*200 sieve), non or slightly plastic and exhibits no strength when air-dried.
- CLAY** - Fine grained soil, exhibits plasticity when moist and considerable strength when air-dried.
- VARVED** - Alternate layers of silt and clay.
- HARDPAN** - Extremely dense soil, cemented layer, not softened when wet.
- MUCK** - Soft organic soil (containing > 10% organic material).
- MOISTURE CONTENT** - Weight of water divided by dry weight of soil.
- FLOWING SAND** - Granular soil so saturated (loose) that it flows into drill casing during extraction of wash rod.
- STRIKE** - Angle from magnetic north to line of intersection of bed with a horizontal plane.
- DIP** - Inclination of bed with a horizontal plane.

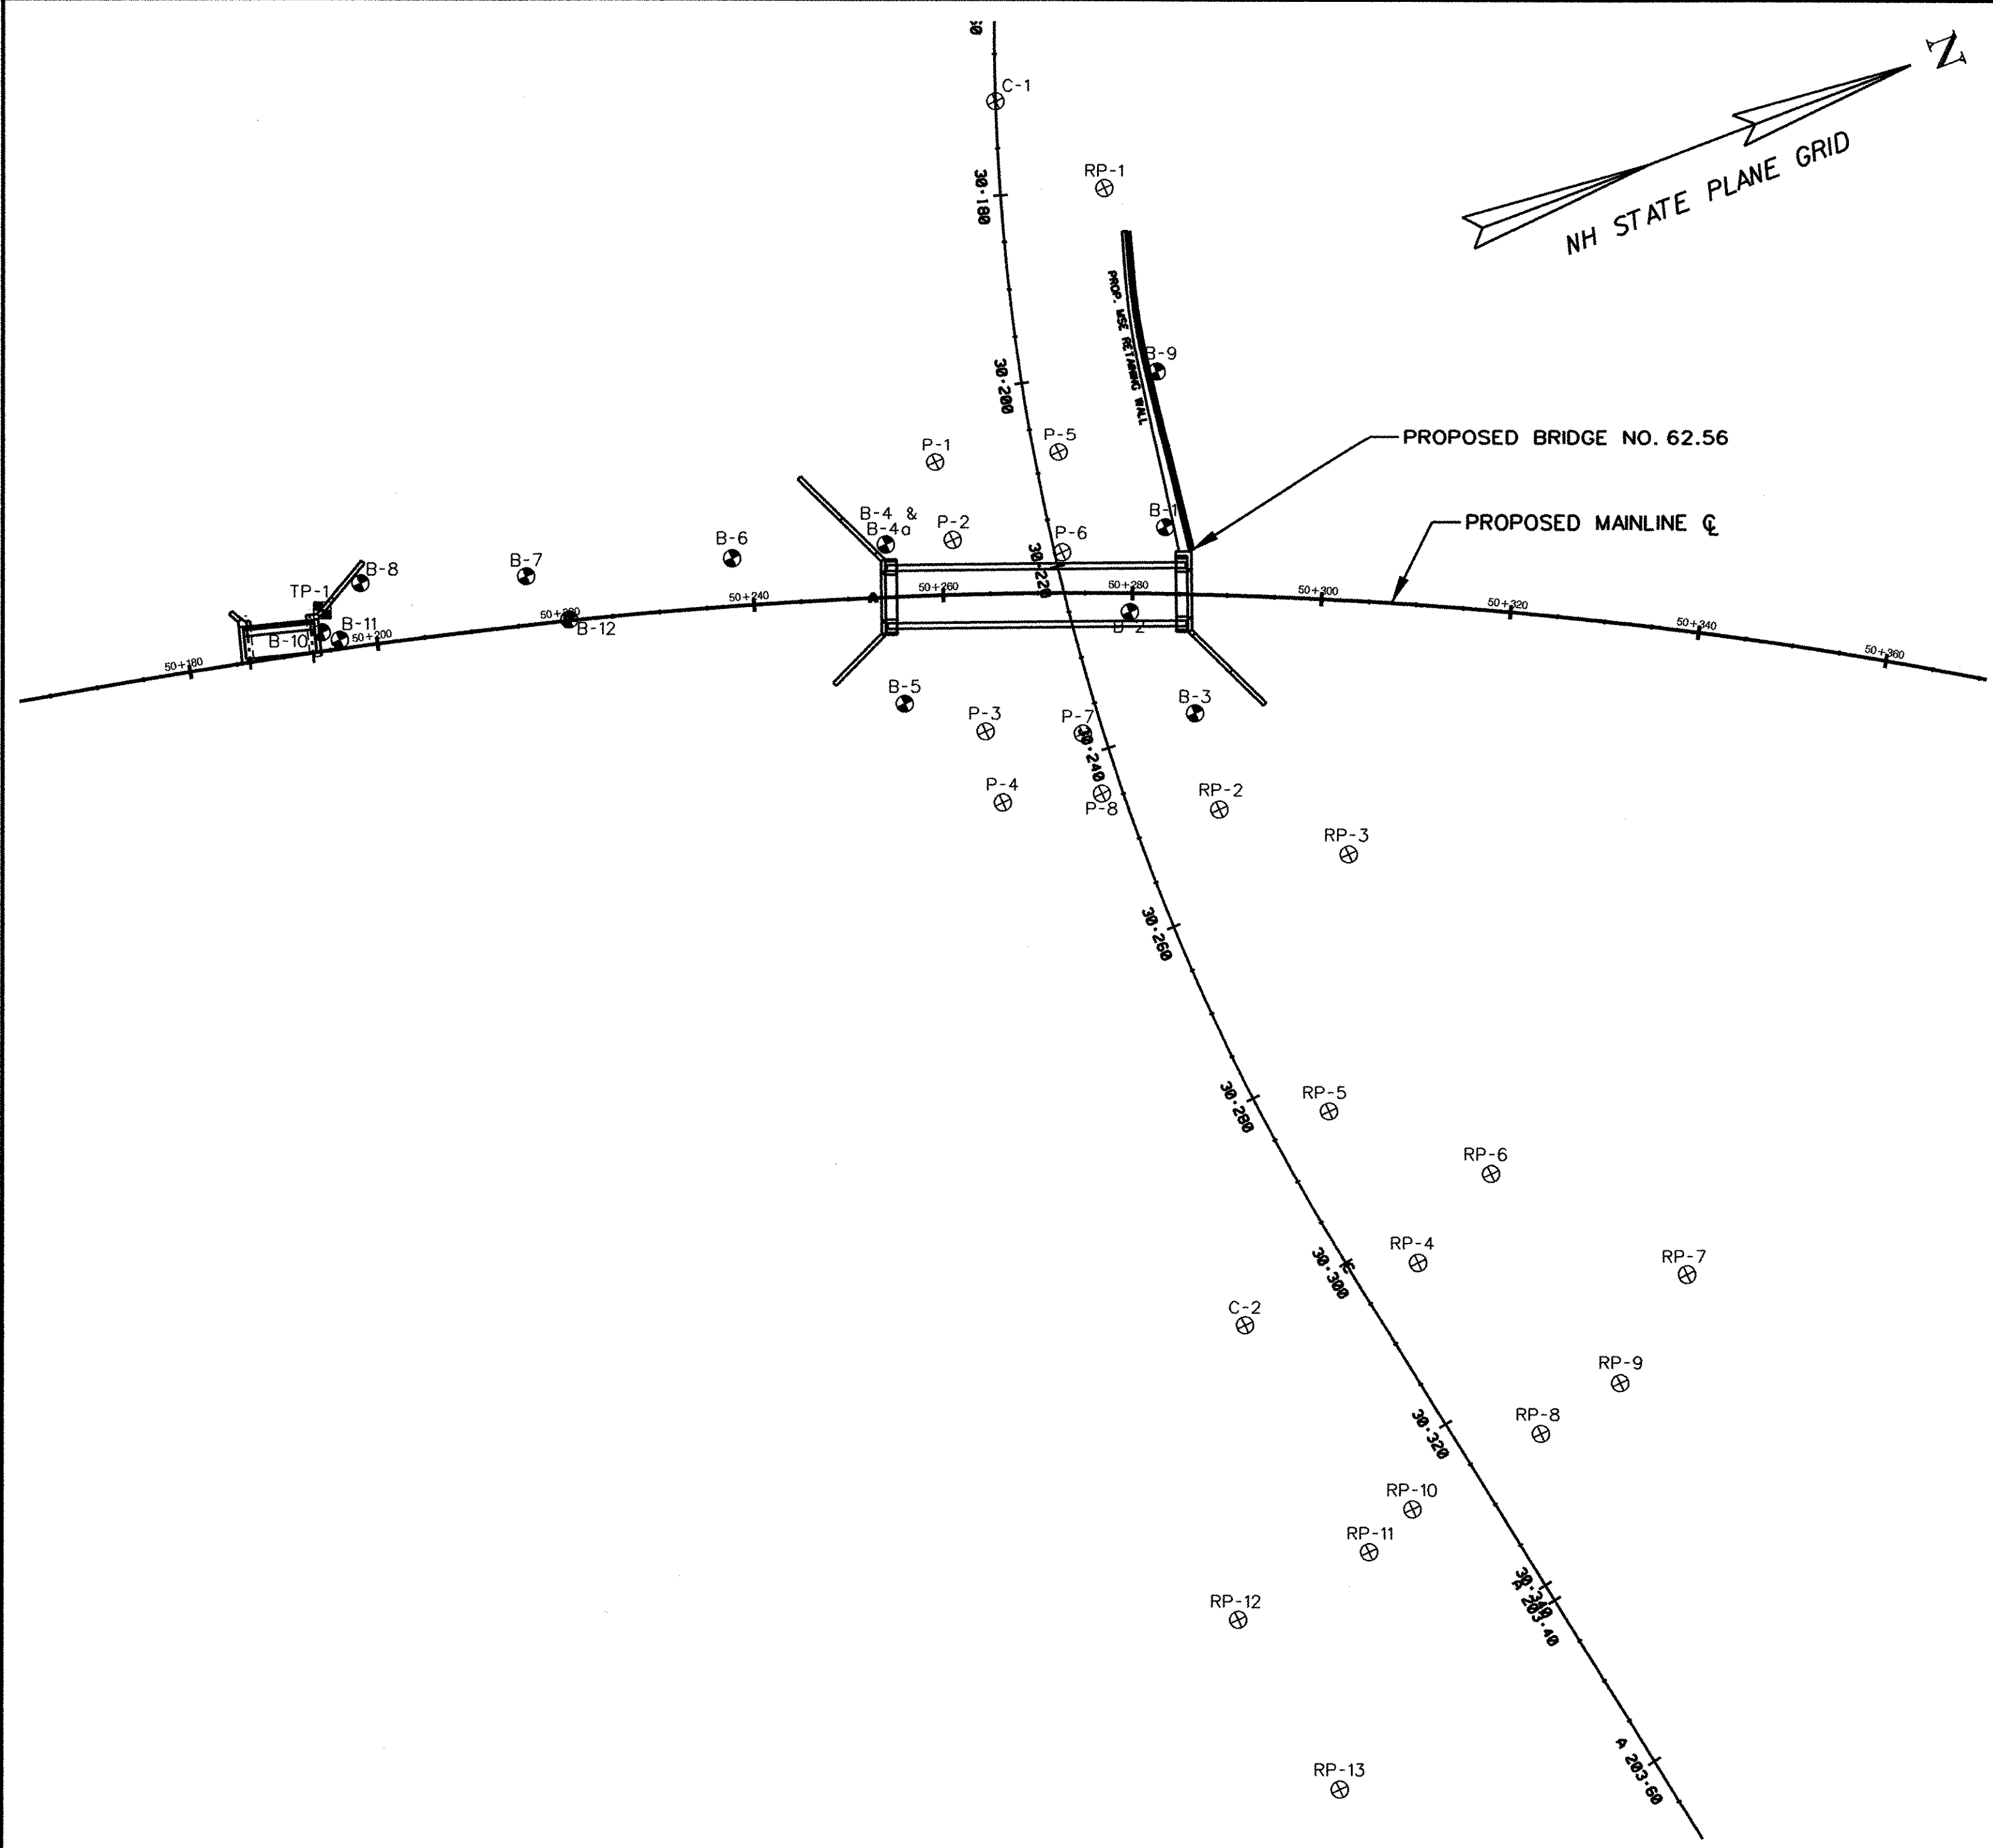

BORING LAYOUT

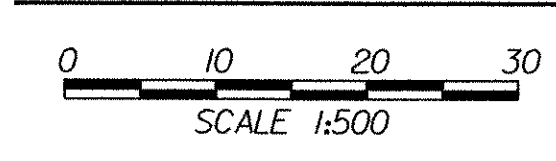

BORING CHART

HOLE NO.	STATION	OFFSET (M)	GROUND ELEV.
B-1	RR 50+283.34	7.02 LT	87.866
B-2	RR 50+279.71	1.95 RT	87.878
B-3	RR 50+286.84	12.59 RT	87.554
B-4	RR 50+254.16	5.72 LT	84.774
B-4A	RR 50+254.16	5.72 LT	84.774
B-5	RR 50+255.41	11.22 RT	86.720
B-6	RR 50+238.02	5.27 LT	83.876
B-7	RR 50+216.39	5.43 LT	84.213
B-8	RR 50+199.06	6.87 LT	84.106
B-9	RR 50+282.28	23.79 LT	87.180
B-10	RR 50+194.35	2.00 LT	85.1
B-11	RR 50+196.10	0.95 LT	86.1
B-12	RR 50+220.42	0.12 LT	86.0
P-1	30+206.85	10.44 RT	83.254
P-2	30+214.99	10.22 RT	82.726
P-3	30+214.61	11.88 RT	81.141
P-4	30+241.92	12.38 RT	80.675
P-5	30+208.07	2.59 LT	82.550
P-6	30+218.63	0.78 LT	81.934
P-7	30+237.73	2.12 RT	80.492
P-8	30+244.28	2.16 RT	80.010
TP-1	RR 50+194.72	4.46 LT	84.009
RP-1	30+180.00	11.00 LT	84.945
RP-2	30+250.05	9.00 LT	88.275
RP-3	30+260.00	20.00 LT	88.317
RP-4	30+304	6.5 LT	90.486
RP-5	30+285.02	6.49 LT	89.972
RP-6	30+300.01	18.01 LT	90.037
RP-7	30+320.01	30.01 LT	89.175
RP-8	30+326.18	8.01 LT	87.409
RP-9	30+326.00	17.98 LT	88.964
RP-10	30+325.82	7.72 RT	83.114
RP-11	30+327.25	14.00 RT	77.856
RP-12	30+326.00	29.50 RT	80.005
RP-13	30+345.01	29.80 RT	77.875
C-1	30+170	0.0	84.284
C-2	30+300	12.5 RT	78.250

GENERAL NOTES

1. The subsurface explorations shown herein were made between 11/10/99 and 6/6/00.
2. Soil and rock classifications, properties and descriptions are based on engineering interpretation from available subsurface information and may not necessarily reflect actual variations in subsurface conditions that may be encountered between individual boring or sample locations.
3. Observed water levels and/or conditions indicated are as recorded at the time of exploration and may vary according to the prevailing rainfall, methods of exploration and other factors.
4. Engineering judgement was exercised in preparing the subsurface information presented herein. Analysis and interpretation of subsurface data was performed and interpreted for Agency design and estimating purposes. Presentation of the information in the Contract is intended to provide the Contractor access to the same data available to the Agency. The subsurface information is presented in good faith and is not intended as a substitute for personal investigation, independent interpretation, independent analysis or judgement by the Contractor.
5. Pictorial structure details shown on the boring plan layout or soils profile are for illustrative purposes only and may not accurately portray final contract details.
6. Terminology used on boring logs to describe the hardness, degree of weathering, and spacing of fractures, joints and other discontinuities in the bedrock is defined in the AASHTO Manual on Subsurface Investigations, 1988.

RECORD OF BOREHOLE B-1												
PROJECT NAME: RT 9 ROAD IMPROVEMENT SITE NAME: BRATTLEBORO VT STATION: 50+28.34 GROUND EL.: 87.866			PROJECT NUMBER: 993-6874 SITE NO.: OFFSET: LT 7.02 C.W. DEPTH: 21'			HOLE NO.: B-1 SHEET 1 OF 1 DATE STARTED: 1430/11-12-99 DATE COMPLETED: 16/01/15-99			BORING CREW: CREW CHIEF: DRILLER: B. BOURASSA LOGGER: MRT CHECKED: TKA ADDITIONAL CREW:			
SOIL PROFILE			SAMPLES			SAMPLE DESCRIPTIONS AND BORING NOTES						
DEPTH SCALE METERS	DEPTH SCALE FEET	BORING METHOD	USCS	GRAPHIC LOG ELEVATION	NUMBER	TYPE	BLOWS / 6 INCHES	N	REC.VAT.			
0	0	WASH AND DRILL		87.9	S1	D.O.	1-1-6-8	7	8/24	Loose, light brown, m-f SAND, little silt.		
	1		87.3							4" casing advanced to 4' bgs and washed		
5	5		86.6	S2	D.O.	7-6-4-5	10	14/24		Grayish brown, loose, m-f SAND some silt.		
	10		86.0							4" casing advanced to 9' bgs and washed		
15	15		85.1	S3	D.O.	5-6-5-6	11	8/24		Grayish brown, compact, m-f SAND, trace silt		
	20		84.5							4" casing advanced to 14' bgs and washed		
25	25		83.6	S4	D.O.	6-5-6-5	11	6/24		Grayish brown, compact, m-f SAND some silt.		
	30		83.0							4" casing advanced to 19' bgs and washed		
35	35	IN CORING		82.1	S5	D.O.	13-11-10-9	21	6/24	Compact, light brown, m-f SAND, trace gravel		
	40		81.5							4" casing advanced to 24' bgs and washed		
45	45		80.9	S6	D.O.	11-8-9-9	17	8/24		Compact light brown m-f SAND trace gravel		
	50		80.6							4" casing advanced to 29' bgs and washed		
55	55		79.9	S7	D.O.	12-10-11-11	21	8/24		Compact light brown m-f SAND trace gravel		
	60		79.0							4" casing advanced to 34' bgs and washed		
65	65		78.4	S8	D.O.	13-11-13-15	24	16/24		Compact, light brown m-f SAND, some silt		
	70		77.5							4" casing advanced to 38' bgs and washed		
75	75			76.9						Rollercored from 38'-39' bgs		
	80			76.3						Coring from 39'-54' bgs		
	85			76.0						38.0 BEDROCK		

RECORD OF ROCK COREHOLE B-1													
CORE DESCRIPTION		GRAPHIC LOG		ELEVATION		RUN		RUN INFORMATION		DISCONTINUITIES			
DEPTH SCALE METERS	DEPTH SCALE FEET	BORING METHOD	USCS	GRAPHIC LOG	ELEVATION	RUN	MIN. / FT.	START / STOP	WATER USAGE	% FLUSH RET.	FRAC. INT.		
39	39	IN CORING		76.0	Run No. 1			0Z	2				
	44		74.5	Run No. 2				0Z	1				
	49		72.9	Run No. 3				0Z	1				
	54		71.4	Run No. 4				0Z	1				
	59							0Z	1				
39'-54' Fresh to slightly weathered, very closely jointed, gray, very fine grained PHYLITE with several near vertical joints.													

RECORD OF BOREHOLE B-2													
PROJECT NAME: RT 9 ROAD IMPROVEMENT SITE NAME: BRATTLEBORO VT STATION: 50+28.71 GROUND EL.: 87.878			PROJECT NUMBER: 993-6874 SITE NO.: OFFSET: RT 195 C.W. DEPTH: 20'			HOLE NO.: B-2 SHEET 1 OF 1 DATE STARTED: 1540/11-16-99 DATE COMPLETED: 16/01/17-99			BORING CREW: CREW CHIEF: DRILLER: B. BOURASSA LOGGER: MRT CHECKED: TKA ADDITIONAL CREW:				
SOIL PROFILE			SAMPLES			SAMPLE DESCRIPTIONS AND BORING NOTES							
DEPTH SCALE METERS	DEPTH SCALE FEET	BORING METHOD	USCS	GRAPHIC LOG ELEVATION	NUMBER	TYPE	BLOWS / 6 INCHES	N	REC.VAT.				
0	0	WASH AND DRIVE		87.9	S1	D.O.	4-5-5-8	10	8/24	Dark brown compact SAND, little silt and organics			
	1		87.3							4" casing advanced to 4' bgs and washed			
5	5		86.7	S2	D.O.	3-2-2-2	4	12/24		Light brown, very loose M-F SAND trace silt			
	10		86.0							4" casing advanced to 9' bgs			
15	15		85.1	S3	D.O.	2-2-3-3	5	8/24		Light brown, very loose M-F SAND trace silt			
	20		84.5							4" casing advanced to 14' bgs			
25	25		83.6	S4	D.O.	10-9-10-9	19	10/24		Grayish brown, compact M-F SAND trace silt			
	30		83.0							4" casing advanced to 19' bgs			
35	35		82.1	S5	D.O.	14-10-9-9	19	10/24		Compact light brown M-F SAND, trace gravel			
	40		81.5							4" casing advanced to 24' bgs			
45	45				80.6	S6	D.O.	26-25/3-50/0	50	8/24	4" dense grayish brown C-M-F SAND trace rock chips		
	50		80.3							4" casing was advanced to 24'9"			
	55		80.2							Refusal at 24'9"			
	60									Rollercored 6" to 25'3"			
	65									Coring from 25'3"-50' bgs			

RECORD OF ROCK COREHOLE B-2												
CORE DESCRIPTION		GRAPHIC LOG		ELEVATION		RUN		RUN INFORMATION		DISCONTINUITIES		
DEPTH SCALE METERS	DEPTH SCALE FEET	BORING METHOD	USCS	GRAPHIC LOG	ELEVATION	RUN	MIN. / FT.	START / STOP	WATER USAGE	% FLUSH RET.	FRAC. INT.	
25	25	IN CORING		80.3	Run No. 1			1	25.4	7	J/S	
	30		78.7	Run No. 2				3	26.3	35	M/FST	
	35		77.2	Run No. 3				1	26.5	35	J/S	
	40		75.7	Run No. 4				1	26.9	78	M/FST	
	45		74.2	Run No. 5				1	27.6	88	M/FST	
	50		72.6	Run No. 6				1	28.6	85	J/R	
	55							1	28.4	35	J/R	
	60							1	29.9	90	J/R	
	65							2	31.3	68	M/FST	
	70							2	31.6	75	J/S	
	75							2	32.2	36	J/R	
	80							2	32.7	85	J/R	
	85							2	33.5	80	M/FST	
	90							2	33.7	18	J/R	
25.25'-50' Fresh to slightly weathered, very closely jointed, gray, very fine grained PHYLITE.												

RECORD OF BOREHOLE B-3												
PROJECT NAME: RT 9 ROAD IMPROVEMENT SITE NAME: BRATTLEBORO VT STATION: 50+28.54 GROUND EL.: 87.554			PROJECT NUMBER: 993-6874 SITE NO.: OFFSET: RT 12.59 C.W. DEPTH: 20'			HOLE NO.: B-3 SHEET 1 OF 1 DATE STARTED: 1000/11-18-99 DATE COMPLETED: 1000/11-18-99			BORING CREW: CREW CHIEF: DRILLER: B. BOURASSA LOGGER: MRT CHECKED: TKA ADDITIONAL CREW:			
SOIL PROFILE			SAMPLES			SAMPLE DESCRIPTIONS AND BORING NOTES						
DEPTH SCALE METERS	DEPTH SCALE FEET	BORING METHOD	USCS	GRAPHIC LOG ELEVATION	NUMBER	TYPE	BLOWS / 6 INCHES	N	REC.VAT.			
0	0	WASH AND DRIVE		87.6	S1	D.O.	6-4-5-4	9	20/24	Compact, yellowish brown, FINE SAND, some silt		
	1		86.9							4" casing advanced to 4' bgs and washed		
5	5		86.3	S2	D.O.	7-5-7-6	12	18/24		6" Light brown compact FINE SAND, some silt		
	10		86.0							3" Black compact FINE SAND		
15	15		85.7							4" casing advanced to 9' bgs and washed		
20	20		84.8	S3	D.O.	7-8-7-8	15	12/24		Grayish brown compact M-F SAND		
	25		84.2							4" casing advanced to 14' bgs and washed		
30	30		83.3	S4	D.O.	11-13-14-14	27	12/24		Grayish brown compact M-F SAND		
35	35	IN CORING		82.7						Refusal at 18' bgs		
	40		81.9							4" casing advanced to 18' bgs and washed		
	45									Rollercored 6" to 18'6"		
	50									Coring from 18'6"-51' bgs		
	55											
	60											
	65											
	70											

RECORD OF ROCK COREHOLE B-3												
CORE DESCRIPTION		GRAPHIC LOG		ELEVATION		RUN		RUN INFORMATION		DISCONTINUITIES		
DEPTH SCALE METERS	DEPTH SCALE FEET	BORING METHOD	USCS	GRAPHIC LOG	ELEVATION	RUN	MIN. / FT.	START / STOP	WATER USAGE	% FLUSH RET.	FRAC. INT.	
18.5	18.5	IN CORING		81.9	Run No. 1			1	18.8	52	M/R	
	19		80.4	Run No. 2				2	19.3	51	M/R	
	20		78.9	Run No. 3				2	19.8	28	M/R	
	21		77.3	Run No. 4				1	20.1	40	M/R	
	22		75.8	Run No. 5				1	20.4	28	M/R	
	23		74.3	Run No. 6				2	20.8	88	J/R	
	24		72.8	Run No. 7				1	21.3	55	M/R	
	25							1	21.5	60	M/R	
	26							1	21.8	20	M/R	
	27							1	22.3	20	M/R	
	28							2	23.5	80	M/R	
	29							2	24.0	29	M/SM	
	30							2	24.4	24	J/R	
	31							2	24.6	24	J/R	
	32							1	25.3	90	M/R	
	33						1	25.4	34	M/SM		
	34						1	27.2	20	J/S		
	35						1	28.1	21	M/SM		
	36						1	28.5	0	J/R		
	37						1	28.8	10	J/R		
	38						2	29.4	15	M/SM		
	39						2	29.7	0	M/R		
	40						2	29.2	37	J/R		
	41						2	32.4	36	M/R		
	42						1	32.8	36	M/SM		
	43						1	33.0	90	J/UE		
	44						4	33.1	42	J/UE		
	45						4	33.2	43	M/FST		
	46						1	38.1	28	M/ST		
	47						1	39.2	24	J/R		
	48						2	39.3	21	M/R		
	49						2	40.6	80	M/R		
	50						5	40.8	78	J/R		
	51						1	40.9	79	J/R		
	52						2	41.3	30	J/ST		
	53						2	41.5	30	J/R		
	54						2	42.1	27	J/SM		
	55						2	42.5	26	J/ST		
	56						1	43.0	25	M/R		
	57						4	44.0	35	M/ST		
	58						2	44.3	48	J/R		
	59						4	44.9	29	J/SM		
	60						0	45.0	70	M/R		
	61						0	45.2	19	J/SM		
	62						0	45.4	29	M/R		
	63						2	46.6	25	J/SM		
	64						2	47.2	26	J/SM		
	65						2	47.6	24	J/SM		
	66						1	48.5	90	J/R		
	67						2	49.0	24	J/SM		
	68						2	49.7	58	J/ST		
	69											

RECORD OF BOREHOLE B-4										
DEPTH SCALE METERS		DEPTH SCALE FEET		BORING METHOD		SOIL PROFILE		SAMPLES		SAMPLE DESCRIPTIONS AND BORING NOTES
DEPTH SCALE METERS	DEPTH SCALE FEET	USCS	GRAPHIC LOG	ELEVATION	NUMBER	TYPE	BLOWS / 6 INCHES	N	REC. ATT.	
0	0			84.8	S1	D.O.	1-2-3-1	5	5/24	Loose, light brown, M-F SAND some roots
1	1			84.2						4" casing advanced to 5' bgs and washed
2	2			83.3	S2	D.O.	7-7-7-7	14	18/24	Compact, grayish brown FINE SAND, trace gravel and silt
3	3			82.6						4" casing advanced to 9' bgs and washed Gravel observed in wash water
4	4			82.0	S3	D.O.	5-6-5-7	11	12/24	Compact, grayish brown M-F SAND, trace silt
5	5			81.4						4" casing advanced to 14' bgs and washed Bottom appears to be hard.
6	6			80.5						14.0 BEDROCK

RECORD OF ROCK COREHOLE B-4										
DEPTH SCALE METERS		DEPTH SCALE FEET		BORING METHOD		CORE DESCRIPTION		RUN INFORMATION		DISCONTINUITIES
DEPTH SCALE METERS	DEPTH SCALE FEET	USCS	GRAPHIC LOG	ELEVATION	NUMBER	TYPE	BLOWS / 6 INCHES	N	REC. ATT.	
14	14			80.5						14'-24" Fresh to slightly weathered, close to moderately closely jointed, gray, very fine grained PHYLITE.
5	5			79.0						
6	6			77.5						

DRILL RIG: MOBILE B-47
 DRILLING CONTRACTOR: Con-Tec Inc.
 DRILLER: B. BOURASSA

TOTAL LENGTH CORED: 10'
 BITS USED: 1

LOGGED: MRT
 CHECKED: TKA
 DATE:

RECORD OF BOREHOLE B-4A										
DEPTH SCALE METERS		DEPTH SCALE FEET		BORING METHOD		SOIL PROFILE		SAMPLES		SAMPLE DESCRIPTIONS AND BORING NOTES
DEPTH SCALE METERS	DEPTH SCALE FEET	USCS	GRAPHIC LOG	ELEVATION	NUMBER	TYPE	BLOWS / 6 INCHES	N	REC. ATT.	
0	0									Borehole advanced to 14' bgs without split spoon sampling. See borehole log B-4 for coring from 14'-34' bgs
1	1									
2	2									
3	3									
4	4									
5	5									
6	6									

RECORD OF ROCK COREHOLE B-4A										
DEPTH SCALE METERS		DEPTH SCALE FEET		BORING METHOD		CORE DESCRIPTION		RUN INFORMATION		DISCONTINUITIES
DEPTH SCALE METERS	DEPTH SCALE FEET	USCS	GRAPHIC LOG	ELEVATION	NUMBER	TYPE	BLOWS / 6 INCHES	N	REC. ATT.	
14	14			80.5						14'-34" Fresh to slightly weathered, close to moderately closely jointed, block to gray (with vitreous luster), very fine grained PHYLITE, with several near vertical joints and slight oxidation on some joint surfaces.
5	5			79.0						
6	6			77.5						
7	7			75.9						
8	8			74.4						

DRILL RIG: MOBILE B-47
 DRILLING CONTRACTOR: Con-Tec Inc.
 DRILLER: B. BOURASSA

TOTAL LENGTH CORED: 20'
 BITS USED: 1

LOGGED: MZ
 CHECKED: TKA
 DATE:

RECORD OF BOREHOLE B-5										
DEPTH SCALE METERS		DEPTH SCALE FEET		BORING METHOD		SOIL PROFILE		SAMPLES		SAMPLE DESCRIPTIONS AND BORING NOTES
DEPTH SCALE METERS	DEPTH SCALE FEET	USCS	GRAPHIC LOG	ELEVATION	NUMBER	TYPE	BLOWS / 6 INCHES	N	REC. ATT.	
0	0			86.7	S1	D.O.	1-1-2-3	3	8/24	4" Black topsoil, followed by very loose, light brown SAND trace silt
1	1			86.1						4" casing advanced to 4' bgs and washed
2	2			85.5	S2	D.O.	5-3-2-2	5	6/24	Loose, light brown SAND, some silt trace organics
3	3			84.9						4" casing advanced to 9' bgs and washed
4	4			84.0						
5	5			83.7						Refusal at 9'-4" (Core barrel bent to 10' bgs and coring continued with new barrel.)
6	6									

RECORD OF ROCK COREHOLE B-5										
DEPTH SCALE METERS		DEPTH SCALE FEET		BORING METHOD		CORE DESCRIPTION		RUN INFORMATION		DISCONTINUITIES
DEPTH SCALE METERS	DEPTH SCALE FEET	USCS	GRAPHIC LOG	ELEVATION	NUMBER	TYPE	BLOWS / 6 INCHES	N	REC. ATT.	
3	3			83.7						10'-30" Fresh to slightly weathered, close to moderately closely jointed gray, very fine grained PHYLITE.
4	4			82.1						
5	5			80.6						
6	6			79.1						
7	7			77.6						

DRILL RIG: MOBILE B-47
 DRILLING CONTRACTOR: Con-Tec Inc.
 DRILLER: B. BOURASSA

TOTAL LENGTH CORED: 20'
 BITS USED: 1

LOGGED: MRT
 CHECKED: TKA
 DATE:



RECORD OF BOREHOLE B-6															
DEPTH SCALE METERS		DEPTH SCALE FEET		SOIL PROFILE			SAMPLES			SAMPLE DESCRIPTIONS AND BORING NOTES					
DEPTH SCALE METERS	DEPTH SCALE FEET	USCS	GRAPHIC LOG	ELEVATION	NUMBER	TYPE	BLOWS / 6 INCHES	N	REC. ATT.	BORING METHOD					
0	0			83.9	S1	D.O.	1-2-3-1	5	12/24	4" casing advanced to 3'2"		Loose, grayish brown SAND, some silt and organics			
				83.3						3" casing from 3'2"-4'		4" casing advanced to 3'2" Refusal at 3'2"			
				82.7			65/6"	365		4.0 BEDROCK		Greenish brown, fine SAND, some silt			
DRILL RIG: MOBILE B-47 DRILLING CONTRACTOR: Con-Tec INC. DRILLER: B. BOURASSA												LOGGED: MRT CHECKED: TKA DATE:			

RECORD OF BOREHOLE B-8															
DEPTH SCALE METERS		DEPTH SCALE FEET		SOIL PROFILE			SAMPLES			SAMPLE DESCRIPTIONS AND BORING NOTES					
DEPTH SCALE METERS	DEPTH SCALE FEET	USCS	GRAPHIC LOG	ELEVATION	NUMBER	TYPE	BLOWS / 6 INCHES	N	REC. ATT.	BORING METHOD					
0	0			84.2	S1	D.O.	1-1-2-1	3	18/24	4" DRIVE AND WASH		Soft dark brown SILT little organic matter, trace to little sand, moist casing blow 0'-5"			
				83.6						4" DRIVE AND WASH		Possible formation change at approximately 3' bgs			
				83.0	S2	D.O.	3-1-1-2	2	18/24	4" DRIVE AND WASH		Loose dark brown fine SAND little to some medium sand, trace wood frags.			
				82.4						4" DRIVE AND WASH		4'-9" Casing blows = 14-12-10-21-24			
				81.5	S3	D.O.	4-4-6-2	10	12/24	4" DRIVE AND WASH		Compact grayish-brown c-f SAND, trace-little silt and gravel			
				80.9						4" DRIVE AND WASH		2" of gray SILTY CLAY in spoon tip			
				80.7						4" DRIVE AND WASH		9'-14" Casing blows = 20-20-50/6"			
DRILL RIG: MOBILE B-47 DRILLING CONTRACTOR: Con-Tec INC. DRILLER: B. BOURASSA												LOGGED: MZ CHECKED: TKA DATE:			

RECORD OF BOREHOLE B-9															
DEPTH SCALE METERS		DEPTH SCALE FEET		SOIL PROFILE			SAMPLES			SAMPLE DESCRIPTIONS AND BORING NOTES					
DEPTH SCALE METERS	DEPTH SCALE FEET	USCS	GRAPHIC LOG	ELEVATION	NUMBER	TYPE	BLOWS / 6 INCHES	N	REC. ATT.	BORING METHOD					
0	0			87.2	S1	D.O.	4-3-4-7	7	18/24	4" DRIVE AND WASH		0.0-1.3 Soft, tan to brown, SILT, trace fine sand, trace organic matter in upper 0.5', moist			
				86.6						4" DRIVE AND WASH		1.3-32.5 Loose to compact, brown to dark brown, m-f SAND, little to trace silt, little to trace gravel			
				86.0	S2	D.O.	7-9-9-10	18	12/24	4" DRIVE AND WASH		4.0-6.0 Compact brown med-fine SAND little trace silt			
				85.4						4" DRIVE AND WASH		4'-9" casing blows = 12-20-25-29-24			
				84.4	S3	D.O.	6-6-7-8	13	5,6/24	4" DRIVE AND WASH		Compact, dark brown, med-fine SAND, little silt, trace coarse sand			
				83.8						4" DRIVE AND WASH		9'-14" casing blows = 15-32-27-38-40			
				82.9	S4	D.O.	10-12-13-13	25	12/24	4" DRIVE AND WASH		Compact, dark brown, med-fine SAND, trace coarse sand, trace silt			
				82.3						4" DRIVE AND WASH		14'-19" casing blows = 22-42-50-54-53			
				81.4	S5	D.O.	9-8-8-9	16	12/24	4" DRIVE AND WASH		Compact, dark brown, c-m-f SAND, little trace silt			
				80.8						4" DRIVE AND WASH		19'-24" casing blows = 30-39-32-41-51			
				79.9	S6	D.O.	8-6-8-8	14	12/24	4" DRIVE AND WASH		Compact, dark brown, m-f SAND, trace gravel, trace silt			
				79.3						4" DRIVE AND WASH		24'-29" casing blows = 40-40-51-53-59			
				78.3	S7	D.O.	8-7-8-10	15	10,8/24	4" DRIVE AND WASH		Compact, dark brown, medium SAND, trace silt, trace fine sand			
				77.7						4" DRIVE AND WASH		29'-34" casing blows = 48-62-81-92-91			
				76.8	S8	D.O.	9-8-10-12	18	12/24	4" DRIVE AND WASH		Formation change at approximately 32.5 ft. bgs			
				76.2						4" DRIVE AND WASH		51'ff, dark brown to gray, SILT, trace fine sand			
				75.3						4" DRIVE AND WASH		Very bottom 2" of spoon is c-m-f SAND and fine GRAVEL			
				75.0	S9	D.O.	10-7-6-6	13	18/24	4" DRIVE AND WASH		34'-39" casing blows approximately 40-78-72-82-99			
				74.7						4" DRIVE AND WASH		39'-39.2" Compact, gray, fine SAND, little silt			
				73.8	S10	D.O.	9-7-10-9	17	14,4/24	4" DRIVE AND WASH		39.2'-41.0" Stiff, gray, SILT, some fine sand, trace clay			
				73.2						4" DRIVE AND WASH		39'-44" casing blow N/A (open hole)			
				72.2	S11	D.O.	10-50/1	250	8/24	4" DRIVE AND WASH		Compact, brown, fine SAND, interbedded with stiff, gray, SILT, with large amounts of deep red oxidized zones along steep partings			
				72.1						4" DRIVE AND WASH		49'-49.5" Stiff, gray, SILT, trace fine sand			
										4" DRIVE AND WASH		49.5' casing refusal on bedrock			
DRILL RIG: MOBILE B-47 DRILLING CONTRACTOR: Con-Tec INC. DRILLER: B. BOURASSA												LOGGED: MZ CHECKED: TKA DATE:			

RECORD OF BOREHOLE B-7															
DEPTH SCALE METERS		DEPTH SCALE FEET		SOIL PROFILE			SAMPLES			SAMPLE DESCRIPTIONS AND BORING NOTES					
DEPTH SCALE METERS	DEPTH SCALE FEET	USCS	GRAPHIC LOG	ELEVATION	NUMBER	TYPE	BLOWS / 6 INCHES	N	REC. ATT.	BORING METHOD					
0	0			84.2	S1	D.O.	1-2-2-1	4	12/24	AUGER/DRIVE AND WASH		Loose, light brown F-M SAND, little silt, trace organics			
				83.6						AUGER/DRIVE AND WASH		4" casing advanced to 5' bgs, and washed			
				82.7	S2	D.O.	1-1-1-1	2	0/24	AUGER/DRIVE AND WASH		Water table encountered at 4'5" bgs measured at end of drilling			
				82.1						AUGER/DRIVE AND WASH		No recovery in split spoon			
				81.1	S3	D.O.	3-50/0"		8/24	AUGER/DRIVE AND WASH		4" casing advanced to 10' bgs, and washed			
										AUGER/DRIVE AND WASH		Grayish brown m-f SAND and SILT, trace clay and gravel			
										AUGER/DRIVE AND WASH		Possible bedrock at 10.2' bgs Tried Auger to confirm bedrock Refusal at 10.3'			
DRILL RIG: MOBILE B-47 DRILLING CONTRACTOR: Con-Tec INC. DRILLER: B. BOURASSA												LOGGED: MRT CHECKED: TKA DATE:			

PROJECT:	BRATTLEBORO	PROJECT NO.:	NH 010-2 (2)
DESIGN FILE NAME:	U:\99123-Brattleboro\dgn\19br500.dgn	PLOT DATE:	10-02-2002
DRAWN BY:	DHL	SQUAD LEADER:	JHR
DATE:	02/29/00	SHEET:	62 OF 145

RECORD OF ABUTMENT CORE B-10. PROJECT NAME: RT 9 ROAD IMPROVEMENT. SITE NAME: BRATTLEBORO VT. STATION: 50+34.35. HOLE NO.: B-10. SHEET 1 OF 1. DATE STARTED: 03/05/00. DATE COMPLETED: 10/06/00. SOIL PROFILE and SAMPLES table with columns for USCS, GRAPHIC LOG, ELEVATION, NUMBER, TYPE, BLOWS / 6 INCHES, N, REC.VATT., and SAMPLE DESCRIPTIONS AND BORING NOTES.

RECORD OF BOREHOLE B-11. PROJECT NAME: RT 9 ROAD IMPROVEMENT. SITE NAME: BRATTLEBORO VT. STATION: 50+36.0. HOLE NO.: B-11. SHEET 1 OF 1. DATE STARTED: 03/06/00. DATE COMPLETED: 10/06/00. SOIL PROFILE and SAMPLES table with columns for USCS, GRAPHIC LOG, ELEVATION, NUMBER, TYPE, BLOWS / 6 INCHES, N, REC.VATT., and SAMPLE DESCRIPTIONS AND BORING NOTES.

RECORD OF BOREHOLE B-12. PROJECT NAME: RT 9 ROAD IMPROVEMENT. SITE NAME: BRATTLEBORO VT. STATION: 50+32.42. HOLE NO.: B-12. SHEET 1 OF 1. DATE STARTED: 09/06/00. DATE COMPLETED: 10/06/00. SOIL PROFILE and SAMPLES table with columns for USCS, GRAPHIC LOG, ELEVATION, NUMBER, TYPE, BLOWS / 6 INCHES, N, REC.VATT., and SAMPLE DESCRIPTIONS AND BORING NOTES.

RECORD OF PROBEHOLE P-1											
			PROJECT NAME: RT 9 ROAD IMPROVEMENT SITE NAME: BRATTLEBORO VT STATION: 50-252.70 GROUND EL.: 83.254				PROJECT NUMBER: 993-6874 SITE NO.: OFFSET: LT 14.25 G.W. DEPTH:				
HOLE NO.: P-1 SHEET 1 OF 1 DATE STARTED: 10/01/11-8-99 DATE COMPLETED: 10/01/11-8-99			BORING CREW: CREW CHIEF: DRILLER: B. BOURASSA LOGGER: MRT CHECKED: TKA ADDITIONAL CREW:				BORING RIG: MOBILE B-47 BORING TYPE: SAMPLE TYPE: WEIGHT OF HAMMER: N/A DROP: N/A				
DEPTH SCALE METERS	DEPTH SCALE FEET	BORING METHOD	SOIL PROFILE			SAMPLES			SAMPLE DESCRIPTIONS AND BORING NOTES		
			USCS	GRAPHIC LOG	ELEVATION	NUMBER	TYPE	BLOWS / 6 INCHES			
0	0	4" AUGER	0.0-6.0	Light brown, m-SAND.	83.3						Water appears to be approximately 6'-7" bgs. Hole cased in therefore exact water level was not measured. Augering terminated at 10' bgs.
6	6		6.0-10.0	Grayish brown, m-SAND, wet.	81.4						
10	10					80.2					
DRILL RIG: MOBILE B-47 DRILLING CONTRACTOR: Con-Tec INC. DRILLER: B. BOURASSA			SHEET 1 OF 1				LOGGED: MRT CHECKED: TKA DATE:				

RECORD OF PROBEHOLE P-3											
			PROJECT NAME: RT 9 ROAD IMPROVEMENT SITE NAME: BRATTLEBORO VT STATION: 50-263.99 GROUND EL.: 81.41				PROJECT NUMBER: 993-6874 SITE NO.: OFFSET: RT 14.49 G.W. DEPTH: 1'				
HOLE NO.: P-3 SHEET 1 OF 1 DATE STARTED: 10/01/11-8-99 DATE COMPLETED: 10/06/11-8-99			BORING CREW: CREW CHIEF: DRILLER: B. BOURASSA LOGGER: MRT CHECKED: TKA ADDITIONAL CREW:				BORING RIG: MOBILE B-47 BORING TYPE: SAMPLE TYPE: WEIGHT OF HAMMER: N/A DROP: N/A				
DEPTH SCALE METERS	DEPTH SCALE FEET	BORING METHOD	SOIL PROFILE			SAMPLES			SAMPLE DESCRIPTIONS AND BORING NOTES		
			USCS	GRAPHIC LOG	ELEVATION	NUMBER	TYPE	BLOWS / 6 INCHES			
0	0	4" AUGER	0.0-4.5	Dark brown, c-m SAND.	81.1					Refusal at 4'6"	
5	5		4.5	BEDROCK	79.8						
DRILL RIG: MOBILE B-47 DRILLING CONTRACTOR: Con-Tec INC. DRILLER: B. BOURASSA			SHEET 1 OF 1				LOGGED: MRT CHECKED: TKA DATE:				

RECORD OF PROBEHOLE P-2											
			PROJECT NAME: RT 9 ROAD IMPROVEMENT SITE NAME: BRATTLEBORO VT STATION: 50-261.17 GROUND EL.: 82.726				PROJECT NUMBER: 993-6874 SITE NO.: OFFSET: LT 5.89 G.W. DEPTH:				
HOLE NO.: P-2 SHEET 1 OF 1 DATE STARTED: 10/01/11-8-99 DATE COMPLETED: 10/25/11-8-99			BORING CREW: CREW CHIEF: DRILLER: B. BOURASSA LOGGER: MRT CHECKED: TKA ADDITIONAL CREW:				BORING RIG: MOBILE B-47 BORING TYPE: SAMPLE TYPE: WEIGHT OF HAMMER: N/A DROP: N/A				
DEPTH SCALE METERS	DEPTH SCALE FEET	BORING METHOD	SOIL PROFILE			SAMPLES			SAMPLE DESCRIPTIONS AND BORING NOTES		
			USCS	GRAPHIC LOG	ELEVATION	NUMBER	TYPE	BLOWS / 6 INCHES			
0	0	4" AUGER	0.0-10.0	Grayish brown, m-SAND, wet, trace silt.	82.7					No soil cuttings observed down to 5' bgs. Water appears to be approximately 5'-6' bgs. Hole cased in therefore exact water level was not measured. Augering terminated at 10' bgs.	
5	5										
10	10					79.7					
DRILL RIG: MOBILE B-47 DRILLING CONTRACTOR: Con-Tec INC. DRILLER: B. BOURASSA			SHEET 1 OF 1				LOGGED: MRT CHECKED: TKA DATE:				

RECORD OF PROBEHOLE P-4											
			PROJECT NAME: RT 9 ROAD IMPROVEMENT SITE NAME: BRATTLEBORO VT STATION: 50-265.75 GROUND EL.: 80.675				PROJECT NUMBER: 993-6874 SITE NO.: OFFSET: RT 21.97 G.W. DEPTH: 2'5"				
HOLE NO.: P-4 SHEET 1 OF 1 DATE STARTED: 10/43/11-10-99 DATE COMPLETED: 10/55/11-10-99			BORING CREW: CREW CHIEF: DRILLER: B. BOURASSA LOGGER: MRT CHECKED: TKA ADDITIONAL CREW:				BORING RIG: MOBILE B-47 BORING TYPE: SAMPLE TYPE: WEIGHT OF HAMMER: N/A DROP: N/A				
DEPTH SCALE METERS	DEPTH SCALE FEET	BORING METHOD	SOIL PROFILE			SAMPLES			SAMPLE DESCRIPTIONS AND BORING NOTES		
			USCS	GRAPHIC LOG	ELEVATION	NUMBER	TYPE	BLOWS / 6 INCHES			
0	0	4" AUGER	0.0-5.8	Dark brown, c-m SAND, some gravel.	80.7					Water at 2'5" Refusal at 5'10"	
5	5		5.8	BEDROCK	78.9						
DRILL RIG: MOBILE B-47 DRILLING CONTRACTOR: Con-Tec INC. DRILLER: B. BOURASSA			SHEET 1 OF 1				LOGGED: MRT CHECKED: TKA DATE:				

RECORD OF PROBEHOLE P-5										
		PROJECT NAME: RT 9 ROAD IMPROVEMENT SITE NAME: BRATTLEBORO VT STATION: 50+272.29 GROUND EL.: 82.550			PROJECT NUMBER: 993-6874 SITE NO.: OFFSET: LT 14.98 G.W. DEPTH: 3'					
HOLE NO.: P-5 SHEET 1 OF 1 DATE STARTED: 12/30/11-10-99 DATE COMPLETED: 12/30/11-10-99		BORING CREW: CREW CHIEF: DRILLER: B. BOURASSA LOGGER: MRT CHECKED: TKA ADDITIONAL CREW:			BORING RIG: MOBILE B-47 BORING TYPE: SAMPLE TYPE: WEIGHT OF HAMMER: N/A DROP: N/A					
DEPTH SCALE METERS	DEPTH SCALE FEET	BORING METHOD	SOIL PROFILE			SAMPLES			SAMPLE DESCRIPTIONS AND BORING NOTES	
			USCS	GRAPHIC LOG	ELEVATION	NUMBER	TYPE	BLOWS / 6 INCHES		N
0	0	4" AUGER / SPLIT SPOON	0.0-5.0	Light brown, m-f SAND.	82.6					Light brown m-f SAND
5	5		5.0-10.0	Light brown, f-SAND.	81.0					Light brown, wet f-SAND
10	10		10.0-15.0	Grayish brown, m-SAND.	79.5					Augered to 10' bgs 10'-15' Driven split spoon sampler Grayish brown m-SAND in split spoon
15	15				78.0					Augering terminated at 15' bgs
DRILL RIG: MOBILE B-47 DRILLING CONTRACTOR: Con-Tec INC. DRILLER: B. BOURASSA					LOGGED: MRT CHECKED: TKA DATE:					

SHEET 1 OF 1

RECORD OF PROBEHOLE P-7										
		PROJECT NAME: RT 9 ROAD IMPROVEMENT SITE NAME: BRATTLEBORO VT STATION: 50+274.85 GROUND EL.: 80.492			PROJECT NUMBER: 993-6874 SITE NO.: OFFSET: RT 14.84 G.W. DEPTH:					
HOLE NO.: P-7 SHEET 1 OF 1 DATE STARTED: 11/17/11-10-99 DATE COMPLETED: 11/17/11-10-99		BORING CREW: CREW CHIEF: DRILLER: B. BOURASSA LOGGER: MRT CHECKED: TKA ADDITIONAL CREW:			BORING RIG: MOBILE B-47 BORING TYPE: SAMPLE TYPE: WEIGHT OF HAMMER: N/A DROP: N/A					
DEPTH SCALE METERS	DEPTH SCALE FEET	BORING METHOD	SOIL PROFILE			SAMPLES			SAMPLE DESCRIPTIONS AND BORING NOTES	
			USCS	GRAPHIC LOG	ELEVATION	NUMBER	TYPE	BLOWS / 6 INCHES		N
0	0	4" AUGER	0.0-4.6	SAND AND GRAVEL (fill)	80.5					Limited soil cuttings observed
5	5		4.6	BEDROCK	79.1					Refusal at 4'7" bgs
10	10									Possible water table at 1'6" bgs Hole covered in therefore water level not measured
15	15									
DRILL RIG: MOBILE B-47 DRILLING CONTRACTOR: Con-Tec INC. DRILLER: B. BOURASSA					LOGGED: MRT CHECKED: TKA DATE:					

SHEET 1 OF 1

RECORD OF PROBEHOLE P-6										
		PROJECT NAME: RT 9 ROAD IMPROVEMENT SITE NAME: BRATTLEBORO VT STATION: 50+272.57 GROUND EL.: 81.934			PROJECT NUMBER: 993-6874 SITE NO.: OFFSET: LT 4.36 G.W. DEPTH: 7.3'					
HOLE NO.: P-6 SHEET 1 OF 1 DATE STARTED: 11/27/11-10-99 DATE COMPLETED: 12/17/11-10-99		BORING CREW: CREW CHIEF: DRILLER: B. BOURASSA LOGGER: MRT CHECKED: TKA ADDITIONAL CREW:			BORING RIG: MOBILE B-47 BORING TYPE: SAMPLE TYPE: WEIGHT OF HAMMER: N/A DROP: N/A					
DEPTH SCALE METERS	DEPTH SCALE FEET	BORING METHOD	SOIL PROFILE			SAMPLES			SAMPLE DESCRIPTIONS AND BORING NOTES	
			USCS	GRAPHIC LOG	ELEVATION	NUMBER	TYPE	BLOWS / 6 INCHES		N
0	0	4" AUGER / 8" AUGER	0.0-5.0	Dark brown, silty, SAND.	81.9					4" Auger 0'-5'
5	5		5.0-12.5	Grayish brown, m-f SAND.	80.4					4" Auger 5'-10'
10	10		12.5	BEDROCK	78.1					8" Auger 0'-12.5' (Driller does not have 3" 4" auger piece therefore had to re-drill hole with 8" auger) Refusal at 12'6"
15	15									
DRILL RIG: MOBILE B-47 DRILLING CONTRACTOR: Con-Tec INC. DRILLER: B. BOURASSA					LOGGED: MRT CHECKED: TKA DATE:					

SHEET 1 OF 1

RECORD OF PROBEHOLE P-8										
		PROJECT NAME: RT 9 ROAD IMPROVEMENT SITE NAME: BRATTLEBORO VT STATION: 50+276.72 GROUND EL.: 80.000			PROJECT NUMBER: 993-6874 SITE NO.: OFFSET: RT 21.4 G.W. DEPTH: 7'					
HOLE NO.: P-8 SHEET 1 OF 1 DATE STARTED: 11/01/11-10-99 DATE COMPLETED: 11/05/11-10-99		BORING CREW: CREW CHIEF: DRILLER: B. BOURASSA LOGGER: MRT CHECKED: TKA ADDITIONAL CREW:			BORING RIG: MOBILE B-47 BORING TYPE: SAMPLE TYPE: WEIGHT OF HAMMER: N/A DROP: N/A					
DEPTH SCALE METERS	DEPTH SCALE FEET	BORING METHOD	SOIL PROFILE			SAMPLES			SAMPLE DESCRIPTIONS AND BORING NOTES	
			USCS	GRAPHIC LOG	ELEVATION	NUMBER	TYPE	BLOWS / 6 INCHES		N
0	0	4" AUGER	0.0-2.25	Dark brown C-M SAND	80.0					Encountered water at 1' bgs
5	5		2.25	BEDROCK	79.3					Refusal at 2'3"
10	10									
15	15									
DRILL RIG: MOBILE B-47 DRILLING CONTRACTOR: Con-Tec INC. DRILLER: B. BOURASSA					LOGGED: MRT CHECKED: TKA DATE:					

SHEET 1 OF 1

PROJECT:	BRATTLEBORO	PROJECT NO.:	NH 010-2 (2)
DESIGN FILE NAME:	U:\99123-Brattleboro\dgn\rt9br500.dgn		
DRAWN BY:	DHL	SQUAD LEADER:	JHR
DATE:	02/29/00	SHEET:	65 OF 145

RECORD OF PROBEHOLE RP-1															
PROJECT NAME: RT 9 ROAD IMPROVEMENT SITE NAME: BRATTLEBORO VT STATION: 30+00.00 GROUND EL.: 84.945			PROJECT NUMBER: 993-6874 SITE NO.: OFFSET: 8.00 LT G.W. DEPTH: 10' (APPROX.)			HOLE NO.: RP-1 SHEET 1 OF 1 DATE STARTED: 10/05/00 DATE COMPLETED: 10/05/00			BORING CREW: CREW CHIEF: DRILLER: B. BOURASSA LOGGER: MZ CHECKED: TKA ADDITIONAL CREW:			BORING RIG: BORING TYPE: AUGER SAMPLE TYPE: WEIGHT OF HAMMER: N/A DROP: N/A			
DEPTH SCALE METERS	DEPTH SCALE FEET	BORING METHOD	SOIL PROFILE			SAMPLES			SAMPLE DESCRIPTIONS AND BORING NOTES						
			USCS	GRAPHIC LOG	ELEVATION	NUMBER	TYPE	BLOWS / FOOT							N
0	0	4" O.D. - SOLID STEM AUGER			84.9	AS	N/A	N/A	N/A	0.0-20.0 Brown m-f SAND, little to some silt. Saturated at approximately 15' bgs					
1	1														
2	2														
3	3														
4	4														
5	5														
6	6			78.8					End boring @ 20' bgs						
7	7														
8	8														
9	9														
10	10														
11	11														
12	12														
DRILL RIG: DIEDRICH D-50 DRILLING CONTRACTOR: Con-Tec Inc. DRILLER: B. BOURASSA			LOGGED: MZ CHECKED: TKA DATE:			SHEET 1 OF 1									

RECORD OF PROBEHOLE RP-2																
PROJECT NAME: RT 9 ROAD IMPROVEMENT SITE NAME: BRATTLEBORO VT STATION: 30+00.00 GROUND EL.: 88.275			PROJECT NUMBER: 993-6874 SITE NO.: OFFSET: 8.00 LT G.W. DEPTH:			HOLE NO.: RP-2 SHEET 1 OF 1 DATE STARTED: 10/05/00 DATE COMPLETED: 10/05/00			BORING CREW: CREW CHIEF: DRILLER: B. BOURASSA LOGGER: MZ CHECKED: TKA ADDITIONAL CREW:			BORING RIG: BORING TYPE: AW ROD SAMPLE TYPE: WEIGHT OF HAMMER: 140 lbs DROP: 30"				
DEPTH SCALE METERS	DEPTH SCALE FEET	BORING METHOD	SOIL PROFILE			SAMPLES			SAMPLE DESCRIPTIONS AND BORING NOTES							
			USCS	GRAPHIC LOG	ELEVATION	NUMBER	TYPE	BLOWS / FOOT							N	REC. ATT.
0	0	AW ROCK PROBE - TRI POD			88.3	1	AW	4	N/A	N/A	0.0-26.2 Brown SAND or silty SAND					
1	1															
2	2															
3	3															
4	4															
5	5															
6	6															
7	7															
8	8															
9	9															
10	10															
11	11															
12	12															
DRILL RIG: TRI-POD DRILLING CONTRACTOR: Con-Tec Inc. DRILLER: B. BOURASSA			LOGGED: MZ CHECKED: TKA DATE:			SHEET 1 OF 1										

RECORD OF PROBEHOLE RP-3																
PROJECT NAME: RT 8 ROAD IMPROVEMENT SITE NAME: BRATTLEBORO VT STATION: 30+00.00 GROUND EL.: 88.317			PROJECT NUMBER: 993-6874 SITE NO.: OFFSET: 30.00 LT G.W. DEPTH:			HOLE NO.: RP-3 SHEET 1 OF 1 DATE STARTED: 12/4/00 DATE COMPLETED: 12/5/00			BORING CREW: CREW CHIEF: DRILLER: B. BOURASSA LOGGER: MZ CHECKED: TKA ADDITIONAL CREW:			BORING RIG: BORING TYPE: AW ROD SAMPLE TYPE: WEIGHT OF HAMMER: 140 lbs DROP: 30"				
DEPTH SCALE METERS	DEPTH SCALE FEET	BORING METHOD	SOIL PROFILE			SAMPLES			SAMPLE DESCRIPTIONS AND BORING NOTES							
			USCS	GRAPHIC LOG	ELEVATION	NUMBER	TYPE	BLOWS / FOOT							N	REC. ATT.
0	0	AW ROCK PROBE - TRI POD			88.3	1	AW	4	N/A	N/A	0.0-17.5 Brown SAND and silty SAND					
1	1															
2	2															
3	3															
4	4															
5	5															
6	6															
7	7															
8	8															
9	9															
10	10															
11	11															
12	12															
DRILL RIG: TRI-POD DRILLING CONTRACTOR: Con-Tec Inc. DRILLER: B. BOURASSA			LOGGED: MZ CHECKED: TKA DATE:			SHEET 1 OF 1										

RECORD OF PROBEHOLE RP-4											
HOLE NO.: RP-4 SHEET 1 OF 1 DATE STARTED: 09/20/5-2-00 DATE COMPLETED: 09/25/5-2-00			PROJECT NAME: RT 9 ROAD IMPROVEMENT SITE NAME: BRATTLEBORO VT STATION: 30-304 GROUND EL.: 90.485			PROJECT NUMBER: 993-6874 SITE NO.: OFFSET: 8.5 LT G.W. DEPTH:			BORING CREW: CREW CHIEF: DRILLER: M. ZARENSKI LOGGER: MZ CHECKED: TKA ADDITIONAL CREW:		
HOLE NO.: RP-5 SHEET 1 OF 1 DATE STARTED: 11/20/5-2-00 DATE COMPLETED: 11/30/5-2-00			PROJECT NAME: RT 9 ROAD IMPROVEMENT SITE NAME: BRATTLEBORO VT STATION: 30-285.02 GROUND EL.: 89.972			PROJECT NUMBER: 993-6874 SITE NO.: OFFSET: 6.49 LT G.W. DEPTH:			BORING CREW: CREW CHIEF: DRILLER: B. BOURASSA LOGGER: MZ CHECKED: TKA ADDITIONAL CREW:		
HOLE NO.: RP-6 SHEET 1 OF 1 DATE STARTED: 13/15/5-2-00 DATE COMPLETED: 13/30/5-2-00			PROJECT NAME: RT 9 ROAD IMPROVEMENT SITE NAME: BRATTLEBORO VT STATION: 30-300.01 GROUND EL.: 90.037			PROJECT NUMBER: 993-6874 SITE NO.: OFFSET: 18.01 G.W. DEPTH:			BORING CREW: CREW CHIEF: DRILLER: G. DEAN LOGGER: MZ CHECKED: TKA ADDITIONAL CREW:		
DEPTH SCALE METERS	DEPTH SCALE FEET	BORING METHOD	SOIL PROFILE			SAMPLES			SAMPLE DESCRIPTIONS AND BORING NOTES		
			USCS	GRAPHIC LOG	ELEVATION	NUMBER	TYPE	BLOWS / FOOT			
0	0	HAND AUGER			90.5	N/A	N/A	N/A	N/A	N/A	0.0-0.25 Moist brown silty fine SAND; little to some organic matter 0.25 BEDROCK
0	0				90.4						Auger refusal @ 0.25' bgs
1	1										
2	2										
3	3										
4	4										
5	5										
6	6										
DRILL RIG: HAND AUGER						LOGGED: MZ					
DRILLING CONTRACTOR: Golder Associates						CHECKED: TKA					
DRILLER: M. ZARENSKI						DATE:					
SHEET 1 OF 1											

RECORD OF PROBEHOLE RP-5											
HOLE NO.: RP-5 SHEET 1 OF 1 DATE STARTED: 11/20/5-2-00 DATE COMPLETED: 11/30/5-2-00			PROJECT NAME: RT 9 ROAD IMPROVEMENT SITE NAME: BRATTLEBORO VT STATION: 30-285.02 GROUND EL.: 89.972			PROJECT NUMBER: 993-6874 SITE NO.: OFFSET: 6.49 LT G.W. DEPTH:			BORING CREW: CREW CHIEF: DRILLER: B. BOURASSA LOGGER: MZ CHECKED: TKA ADDITIONAL CREW:		
HOLE NO.: RP-6 SHEET 1 OF 1 DATE STARTED: 13/15/5-2-00 DATE COMPLETED: 13/30/5-2-00			PROJECT NAME: RT 9 ROAD IMPROVEMENT SITE NAME: BRATTLEBORO VT STATION: 30-300.01 GROUND EL.: 90.037			PROJECT NUMBER: 993-6874 SITE NO.: OFFSET: 18.01 G.W. DEPTH:			BORING CREW: CREW CHIEF: DRILLER: G. DEAN LOGGER: MZ CHECKED: TKA ADDITIONAL CREW:		
DEPTH SCALE METERS	DEPTH SCALE FEET	BORING METHOD	SOIL PROFILE			SAMPLES			SAMPLE DESCRIPTIONS AND BORING NOTES		
			USCS	GRAPHIC LOG	ELEVATION	NUMBER	TYPE	BLOWS / FOOT			
0	0	AW ROCK PROBE - TRI POD			90.0	1	AW	1	N/A	N/A	0.0-11.6 Brown SAND
0	0										
1	1										
2	2										
3	3										
4	4										
5	5										
6	6										
DRILL RIG: TRI-POD						LOGGED: MZ					
DRILLING CONTRACTOR: Con-Tec Inc.						CHECKED: TKA					
DRILLER: B. BOURASSA						DATE:					
SHEET 1 OF 1											

RECORD OF PROBEHOLE RP-6											
HOLE NO.: RP-6 SHEET 1 OF 1 DATE STARTED: 13/15/5-2-00 DATE COMPLETED: 13/30/5-2-00			PROJECT NAME: RT 9 ROAD IMPROVEMENT SITE NAME: BRATTLEBORO VT STATION: 30-300.01 GROUND EL.: 90.037			PROJECT NUMBER: 993-6874 SITE NO.: OFFSET: 18.01 G.W. DEPTH:			BORING CREW: CREW CHIEF: DRILLER: G. DEAN LOGGER: MZ CHECKED: TKA ADDITIONAL CREW:		
HOLE NO.: RP-7 SHEET 1 OF 1 DATE STARTED: 10/05/2-2000 DATE COMPLETED: 10/29/5-2-2000			PROJECT NAME: RT 9 ROAD IMPROVEMENT SITE NAME: BRATTLEBORO VT STATION: 30-326.00 GROUND EL.: 89.964			PROJECT NUMBER: 993-6874 SITE NO.: OFFSET: 8.01 G.W. DEPTH:			BORING CREW: CREW CHIEF: DRILLER: G. DEAN LOGGER: MZ CHECKED: TKA ADDITIONAL CREW:		
DEPTH SCALE METERS	DEPTH SCALE FEET	BORING METHOD	SOIL PROFILE			SAMPLES			SAMPLE DESCRIPTIONS AND BORING NOTES		
			USCS	GRAPHIC LOG	ELEVATION	NUMBER	TYPE	BLOWS / FOOT			
0	0	AW ROCK PROBE/HAND AUGER			90.0	1	AW	6	N/A	N/A	0.0-0.25 Black silty SAND, moist, some organic matter 0.25-4.5 Olive green to gray m-f SAND, trace silt
0	0										
1	1										
2	2										
3	3										
4	4										
5	5										
6	6										
DRILL RIG: TRI-POD						LOGGED: MZ					
DRILLING CONTRACTOR: Con-Tec Inc.						CHECKED: TKA					
DRILLER: G. DEAN						DATE:					
SHEET 1 OF 1											

RECORD OF BOREHOLE RP-7											
HOLE NO.: RP-7 SHEET 1 OF 1 DATE STARTED: 10/05/2-2000 DATE COMPLETED: 10/29/5-2-2000			PROJECT NAME: RT 9 ROAD IMPROVEMENT SITE NAME: BRATTLEBORO VT STATION: 30-326.00 GROUND EL.: 89.964			PROJECT NUMBER: 993-6874 SITE NO.: OFFSET: 8.01 G.W. DEPTH:			BORING CREW: CREW CHIEF: DRILLER: G. DEAN LOGGER: MZ CHECKED: TKA ADDITIONAL CREW:		
HOLE NO.: RP-8 SHEET 1 OF 1 DATE STARTED: 12/05/5-2-00 DATE COMPLETED: 12/05/5-2-00			PROJECT NAME: RT 9 ROAD IMPROVEMENT SITE NAME: BRATTLEBORO VT STATION: 30-326.00 GROUND EL.: 89.964			PROJECT NUMBER: 993-6874 SITE NO.: OFFSET: 8.01 G.W. DEPTH:			BORING CREW: CREW CHIEF: DRILLER: G. DEAN LOGGER: MZ CHECKED: TKA ADDITIONAL CREW:		
DEPTH SCALE METERS	DEPTH SCALE FEET	BORING METHOD	SOIL PROFILE			SAMPLES			SAMPLE DESCRIPTIONS AND BORING NOTES		
			USCS	GRAPHIC LOG	ELEVATION	NUMBER	TYPE	BLOWS / FOOT			
0	0	AW ROCK PROBE - TRI POD			89.2	1	AW	4	N/A	N/A	0.0-16.7' Brown SAND
0	0										
1	1										
2	2										
3	3										
4	4										
5	5										
6	6										
DRILL RIG: TRI-POD						LOGGED: MZ					
DRILLING CONTRACTOR: Con-Tec Inc.						CHECKED: TKA					
DRILLER: G. DEAN						DATE:					
SHEET 1 OF 1											

RECORD OF PROBEHOLE RP-8											
HOLE NO.: RP-8 SHEET 1 OF 1 DATE STARTED: 12/05/5-2-00 DATE COMPLETED: 12/05/5-2-00			PROJECT NAME: RT 9 ROAD IMPROVEMENT SITE NAME: BRATTLEBORO VT STATION: 30-326.00 GROUND EL.: 89.964			PROJECT NUMBER: 993-6874 SITE NO.: OFFSET: 8.01 G.W. DEPTH:			BORING CREW: CREW CHIEF: DRILLER: G. DEAN LOGGER: MZ CHECKED: TKA ADDITIONAL CREW:		
HOLE NO.: RP-9 SHEET 1 OF 1 DATE STARTED: 09/10/5-2-00 DATE COMPLETED: 10/29/5-2-00			PROJECT NAME: RT 9 ROAD IMPROVEMENT SITE NAME: BRATTLEBORO VT STATION: 30-326.00 GROUND EL.: 89.964			PROJECT NUMBER: 993-6874 SITE NO.: OFFSET: 8.01 G.W. DEPTH:			BORING CREW: CREW CHIEF: DRILLER: G. DEAN LOGGER: MZ CHECKED: TKA ADDITIONAL CREW:		
DEPTH SCALE METERS	DEPTH SCALE FEET	BORING METHOD	SOIL PROFILE			SAMPLES			SAMPLE DESCRIPTIONS AND BORING NOTES		
			USCS	GRAPHIC LOG	ELEVATION	NUMBER	TYPE	BLOWS / FOOT			
0	0	AW ROCK PROBE - TRI POD			87.4	1	AW	3	N/A	N/A	0.0-18.75' Black to brown SAND
0	0										
1	1										
2	2										
3	3										
4	4										
5	5										
6	6										
DRILL RIG: TRI-POD						LOGGED: MZ					
DRILLING CONTRACTOR: Con-Tec Inc.						CHECKED: TKA					
DRILLER: G. DEAN						DATE:					
SHEET 1 OF 1											

RECORD OF PROBEHOLE RP-9											
HOLE NO.: RP-9 SHEET 1 OF 1 DATE STARTED: 09/10/5-2-00 DATE COMPLETED: 10/29/5-2-00			PROJECT NAME: RT 9 ROAD IMPROVEMENT SITE NAME: BRATTLEBORO VT STATION: 30-326.00 GROUND EL.: 89.964			PROJECT NUMBER: 993-6874 SITE NO.: OFFSET: 8.01 G.W. DEPTH:			BORING CREW: CREW CHIEF: DRILLER: G. DEAN LOGGER: MZ CHECKED: TKA ADDITIONAL CREW:		
DEPTH SCALE METERS	DEPTH SCALE FEET	BORING METHOD	SOIL PROFILE			SAMPLES			SAMPLE DESCRIPTIONS AND BORING NOTES		
			USCS	GRAPHIC LOG	ELEVATION	NUMBER	TYPE	BLOWS / FOOT			
0	0	AW ROCK PROBE/HAND AUGER			89.0	1	HAND AUGER	N/A	N/A	N/A	0.0-0.25 Black, moist silty SAND some organics 0.0-4.5 Olive green to gray m-f SAND, trace to some silt
0	0										
1	1										
2	2										
3	3										
4	4										
5	5										
6	6										
DRILL RIG: TRI-POD/HAND AUGER						LOGGED: MZ					
DRILLING CONTRACTOR: Con-Tec Inc.						CHECKED: TKA					
DRILLER: G. DEAN						DATE:					
SHEET 1 OF 1											

RECORD OF PROBEHOLE RP-10											
PROJECT INFORMATION			SOIL PROFILE			SAMPLES			BORING NOTES		
DEPTH SCALE METERS	DEPTH SCALE FEET	BORING METHOD	USCS	GRAPHIC LOG ELEVATION	NUMBER	TYPE	BLOWS / FOOT	N	REC.VAT.	SAMPLE DESCRIPTIONS AND BORING NOTES	
0	0	HAND AUGER		83.1						0.0-0.25' Moist black silty SAND some organics	
0	0			83.0						0.25-4.0' Olive green fine SAND trace to little silt. moist	
0	0			81.7						4.0-4.5' Olive green to tan fine SAND with red oxidized zones wet - saturated	
0	0									4.5' BEDROCK	
0	0									Auger refusal @ 4.5' bgs	
0	0									NOTE: THIS ROCKPROBE LOCATED APPROX. 4 FEET SOUTH OF SURVEY LOCATION (APPROX. 1 FOOT LOWER IN ELEVATION) DUE TO HEAVY VEGETATION.	
DRILL RIG: HAND AUGER DRILLING CONTRACTOR: GOLDER ASSOCIATES DRILLER: M. ZARENSKI			LOGGED: MZ CHECKED: TKA DATE:			SHEET 1 OF 1					


RECORD OF PROBEHOLE RP-11											
PROJECT INFORMATION			SOIL PROFILE			SAMPLES			BORING NOTES		
DEPTH SCALE METERS	DEPTH SCALE FEET	BORING METHOD	USCS	GRAPHIC LOG ELEVATION	NUMBER	TYPE	BLOWS / FOOT	N	REC.VAT.	SAMPLE DESCRIPTIONS AND BORING NOTES	
0	0	4" O.D. SOLID STEM AUGER		77.9	1	AS	N/A	N/A	N/A	0.0-2.5' Fill material - 3/4 inch stone with sand and silt	
0	0			77.1	2	AS	N/A	N/A	N/A	2.5-3.0' Bedrock (weathered)	
0	0			76.9						2.5'-3.0' weathered Bedrock End boring at 3' bgs	
NOTE: This rockprobe drilled at edge of pavement on Route 5 west bound lane.											
DRILL RIG: DIEDRICH D-50 DRILLING CONTRACTOR: Con-Tec Inc. DRILLER: B. BOURASSA			LOGGED: MZ CHECKED: TKA DATE:			SHEET 1 OF 1					

RECORD OF PROBEHOLE RP-12												
PROJECT INFORMATION			SOIL PROFILE			SAMPLES			BORING NOTES			
DEPTH SCALE METERS	DEPTH SCALE FEET	BORING METHOD	USCS	GRAPHIC LOG ELEVATION	NUMBER	TYPE	BLOWS / FOOT	N	REC.VAT.	SAMPLE DESCRIPTIONS AND BORING NOTES		
0	0	AW ROCK PROBE - TRI-POD		80.0	1	AW	3	N/A	N/A	0.0-7.5' Black and Brown SAND		
0	0						2			saturated @ 2' bgs.		
0	0						5					
0	0						10					
0	0						14					
0	0						20		N/A	N/A	Rod Refusal @ 7.5' bgs	
0	0						26					
0	0			77.7						1.5' Bedrock		
DRILL RIG: TRI-POD DRILLING CONTRACTOR: Con-Tec Inc. DRILLER: B. BOURASSA			LOGGED: MZ CHECKED: TKA DATE:			SHEET 1 OF 1						


RECORD OF PROBEHOLE RP-13											
PROJECT INFORMATION			SOIL PROFILE			SAMPLES			BORING NOTES		
DEPTH SCALE METERS	DEPTH SCALE FEET	BORING METHOD	USCS	GRAPHIC LOG ELEVATION	NUMBER	TYPE	BLOWS / FOOT	N	REC.VAT.	SAMPLE DESCRIPTIONS AND BORING NOTES	
0	0	AW ROCK PROBE - TRI-POD		77.9						0.0-3.5' Black silty SAND and Stone (Fill material)	
0	0			76.8						3.5' Bedrock	
Rod Refusal @ 3.5' bgs											
DRILL RIG: TRI-POD DRILLING CONTRACTOR: Con-Tec Inc. DRILLER: B. BOURASSA			LOGGED: MZ CHECKED: TKA DATE:			SHEET 1 OF 1					

RECORD OF PAVEMENT CORE C-1											
PROJECT INFORMATION			SOIL PROFILE			SAMPLES			BORING NOTES		
DEPTH SCALE METERS	DEPTH SCALE FEET	BORING METHOD	USCS	GRAPHIC LOG ELEVATION	NUMBER	TYPE	BLOWS / FOOT	N	REC.VAT.	SAMPLE DESCRIPTIONS AND BORING NOTES	
0	0	6" O.D. SOLID STEM AUGERS		84.3						0.0-0.5' Asphalt	
0	0			84.1						0.5-2.5' Subbase	
0	0			83.5						2.5-3.0' Brown silty SAND (Native Material)	
0	0			83.4						2.5'-3.0' Native Material - brown silty SAND End boring at 3' bgs	
DRILL RIG: DIEDRICH D-50 DRILLING CONTRACTOR: Con-Tec Inc. DRILLER: B. BOURASSA			LOGGED: MZ CHECKED: TKA DATE:			SHEET 1 OF 1					

RECORD OF PAVEMENT CORE C-2											
PROJECT INFORMATION			SOIL PROFILE			SAMPLES			BORING NOTES		
DEPTH SCALE METERS	DEPTH SCALE FEET	BORING METHOD	USCS	GRAPHIC LOG ELEVATION	NUMBER	TYPE	BLOWS / FOOT	N	REC.VAT.	SAMPLE DESCRIPTIONS AND BORING NOTES	
0	0	6" O.D. SOLID STEM AUGERS		78.3						0.0-0.5' Asphalt	
0	0			78.1						0.5-2.0' Subbase	
0	0			77.6						2.0-3.0' Possibly native material	
0	0			77.3						End boring at 3' bgs	
DRILL RIG: DIEDRICH D-50 DRILLING CONTRACTOR: Con-Tec Inc. DRILLER: B. BOURASSA			LOGGED: MZ CHECKED: TKA DATE:			SHEET 1 OF 1					

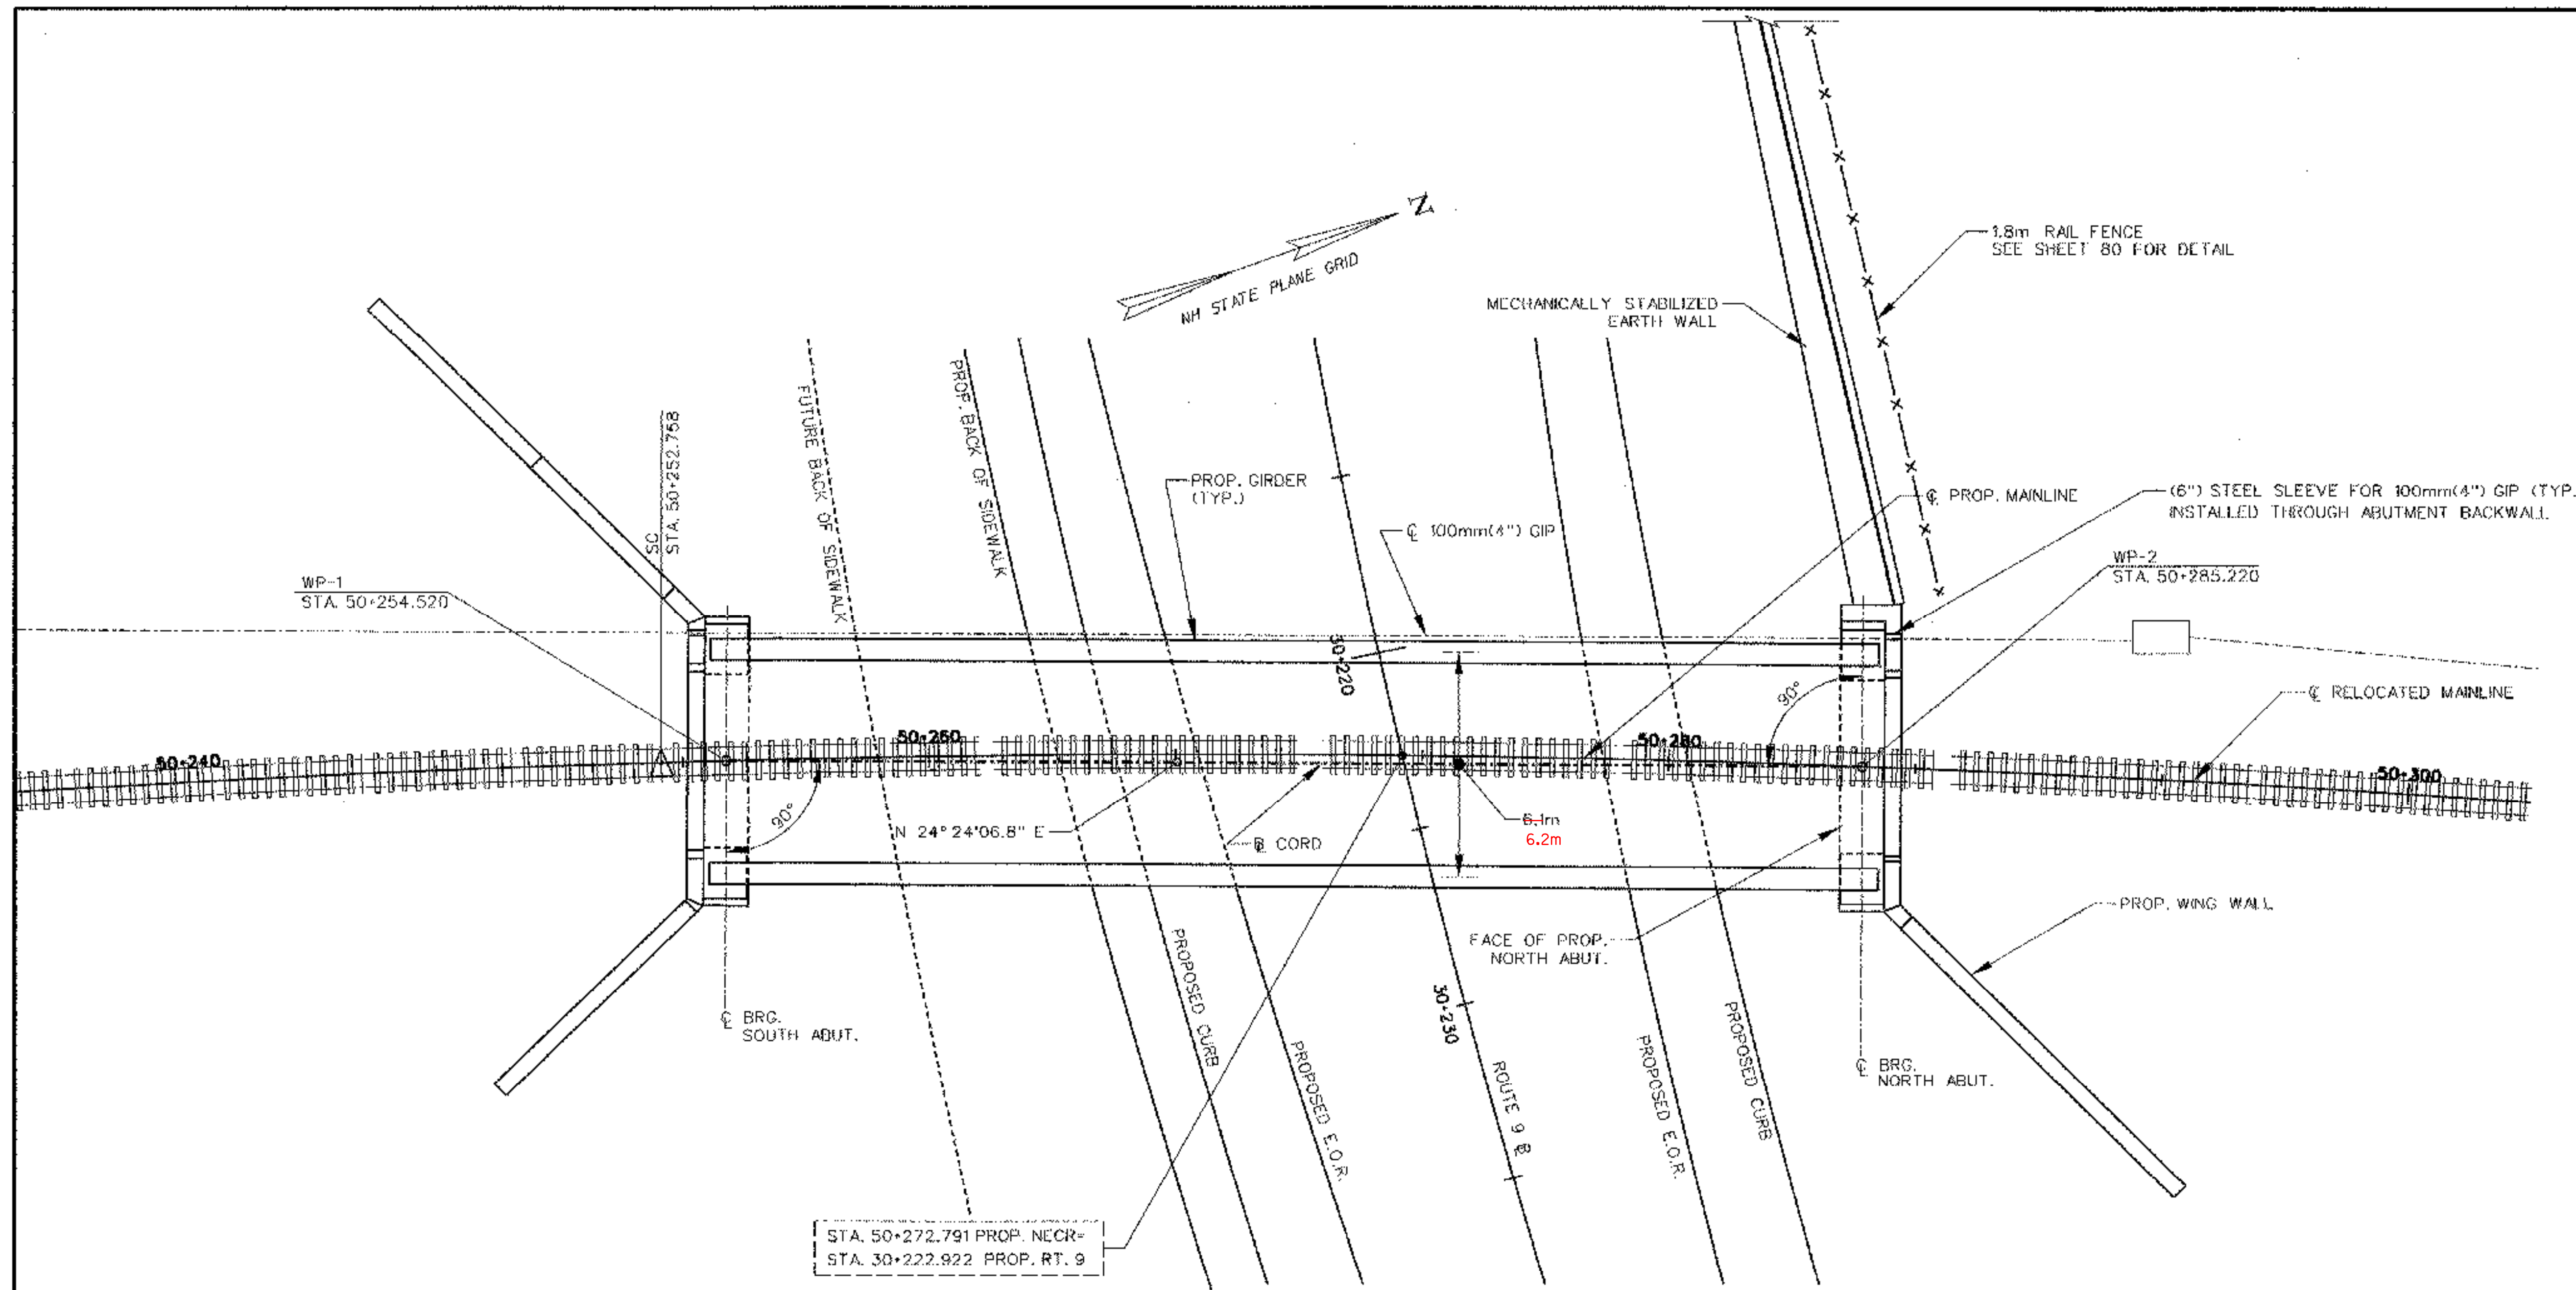









**ROUTE 9 BRIDGE
PLAN**
SCALE: 1:100

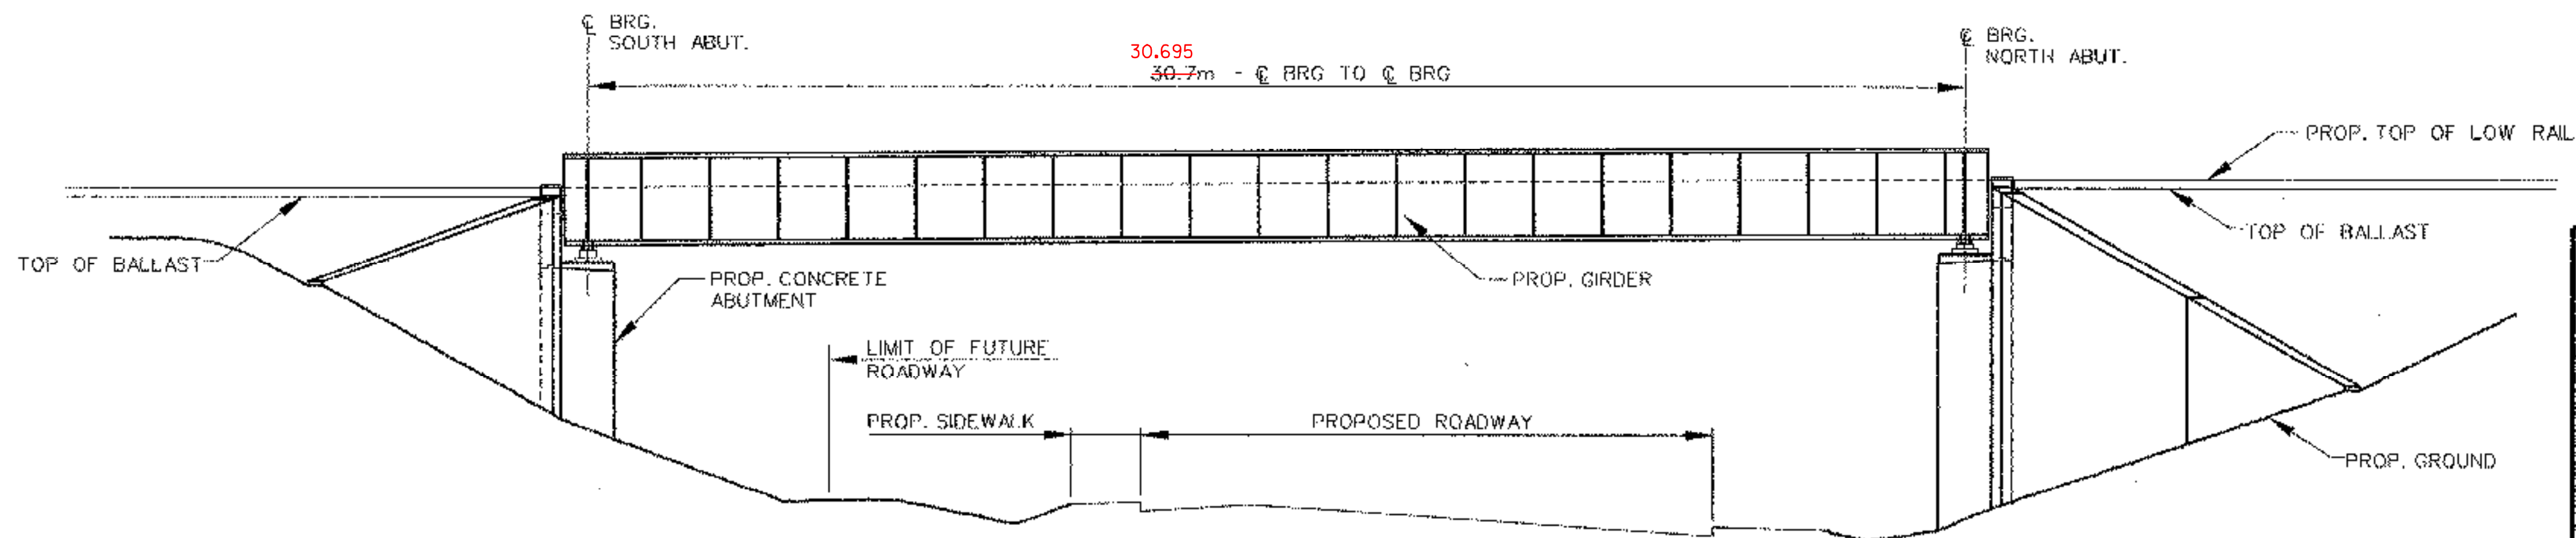

**ROUTE 9 BRIDGE
ELEVATION**
SCALE: 1:100

STATE OF VERMONT AGENCY OF TRANSPORTATION			
Town Of	BRATTLEBORO	Bridge No.	62.56
Highway No.	VT. ROUTE 9	Log Sta.	
		Surv. Sta.	
ROUTE 9 BRIDGE			
BRIDGE PLAN & ELEVATION			
Designed By	LM	Drawn By	DHL
Checked By	GJB	Bridge Design Supervisor	JHR
	Date	Date	
PROJECT	BRATTLEBORO	PROJECT NO.	NH BRF 012-1(33)
I.G.C. Info.		Bridge Sheet No. 1	
		Sheet 69 of 145	


Plot Date: 10-03-2002
File: r19br100.dgn

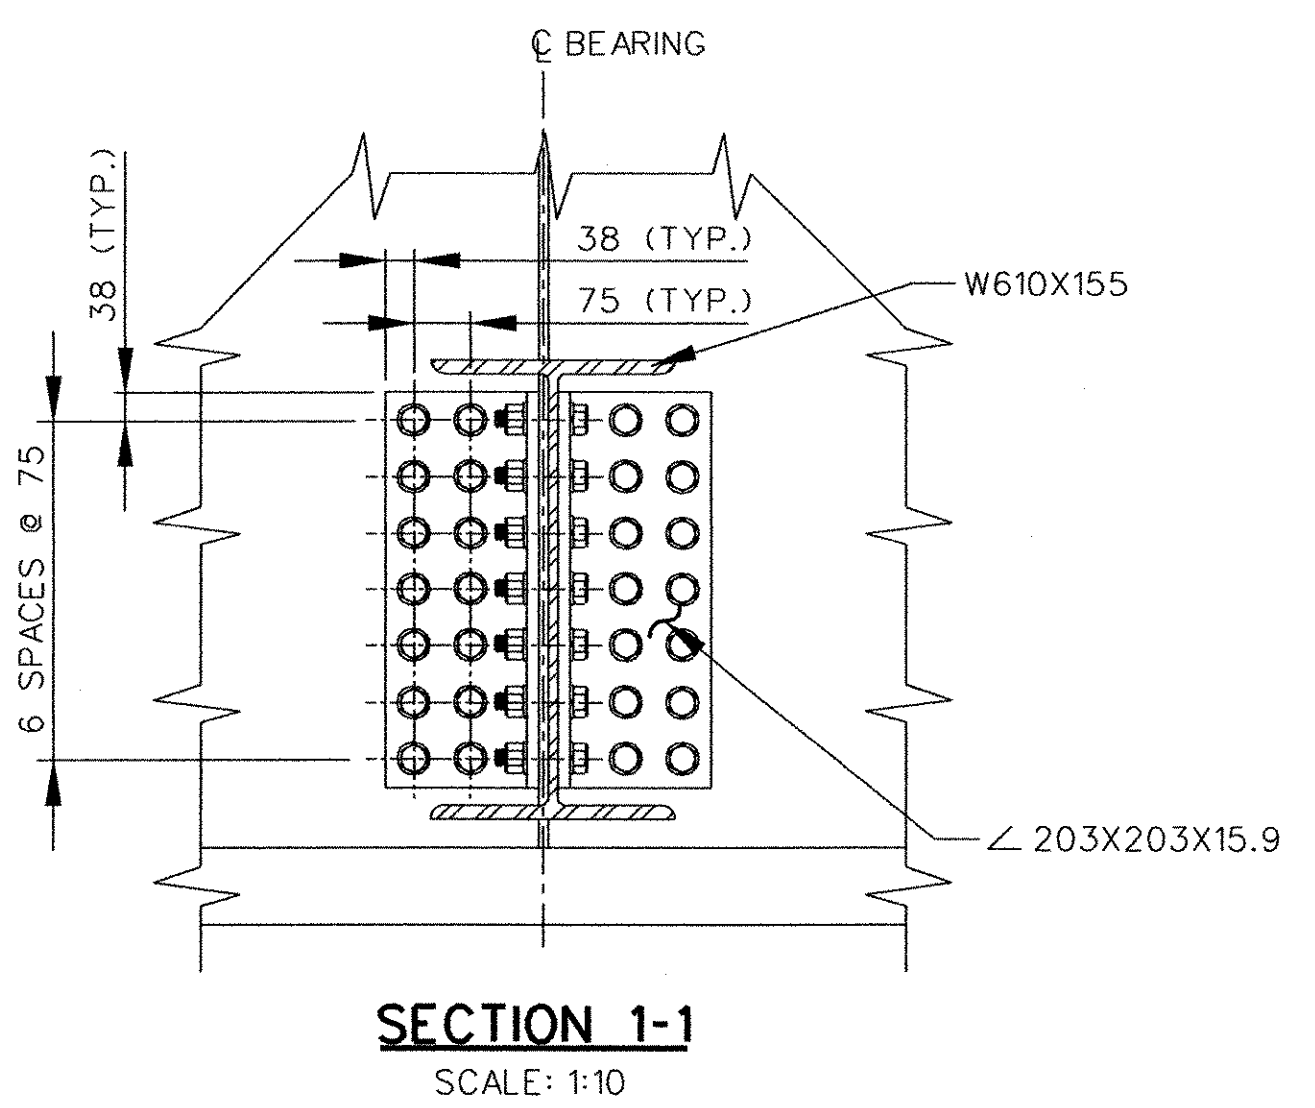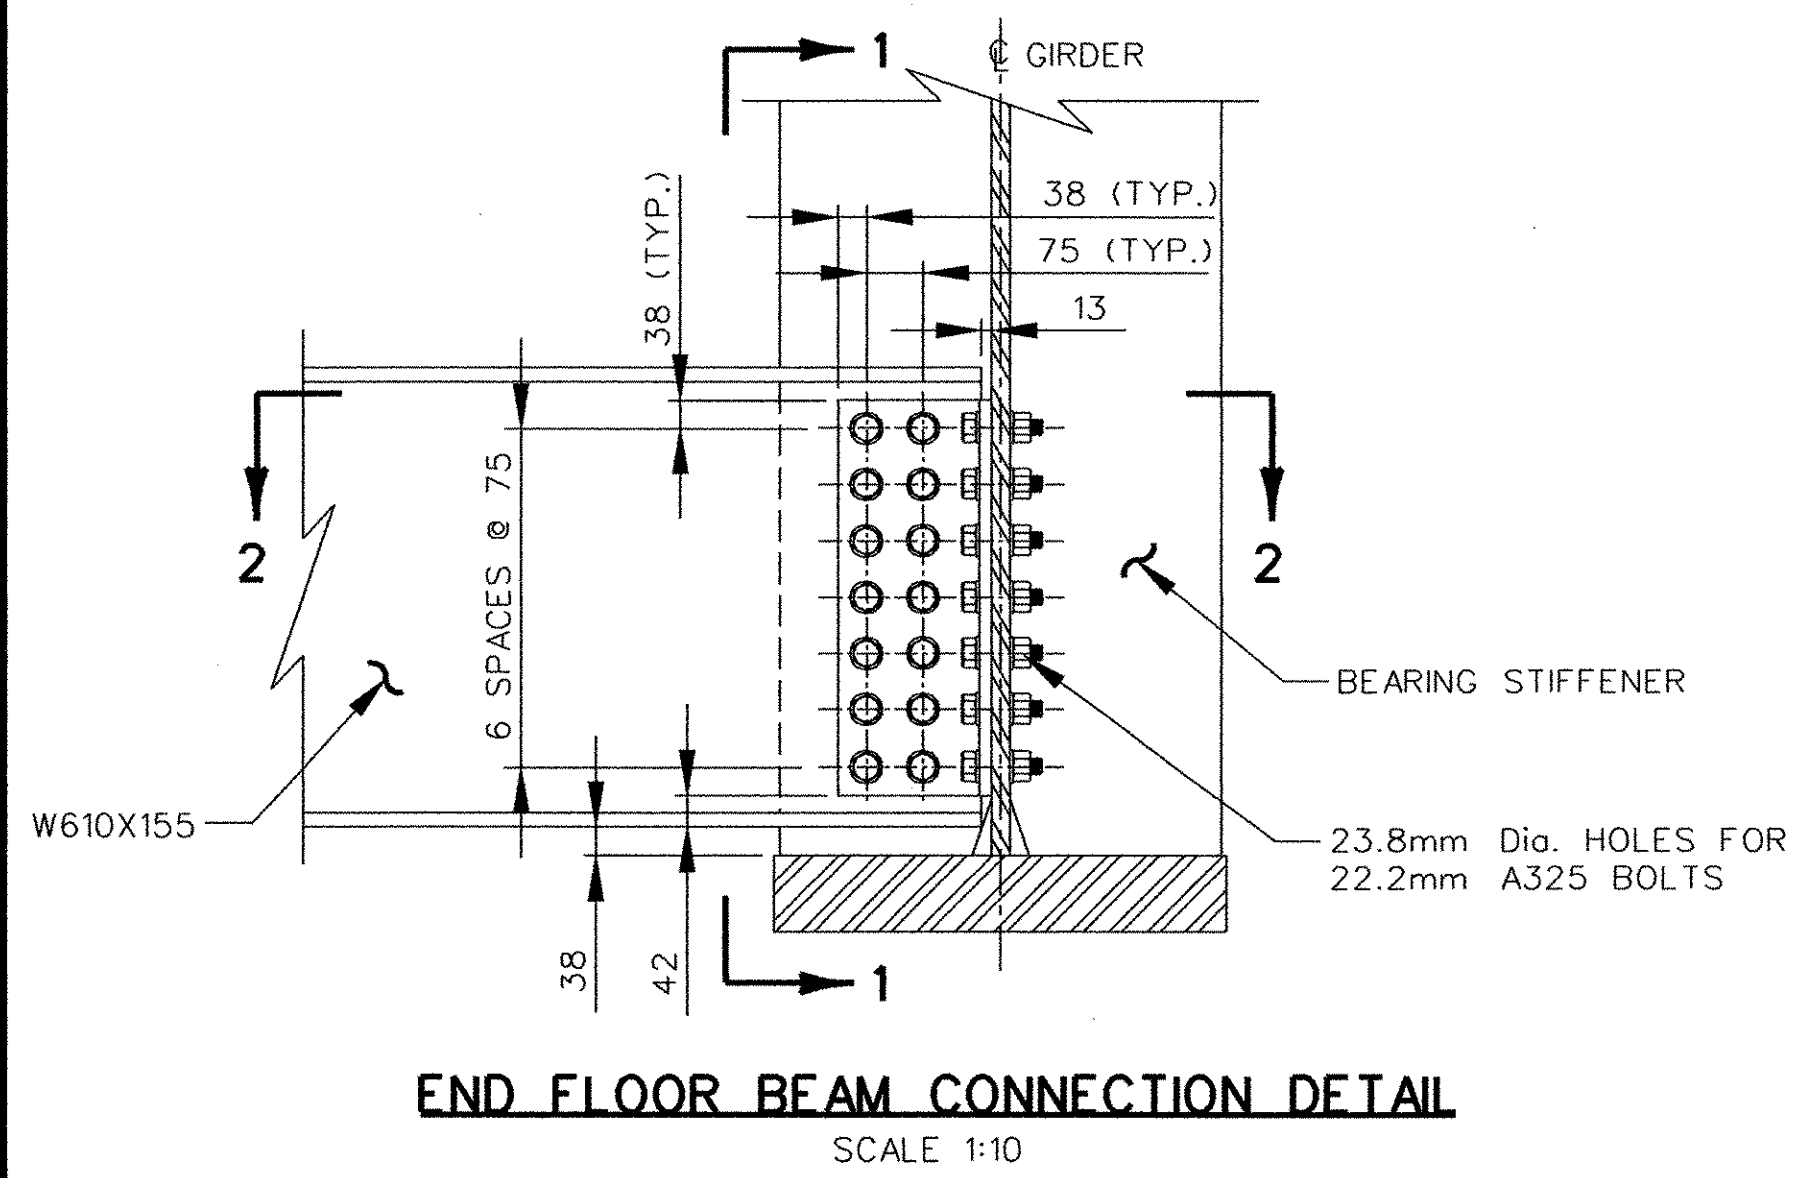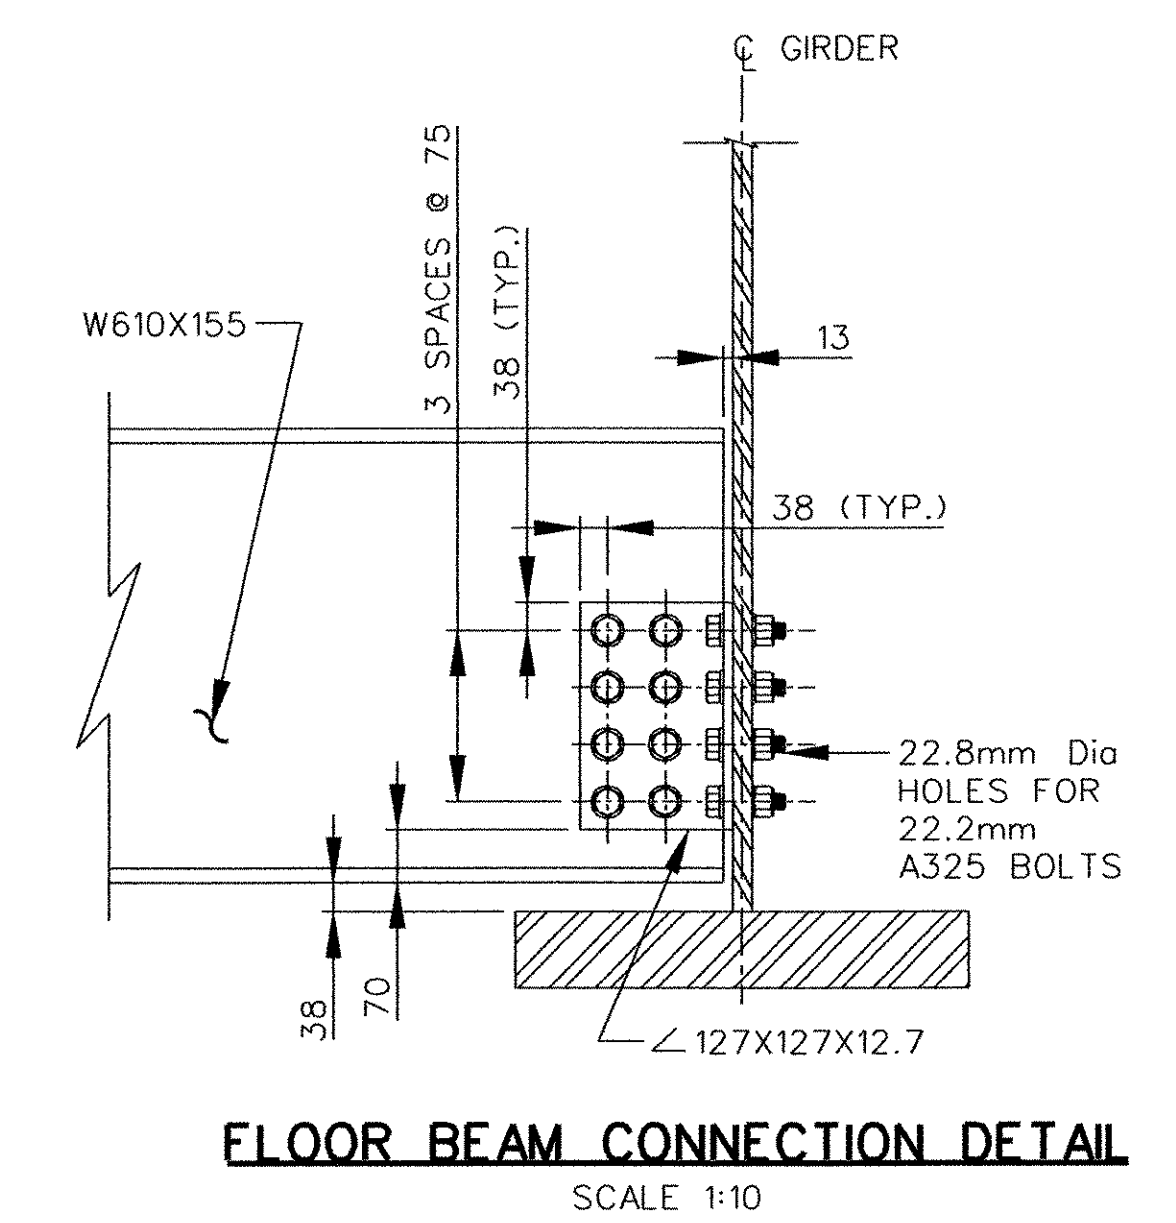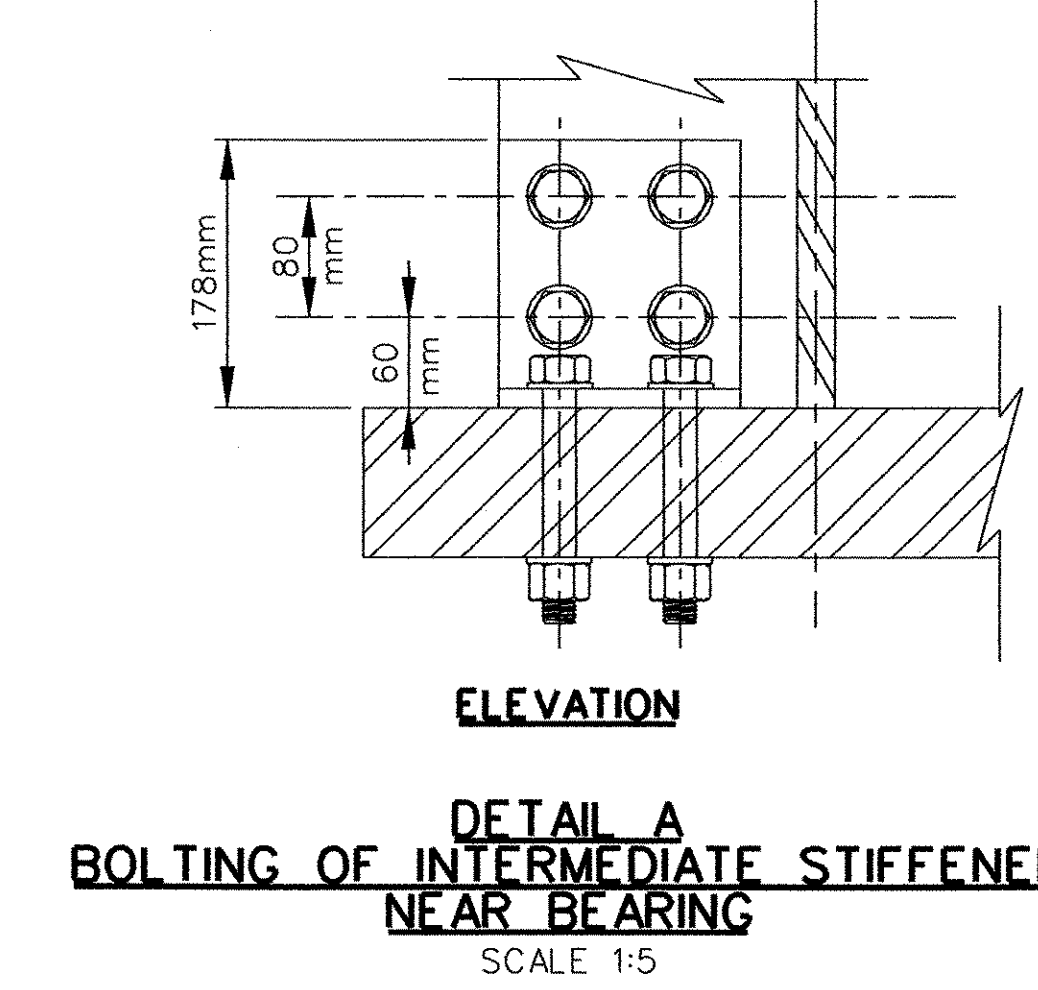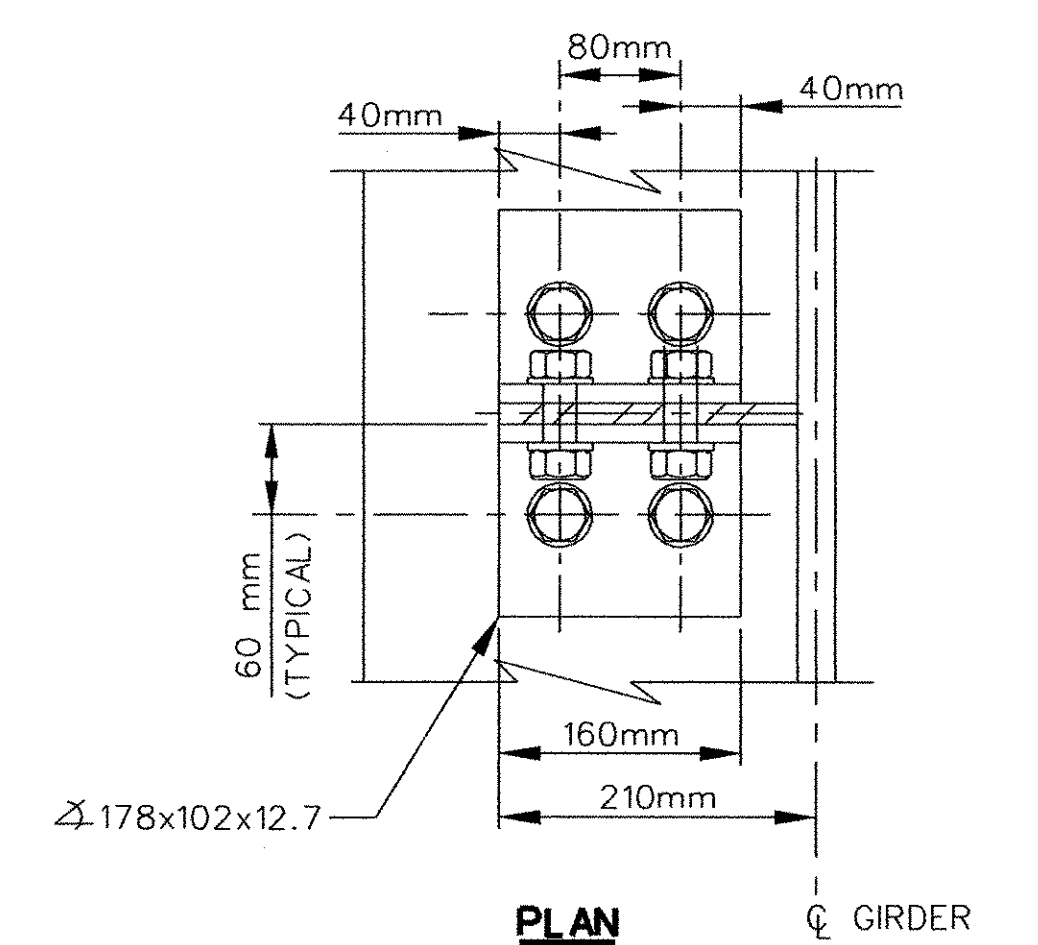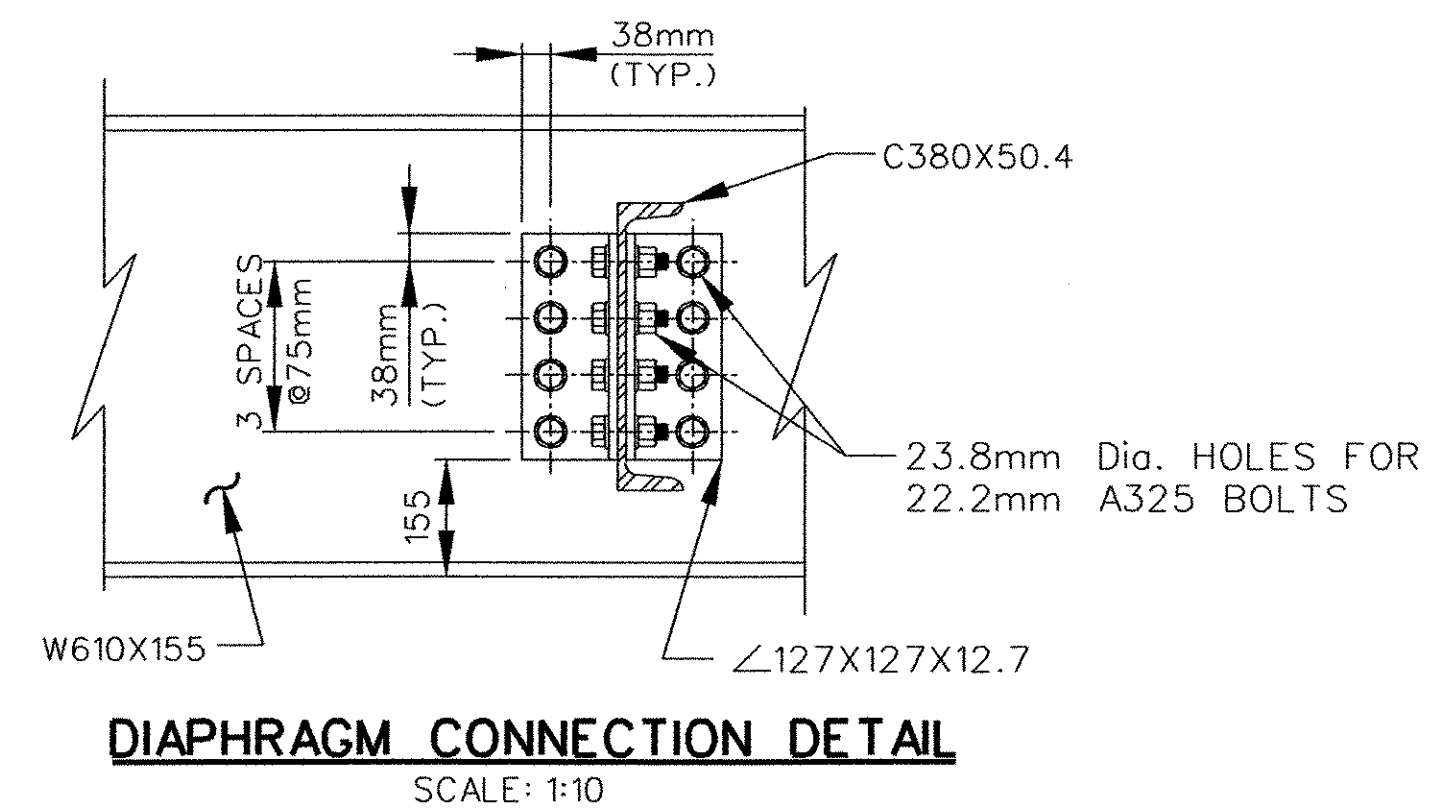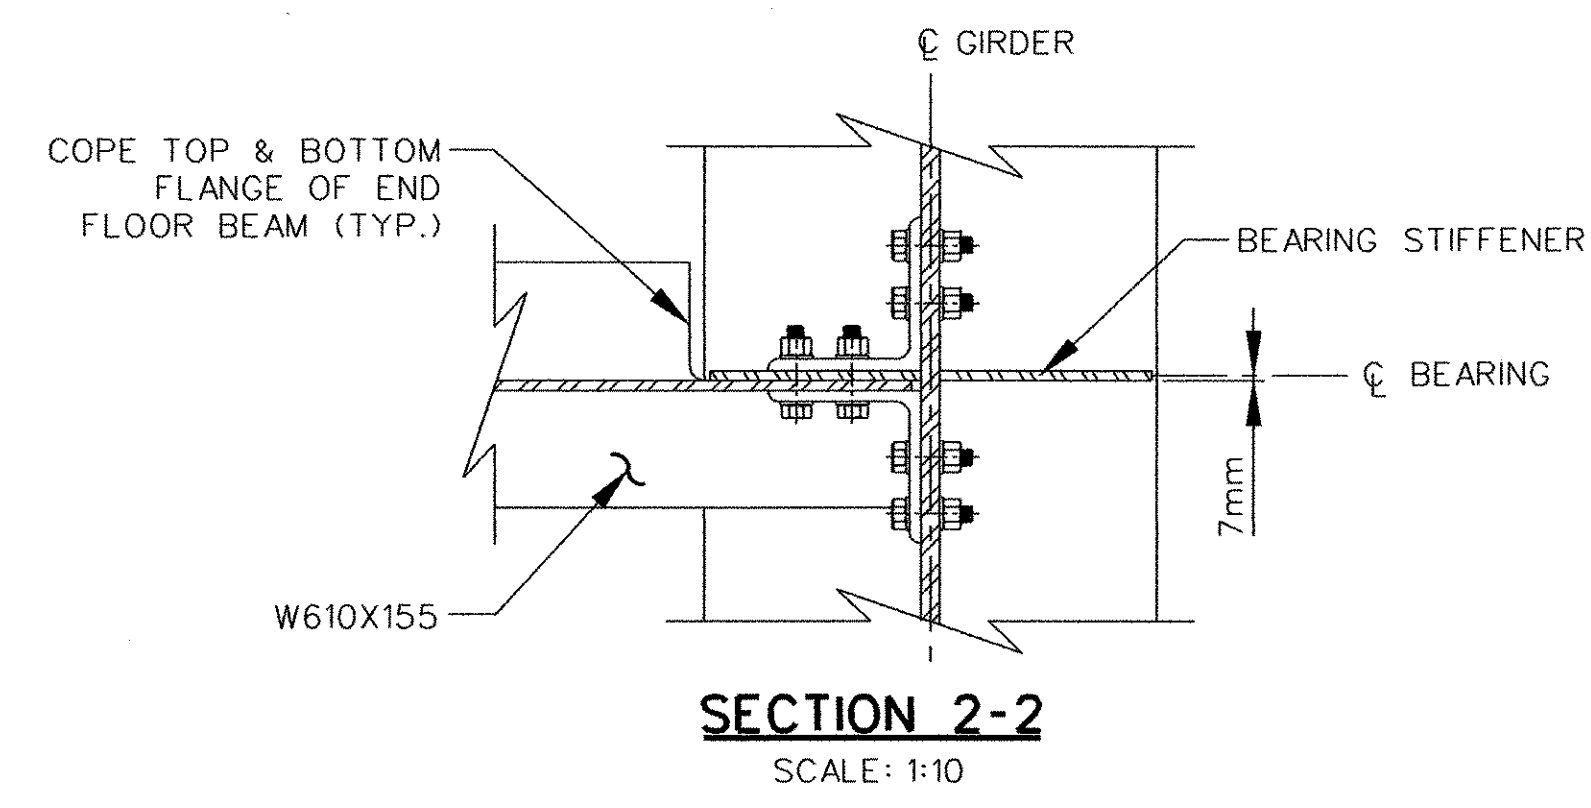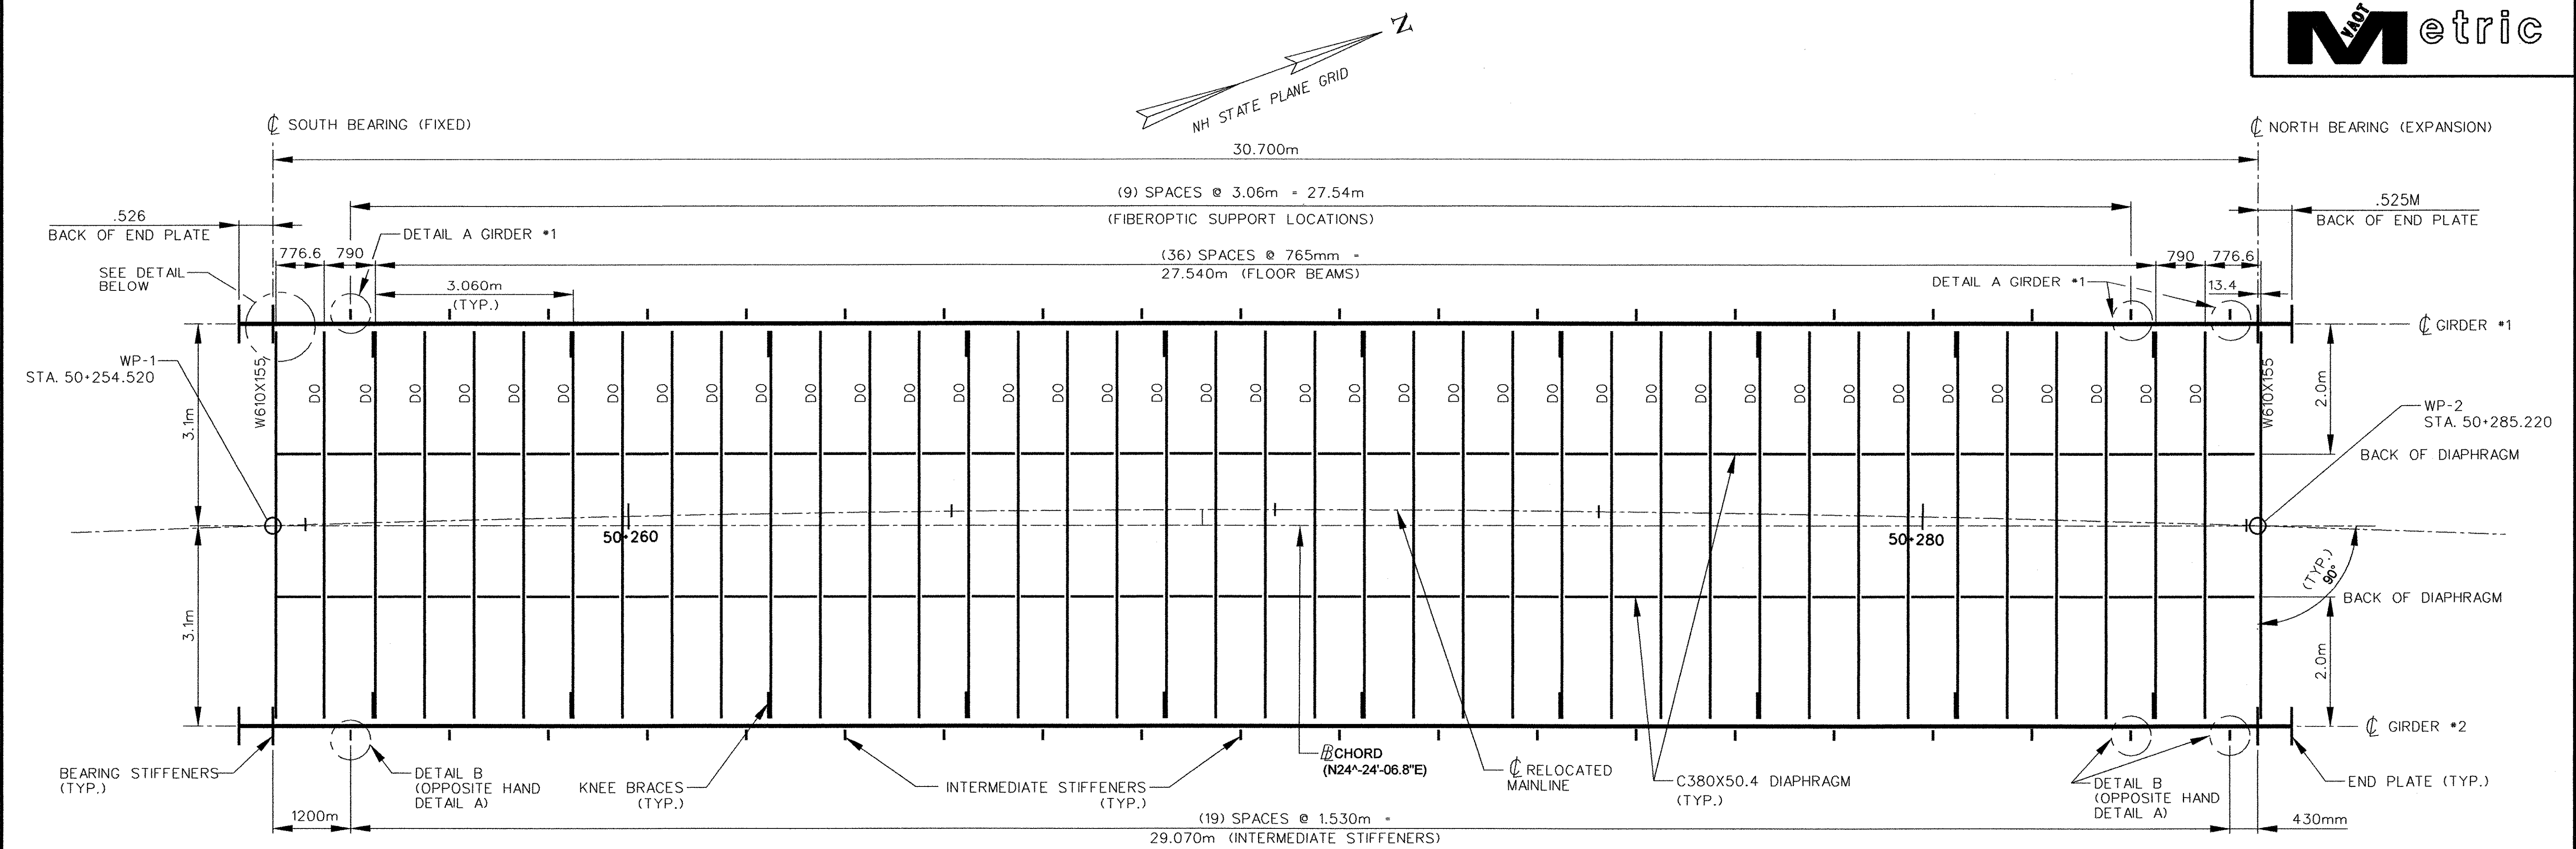

NOTE: DETAIL B (OPPOSITE HAND)


Plot Date: 10-28-2002
File: r19br150

STATE OF VERMONT AGENCY OF TRANSPORTATION		
Town Of	BRATTLEBORO	Bridge No. 62.56
Highway No.	VT. ROUTE 9	Log Sto.
		Surv. Sto.
ROUTE 9 BRIDGE		
FRAMING PLAN & CONNECTION DETAILS		
Designed By	LM	Drawn By
Checked By	GJB	Date
		Bridge Design Supervisor
		Date
PROJECT	BRATTLEBORO	PROJECT NO.
		NH 010-2(2)
I.G.C. Info.		
Bridge Sheet No. 2		Sheet 70 of 145

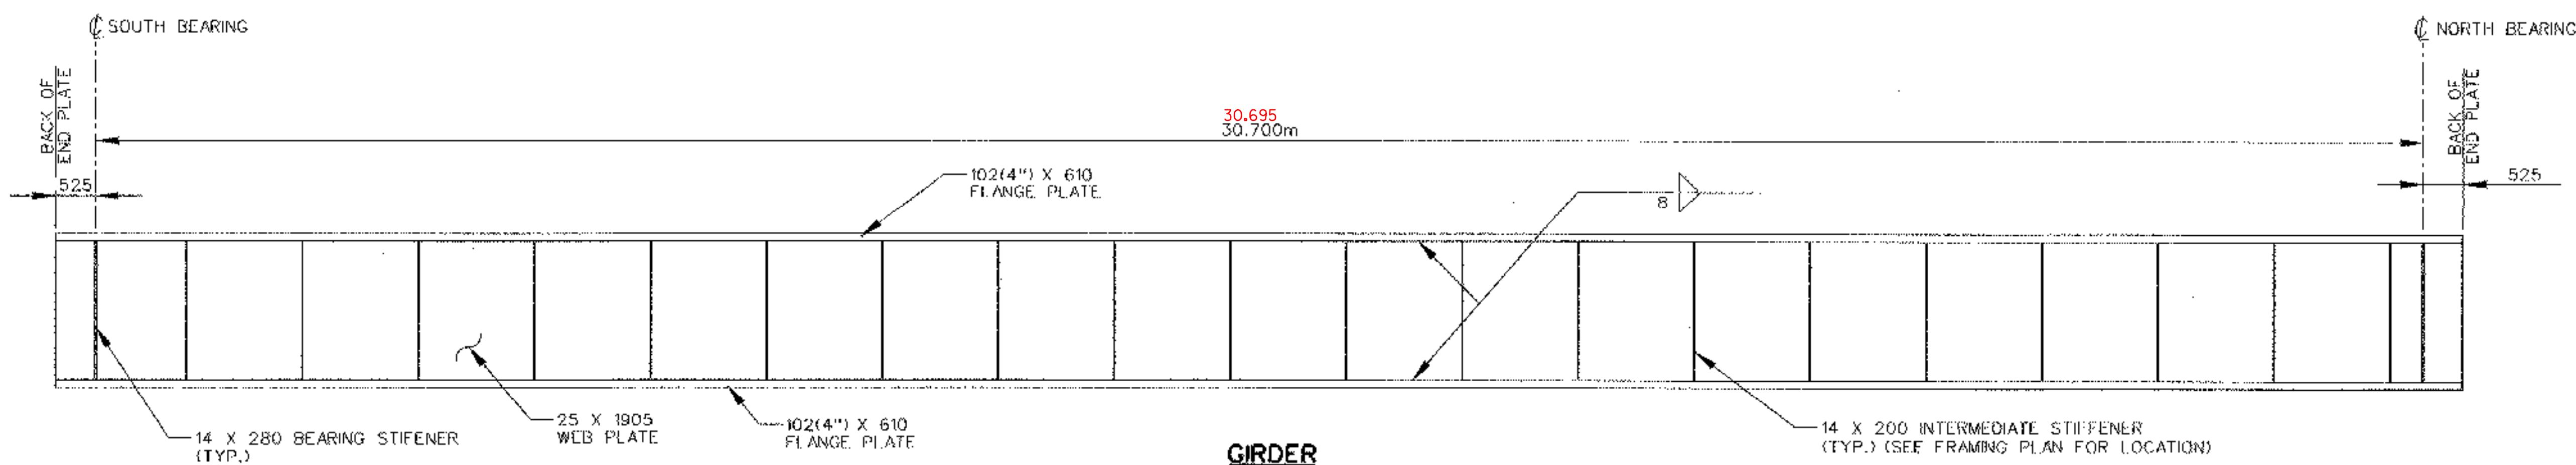


**GIRDER
OUTSIDE VIEW**
SCALE: 1:50

NOTE: EAST GIRDER SHOWN. WEST GIRDER SIMILAR, SEE FRAMING PLAN.

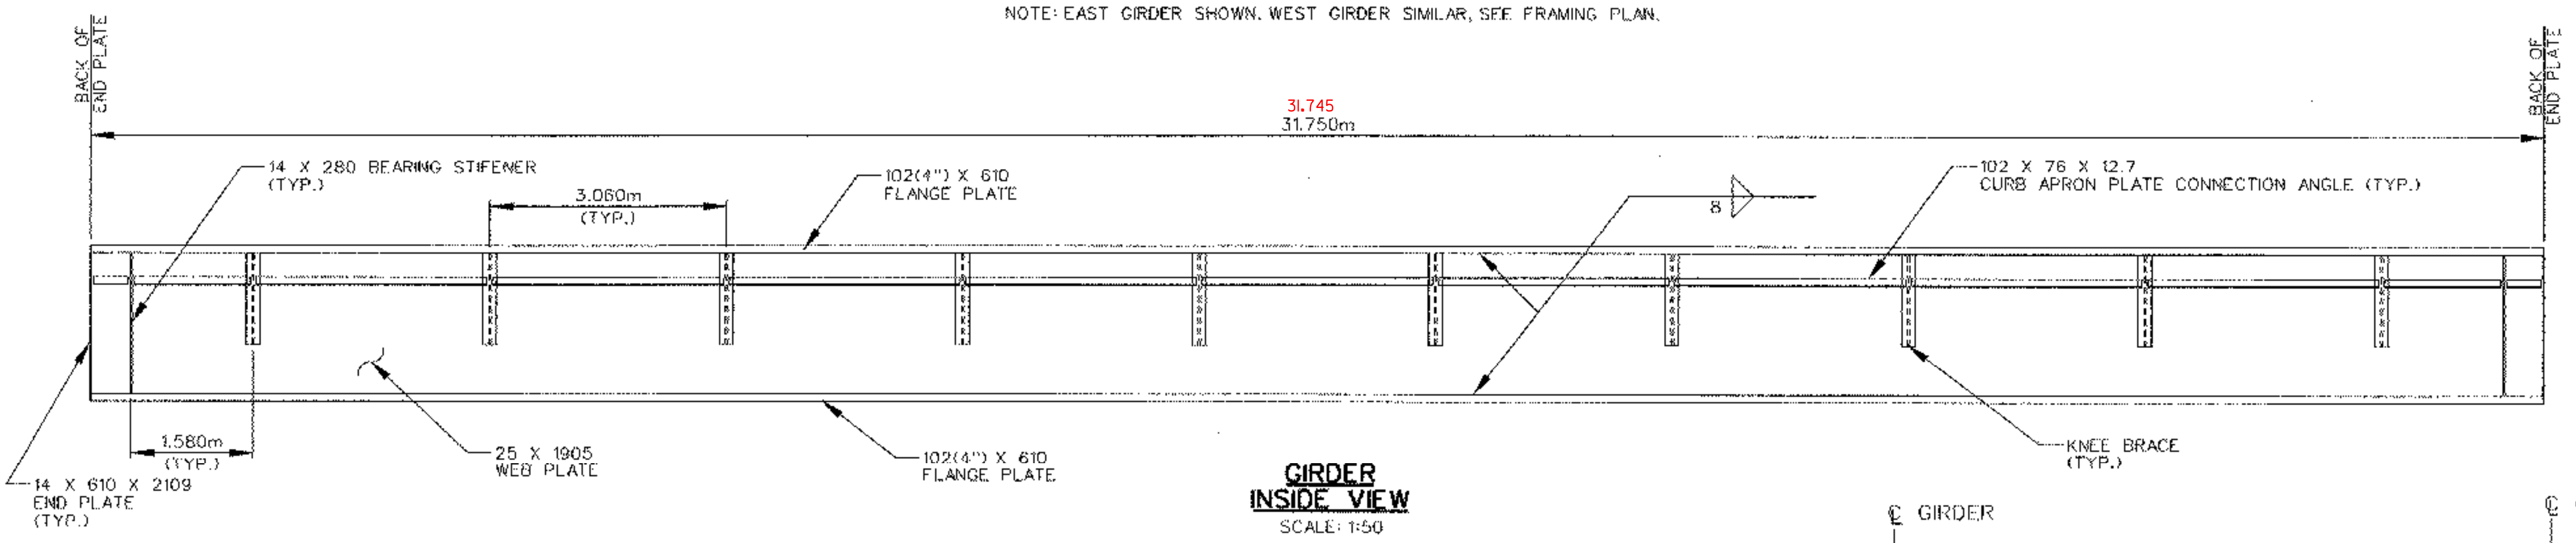


**GIRDER
INSIDE VIEW**
SCALE: 1:50

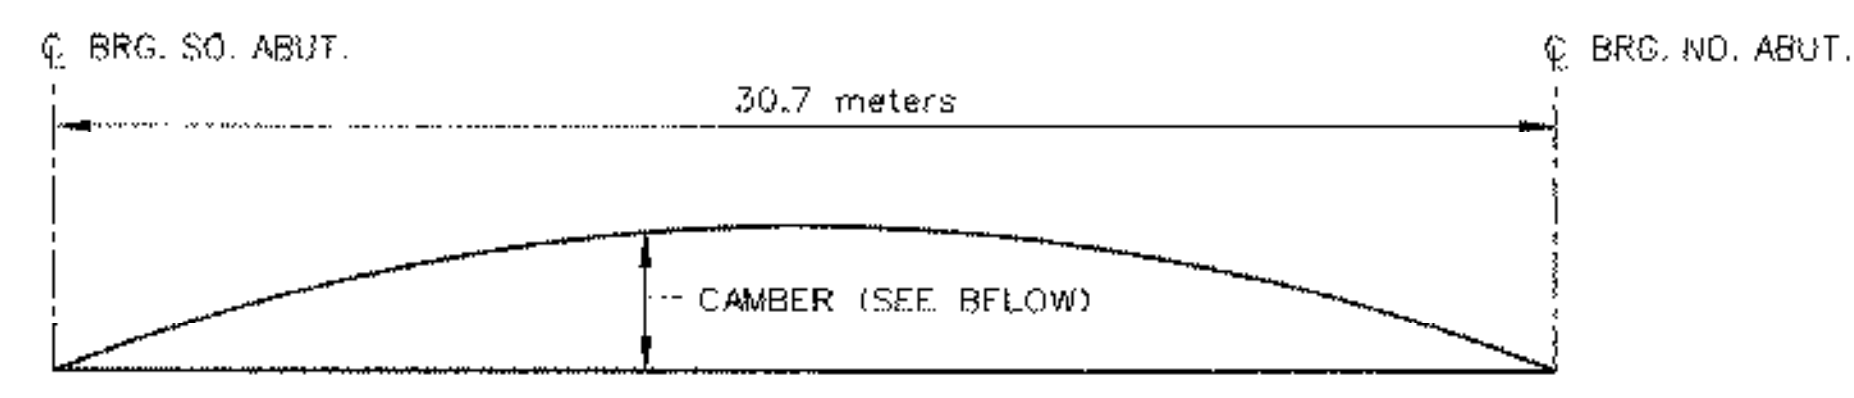

GIRDER CAMBER									
GIRDER	SO. BRG.	1/8 PT.	1/4 PT.	3/8 PT.	1/2 PT.	5/8 PT.	3/4 PT.	7/8 PT.	NO. BRG.
EAST	0	10	19	24	26	24	19	10	0
WEST	0	10	19	24	26	24	19	10	0


* CAMBER SHOWN IN mm

GIRDER CAMBER TABLE
SCALE: 1:50

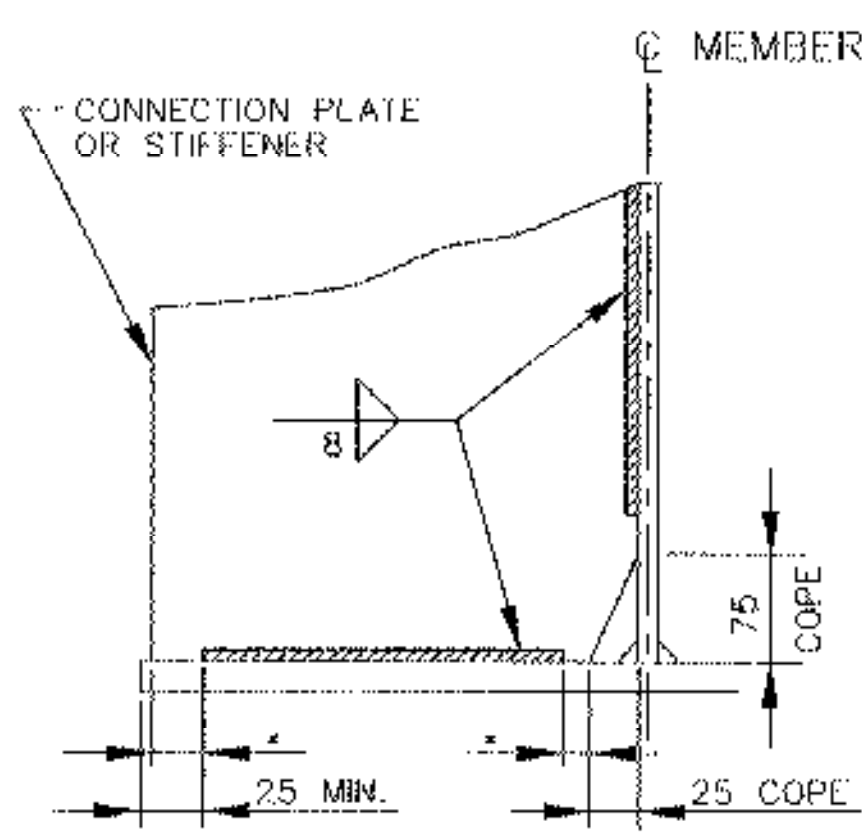


WELD TERMINATION DETAIL
N.T.S.


* NO WELD FOR 6 MIN. 12 MAX.
(EXCEPT MUST MAINTAIN 25 MINIMUM FROM EDGE OF FLANGE)

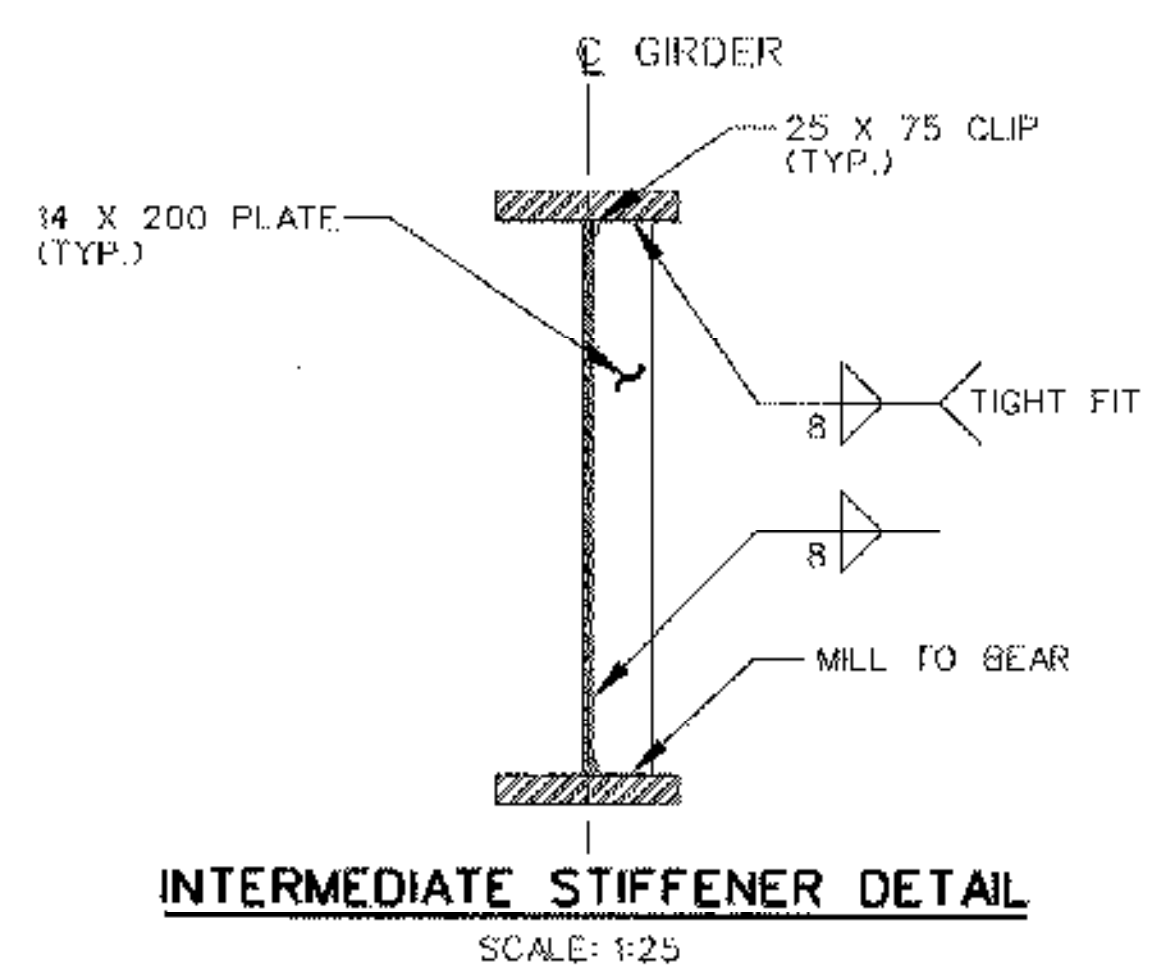

INTERMEDIATE STIFFENER DETAIL
SCALE: 1:25

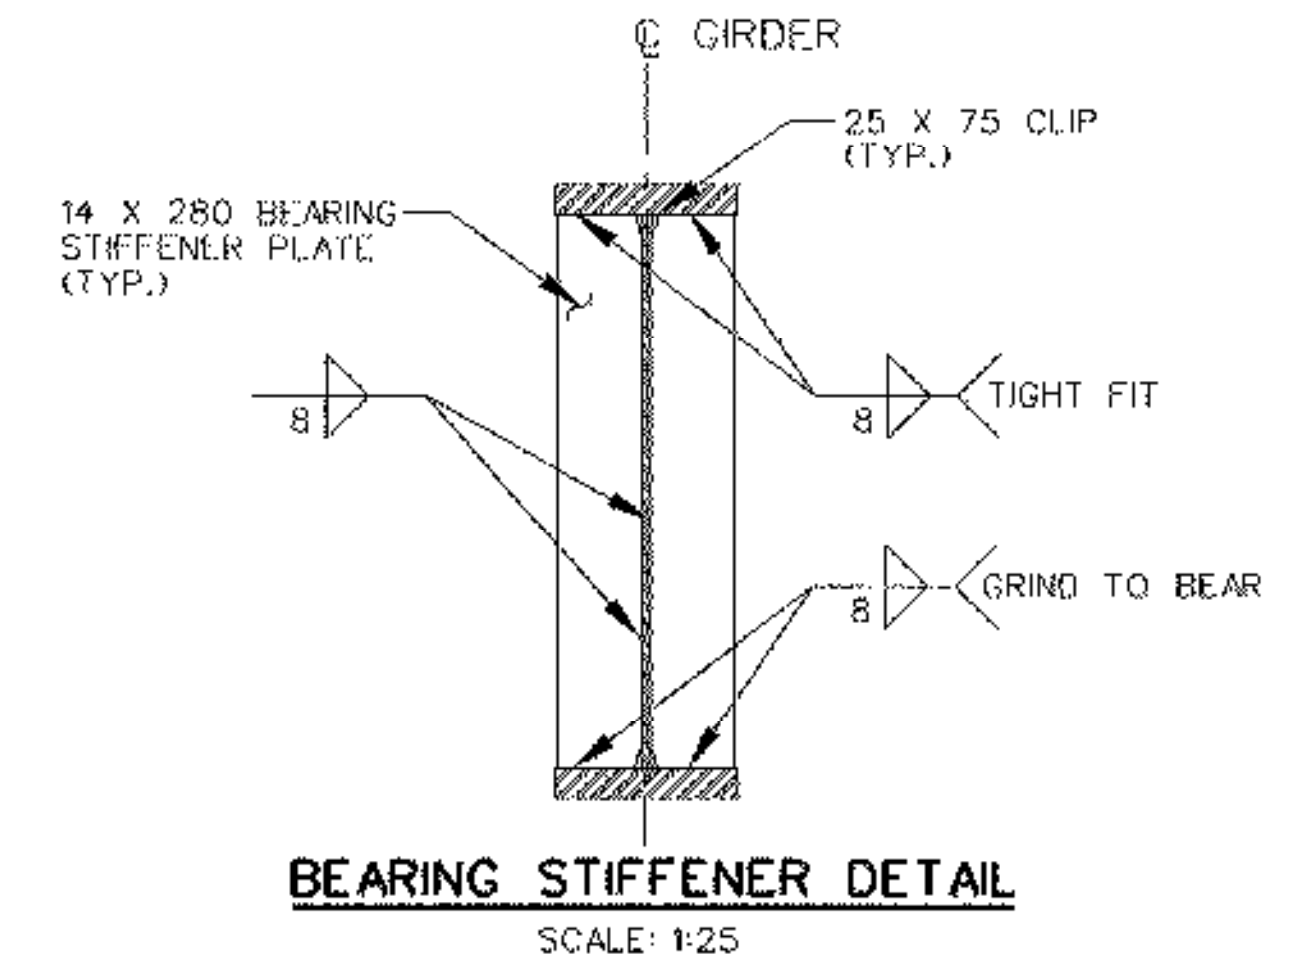


BEARING STIFFENER DETAIL
SCALE: 1:25

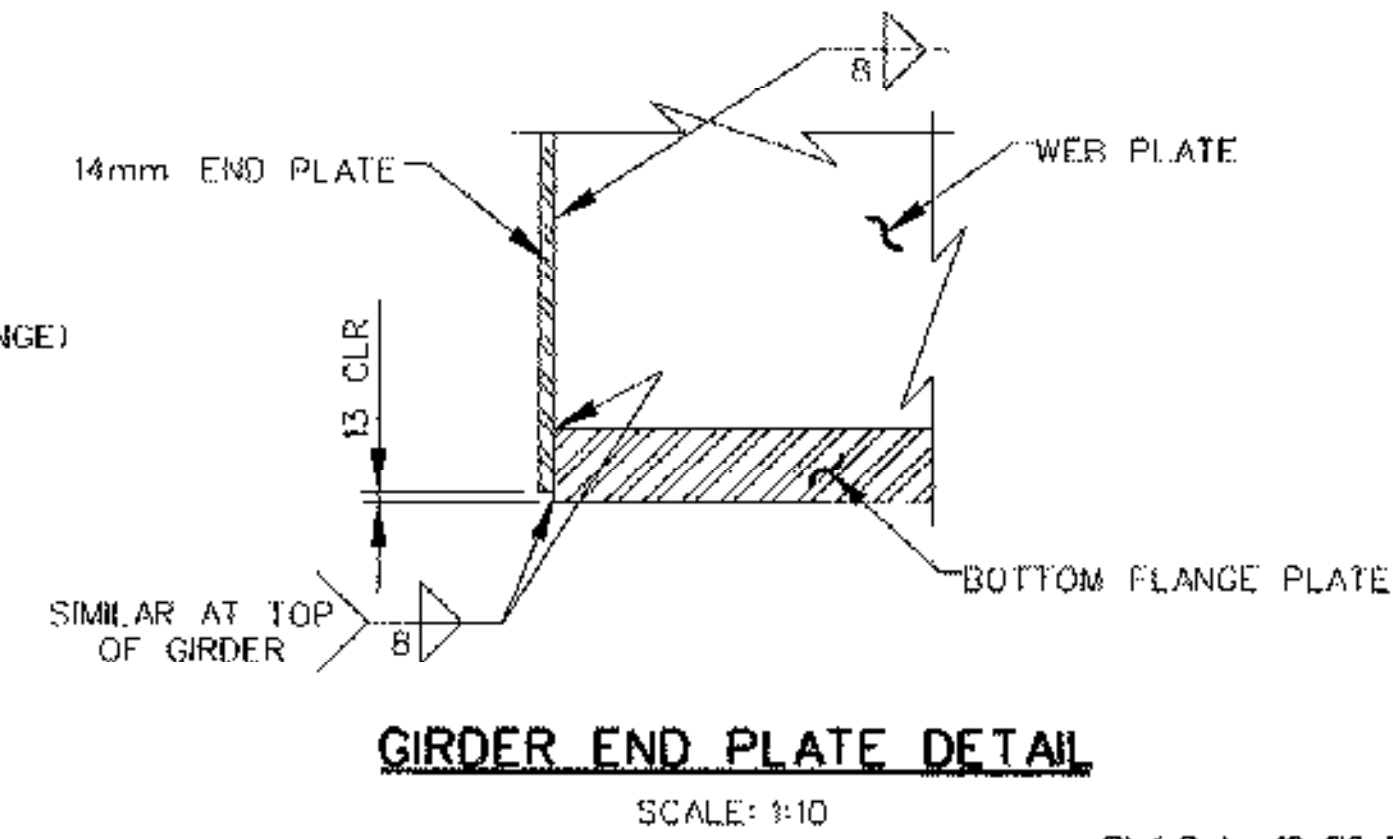


GIRDER END PLATE DETAIL
SCALE: 1:10


STATE OF VERMONT AGENCY OF TRANSPORTATION			
Town Of	BRATTLEBORO	Bridge No.	62.56
Highway No.	VT. ROUTE 9	Log Sta.	
		Surv. Sta.	
ROUTE 9 BRIDGE			
GIRDER ELEVATION, CAMBER & DETAILS			
Designed By	LM	Drawn By	DHL
Checked By	GJB	Bridge Design Supervisor	JHR
	Date	Date	
PROJECT	BRATTLEBORO	PROJECT NO.	NH 010-2(2)
I.G.C. Info.			
Bridge Sheet No. 3		Sheet 71 of 145	

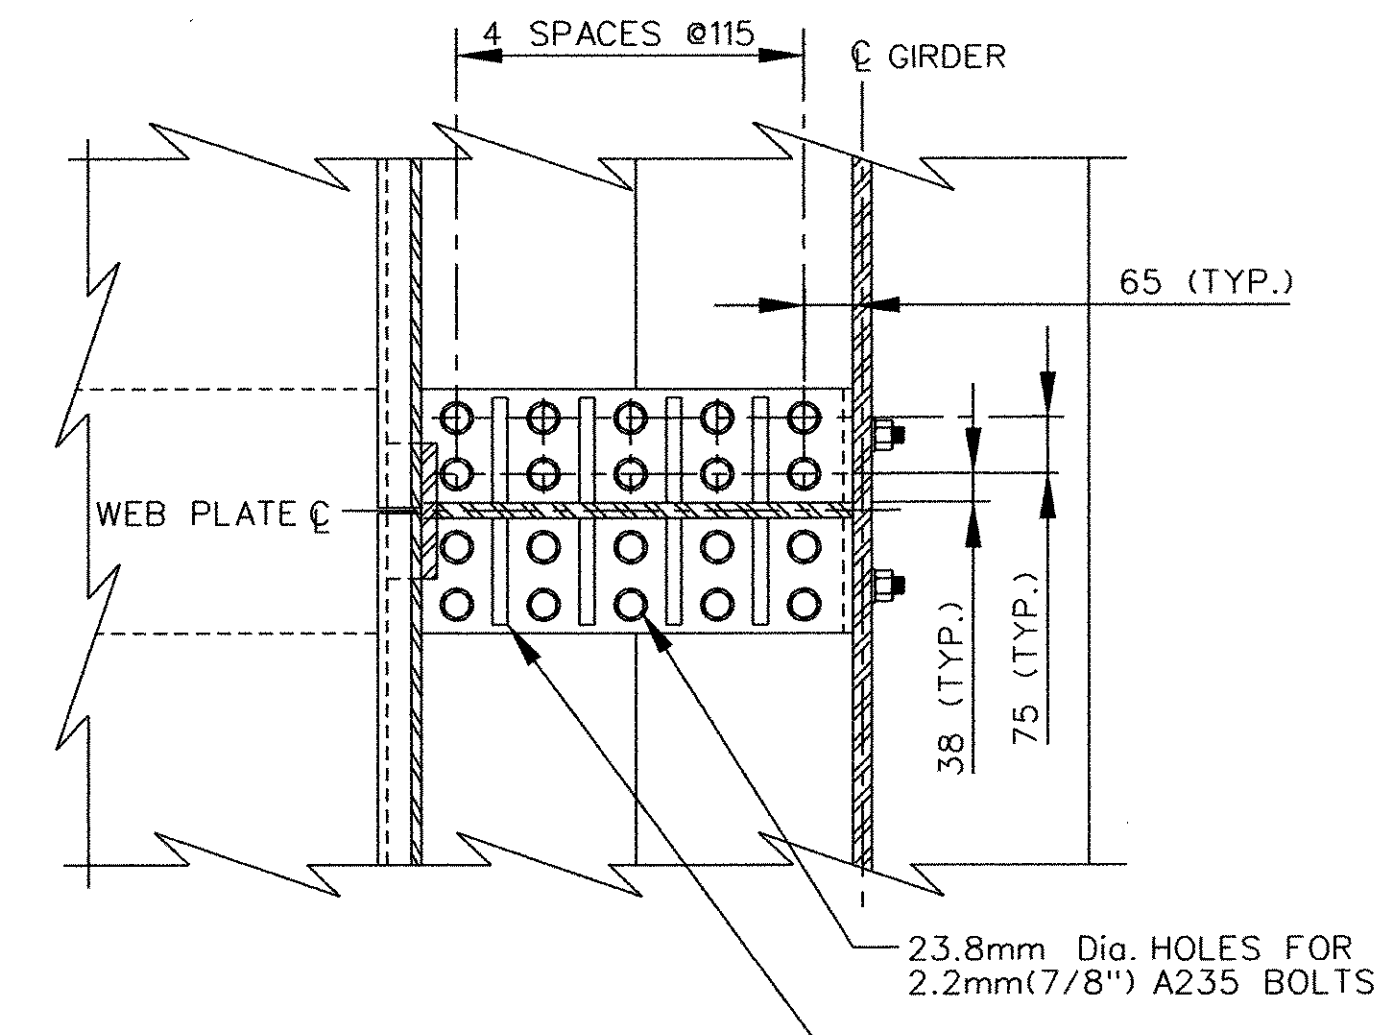


SECTION 1-1
SCALE: 1:10

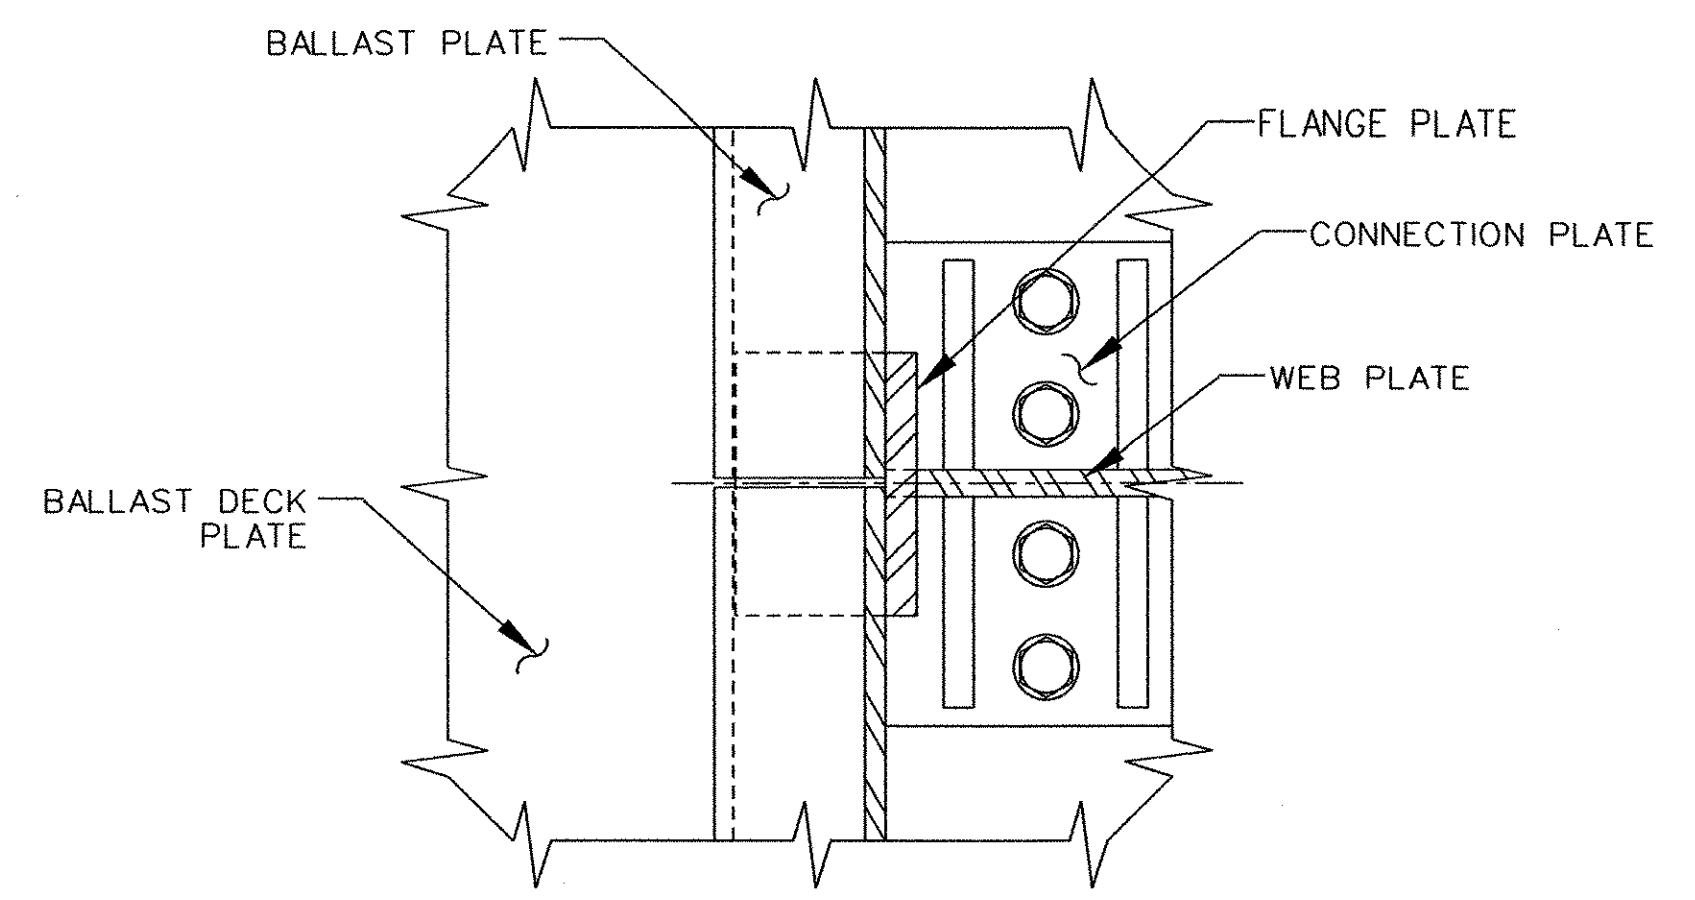


SECTION 3-3
SCALE: 1:5

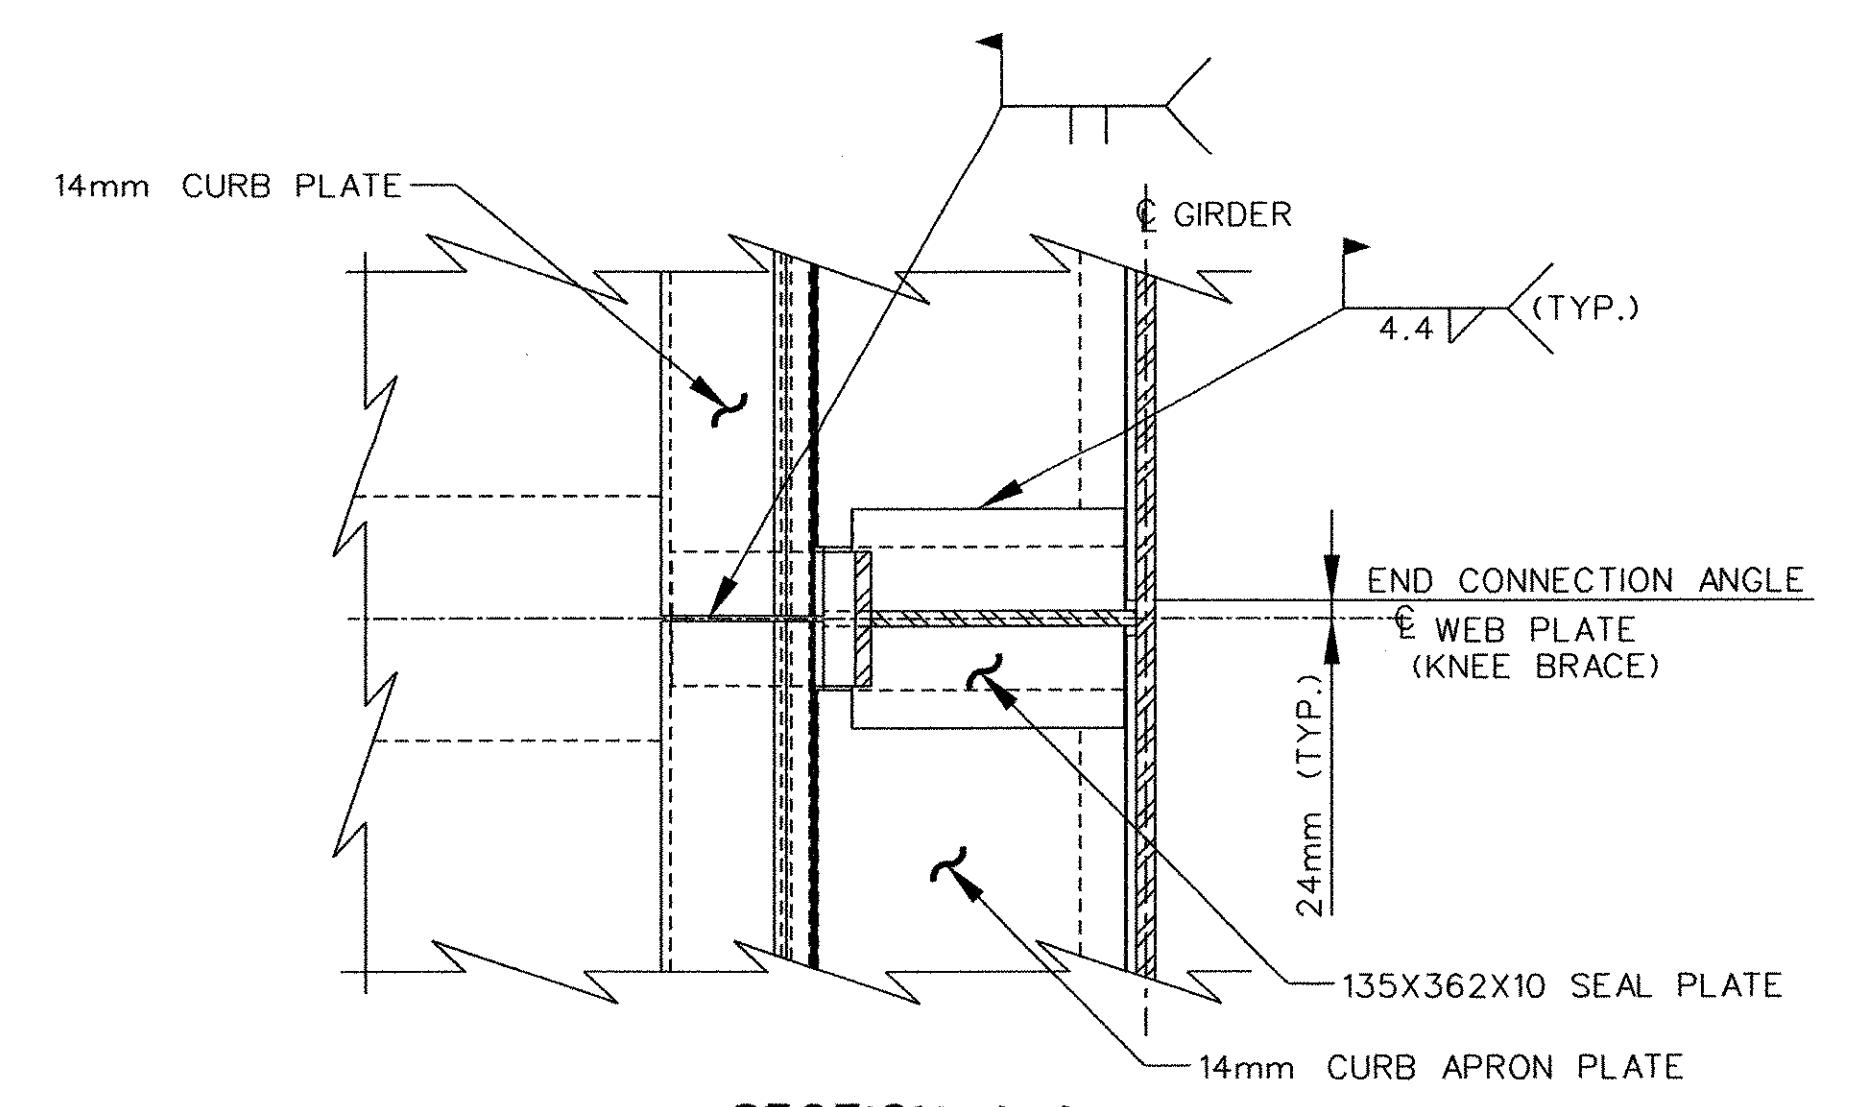


SECTION 4-4
SCALE: 1:10

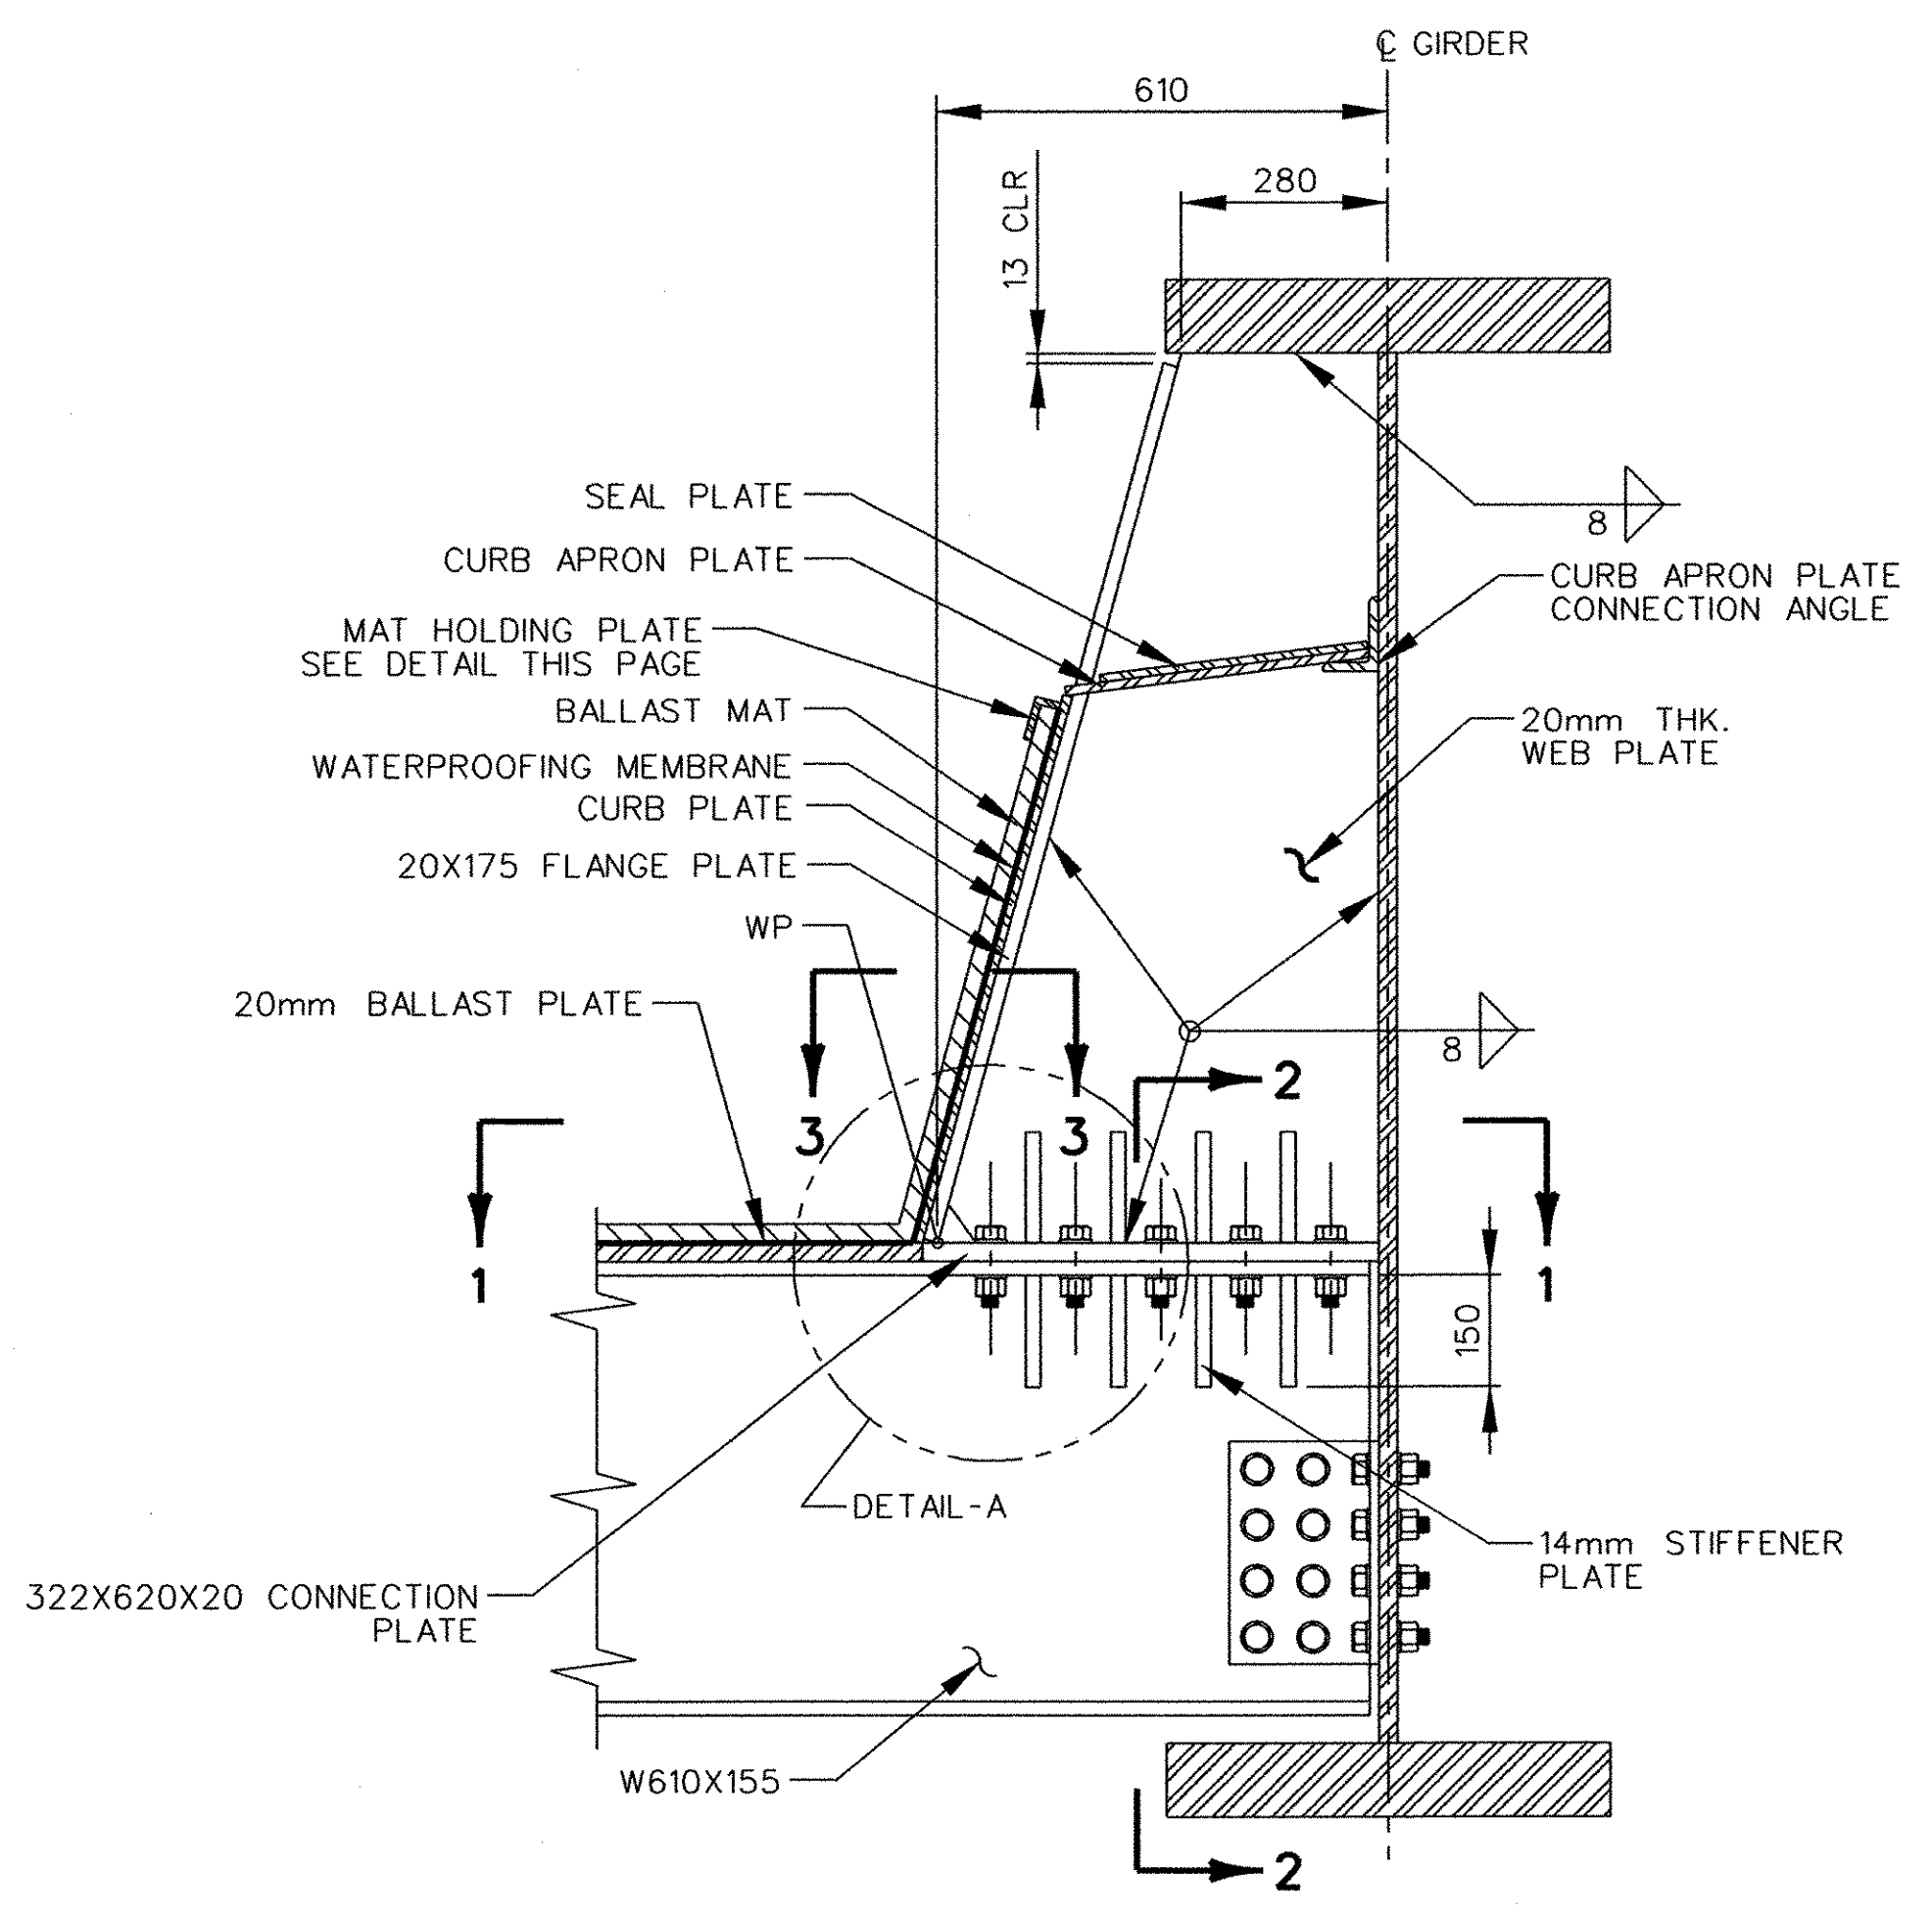


KNEE BRACE CONNECTION DETAIL
SCALE: 1:10

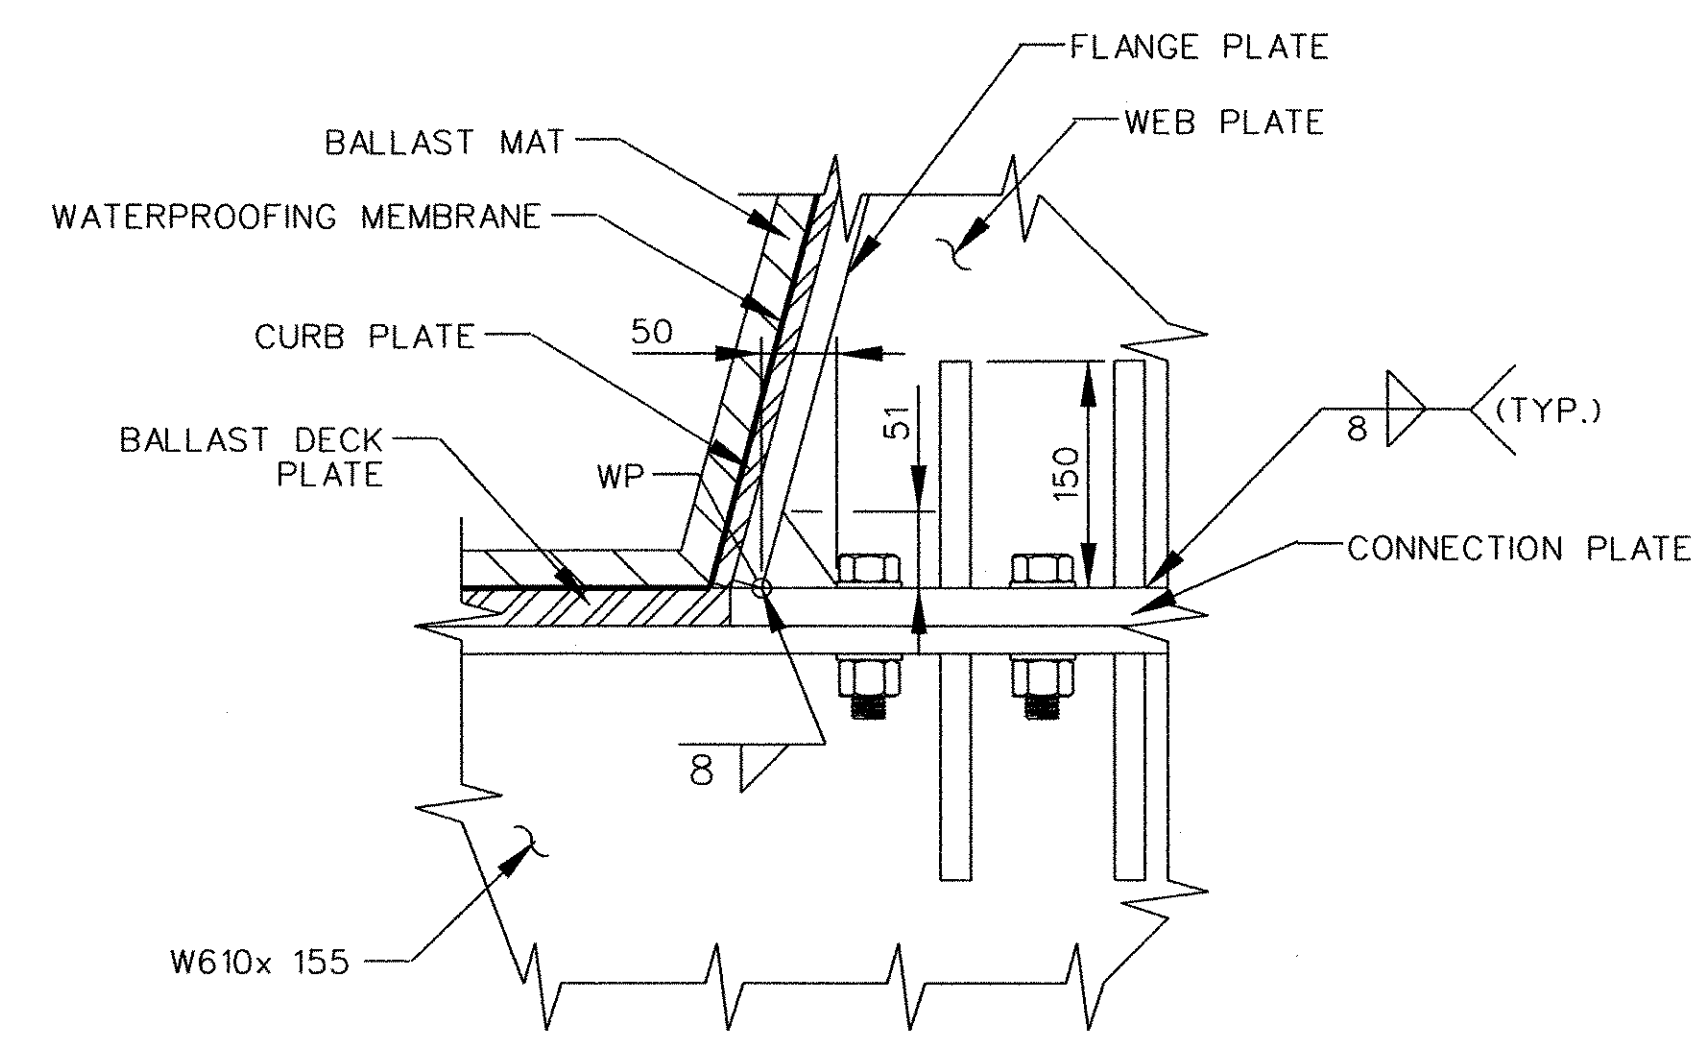


DETAIL-A
SCALE: 1:5

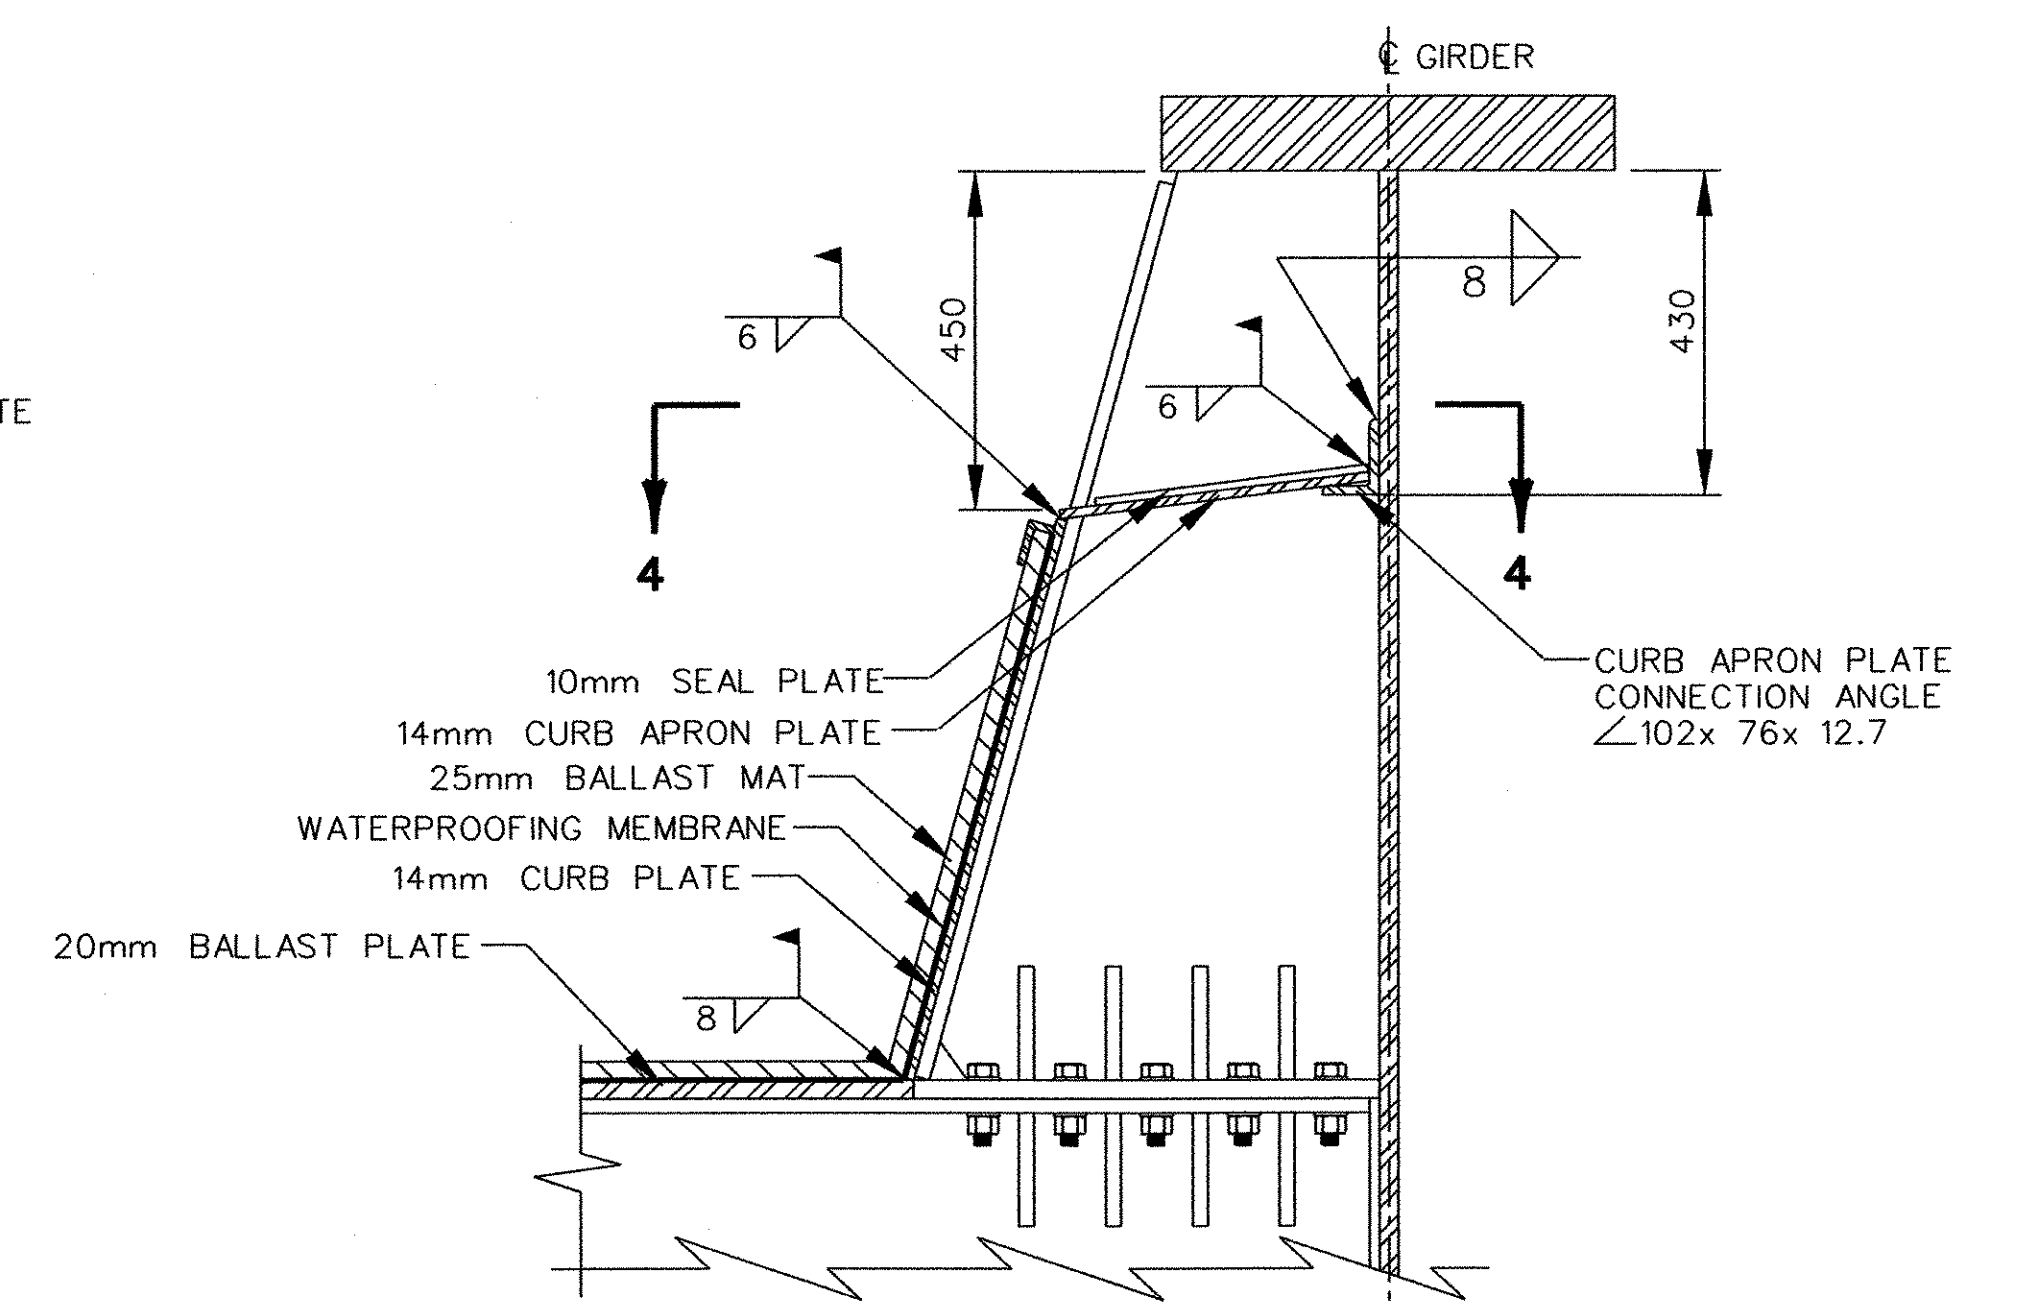

CURB PLATE CONNECTION DETAIL
SCALE: 1:10

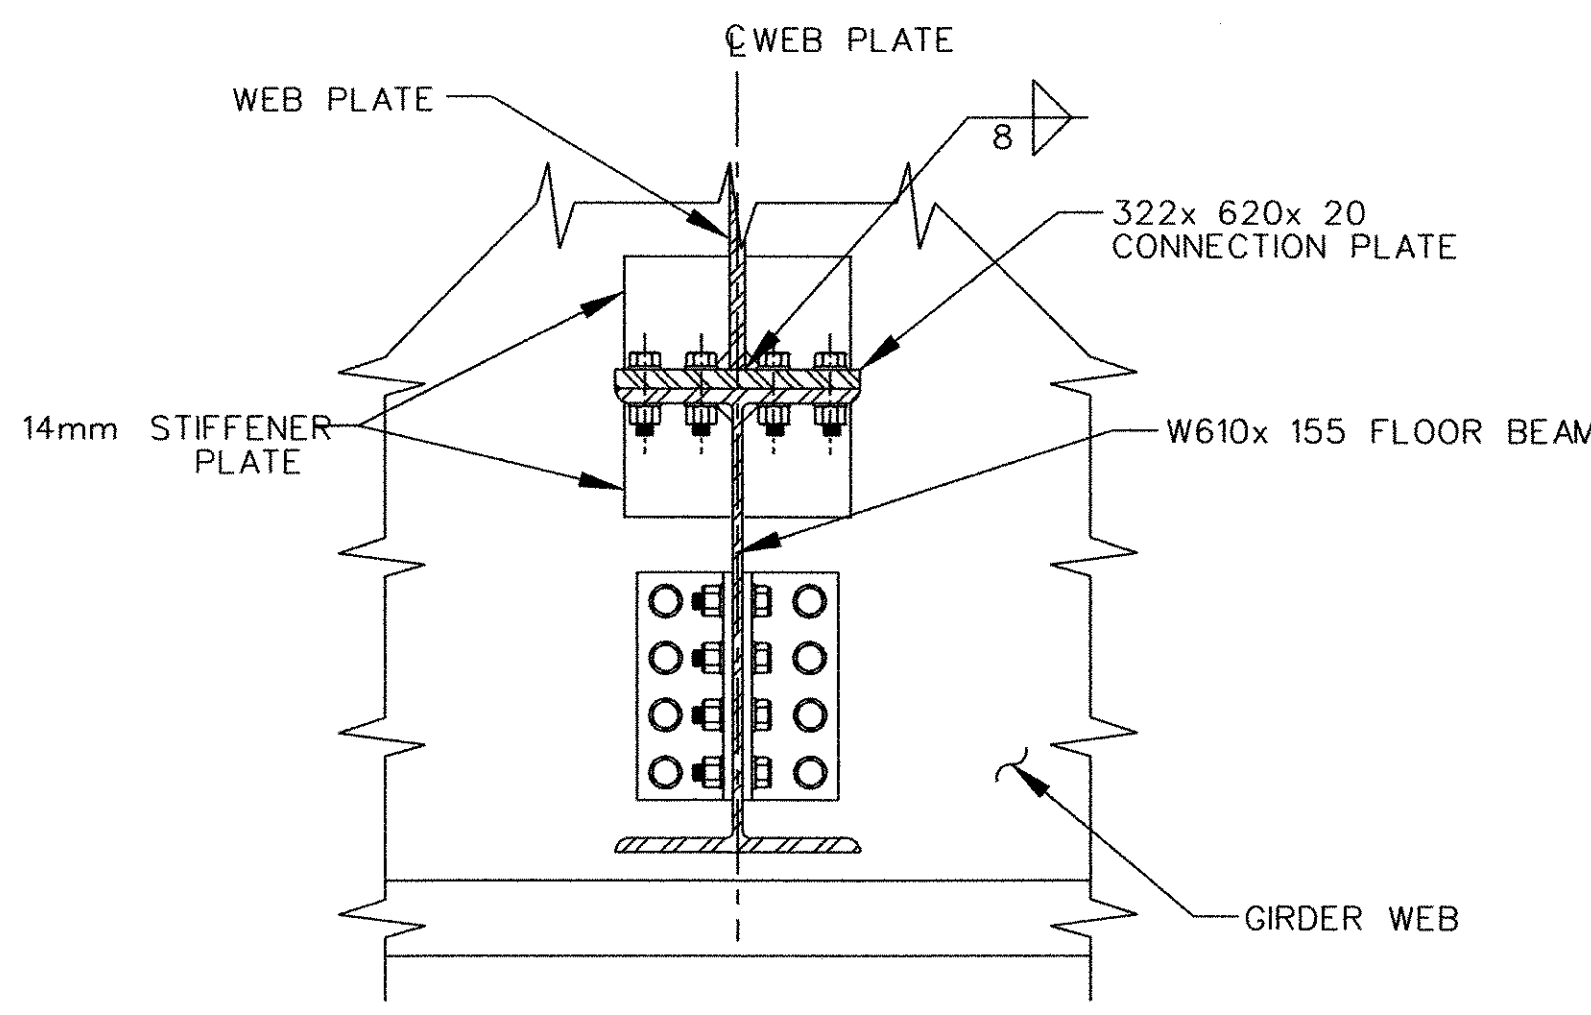

SECTION 2-2
SCALE: 1:10

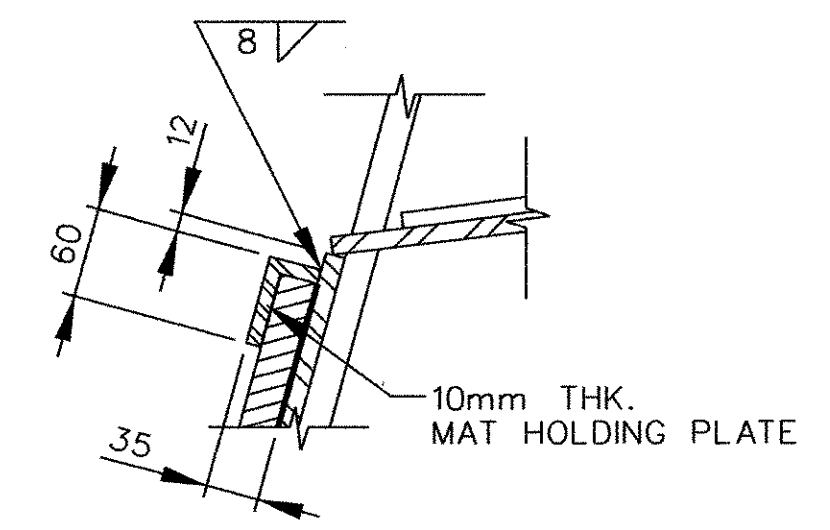


MAT HOLDING PLATE DETAIL
SCALE: 1:5


NOTE:
FOR FASTENERS SEE NOTE 3 ON SHEET 7 OF 145

Plot Date: 10-10-2002
File: rt9br152


STATE OF VERMONT AGENCY OF TRANSPORTATION		
Town Of	BRATTLEBORO	Bridge No. 62.56
Highway No.	VT. ROUTE 9	Log Sta. Surv. Sta.
ROUTE 9 BRIDGE		
KNEEBRACE CONNECTION & DETAILS		
Designed By	LM	Drawn By DHL/MER
Checked By	GJB Date	Bridge Design Supervisor JHR Date
PROJECT	BRATTLEBORO	PROJECT NO. NH 010-2(2)
I.G.C. Info.	Bridge Sheet No. 4	Sheet 72 of 145

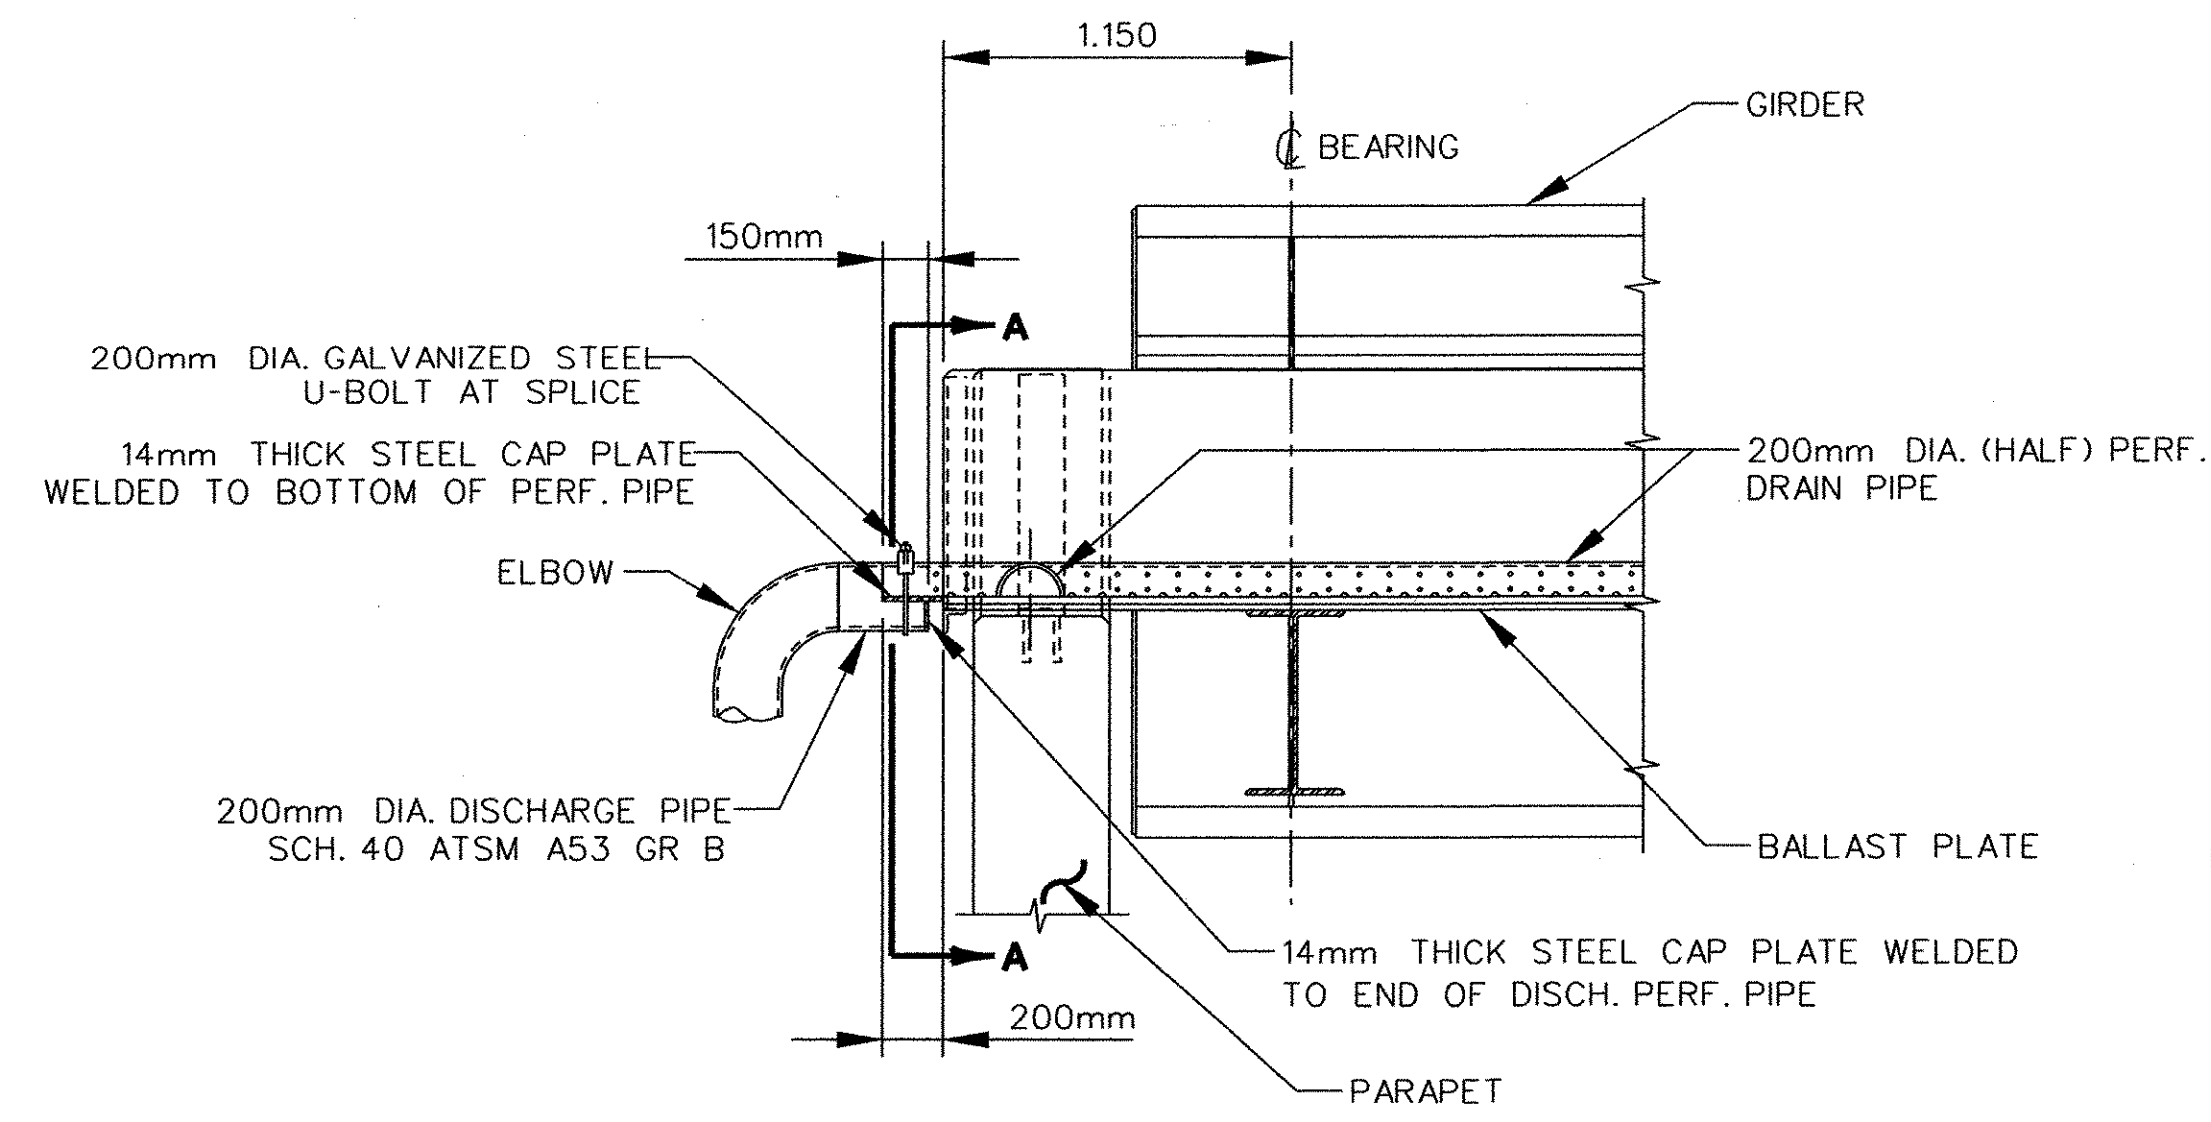


PARAPET DISCHARGE PIPE CONNECTION DETAIL
SCALE: 1:25

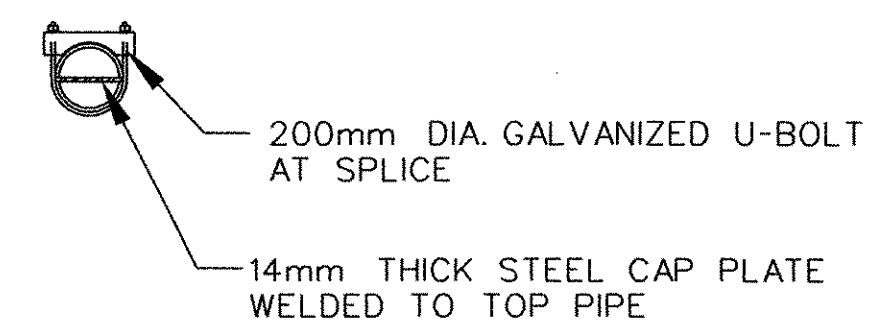


SECTION A-A

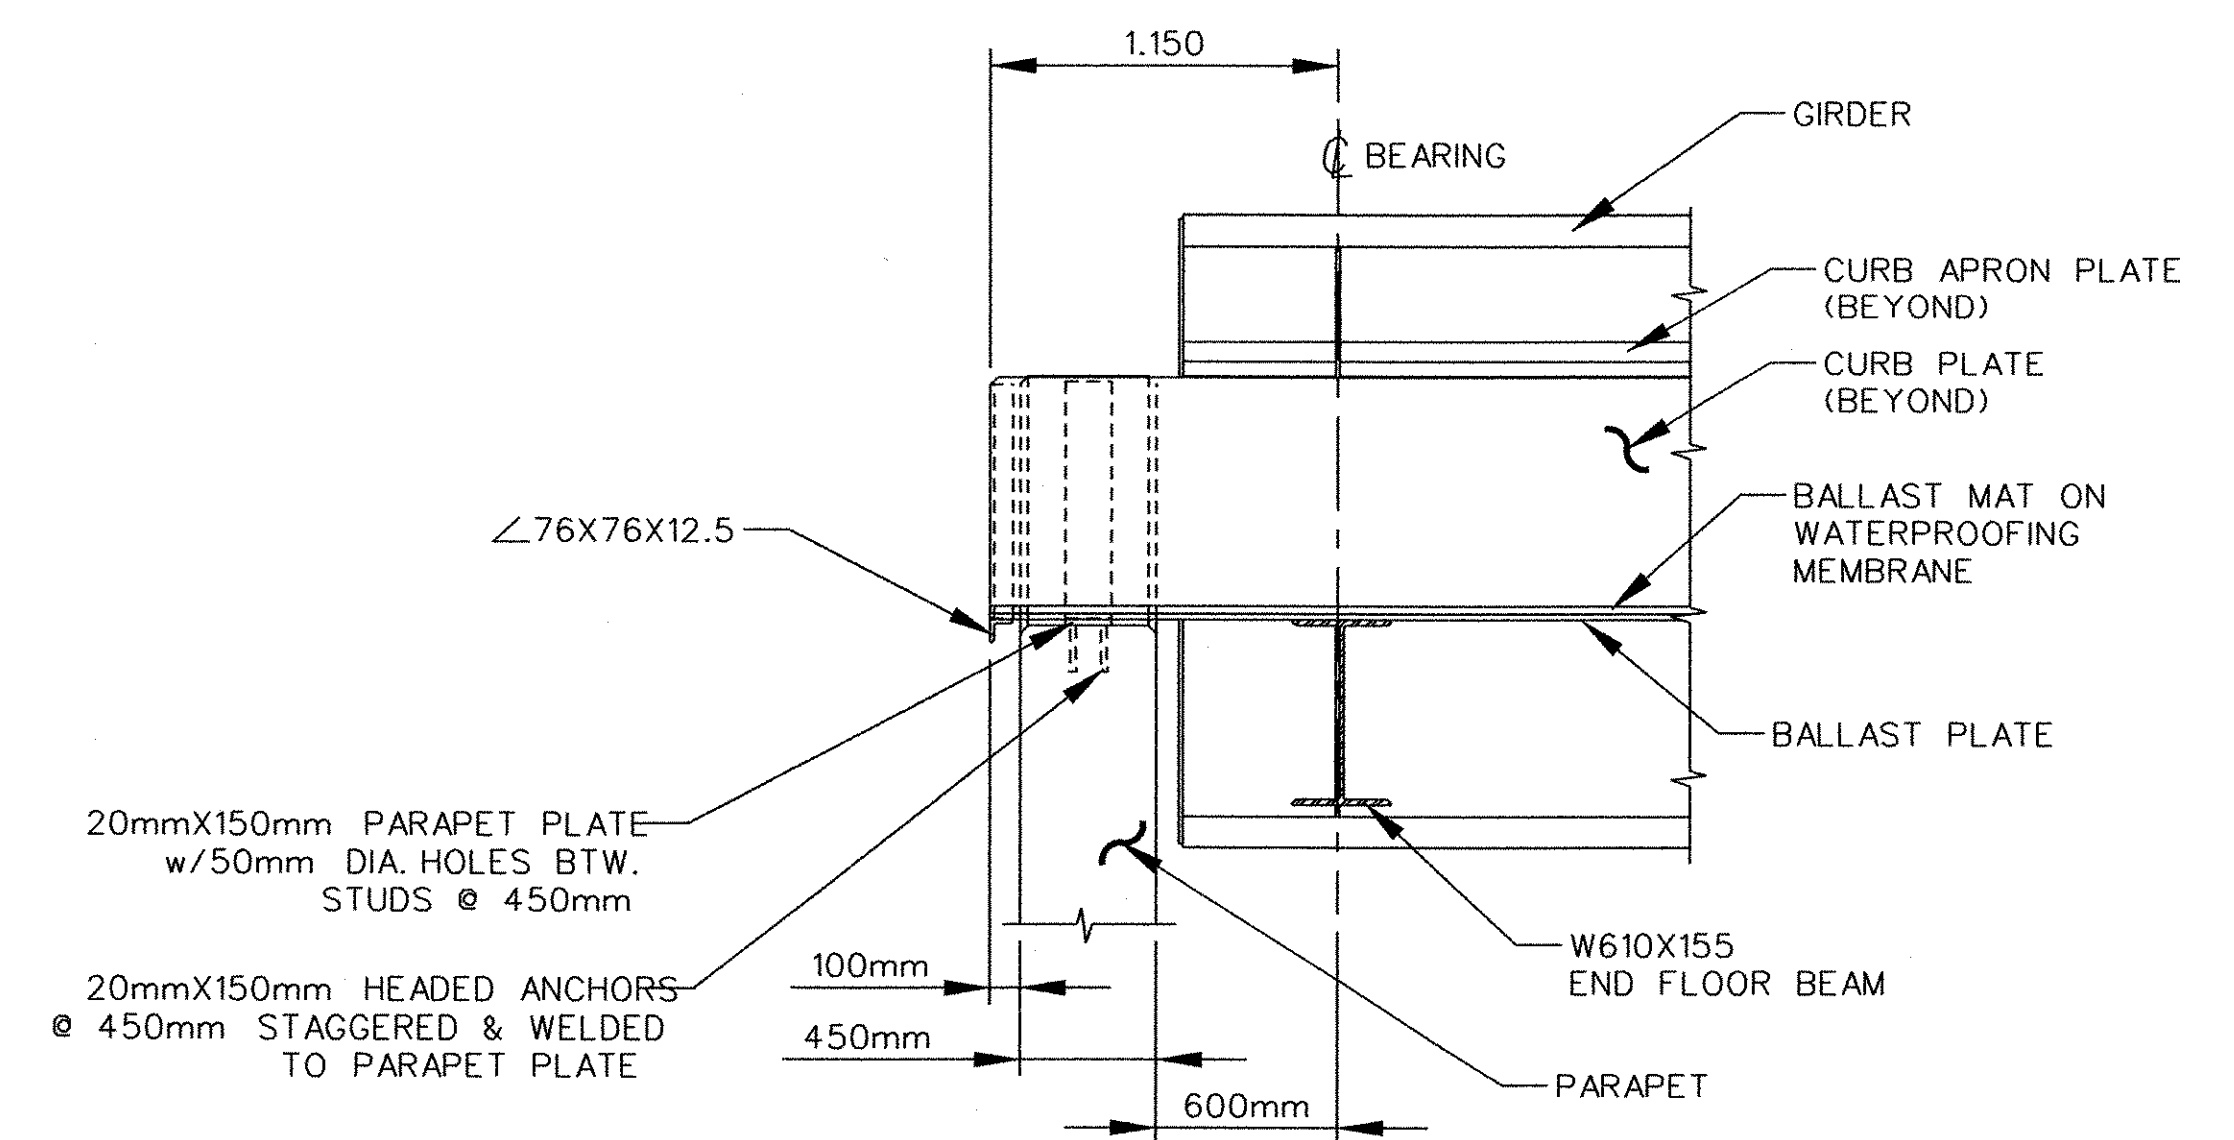


PARAPET DETAIL
SCALE: 1:25

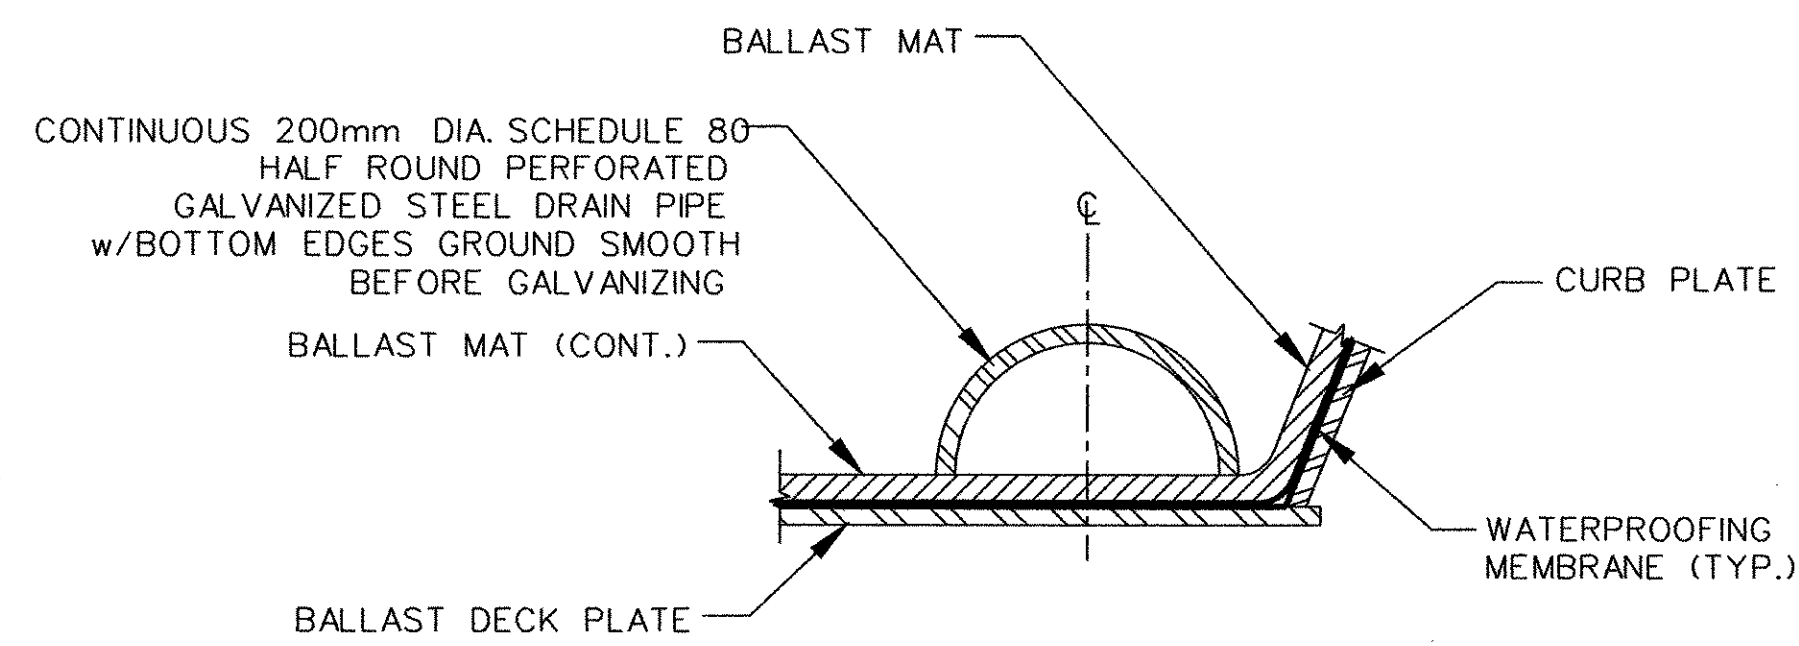


DRAIN PIPE DETAIL
SCALE: 1:5
SEE PARAPET DETAIL FOR EXTENSION OF PIPE.

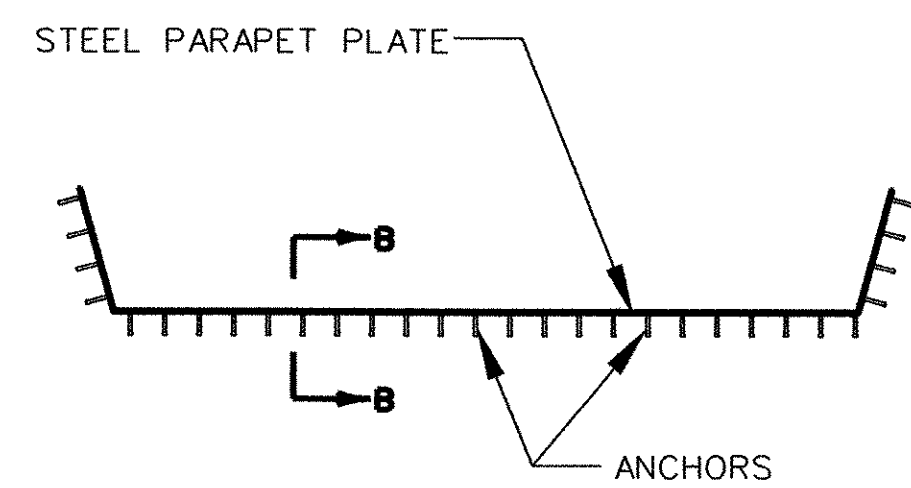


PARAPET PLATE DETAIL
SCALE: 1:50

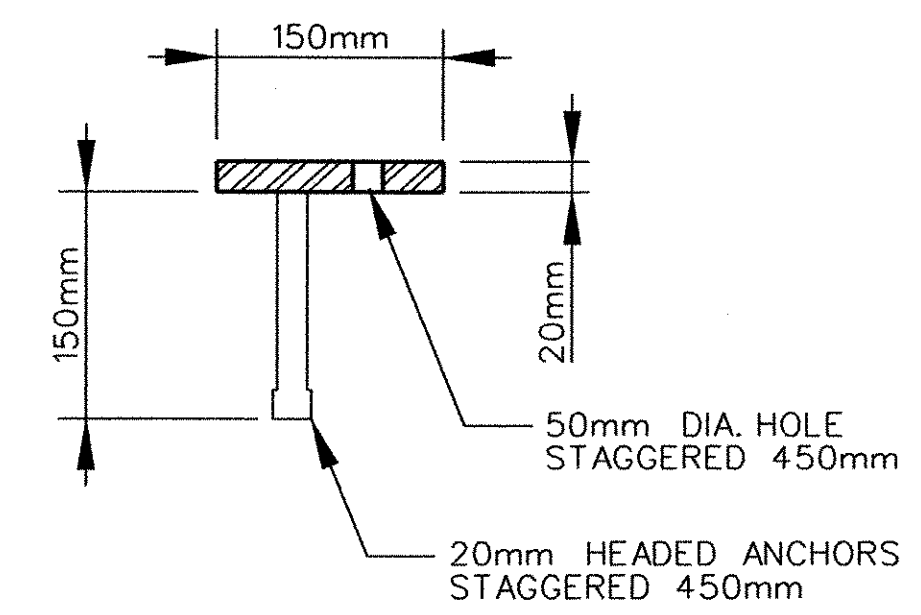

SECTION B-B

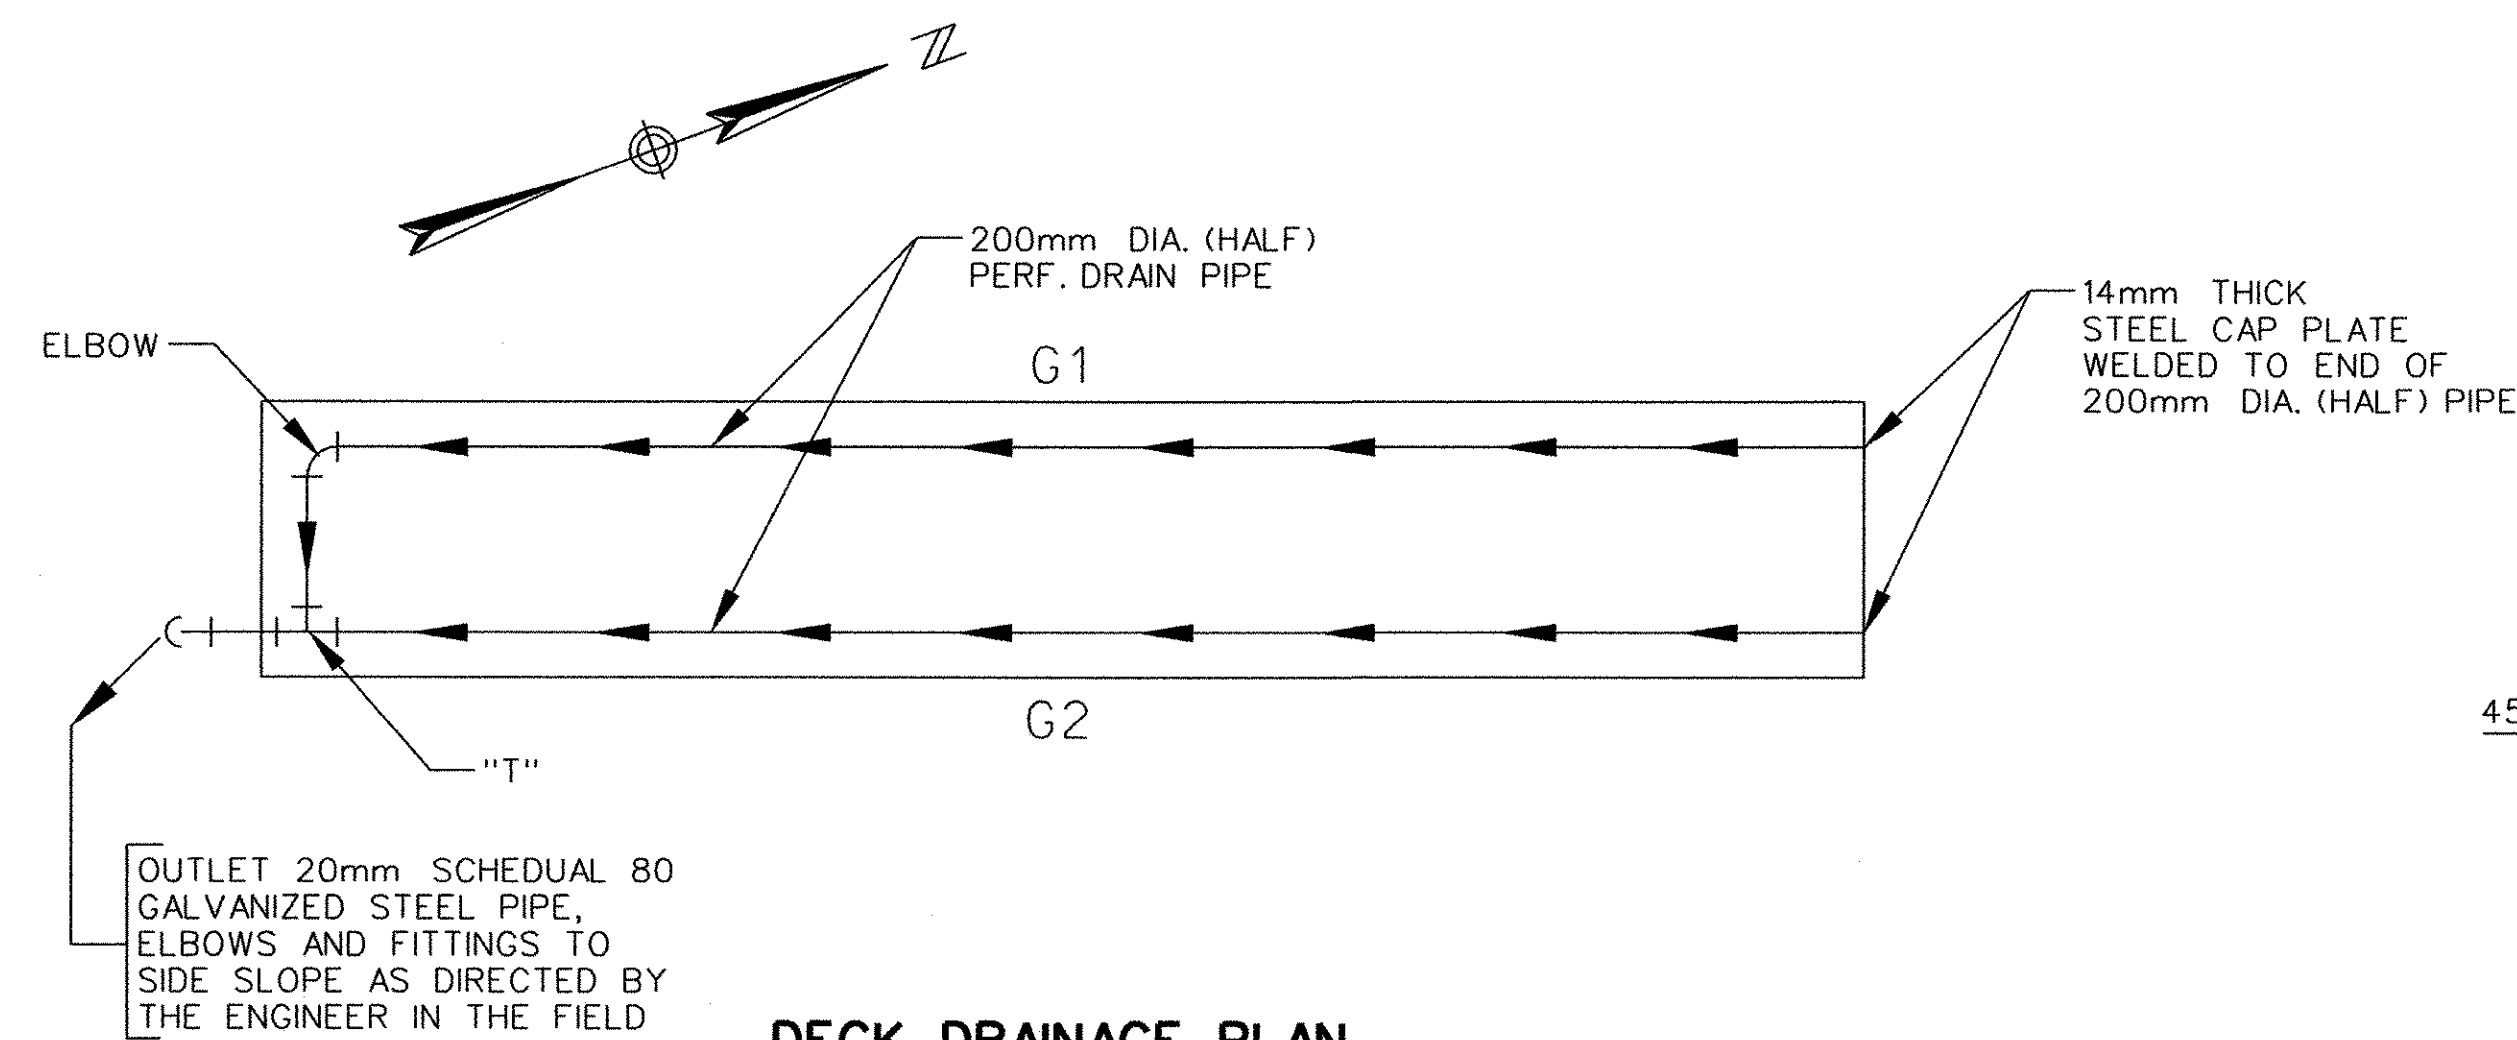


DECK DRAINAGE PLAN
SCALE: NTS

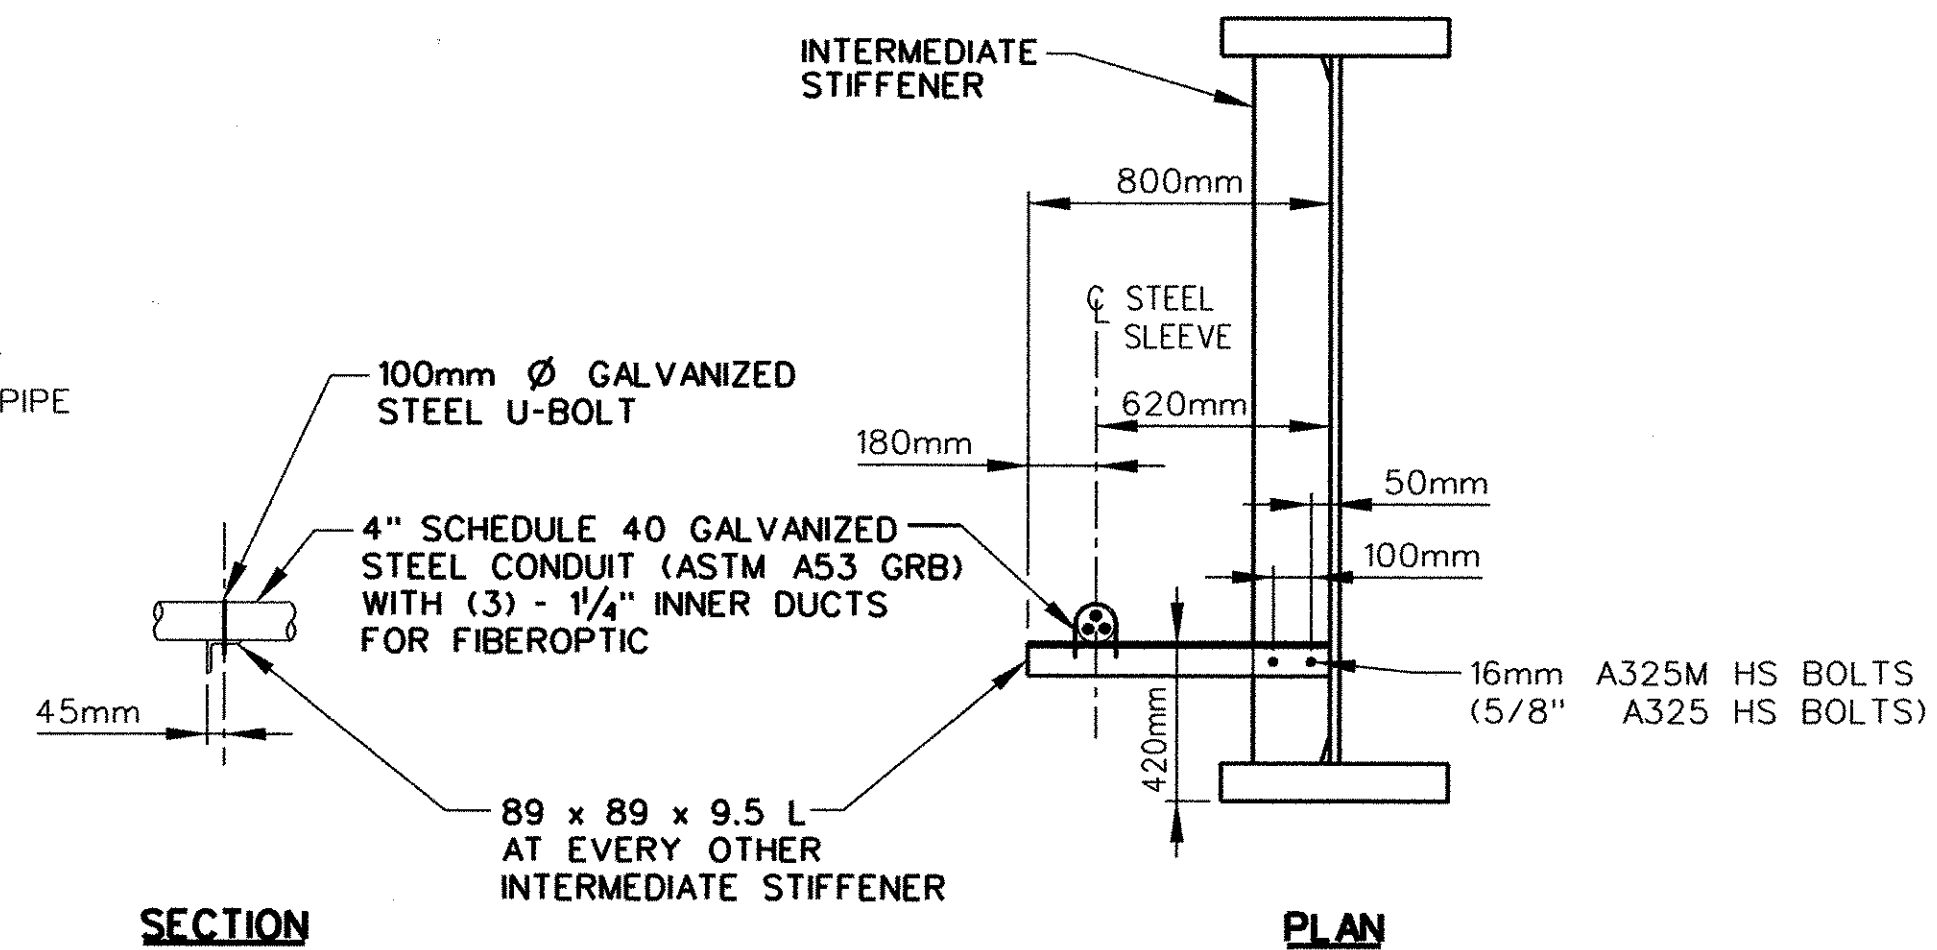


FIBEROPTIC CONDUIT SUPPORT DETAIL
SCALE: 1:20

STATE OF VERMONT AGENCY OF TRANSPORTATION		
Town Of	BRATTLEBORO	Bridge No. 62.56
Highway No.	VT. ROUTE 9	Log Sta.
		Surv. Sta.
ROUTE 9 BRIDGE		
SUPERSTRUCTURE DETAILS		
Designed By		Drawn By DHL/LB
Checked By	Date	Bridge Design Supervisor
	GJB	JHR Date
PROJECT	BRATTLEBORO	PROJECT NO. NH 010-2(2)
I.G.C. Info.		
Bridge Sheet No. 5		Sheet 73 of 145

Plot Date: 10-03-2002
File: rt9br153

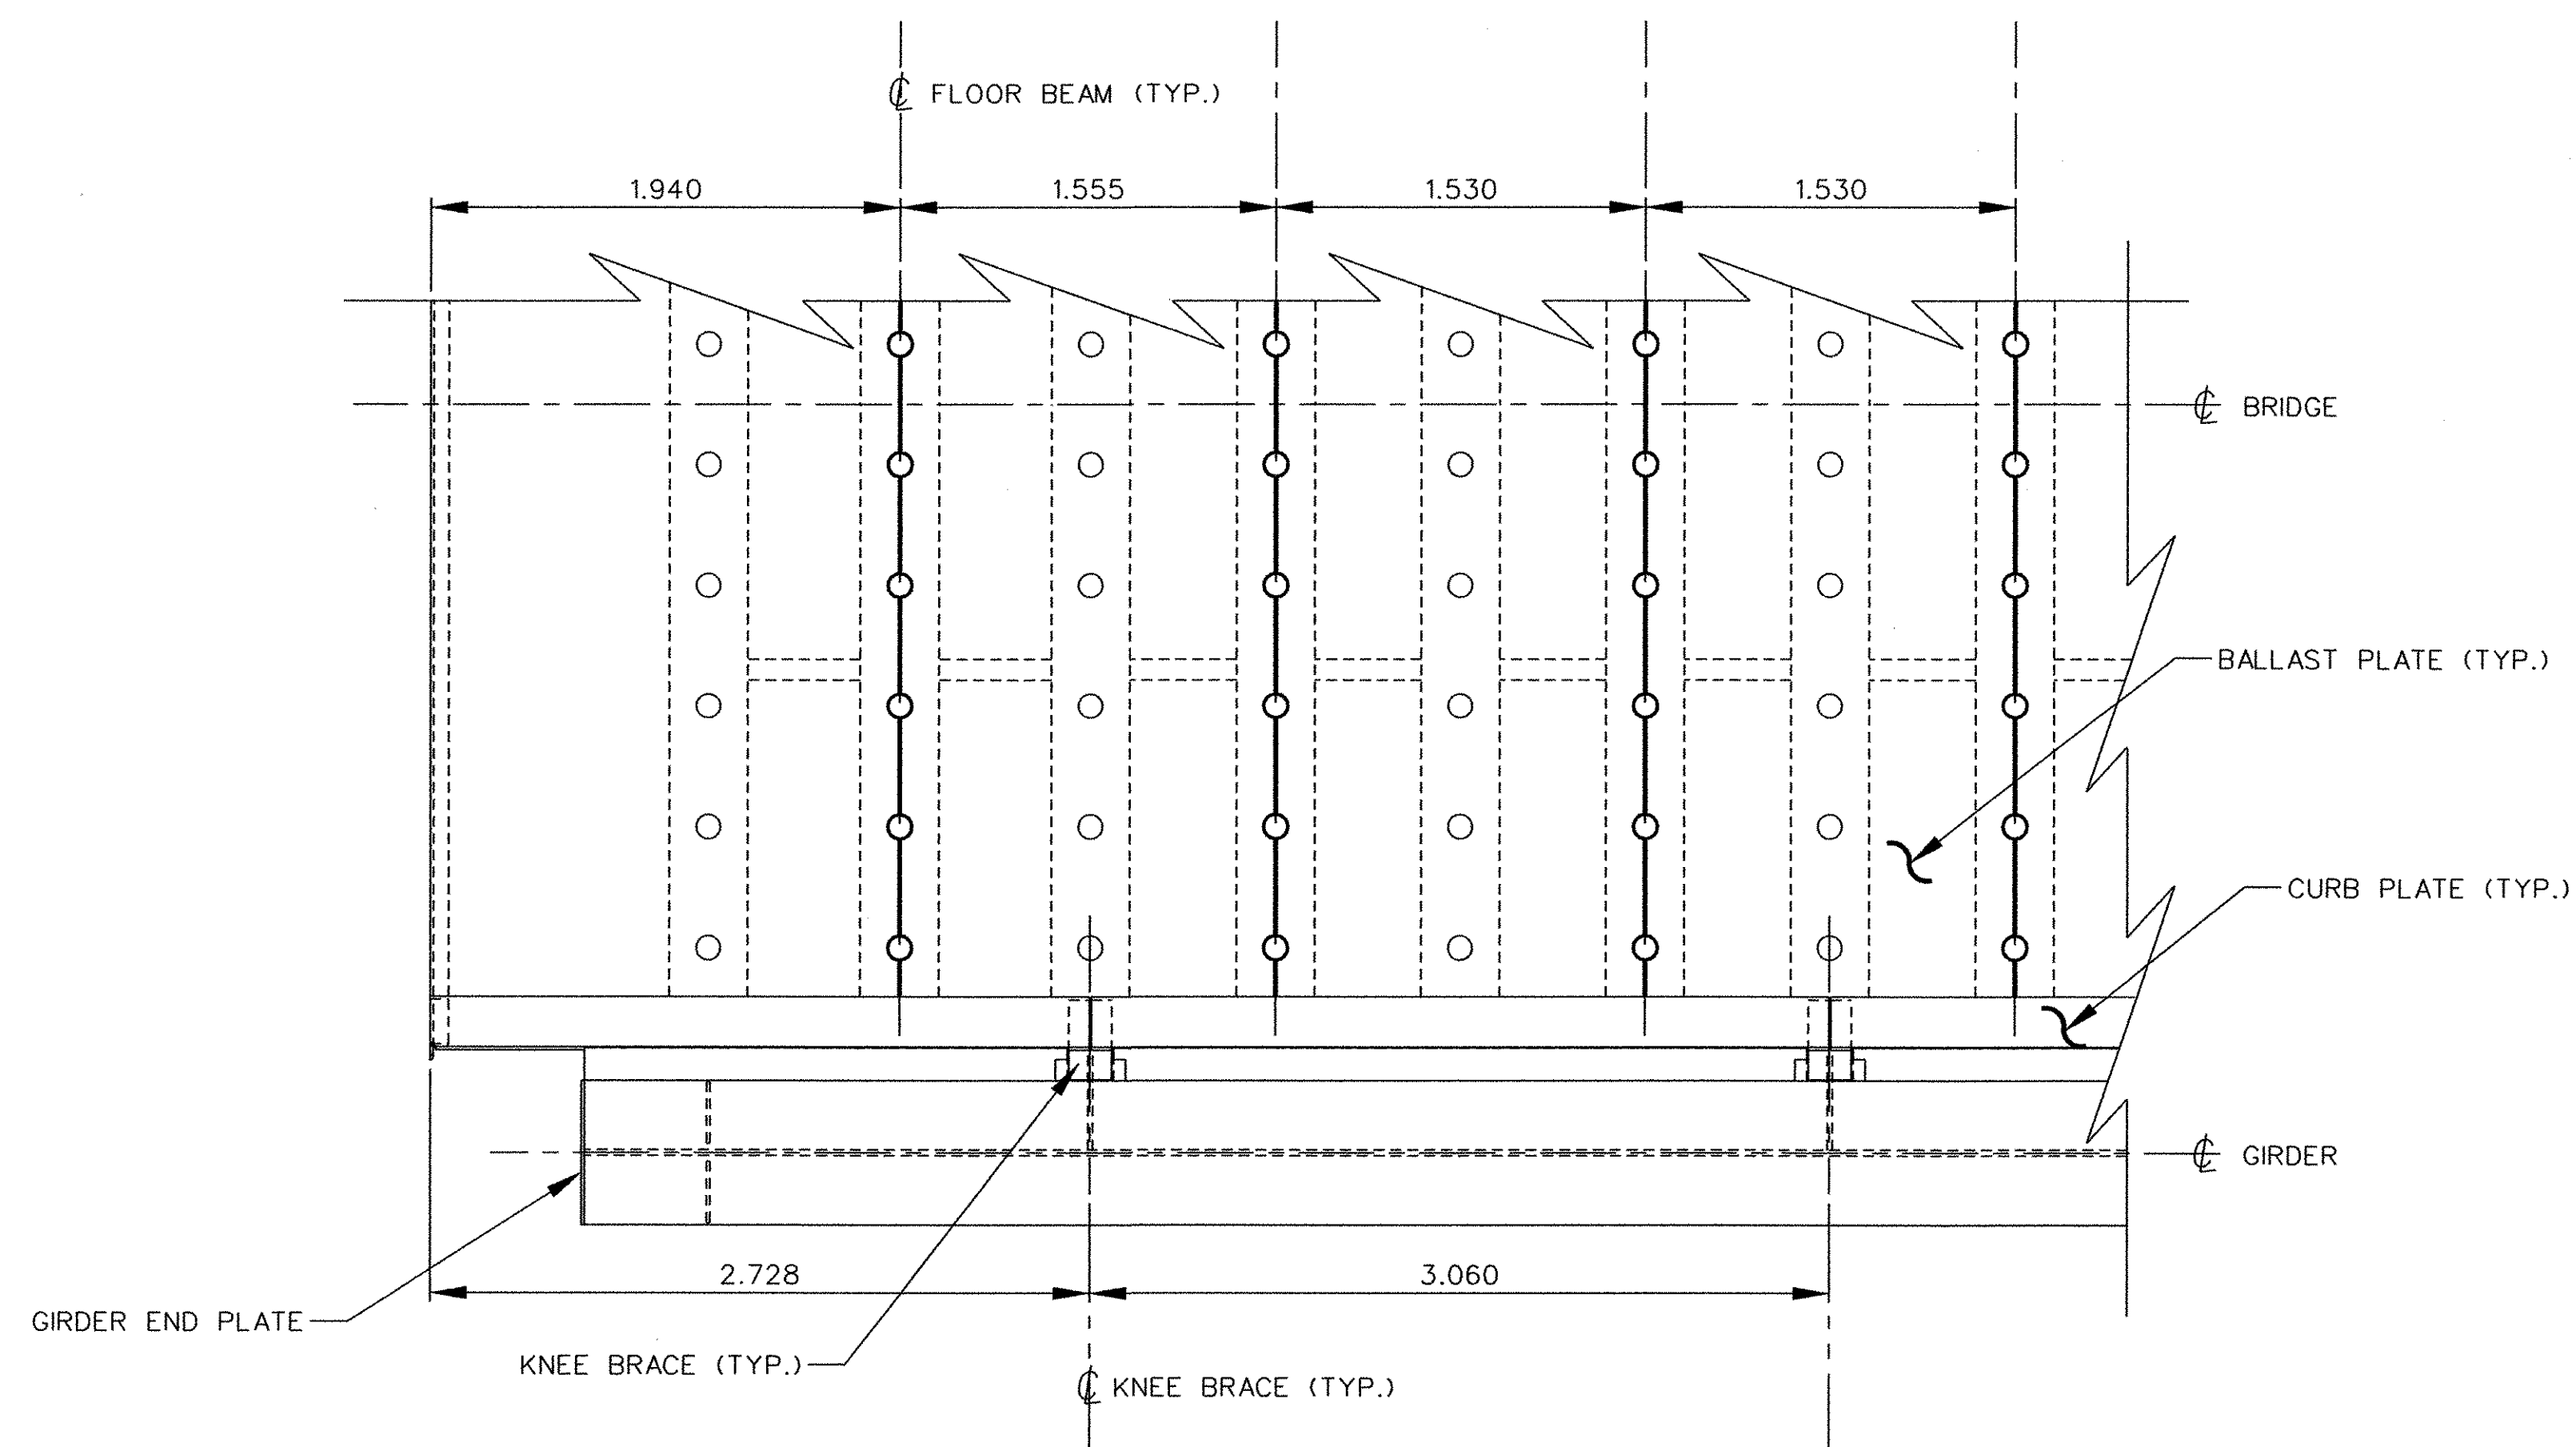

BALLAST PLATE LAYOUT
SCALE: 1:25












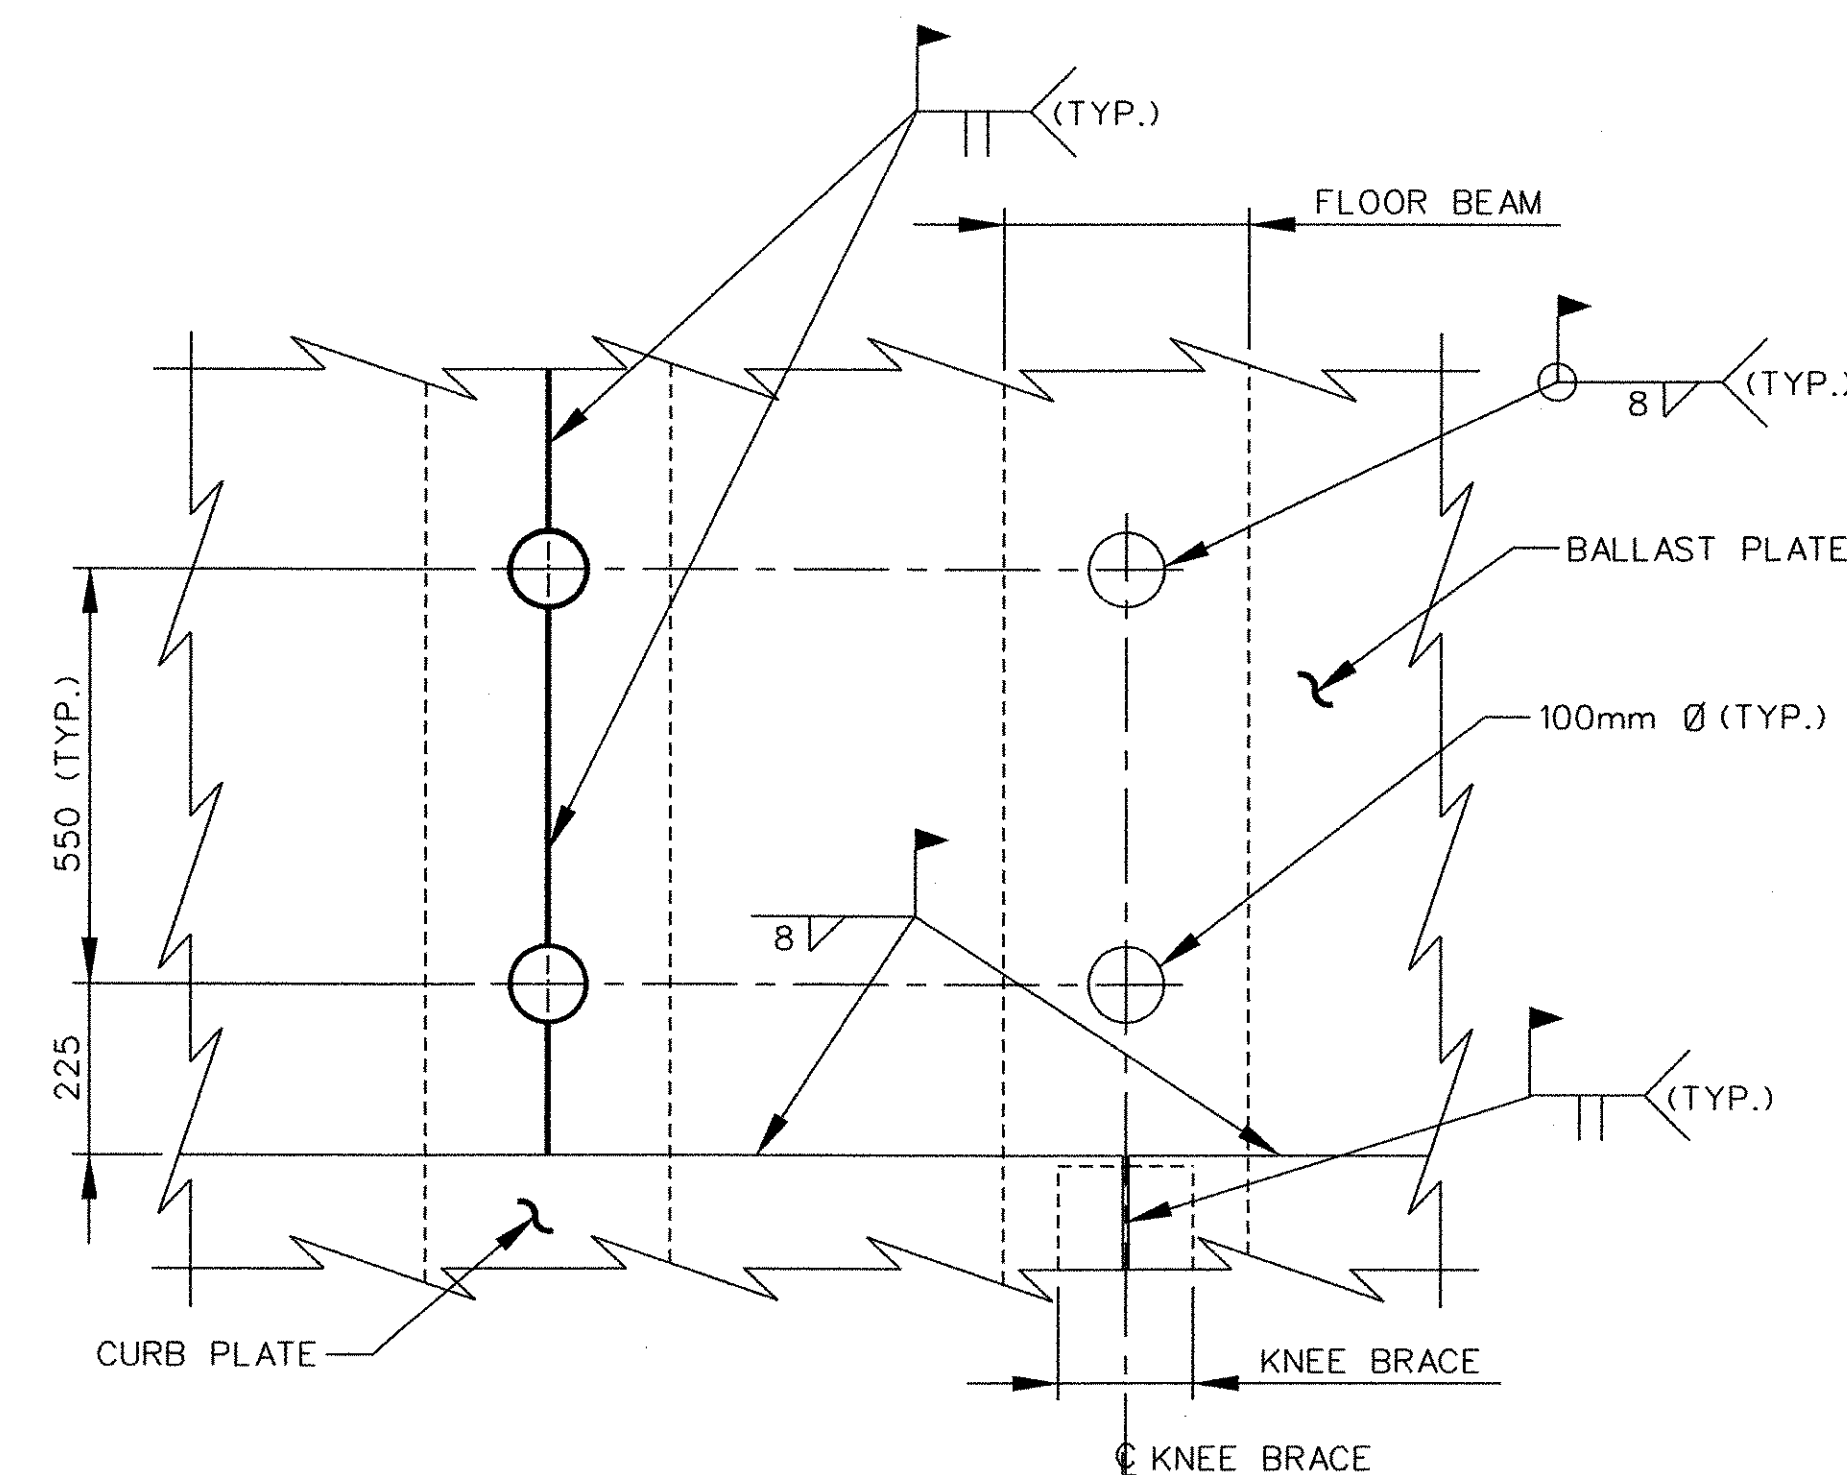


BALLAST PLATE CONNECTION
SCALE: 1:10

**STATE OF VERMONT
AGENCY OF TRANSPORTATION**

Town Of	BRATTLEBORO	Bridge No.	62.56
Highway No.	VT. ROUTE 9	Log Sta.	
		Surv. Sta.	
ROUTE 9 BRIDGE			
SUPERSTRUCTURE DETAILS			
Designed By		Drawn By	DHL
Checked By	GJB Date	Bridge Design Supervisor	JHR Date
PROJECT	BRATTLEBORO	PROJECT NO.	NH BRF 010-2(2)
I.G.C. Info.			
Bridge Sheet No. 6		Sheet 74 of 145	

Plot Date: 10-02-2002
File: rt9br161

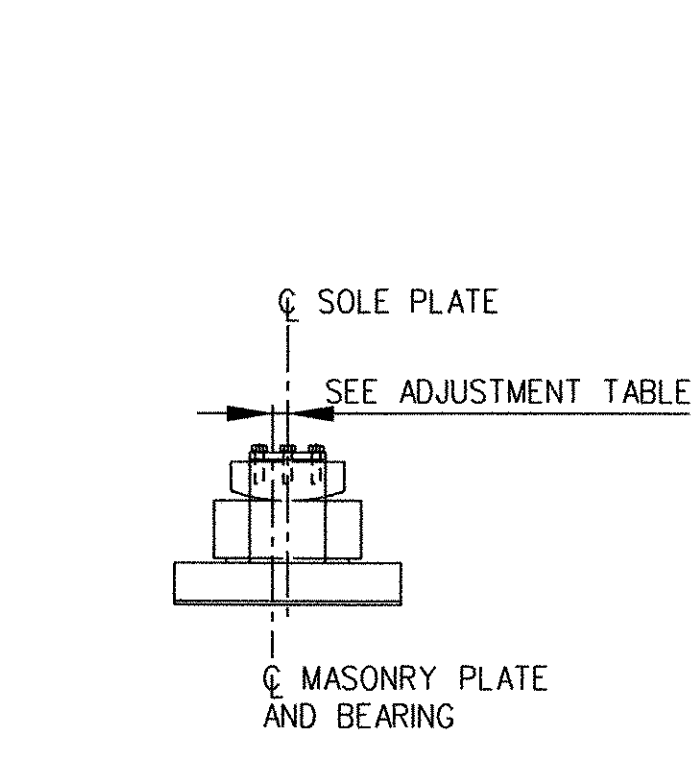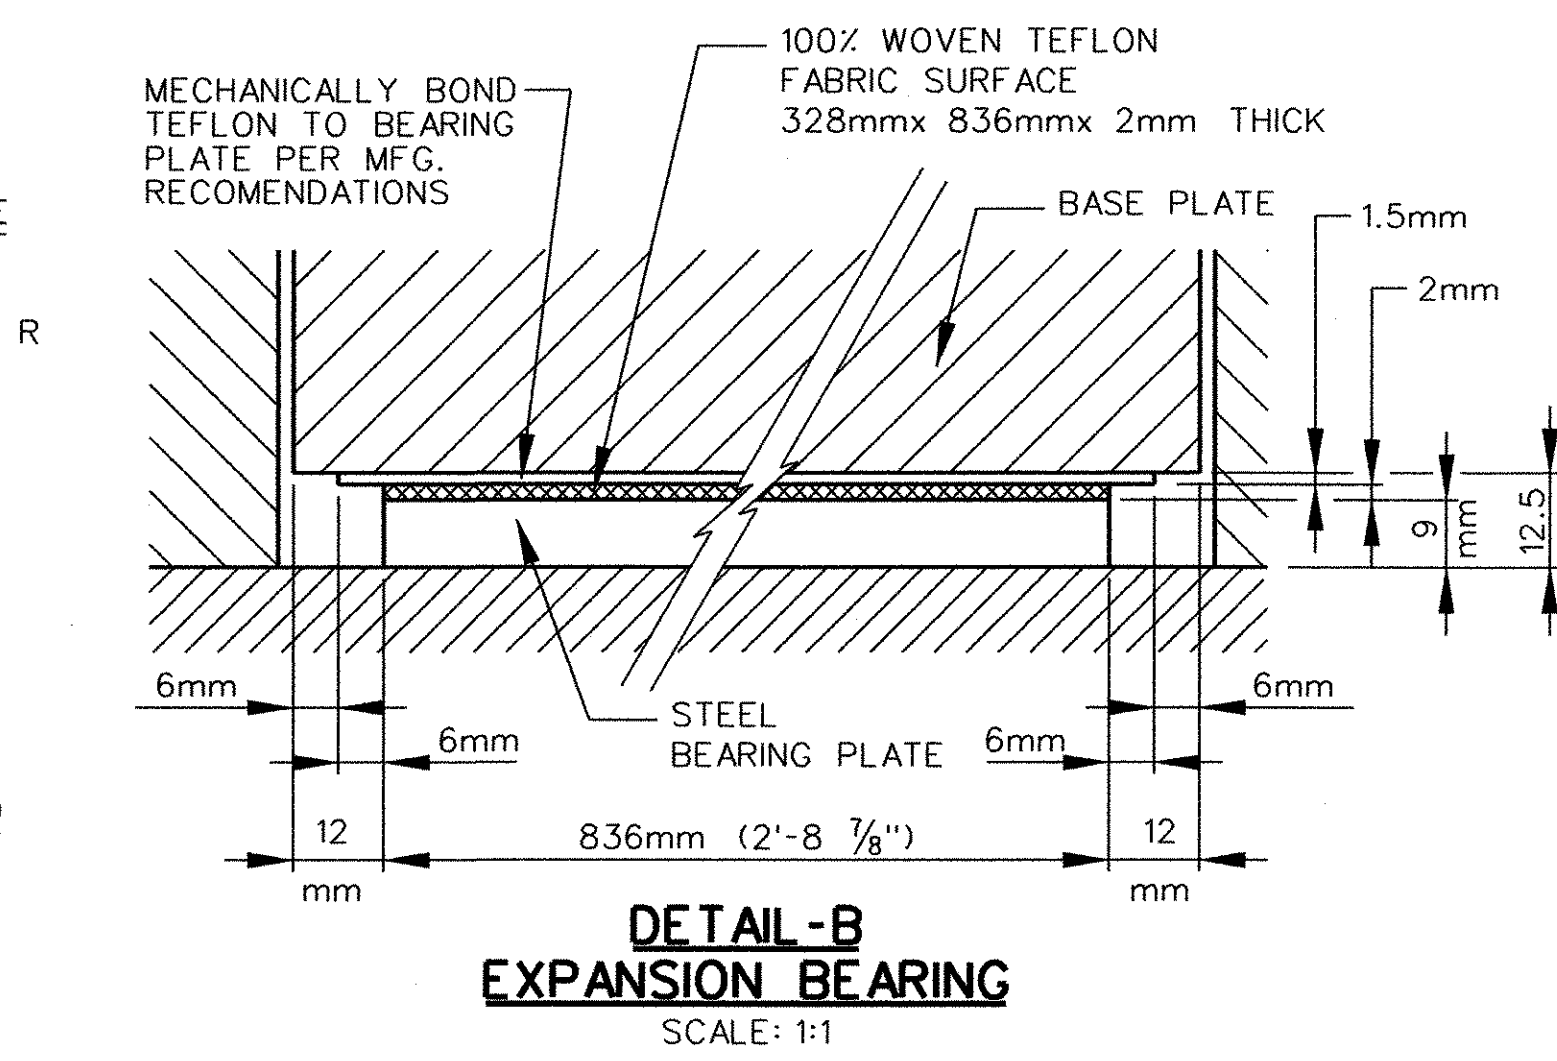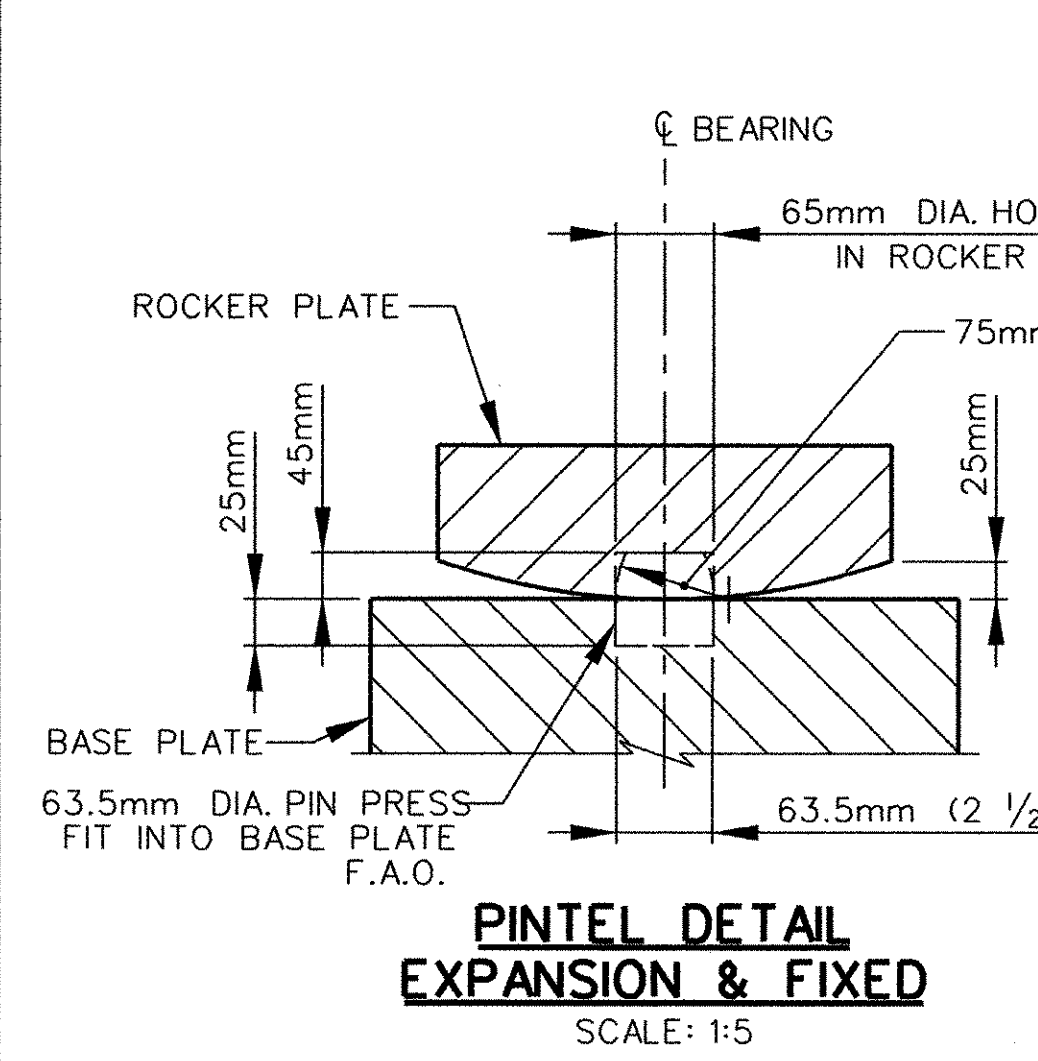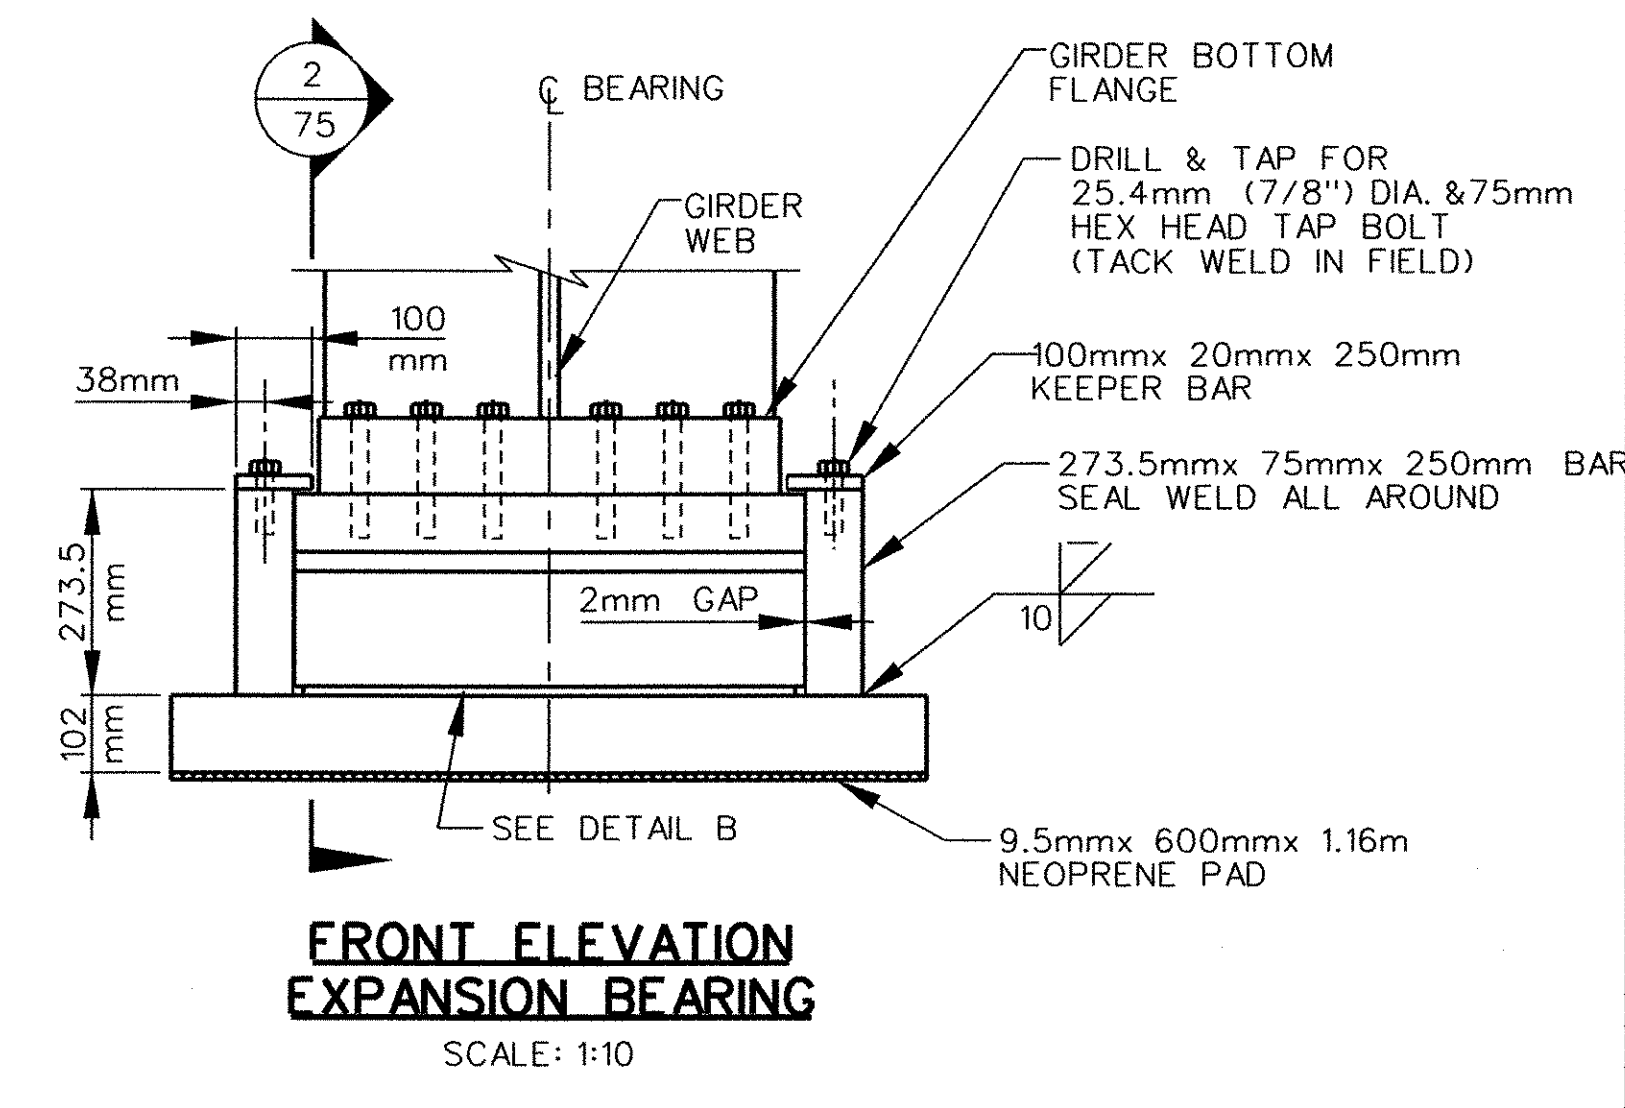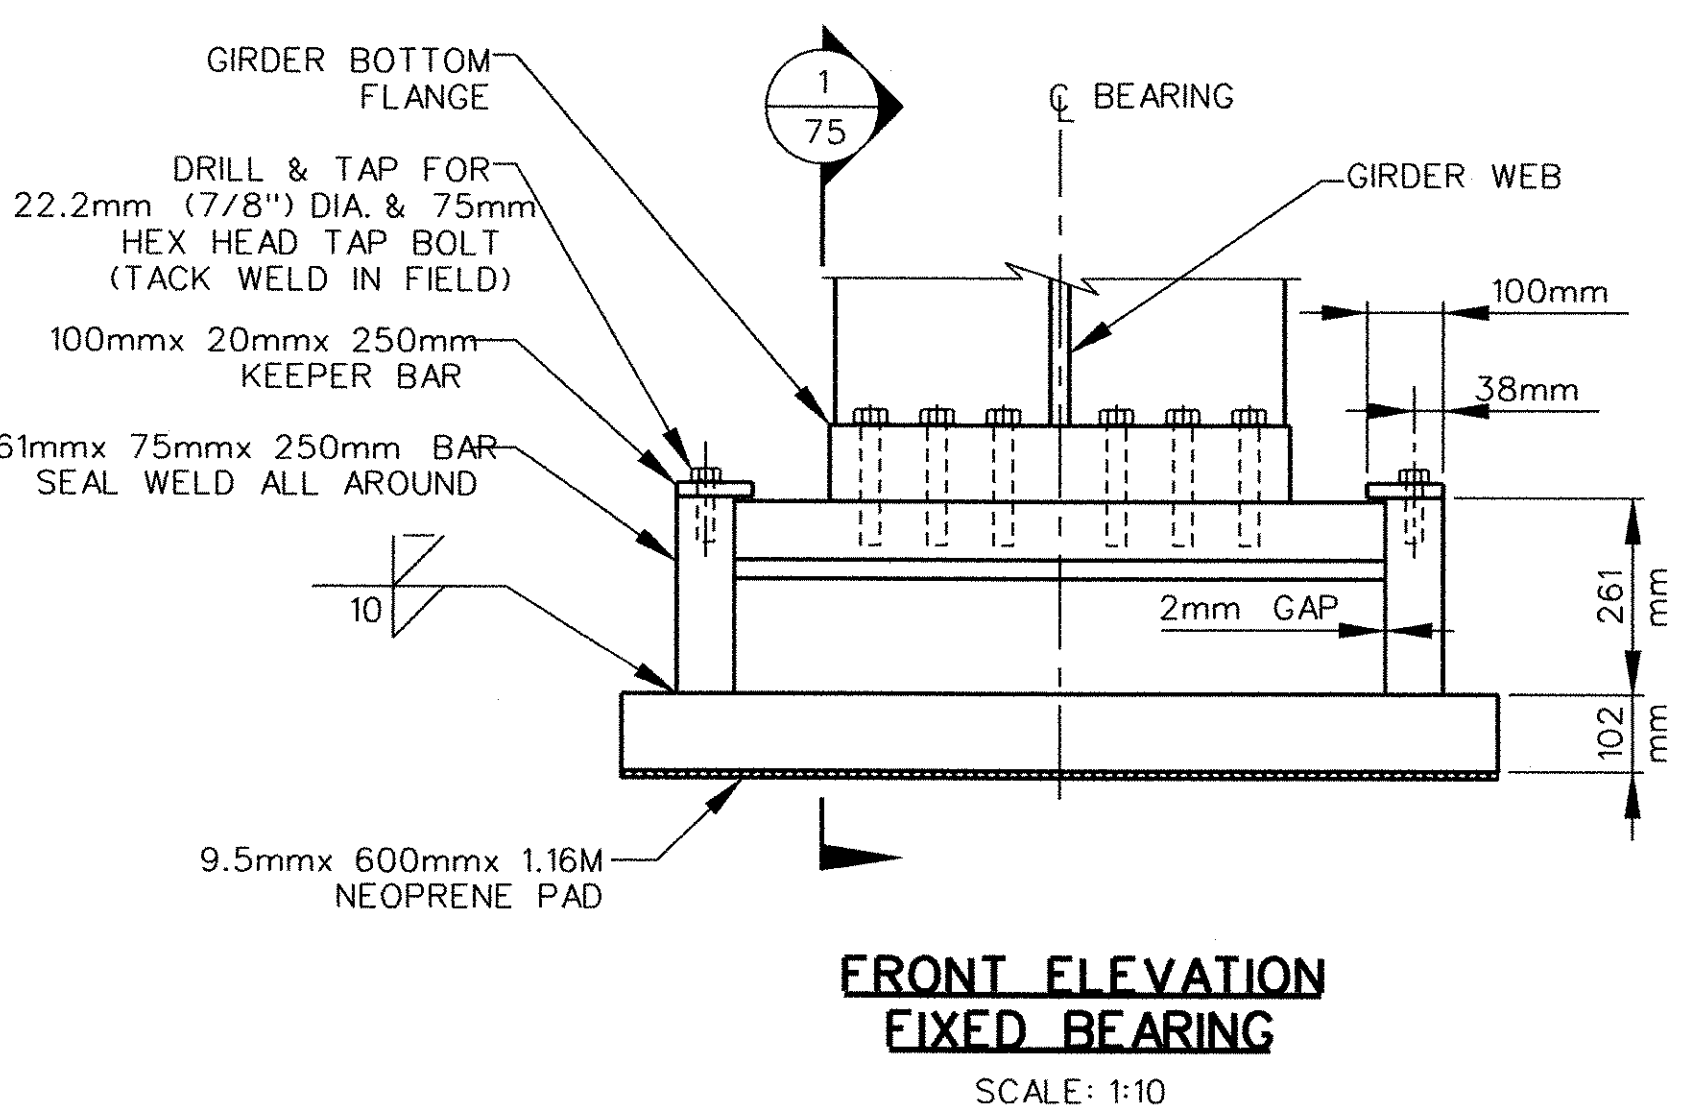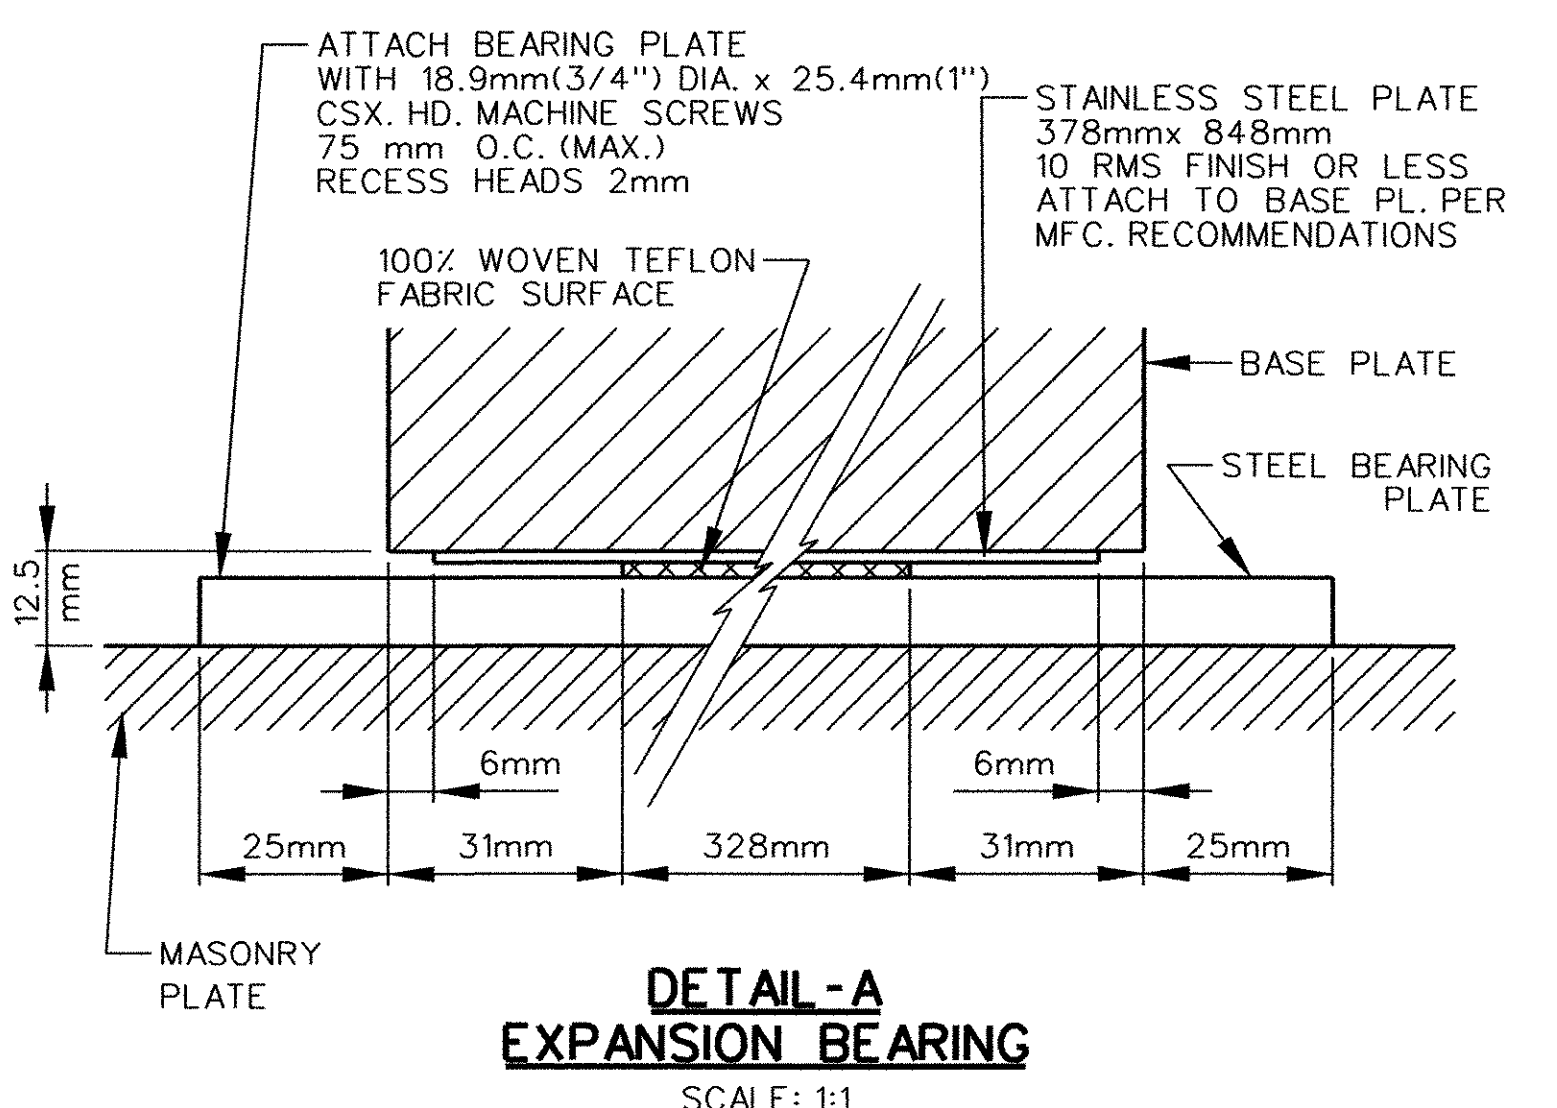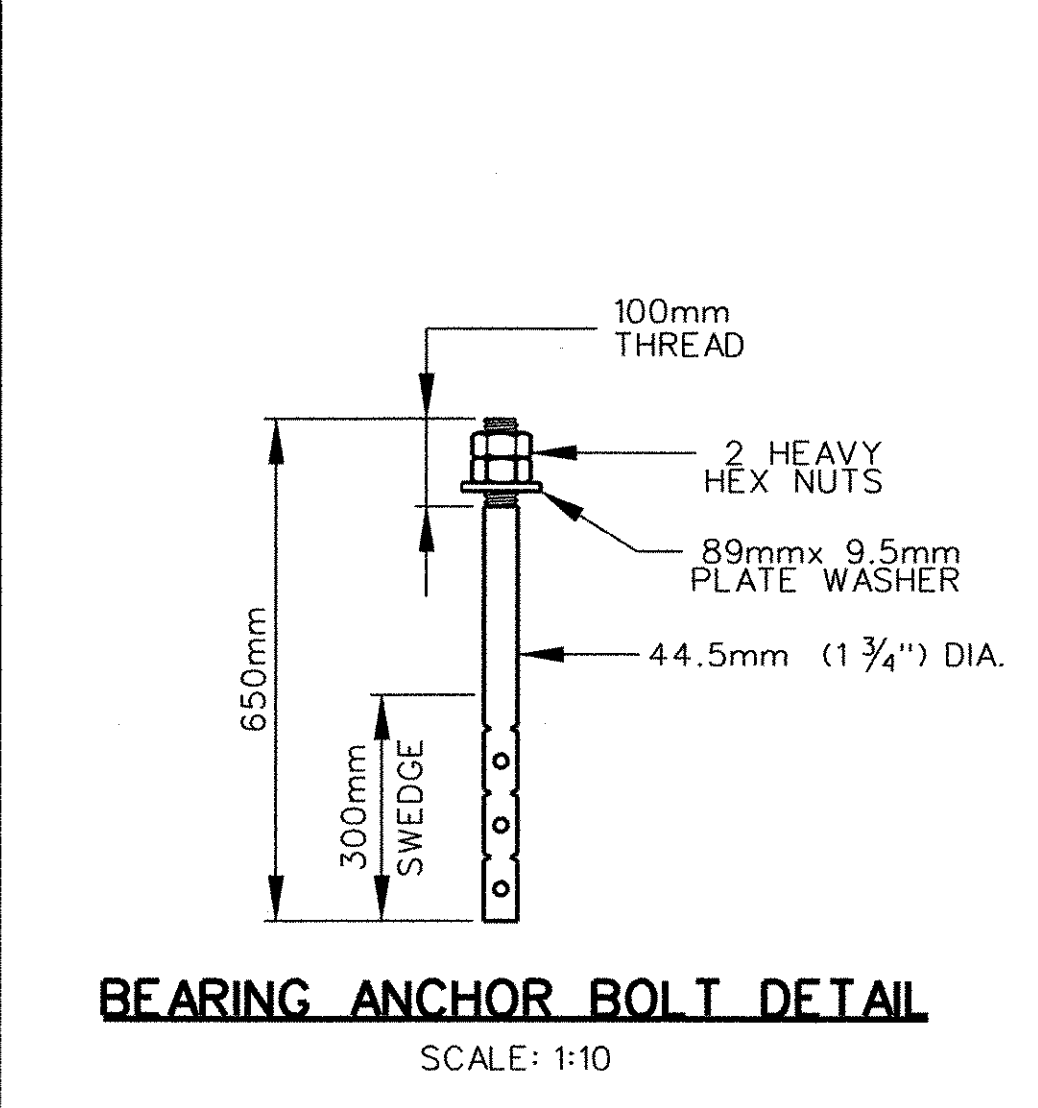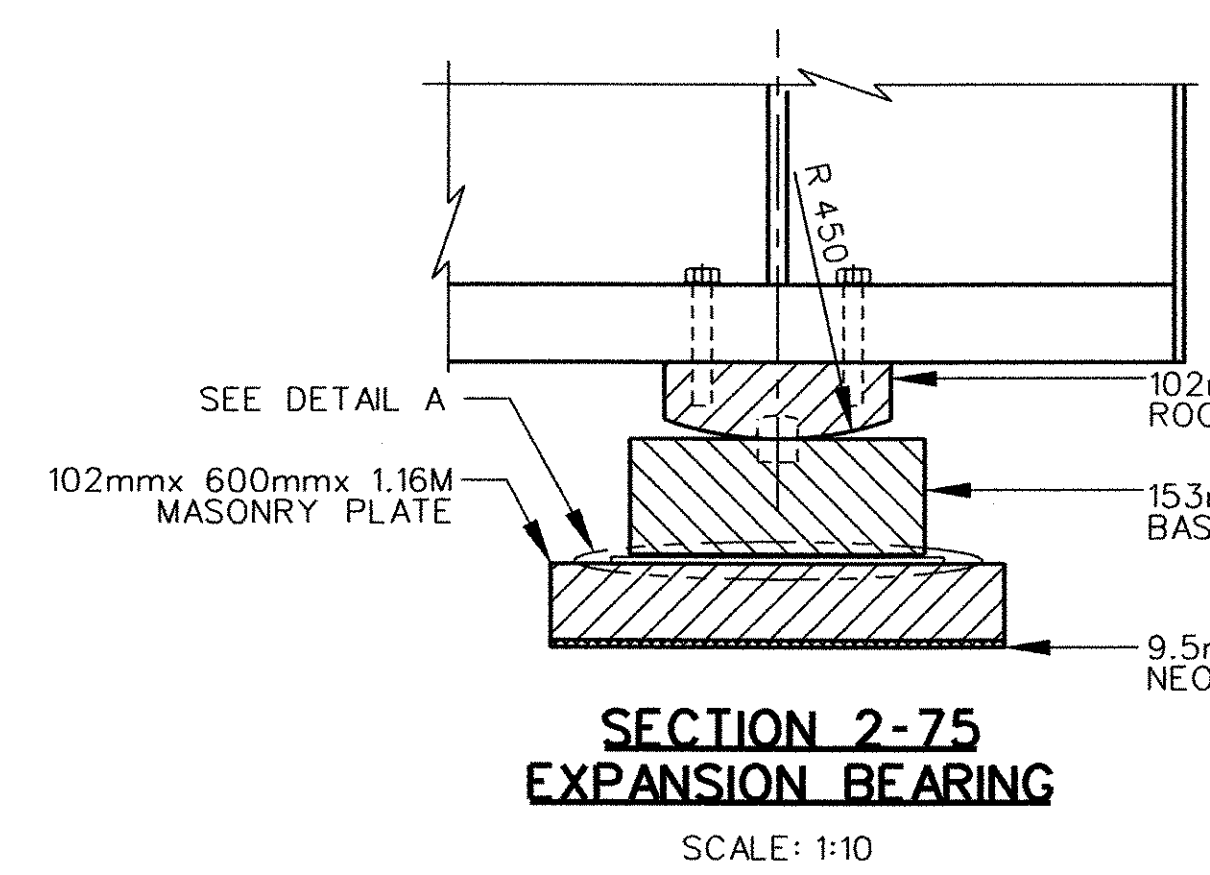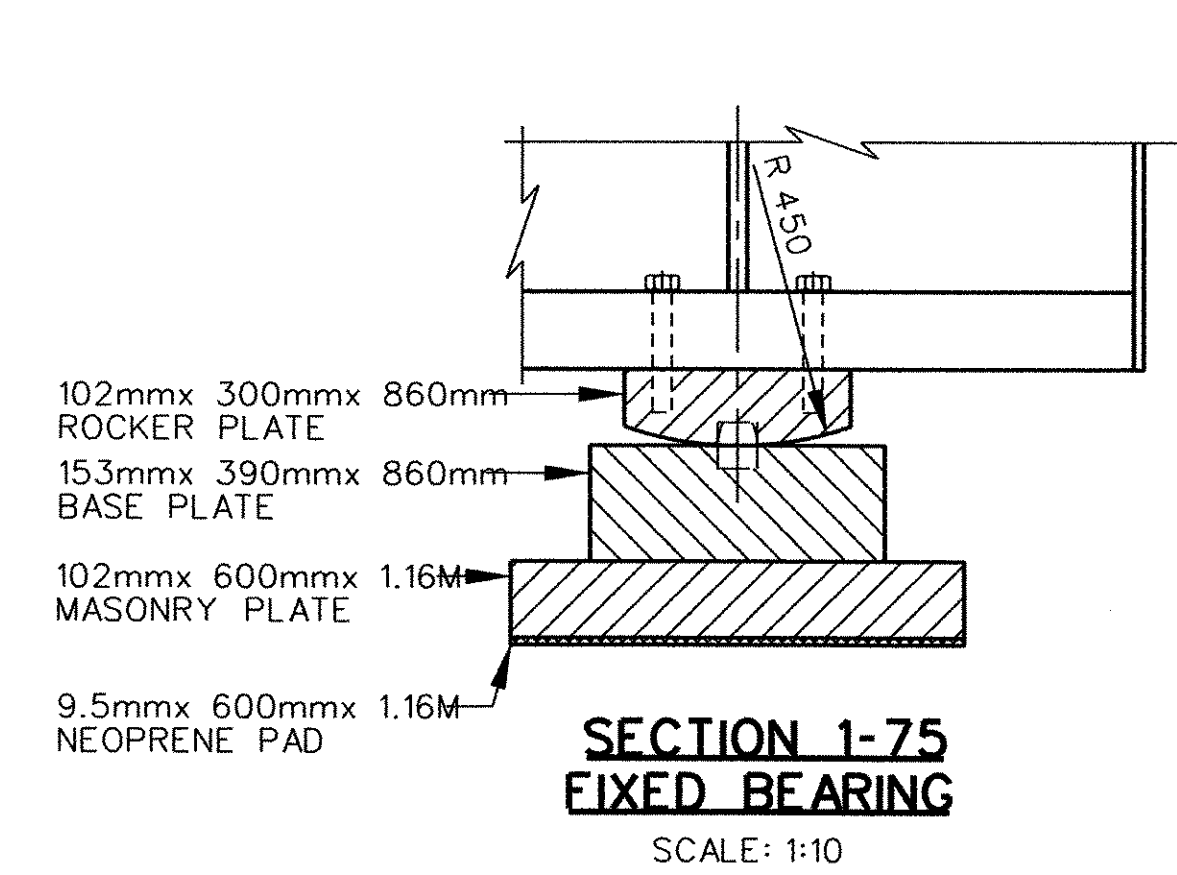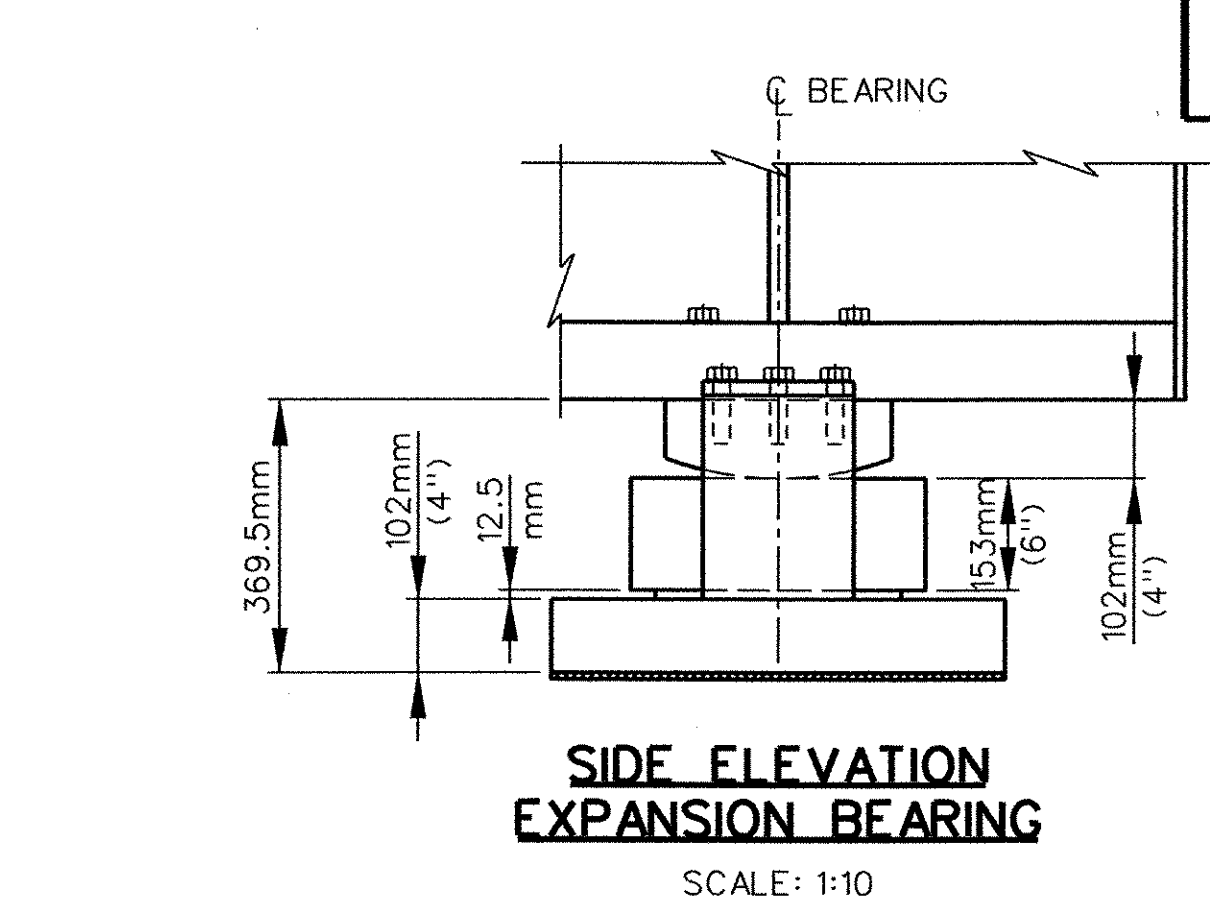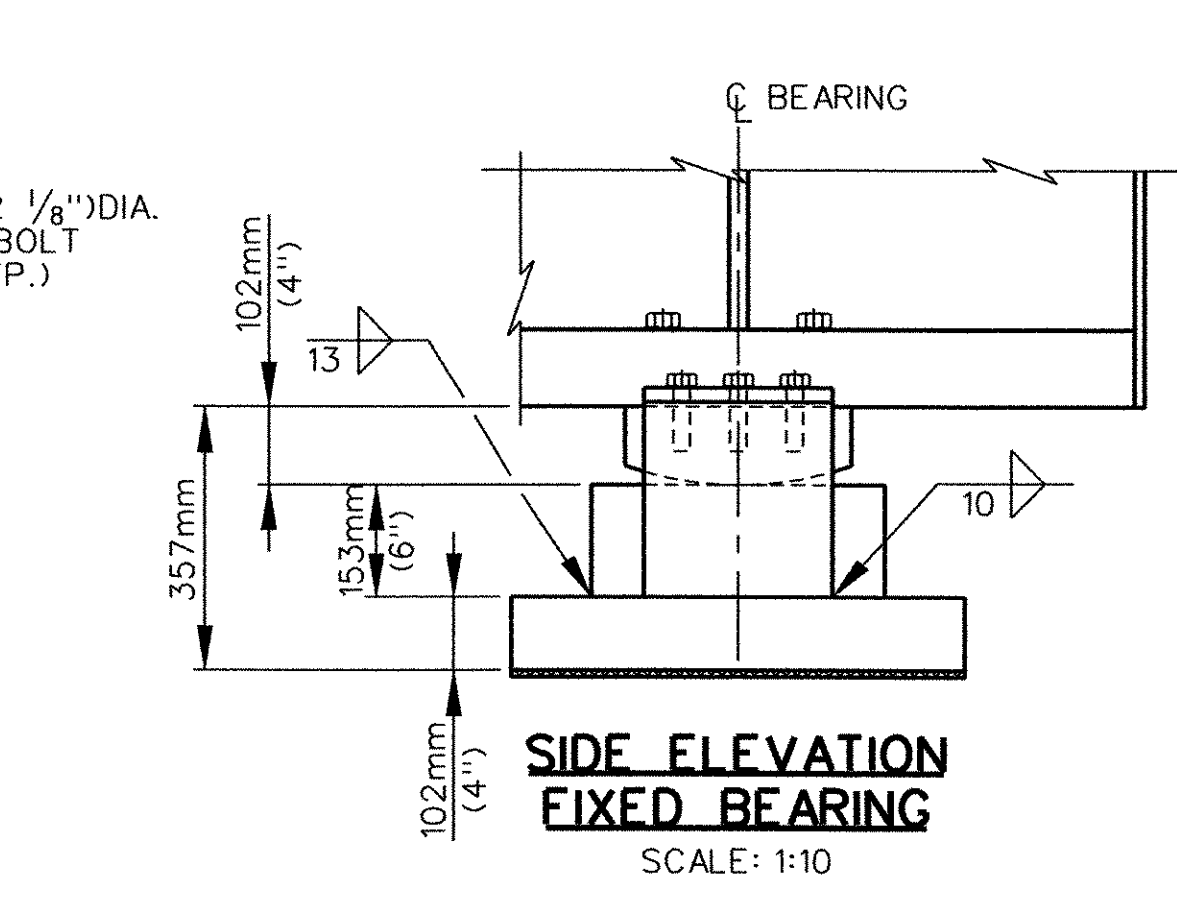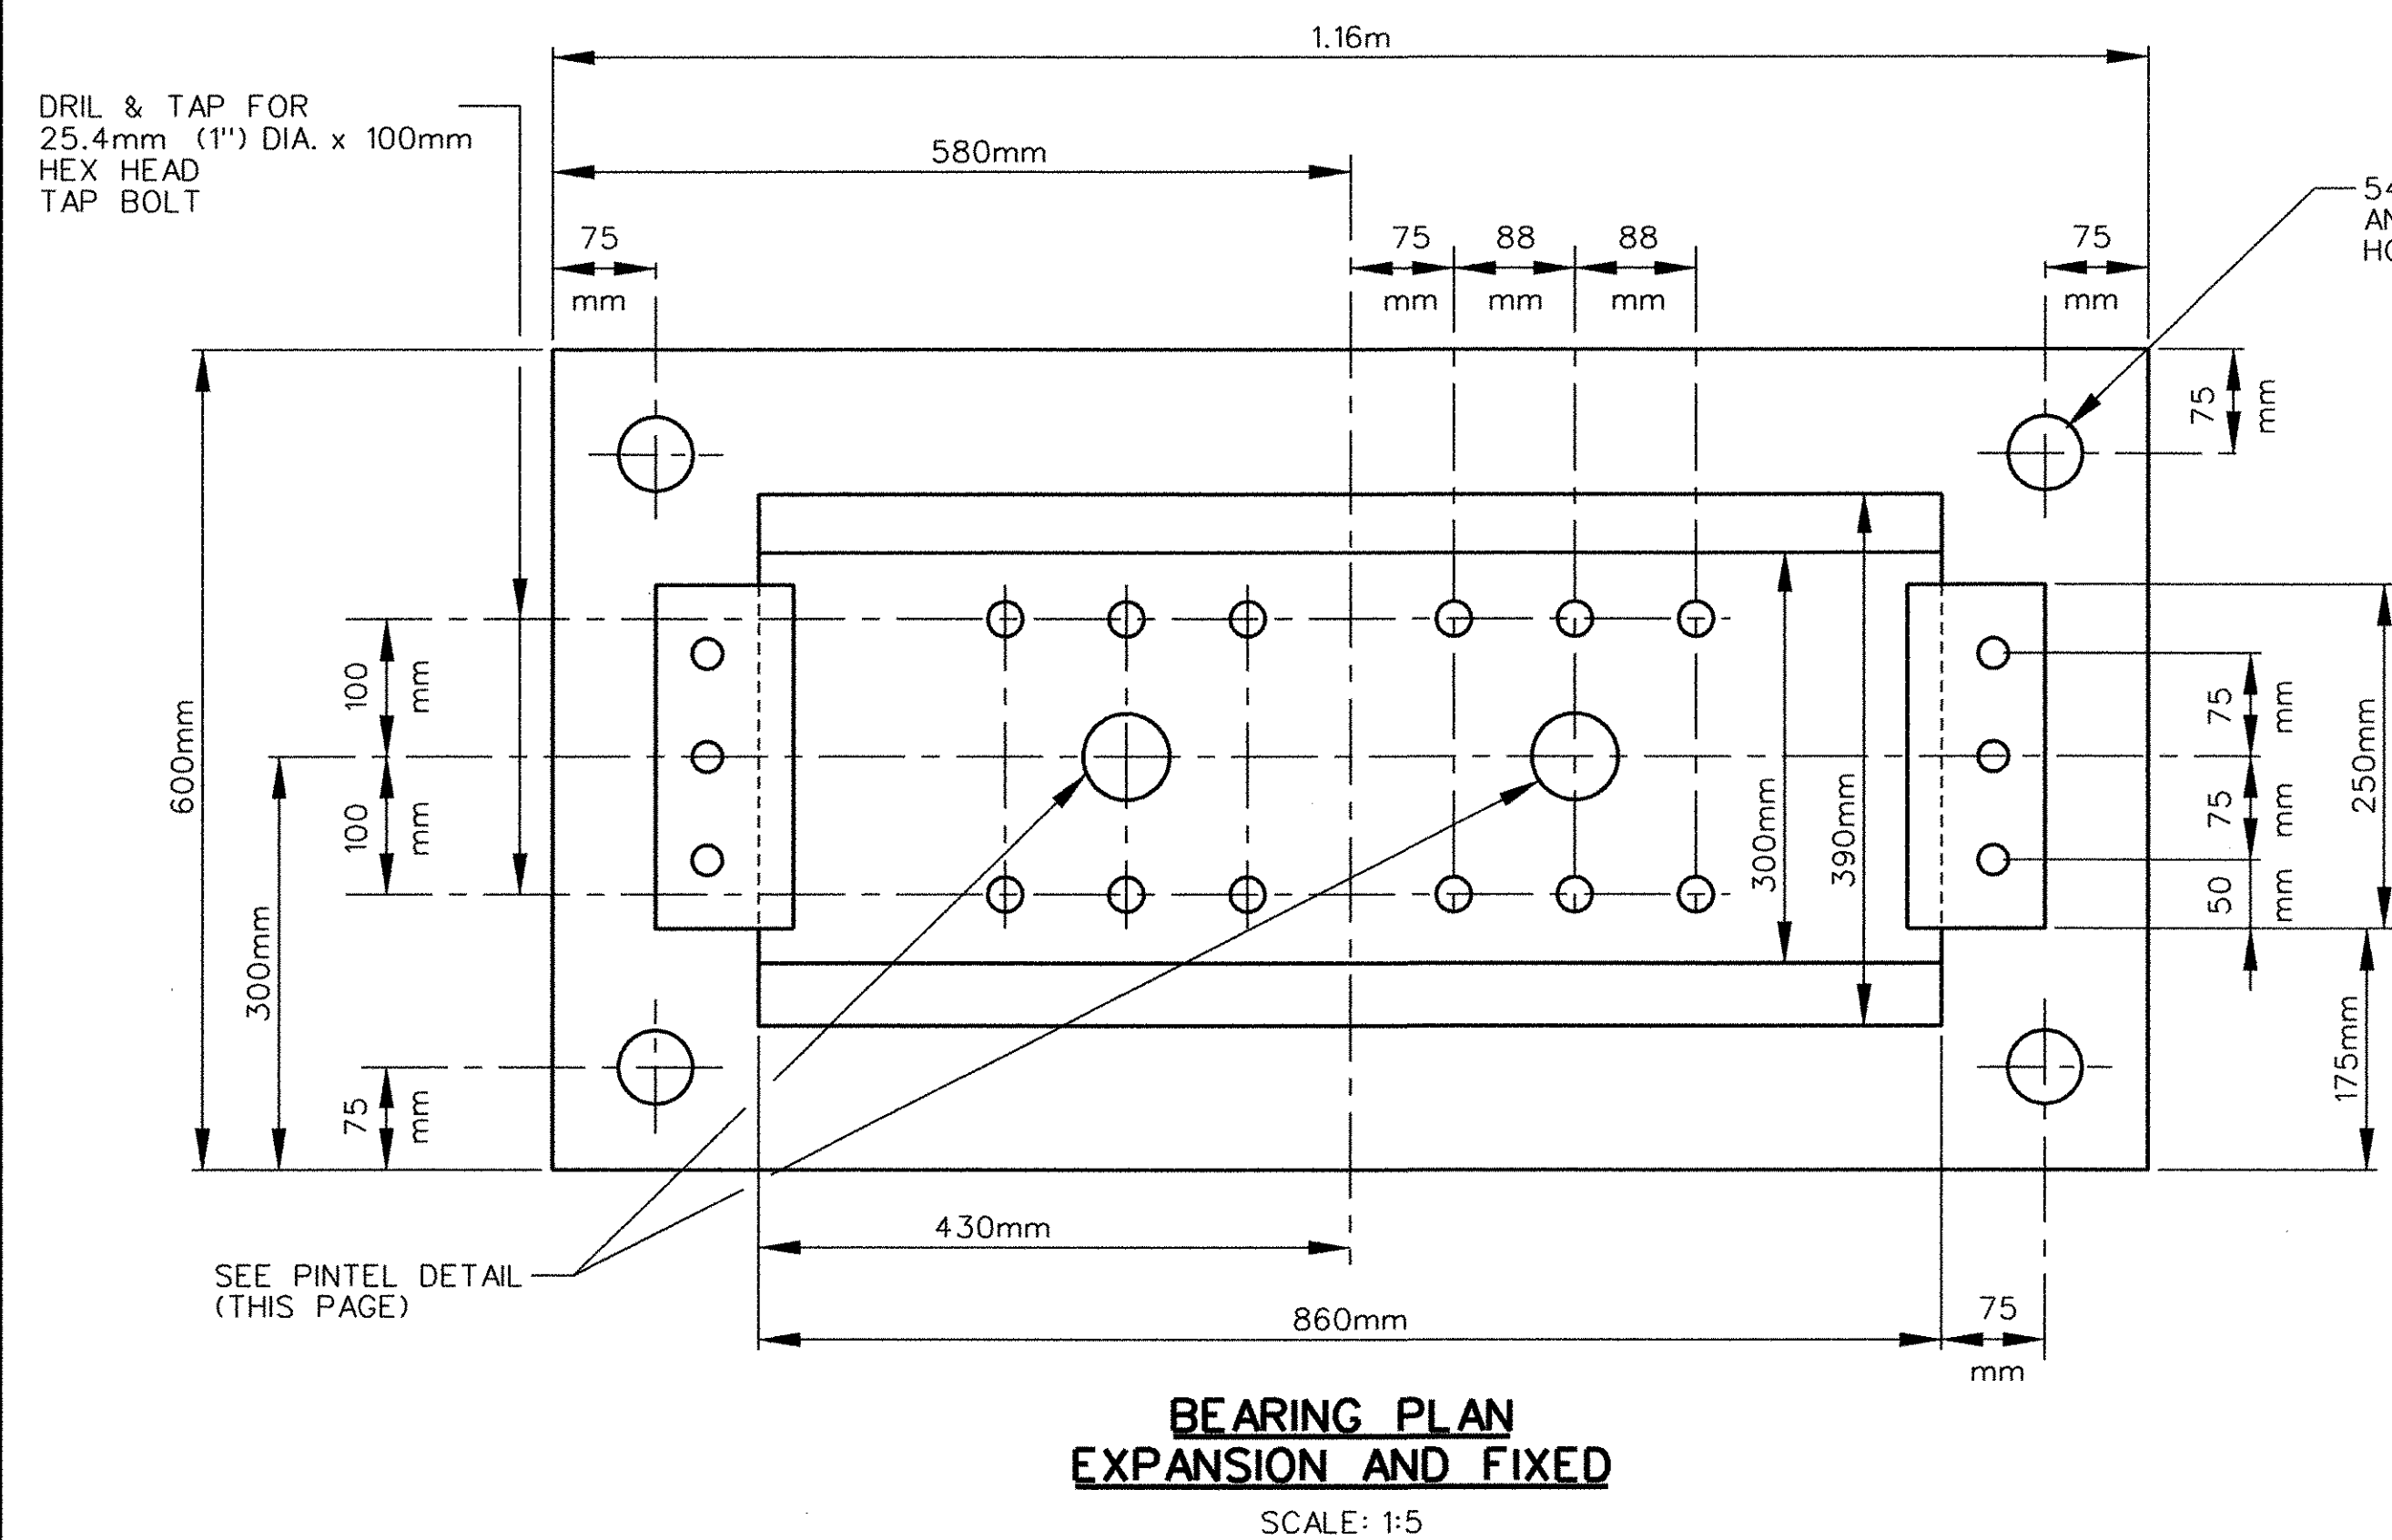

BEARING	BEARING LOAD TABLE	
	VERTICAL LOAD	HORIZONTAL LOAD TRANSVERSE/LONGITUDINAL
EXPANSION	2970KN (668 Kips)	209KN (47 Kips)
FIXED	2970KN (668 Kips)	182KN (41 Kips) 676KN (152 Kips)


ADJUSTMENT FOR 10° TEMP. CHANGE

MOVE TOP PLATE 3mm (0.01") TOWARD CENTER OF SPAN FOR TEMP. FALL AND 3mm (0.01") AWAY FOR TEMP. RISE.


NOTE: BEARINGS ARE TO BE CENTERED AT 45°F SO THAT THE CENTERLINE OF THE SOLE PLATE IS OVER THE CENTERLINE OF THE MASONRY PLATE.

STATE OF VERMONT AGENCY OF TRANSPORTATION


Town Of	BRATTLEBORO	Bridge No.	62.56
Highway No.	VT. ROUTE 9	Log Sta.	
		Surv. Sta.	
ROUTE 9 BRIDGE			
BEARING DETAILS			
Designed By	LM	Drawn By	LRD/DL
Checked By	GJB	Date	
		Bridge Design Supervisor	JHR
		Date	
PROJECT	BRATTLEBORO	PROJECT NO.	NH 010-2(2)
I.G.C. Info.			
Bridge Sheet No. 7		Sheet 75 of 145	

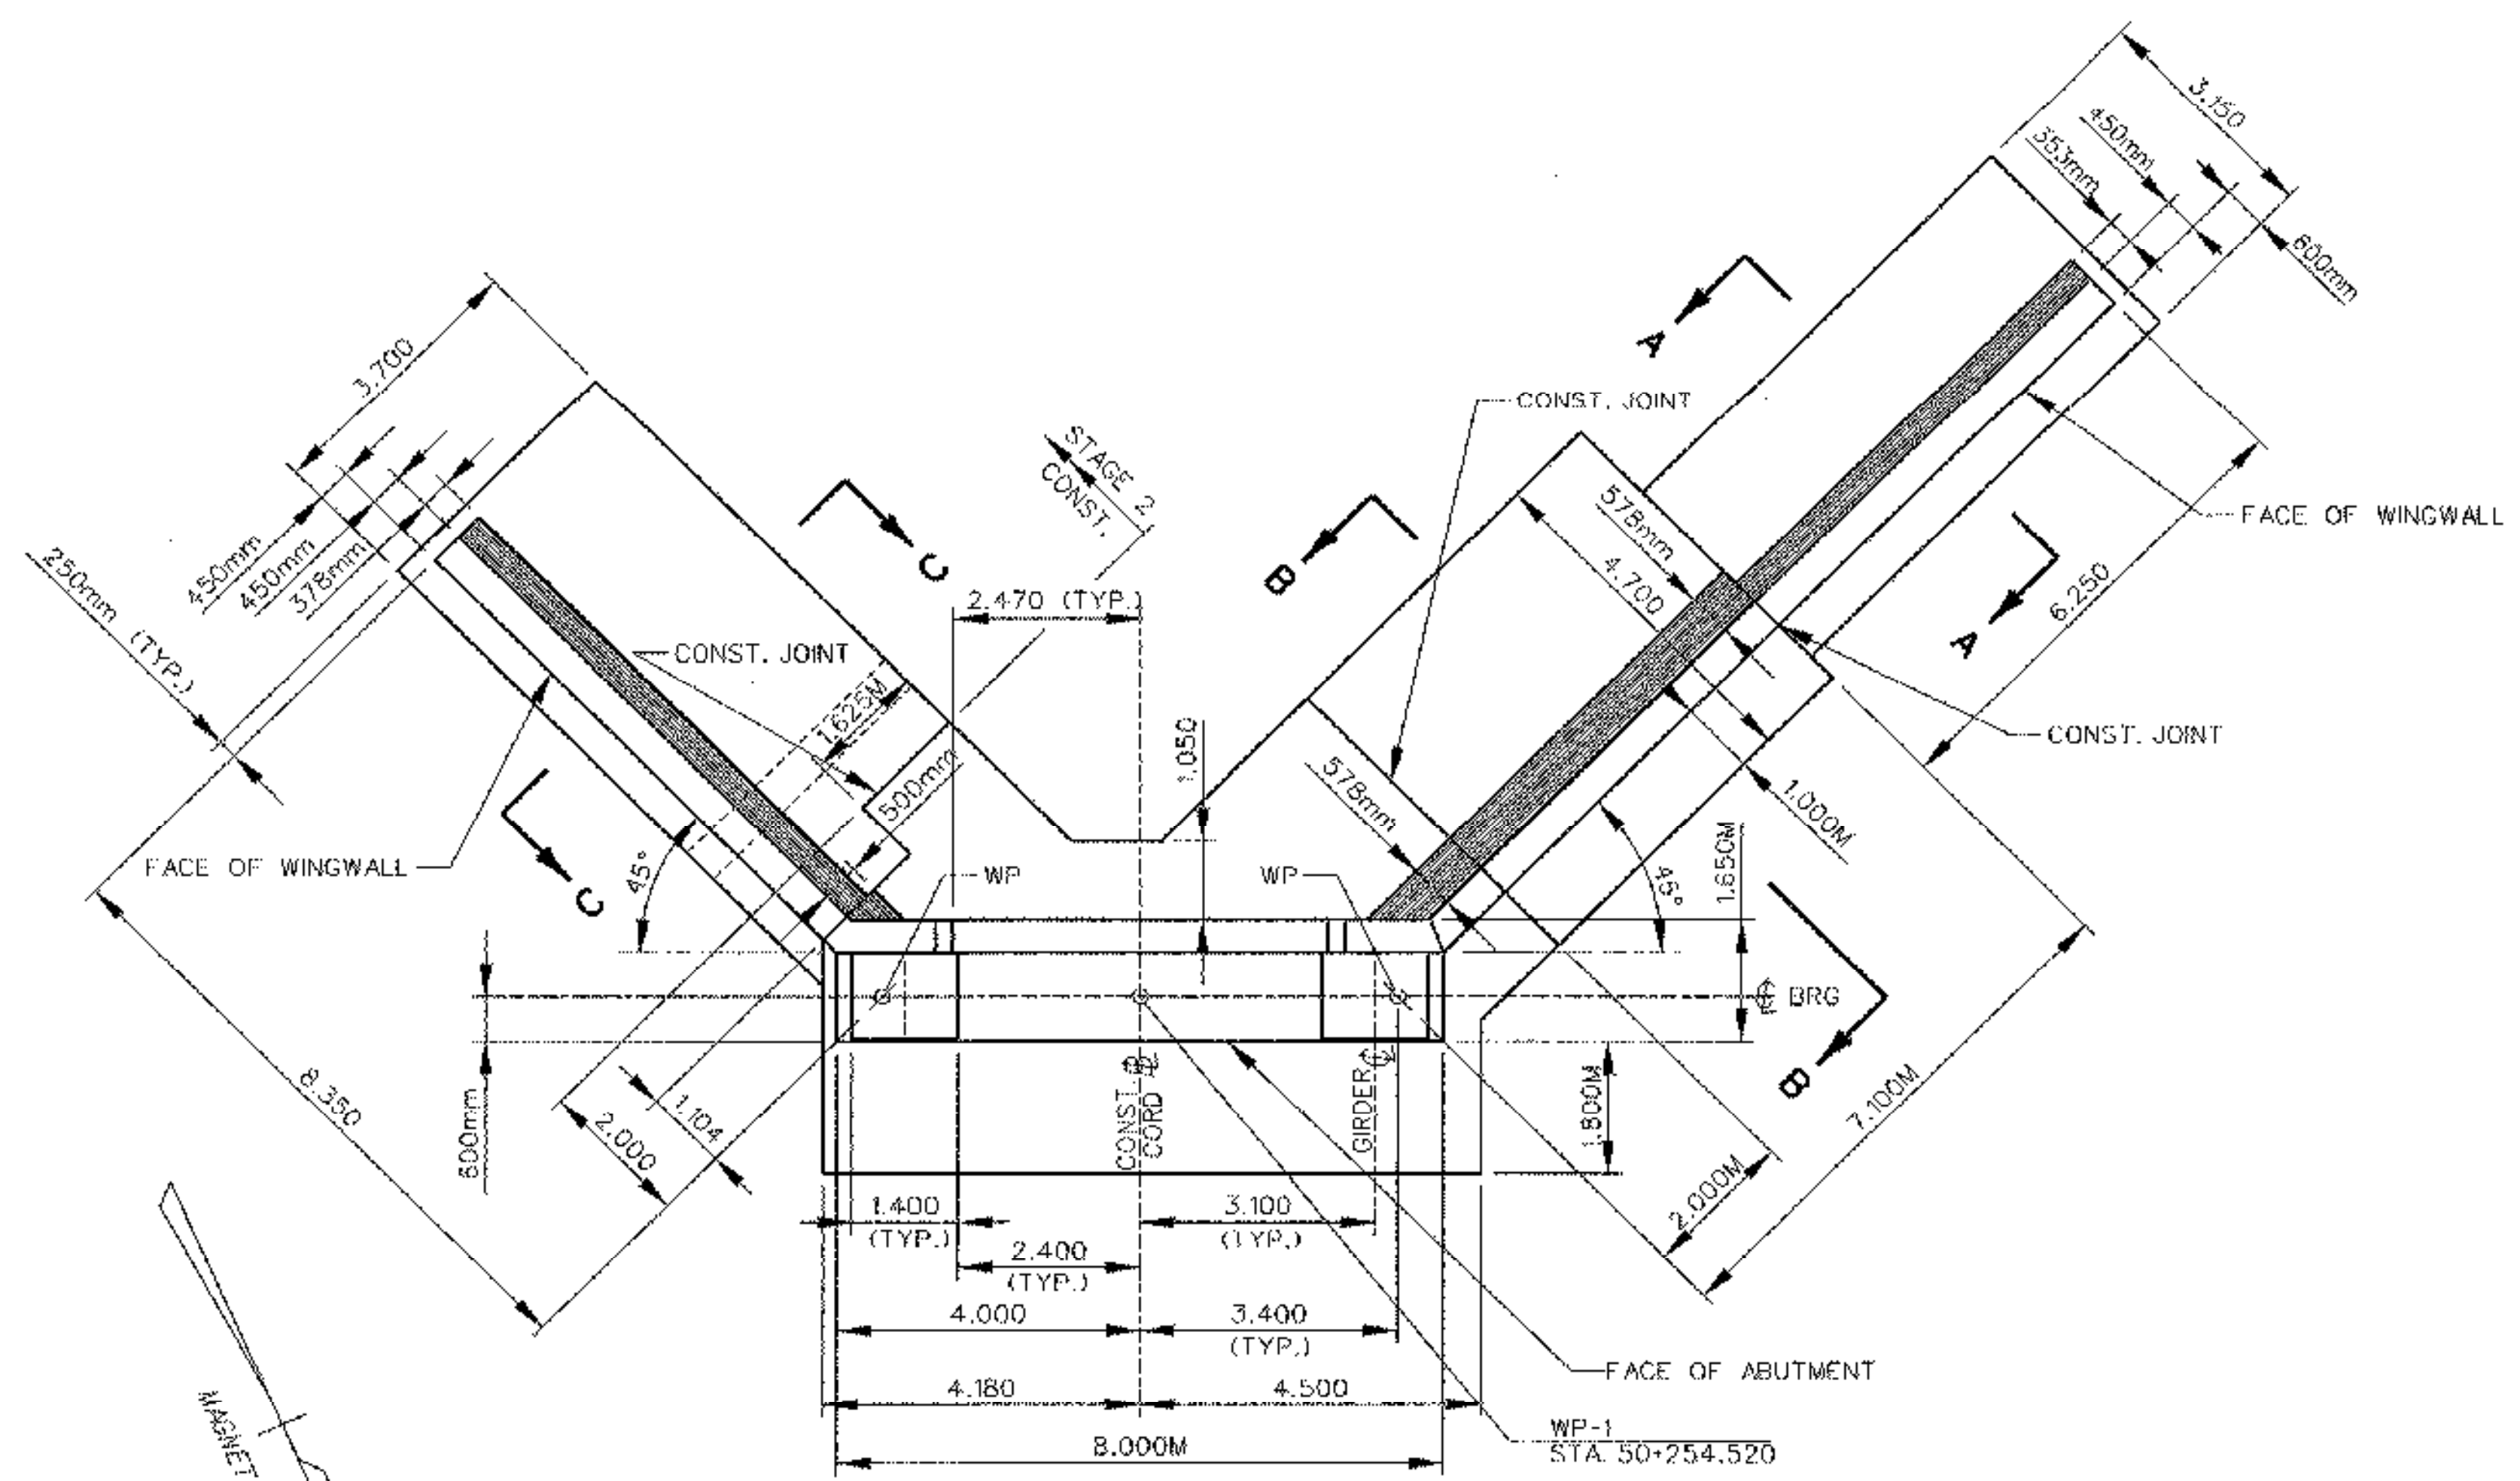

SOUTH ABUTMENT PLAN
SCALE 1:75

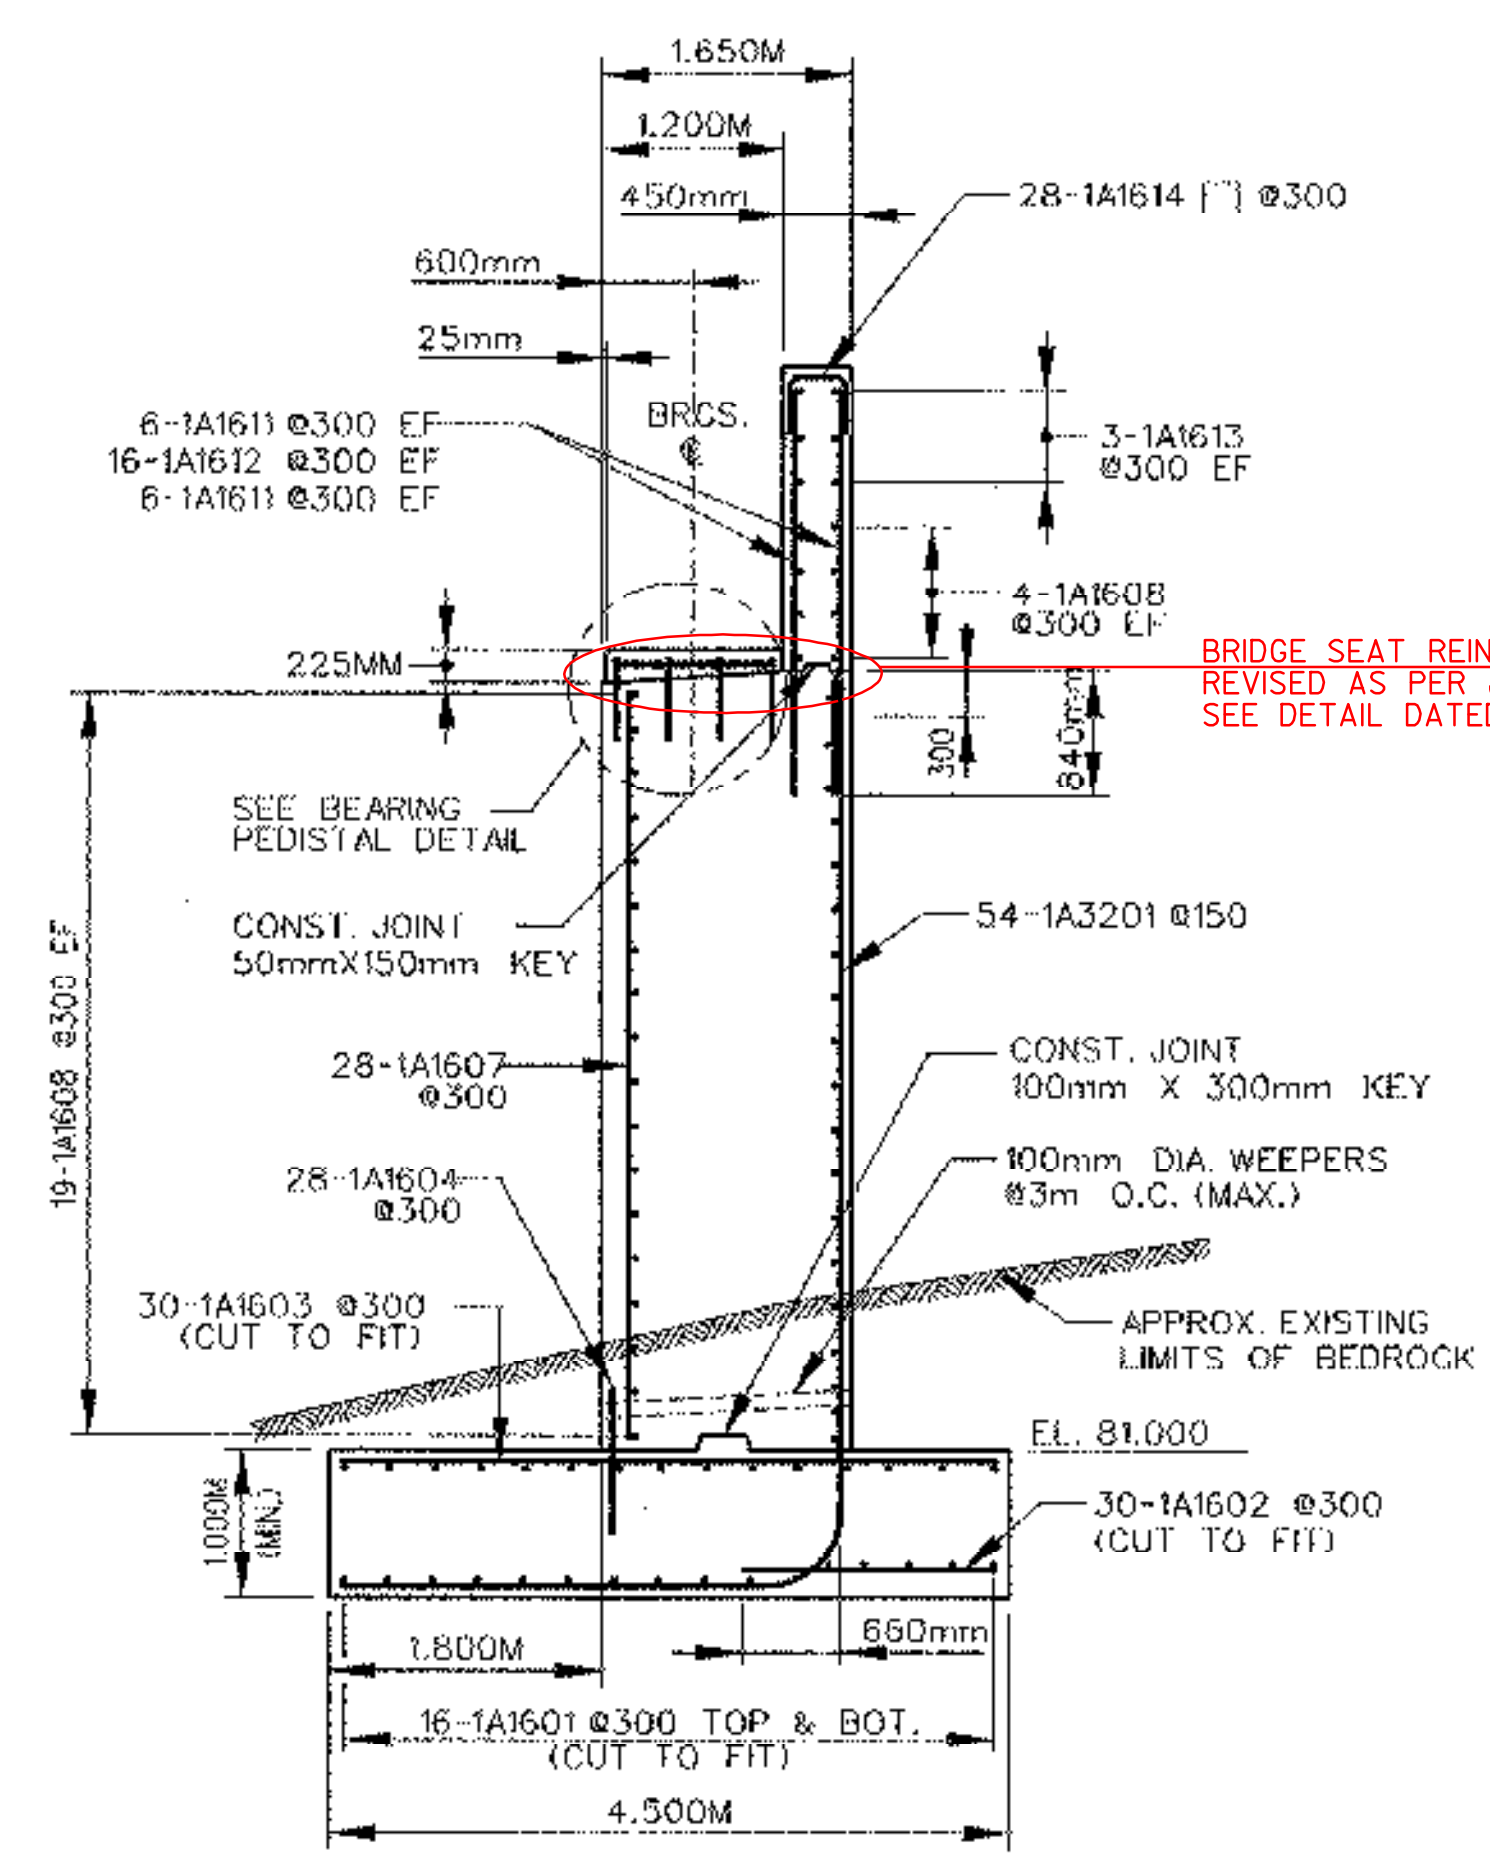

TYPICAL SOUTH ABUTMENT SECTION
SCALE 1:50

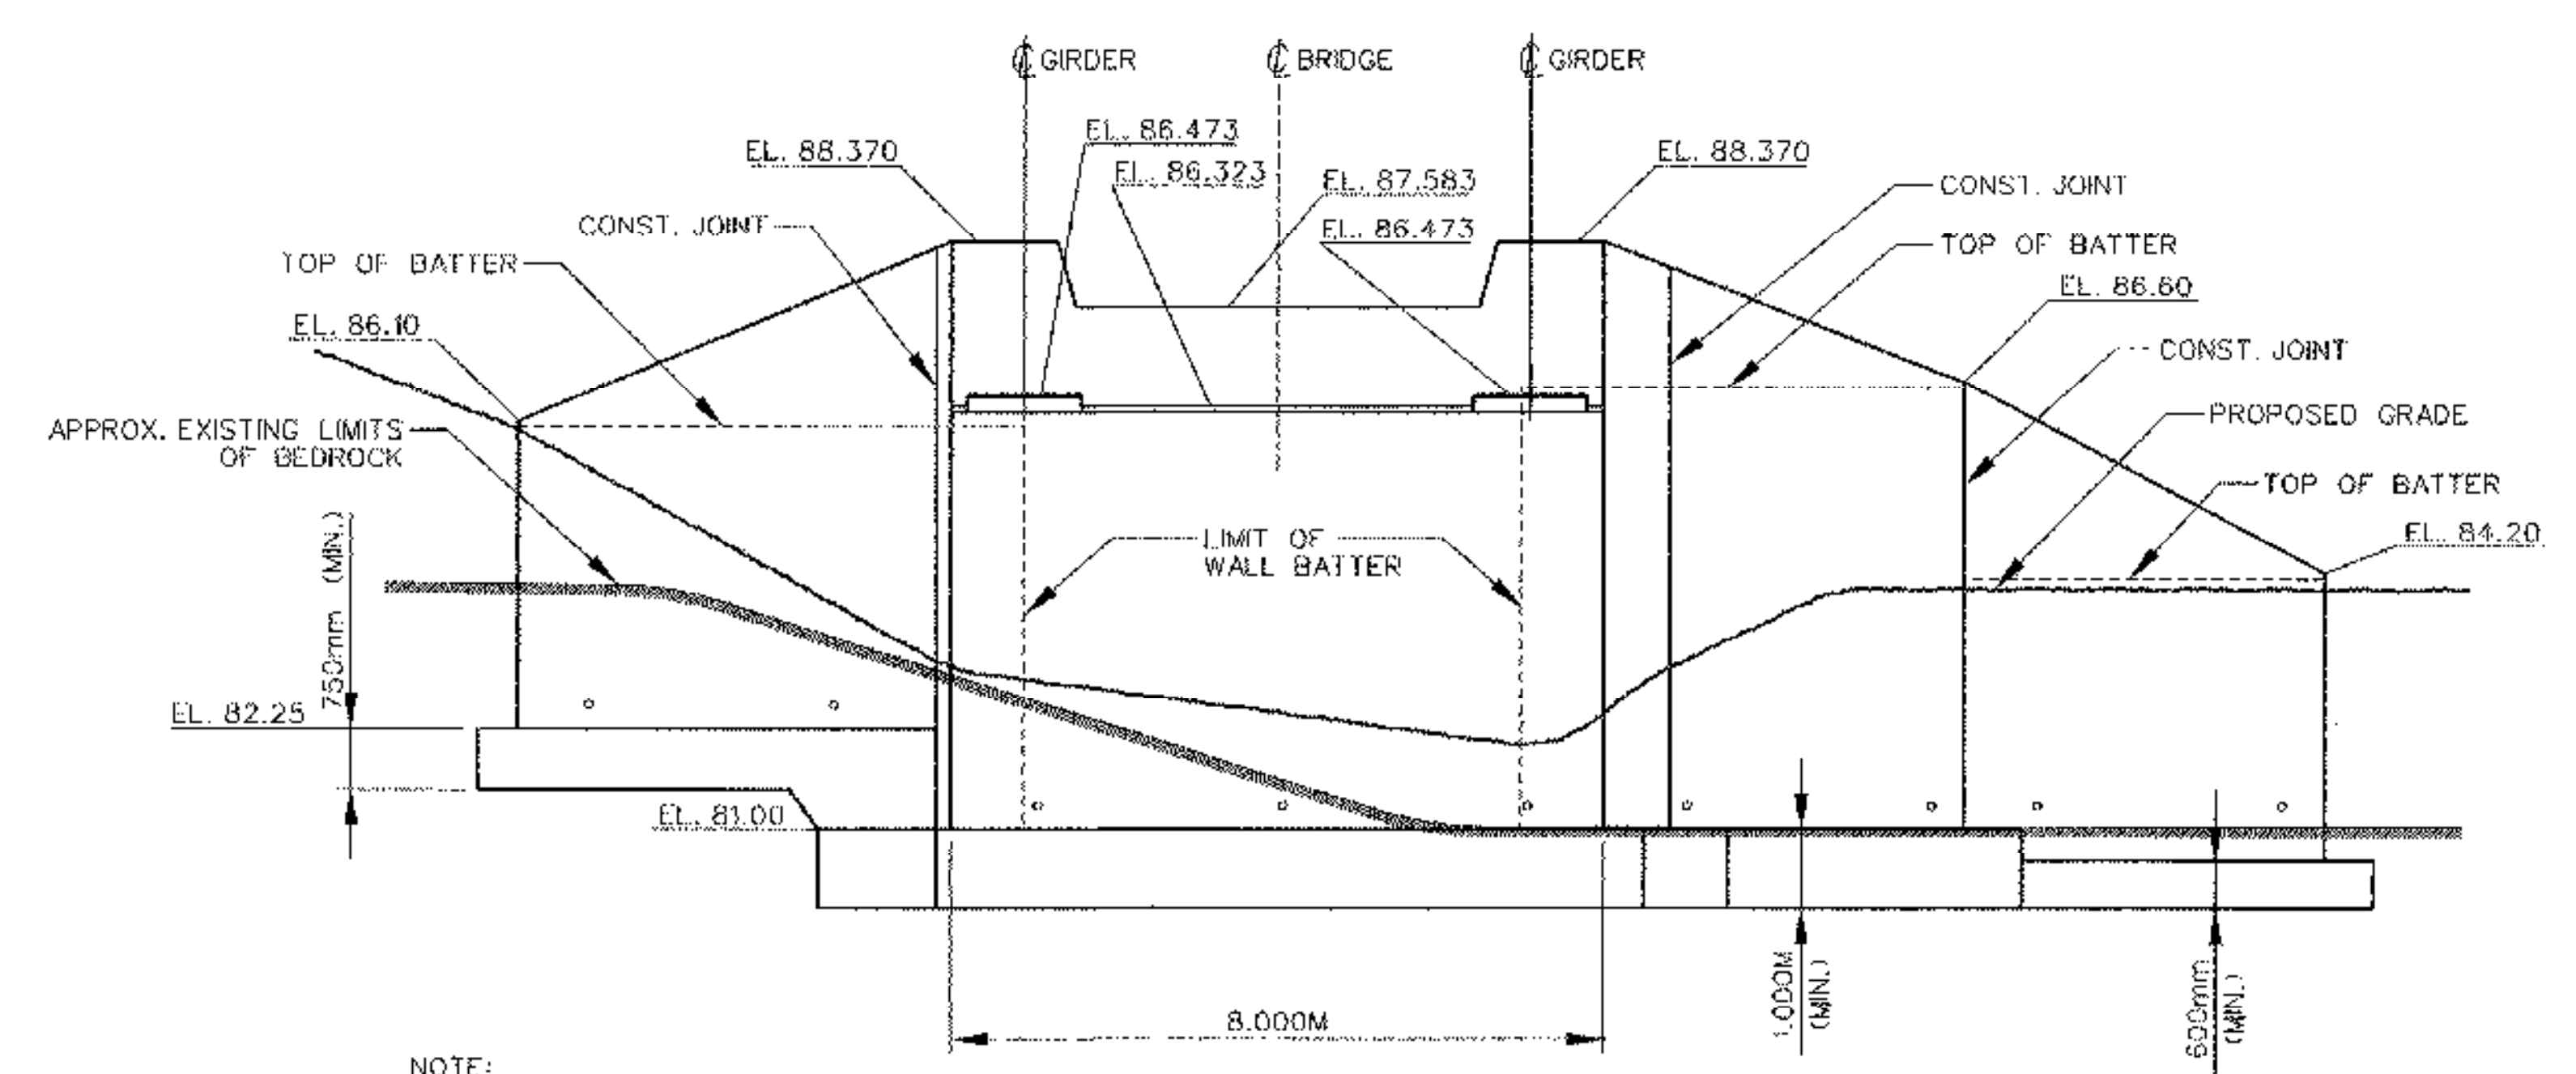


SOUTH ABUTMENT ELEVATION
SCALE 1:75

NOTE:
FOR PARAPET PLATE DETAIL
SEE SHEET 73 OF 145


EL. 76.7
11-23-99

STATE OF VERMONT AGENCY OF TRANSPORTATION			
Town Of	BRATTLEBORO	Bridge No.	62.56
Highway No.	VT. ROUTE 9	Log Sta.	
		Surv. Sta.	
ROUTE 9 BRIDGE			
SOUTH ABUTMENT PLAN, ELEVATION & SECTIONS			
Designed By	LM	Drawn By	DHL
Checked By	GJB	Bridge Design Supervisor	JHR
	Date		Date
PROJECT	BRATTLEBORO	PROJECT NO.	NH 010-2(2)
I.G.C. Info.			
Bridge Sheet No. 8		Sheet 76	of 145

Plot Date: 10-03-2002
File: r19br154

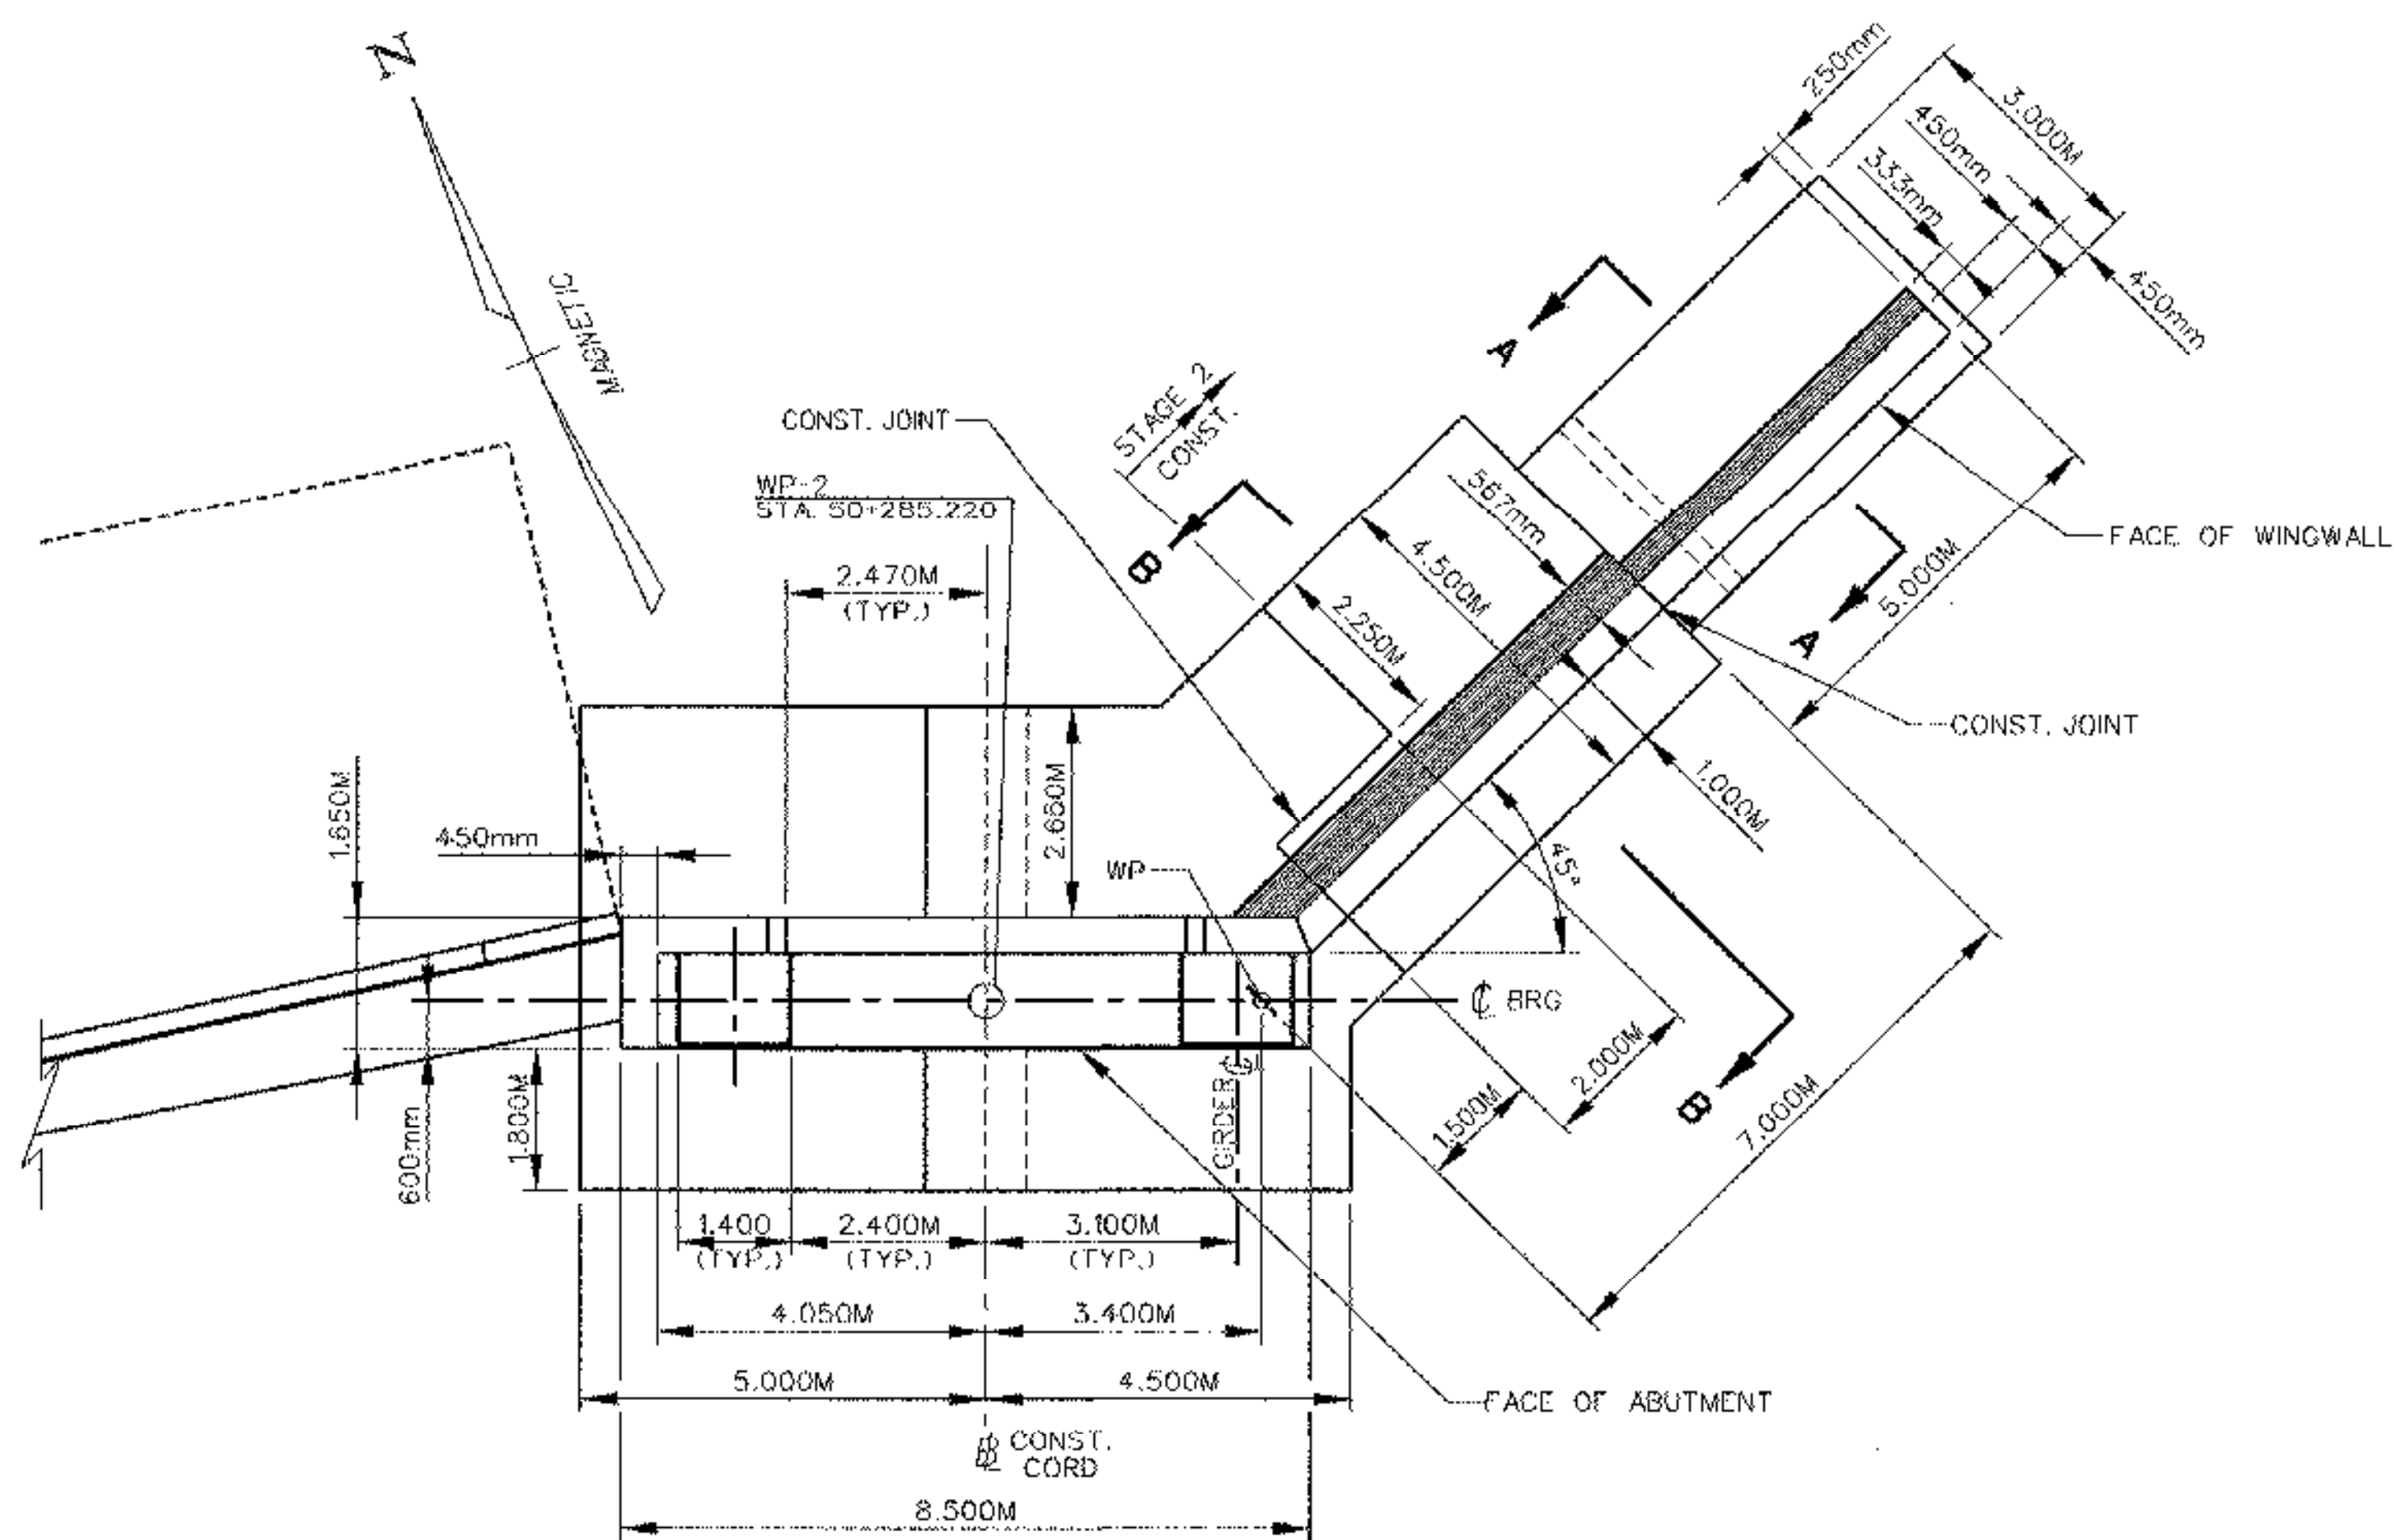


NORTH ABUTMENT PLAN
SCALE 1:75

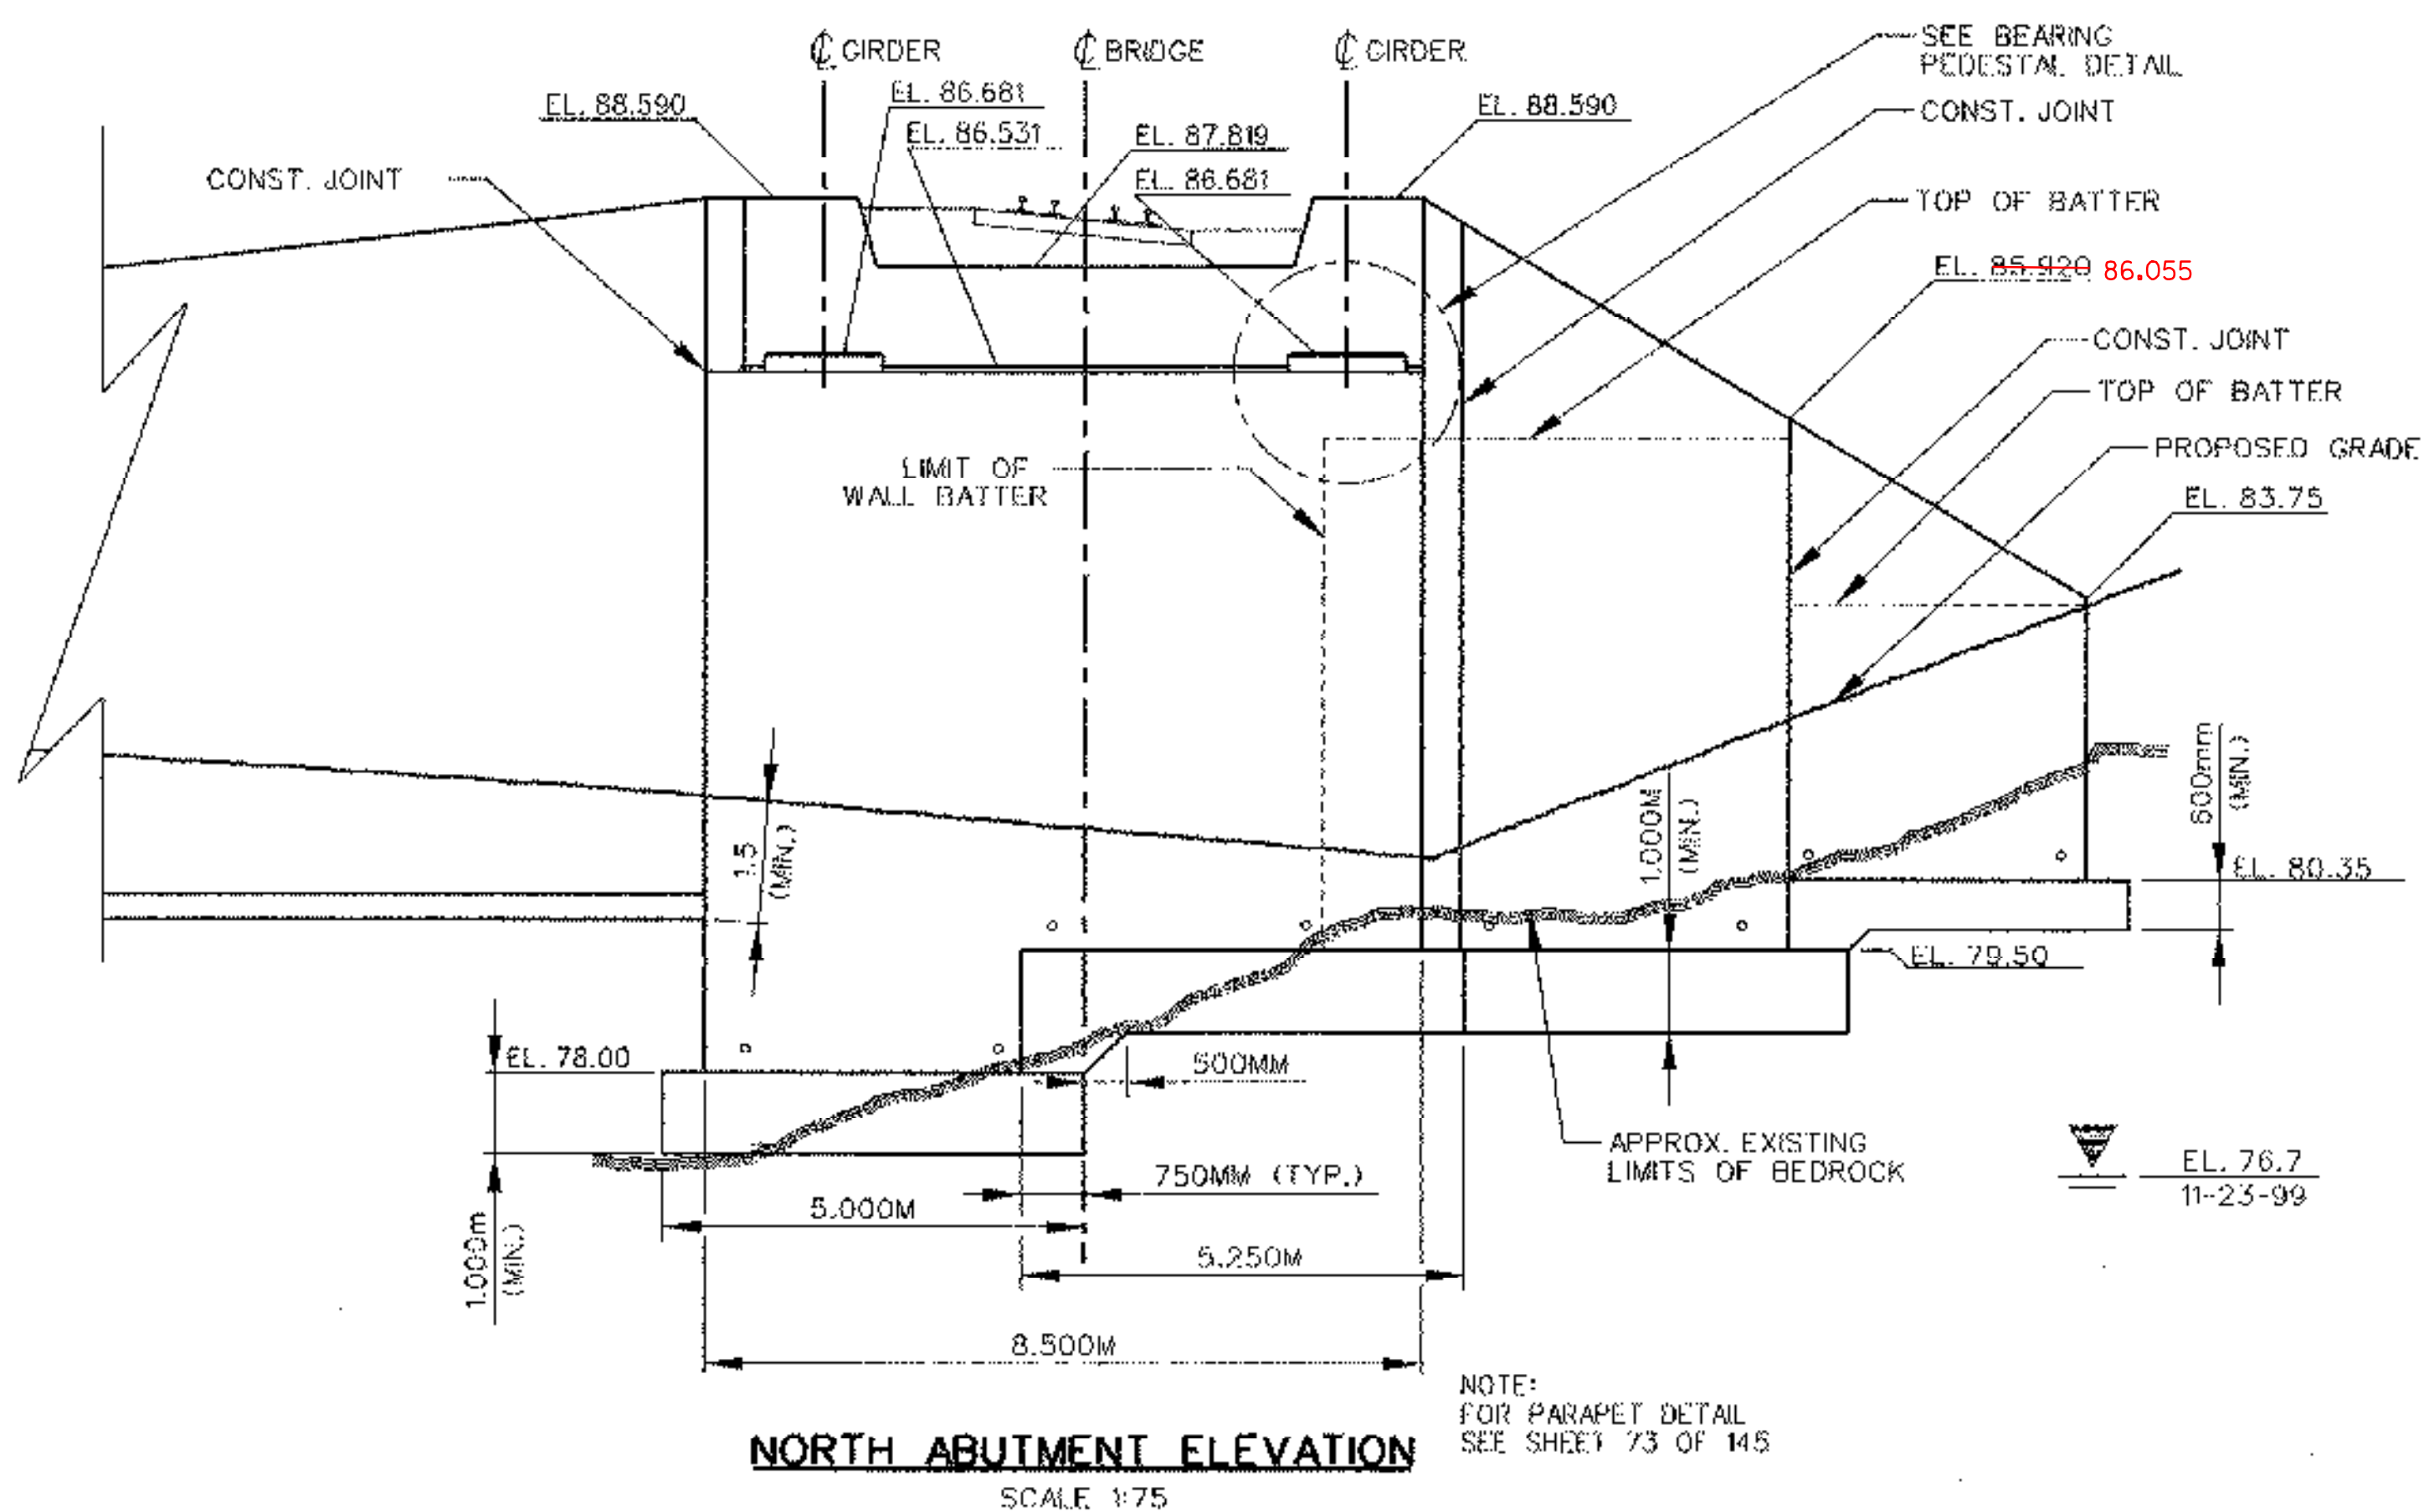


NORTH ABUTMENT ELEVATION
SCALE 1:75

NOTE:
FOR PARAPET DETAIL
SEE SHEET 73 OF 145

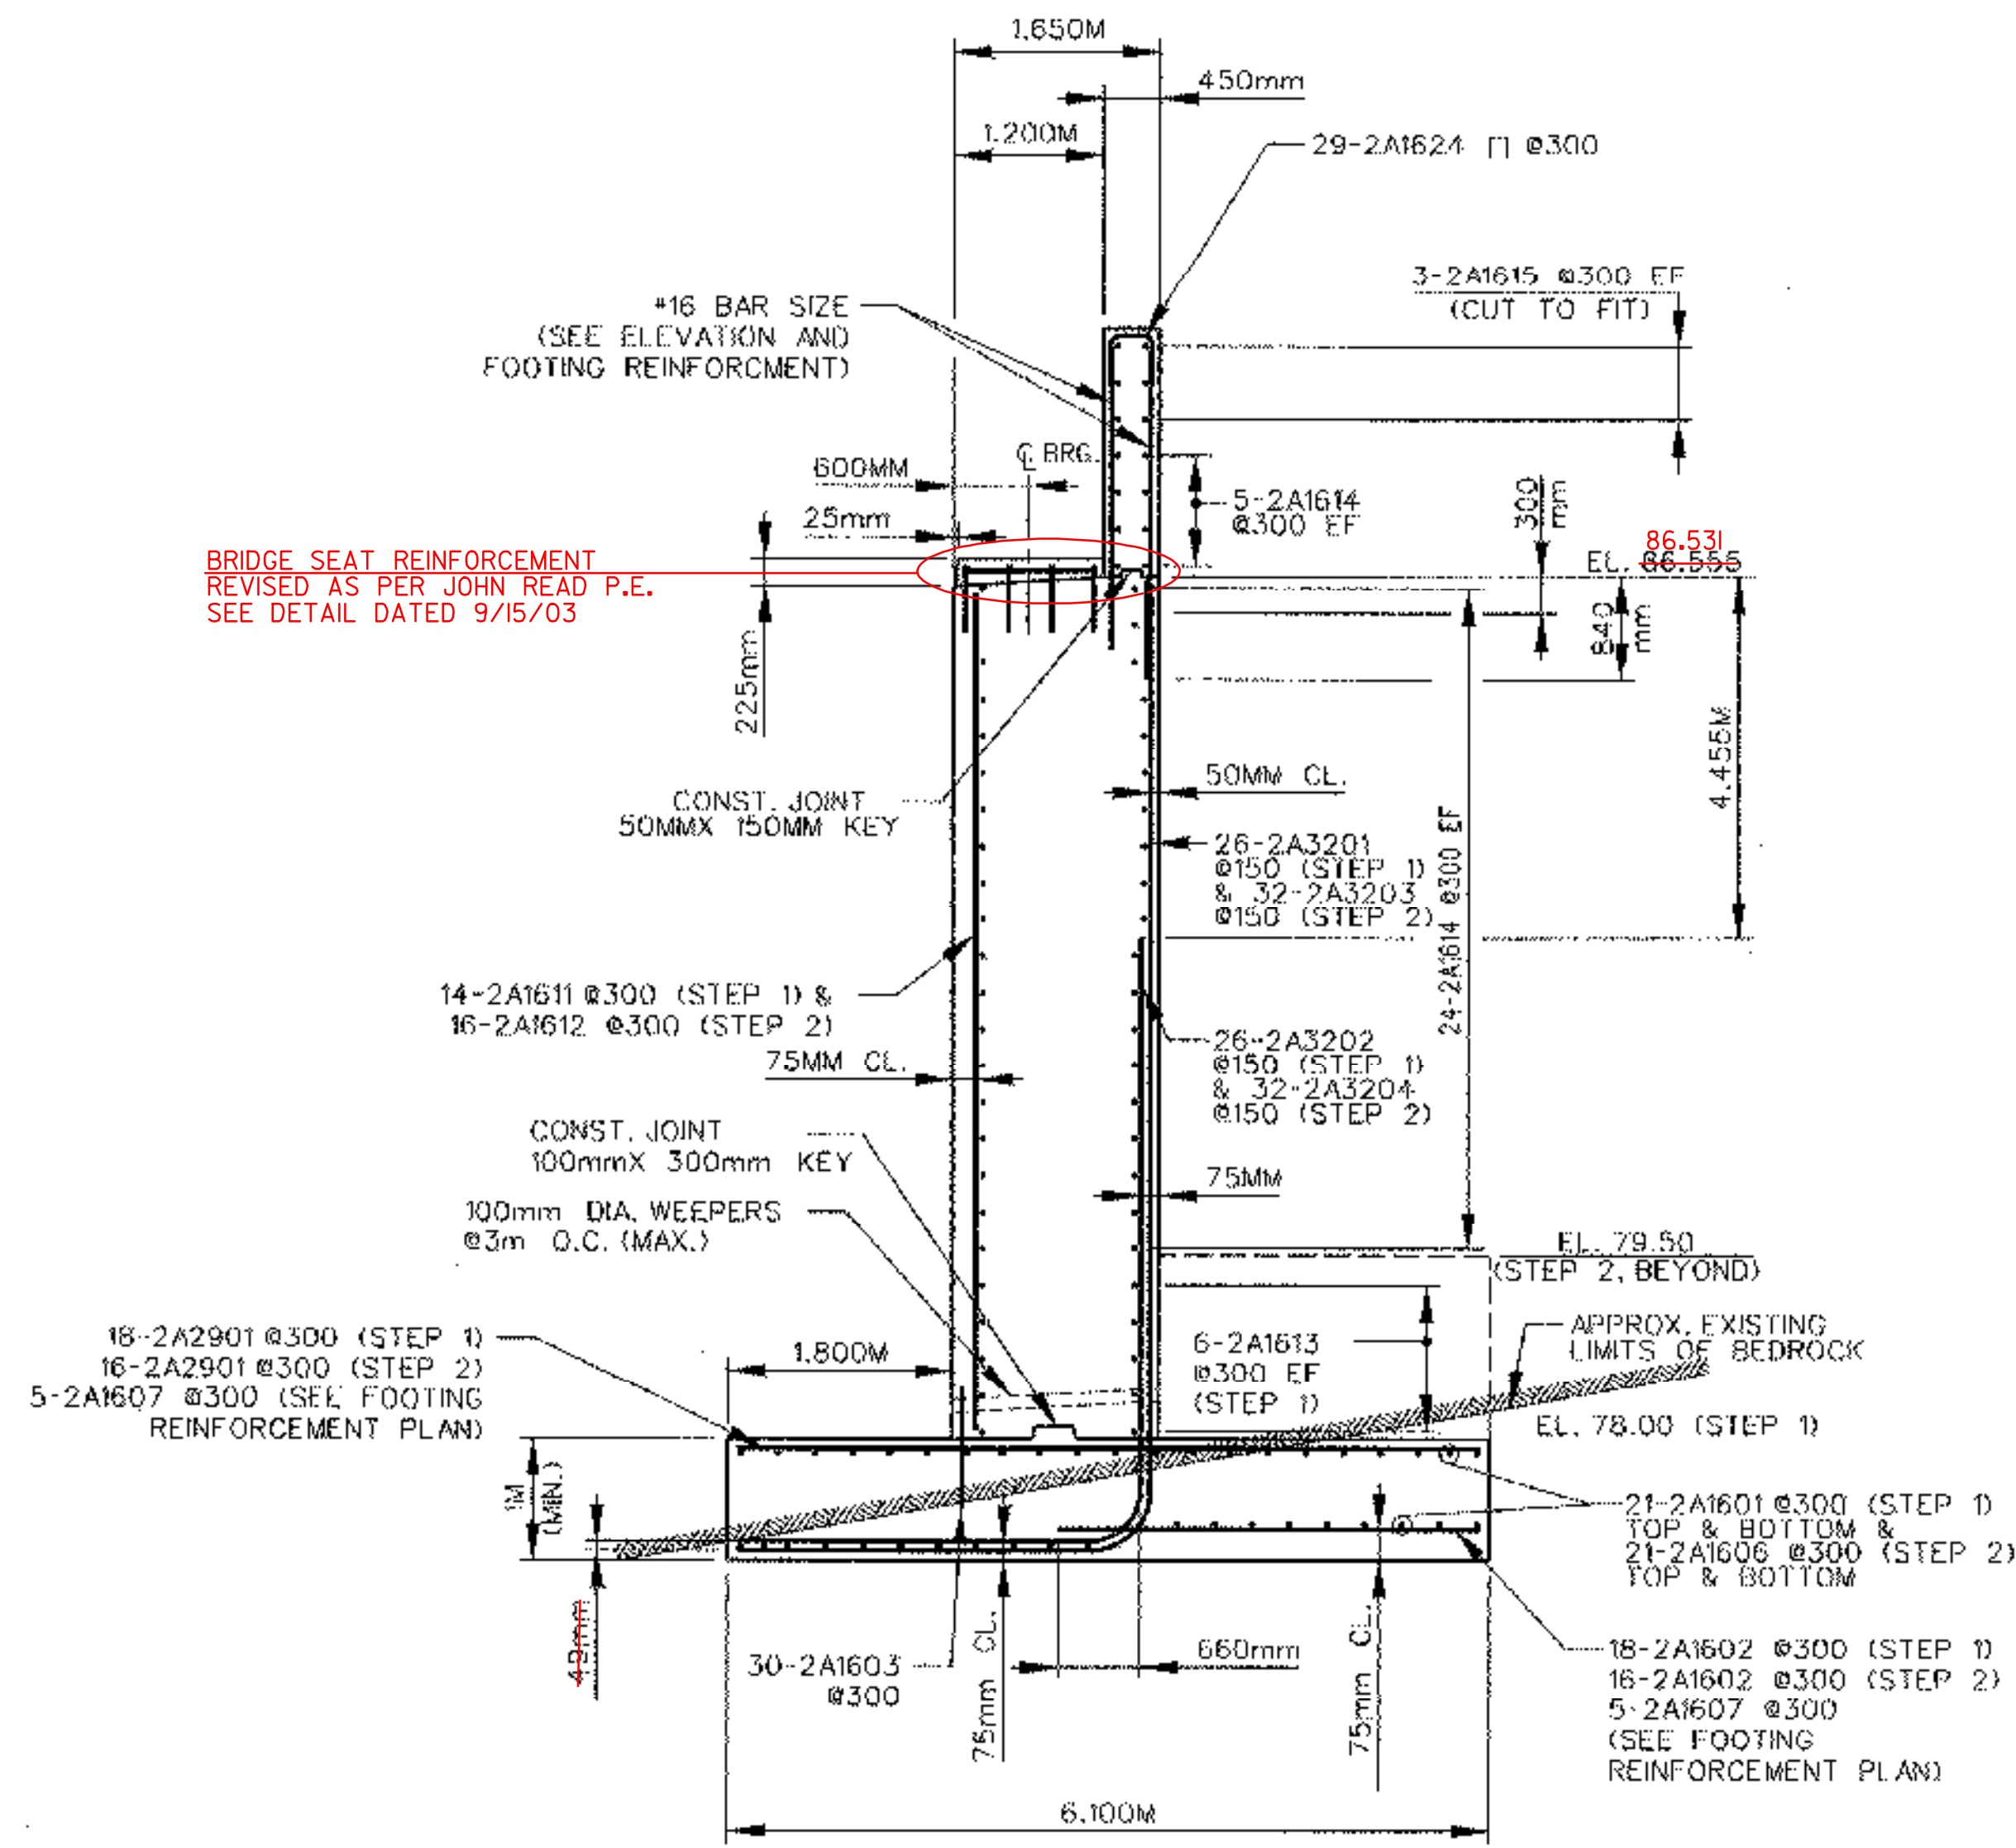


TYPICAL NORTH ABUTMENT SECTION
SCALE 1:50

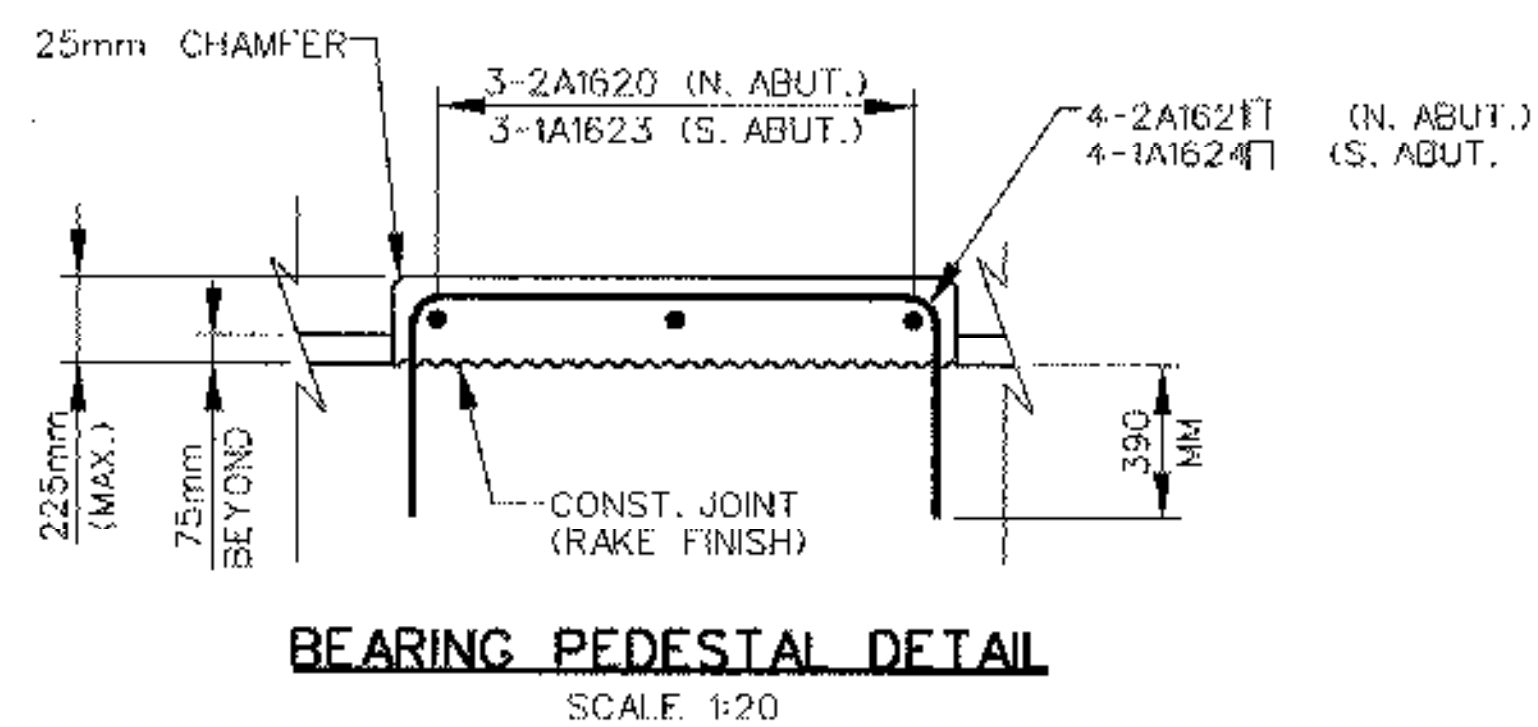


BEARING PEDESTAL DETAIL
SCALE 1:20


STATE OF VERMONT	
AGENCY OF TRANSPORTATION	
Town Of	BRATTLEBORO
Bridge No.	62.56
Highway No.	VT. ROUTE 9
Log Sta.	
Surv. Sta.	
ROUTE 9 BRIDGE	
NORTH ABUTMENT PLAN, ELEVATION & SECTIONS	
Designed By	LM
Drawn By	DHL/LRD
Checked By	GJB Date
Bridge Design Supervisor	JHR Date
PROJECT	BRATTLEBORO
PROJECT NO.	NH 010-2(2)
I.G.C. Info.	
Bridge Sheet No. 9	Sheet 77 of 145

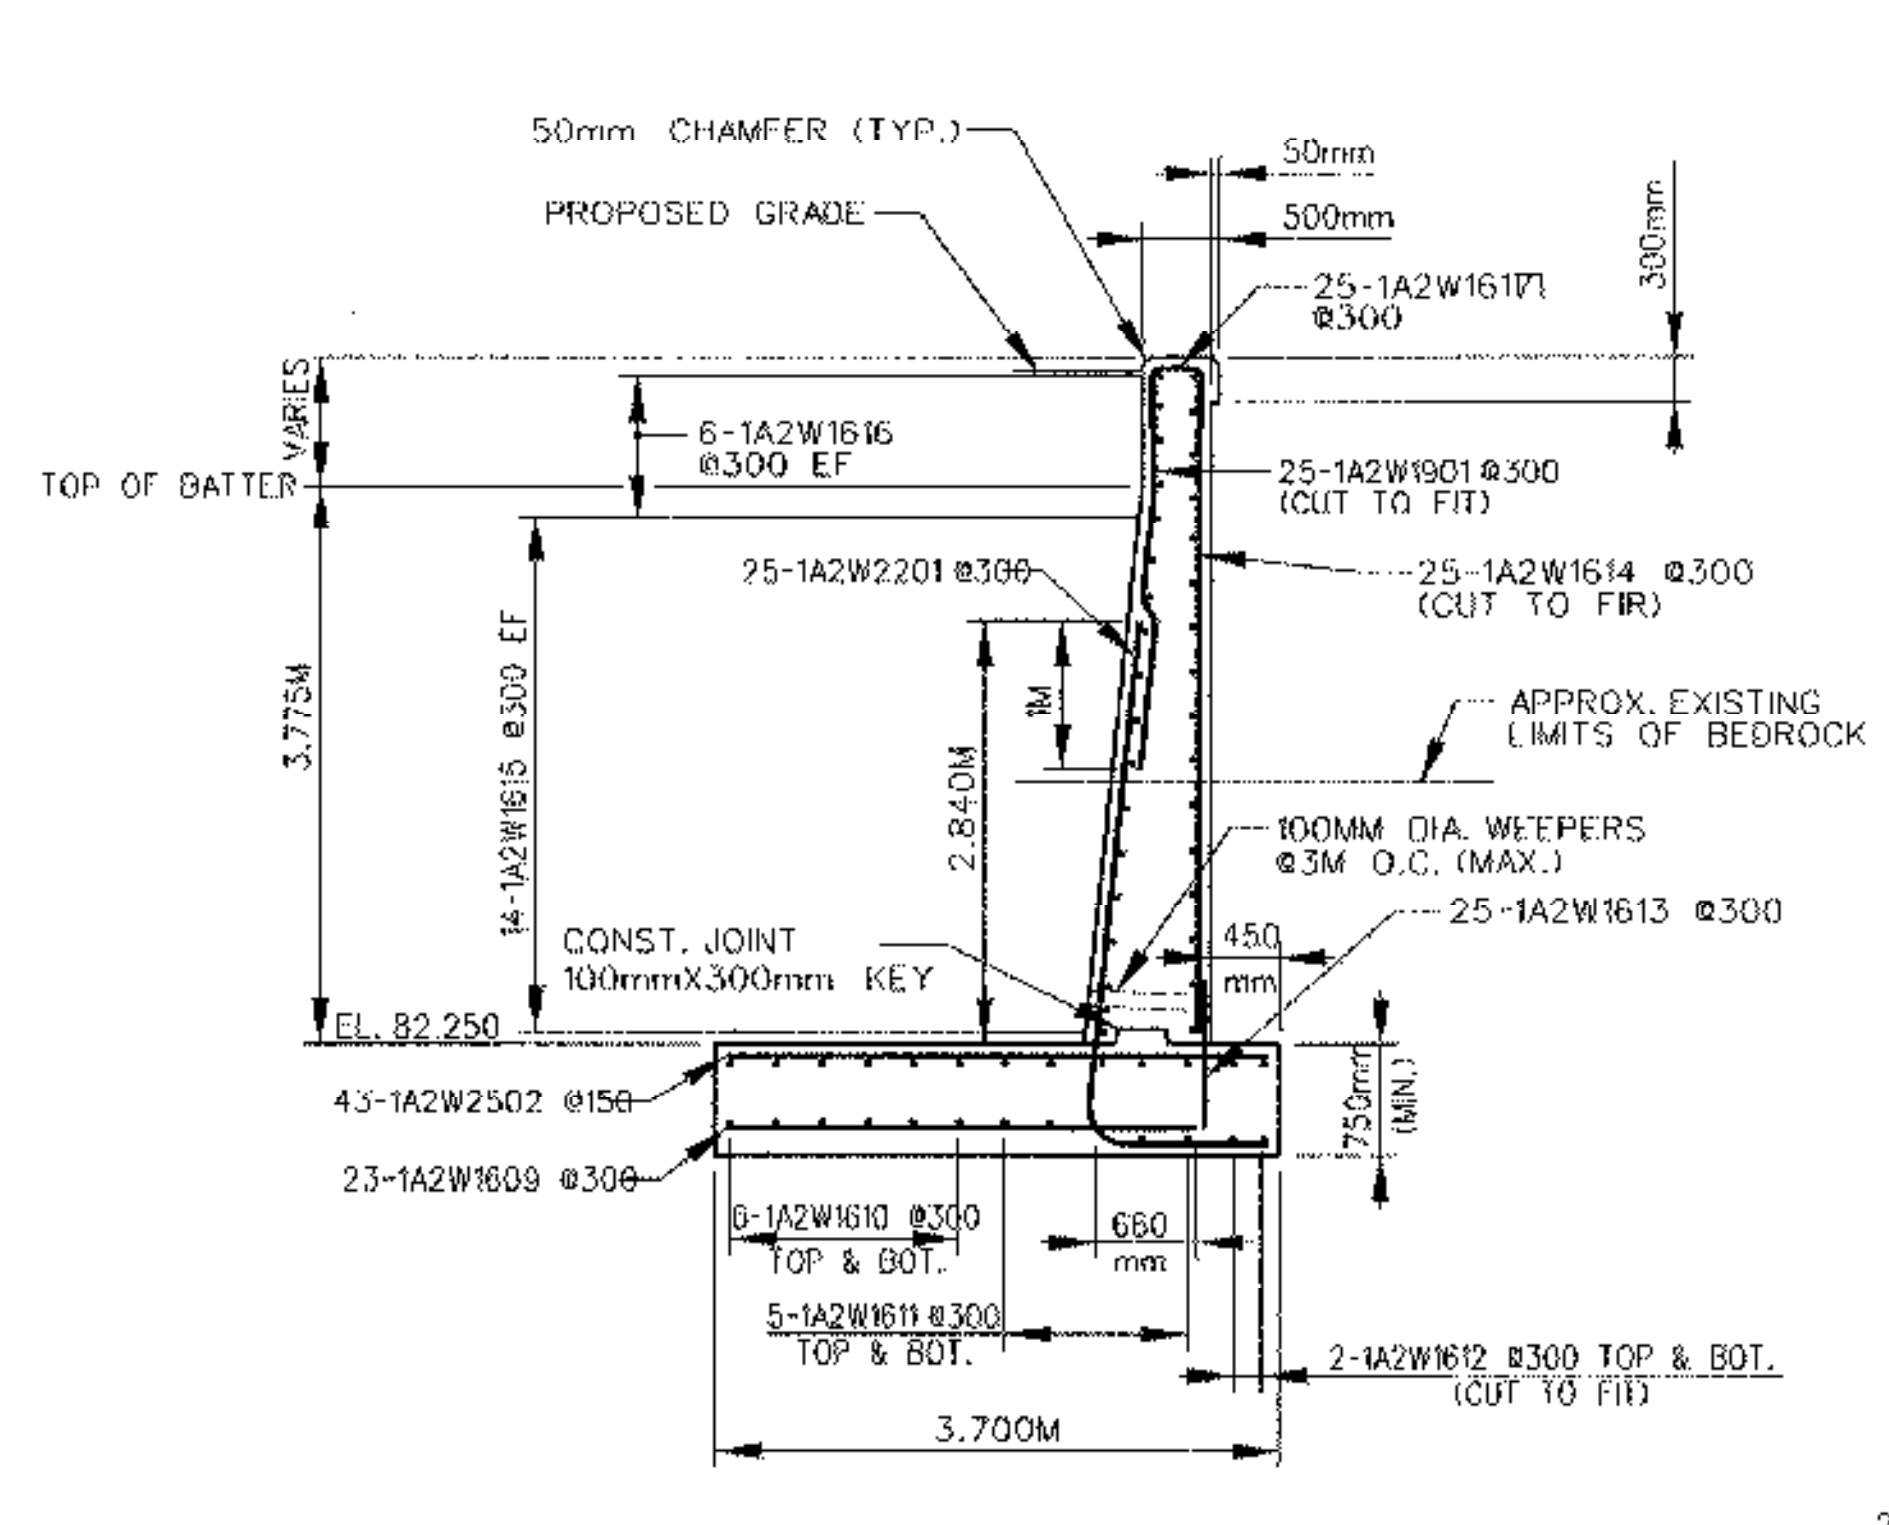


TYPICAL SOUTHEAST WINGWALL SECTION C-C
SCALE 1:50

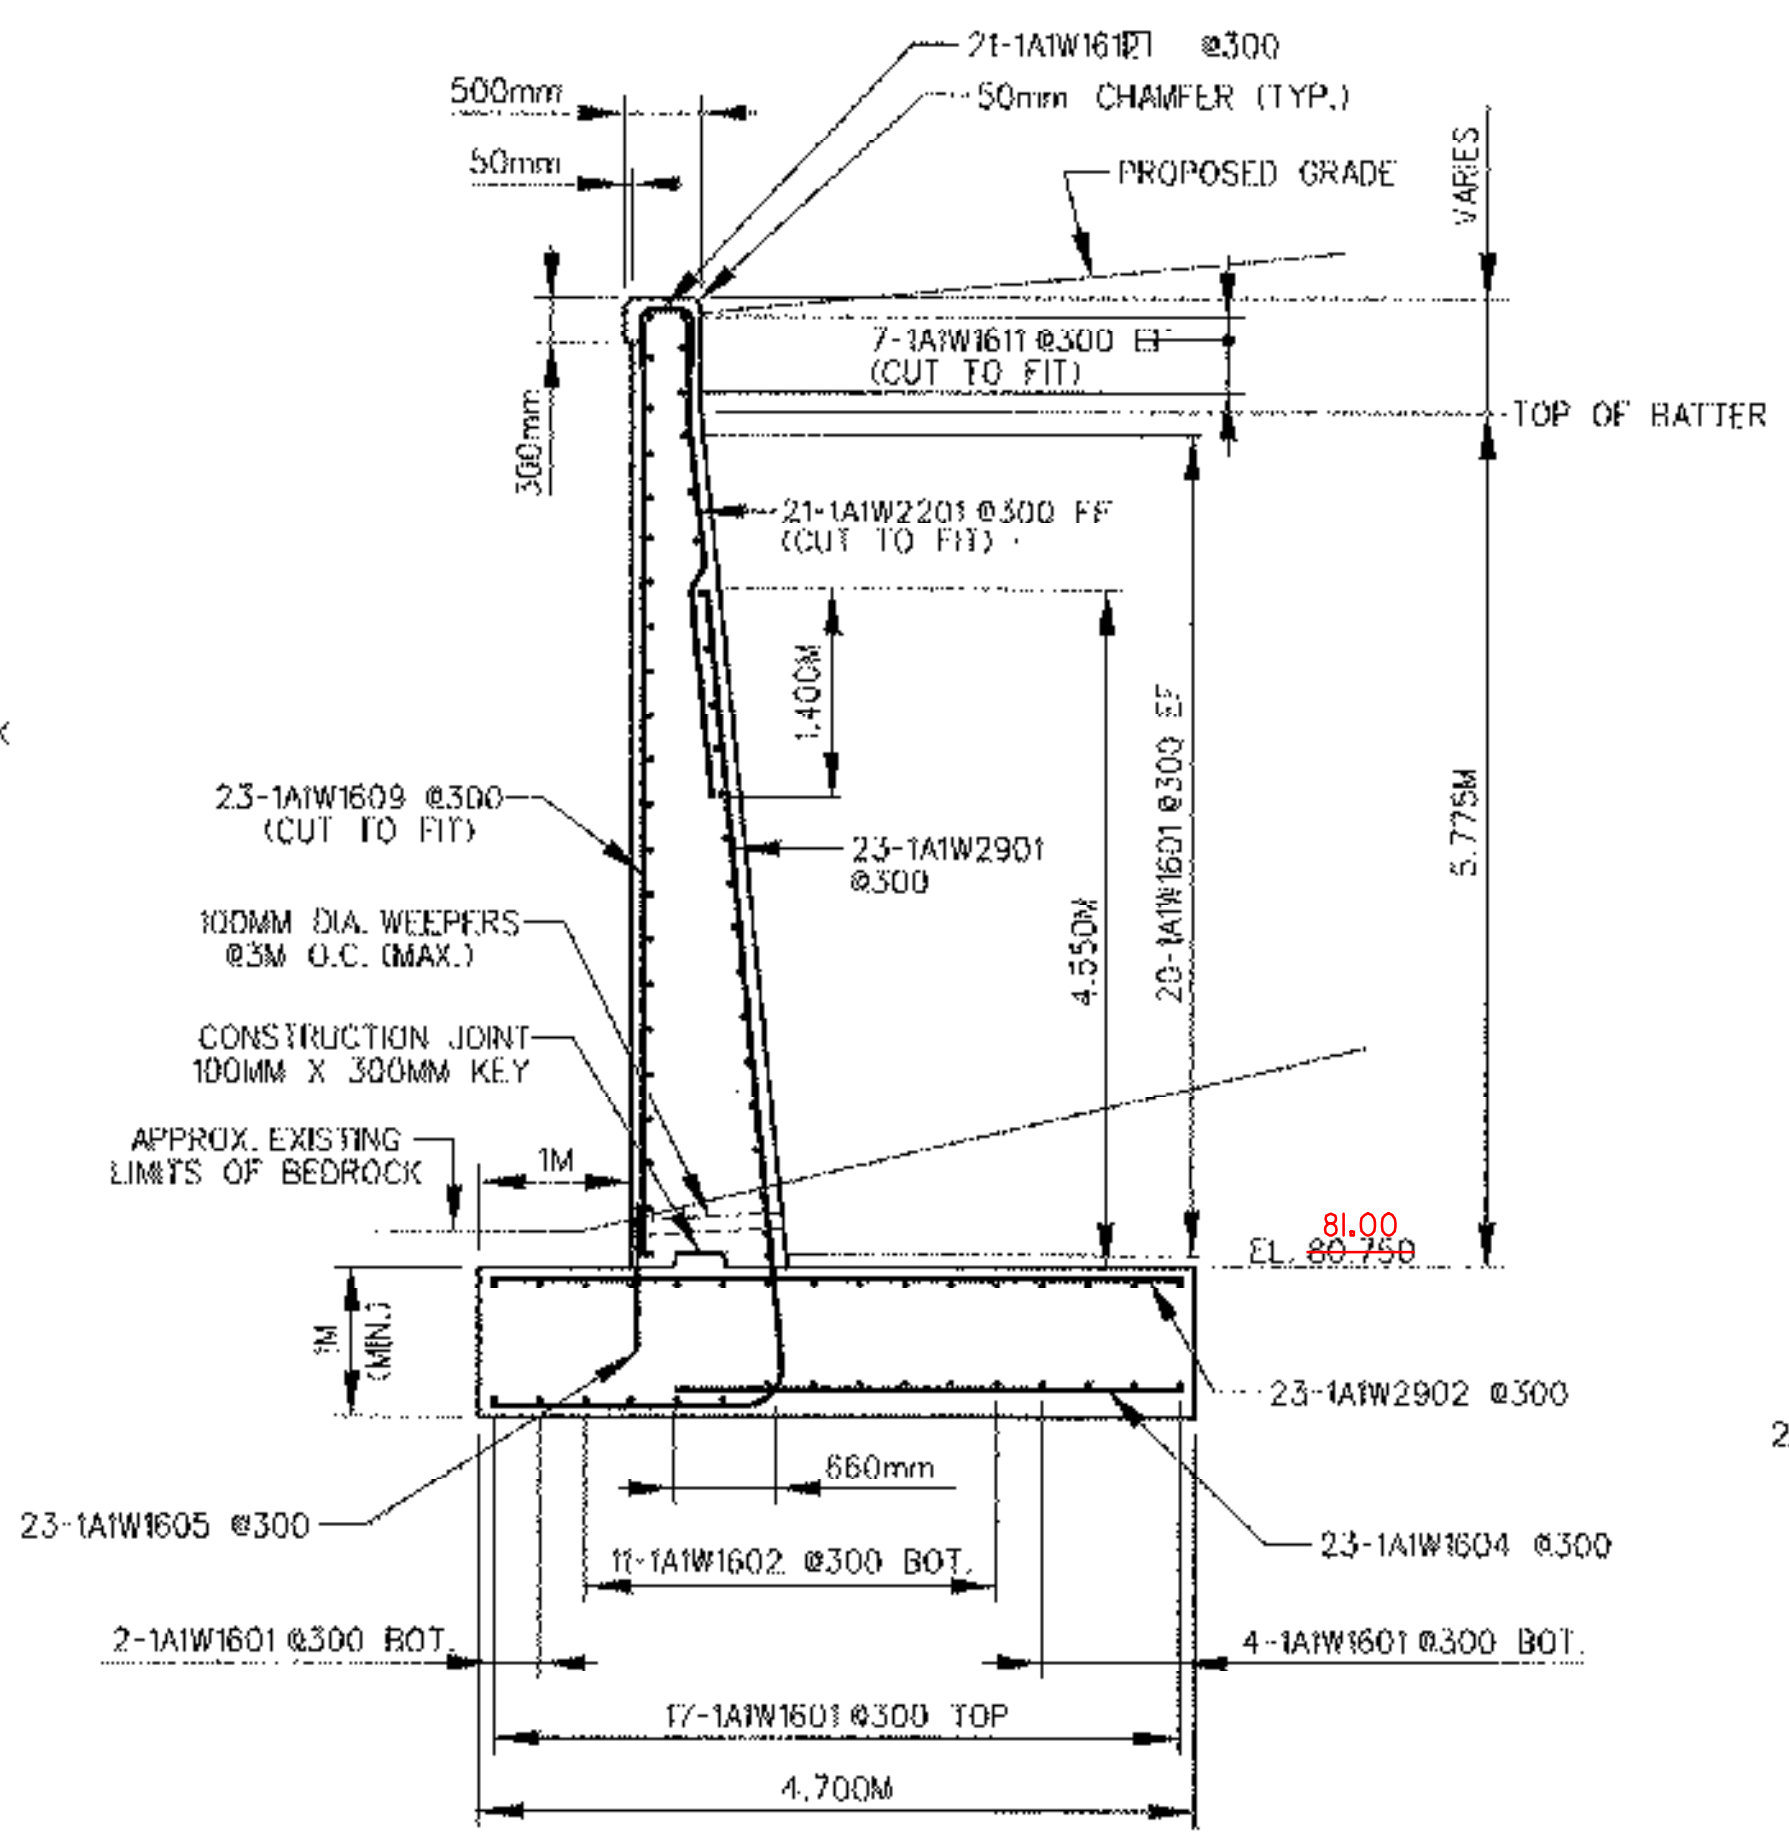


TYPICAL SOUTHWEST WINGWALL SECTION B-B
SCALE 1:50

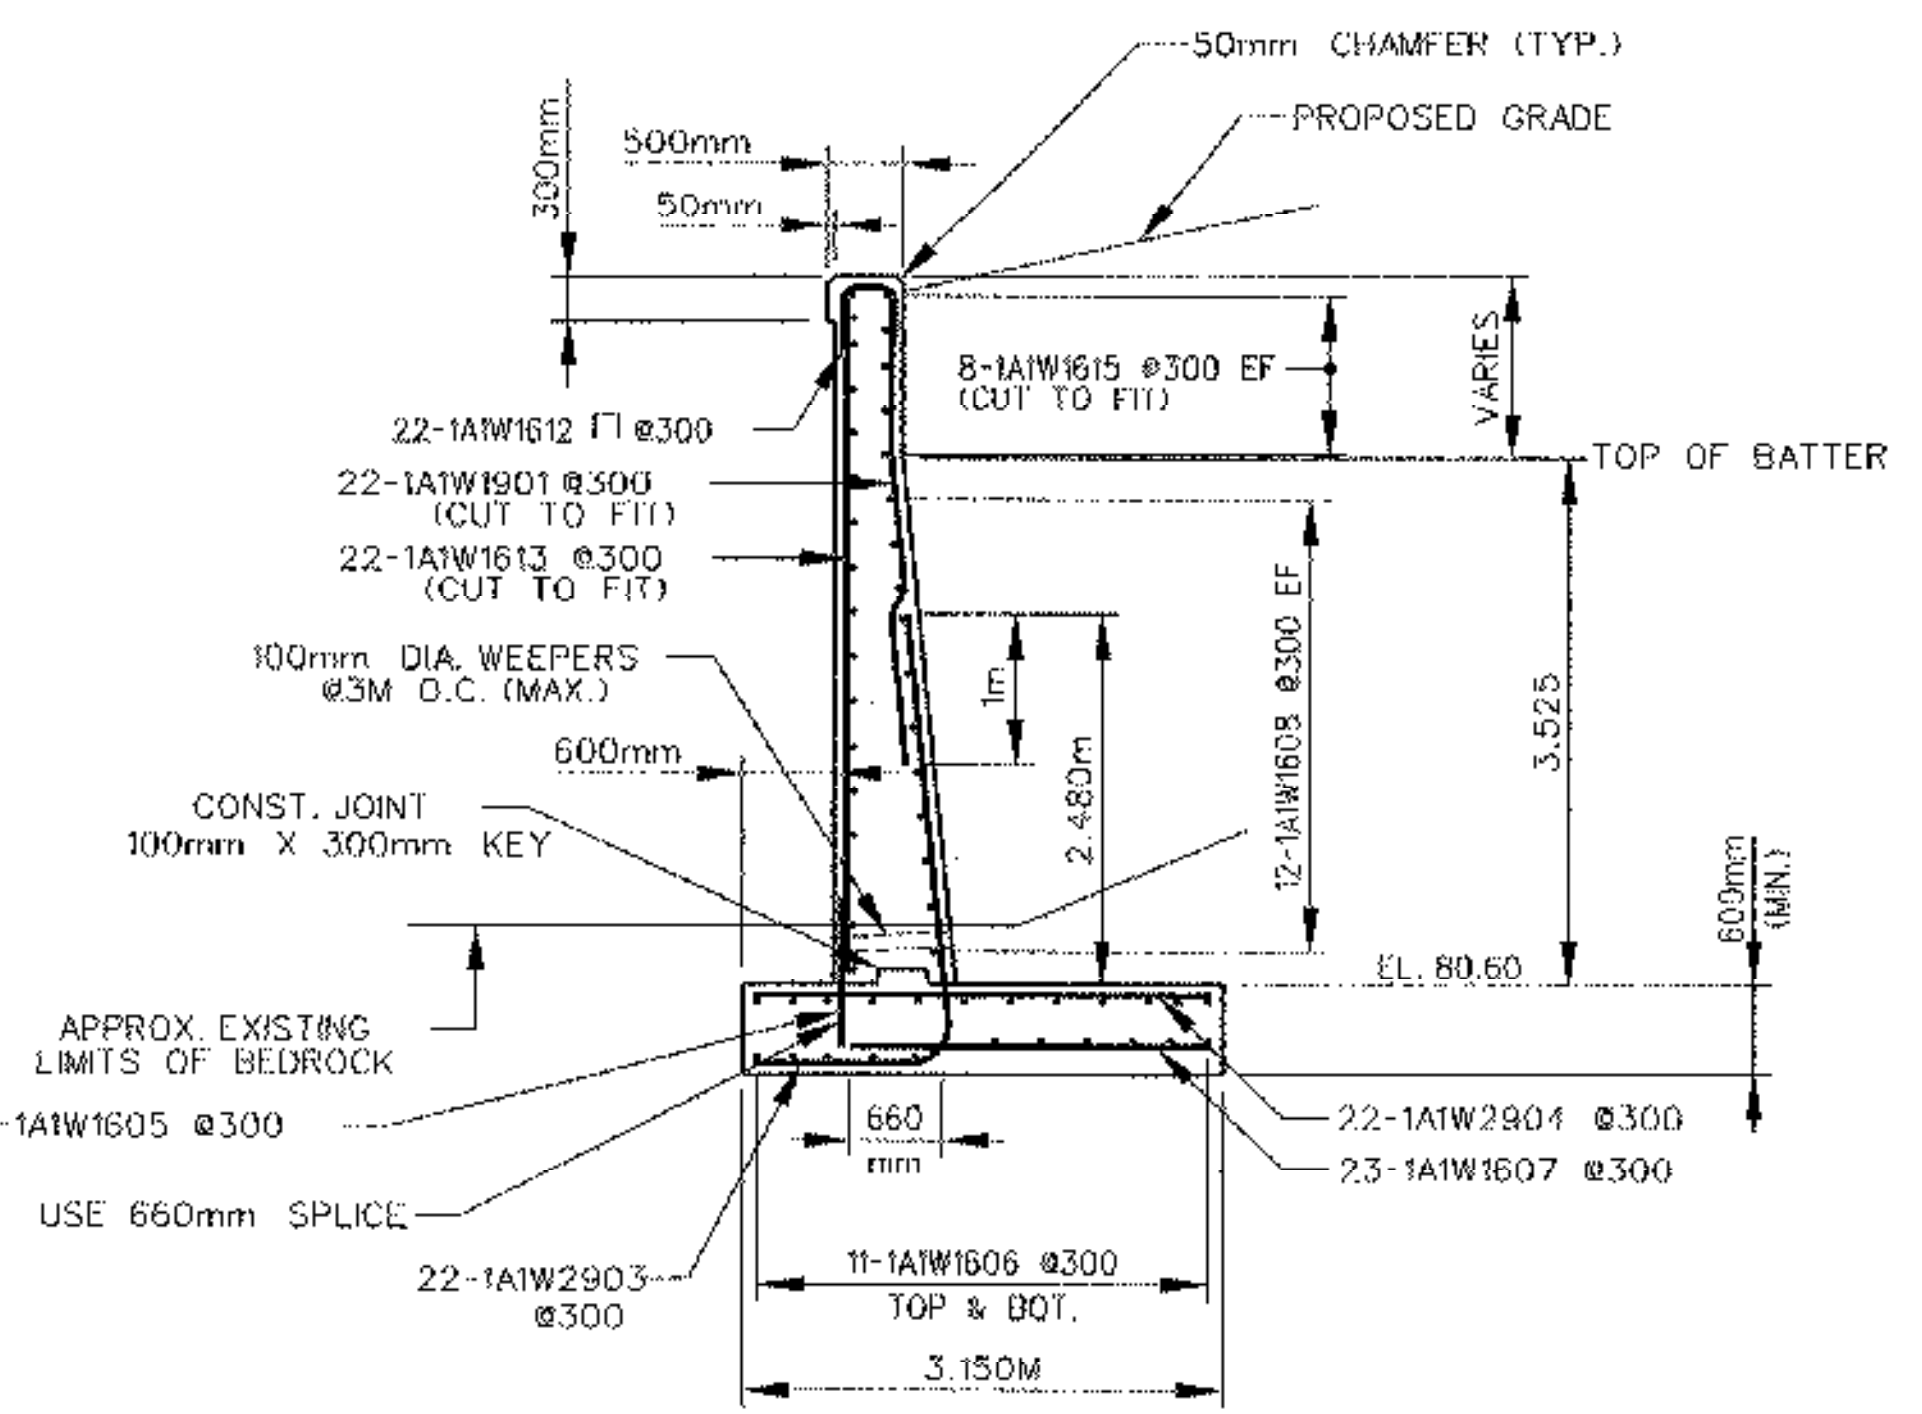

TYPICAL SOUTHWEST WINGWALL SECTION A-A
SCALE 1:50

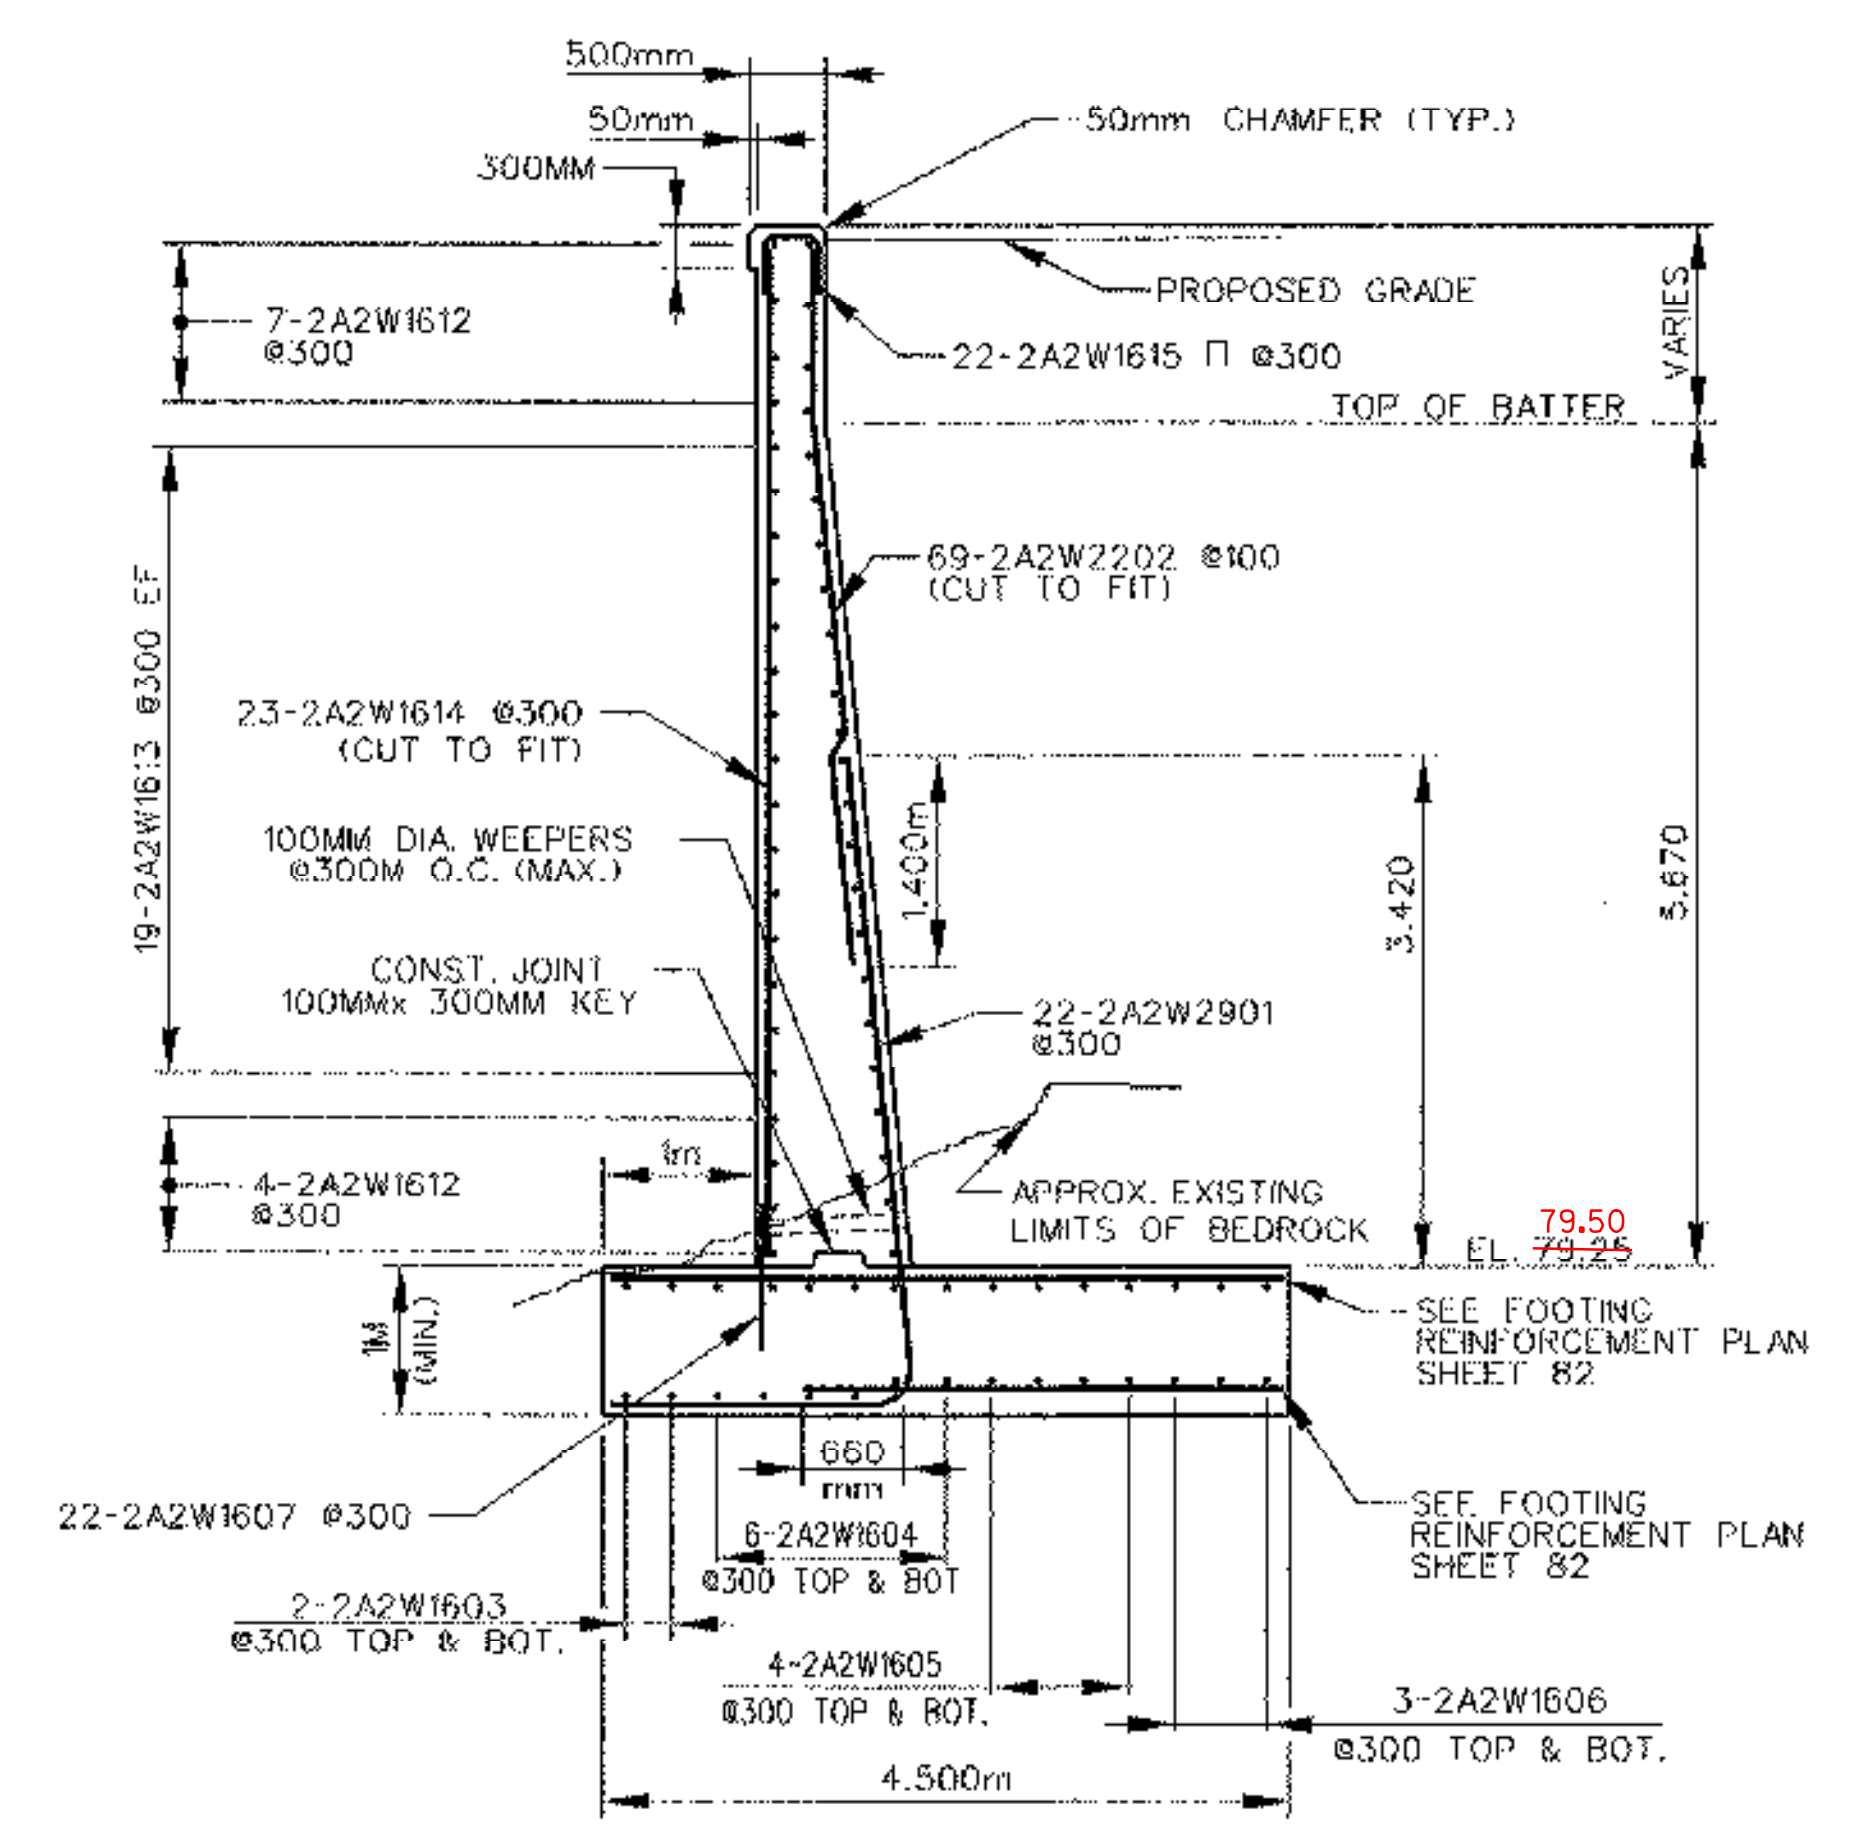


TYPICAL NORTHEAST WINGWALL SECTION B-B
SCALE 1:50

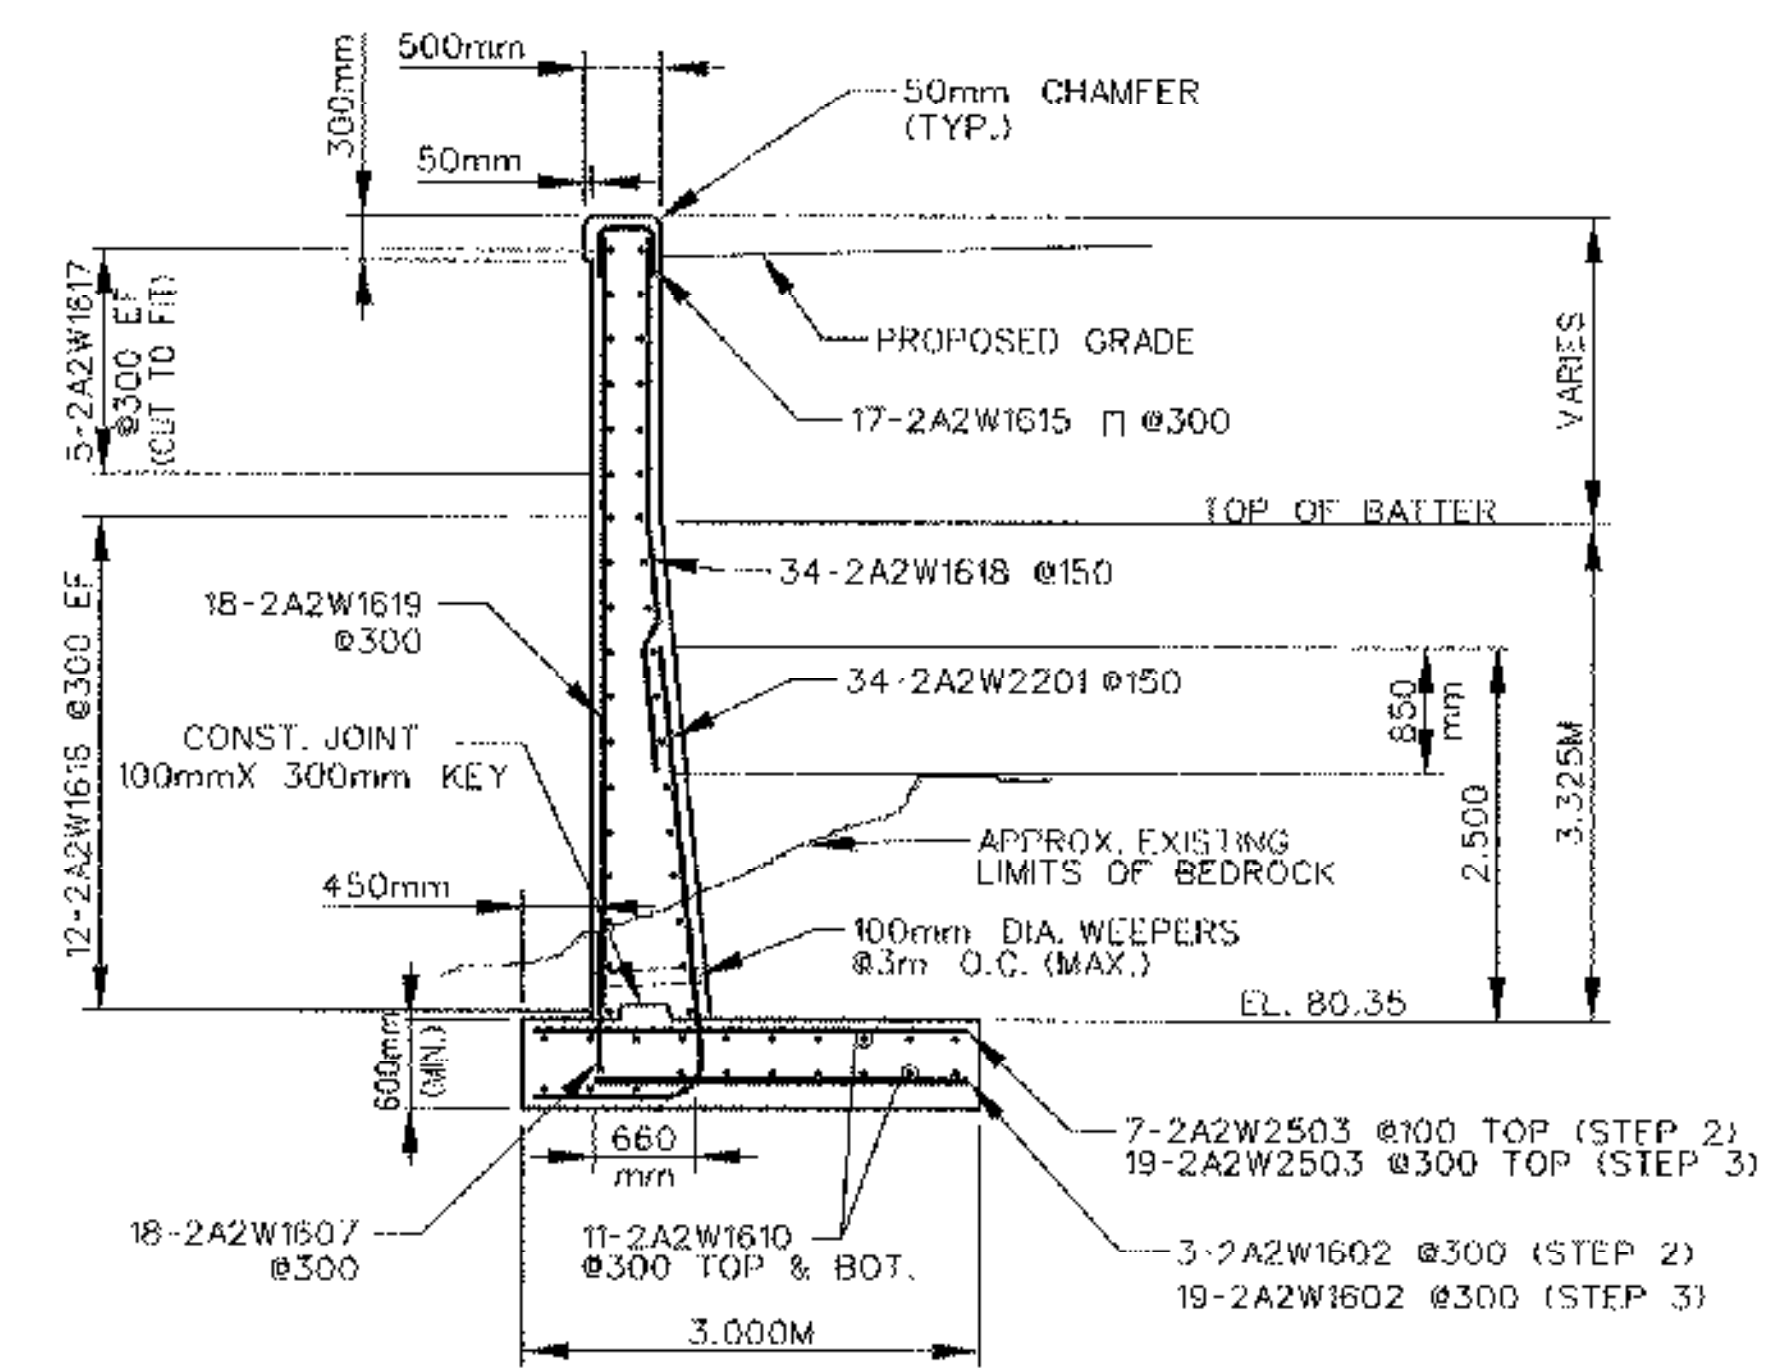

TYPICAL NORTHEAST WINGWALL SECTION A-A
SCALE 1:50


STATE OF VERMONT AGENCY OF TRANSPORTATION

Town Of	BRATTLEBORO	Bridge No.	62.56
Highway No.	VT. ROUTE 9	Log Sta.	
		Surv. Sta.	
ROUTE 9 BRIDGE			
CONCRETE WINGWALL SECTIONS			
Designed By	TTTT	Drawn By	DHL
Checked By	GJB	Bridge Design Supervisor	JHR
		Date	
PROJECT	BRATTLEBORO	PROJECT NO.	NH 010-2(2)
I.G.C. info.			
Bridge Sheet No. 10		Sheet 78	of 145

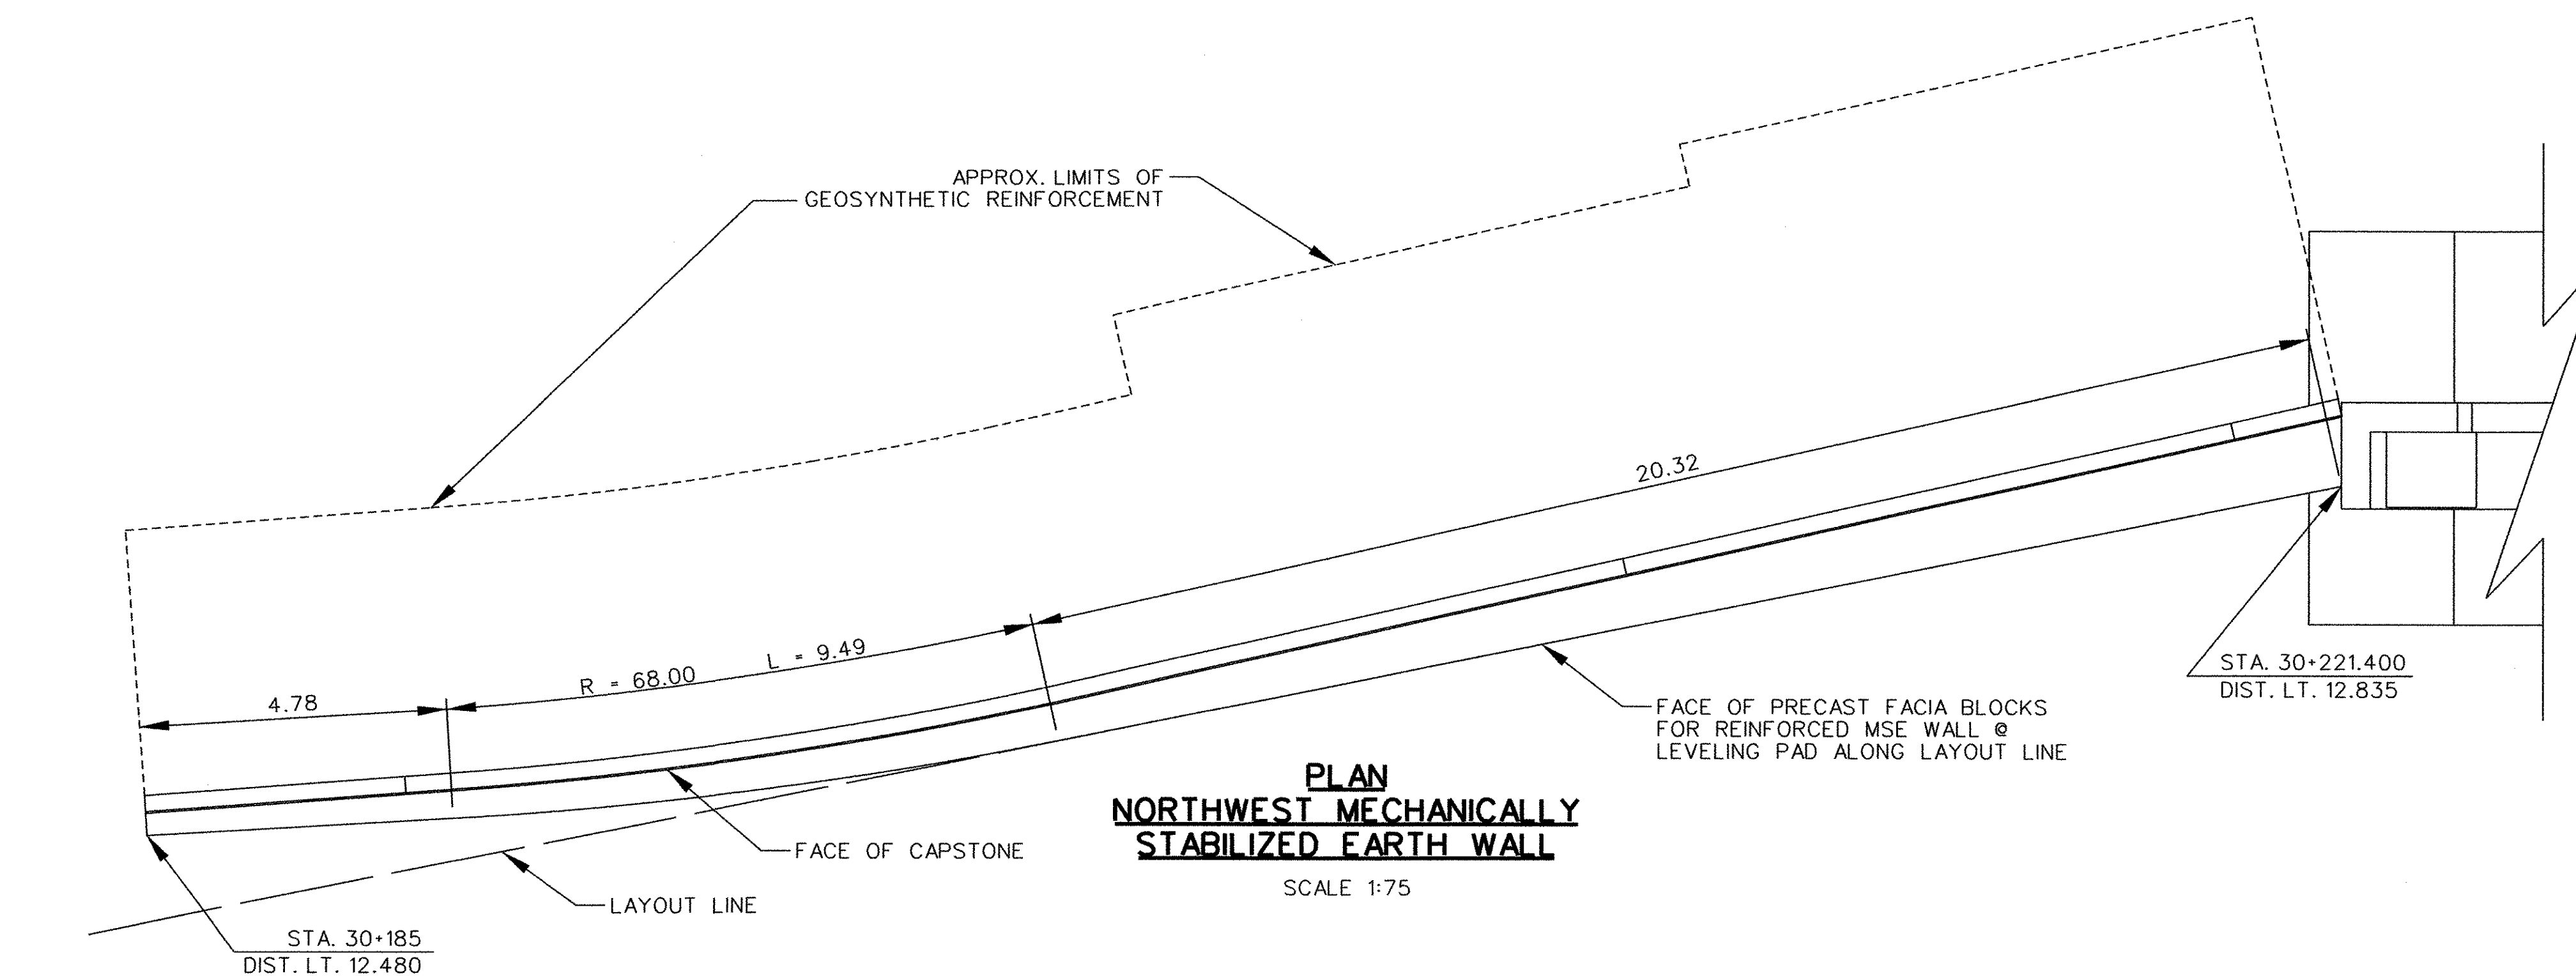

**PLAN
NORTHWEST MECHANICALLY
STABILIZED EARTH WALL**

SCALE 1:75

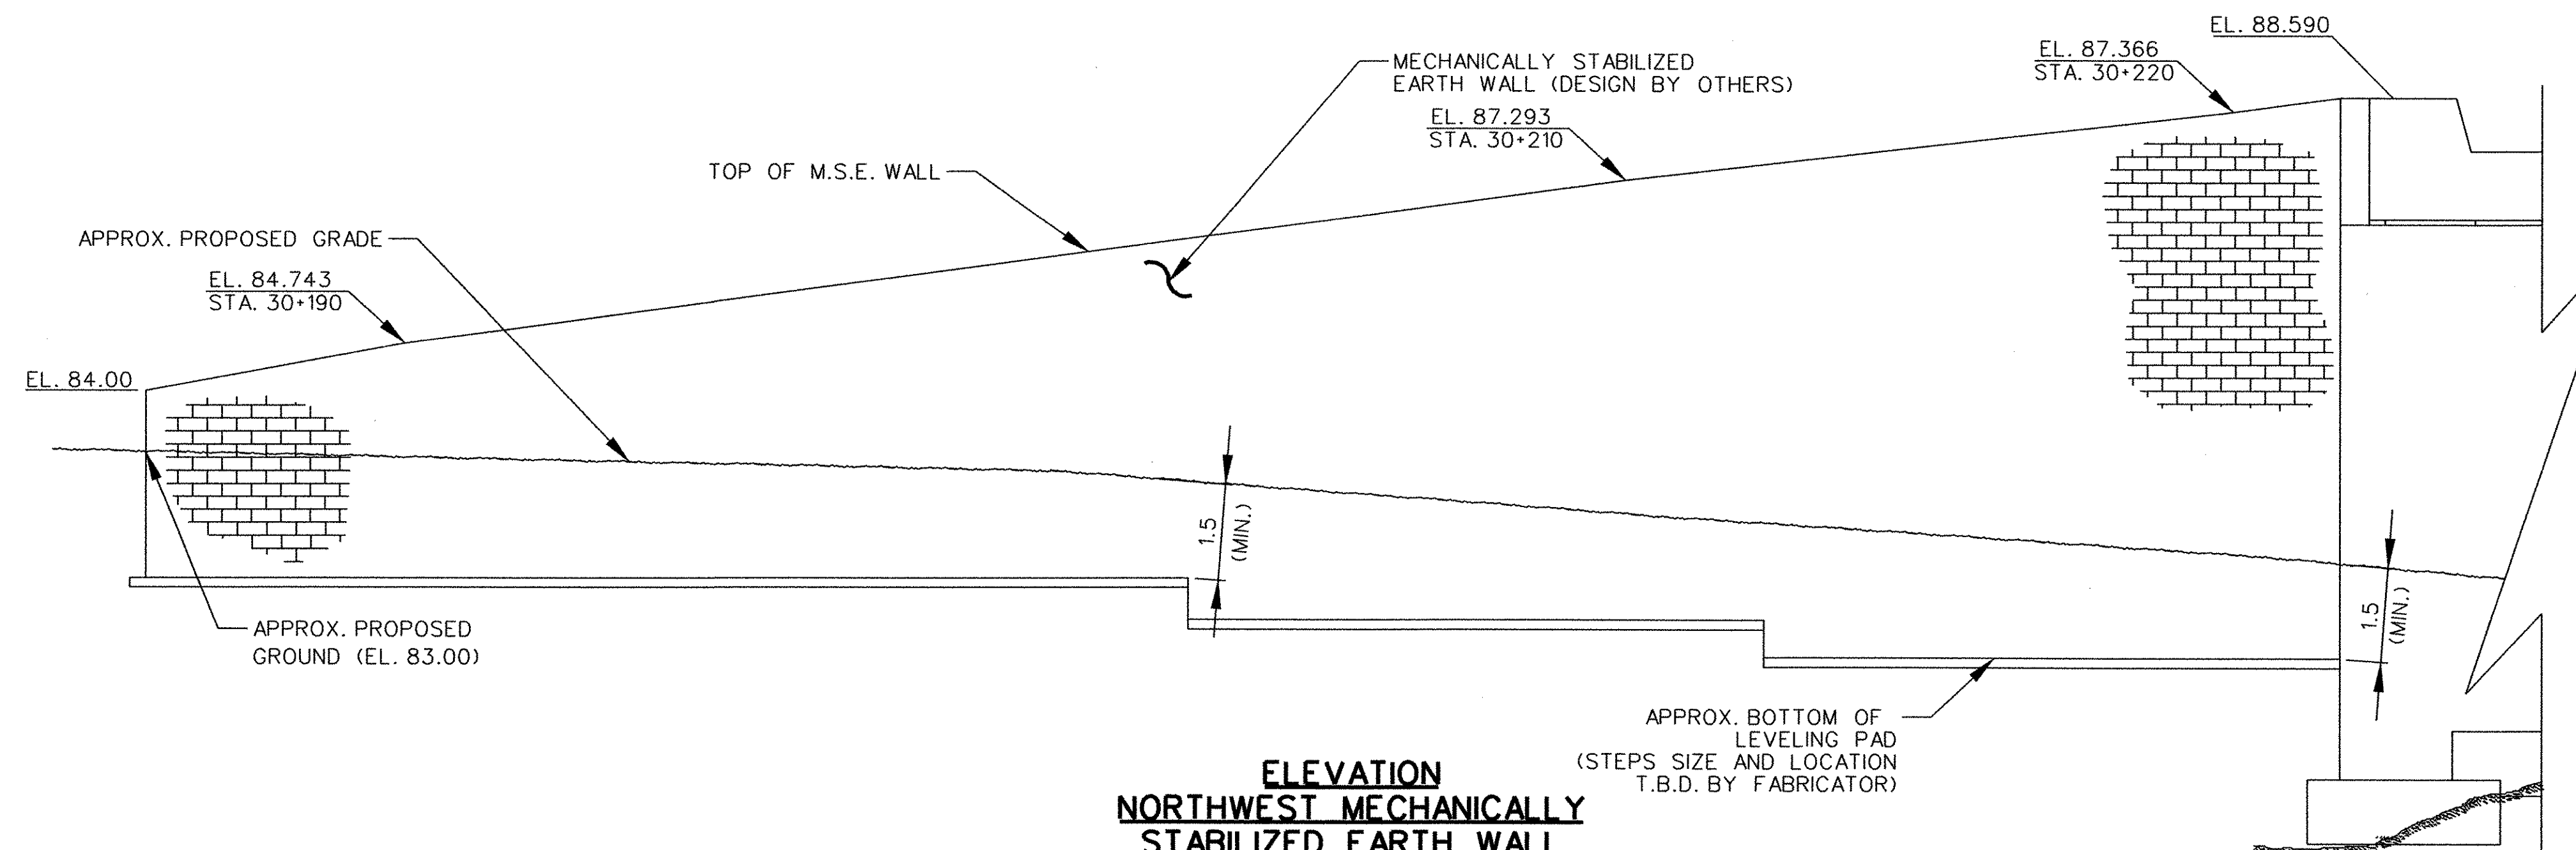

**ELEVATION
NORTHWEST MECHANICALLY
STABILIZED EARTH WALL**

SCALE 1:75

NOTE:
FOR MECHANICALLY STABILIZED EARTH (MSE)
WALL DESIGN SEE SHEETS 138 TO 144 OF 145.

STATE OF VERMONT AGENCY OF TRANSPORTATION			
Town Of	BRATTLEBORO	Bridge No.	62.56
Highway No.	VT. ROUTE 9	Log Sto.	
		Surv. Sto.	
ROUTE 9 BRIDGE			
NORTHWEST M.S.E. WALL PLAN & ELEVATION			
Designed By		Drawn By	DHL
Checked By	GJB Date	Bridge Design Supervisor	JHR Date
PROJECT	BRATTLEBORO	PROJECT NO.	NH BRF 012-1(33)
I.G.C. Info.			
Bridge Sheet No. 11			Sheet 79 of 145

Plot Date: 10-02-2002
File: rt9br160

FENCE SPECIFICATIONS

1. MATERIALS

A. PICKETS SHALL BE MADE OF HOT-ROLLED STRUCTURAL STEEL. THE WALL THICKNESS SHALL BE 1.6 mm. TUBE SHALL BE HOT-DIPPED GALVANIZED PER AASHTO M111. SPACE BETWEEN PICKETS SHALL BE 100 FACE TO FACE.

SIZE	WALL THICKNESS	WGT. PER m	TENSILE STRENGTH
25 mm ²	1.6 mm	0.94 kg	3 140 kg/cm ²

B. RAILS SHALL BE MADE OF HOT ROLLED STRUCTURAL STEEL, ROLLED INTO "U" CHANNEL MEASURING 35 WIDE X 38 DEEP X 3 WALL THICKNESS. RAILS SHALL BE MANUFACTURED PER AASHTO M183 AND HOT-DIPPED GALVANIZED PER AASHTO M111.

C. POSTS SHALL BE MADE OF HOT ROLLED STRUCTURAL STEEL. THE WALL THICKNESS SHALL BE 2 mm. TUBE SHALL BE MANUFACTURED PER AASHTO M183. TUBE SHALL BE HOT-DIPPED GALVANIZED PER AASHTO M111.

SIZE	WALL THICKNESS	WGT. PER m	TENSILE STRENGTH
64 mm ²	2.0 mm	4.0 kg	3 140 kg/cm ²

D. RAIL ATTACHMENT BRACKETS SHALL BE CAST OF MALLEABLE IRON PER AASHTO M105 AND HOT-DIPPED GALVANIZED PER AASHTO M232.

2. ASSEMBLY

A. SECTIONS SHALL BE ASSEMBLED USING 2,3 OR 4 RAILS THAT ARE PUNCHED OUT TO INSERT PICKETS THROUGH THEM. PICKETS SHALL BE RIVETED TO RAILS USING A 6 mm INDUSTRIAL DRIVE RIVET.

B. RAILS ARE ATTACHED TO POSTS BY MEANS OF RAIL BRACKETS. RAIL BRACKETS SHALL BE ATTACHED TO POSTS USING A 6 mm BOLT AND LOCK NUT. BRACKETS SHALL BE ATTACHED TO RAILS USING A 6 mm INDUSTRIAL DRIVE RIVETS.

3. COATING

EVERY FENCE SHALL HAVE A GALVANIZED UNDERCOAT INSIDE AND OUTSIDE ALL MEMBERS TO ASSURE MAXIMUM CORROSION RESISTANCE. ALL FENCE COMPONENTS SHALL THEN BE GIVEN A 4 STAGE "POWER WASH" PRETREATMENT PROCESS THAT CLEANS AND PREPARES THE GALVANIZED SURFACE TO ASSURE COMPLETE ADHESION OF THE FINISH COAT.

STAGE 1 - ALL METAL SHALL BE CLEANED AND PHOSPHATE TREATED SIMULTANEOUSLY TO FORM A AMPORPHOUS STRUCTURE ON THE GALVANIZED SURFACE FOR SUPERIOR POWDER COATING ADHESION.

STAGE 2 - ALL METAL SHALL THEN BE GIVEN A THOROUGH WATER RINSE TO PREPARE THE PHOSPHATE COATED SURFACE FOR STAGE 3.

STAGE 3 - ALL METAL SHALL THEN BE GIVEN A NON-CHROMATED SEAL RINSE, WHICH WILL FURTHER IMPROVE THE CORROSION RESISTANCE.


STAGE 4 - ALL METAL SHALL THEN BE BAKED DRY, PRIOR TO THE POWDER COATING BEING APPLIED. ALL METAL SHALL THEN BE GIVEN A BLACK POLYESTER RESIN BASED POWDER COATING APPLIED BY A ELECTROSTATIC SPRAY PROCESS, TO A THICKNESS OF 0.06 mm. THE FINISH SHALL THEN BE BAKED IN A 232³/₄C OVEN FOR 20 MINUT

4. INSTALLATION


A. FENCE AND ACCESSORIES SHALL BE INSTALLED IN STRICT ACCORDANCE WITH THE PLANS AND SPECIFICATIONS IN A WORKMANLIKE MANNER.

B. LINE POSTS SHALL BE SPACED NO MORE THAN 2.4 m ON CENTER IN LINE OF THE FENCE. POSTS SHALL BE PLUMB WITH THE TOPS PROPERLY ALIGNED.


C. CONCRETE FOOTINGS
 1. DRILL HOLES IN FIRM, UNDISTURBED COMPACTED SOIL. FOOTINGS SHALL NOT BE LESS THAN 250 mm IN DIAMETER AND SHALL BE 150 mm DEEPER THAN THE POST BOTTOM.
 2. PLACE CONCRETE AROUND THE POST IN A CONTINUOUS POUR. TROWEL FINISH TOPS OF FOOTINGS AND SLOPE OR DOME TO DIRECT WATER AWAY FROM THE POSTS.
 3. CONCRETE SHALL BE CLASS C.

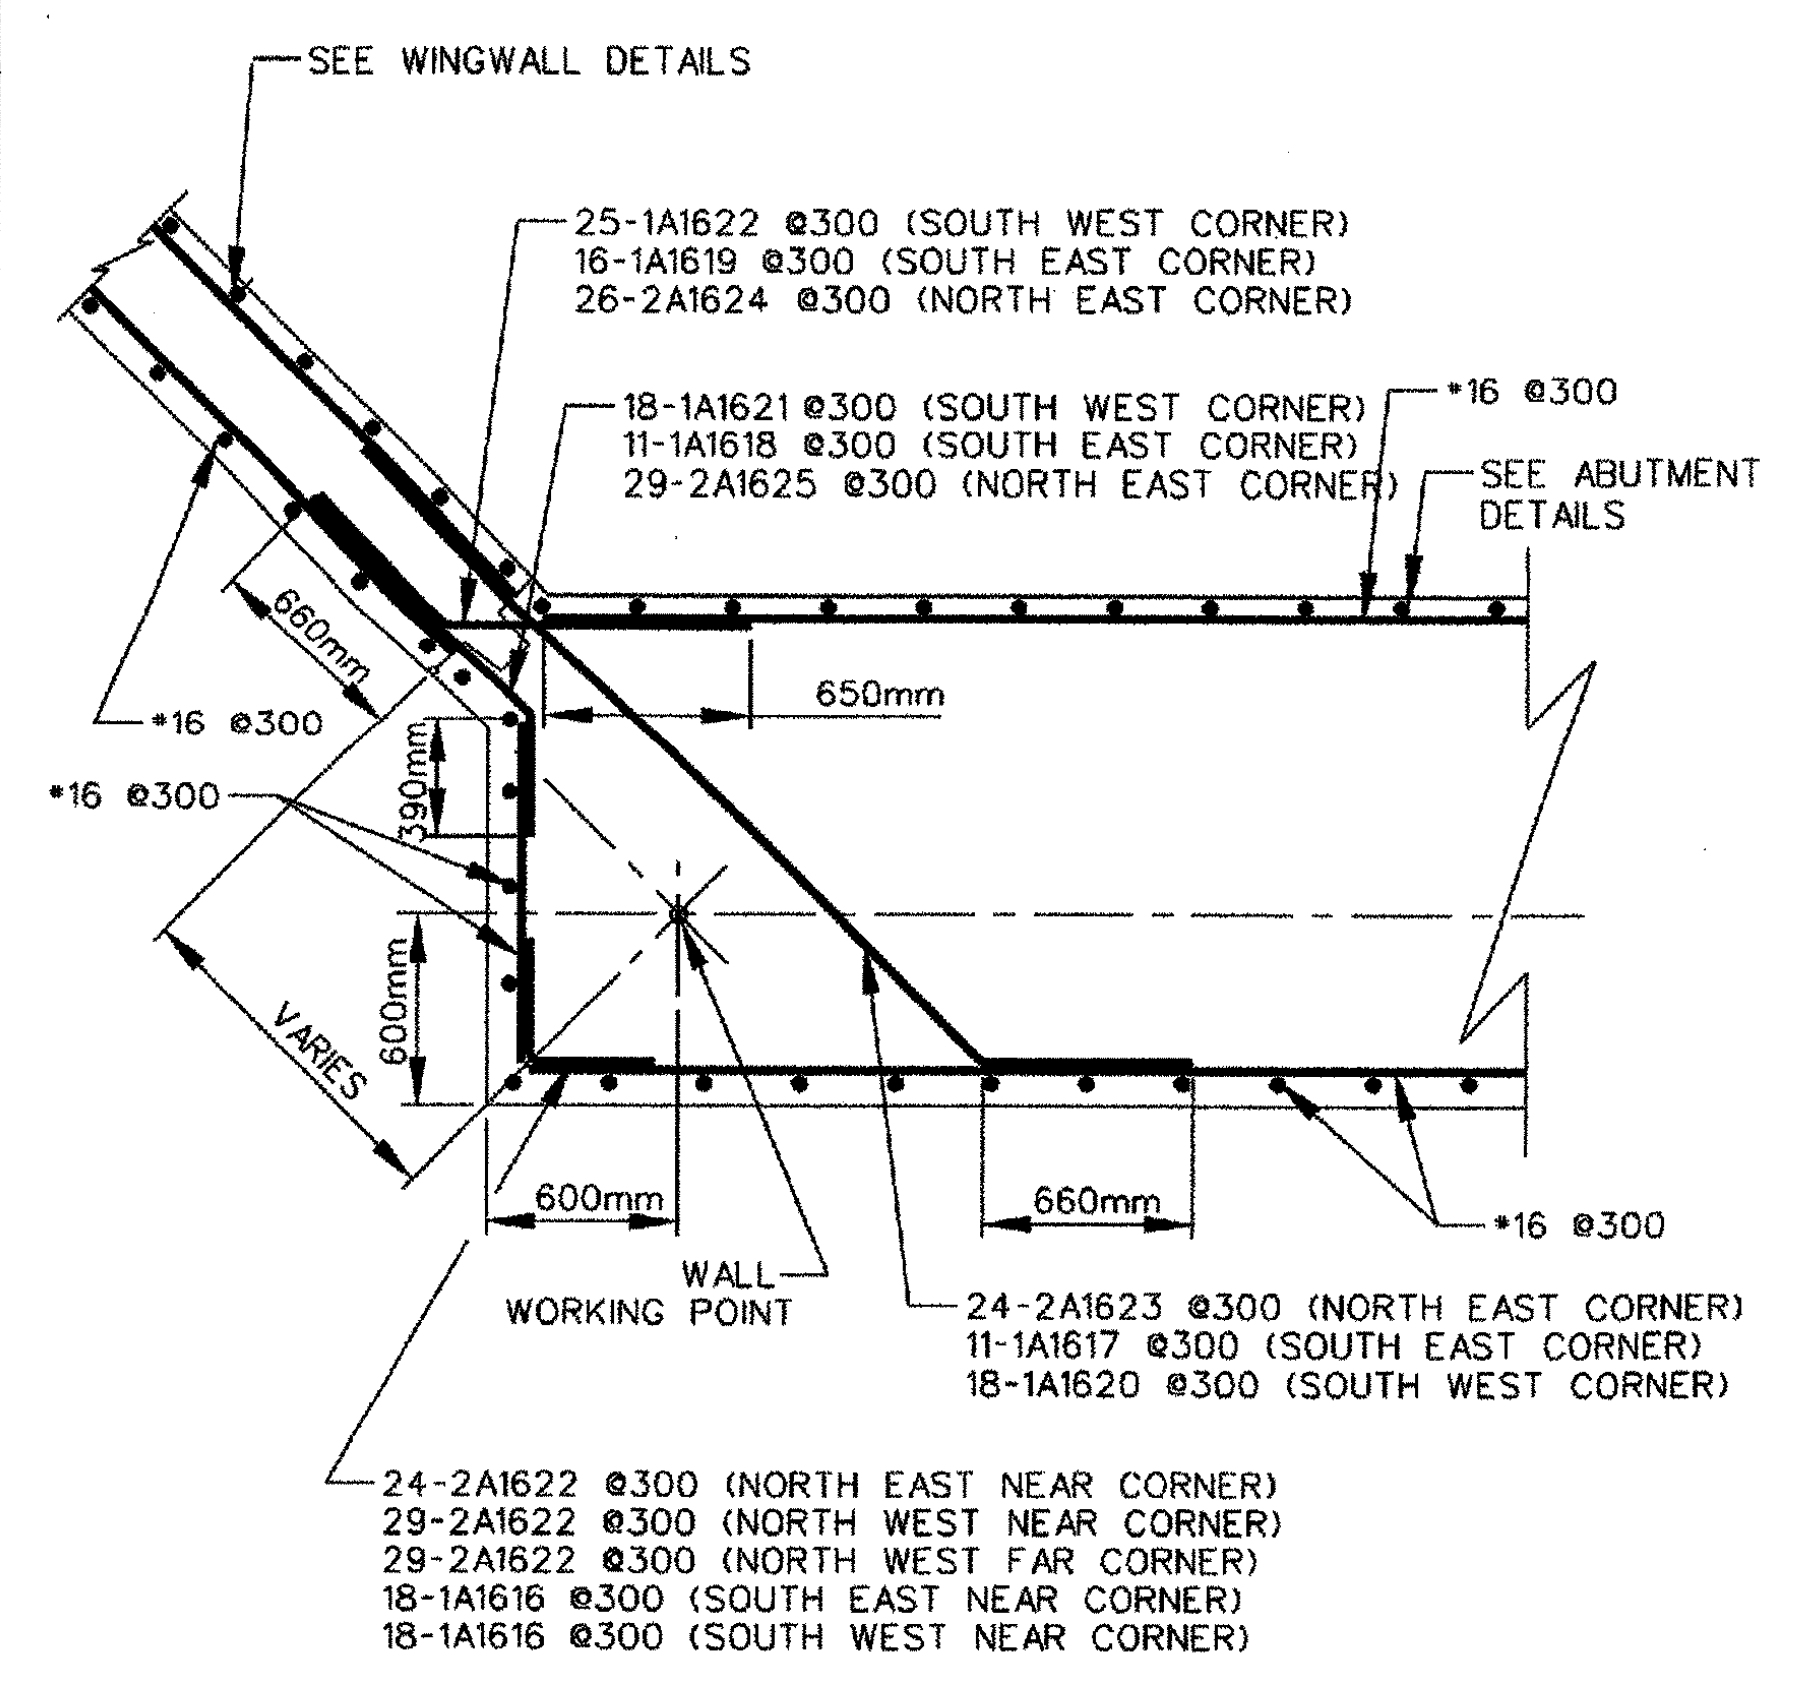


WINGWALL CORNER REINFORCEMENT DETAIL
SCALE 1:25

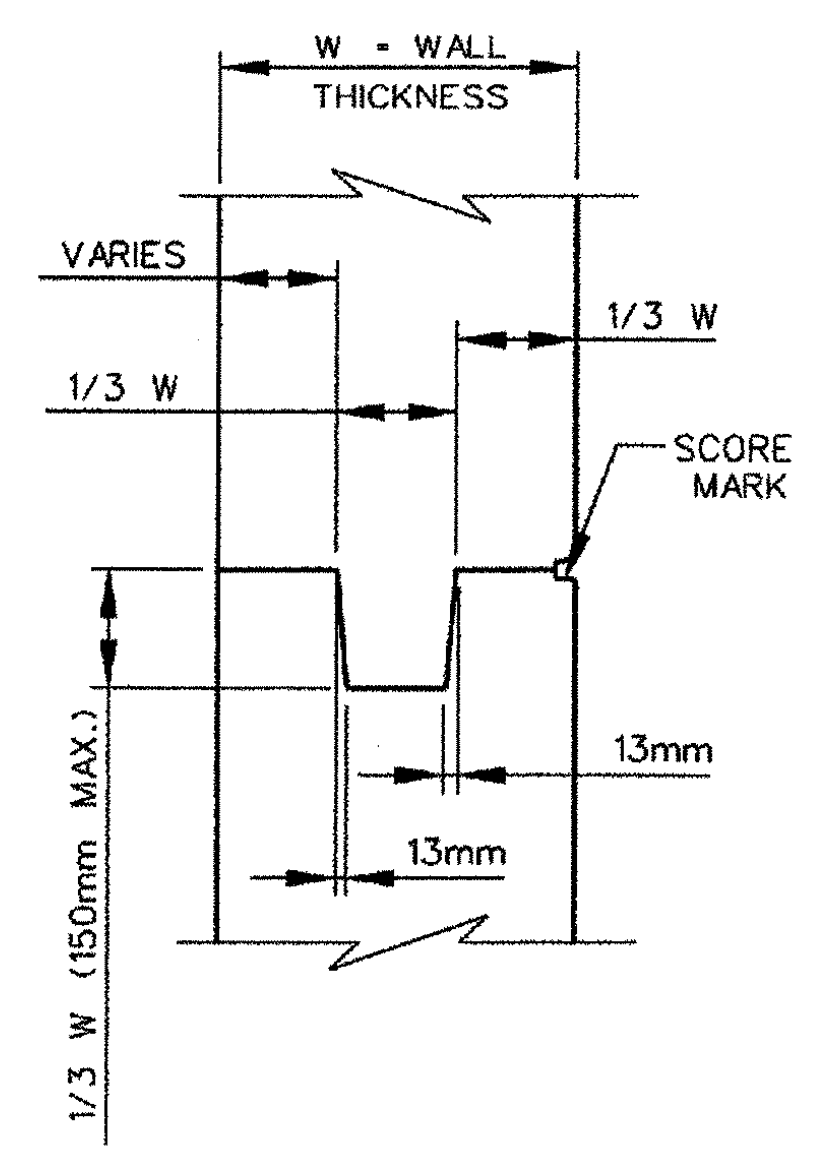

TYPICAL CONCRETE CONSTRUCTION JOINT
SCALE 1:10

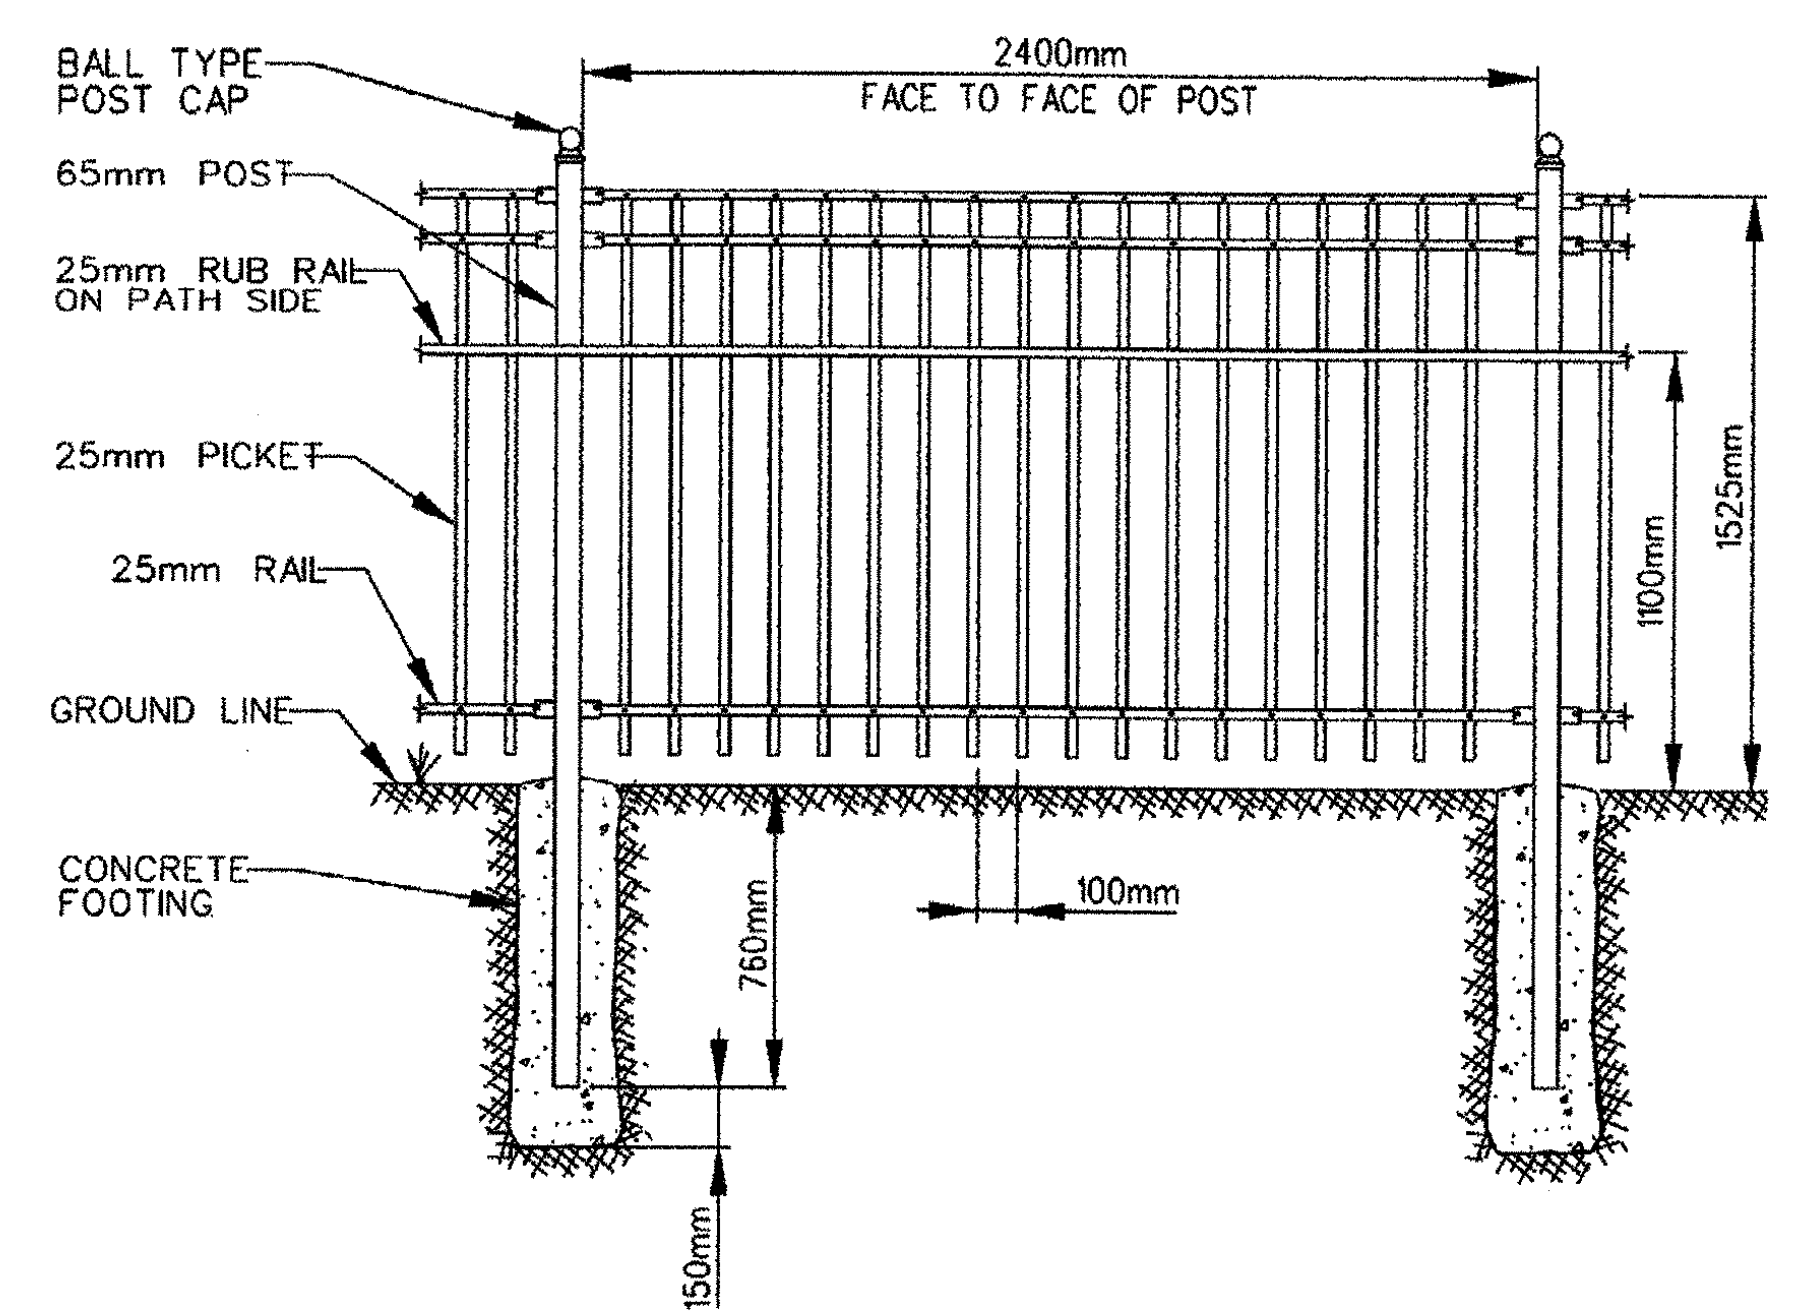


RAIL FENCE DETAIL
SCALE 1:60

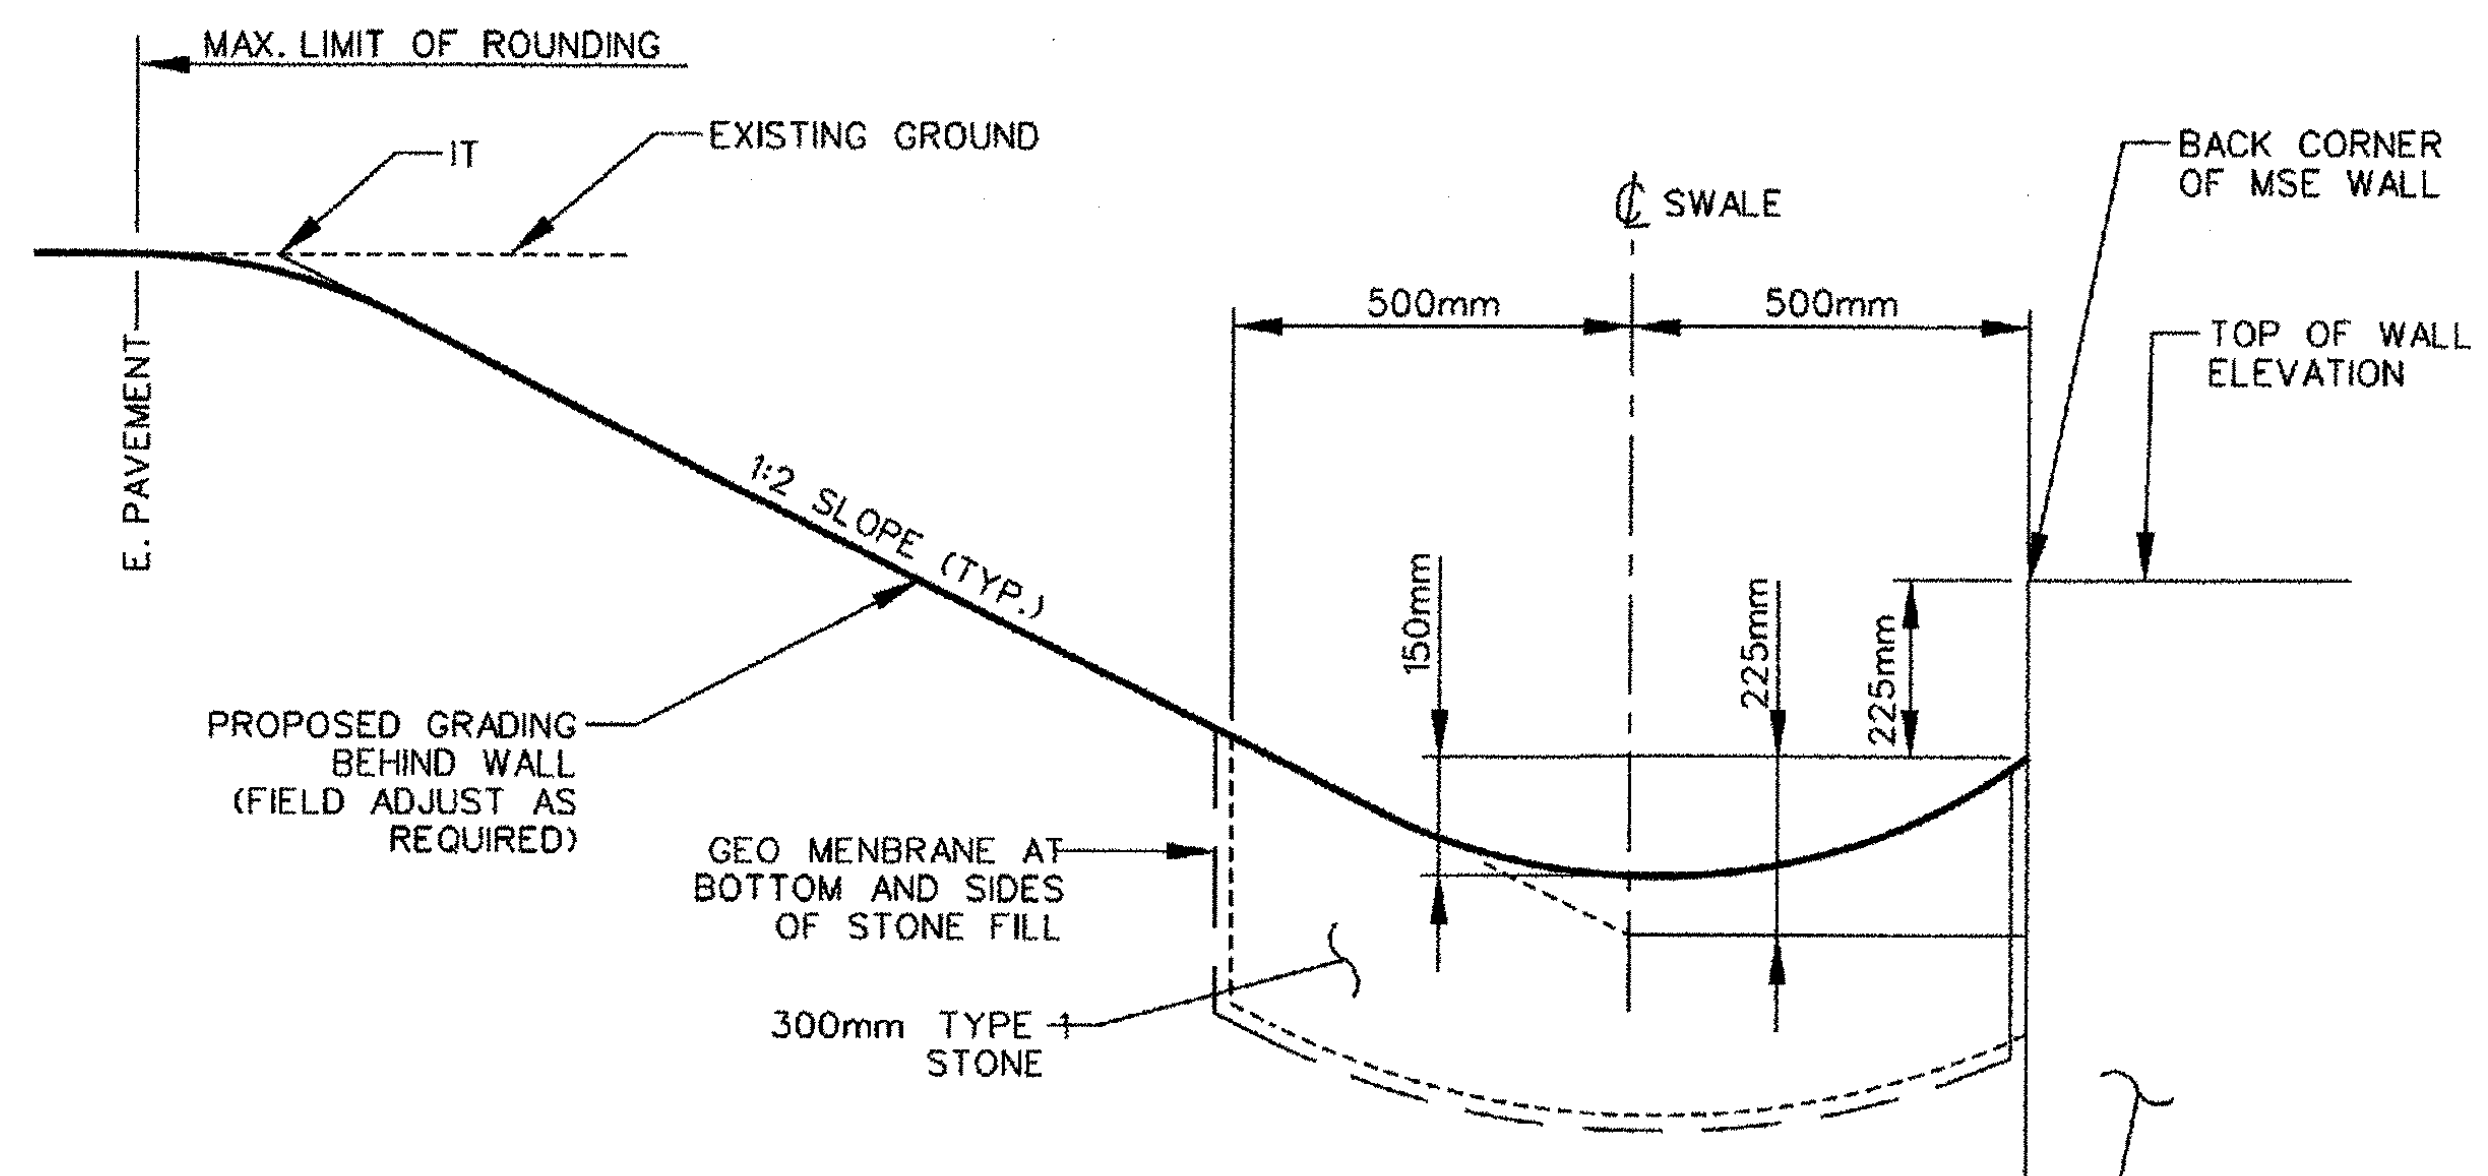

GRADING BEHIND MSE RETAINING WALL
SCALE 1:10

NOTE:
 WALL AS SHOWN ON THIS DETAIL AND ON CROSS SECTIONS IS A GRAPHICAL REPRESENTATION ONLY. NUMEROUS MSE WALL TYPES ARE AVAILABLE. ACTUAL WALL DIMENSIONS AND BATTER OF WALL FACE WILL VARY DEPENDING ON THE OPTION SELECTED. SLOPE LIMITS BEHIND THE WALL WILL ALSO VARY DEPENDING ON WALL THICKNESS AND THE LOCATION OF BACK OF WALL. IN ANY EVENT, THE SLOPE LIMIT WITH ROUNDING MUST NOT EXTEND BEYOND THE CURRENT EDGE OF BITUMINOUS PAVEMENT.

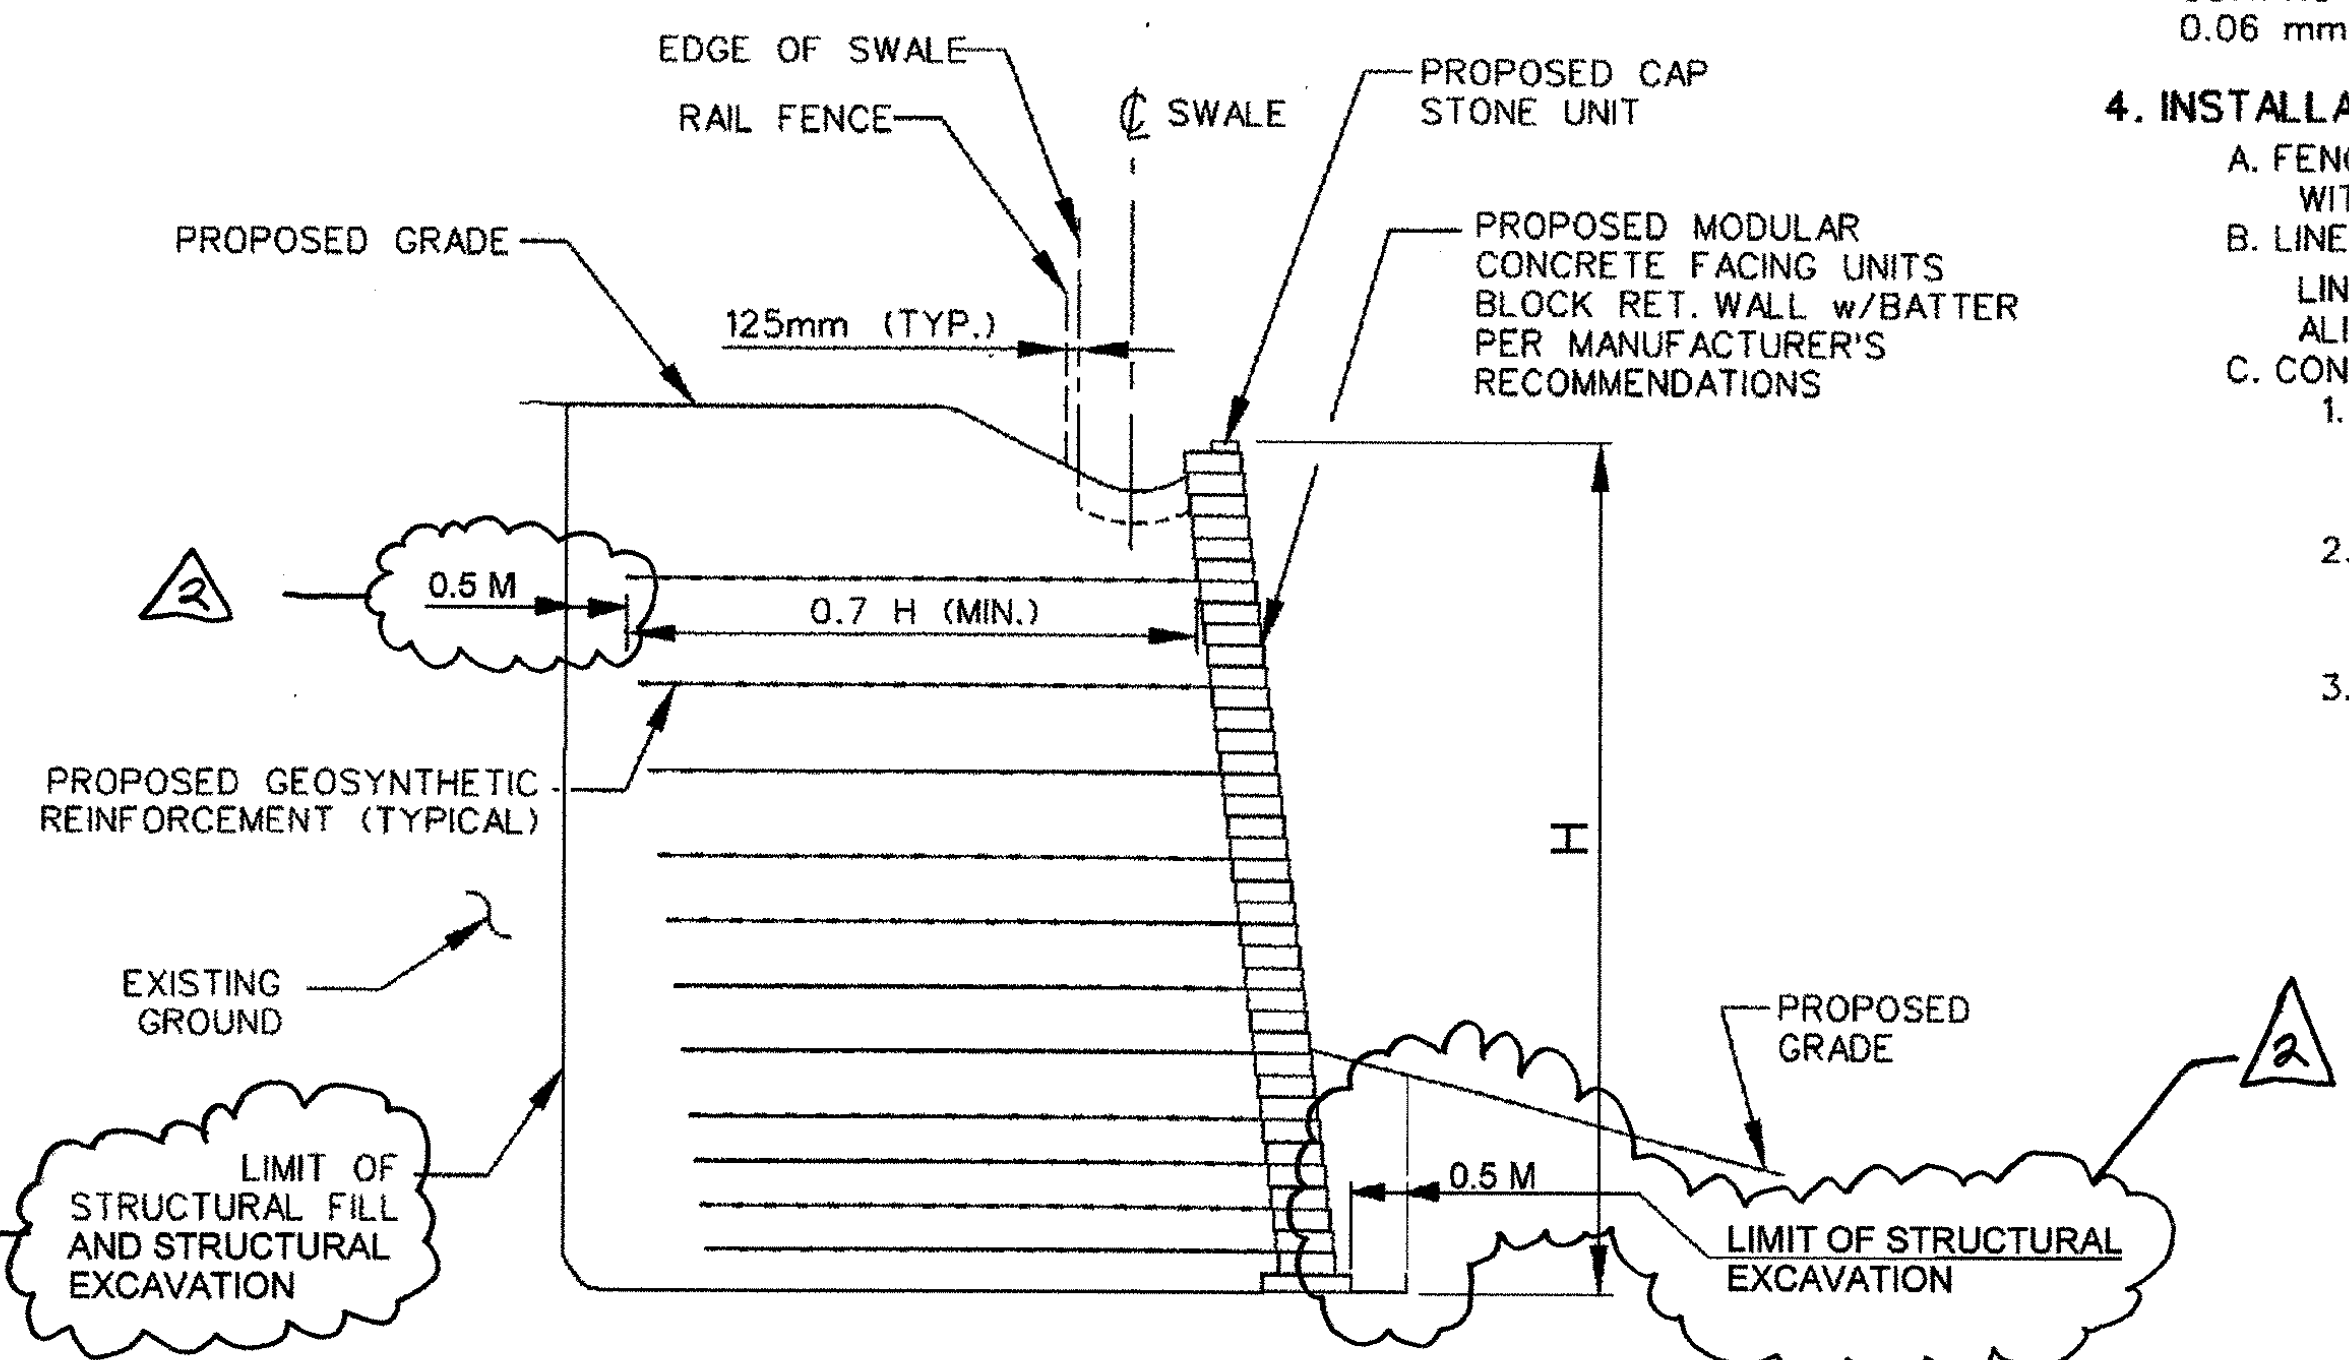


MSE RETAINING WALL SECTION
SCALE 1:75


SEE SHEETS 138 TO 144 FOR THE MSE WALL DESIGN PERFORMED BY TENSAR FOR THIS LOCATION.

△ Addendum two, Fill/Excavation Limits Dec 6, 2002

STATE OF VERMONT AGENCY OF TRANSPORTATION			
Town Of	BRATTLEBORO	Bridge No.	62.56
Highway No.	VT. ROUTE 9	Log Sta.	
		Surv. Sta.	
ROUTE 9 BRIDGE			
SUBSTRUCTURE DETAILS			
Designed By		Drawn By	DHL
Checked By	Date	Bridge Design Supervisor	Date
PROJECT	BRATTLEBORO	PROJECT NO.	NH 010-2(2)
I.G.C. Info.			
Bridge Sheet No. 12		Sheet 80	of 145

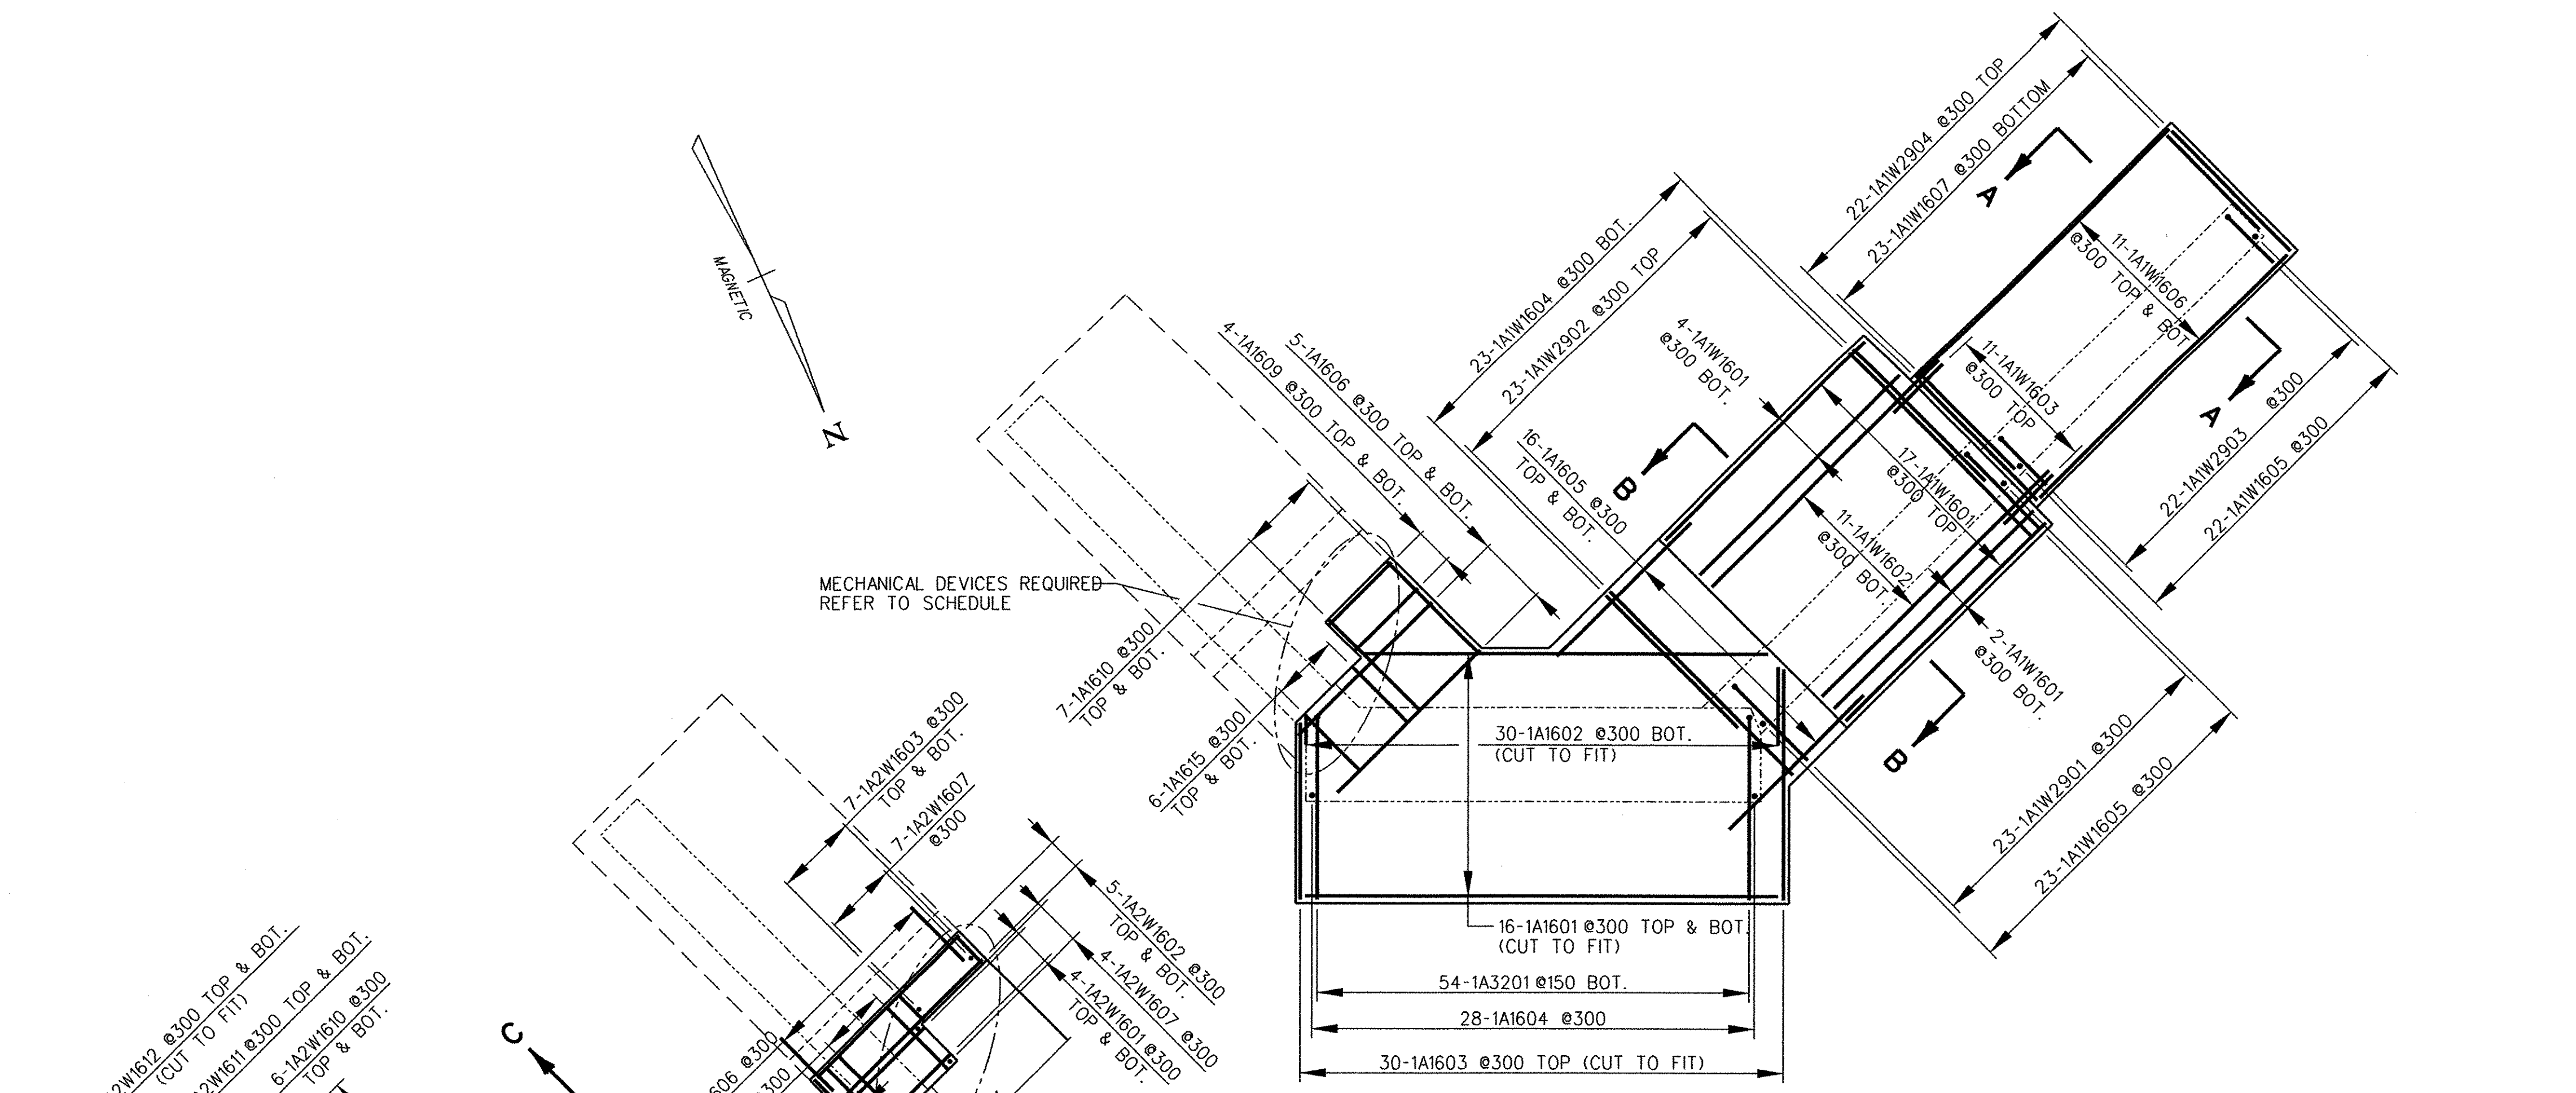


SOUTH ABUTMENT FOOTING REINFORCEMENT PLAN
SCALE 1:75

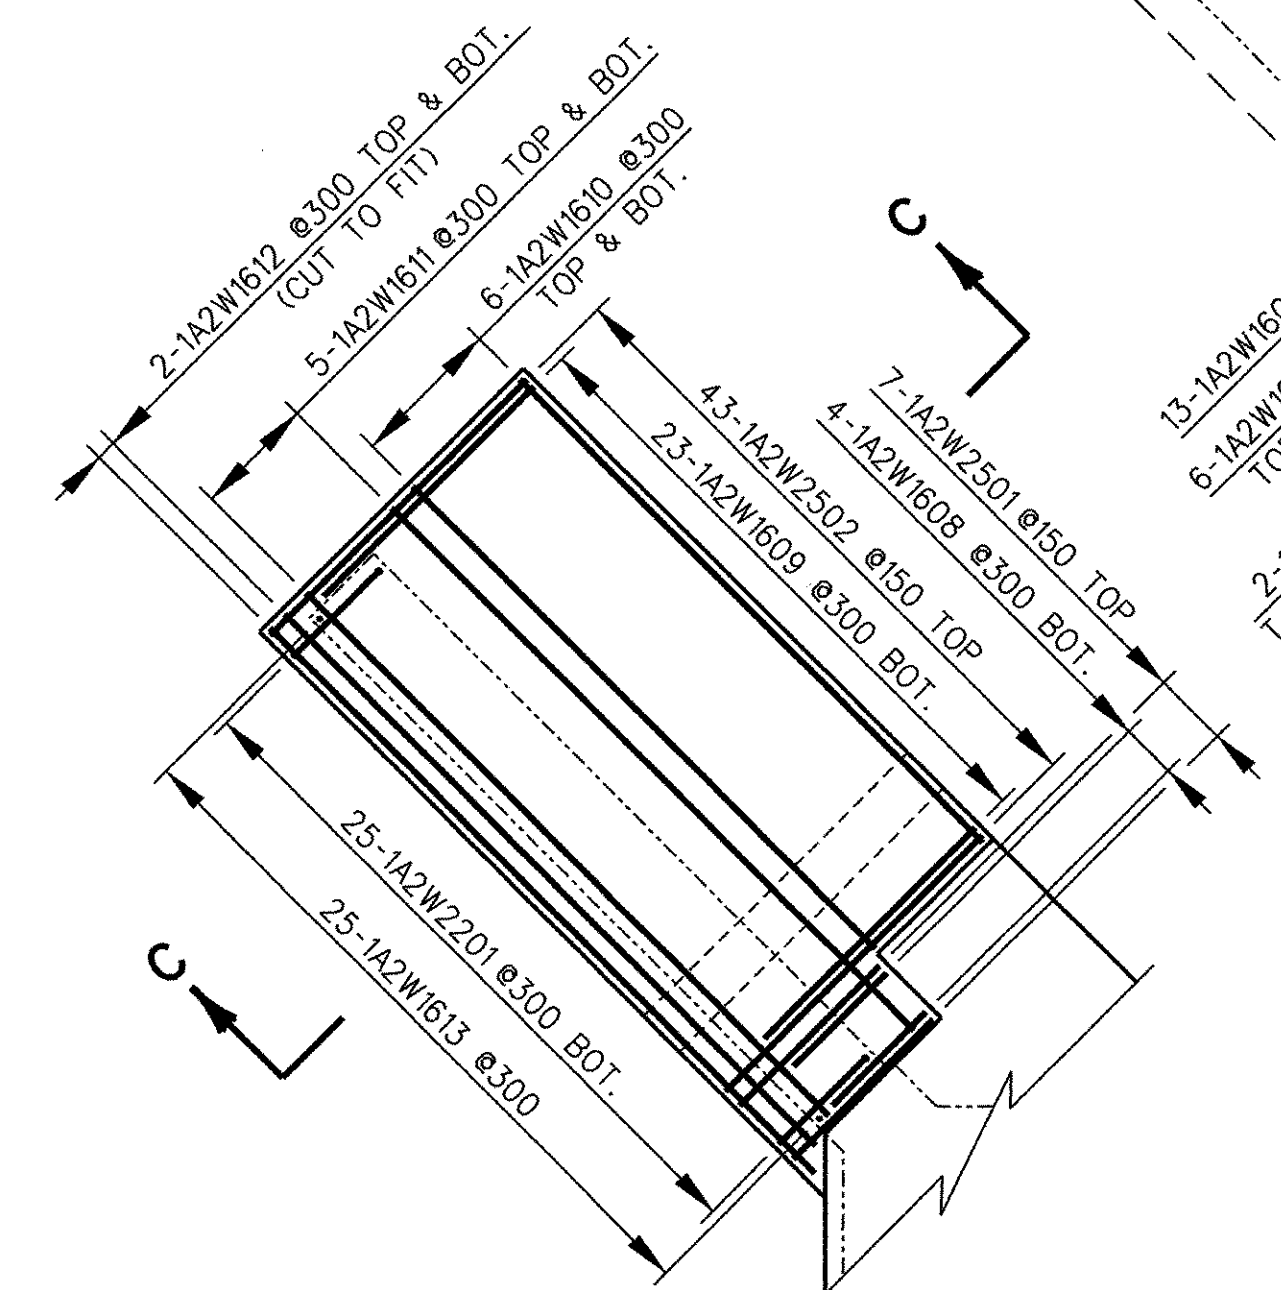

S. ABUTMENT E. WINGWALL FOOTING REINFORCEMENT PLAN (LEVEL 2)
SCALE 1:75



S. ABUTMENT E. WINGWALL FOOTING REINFORCEMENT PLAN (LEVEL 1)
SCALE 1:75

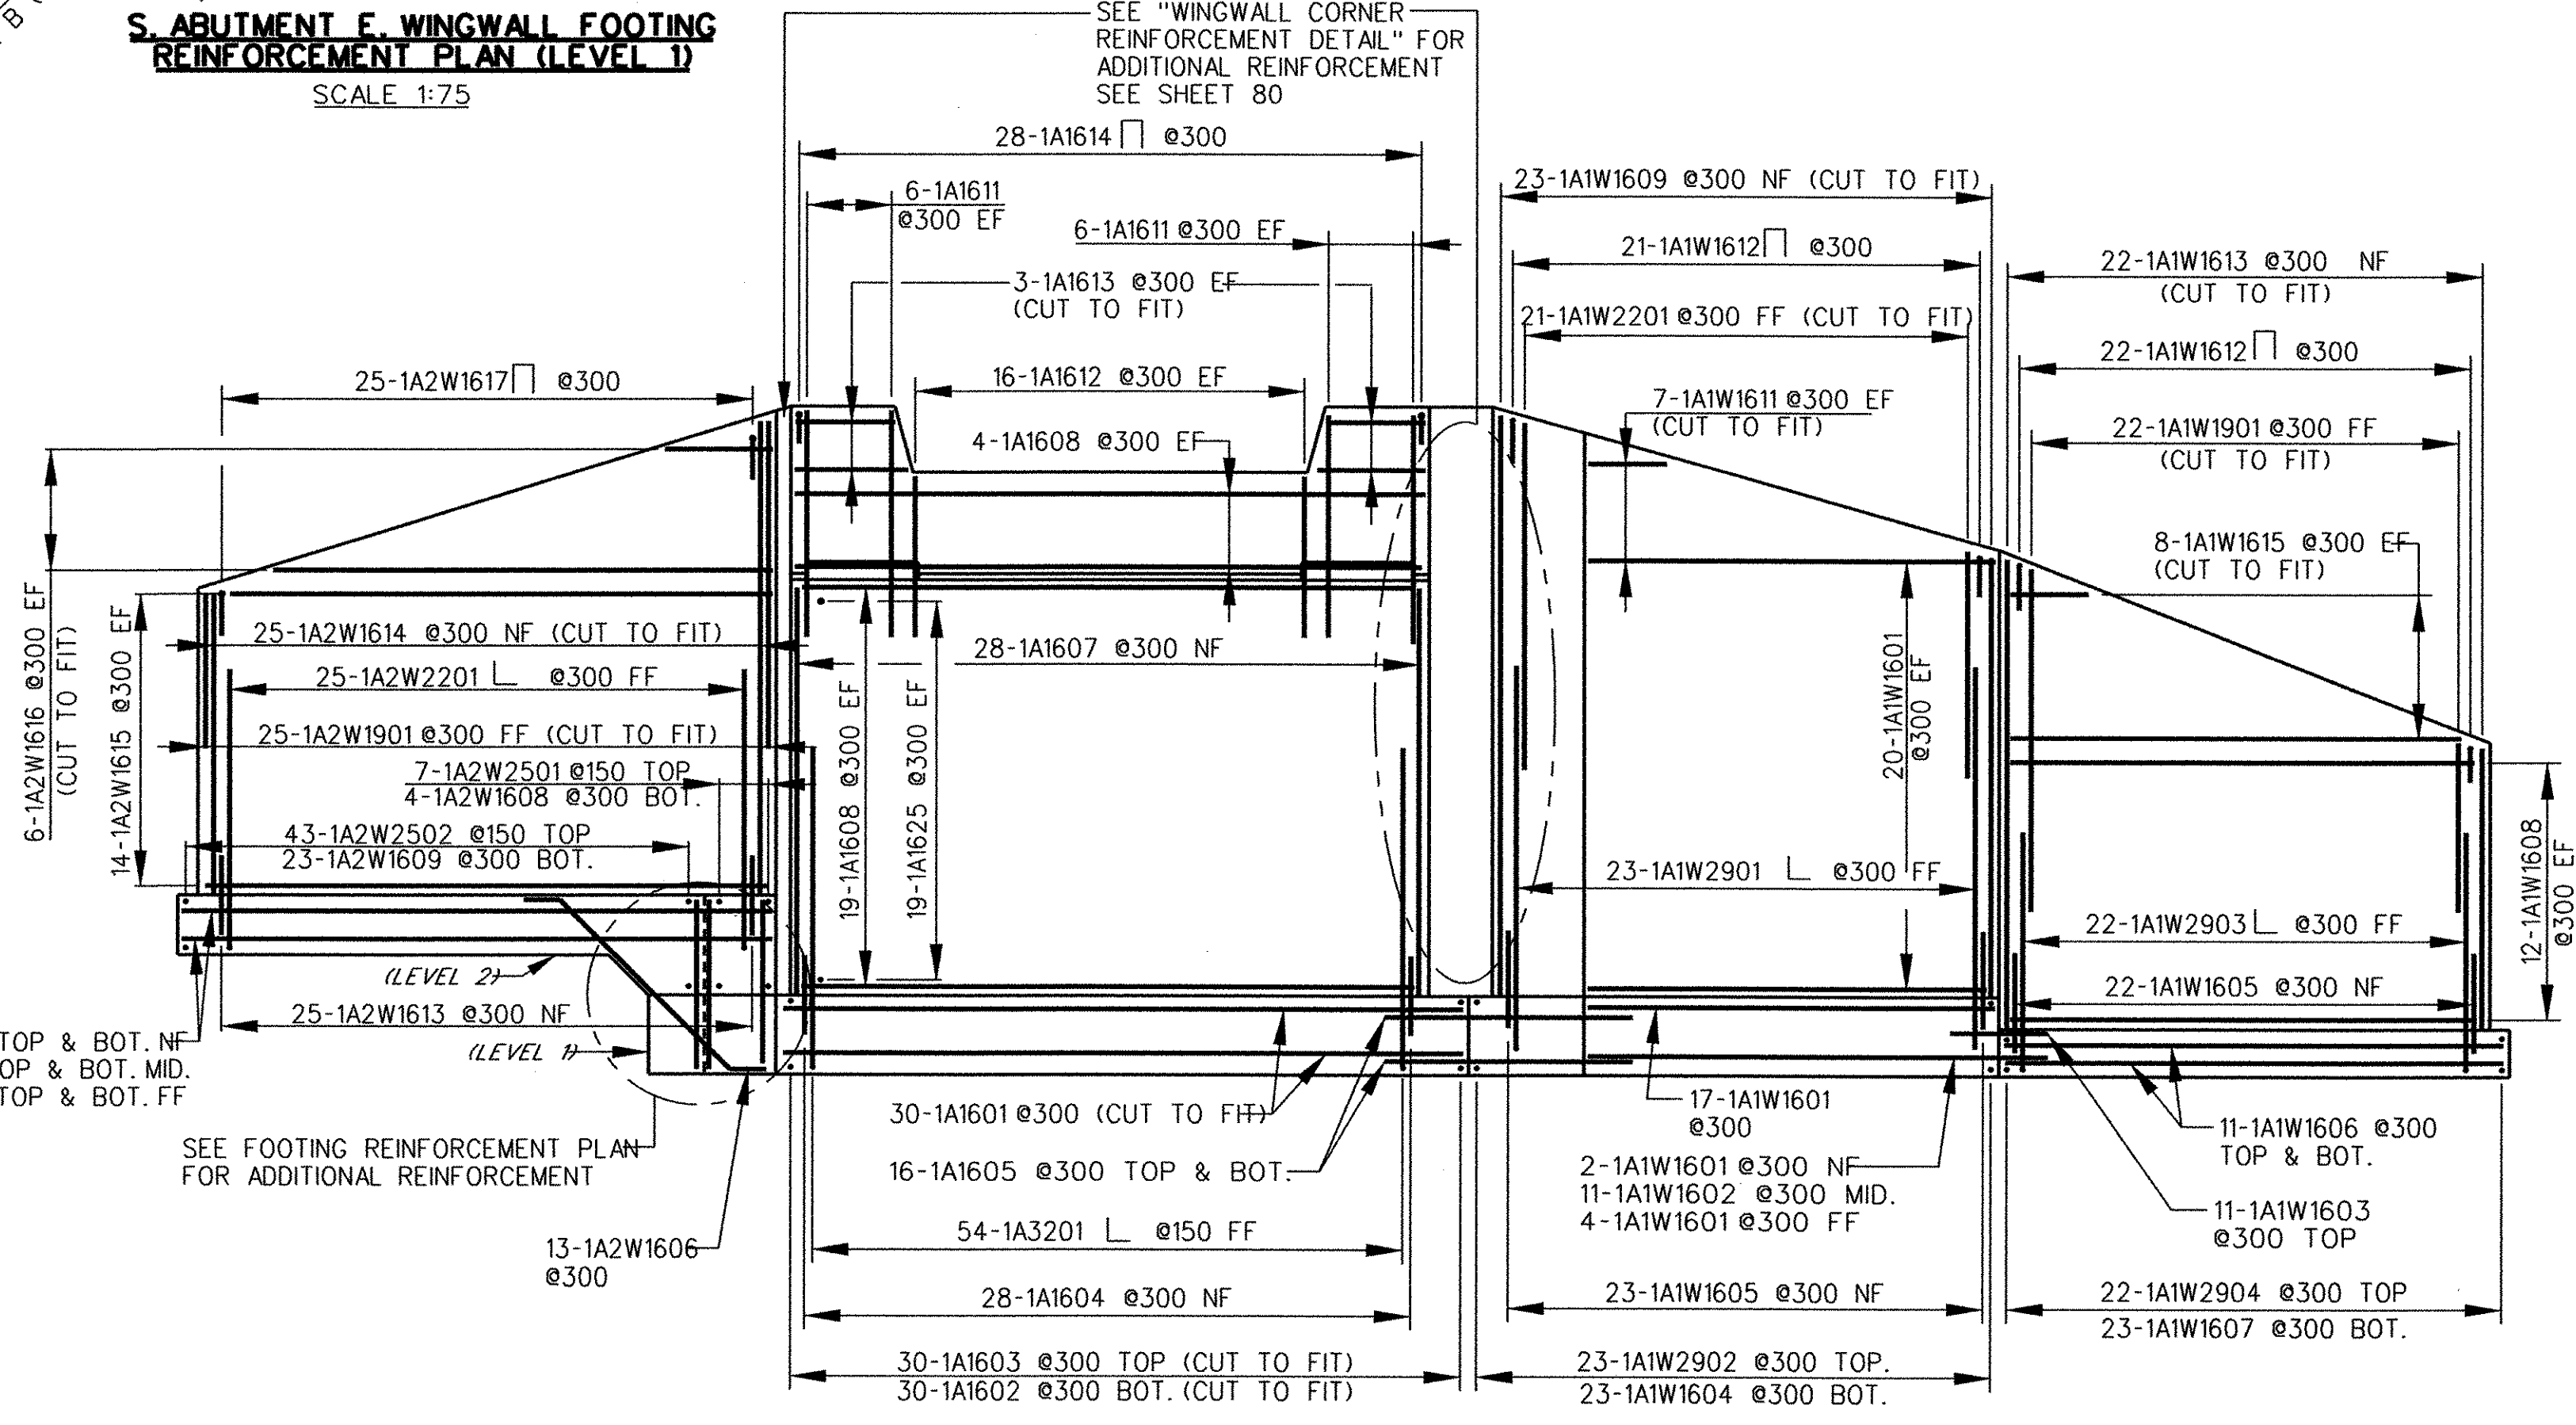


SOUTH ABUTMENT REINFORCEMENT ELEVATION
SCALE 1:75

STATE OF VERMONT AGENCY OF TRANSPORTATION		
Town Of	BRATTLEBORO	Bridge No. 62.56
Highway No.	VT. ROUTE 9	Log Sta.
		Surv. Sta.
ROUTE 9 BRIDGE		
SOUTH ABUTMENT REINFORCEMENT PLAN & ELEVATION		
Designed By		Drawn By LRD
Checked By	Date	Bridge Design Supervisor
		Date
PROJECT	BRATTLEBORO	PROJECT NO. NH 010-2(2)
I.G.C. Info.		
Bridge Sheet No.		Sheet 81 of 145


Plot Date: 10-03-2002
File: rt9br163

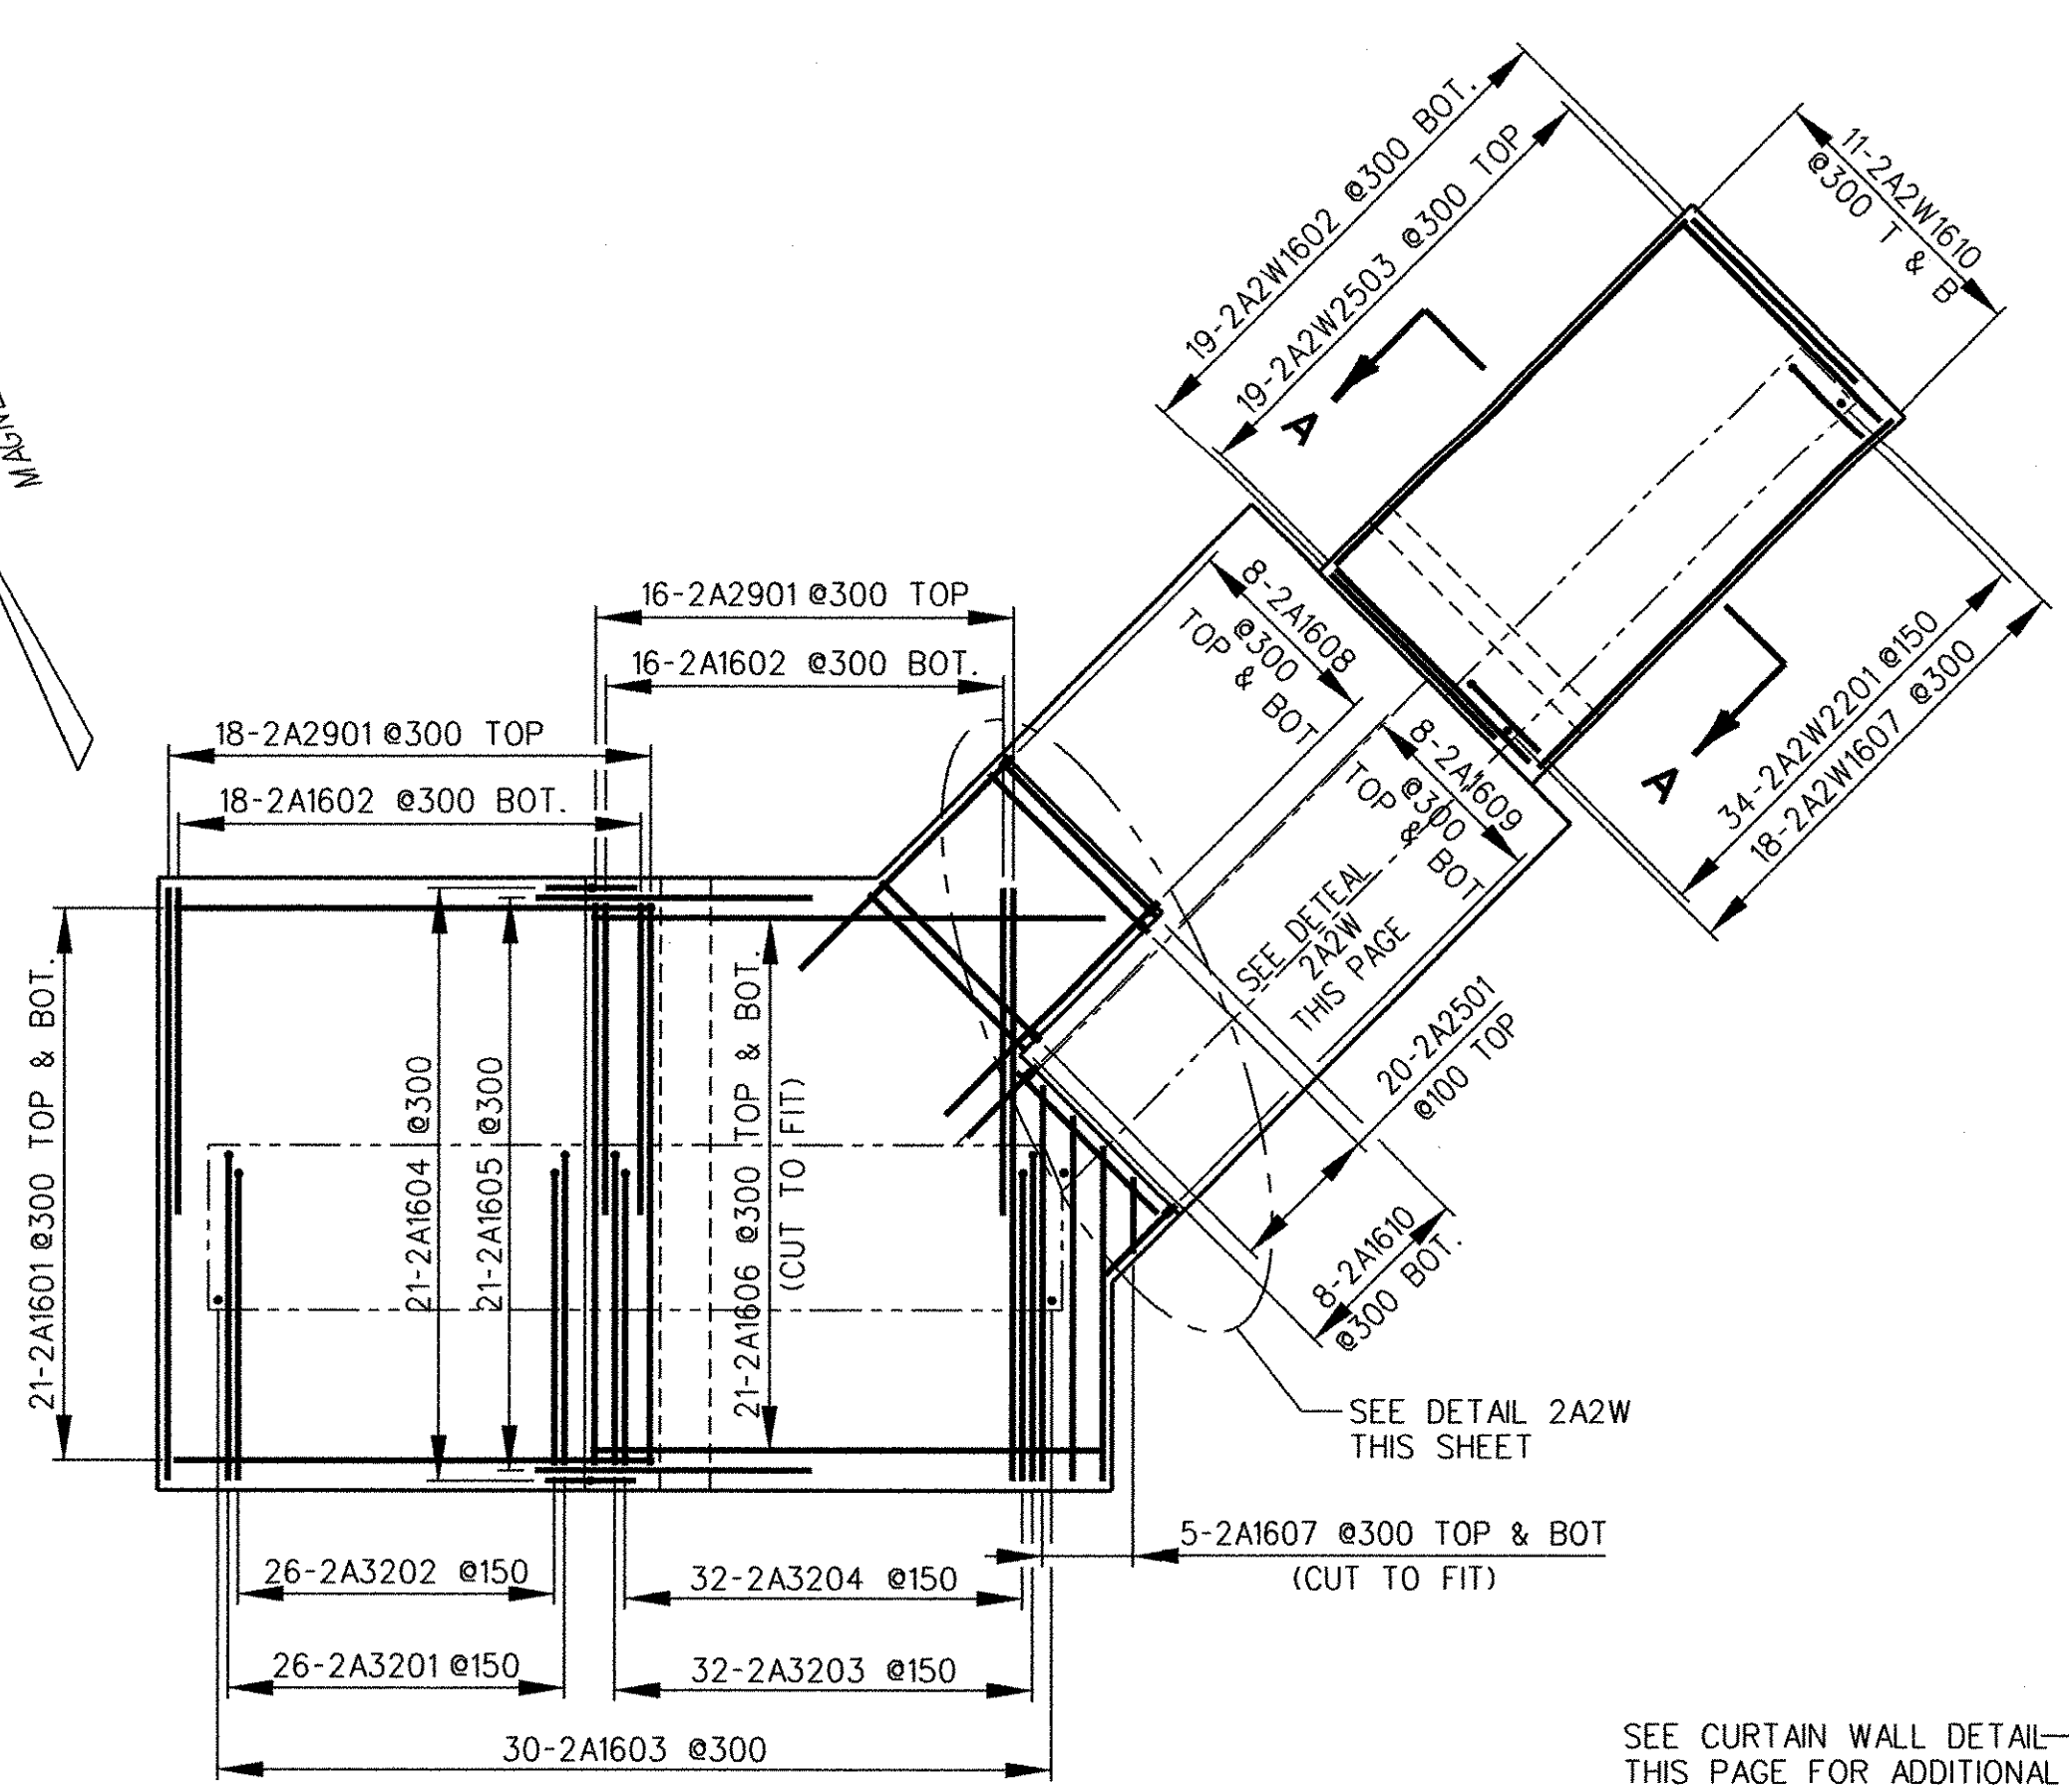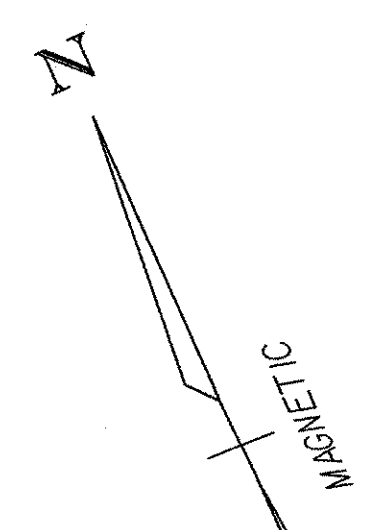


NORTH ABUTMENT FOOTING REINFORCEMENT PLAN
SCALE 1:75

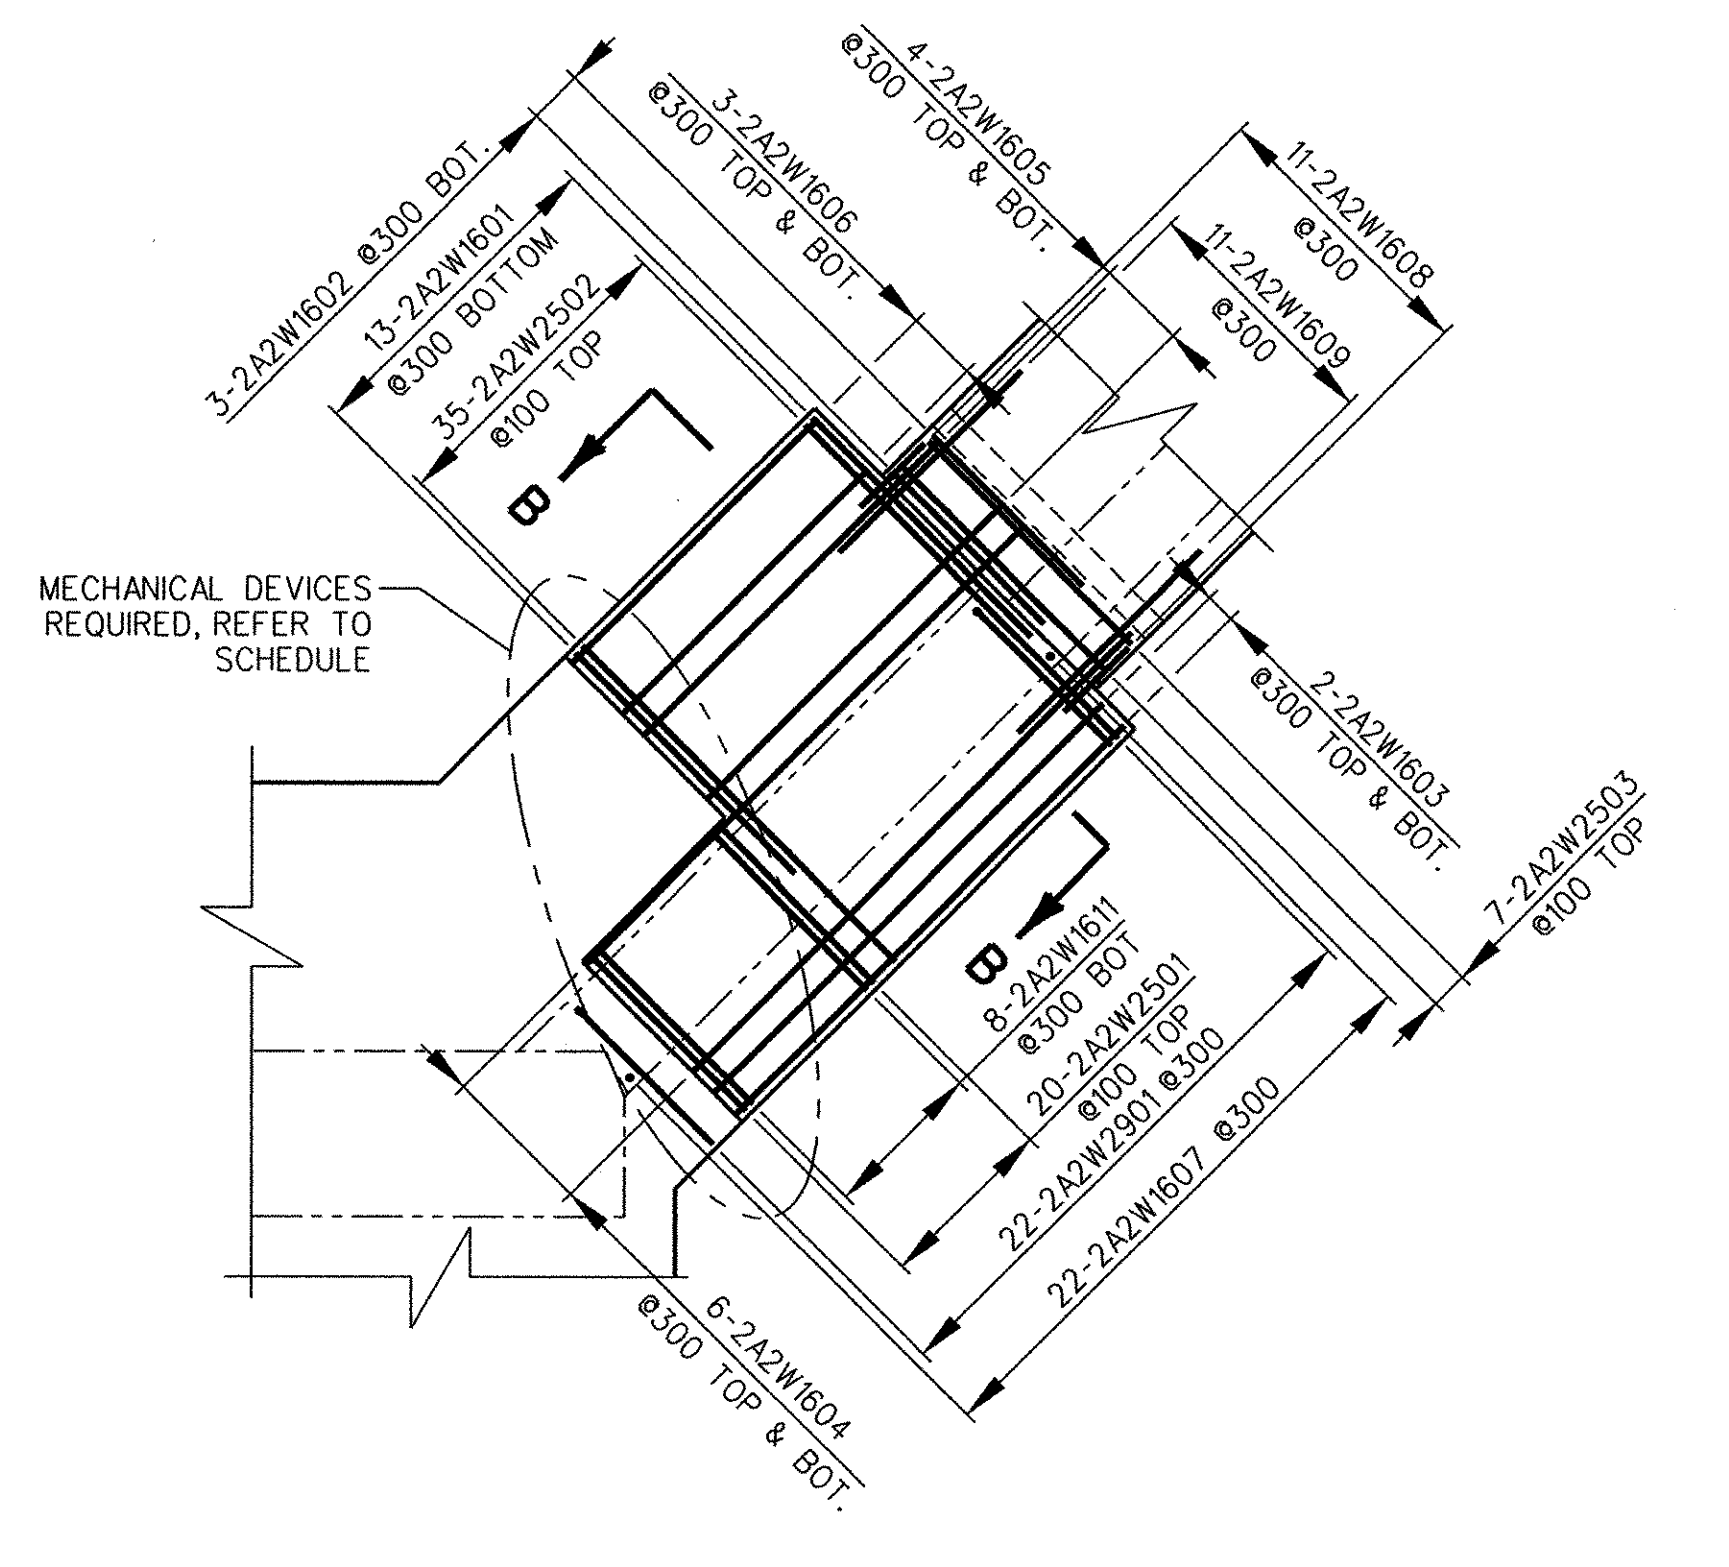

DETAIL 2A2W
SCALE 1:75

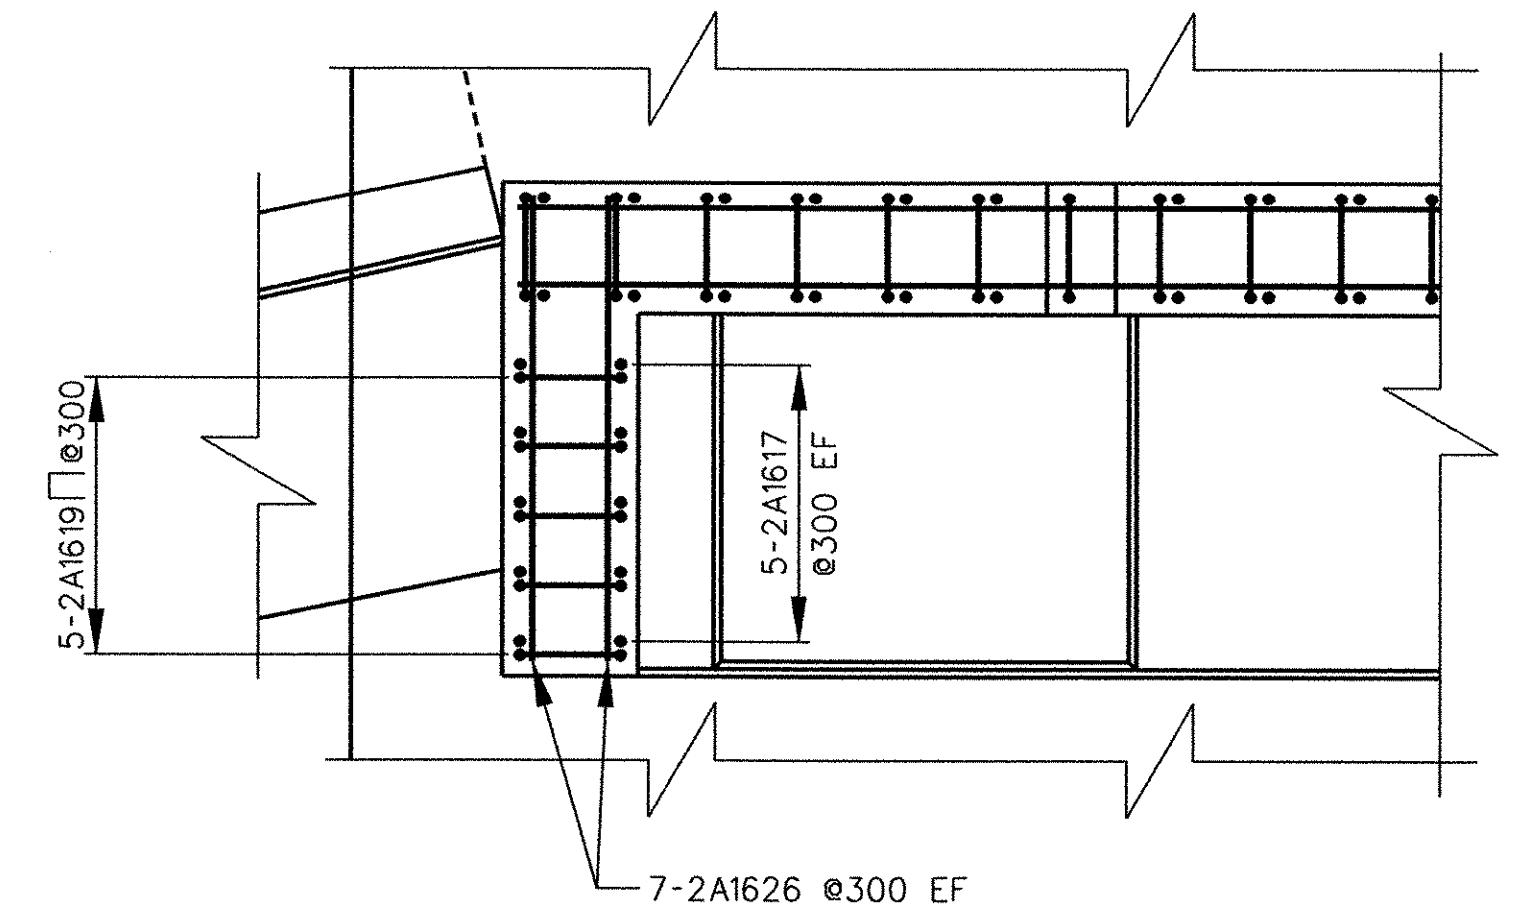



No. ABUTMENT CURTAIN WALL DETAIL
SCALE: 1:25

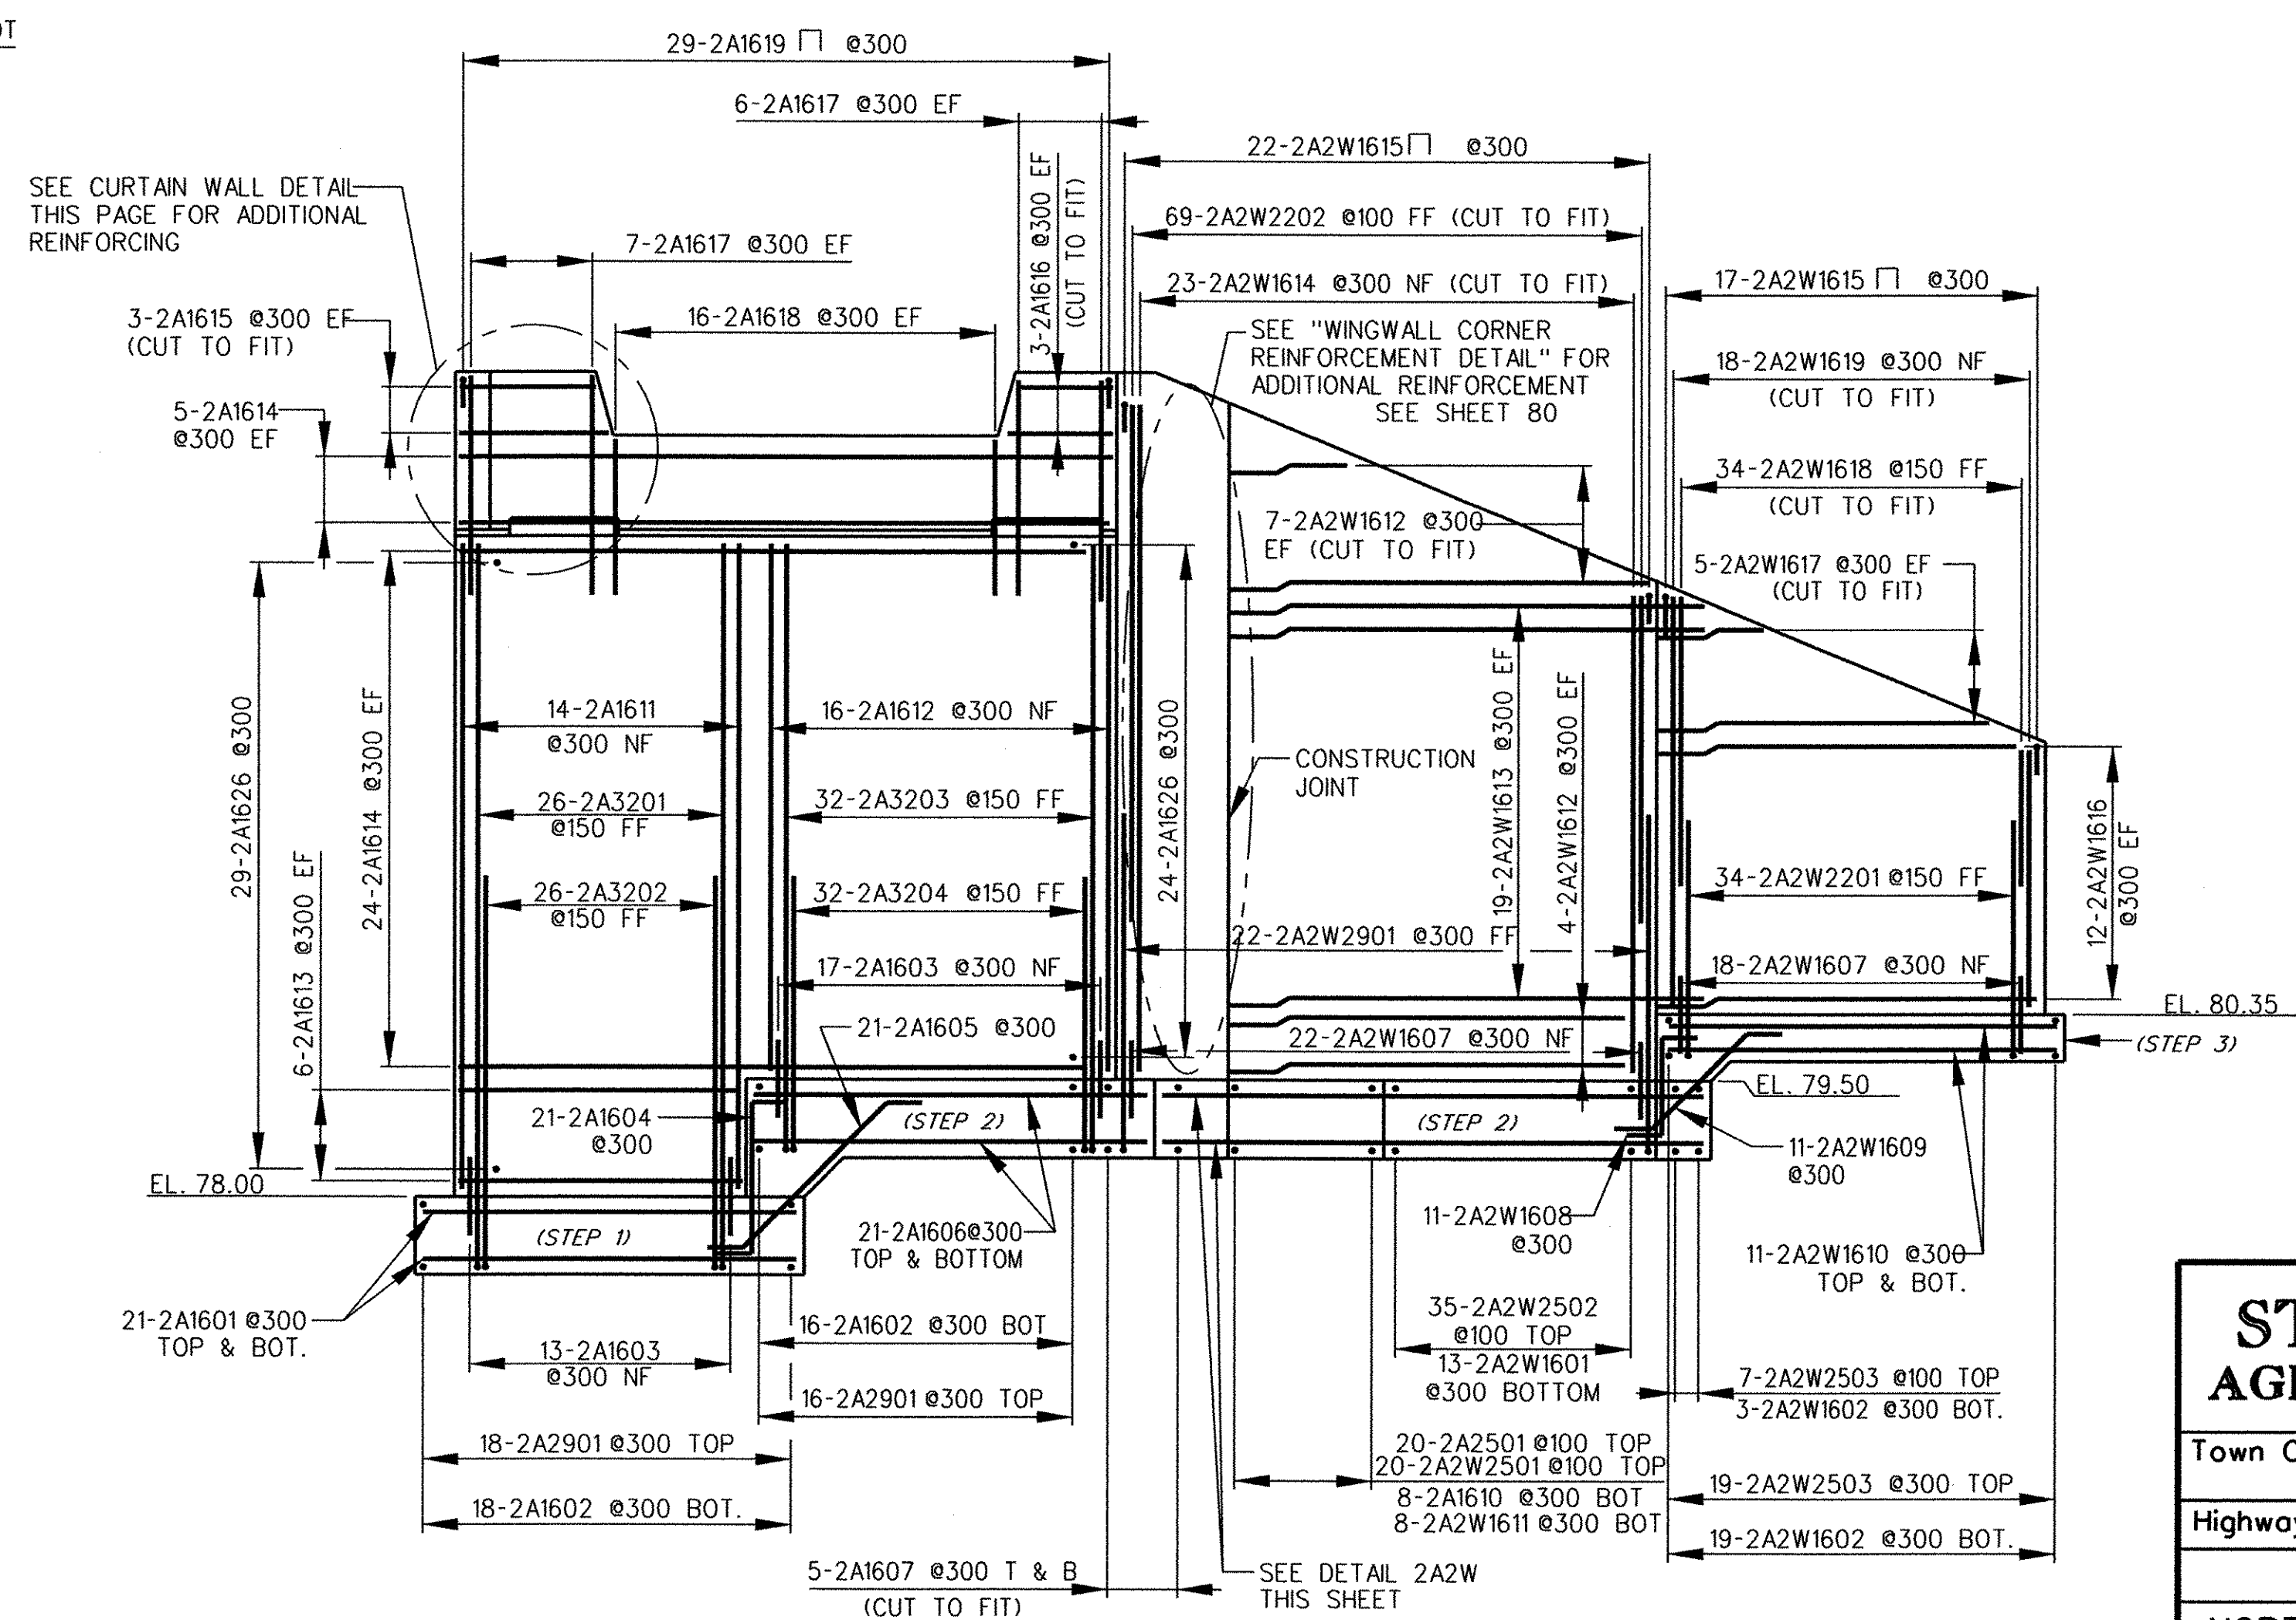


NORTH ABUTMENT REINFORCEMENT ELEVATION
SCALE 1:75

**STATE OF VERMONT
AGENCY OF TRANSPORTATION**

Town Of	BRATTLEBORO	Bridge No.	62.56
Highway No.	VT. ROUTE 9	Log Sta.	
		Surv. Sta.	
ROUTE 9 BRIDGE			
NORTH ABUTMENT FOOTING PLAN & ELEVATION			
Designed By		Drawn By	LRD
Checked By	Date	Bridge Design Supervisor	Date
PROJECT	BRATTLEBORO	PROJECT NO.	NH BRF 012-1(33)
I.G.C. Info.			
Bridge Sheet No. 14		Sheet	82 of 145

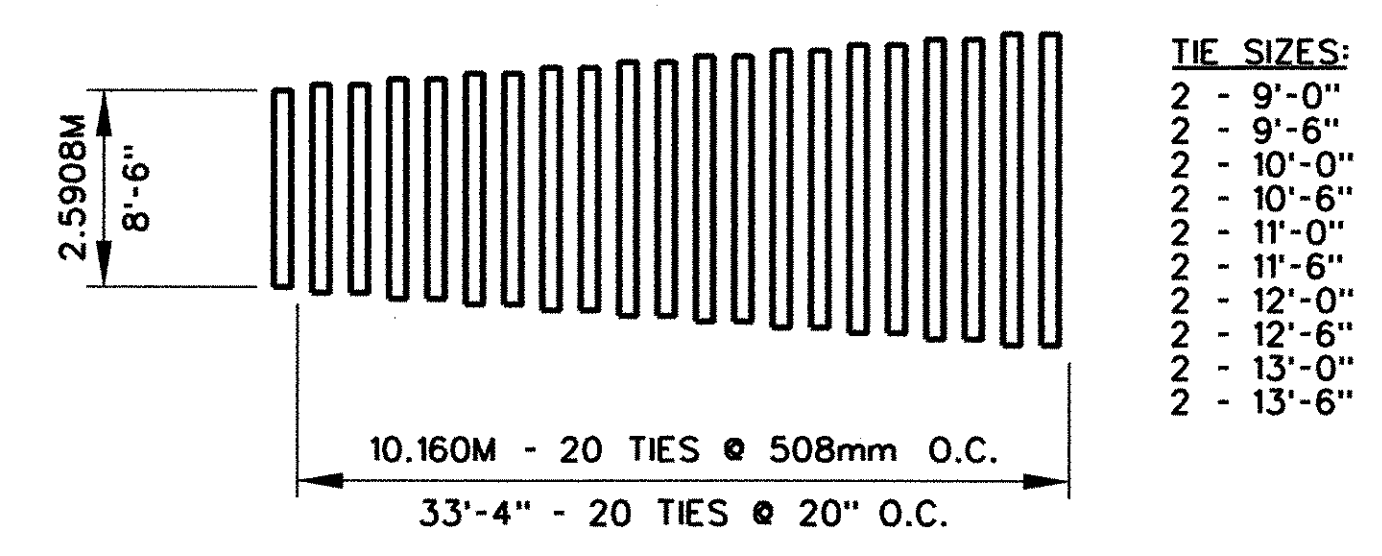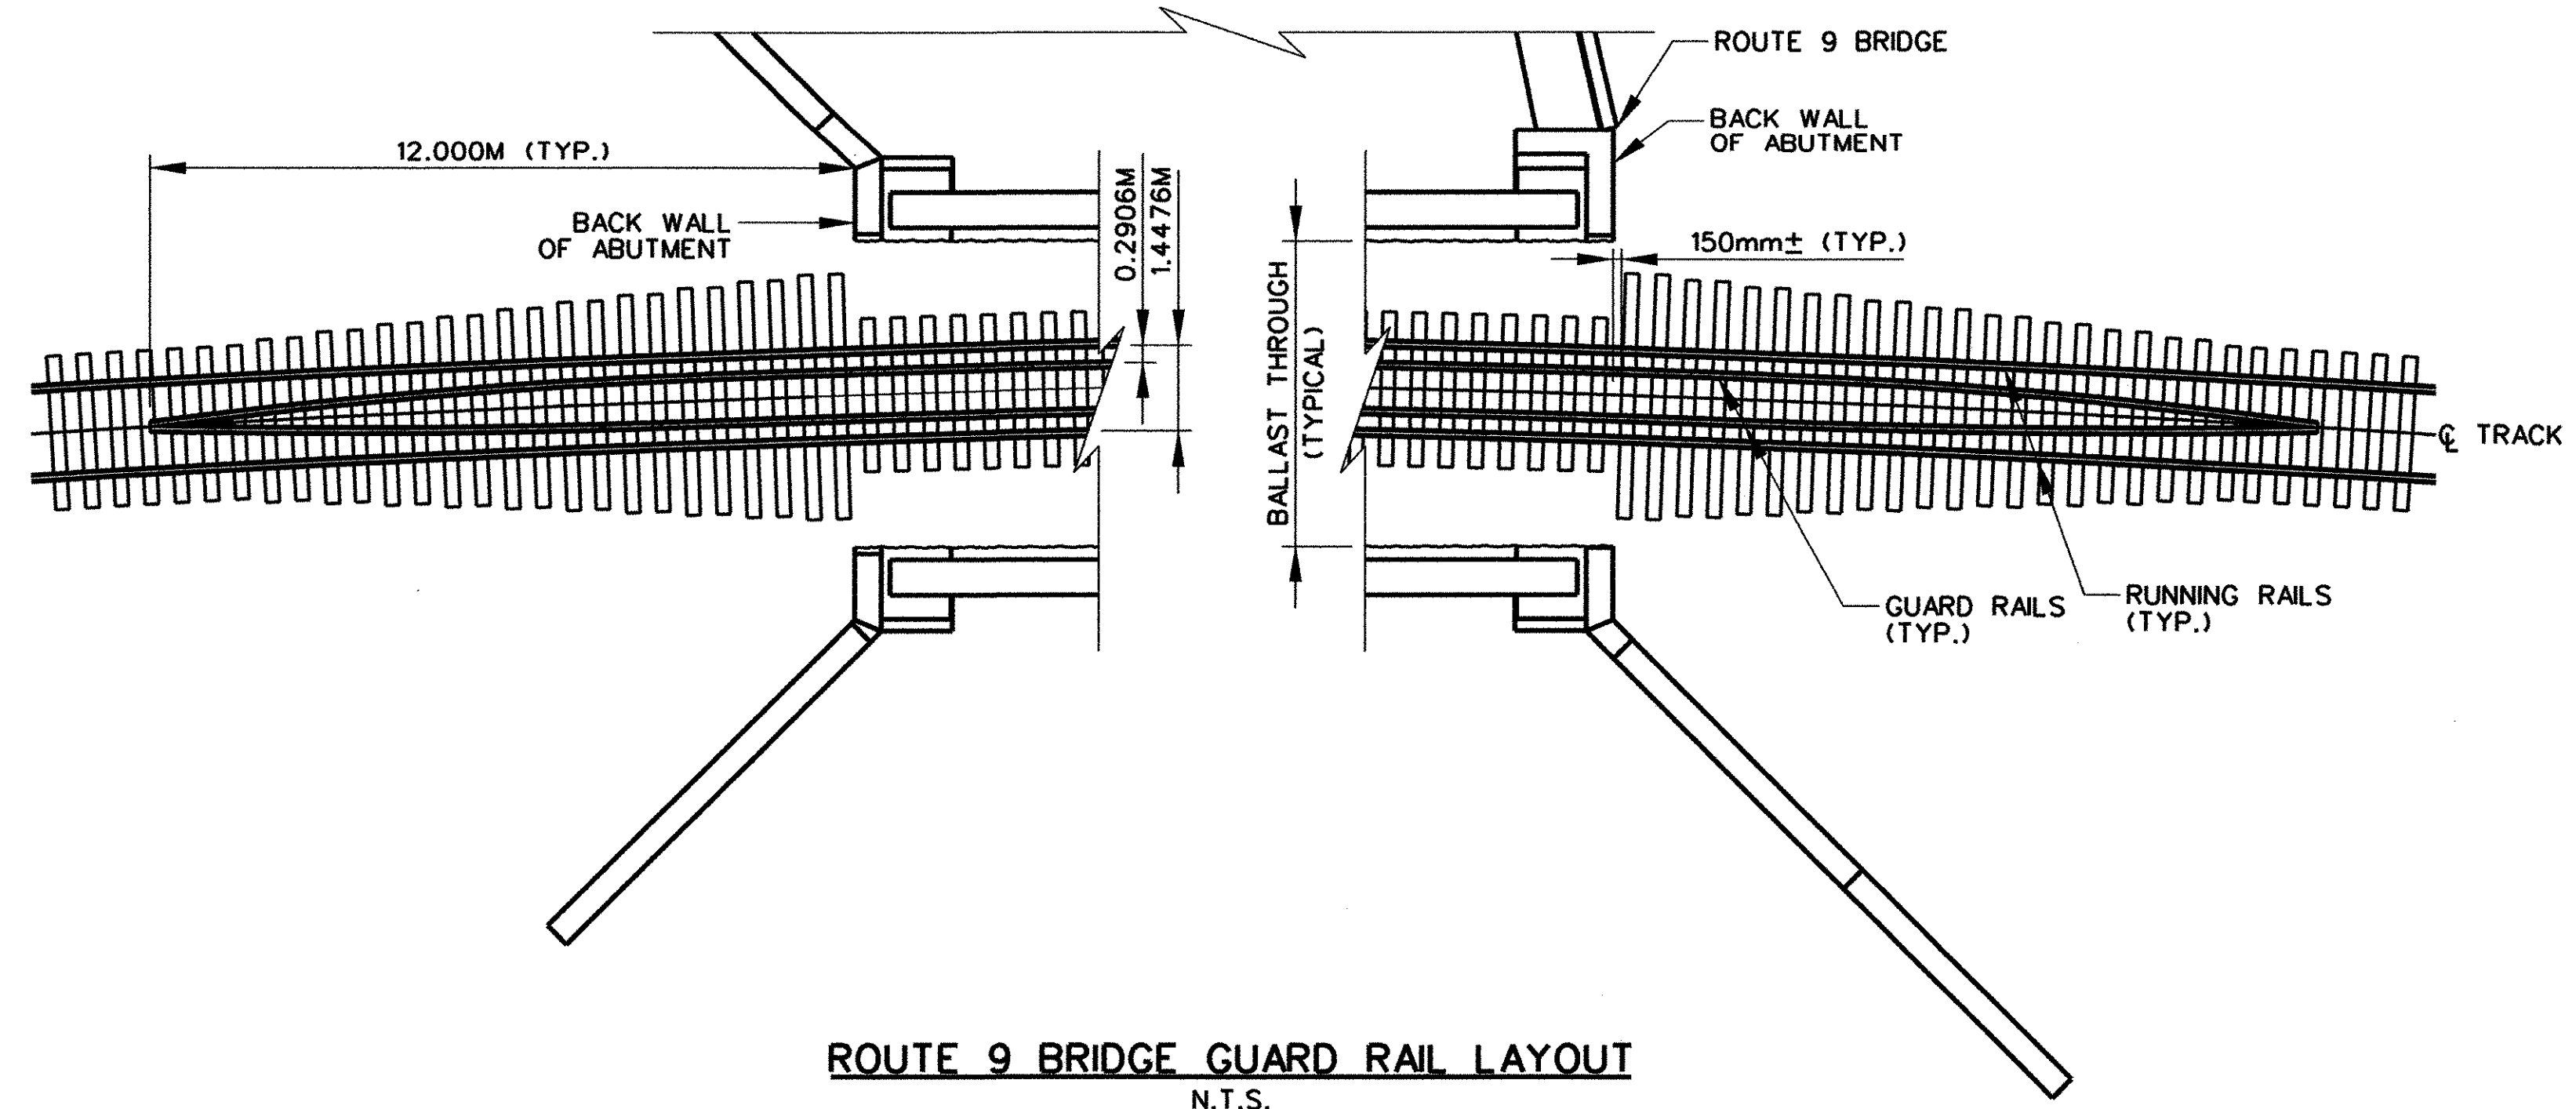



- TIE SIZES:**
- 2 - 9'-0"
 - 2 - 9'-6"
 - 2 - 10'-0"
 - 2 - 10'-6"
 - 2 - 11'-0"
 - 2 - 11'-6"
 - 2 - 12'-0"
 - 2 - 12'-6"
 - 2 - 13'-0"
 - 2 - 13'-6"

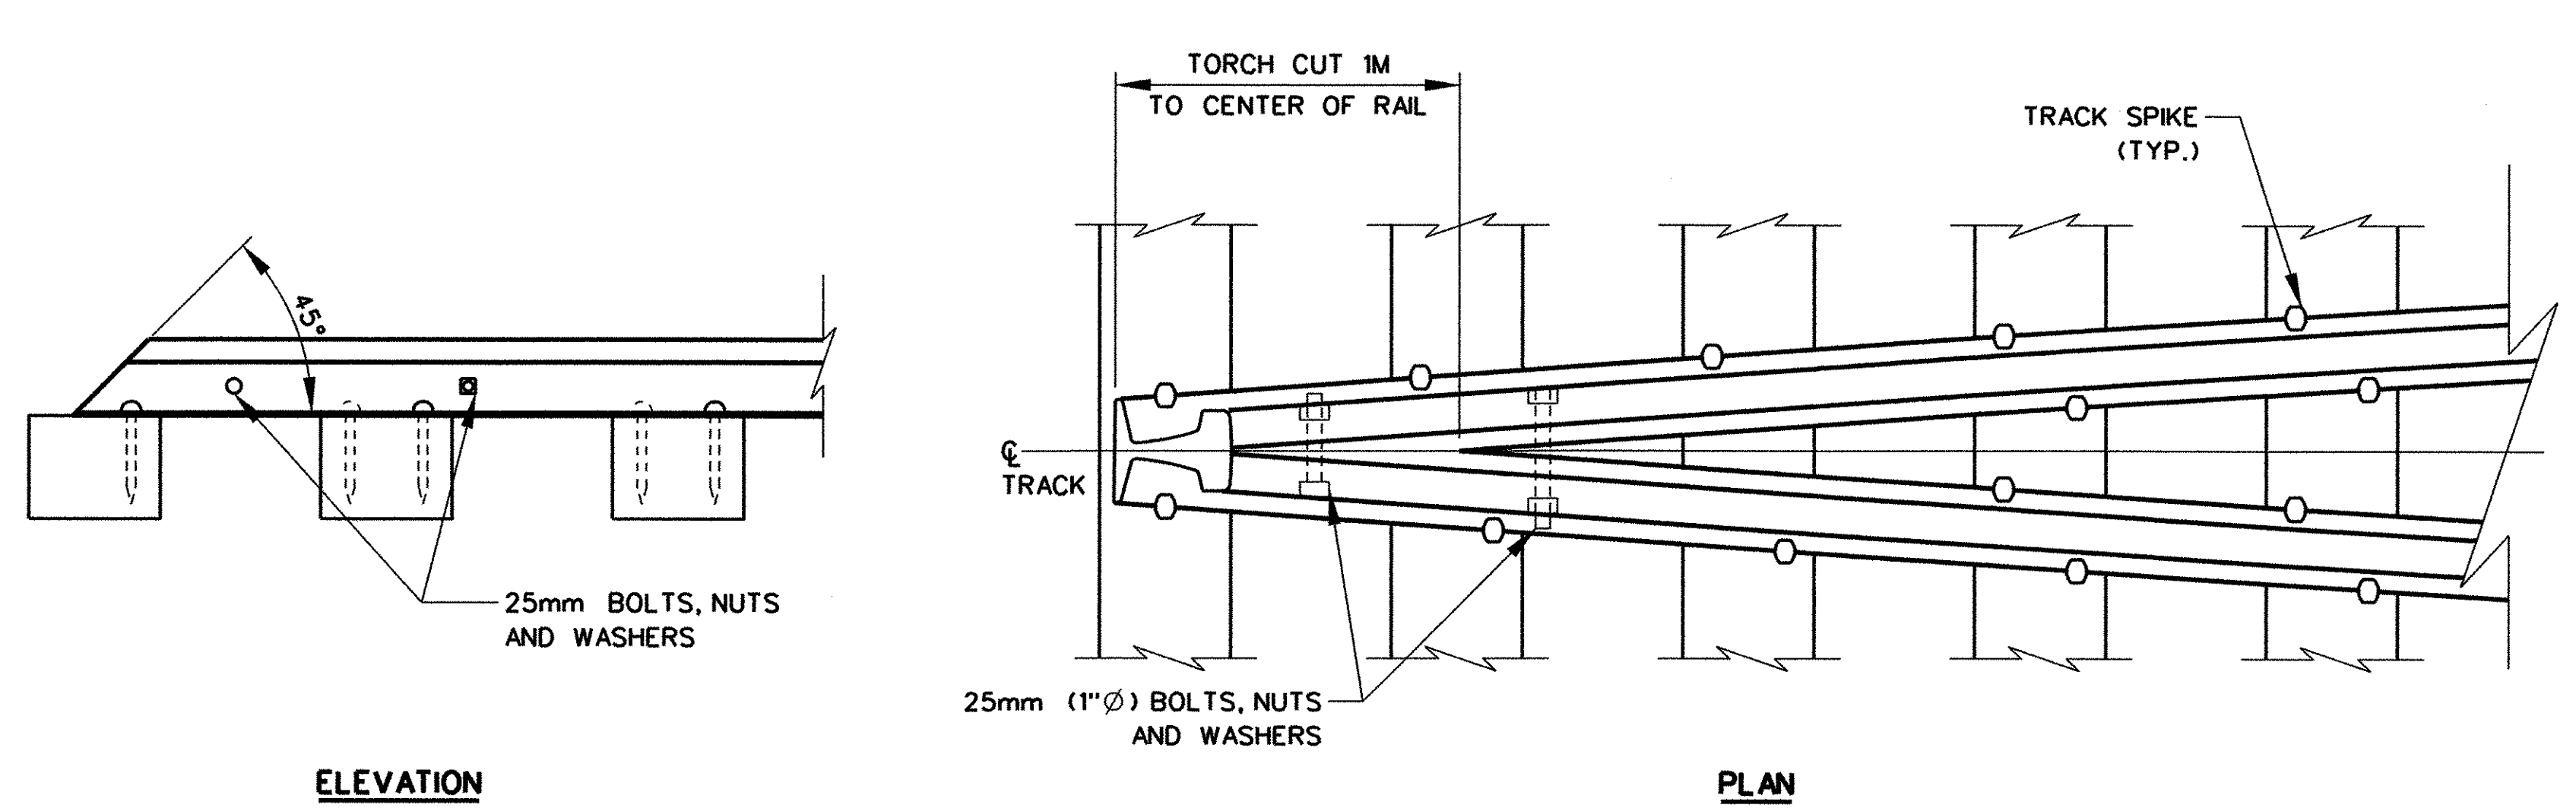

NOTE: WORK SHOWN HERE IS TO BE PERFORMED BY OTHERS UNDER RAILROAD FORCE ACCOUNT.

**STATE OF VERMONT
 AGENCY OF TRANSPORTATION**

Town Of	BRATTLEBORO	Bridge No.	62.56
Highway No.	VT. ROUTE 9	Log Sta.	
		Surv. Sta.	
ROUTE 9 BRIDGE			
BRIDGE APPROACH TIMBERS & GUARD RAIL			
Designed By	JHR	Drawn By	LRD
Checked By	JHR	Bridge Design Supervisor	JHR
	Date		Date
PROJECT	BRATTLEBORO	PROJECT NO.	NH 010-2(2)
I.G.C. Info.			
Bridge Sheet No. 16		Sheet 84 of 145	

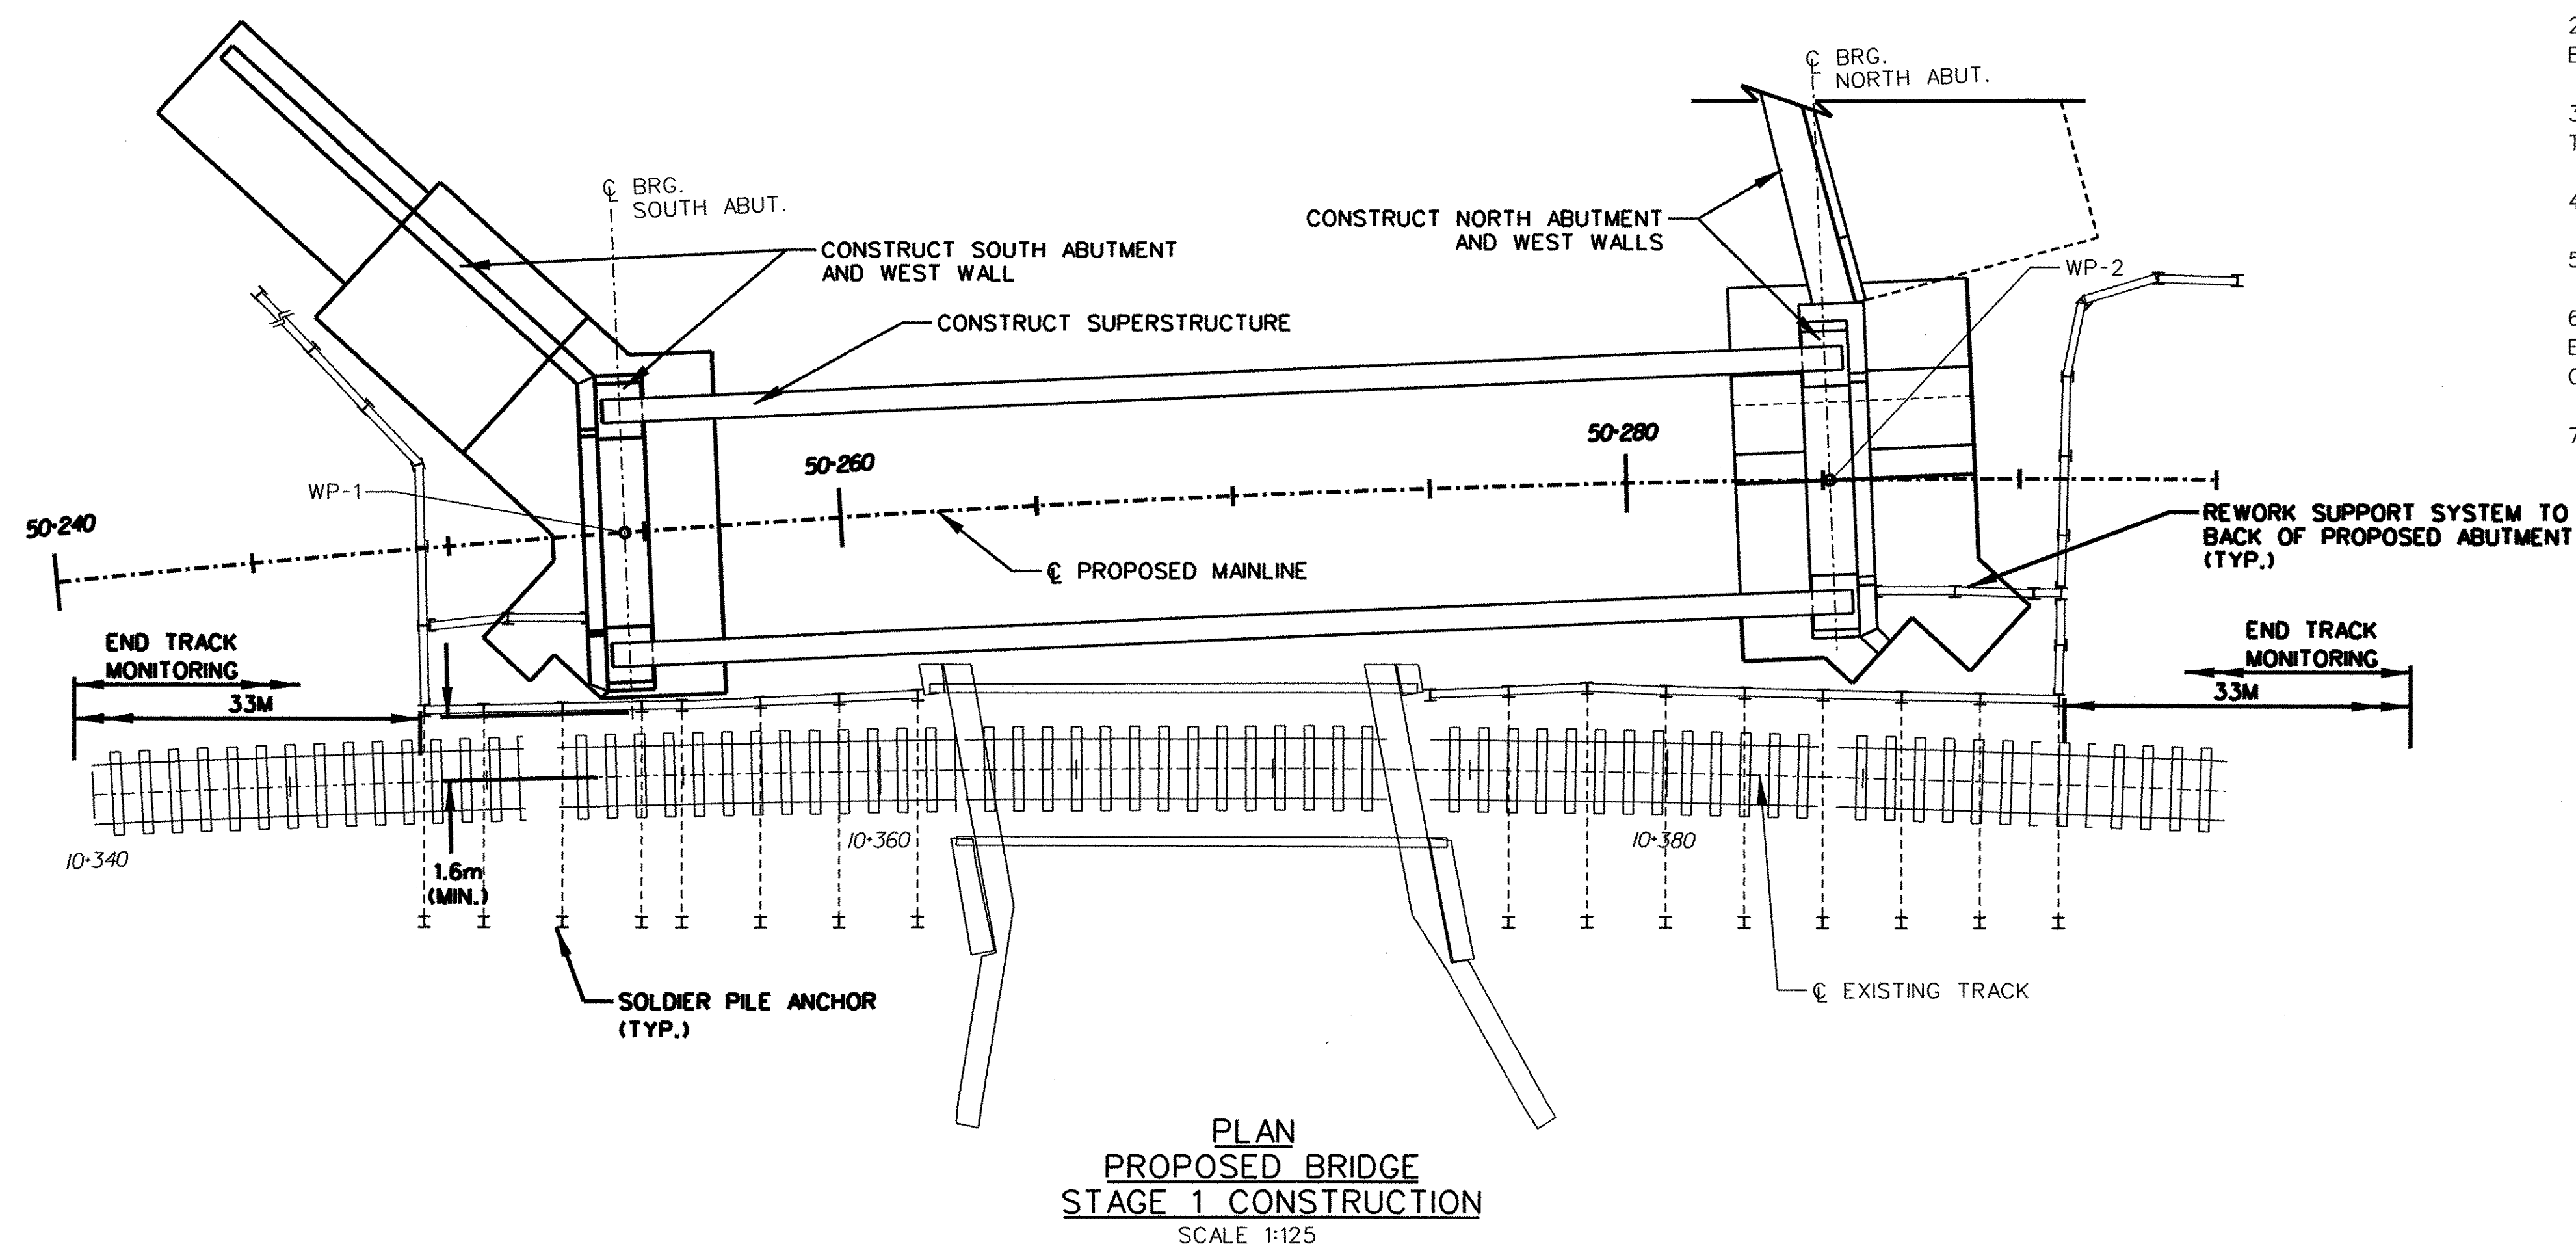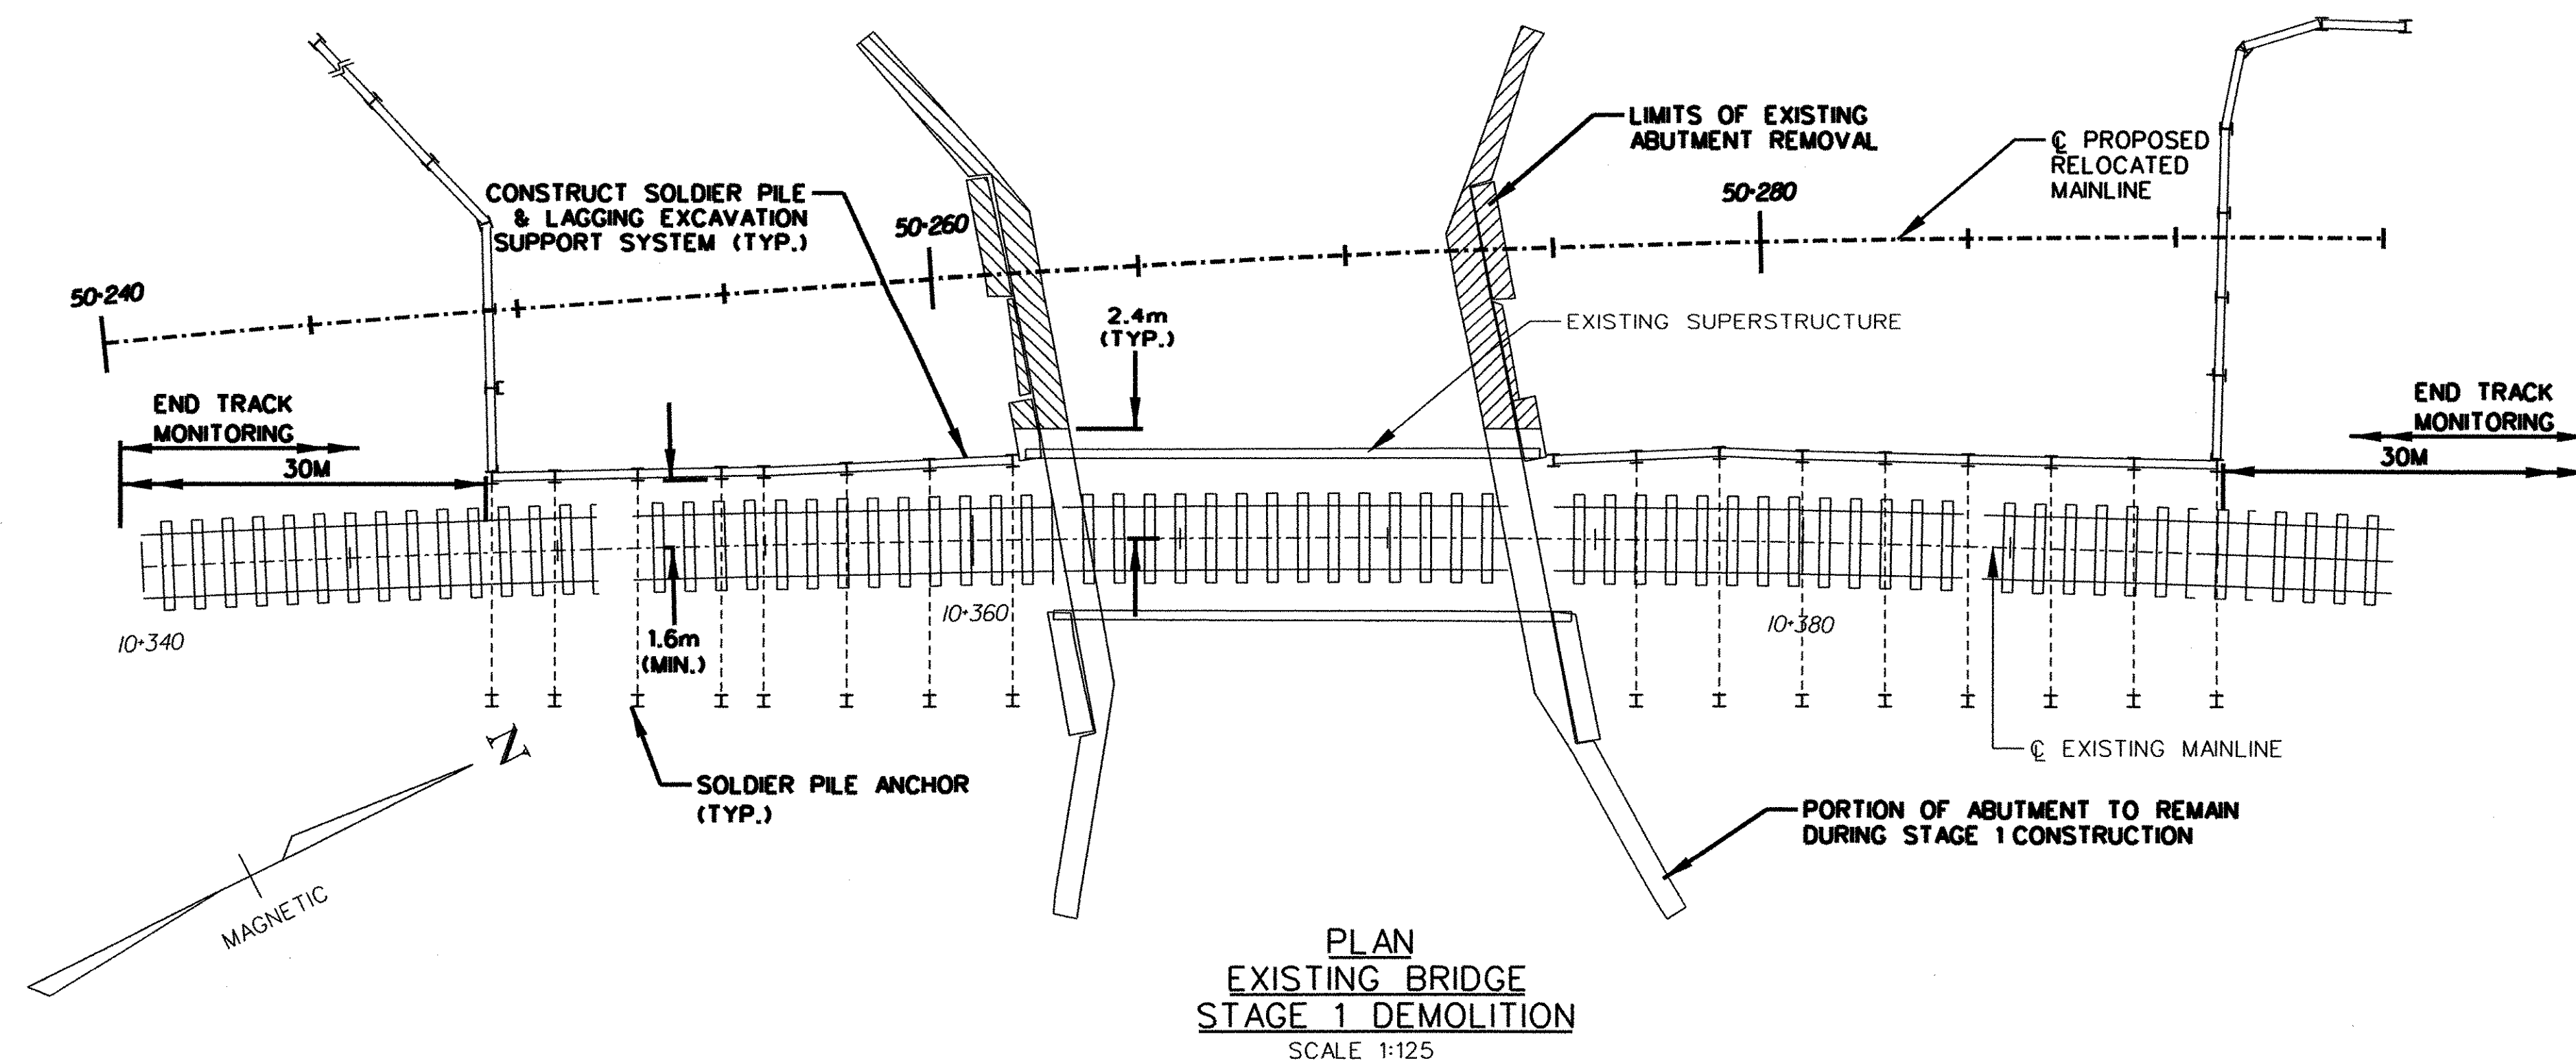

NOTES:

THE SEQUENCE OF CONSTRUCTION TO FOLLOW IS ONLY A SUGGESTED SEQUENCE. THE CONTRACTOR MAY MODIFY CONSTRUCTION STAGING SUBJECT TO THE APPROVAL OF THE ENGINEER.

SUGGESTED SEQUENCE OF CONSTRUCTION

STAGE 1 - DEMOLITION

1. INSTALL SOLDIER PILES ADJACENT TO THE EXISTING TRACK AND BRIDGE ABUTMENTS. THE SOLDIER PILES SHALL BE INSTALLED IN A LEDGE SOCKET AT LEAST 1.5m BELOW THE ADJACENT PROPOSED BOTTOM OF FOOTING.
2. EXCAVATE AND INSTALL LAGGING BETWEEN THE SOLDIER PILES DOWN TO THE FIRST LEVEL WALER. INSTALL WALERS AND TIE BACKS AS NECESSARY AND THEN CONTINUE EXCAVATION TO NEXT LEVEL OF WALERS.
3. AT THE LEDGE INTERFACE PROVIDE SUITABLE SUPPORT TO RETAIN THE SOIL.
4. CONTINUE LEDGE EXCAVATION USING CONTROLLED BLASTING TECHNIQUES, OR OTHER APPROVED MATERIALS, TO THE PROPOSED BOTTOM OF ABUTMENT FOOTING. THE CONTROLLED BLASTING PROCEDURES MUST BE APPROVED BY THE NEW ENGLAND CENTRAL RAILROAD (NECR) PRIOR TO THE PERFORMANCE OF ANY BLASTING ADJACENT THE RAILROAD. (SEE GENERAL NOTES FOR ADDITIONAL INFORMATION)
5. DEMOLISH THE PORTION OF THE EXISTING CONCRETE ABUTMENT IN PREPARATION FOR THE CONSTRUCTION OF THE PROPOSED RAILROAD BRIDGE. (SEE STAGING PLANS AND ELEVATIONS FOR SUGGESTED LIMITS)


STAGE 1 - CONSTRUCTION

1. CONSTRUCT THE PROPOSED BRIDGE ABUTMENTS AND WESTERLY WING WALLS.
2. ERECT THE BRIDGE SUPERSTRUCTURE USING AN ERECTION PLAN APPROVED BY THE ENGINEER AND THE NECR.
3. INSTALL SOLDIER PILE AND LAGGING CUT OFF BETWEEN THE NEW ABUTMENT AND THE TEMPORARY SUPPORT WALL, BRACE AS NECESSARY.
4. BACKFILL BEHIND THE NEW ABUTMENT TO SUBGRADE.
5. PERFORM FULL DEPTH TRACK CONSTRUCTION FROM RAILROAD STATION 50-200 TO 50-500.
6. CONSTRUCT SUBGRADE, AND BALLAST TO CUT AND THROW TRACK AT SOUTH AND NORTH ENDS IN TRANSITION SECTIONS ONTO NEW PROPOSED ALIGNMENT DURING A PREARRANGED CONSTRUCTION WINDOW WITH THE NECR.
7. INITIATE RAILROAD OPERATIONS ON THE NEW TRACK ALIGNMENT.

PROJECT NAME: BRATTLEBORO
PROJECT NUMBER: NH 010-2(2)

FILE NAME: r19br101
PROJECT LEADER: JHR
DESIGNED BY: GHB

PLOT DATE: 10-02-2002
DRAWN BY: DHL
CHECKED BY: TEM
SHEET 85 OF 145

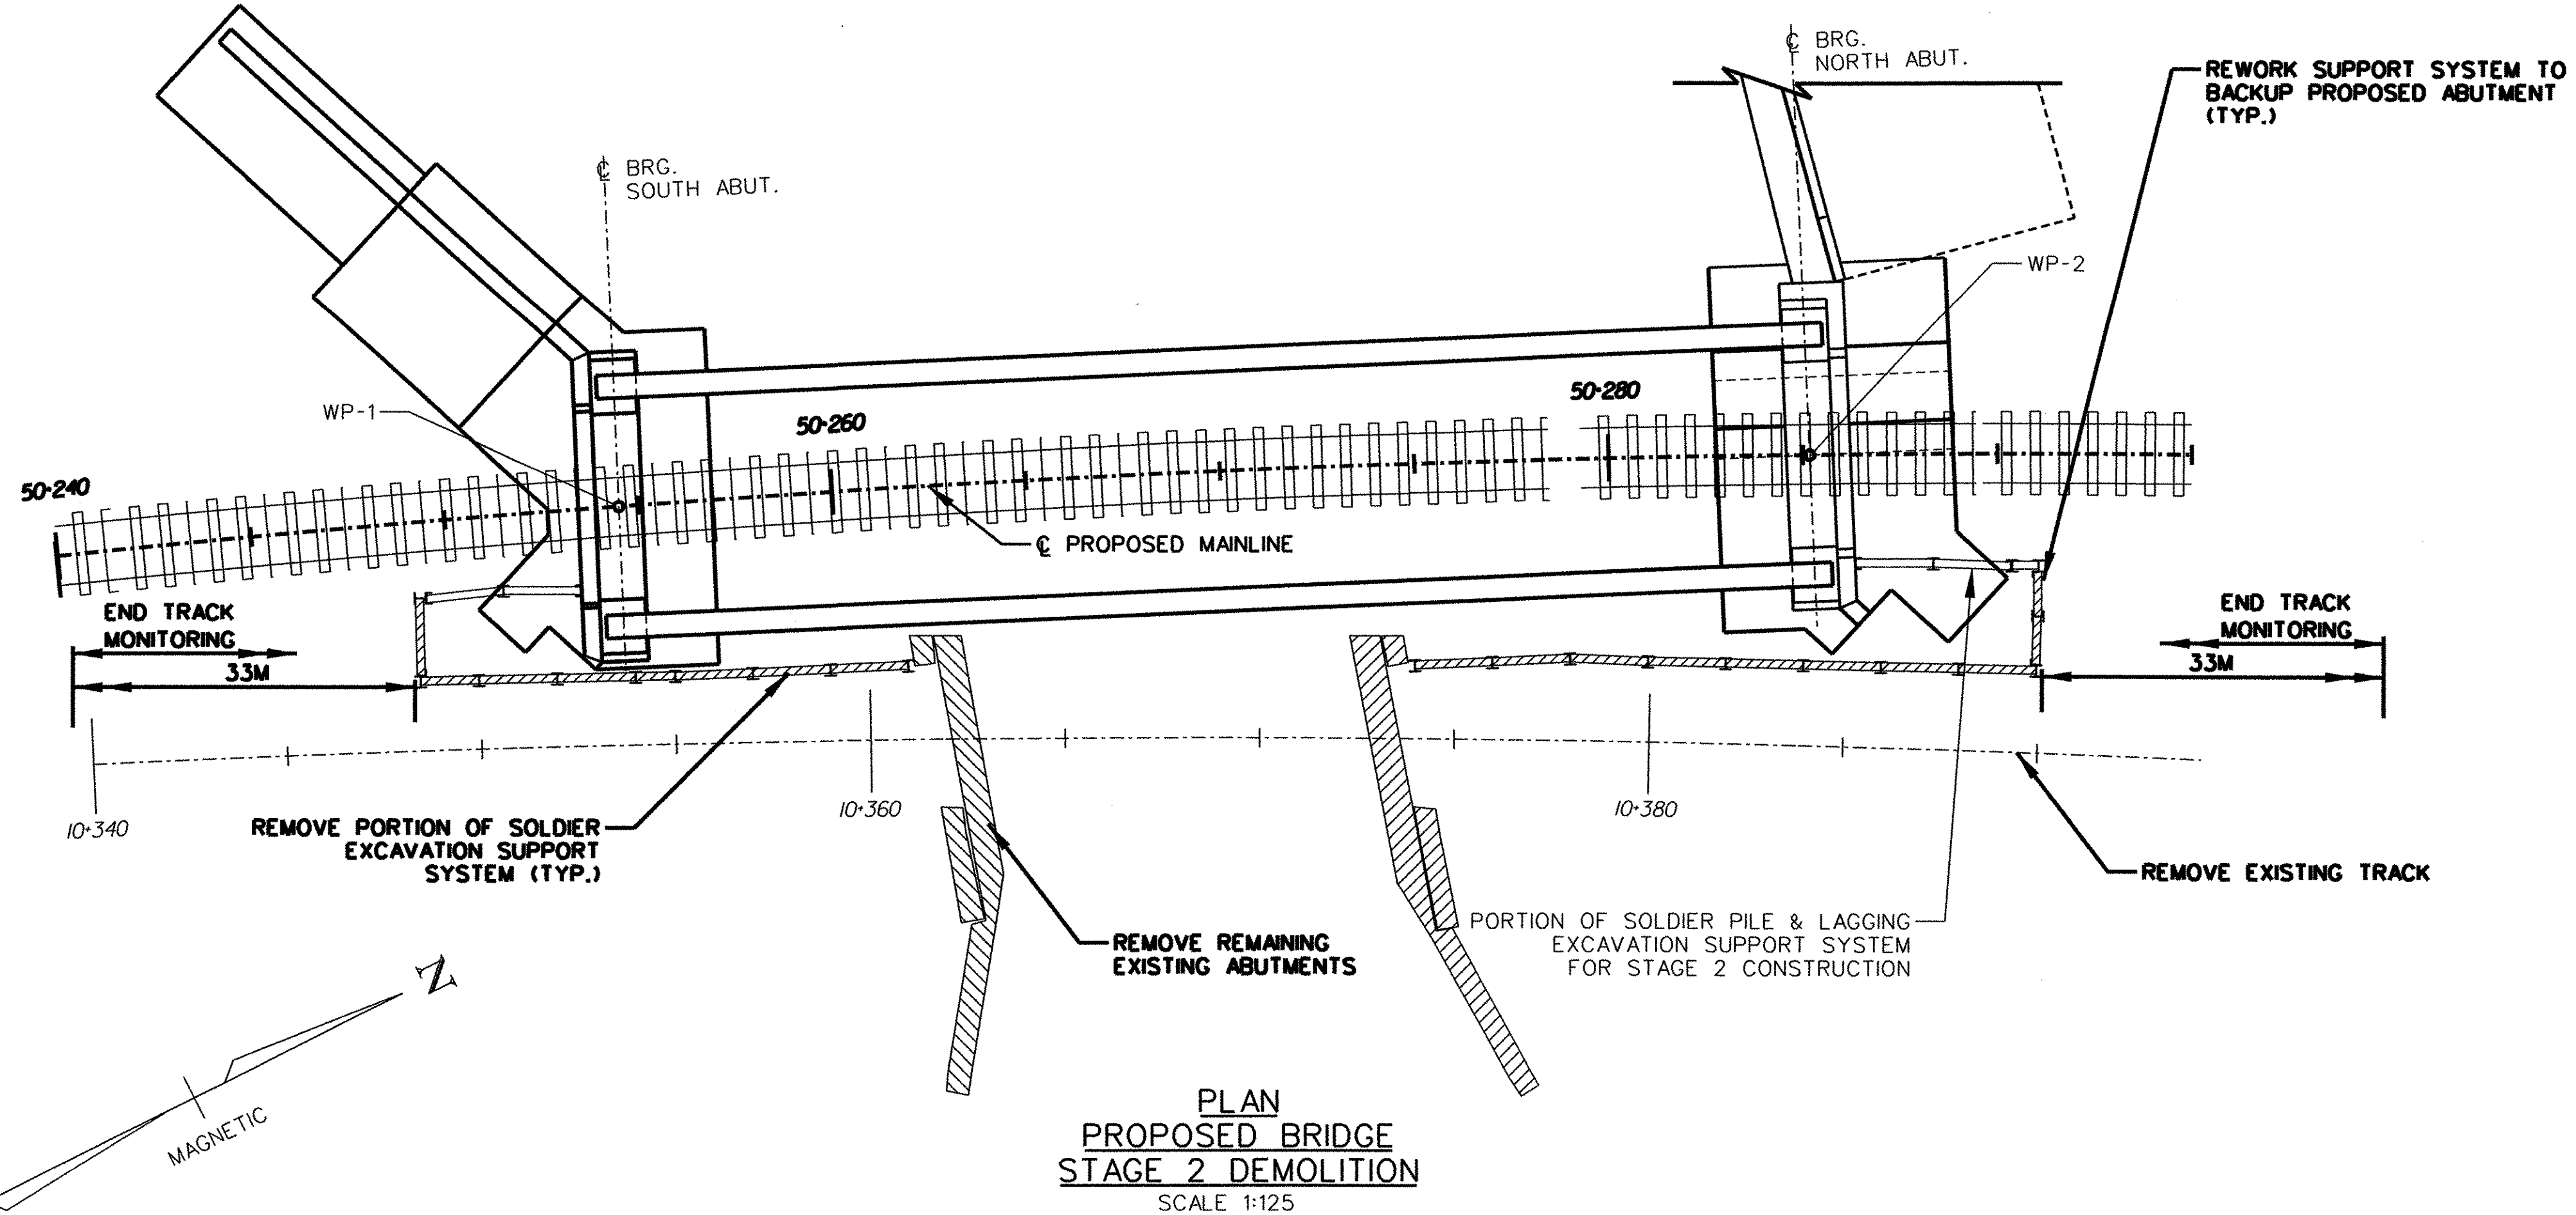


STAGE 2 - DEMOLITION


1. REMOVE EXISTING TRACK, SOLDIER PILE, AND LAGGING AS NECESSARY.
2. PROCEED WITH EXCAVATION ON THE EAST SIDE OF THE TEMPORARY SOLDIER PILE AND LAGGING WALL, SUPPORT LAGGING AS NECESSARY.
3. INSTALL WALERS AND TIE BACKS AND THEN CONTINUE EXCAVATION TO THE NEXT LEVEL OF WALERS.
4. COMPLETE EXCAVATION TO BOTTOM OF ABUTMENT WINGWALL AND FOOTING TO INCLUDE DEMOLITION OF THE REMAINING PORTION OF THE EXISTING ABUTMENT.

STAGE 2 - CONSTRUCTION

1. CONSTRUCT REMAINING PORTION OF THE ABUTMENT AND WINGWALL.
2. BACKFILL BEHIND ABUTMENT AND WINGWALL REMOVING LAGGING AND WALERS DURING BACKFILLING OPERATION.
3. CUT OFF SOLDIER PILES AT 1M BELOW TOP OF RAIL AND COMPLETE BACKFILL.

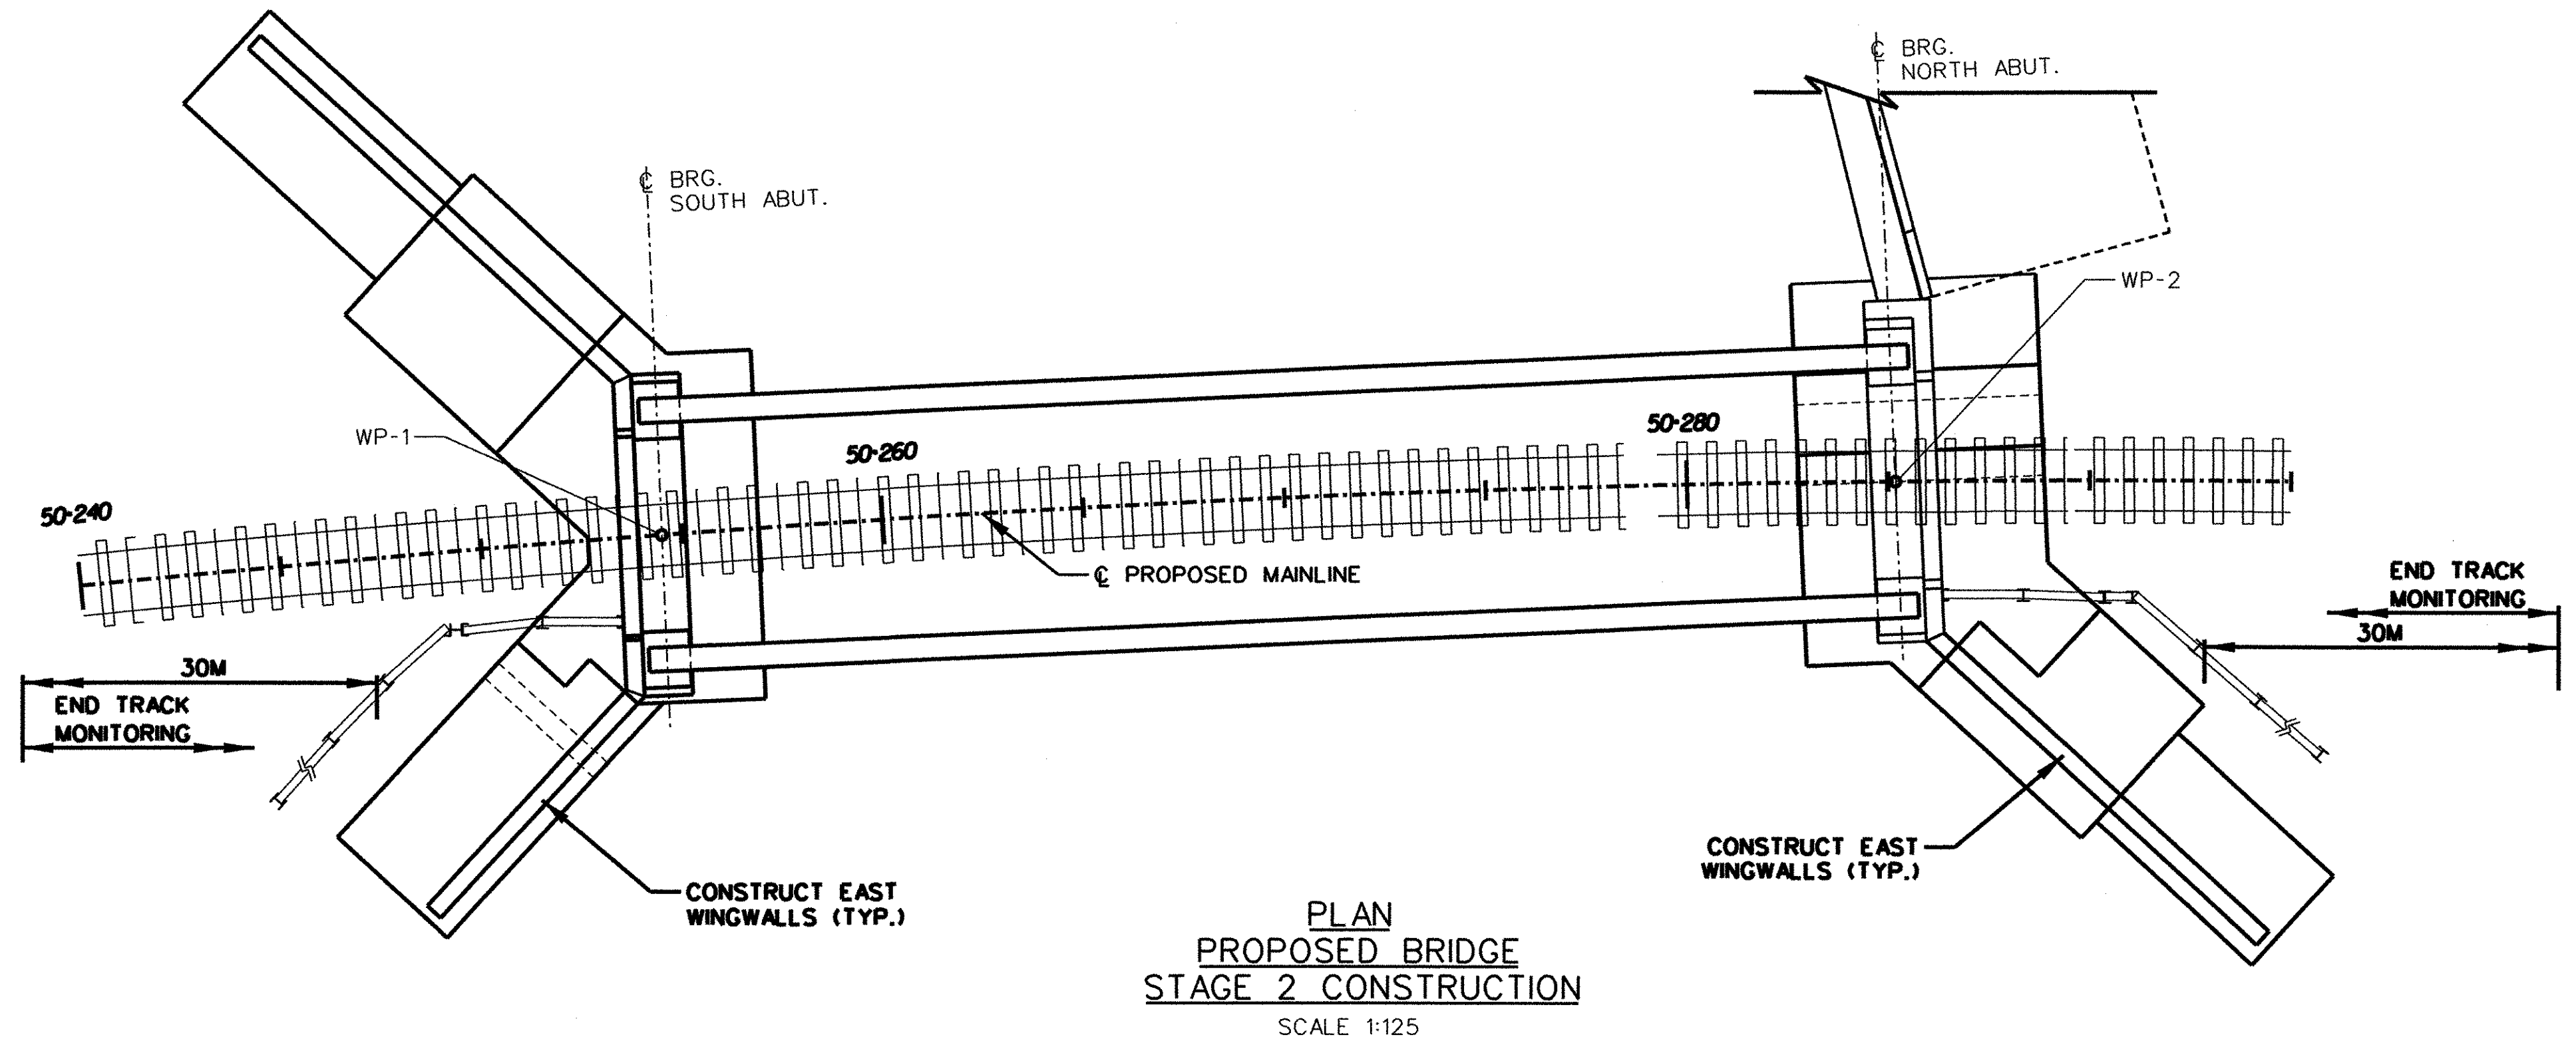


PROJECT NAME: BRATTLEBORO	
PROJECT NUMBER: NH 010-2(2)	
FILE NAME: rt9br101	PLOT DATE: 10-02-2002
PROJECT LEADER: JHR	DRAWN BY: DHL
DESIGNED BY: GHB	CHECKED BY: TEM
SHEET 86 OF 145	

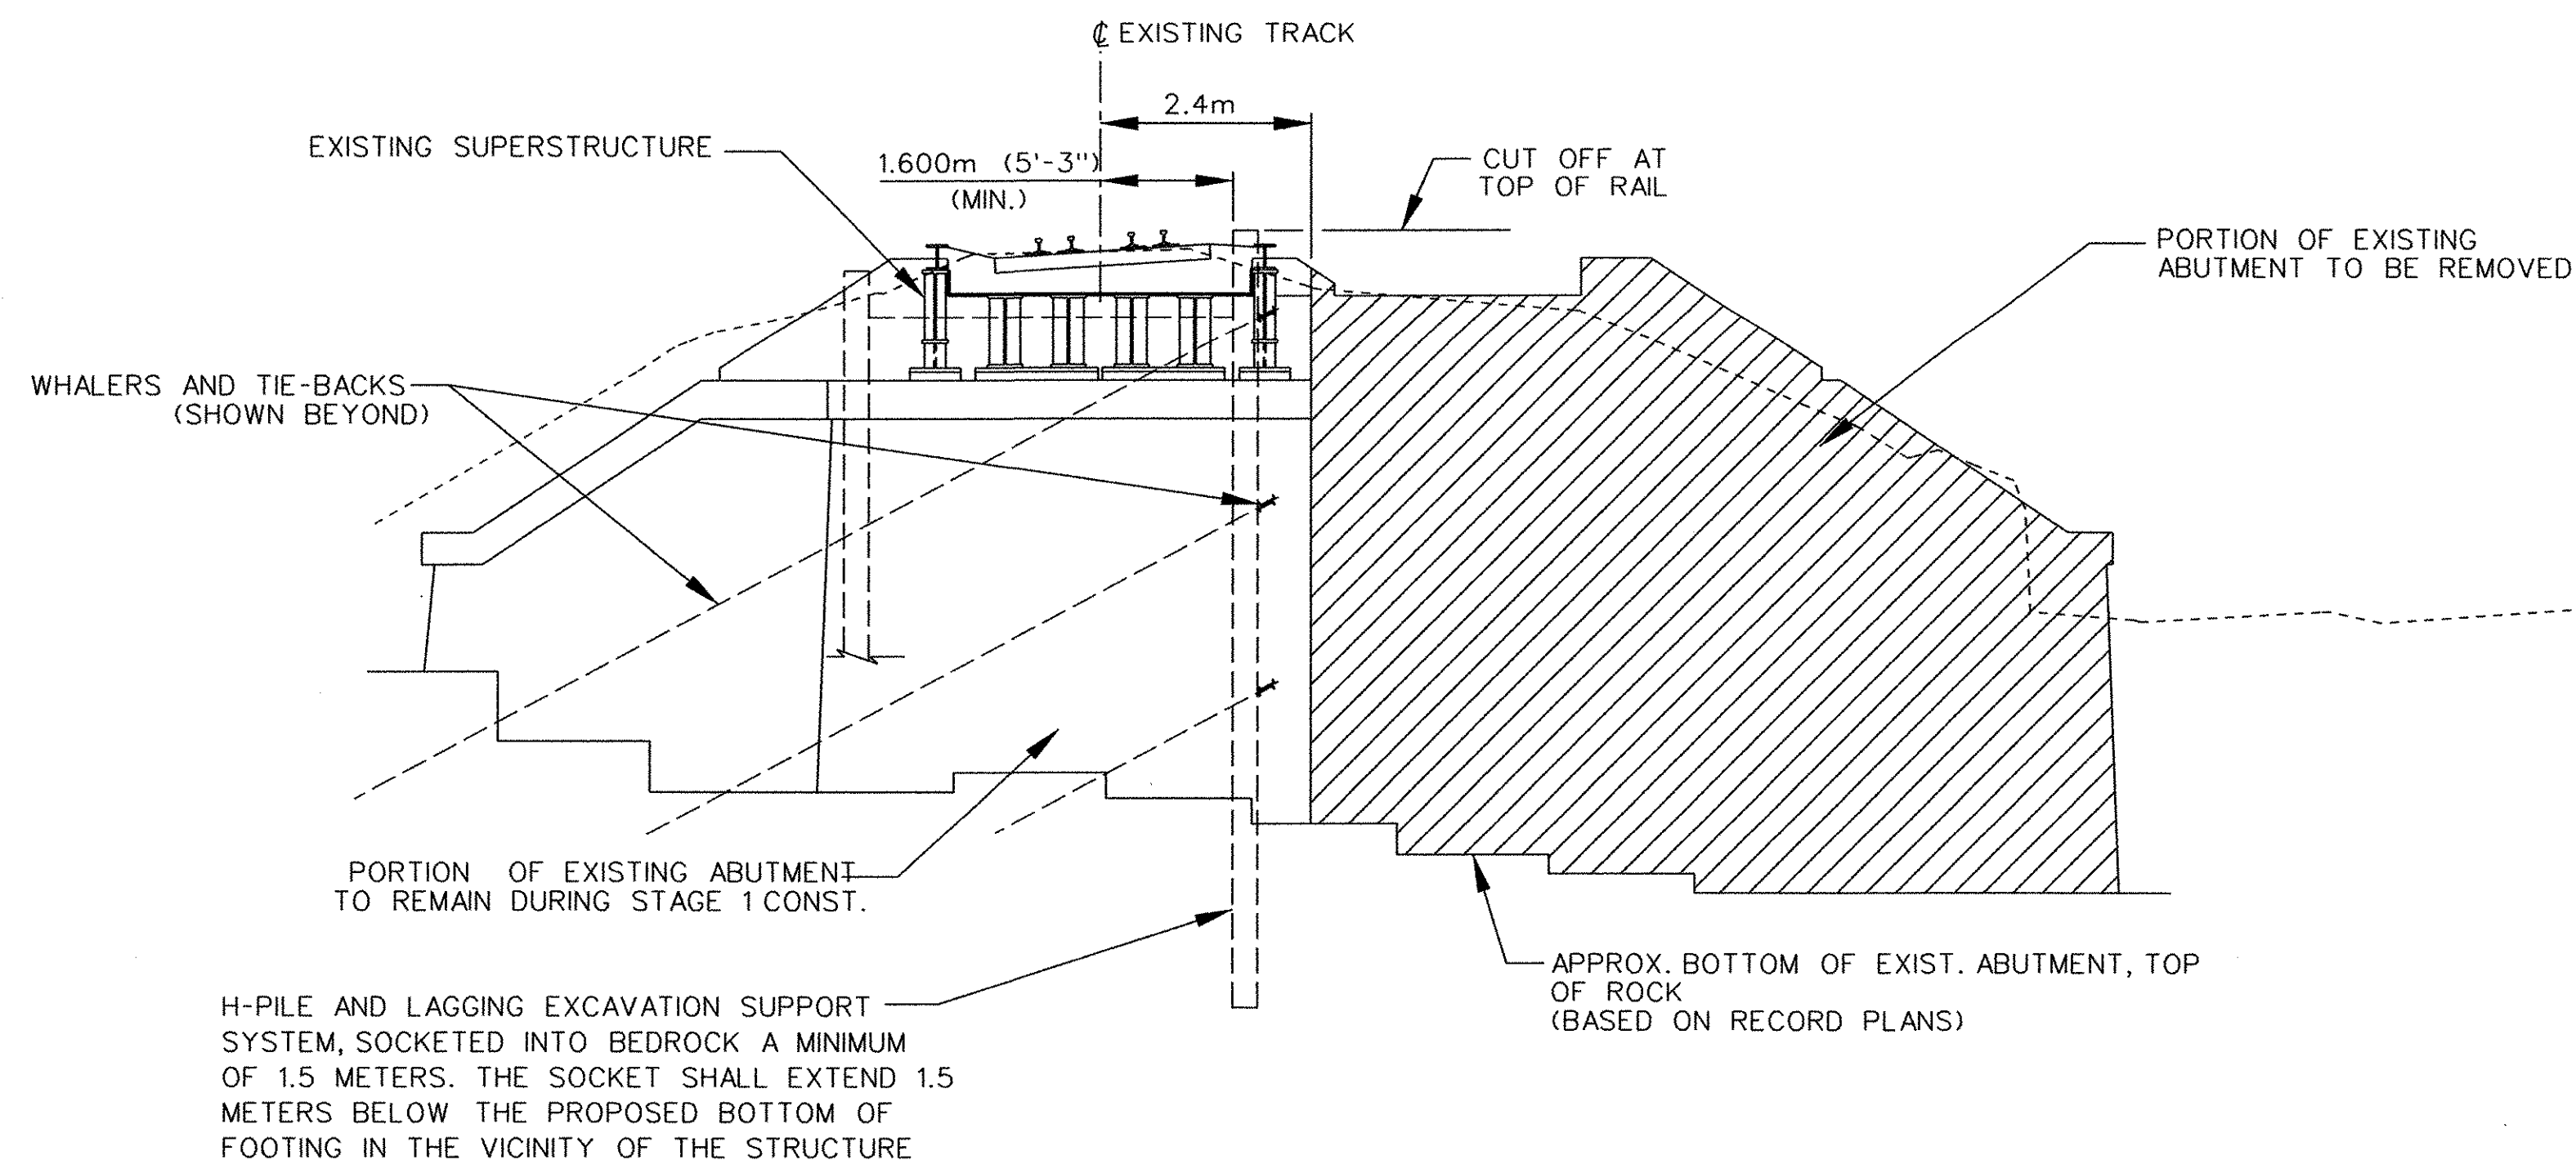

**ELEVATION
EXISTING BRIDGE
STAGE 1 - SOUTH ABUTMENT DEMOLITION**
SCALE 1:75



NOTES:

1. Excavation support system shown in schematic. H-Piles with lagging and walers are shown. The contractor is responsible for the design and configuration of the support system. The design and configuration should be submitted for approval.
2. H-Piles and lagging shall be located no closer than 1.6 meters from the existing mainline track center.
3. Special attention will need to be given to the removal of rock adjacent to the excavation support system in the vicinity of the proposed abutments. Controlled blasting, hydraulic splitting, or other acceptable methods of rock removal shall be used.

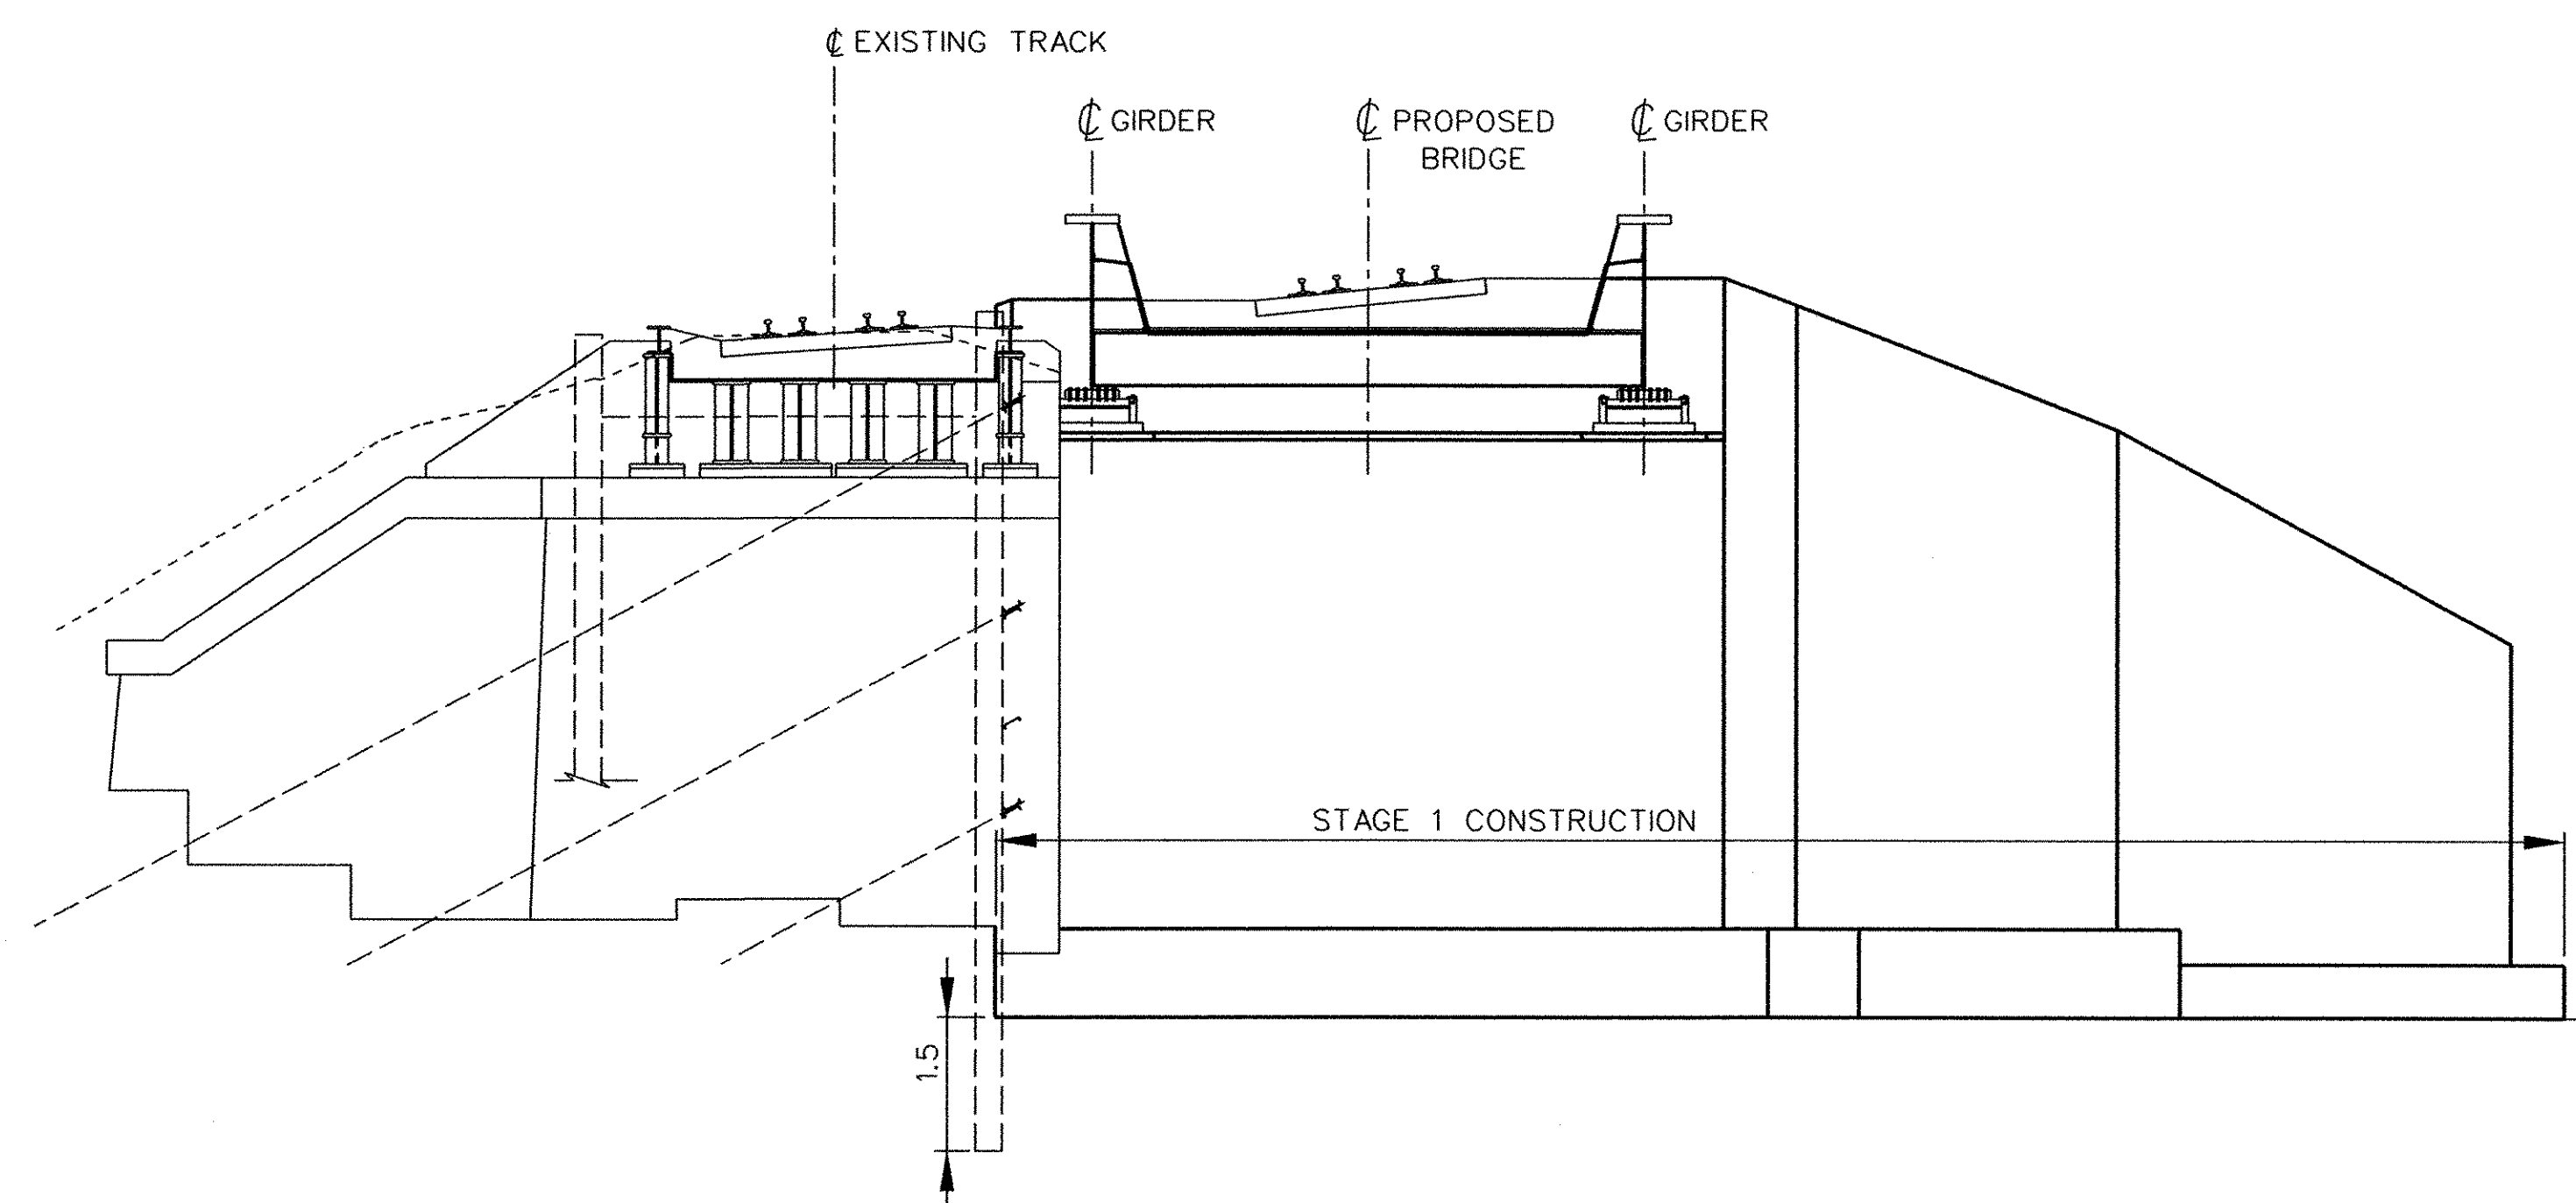


**ELEVATION
PROPOSED BRIDGE
STAGE 1 - SOUTH ABUTMENT CONSTRUCTION**
SCALE 1:75

STATE OF VERMONT AGENCY OF TRANSPORTATION		
Town Of	BRATTLEBORO	Bridge No. 62.56
Highway No.	VT. ROUTE 9	Log Sta. Surv. Sta.
ROUTE 9 BRIDGE		
CONSTRUCTION STAGING ELEVATIONS		
Designed By	GJB	Drawn By DHL
Checked By	GJB	Bridge Design Supervisor JHR
		Date
PROJECT	BRATTLEBORO	PROJECT NO. NH 010-2(2)
I.G.C. Info.		
Bridge Sheet No. 19		Sheet 87 of 145

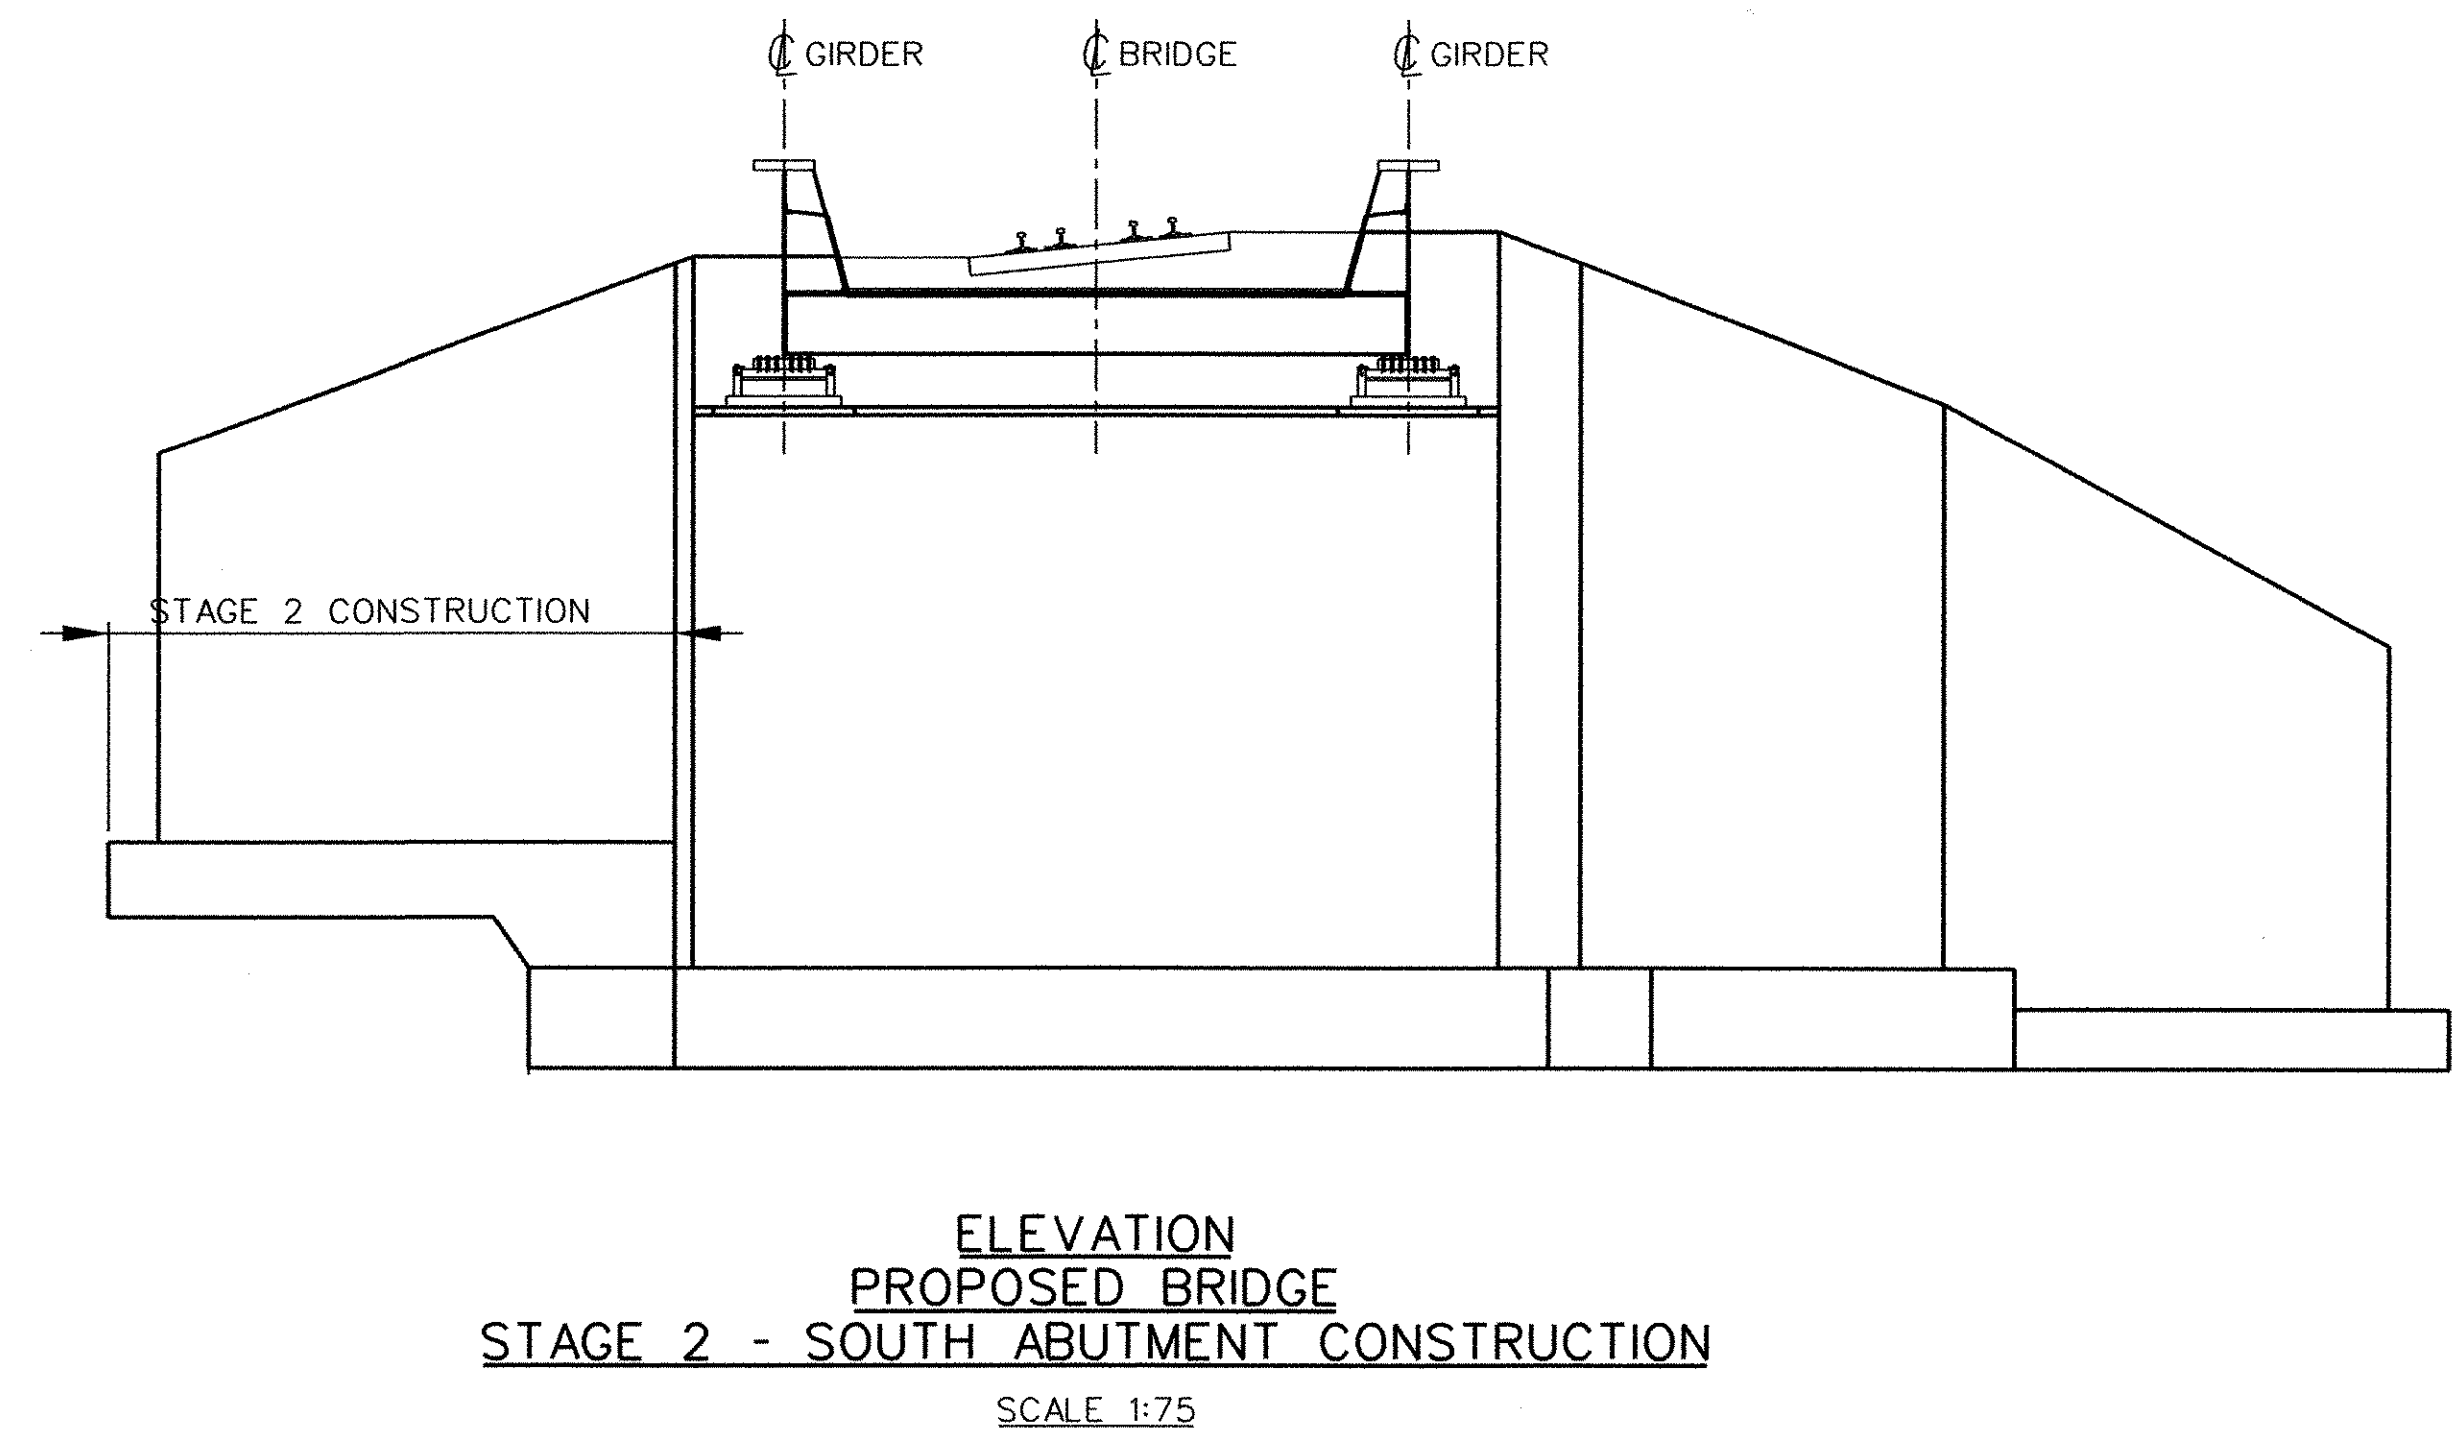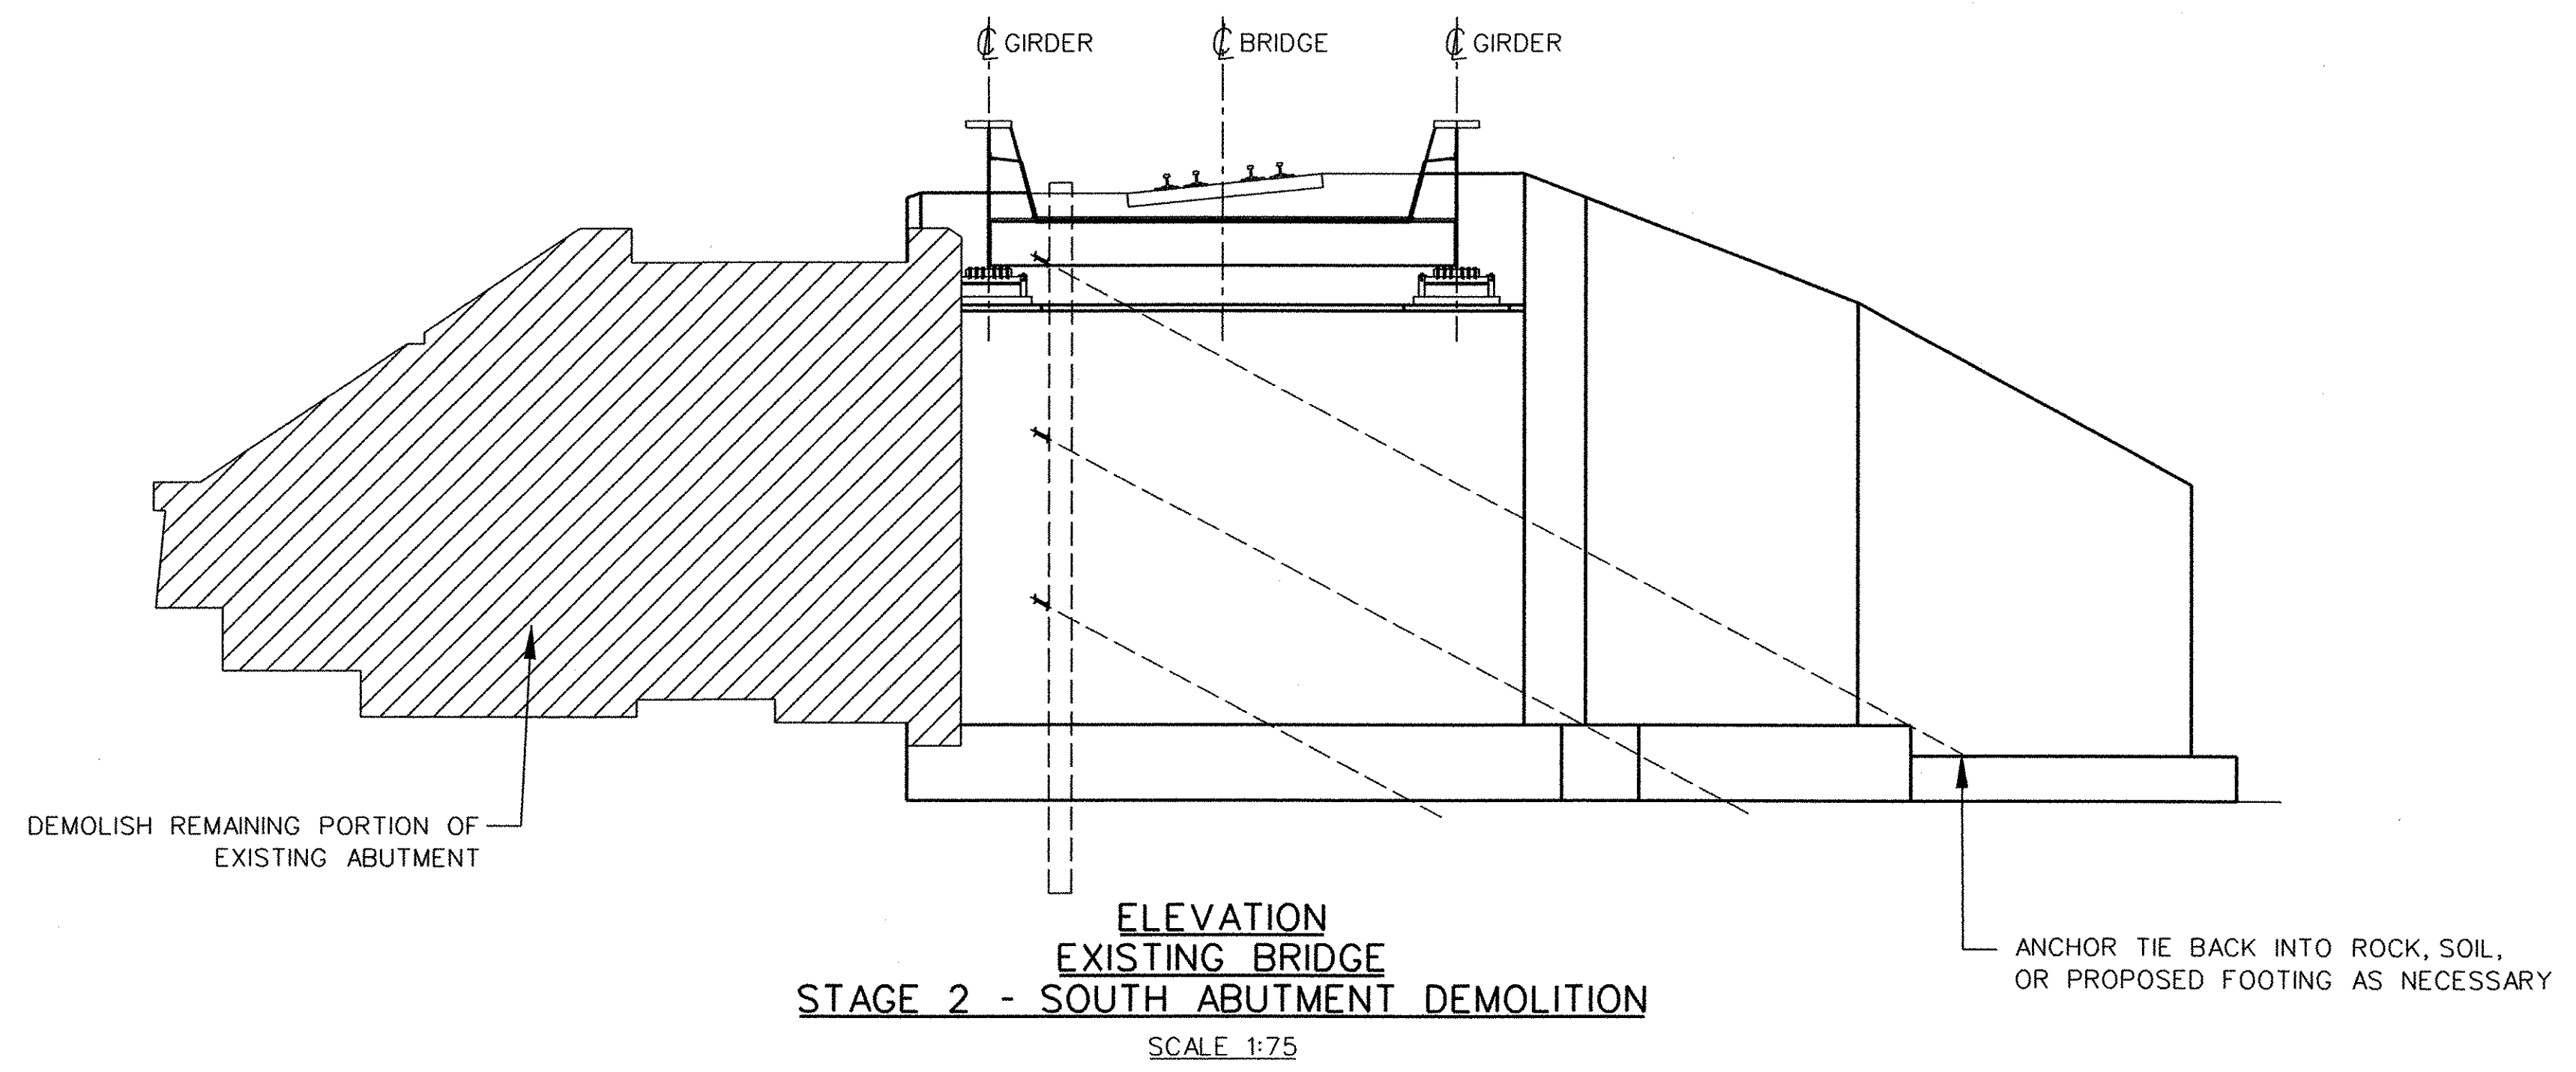

STATE OF VERMONT AGENCY OF TRANSPORTATION		
Town Of	BRATTLEBORO	Bridge No. 62.56
Highway No.	VT. ROUTE 9	Log Sta.
		Surv. Sta.
ROUTE 9 BRIDGE		
CONSTRUCTION STAGING ELEVATIONS		
Designed By	GJB	Drawn By DHL
Checked By	GJB	Bridge Design Supervisor JHR
	Date	Date
PROJECT	BRATTLEBORO	PROJECT NO. NH 010-2(2)
I.G.C. Info.		
Bridge Sheet No. 20		Sheet 88 of 145

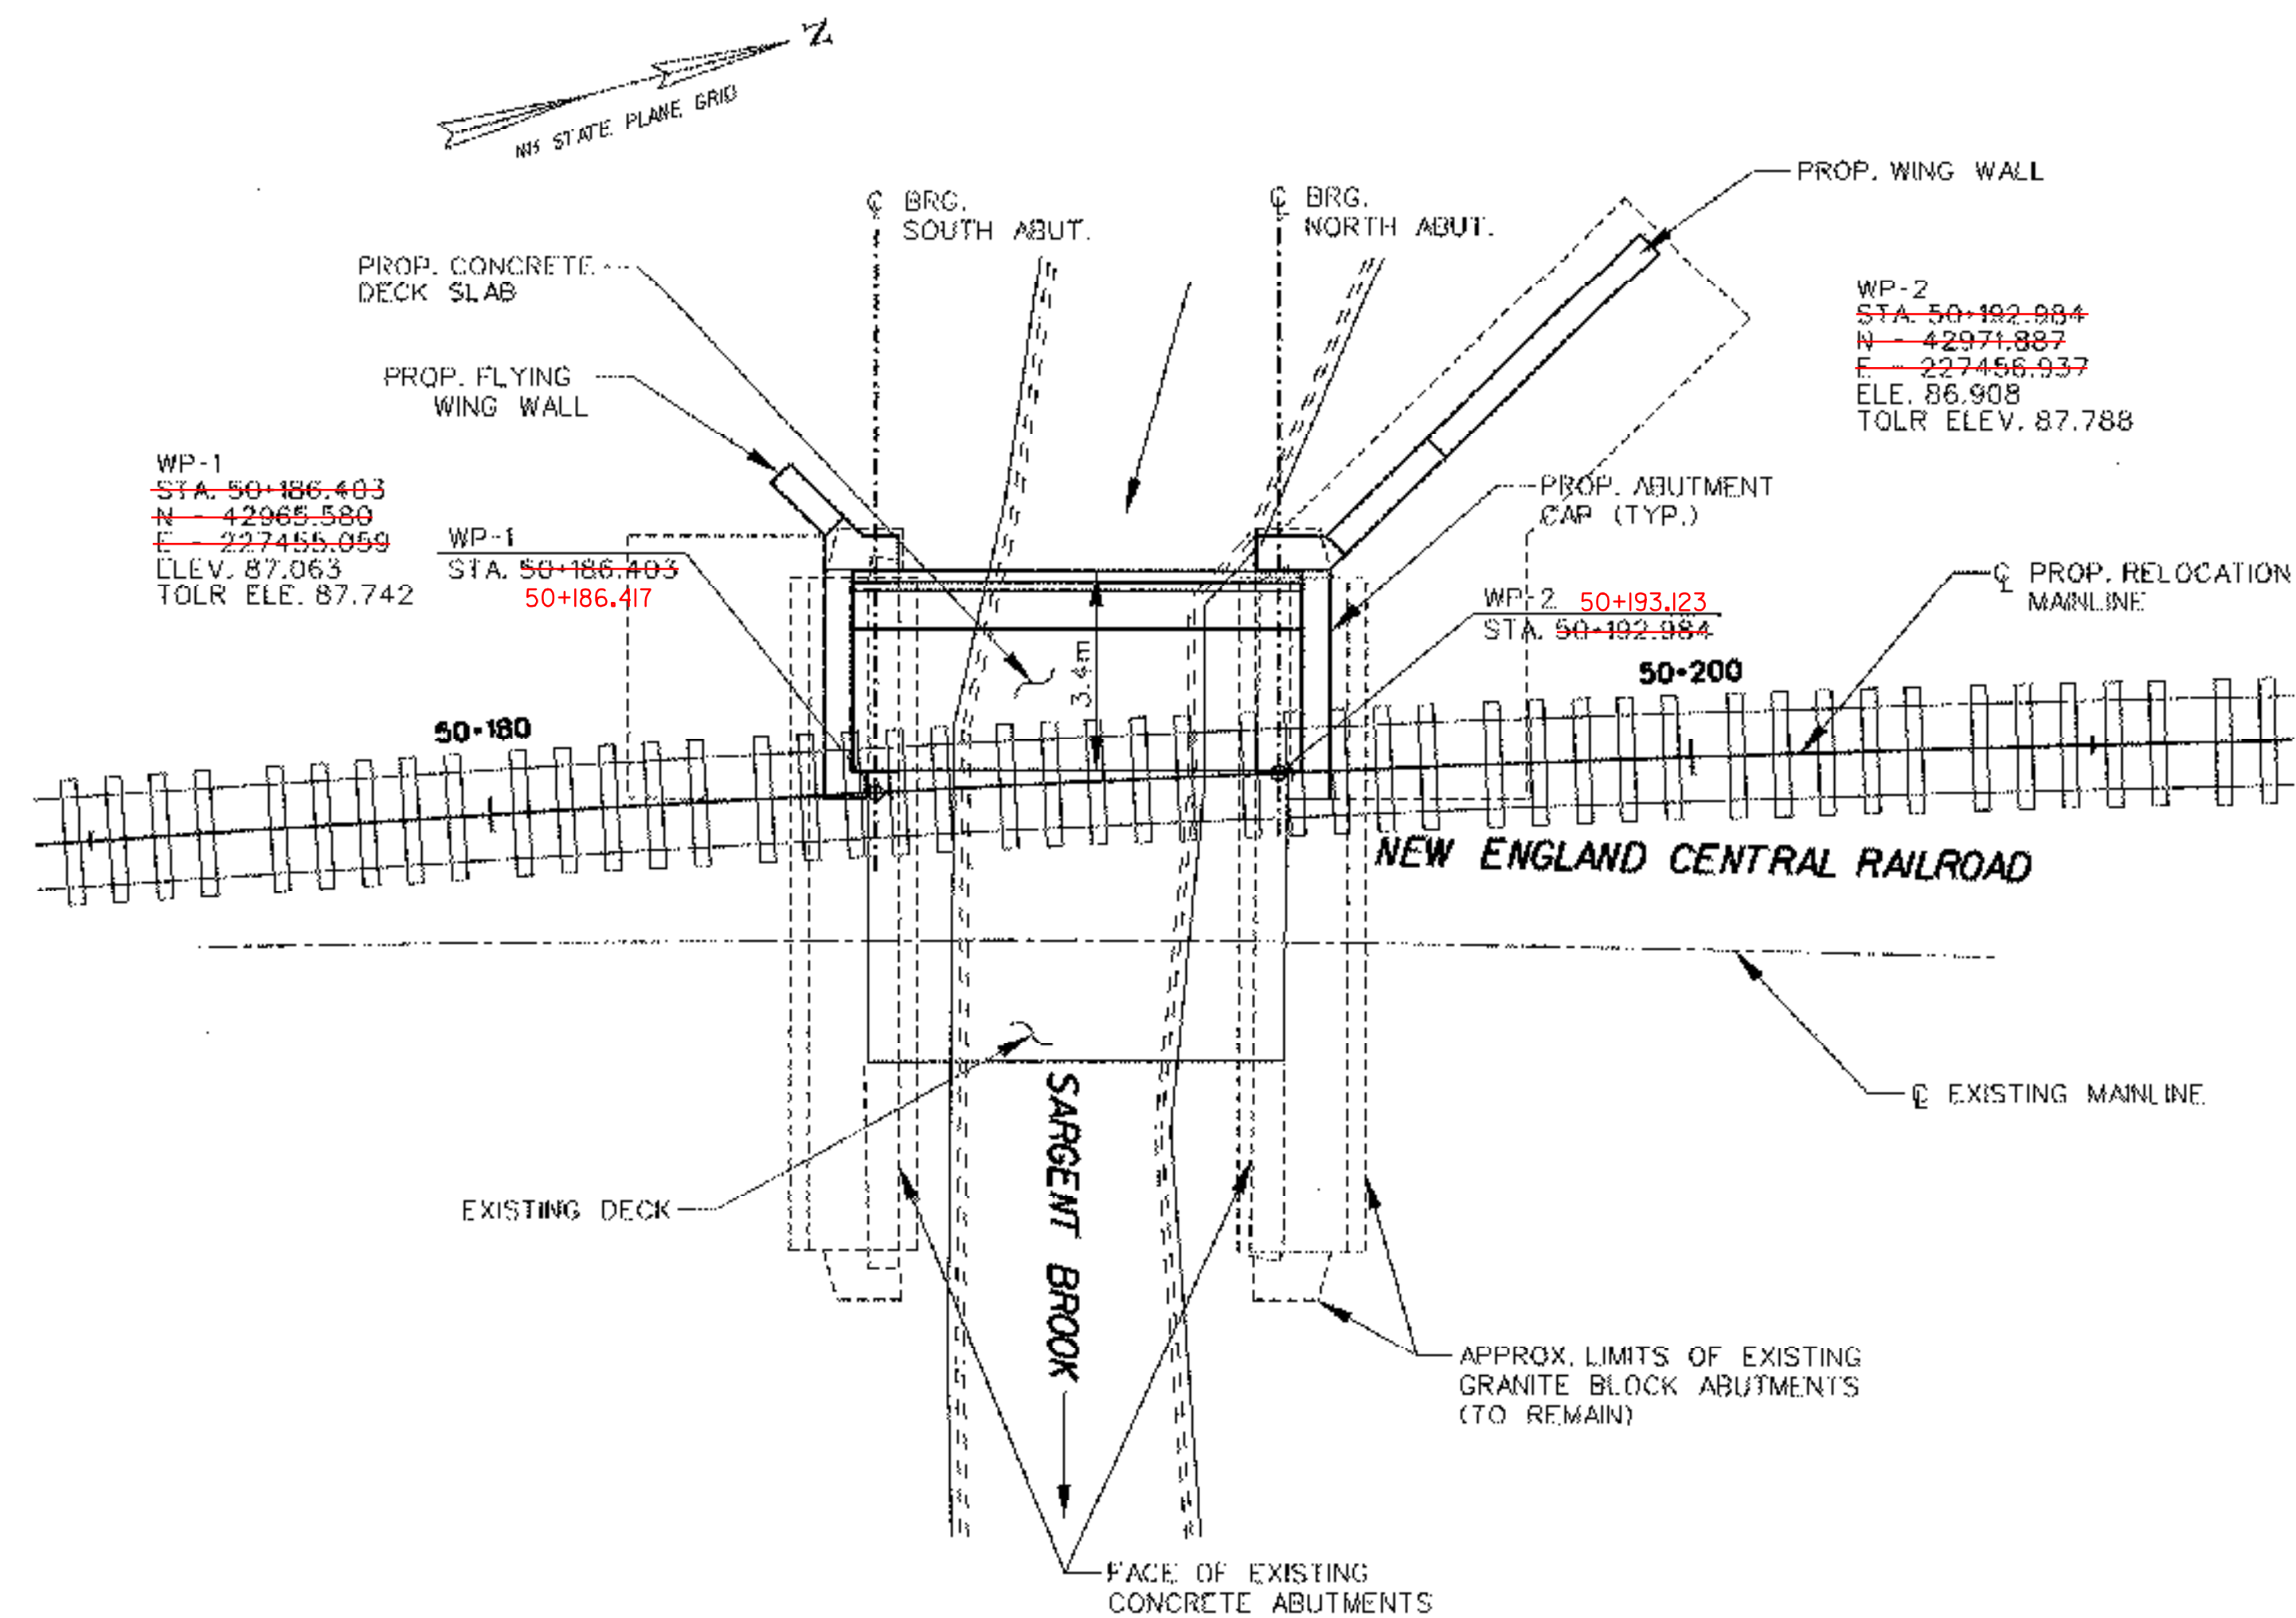

WP-1
~~STA. 50+186.403~~
~~N. 42965.580~~
~~E. 227455.059~~
 LLEV. 87.063
 TOLR. ELE. 87.742


WP-1
 STA. 50+186.403
 50+186.417

WP-2
~~STA. 50+192.984~~
~~N. 42971.887~~
~~E. 227456.937~~
 ELE. 86.908
 TOLR. ELEV. 87.788

WP-2
 50+193.123
~~STA. 50+192.984~~

PLAN


SCALE 1:100

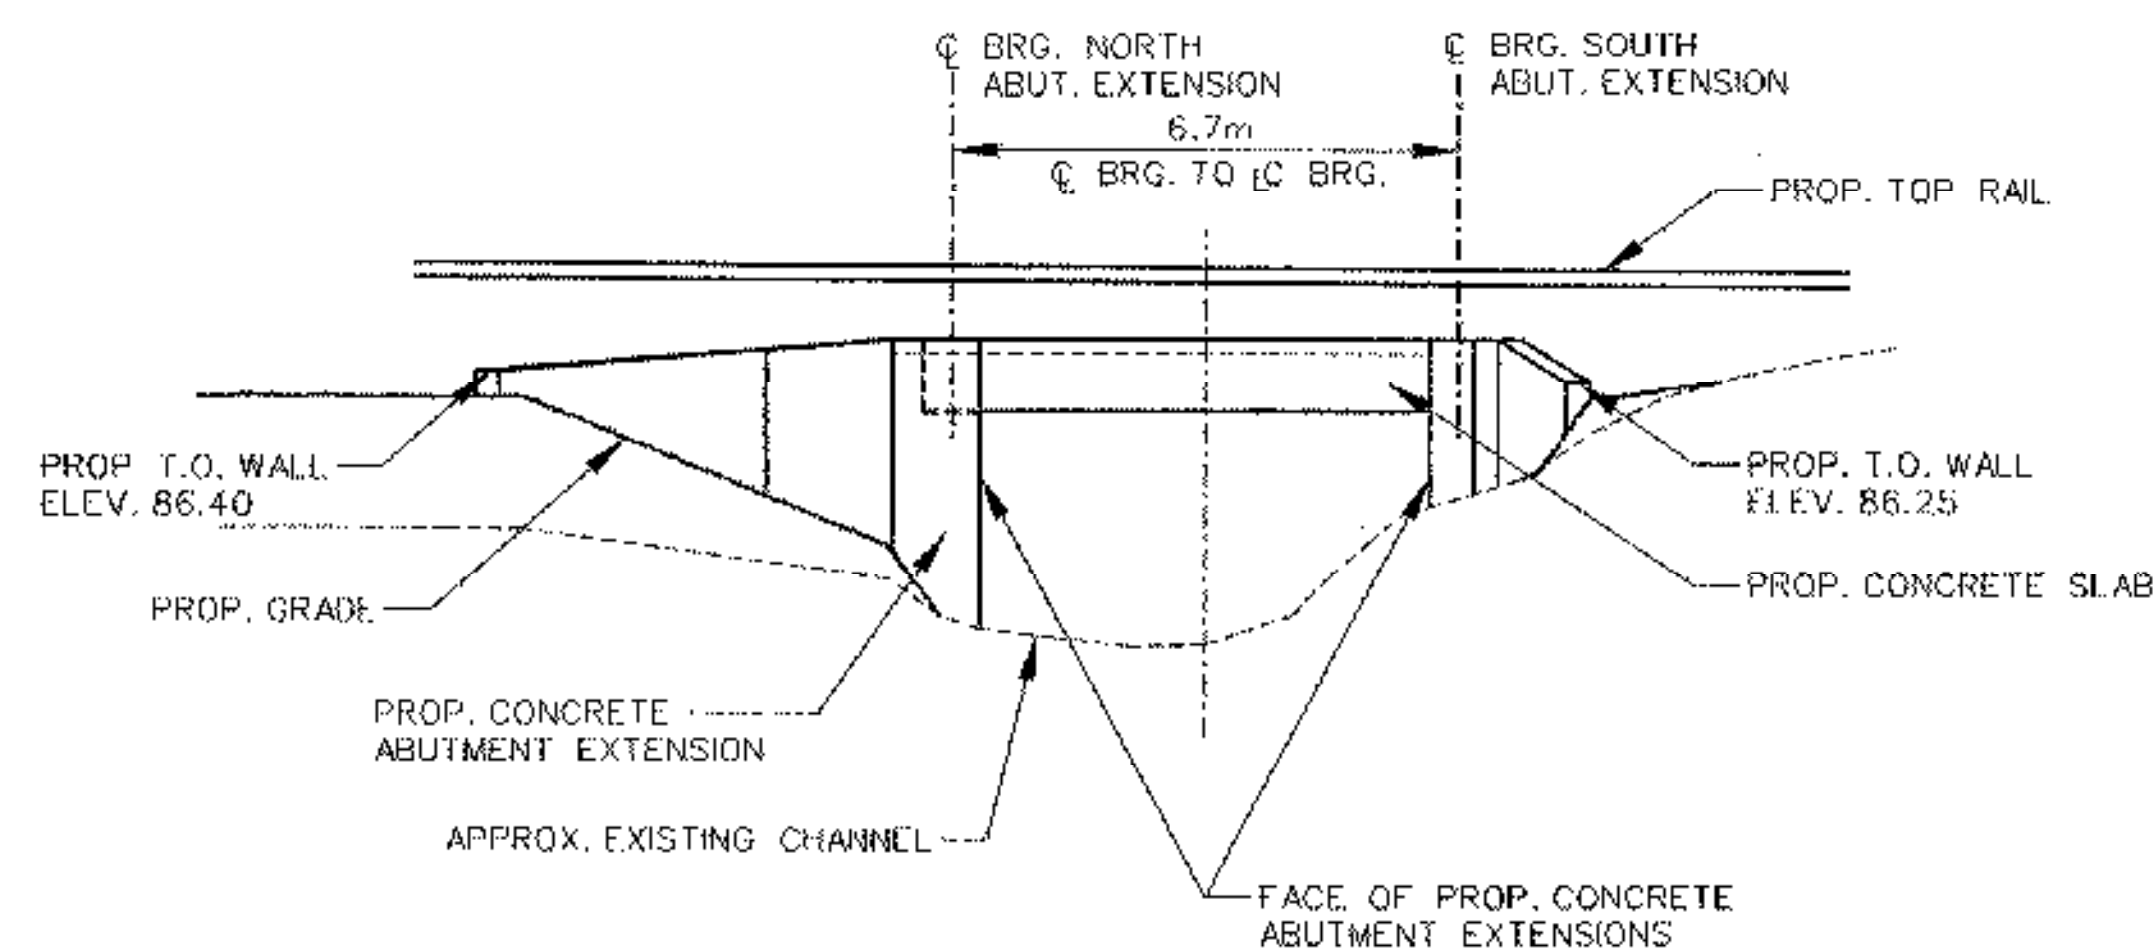


**ELEVATION
 (LOOKING EAST)**

SCALE 1:100

STATE OF VERMONT AGENCY OF TRANSPORTATION		
Town Of	BRATTLEBORO	Bridge No. 62.51
Highway No.	VT. ROUTE 9	Log Sta. Surv. Sta.
SARGENT BROOK		
PLAN & ELEVATION		
Designed By	GJB	Drawn By DHL
Checked By	GJB Date	Bridge Design Supervisor JHR Date
PROJECT	BRATTLEBORO	PROJECT NO. NH BRF 012-1(331)
I.G.C. Info.		
Bridge Sheet No. 1	Sheet 90 of 145	

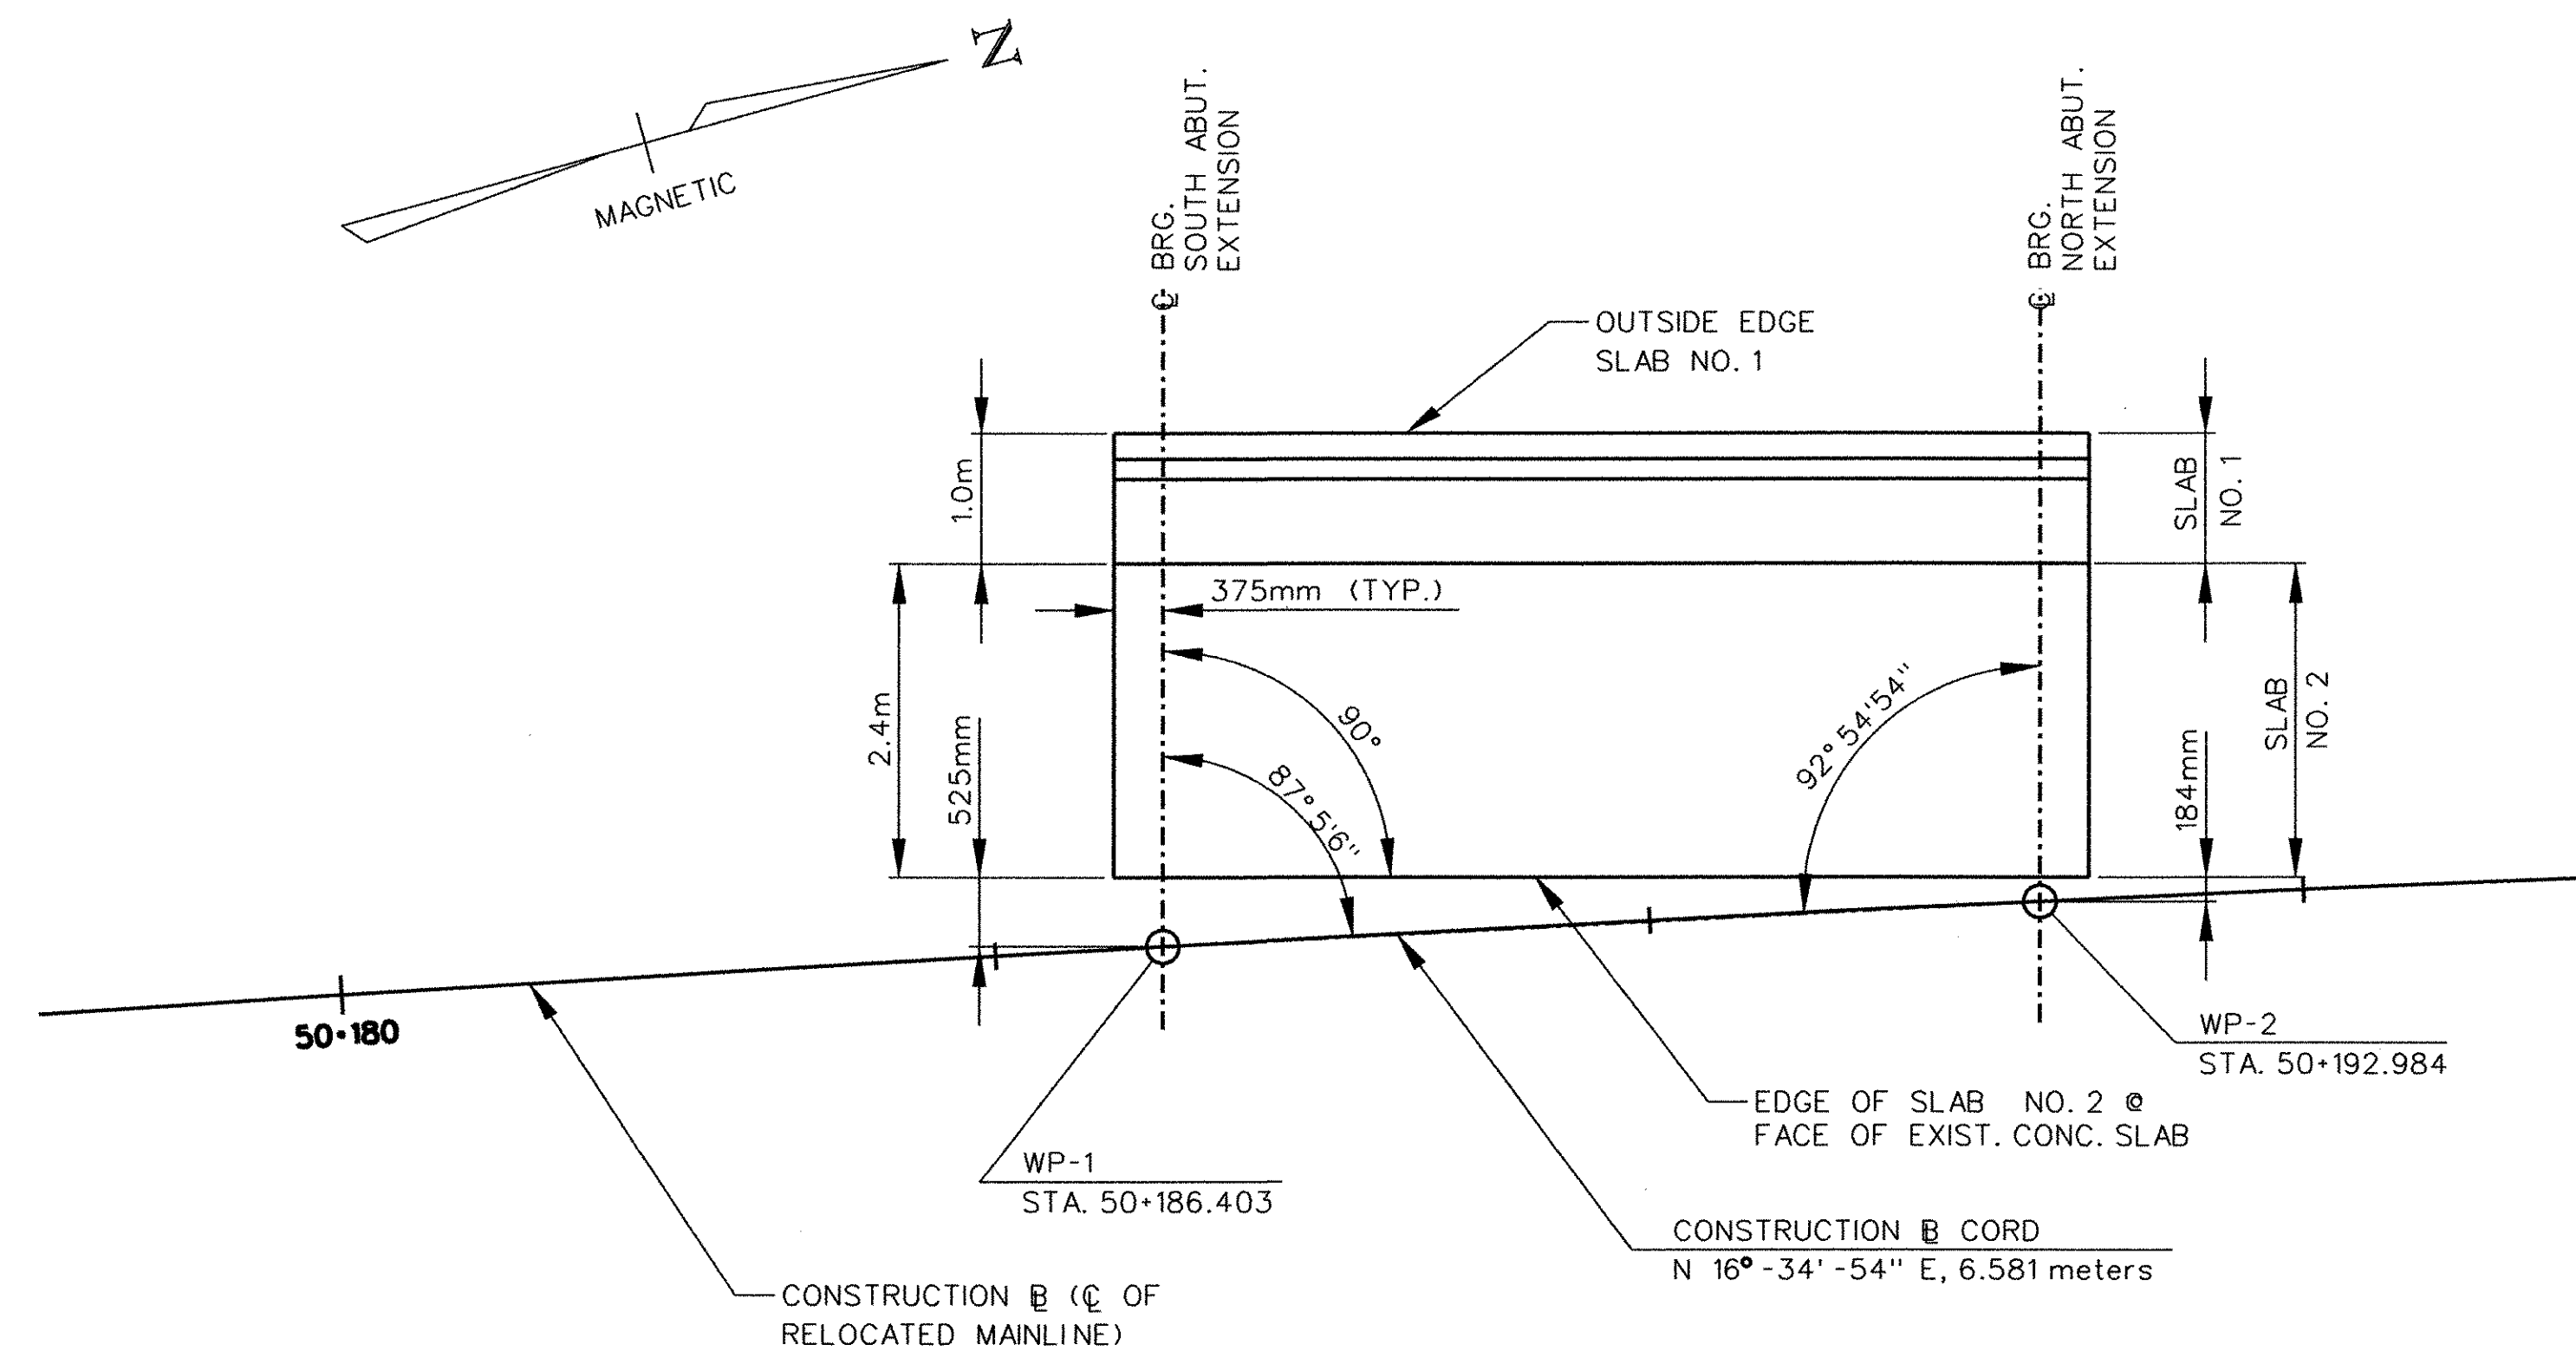


FRAMING PLAN
SCALE 1:50

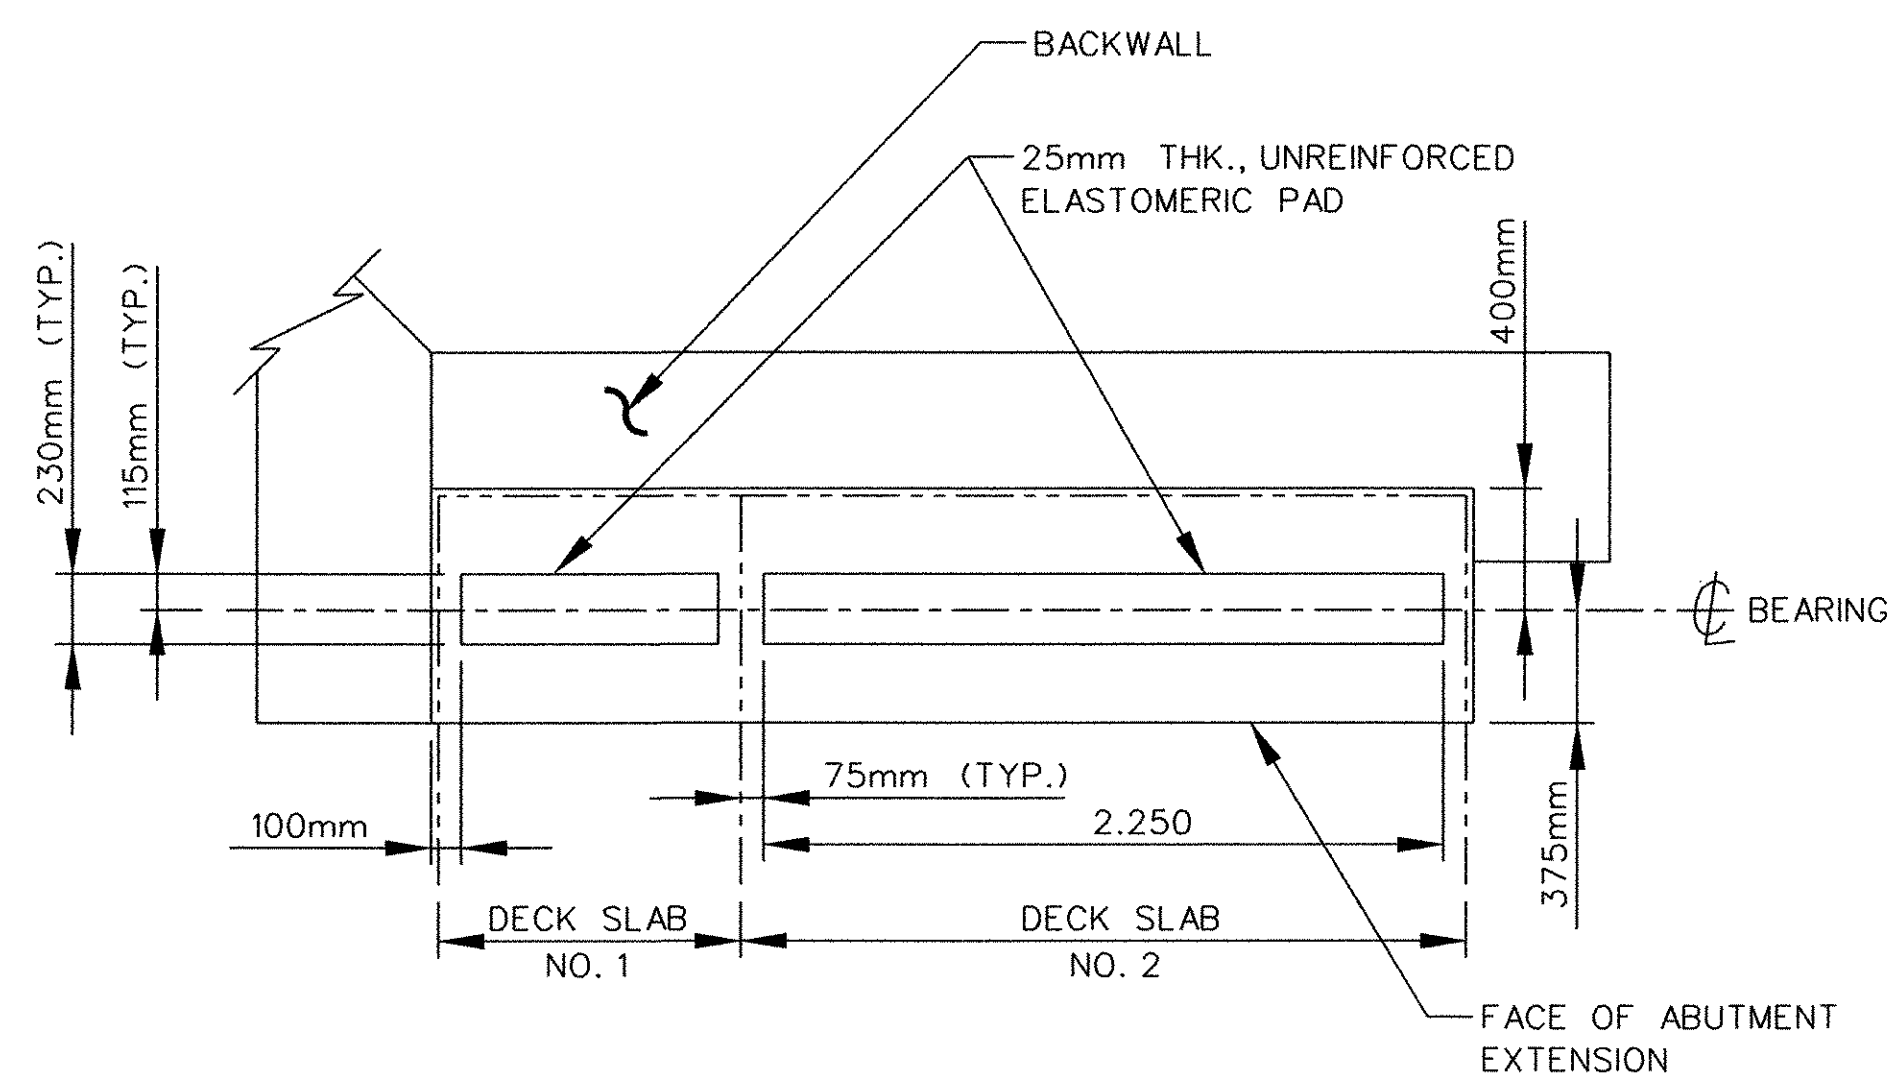

BEARING PAD LAYOUT
SCALE 1:25


**STATE OF VERMONT
AGENCY OF TRANSPORTATION**

Town Of	BRATTLEBORO	Bridge No.	62.51
Highway No.	VT. ROUTE 9	Log Sta.	
		Surv. Sta.	
SARGENT BROOK			
FRAMING PLAN & BEARING LAYOUT			
Designed By	LM	Drawn By	DHL
Checked By	GJB	Date	
		Bridge Design Supervisor	JHR
		Date	
PROJECT	BRATTLEBORO	PROJECT NO.	NH 010-2(2)
I.G.C. Info.			
Bridge Sheet No. 2	Sheet 91 of 145		

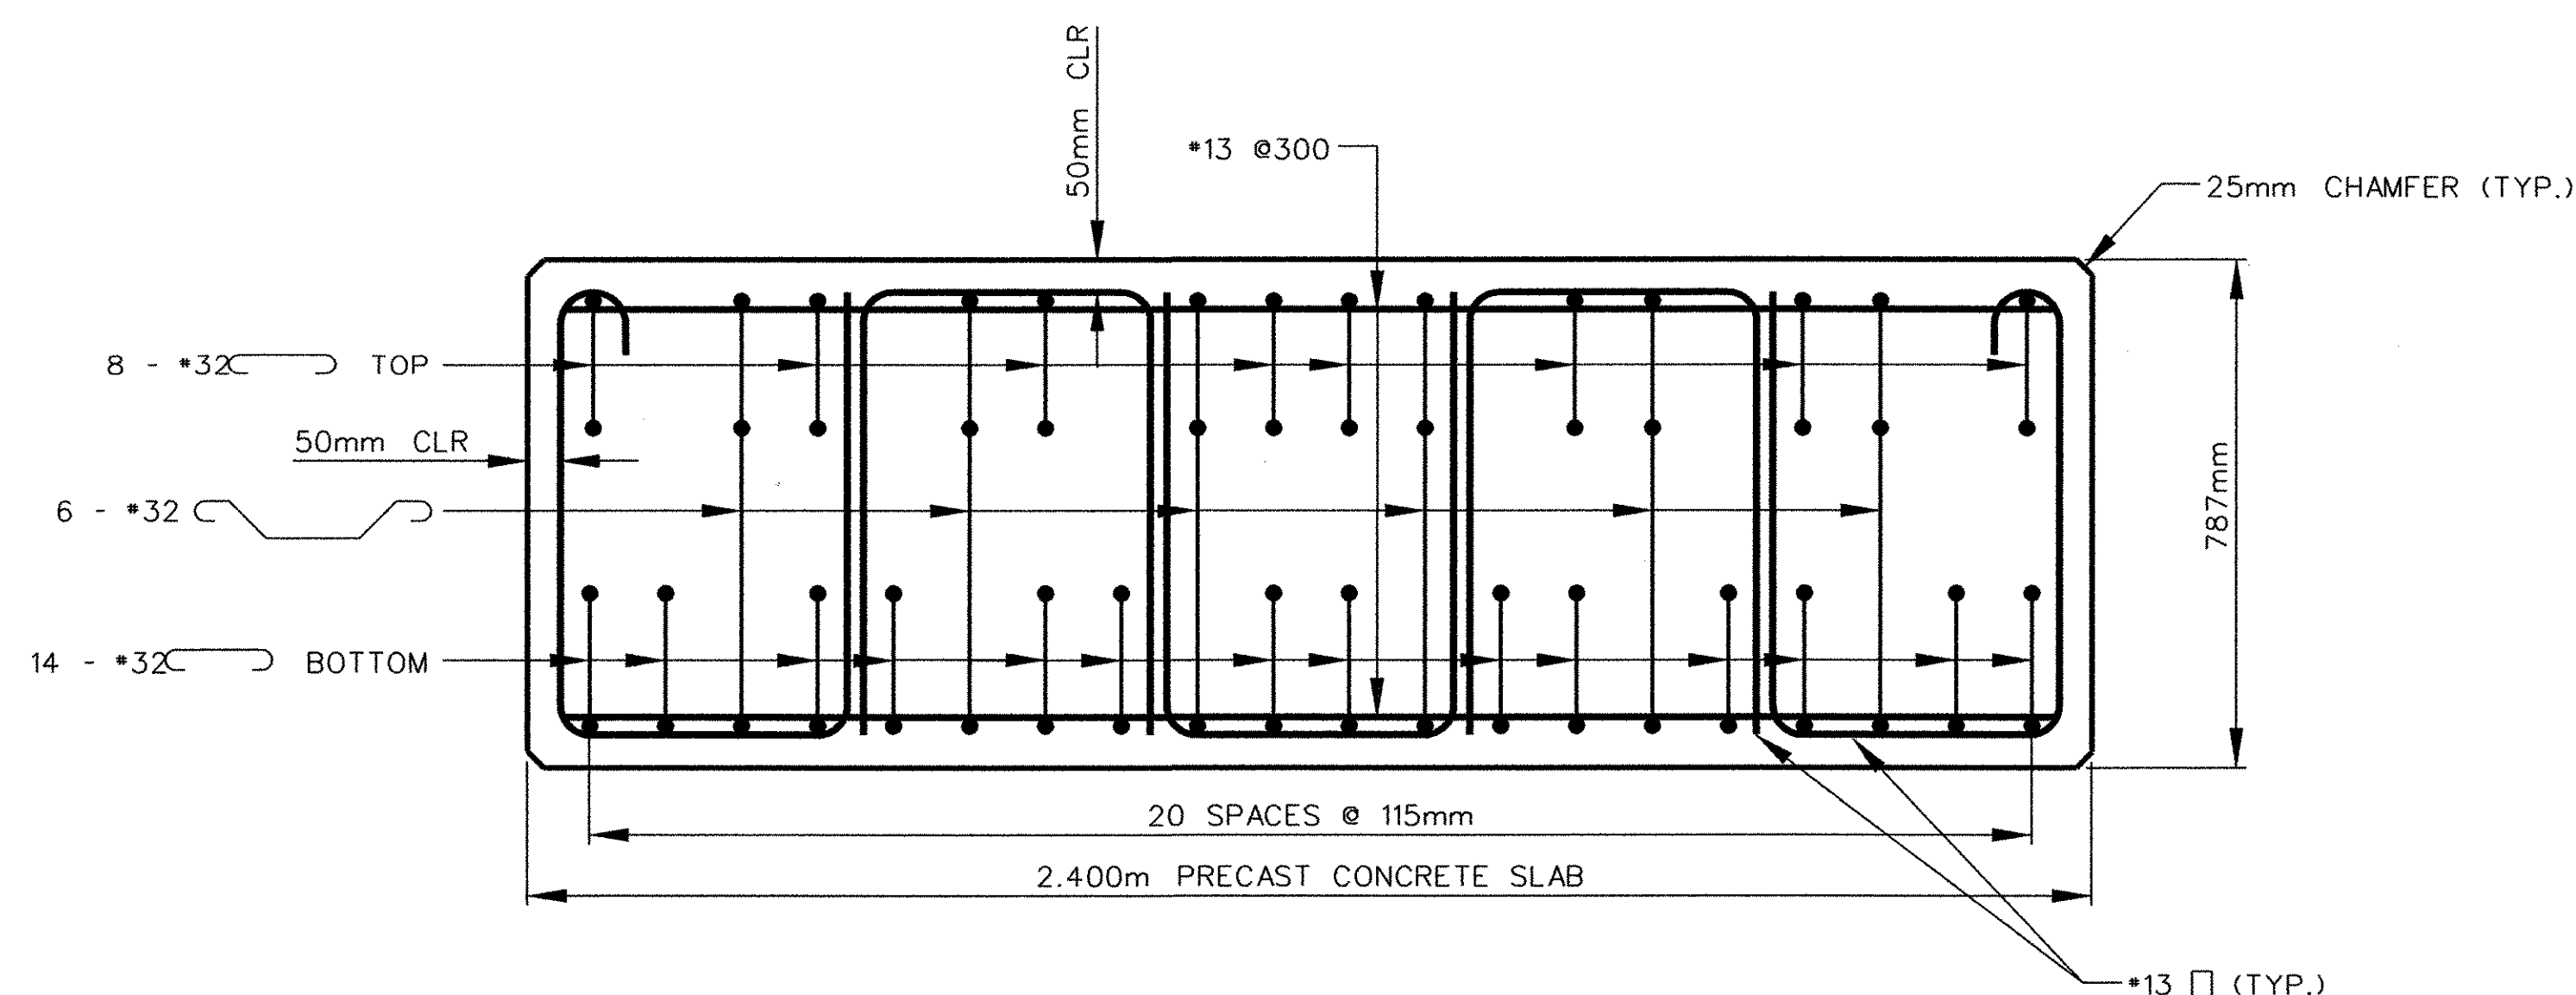


DECK SLAB NO. 2

SCALE 1:10

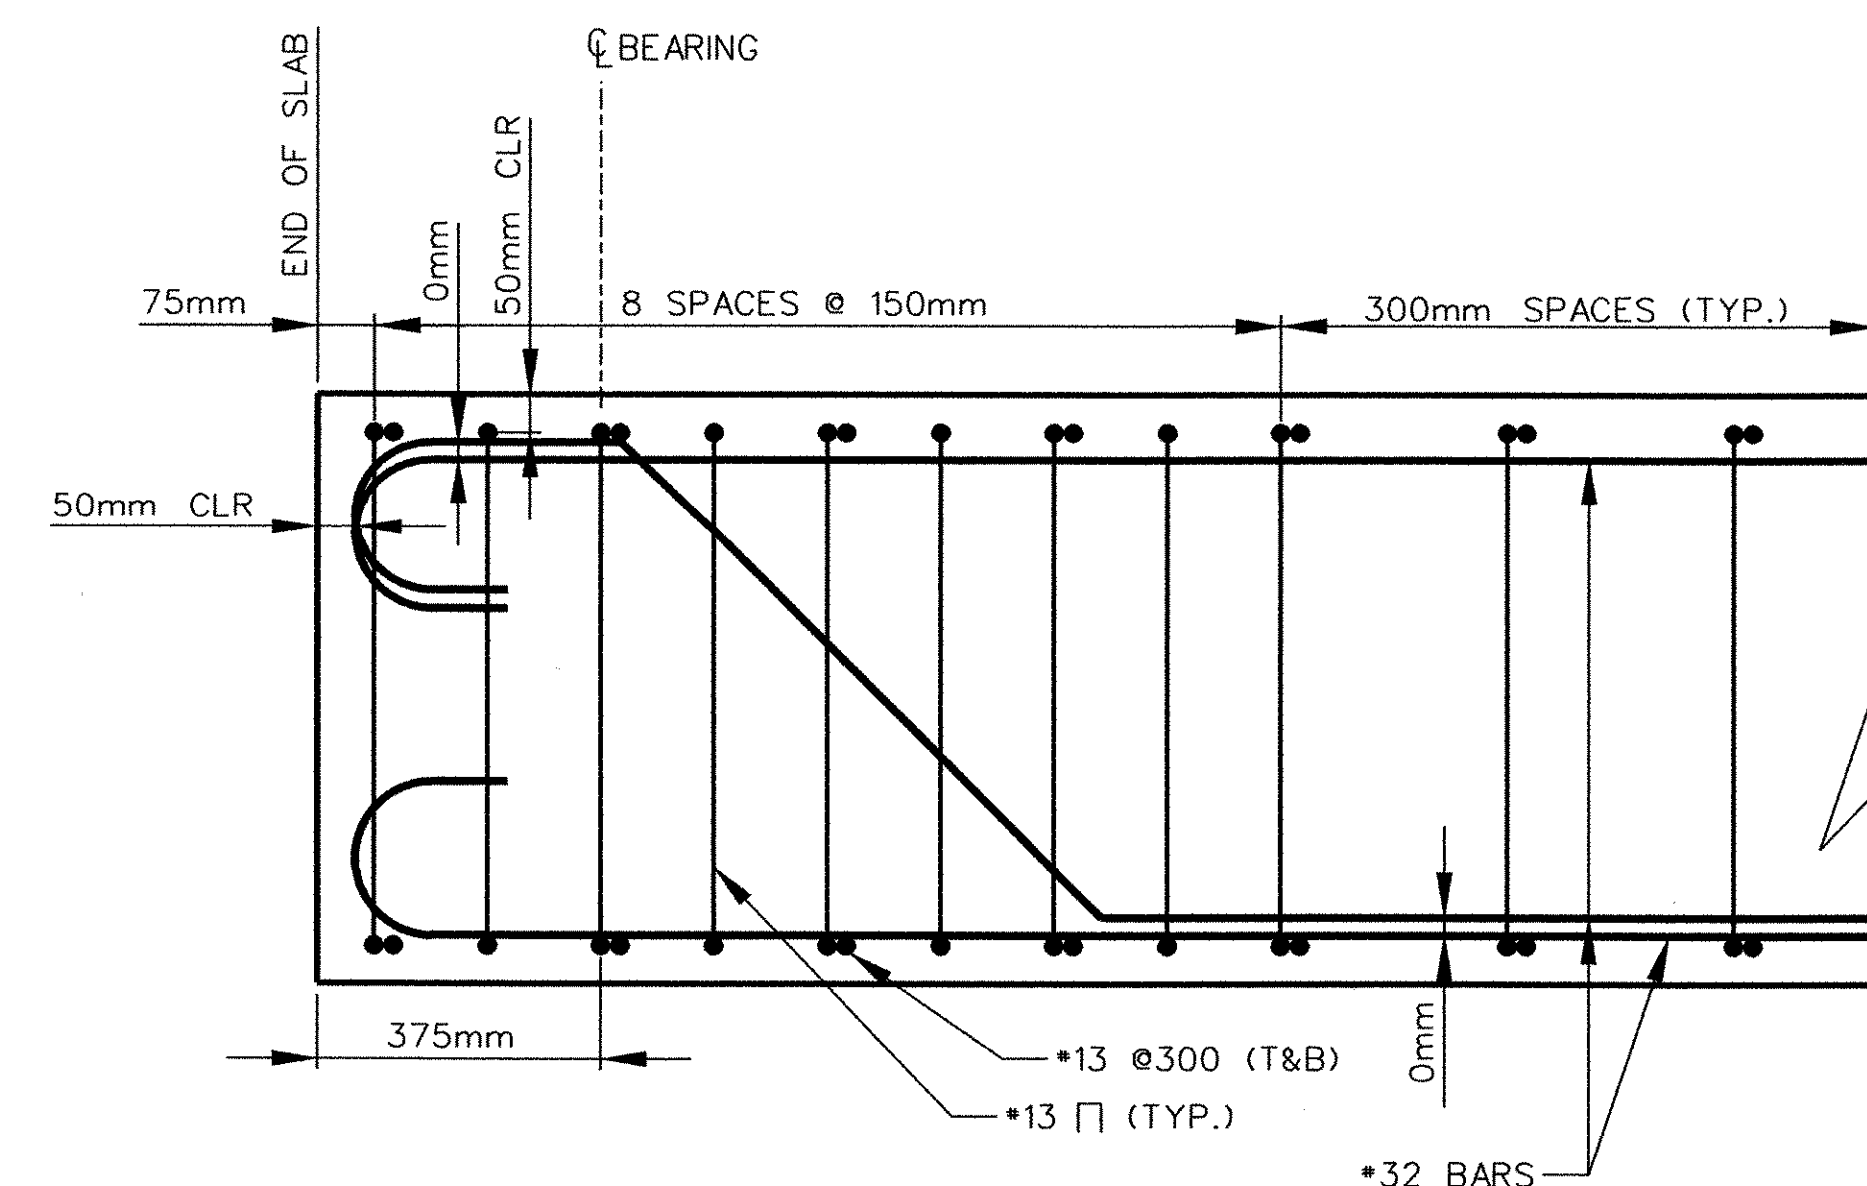


END OF SLAB NO. 2 SECTION

SCALE 1:10

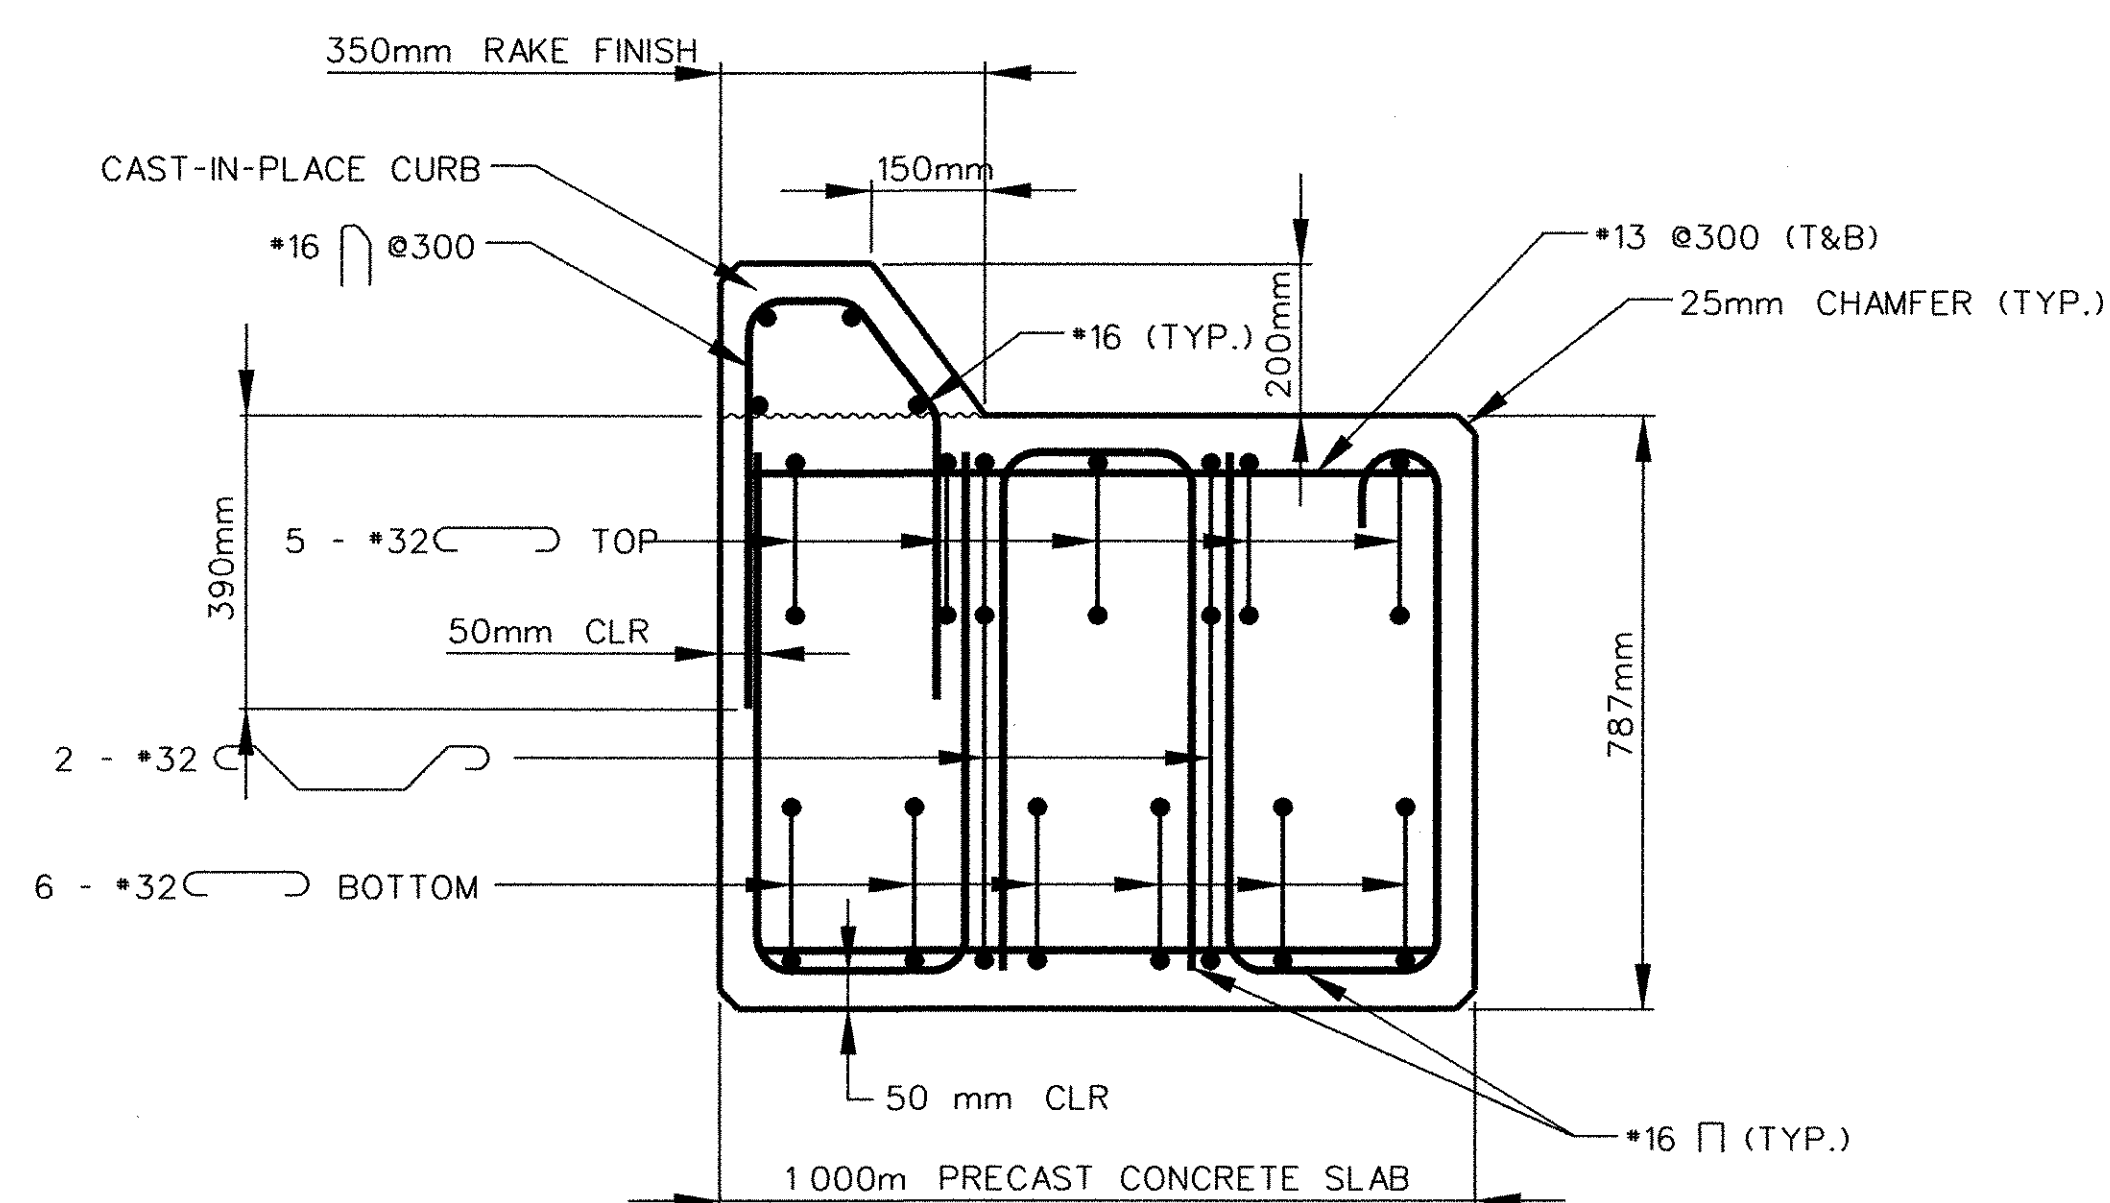

DECK SLAB NO. 1

SCALE 1:10

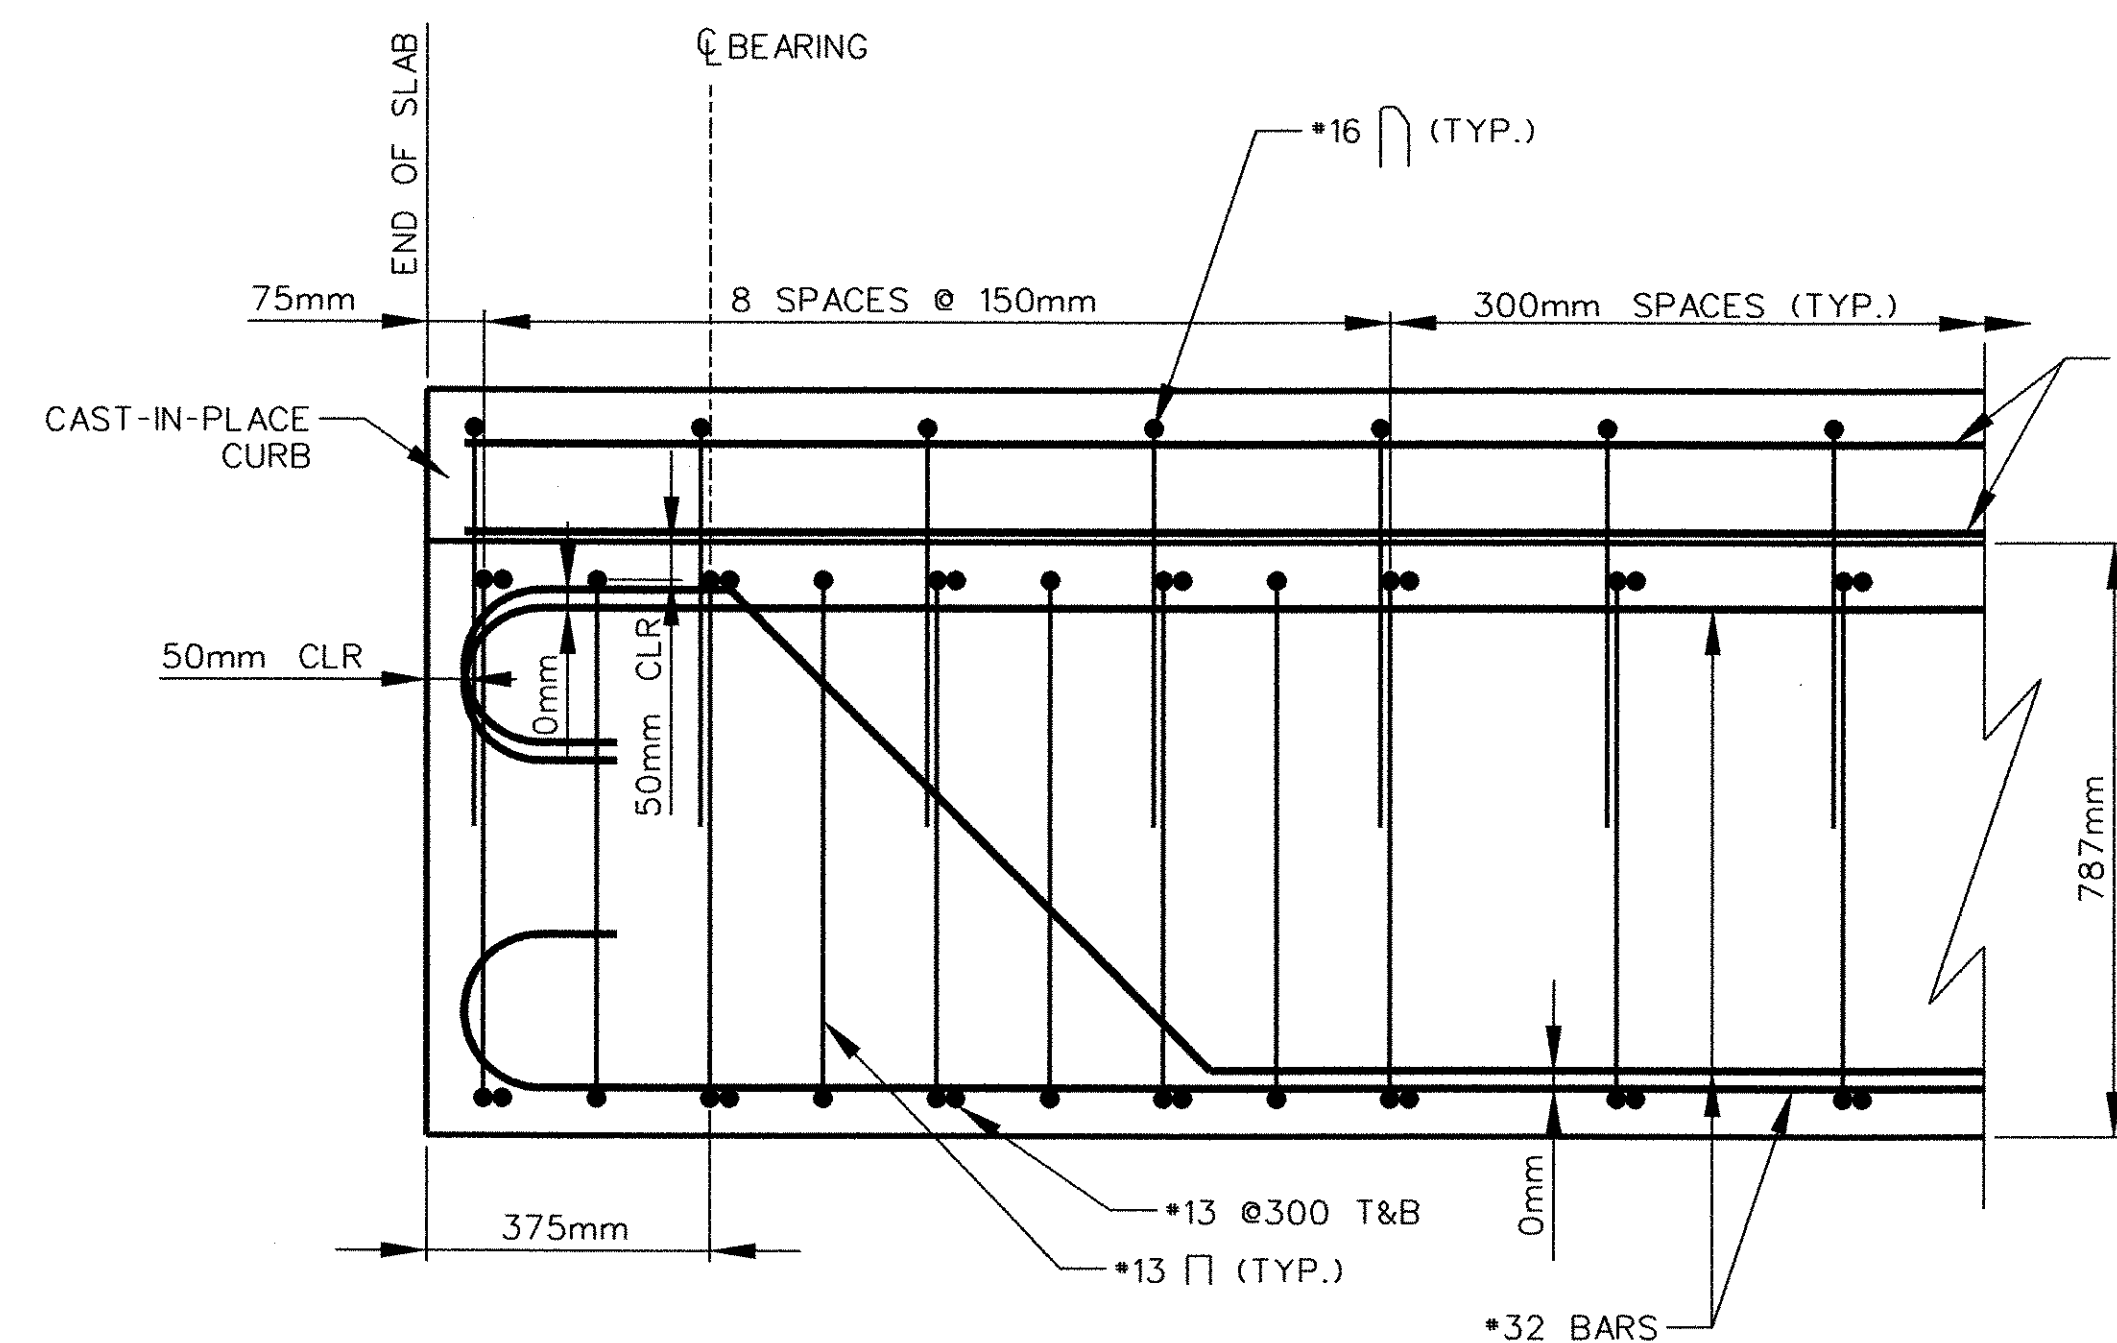

END OF SLAB NO. 1 SECTION

SCALE 1:10


PRECAST CONCRETE NOTES

- MEMBERS SHOWN ARE SIMILAR, IN SIZE AND REINFORCEMENT LAYOUT, TO THE BOSTON AND MAINE RAILROAD'S STANDARD REINFORCED CONCRETE SLAB WHICH WAS USED IN THE ORIGINAL CONSTRUCTION.
- MEMBERS ARE TO BE PRECAST CONCRETE. THE FABRICATION OF THESE BEAMS SHALL CONFORM TO AREMA AND VTRANS STANDARD PROCEDURES FOR PRECAST CONCRETE.
- PRECAST CONCRETE MEMBERS SHALL HAVE A MINIMUM COMPRESSIVE STRENGTH OF 35 MPa.
- TOP OF ALL BEAMS SHALL BE GIVEN A SMOOTH FINISH EXCEPT UNDER AREA OF CAST-IN-PLACE CURB. AREAS UNDER THE CURB SHALL HAVE A RAKE FINISH WITH AN AMPLITUDE OF 6 mm.
- THE FABRICATOR IS RESPONSIBLE FOR THE DESIGN AND LOCATION OF LIFTING DEVICES. THE DEVICES SHALL BE DESIGNED FOR FACTORS OF SAFETY REQUIRED BY THE ERECTION PROCEDURE.
- ALL REINFORCEMENT SHALL BE EPOXY COATED, GRADE 420, AASHTO M 31M/m 31 (ASTM A-615-S1) BILLET STEEL BARS.


**STATE OF VERMONT
AGENCY OF TRANSPORTATION**

Town Of	BRATTLEBORO	Bridge No.	62.51
Highway No.	VT. ROUTE 9	Log Sta.	
		Surv. Sta.	
SARGENT BROOK			
CONCRETE DECK SLAB			
Designed By	LM	Drawn By	DHL
Checked By	GJB	Date	
		Bridge Design Supervisor	JHR
		Date	
PROJECT	BRATTLEBORO	PROJECT NO.	NH 010-2(2)
I.G.C. Info.			
Bridge Sheet No. 3		Sheet 92 of 145	


Plot Date: 10-02-2002
File: sgtr150

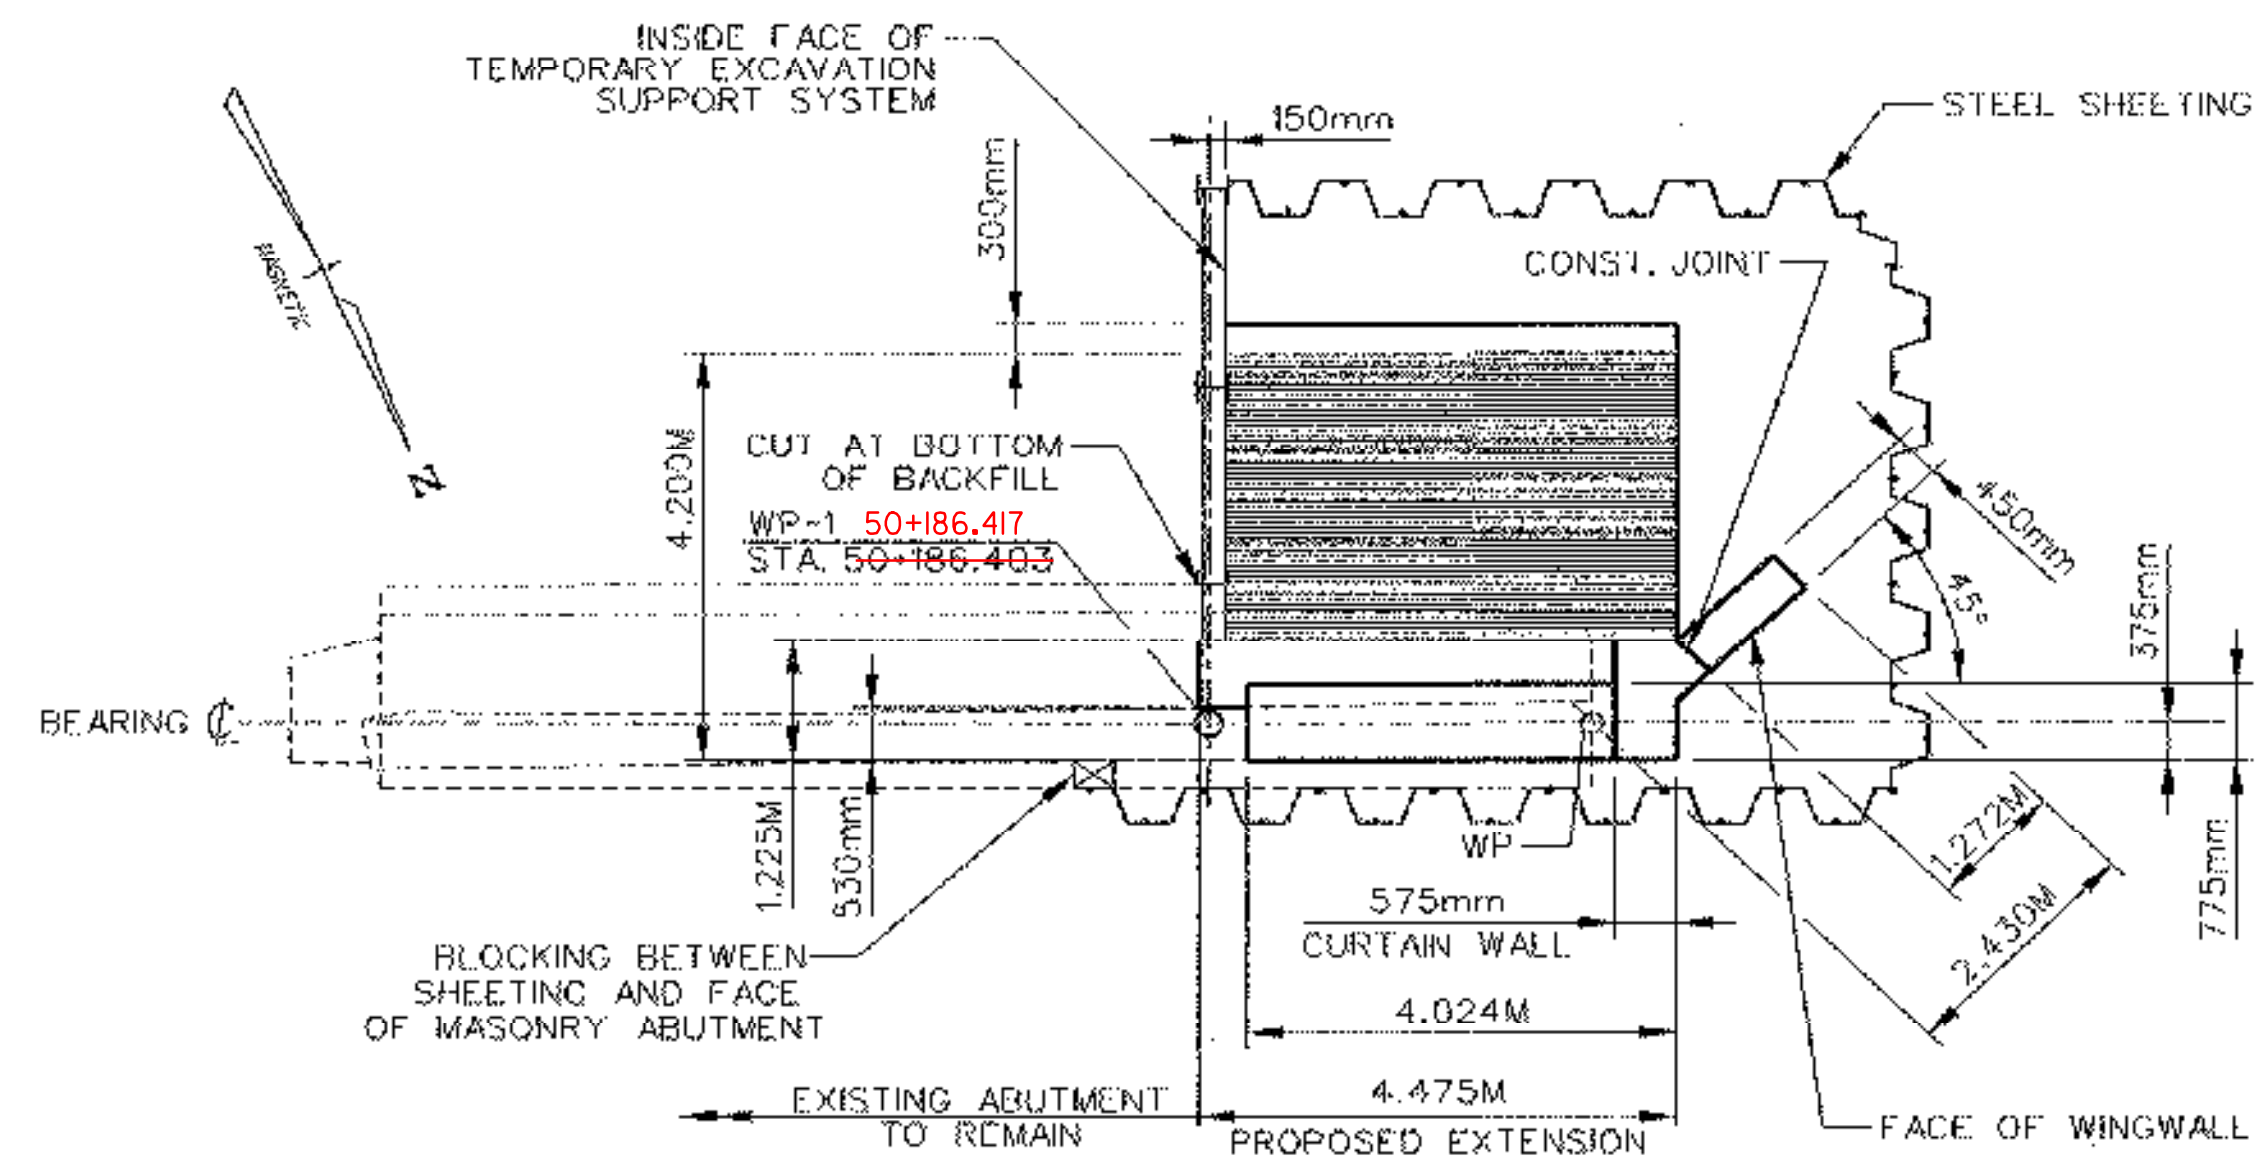


PLAN SOUTH ABUTMENT SARGENT BROOK BRIDGE
SCALE 1:75

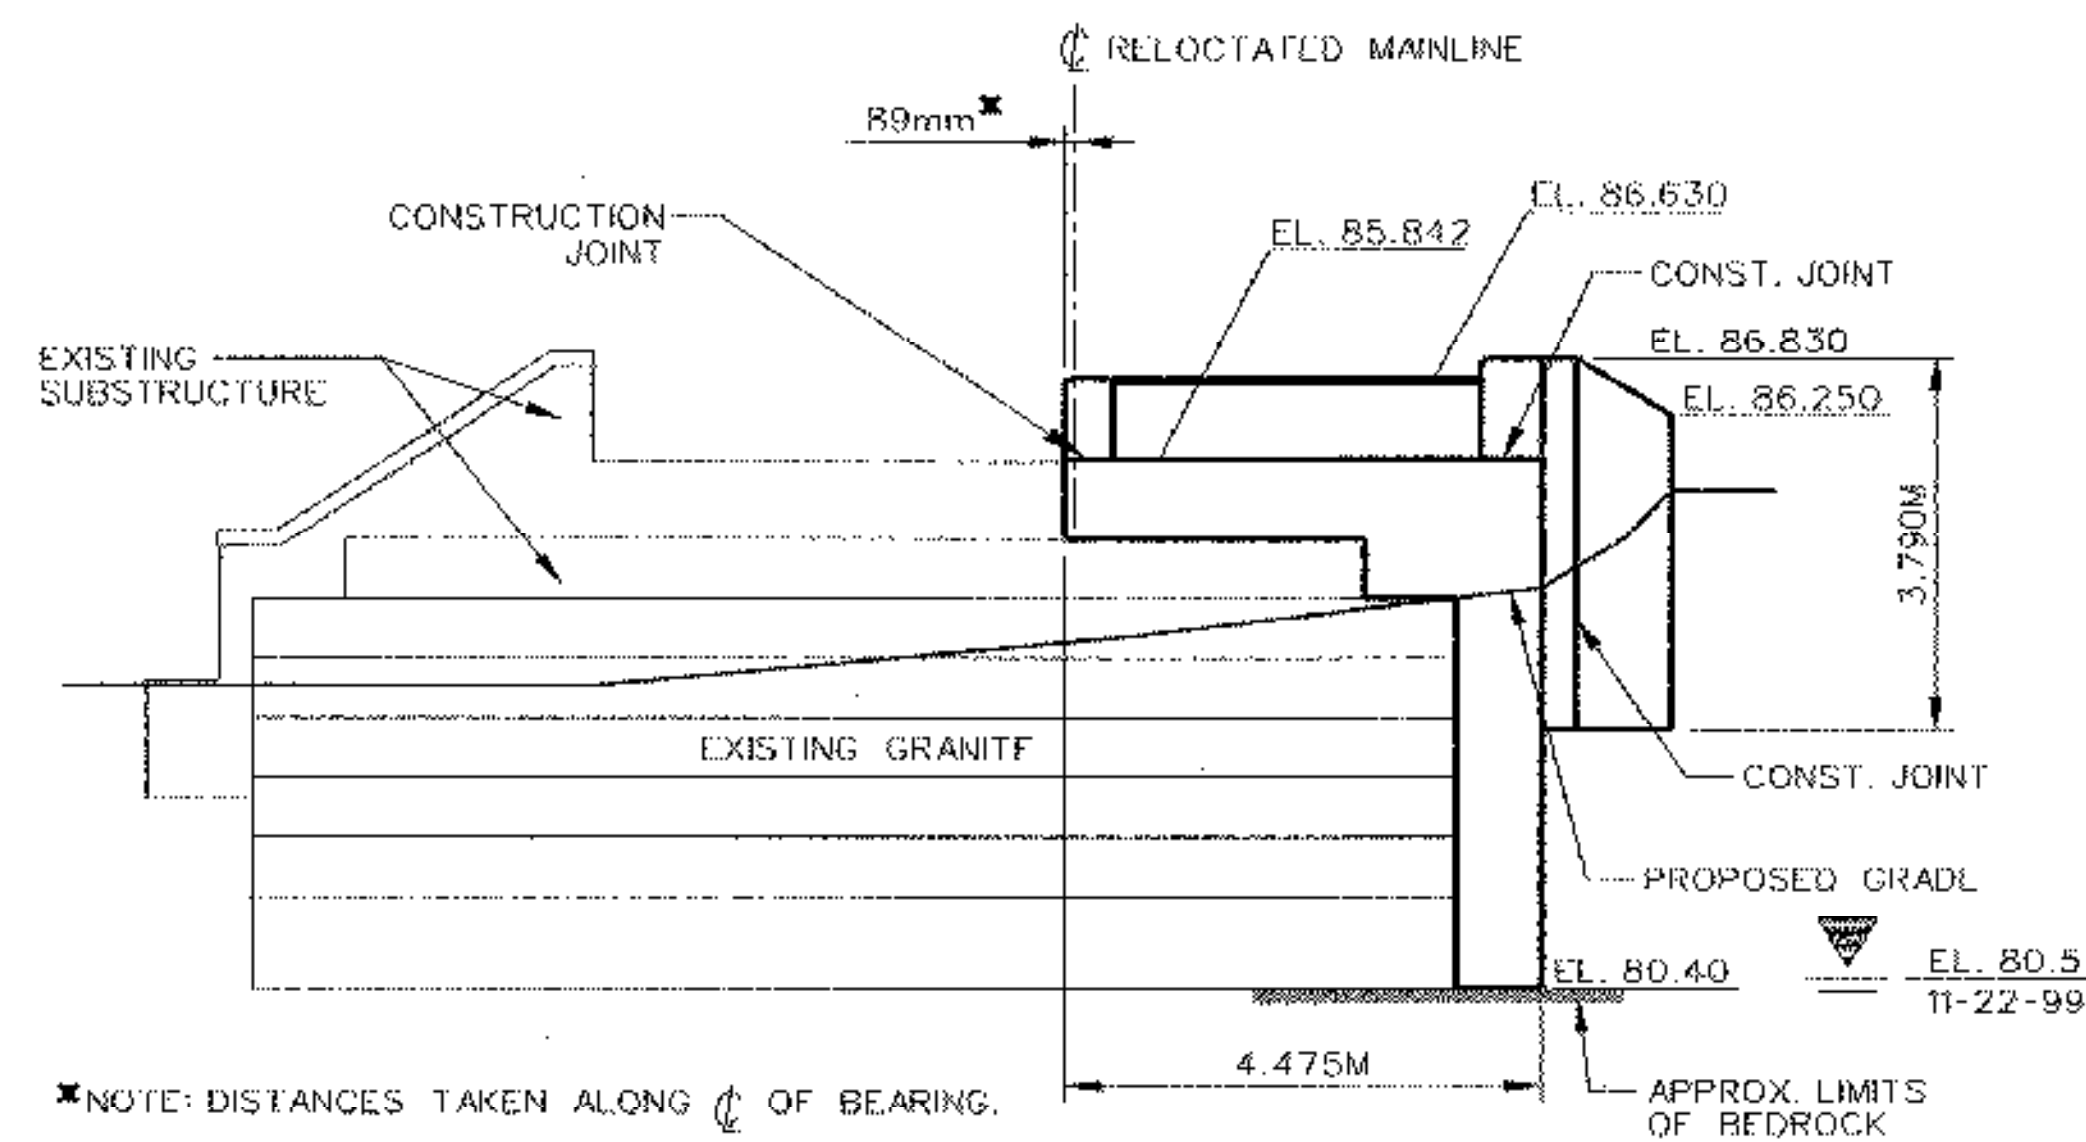


SOUTH ABUTMENT ELEVATION SARGENT BROOK BRIDGE
SCALE 1:75

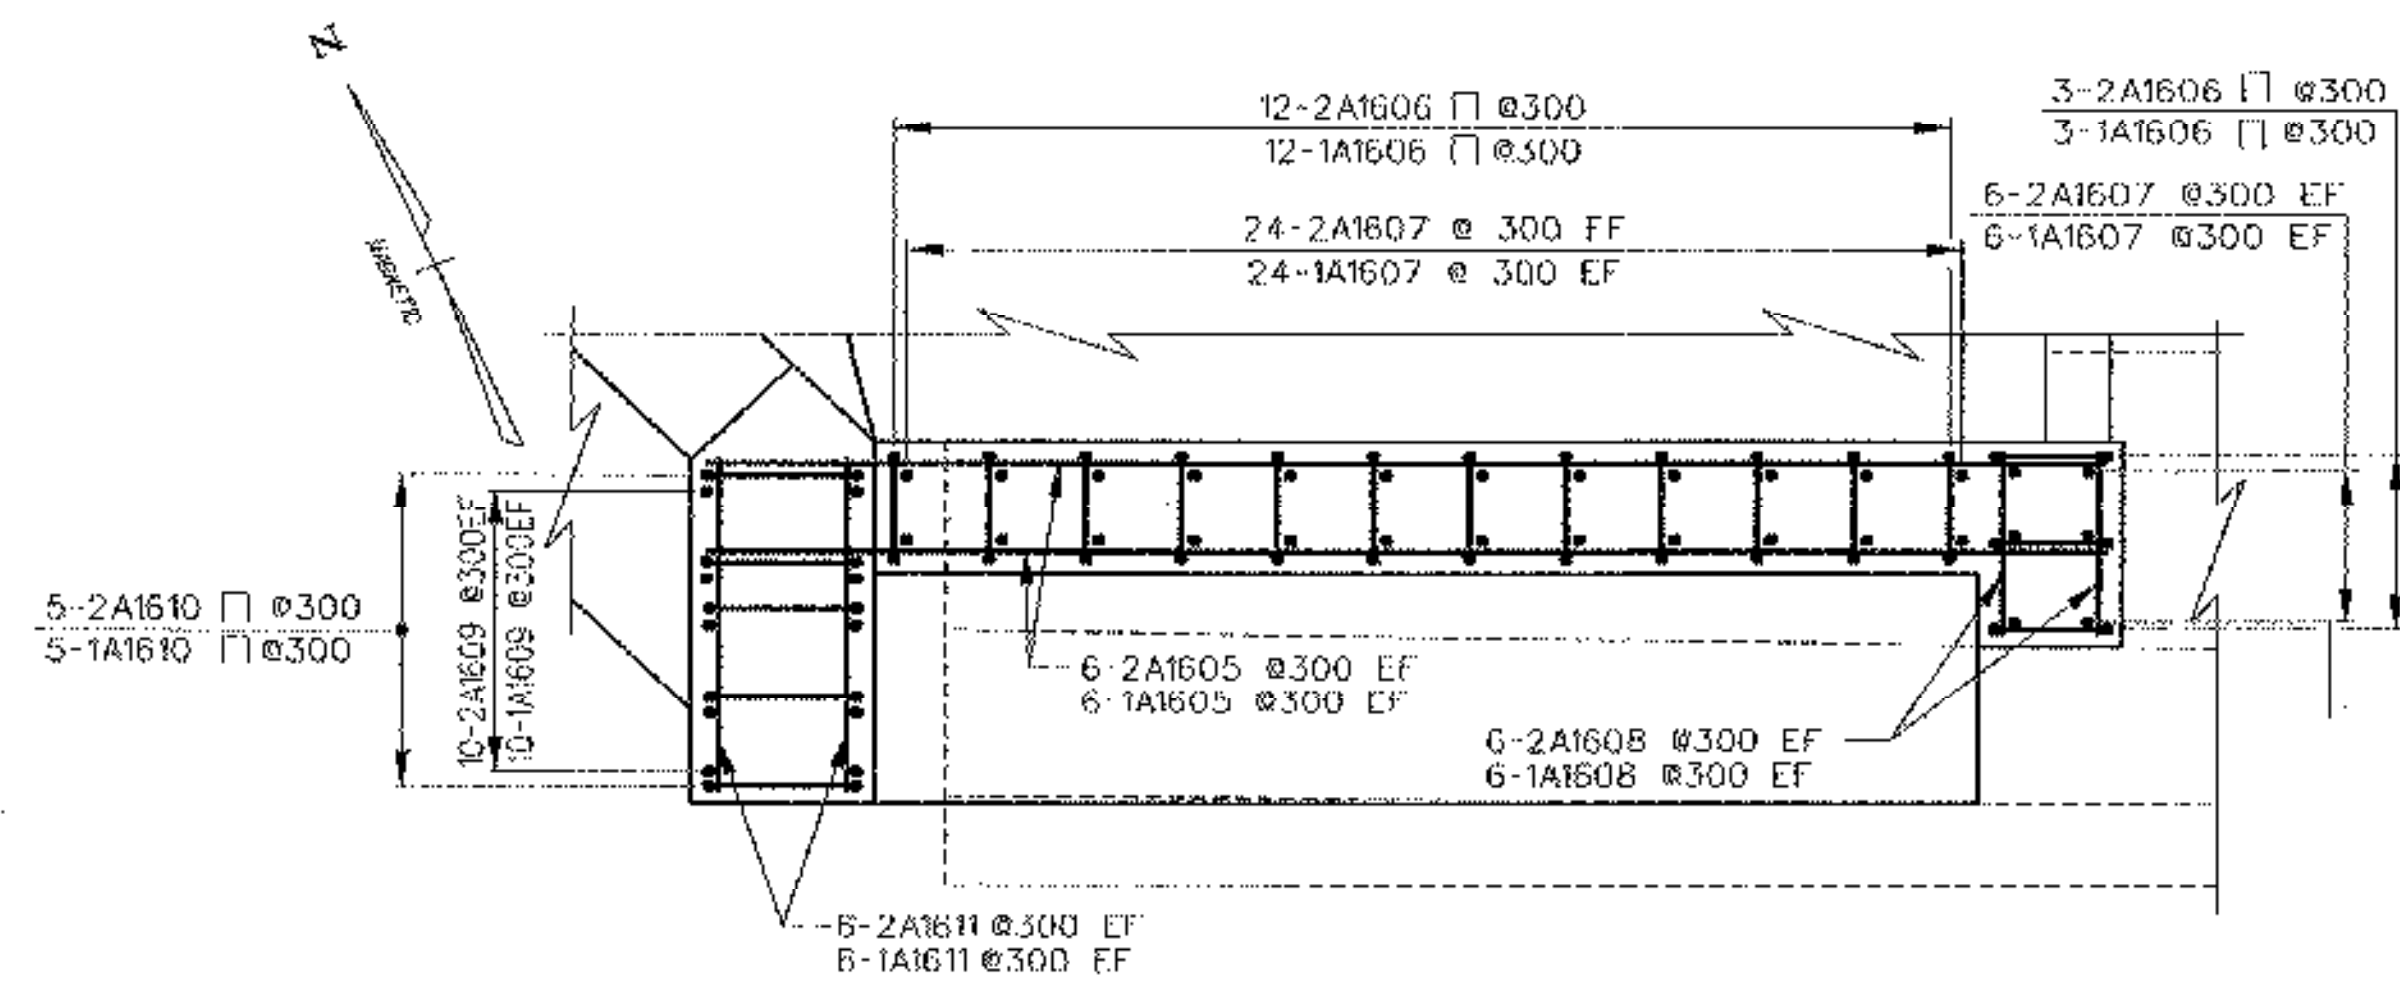


NORTH ABUTMENT CURTAINWALL & BACKWALL REINFORCEMENT PLAN (SOUTH ABUTMENT - OPPOSITE HAND)
SCALE 1:25

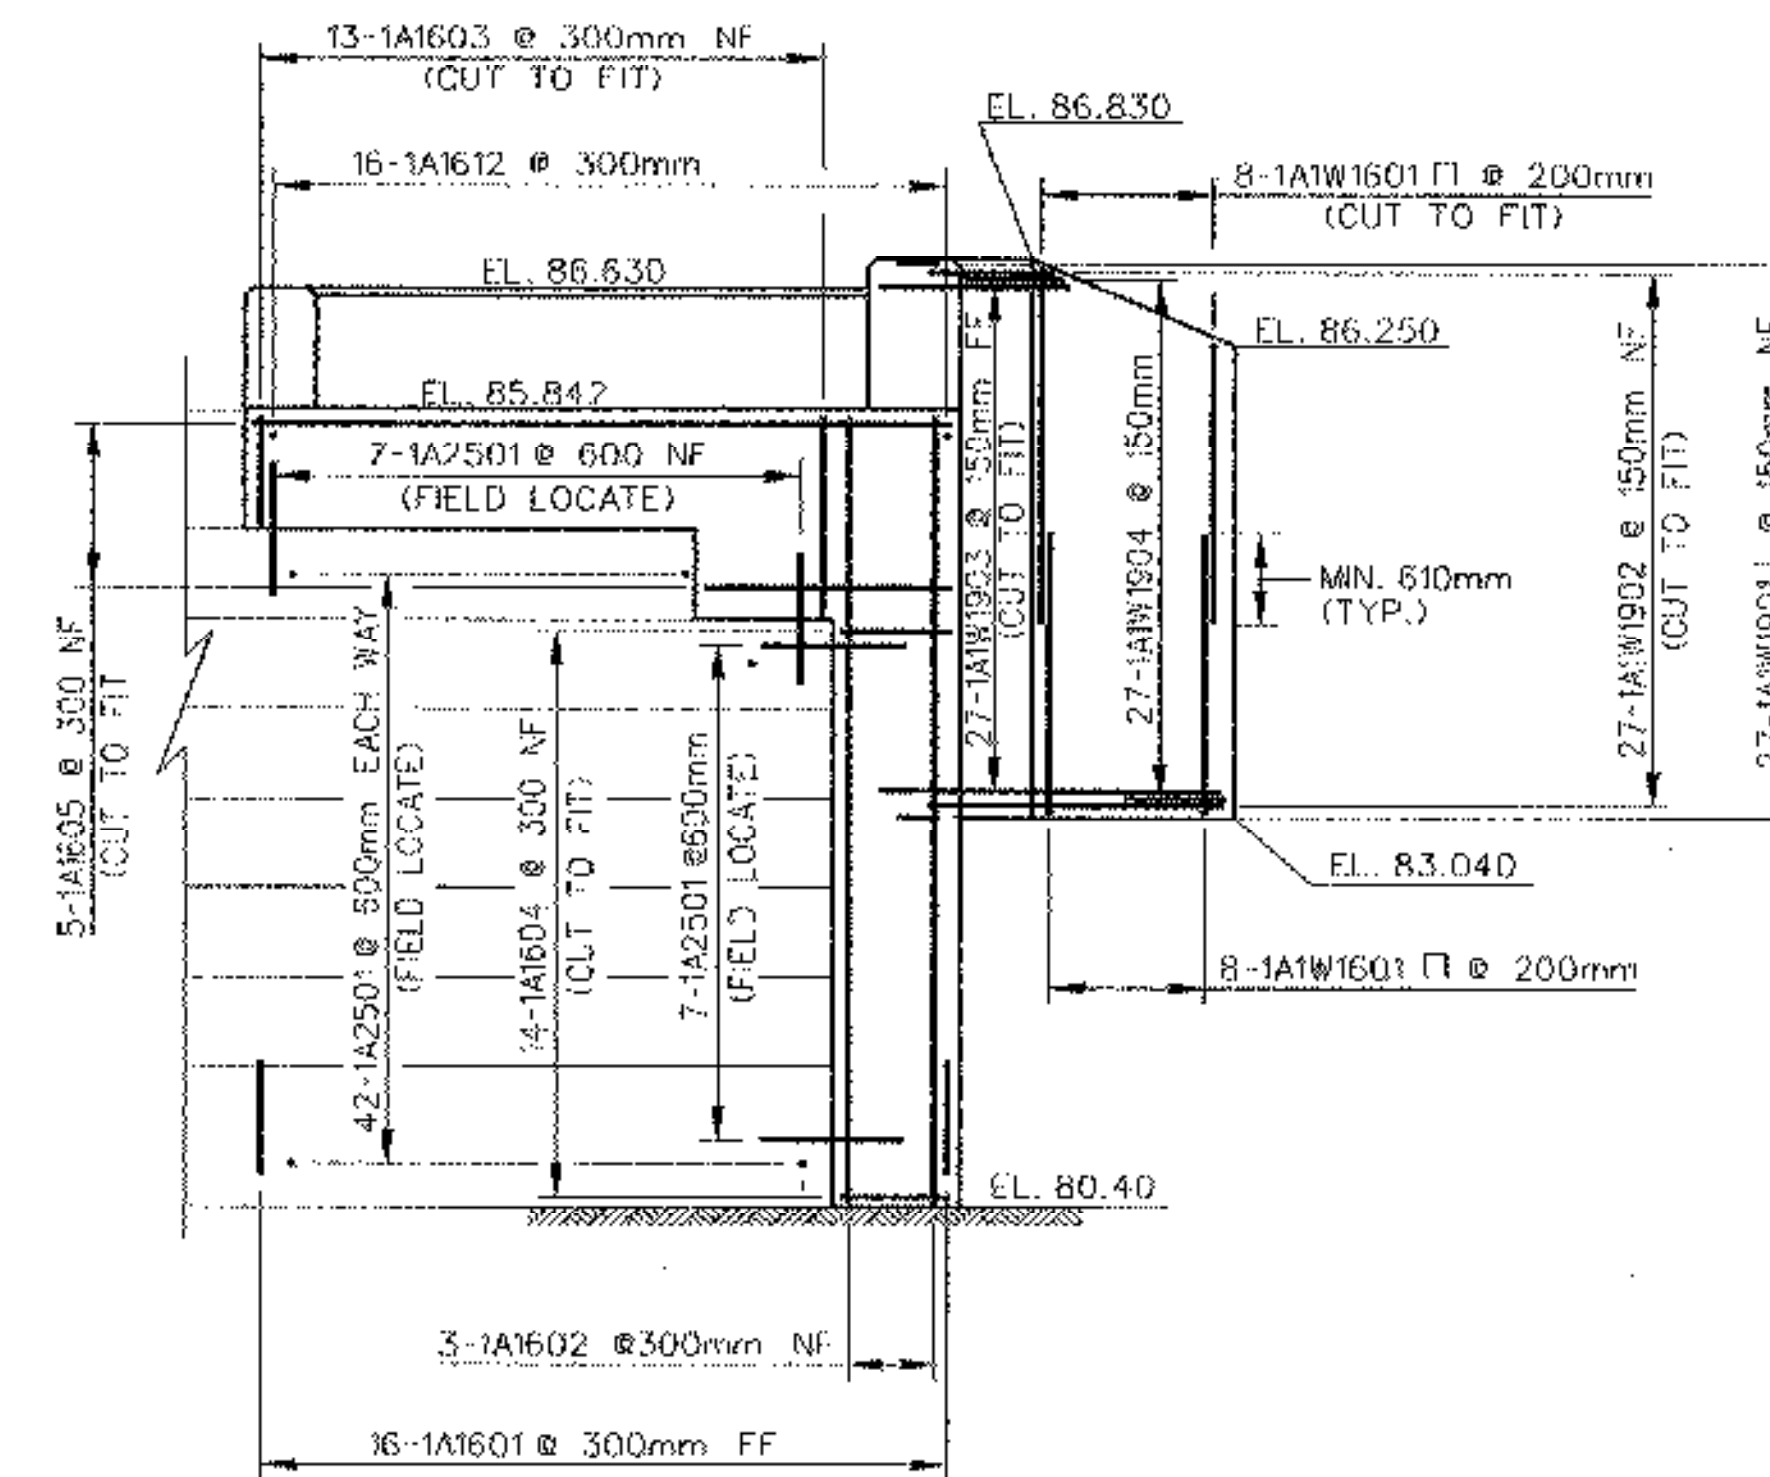

SARGENT BROOK BRIDGE SOUTH ABUTMENT REINFORCEMENT ELEVATION
SCALE 1:50






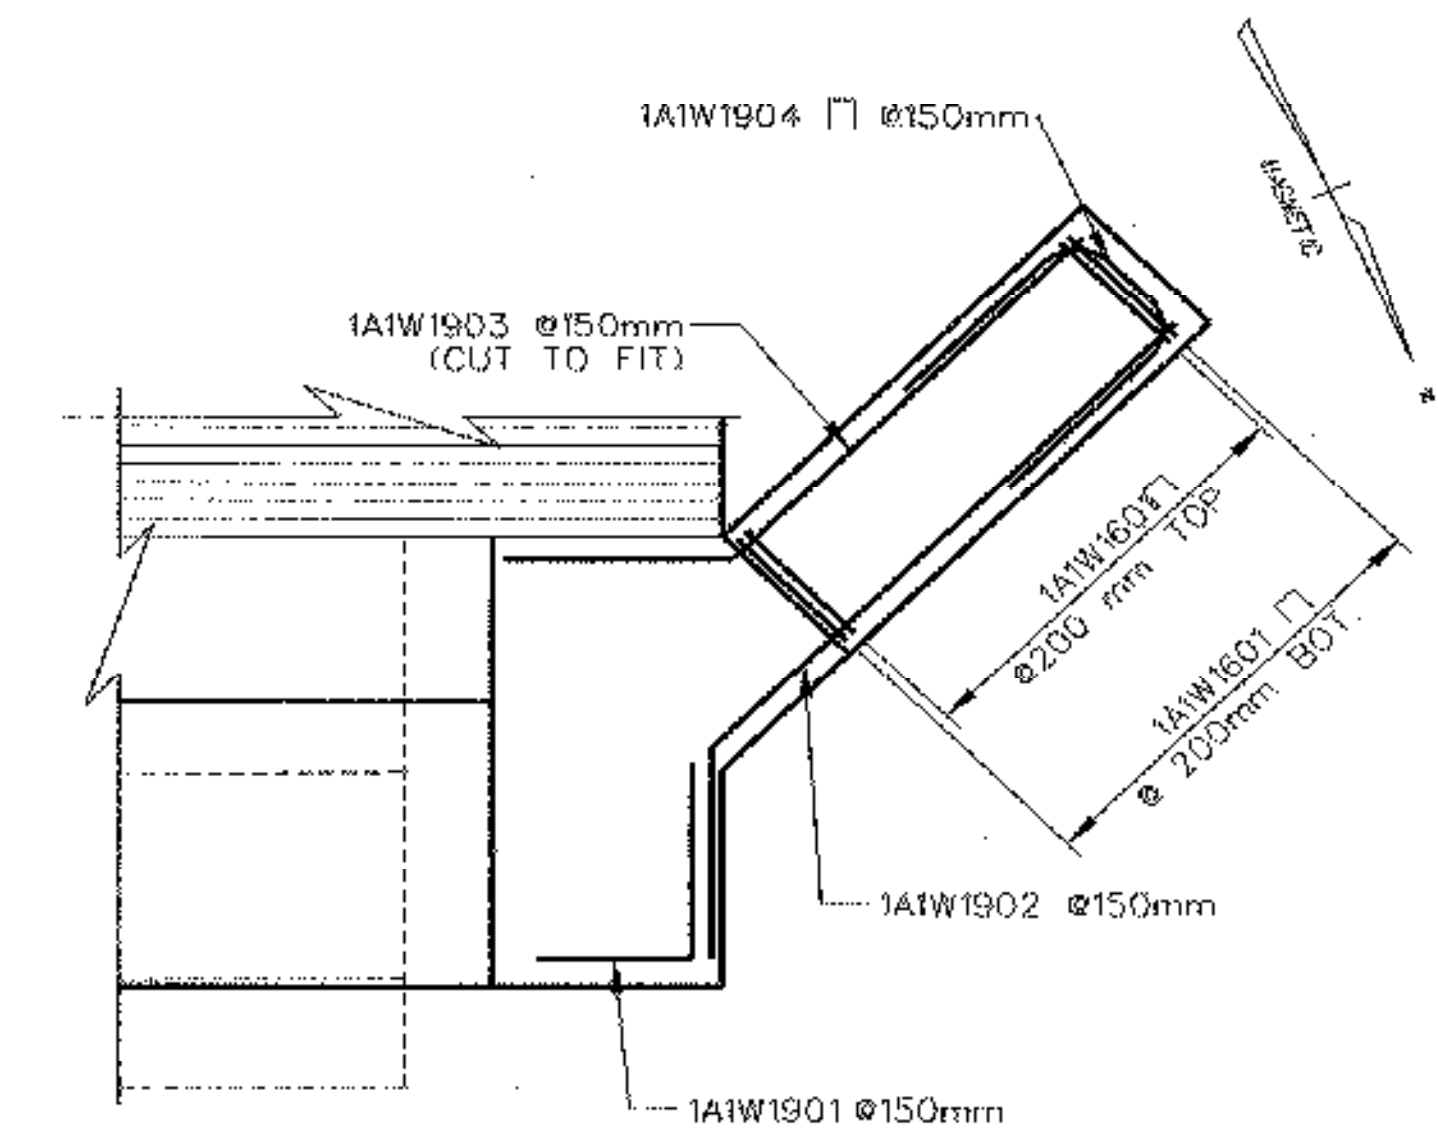


SOUTH WEST WINGWALL REINFORCEMENT PLAN
SCALE 1:20



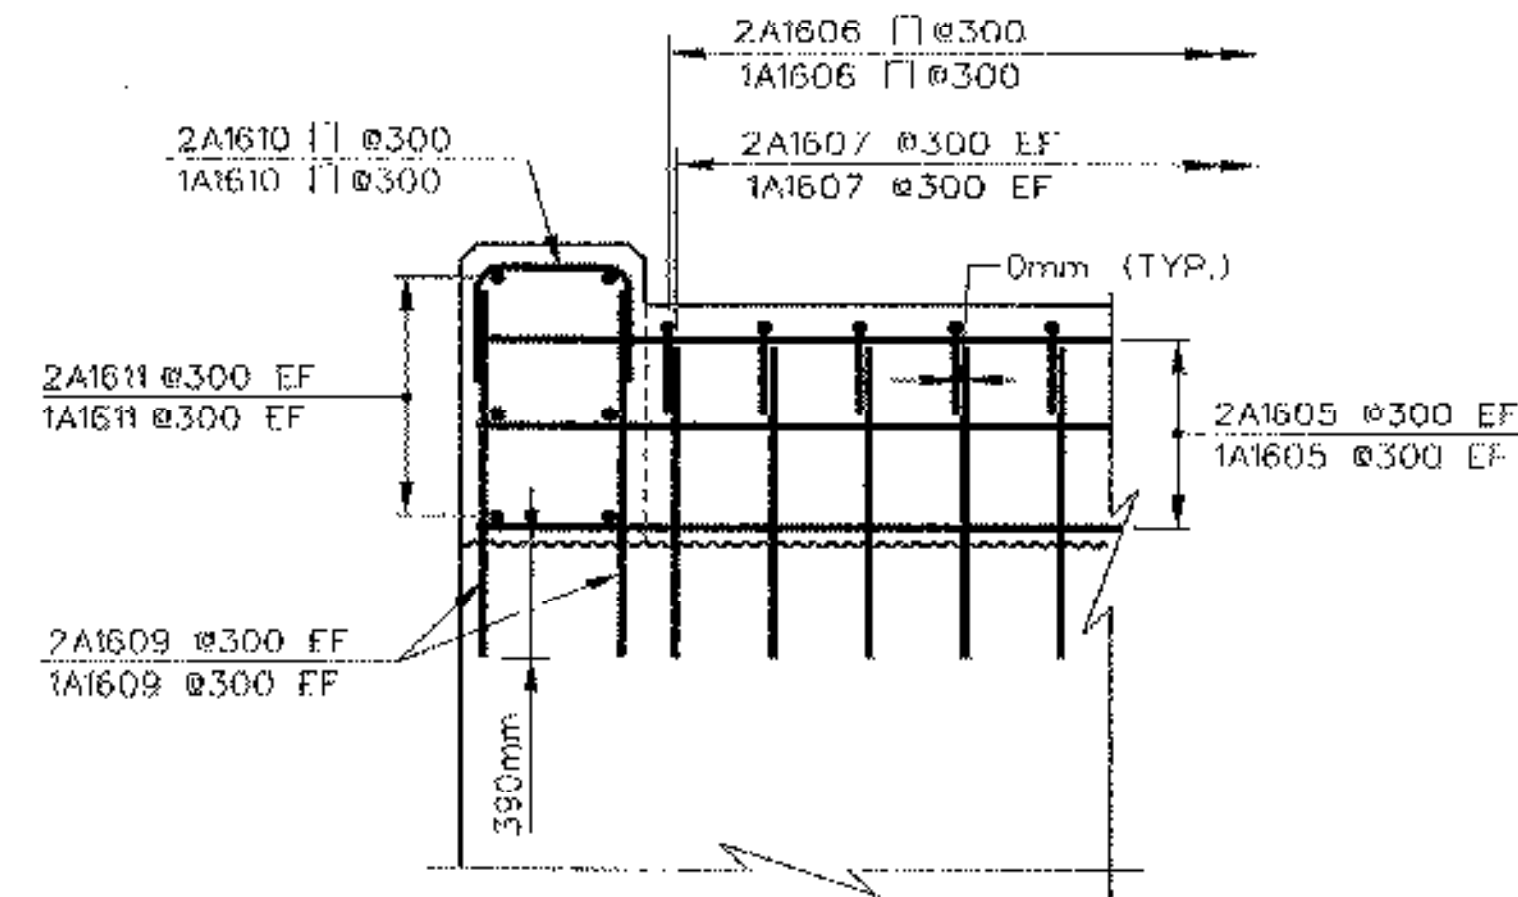


CURTAIN WALL REINFORCEMENT SECTION
SCALE 1:25

STATE OF VERMONT AGENCY OF TRANSPORTATION		
Town Of	BRATTLEBORO	Bridge No. 62.51
Highway No.	VT. ROUTE 9	Log Sta.
		Surv. Sta.
SARGENT BROOK		
SOUTH ABUTMENT PLAN, ELEVATION AND DETAILS		
Designed By	LM	Drawn By LRD/DHL
Checked By	GJB	Bridge Design Supervisor JHR
		Date
PROJECT	BRATTLEBORO	PROJECT NO. NH 010-2(2)
I.G.C. Info.		
Bridge Sheet No. 4		Sheet 93 of 145

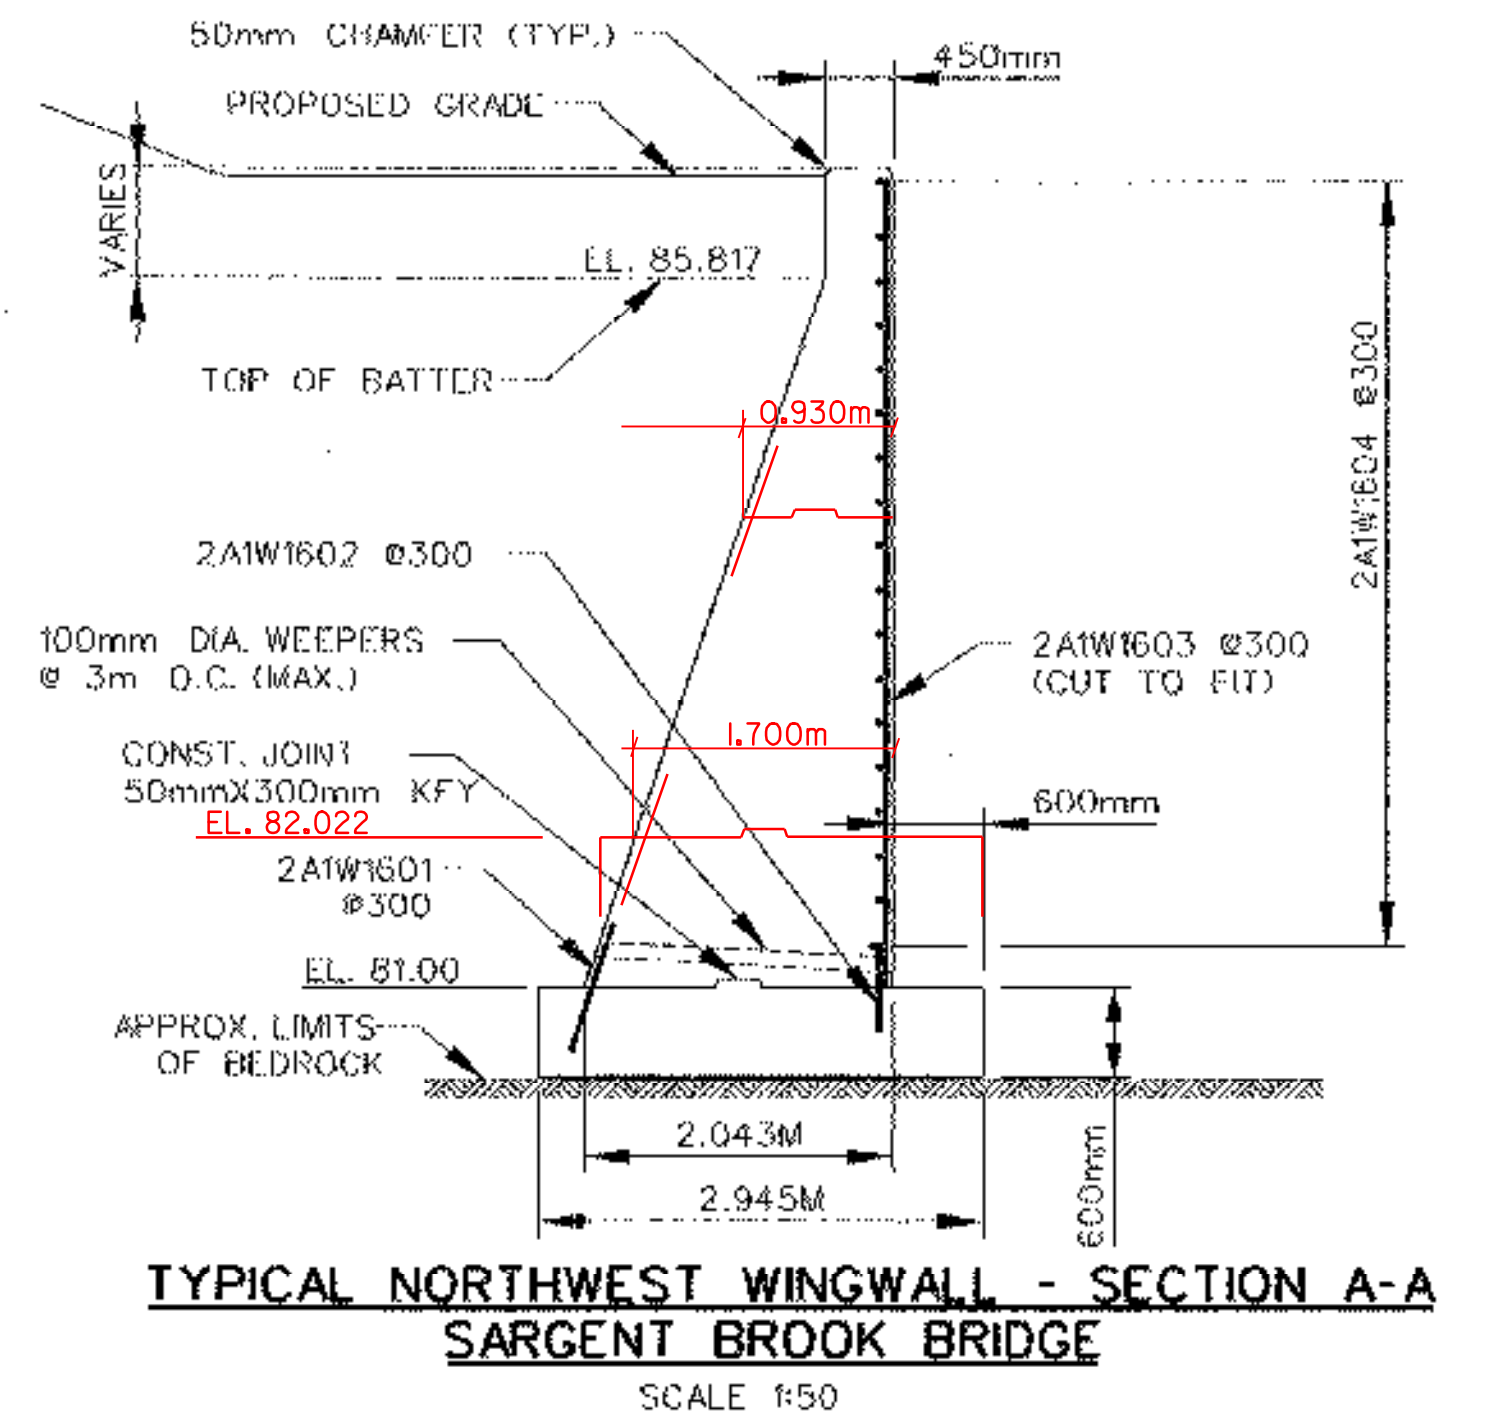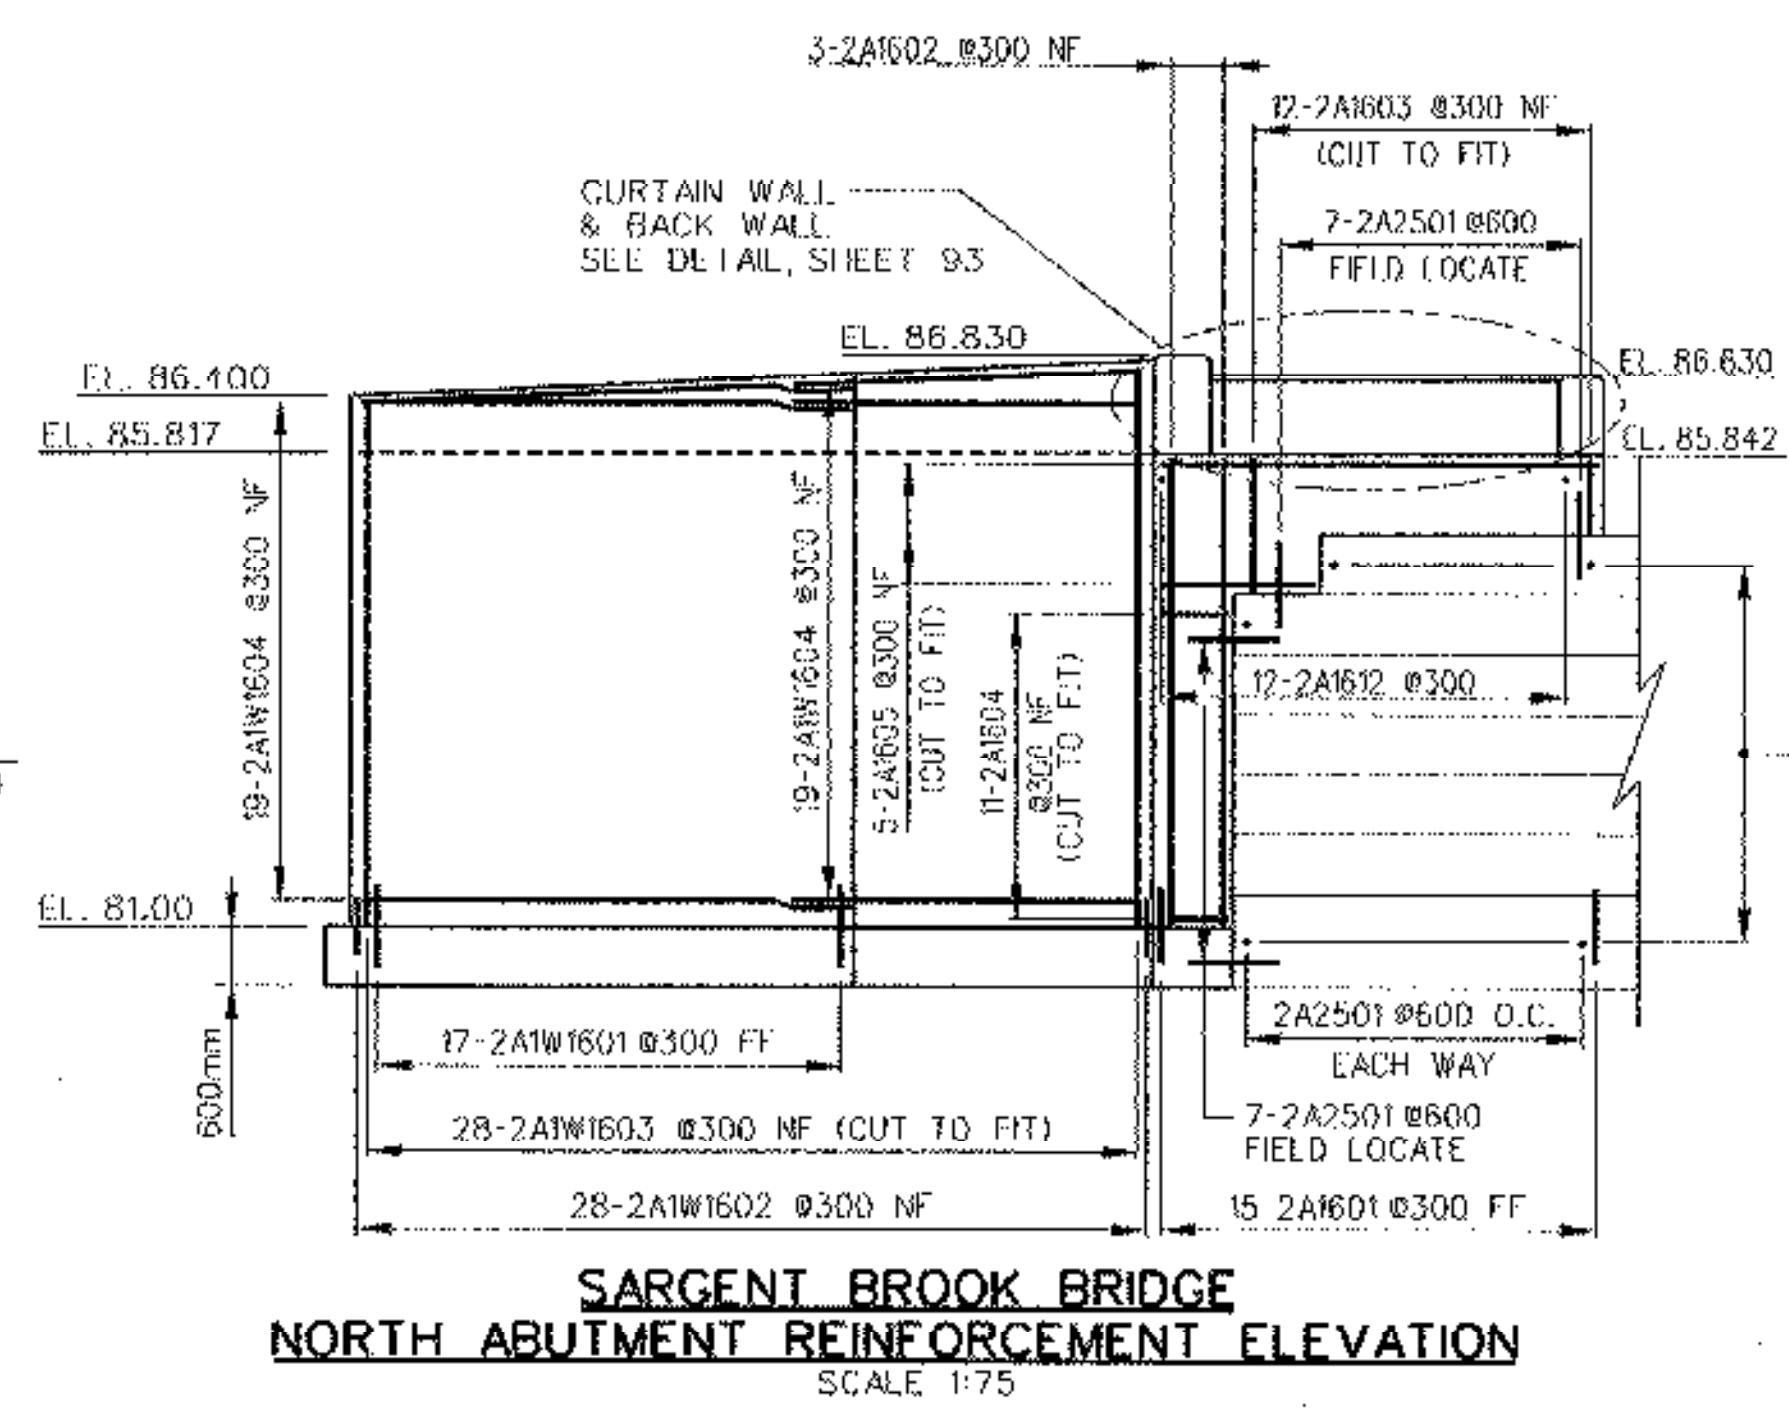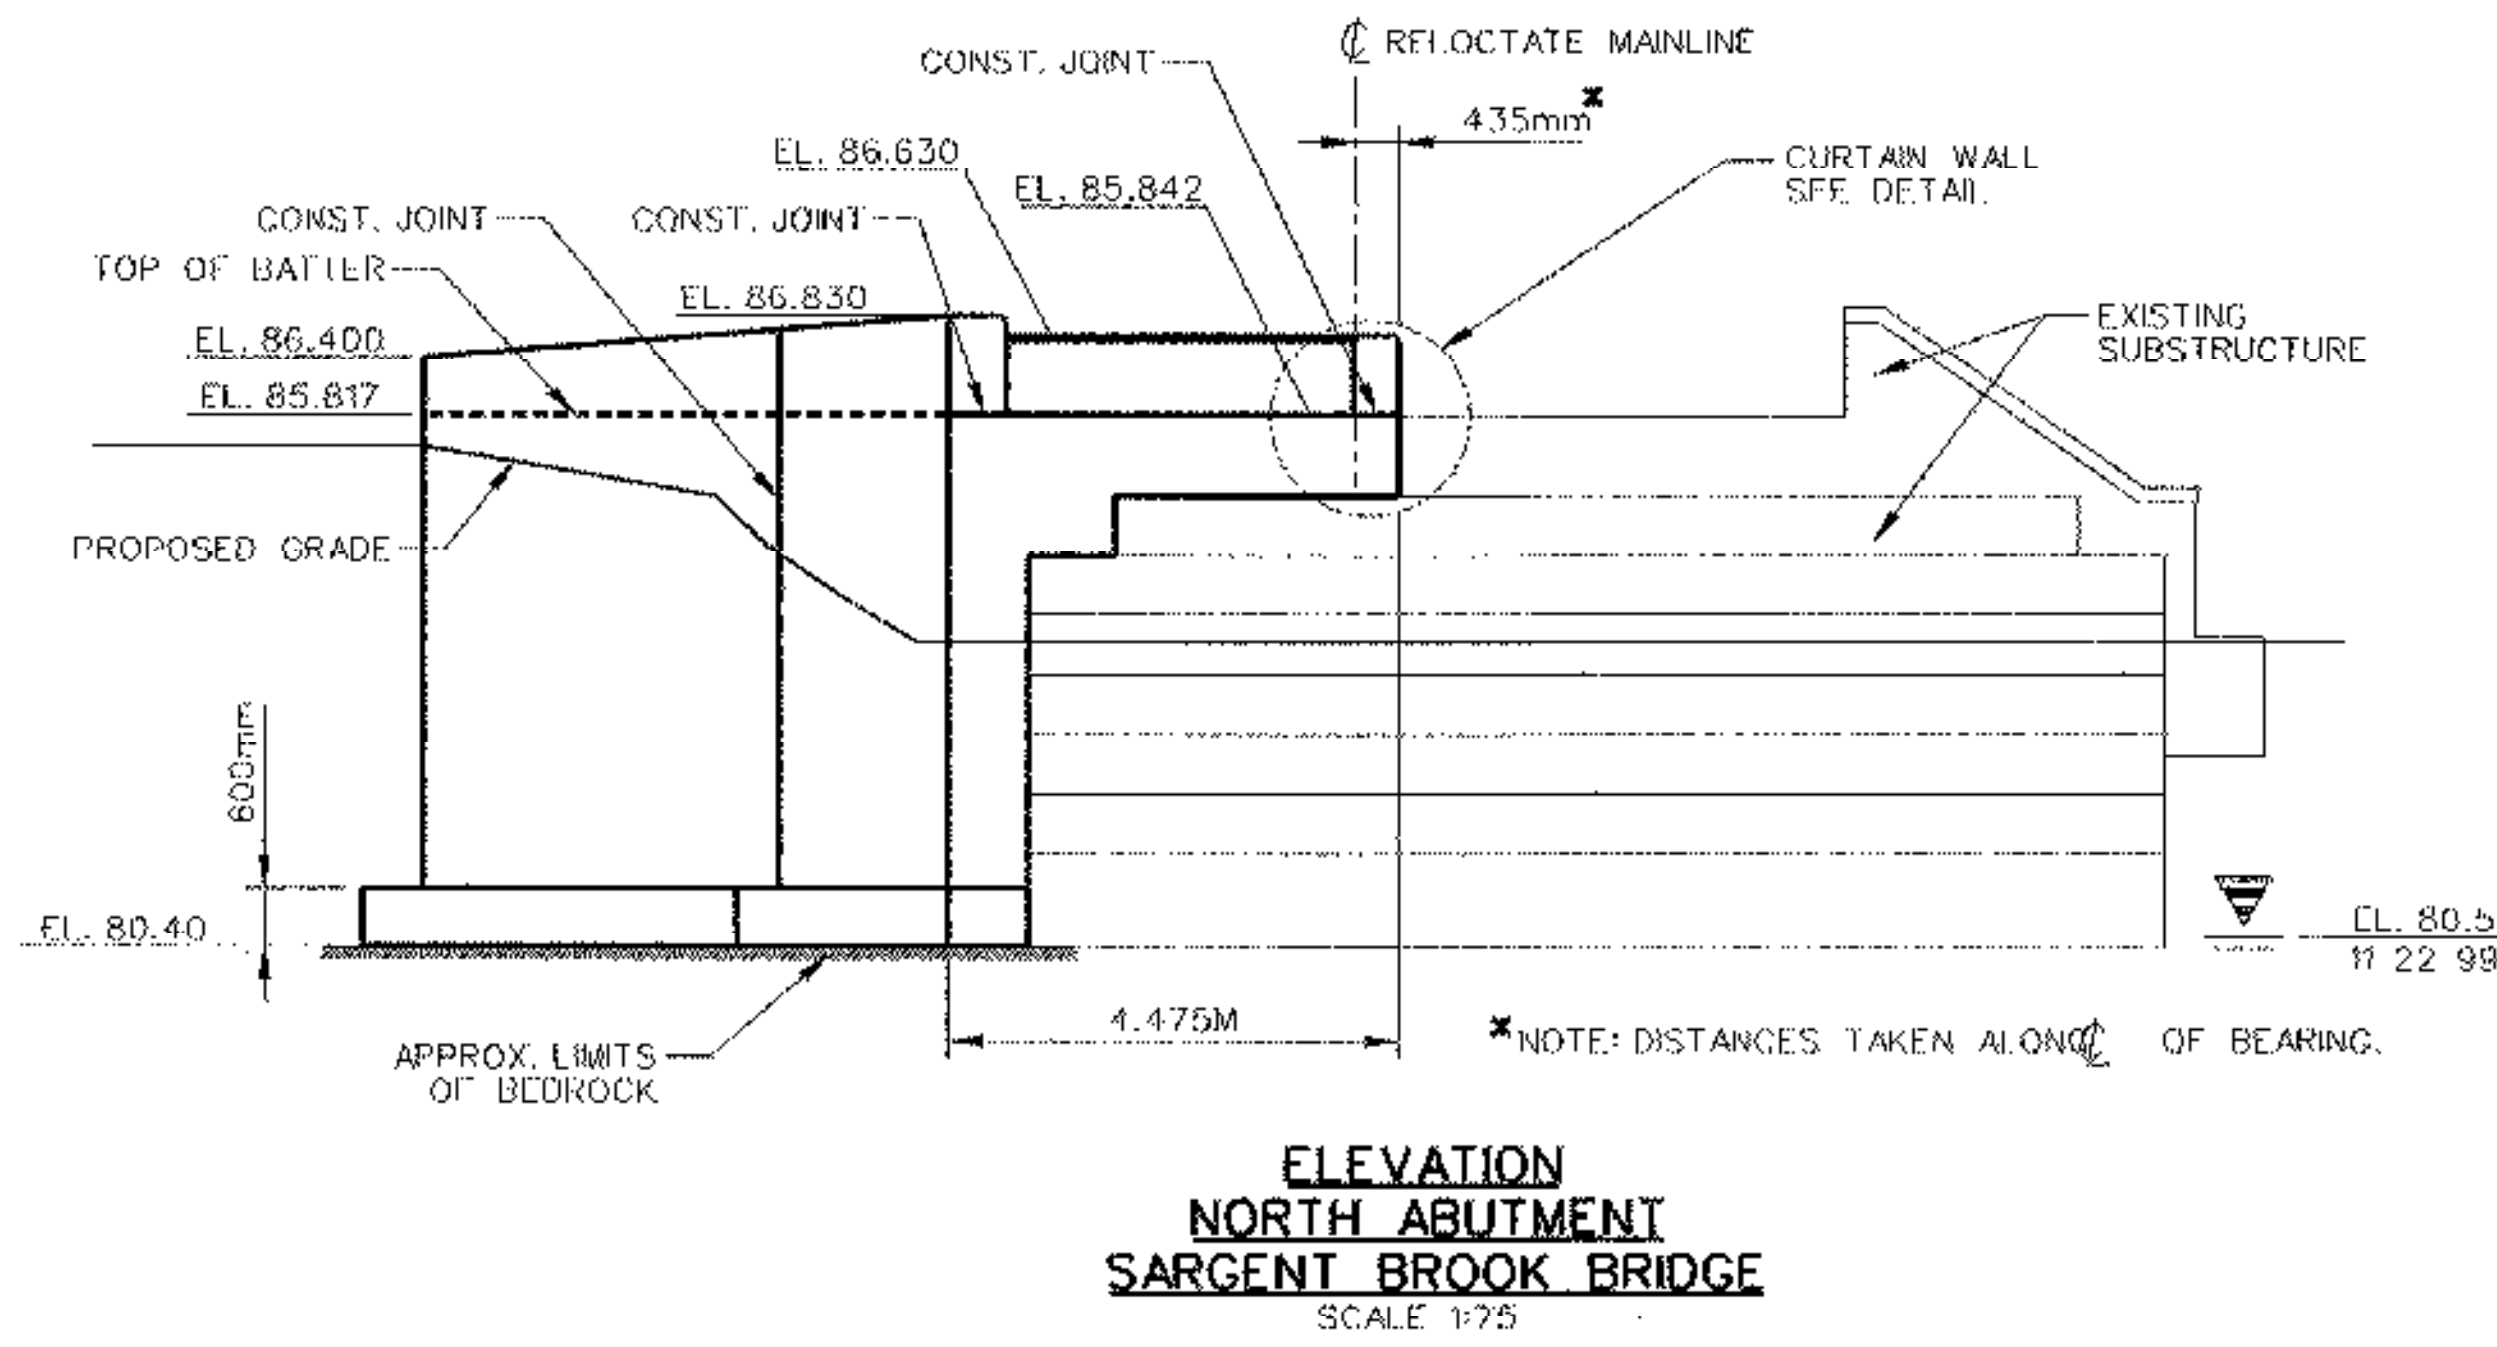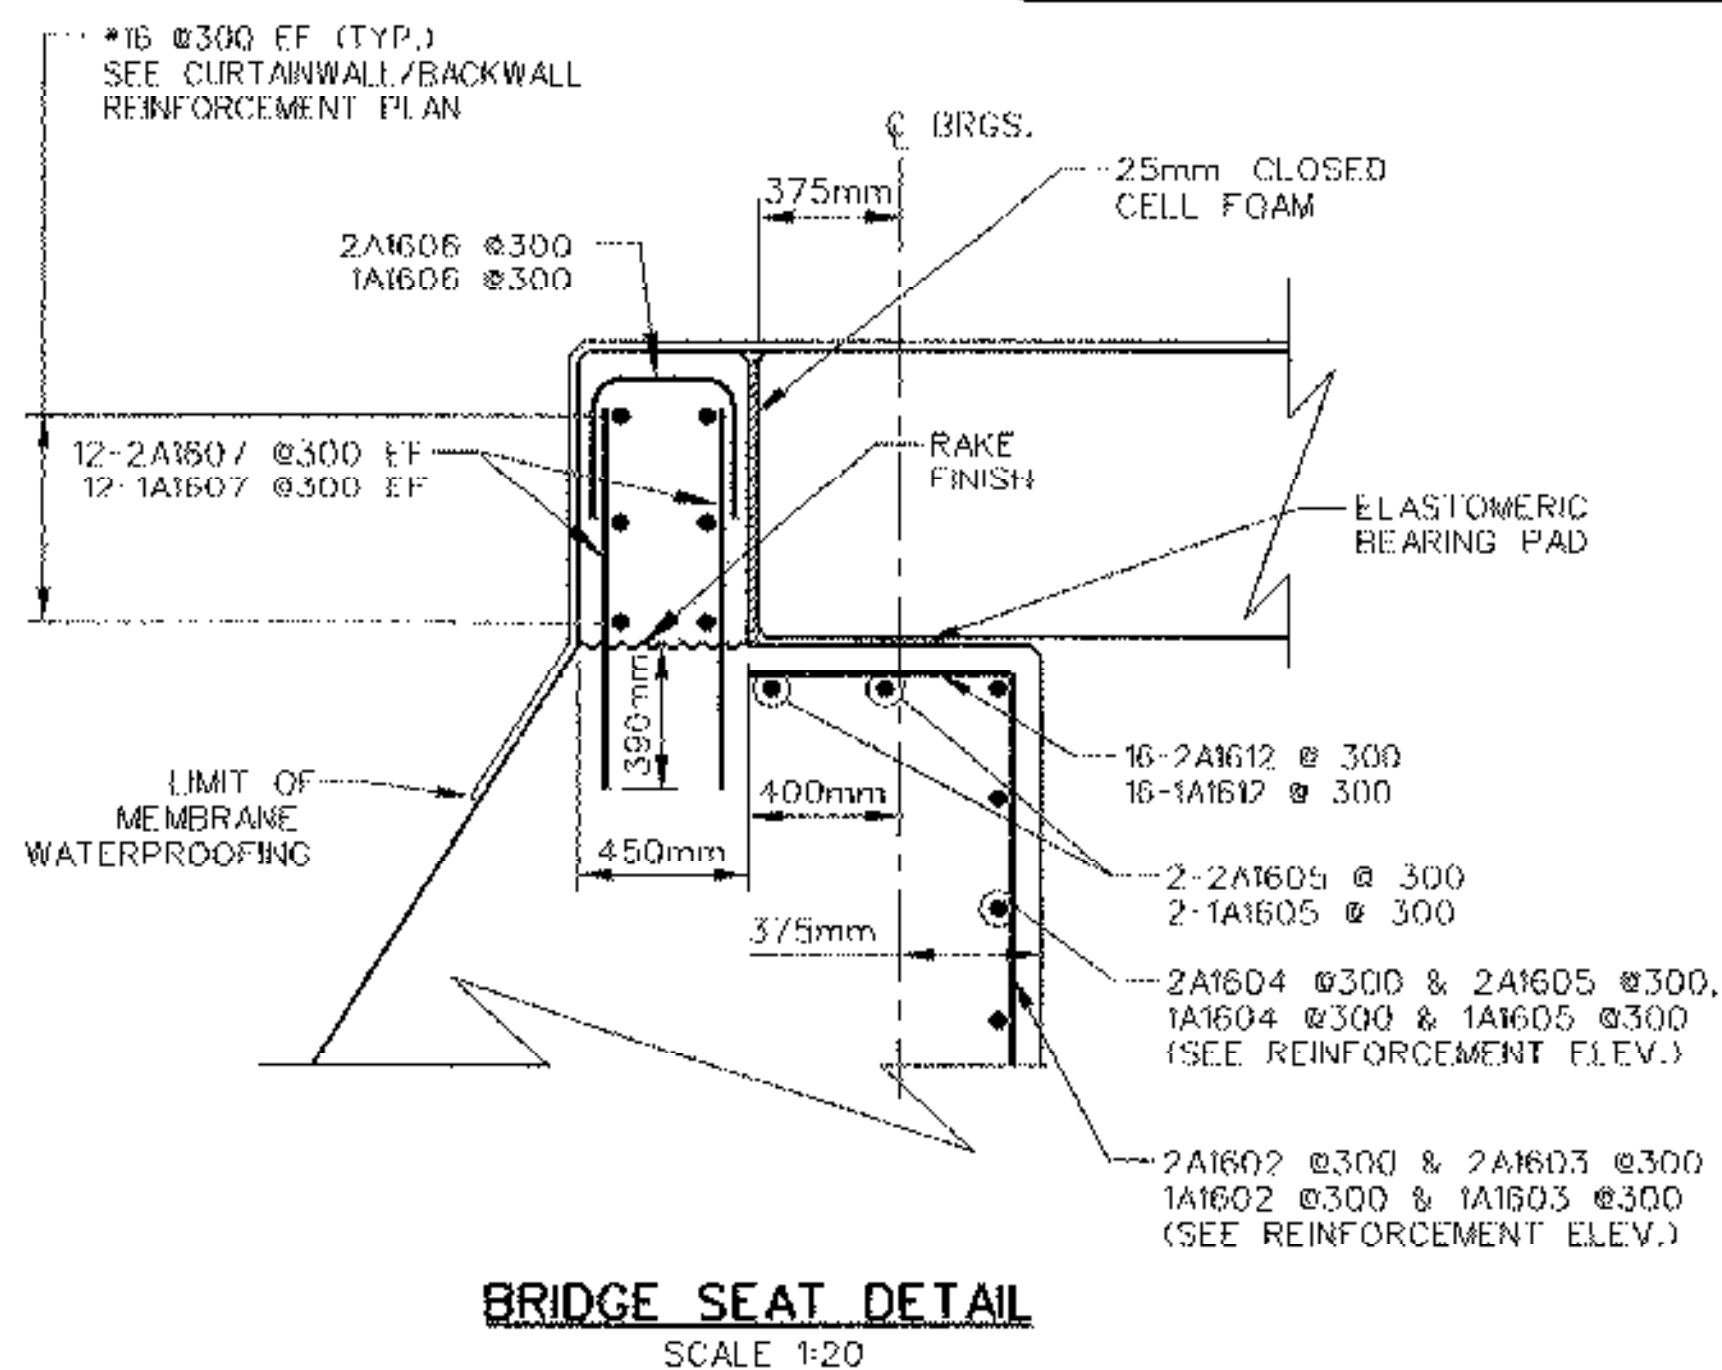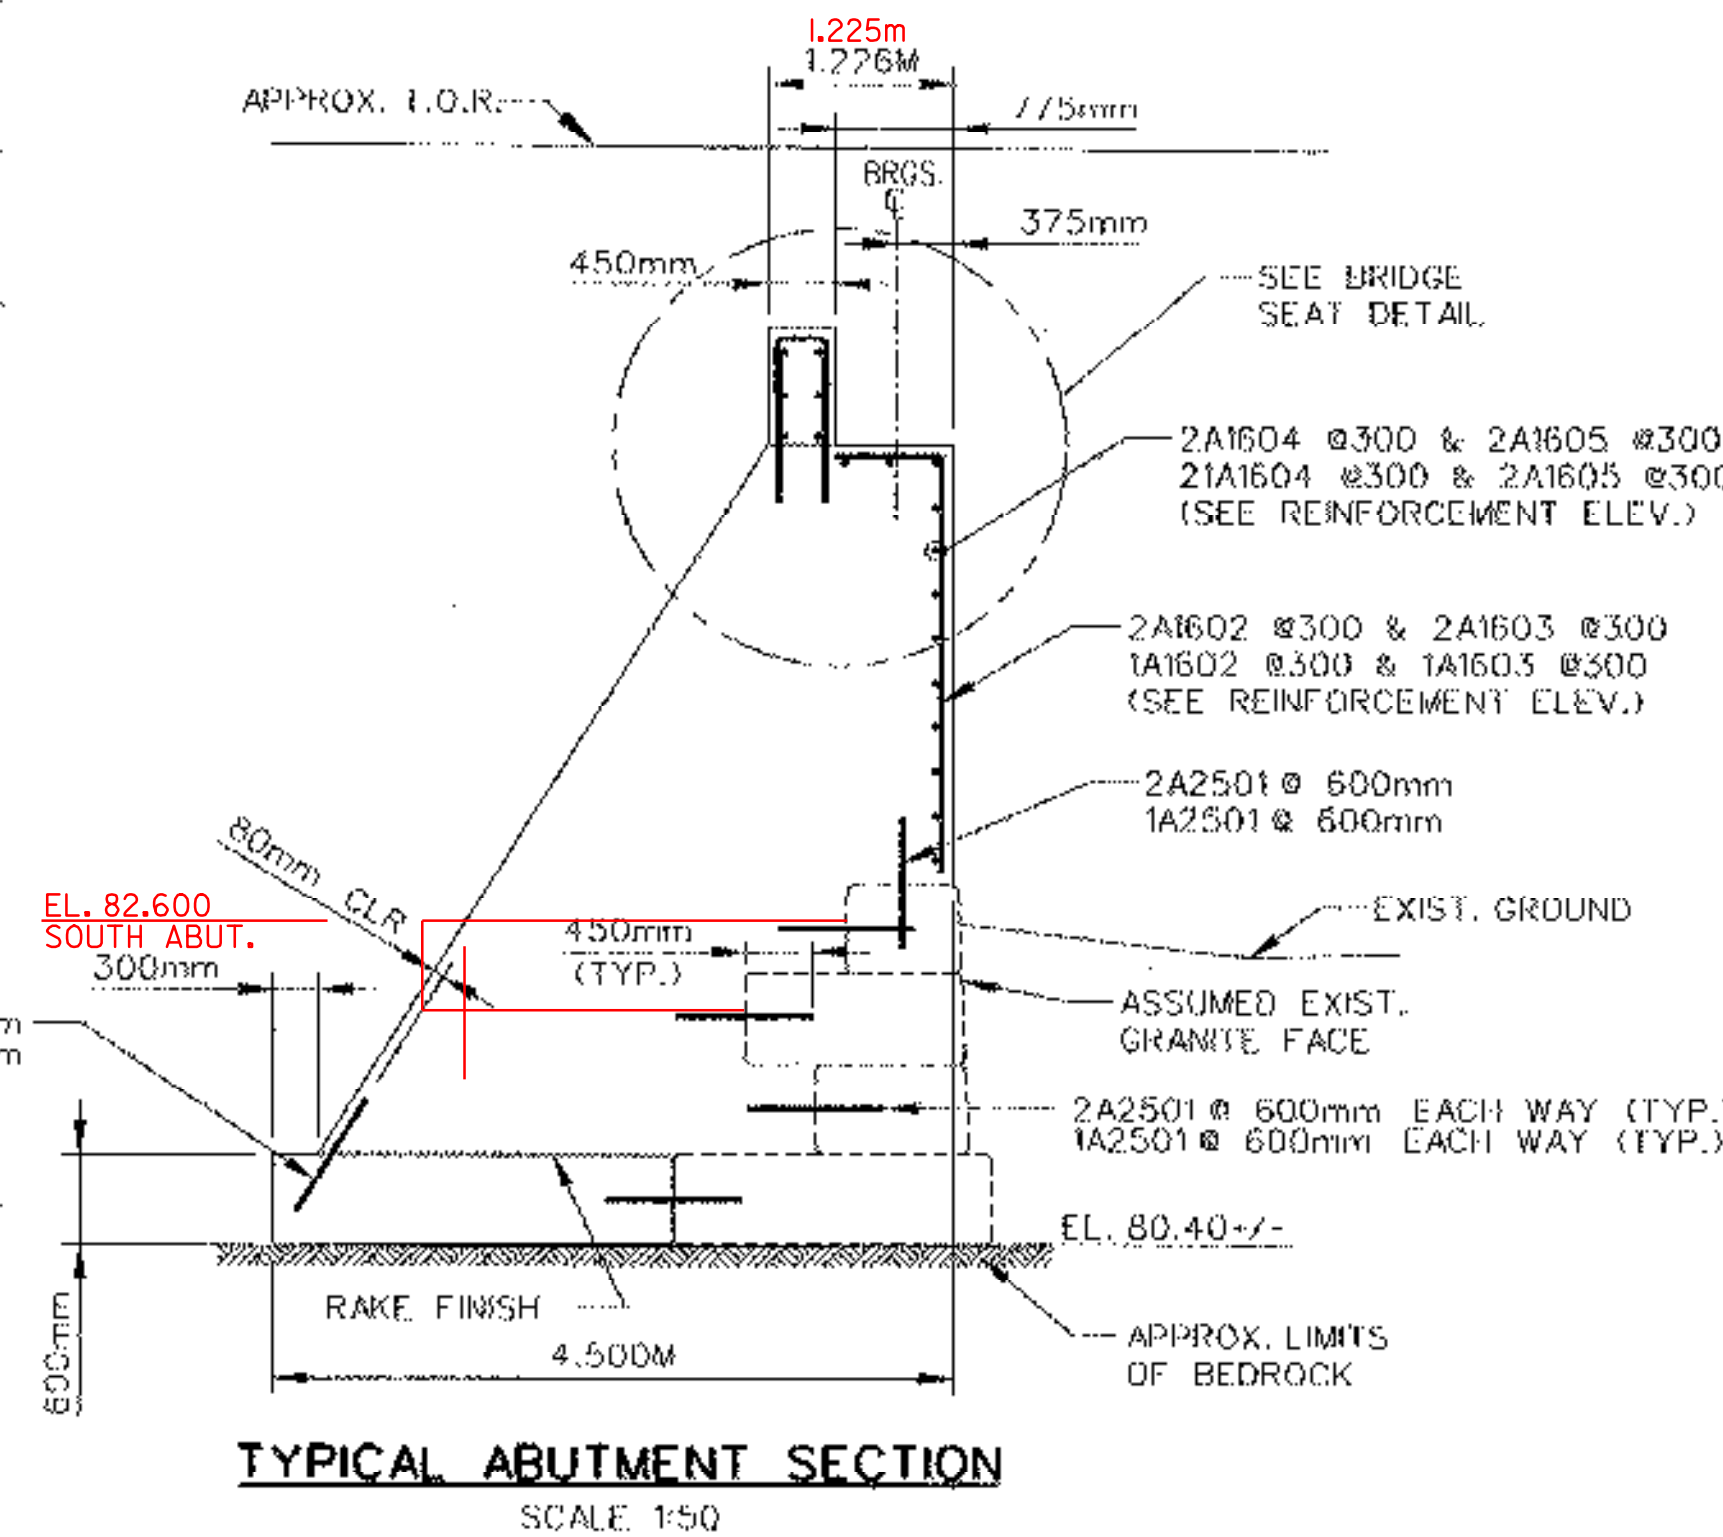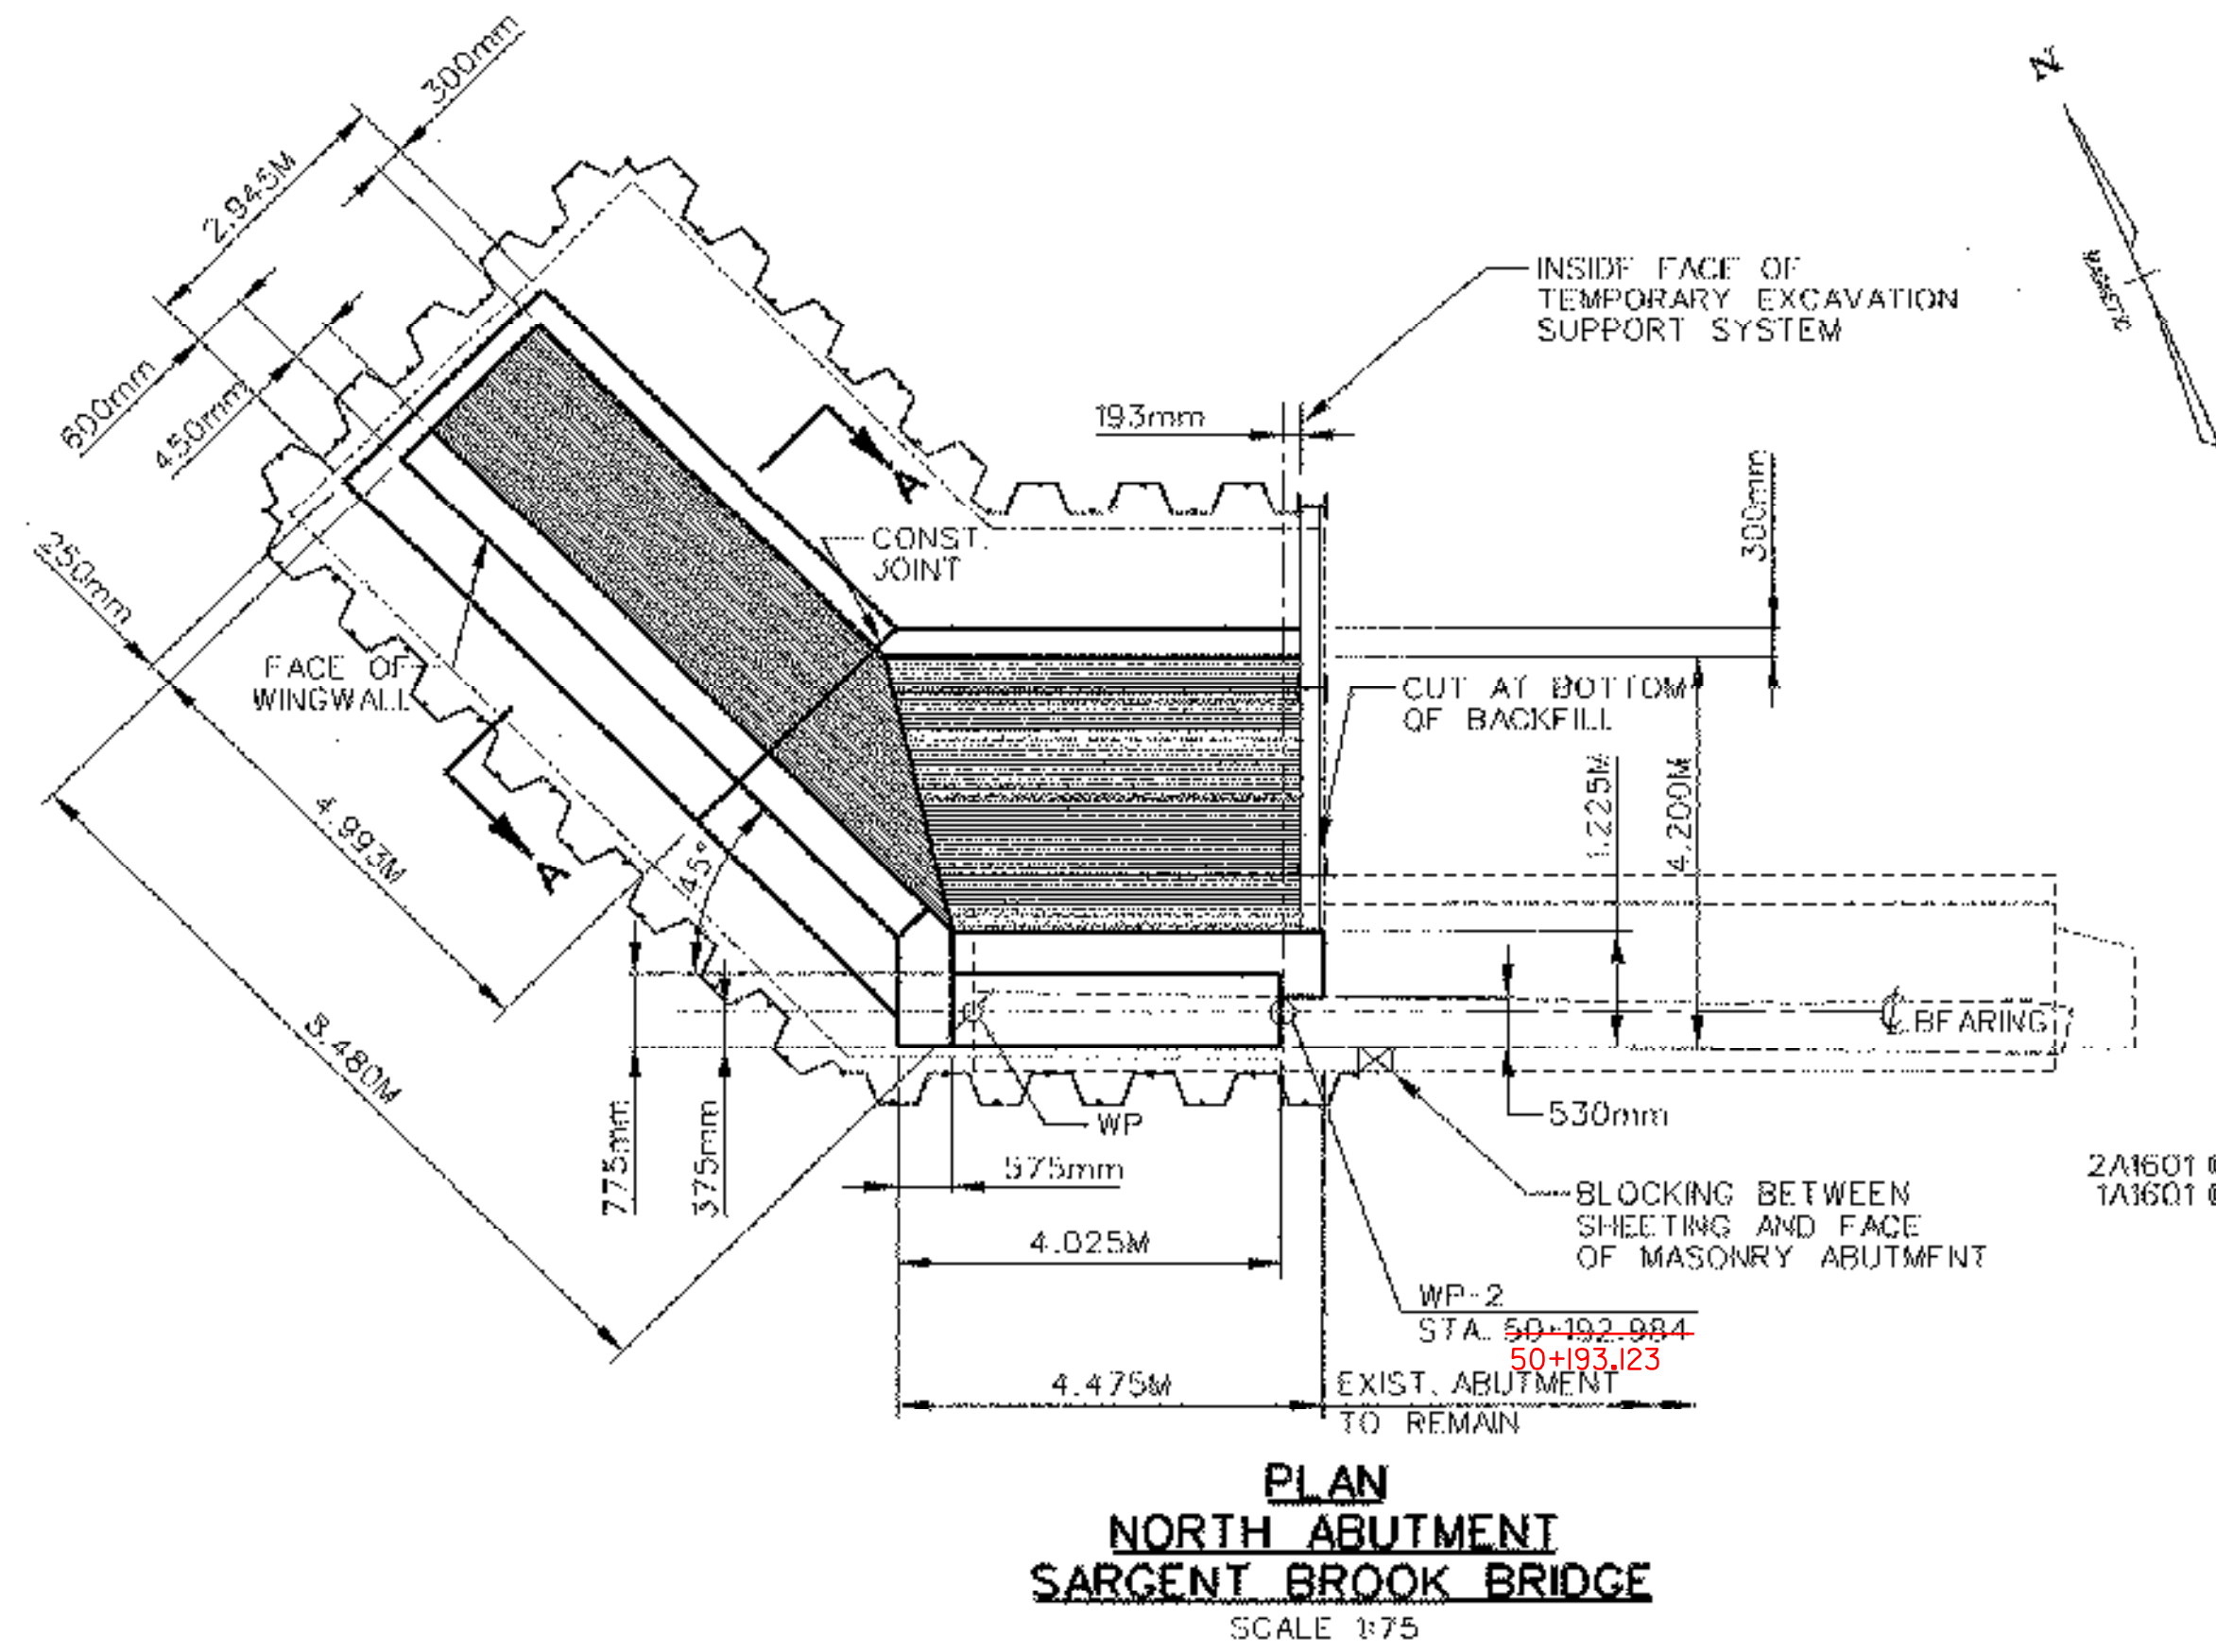

STATE OF VERMONT AGENCY OF TRANSPORTATION		
Town Of	BRATTLEBORO	Bridge No. 62.51
Highway No.	VT. ROUTE 9	Log Sta. Surv. Sta.
SARGENT BROOK		
NORTH ABUTMENT PLAN, ELEVATION AND DETAILS		
Designed By	LM	Drawn By LRD/DHL
Checked By	GJB Date	Bridge Design Supervisor JHR Date
PROJECT	BRATTLEBORO	PROJECT NO. NH 010-2(2)
I.G.C. Info.		Bridge Sheet No. 5
		Sheet 94 of 145

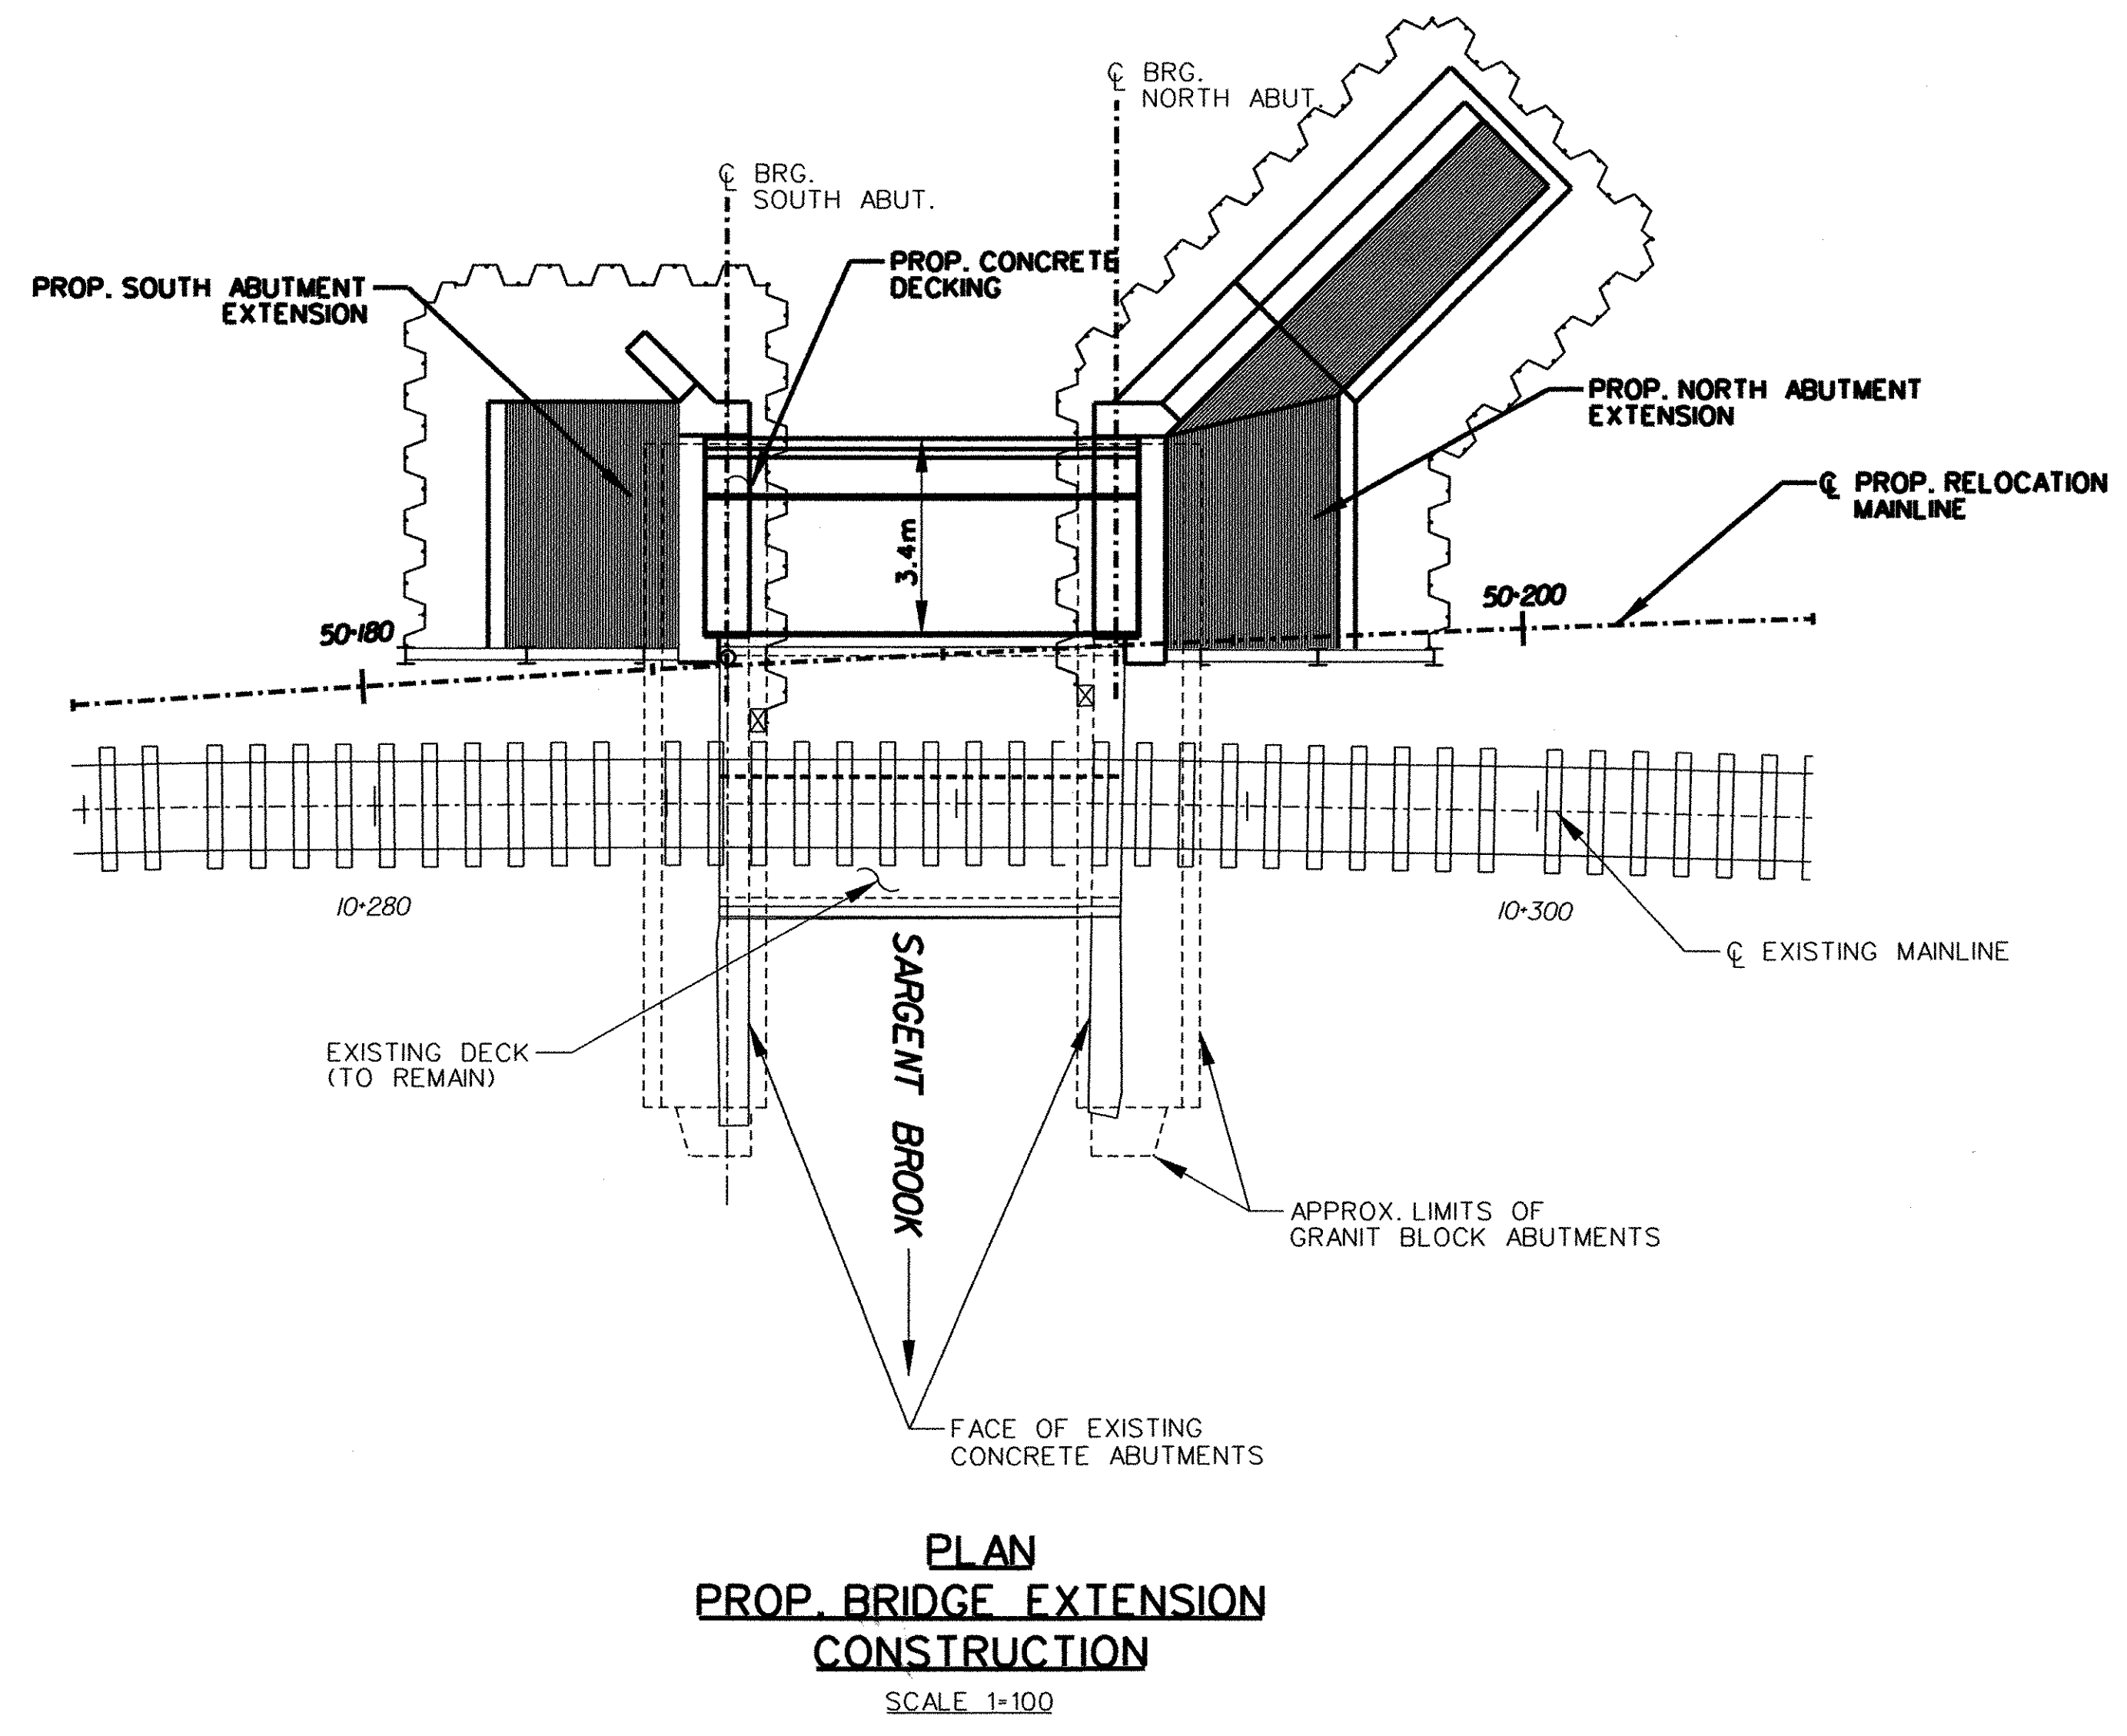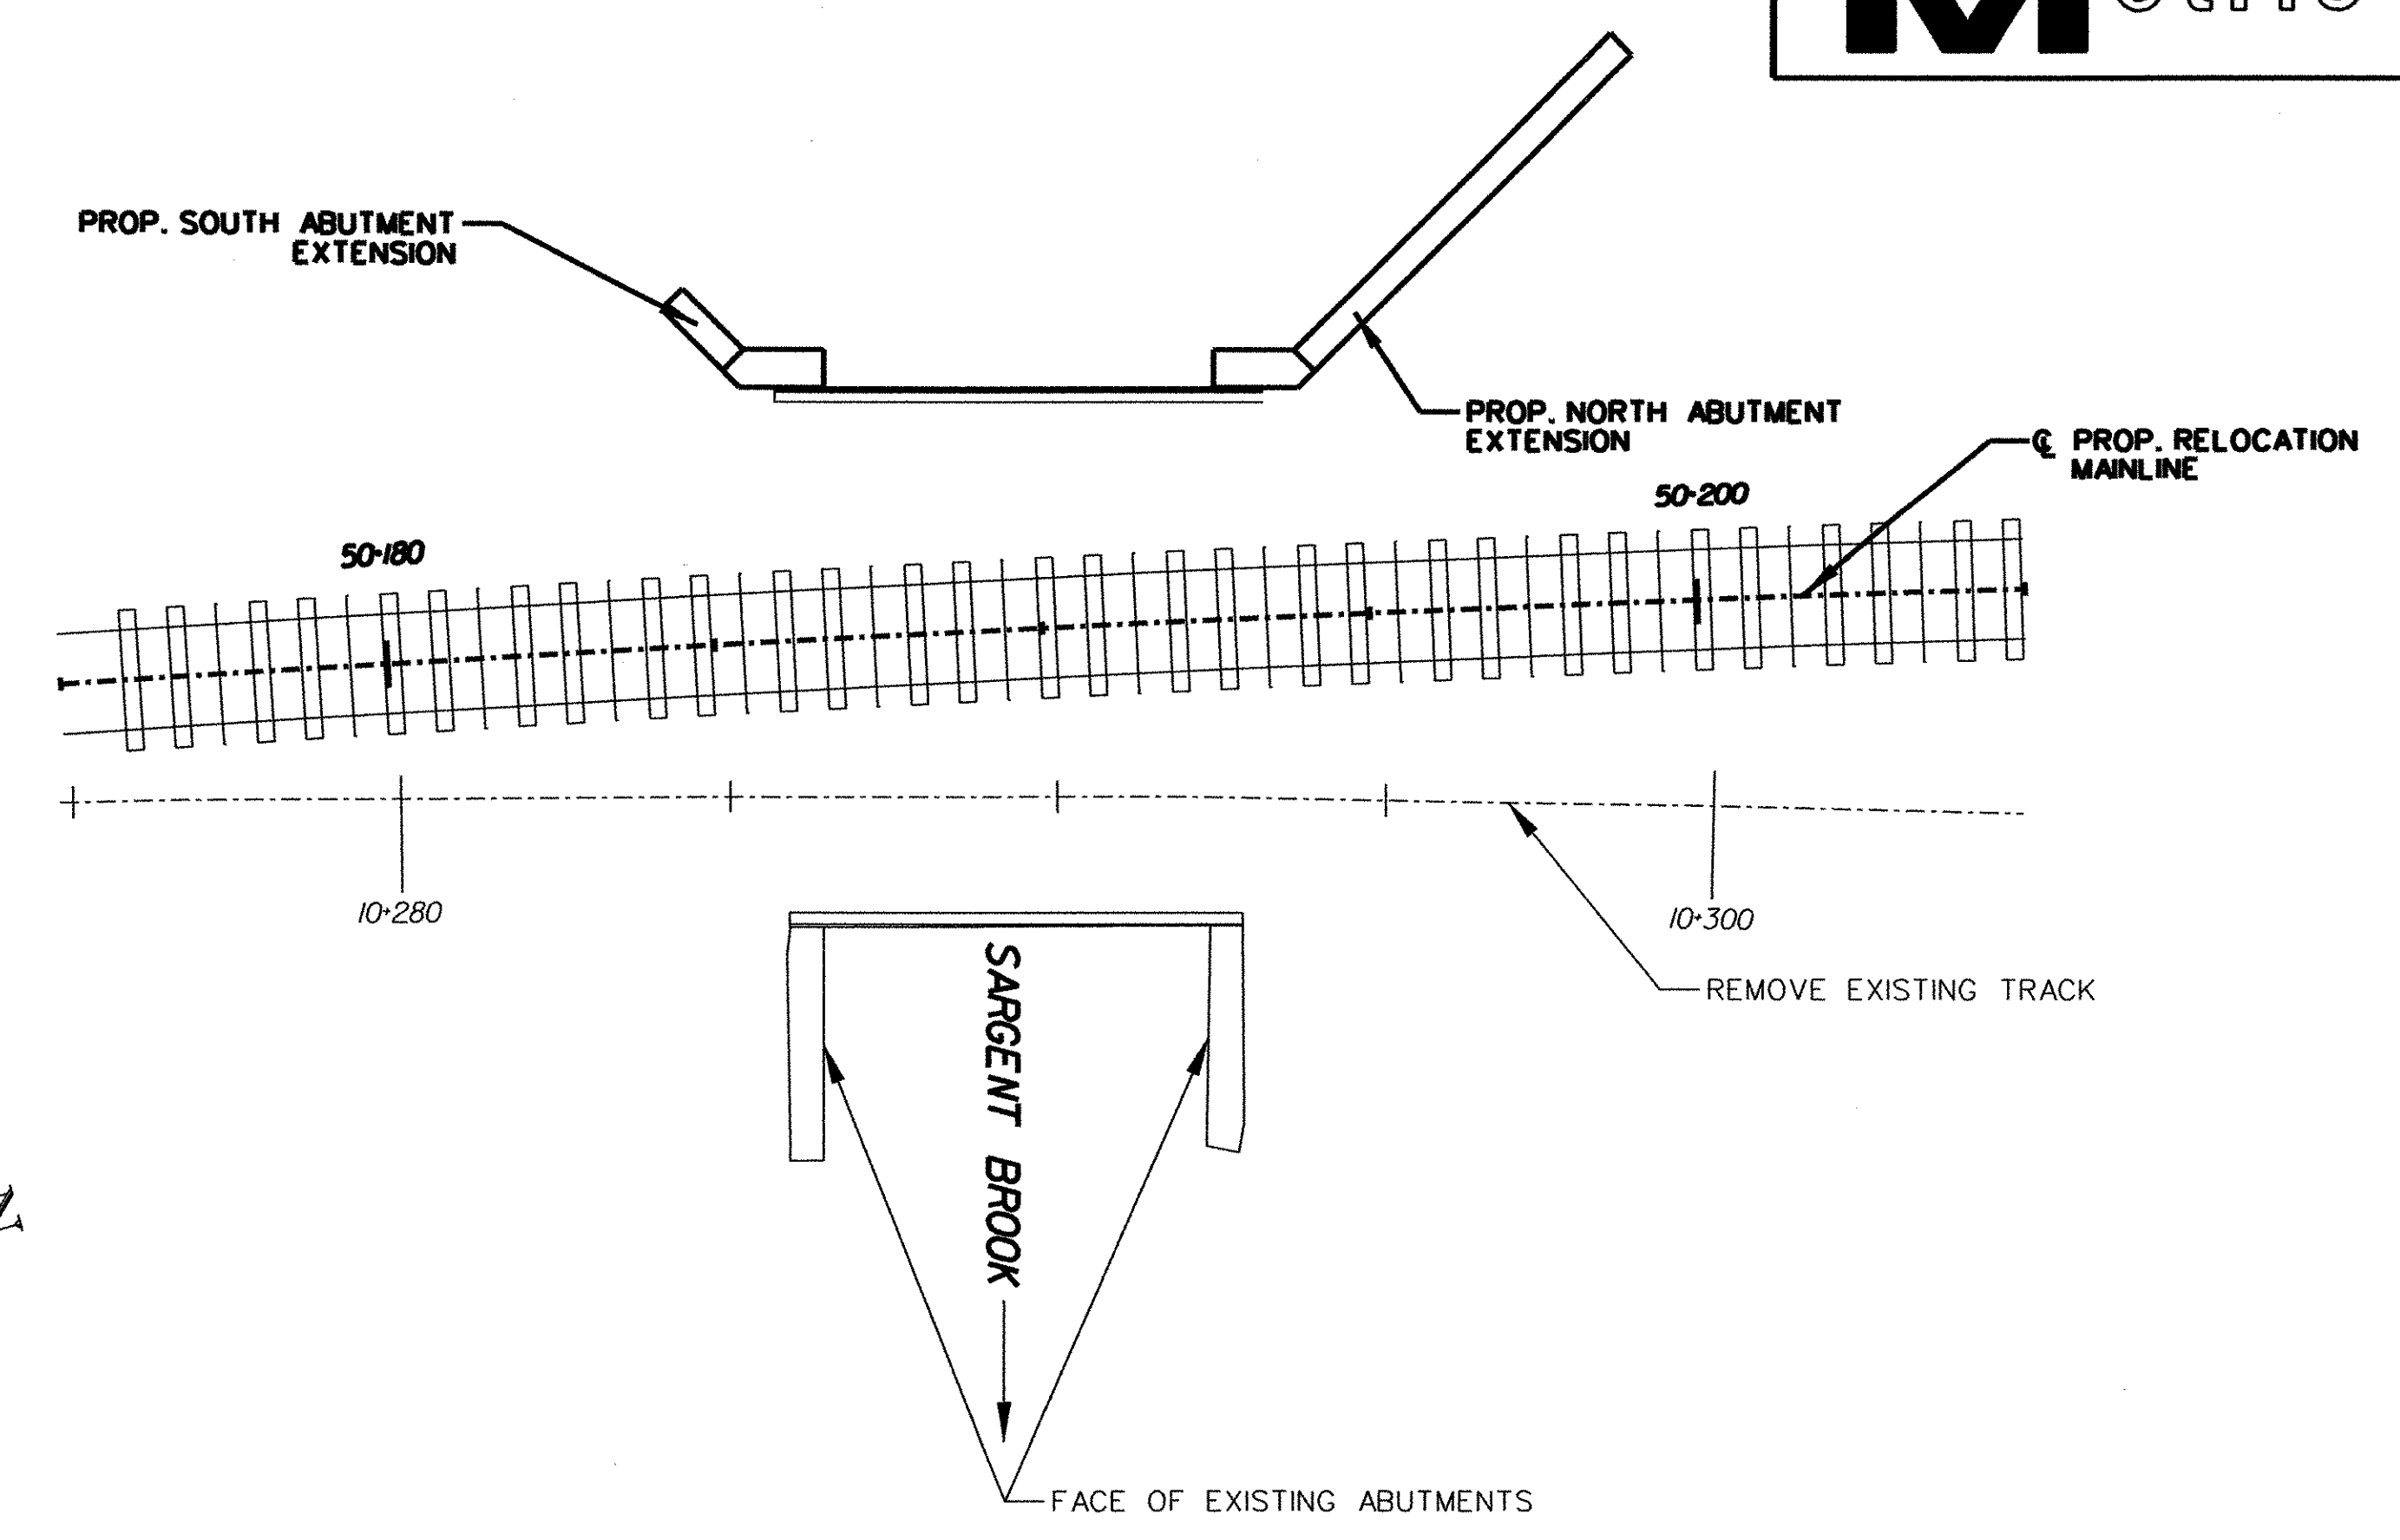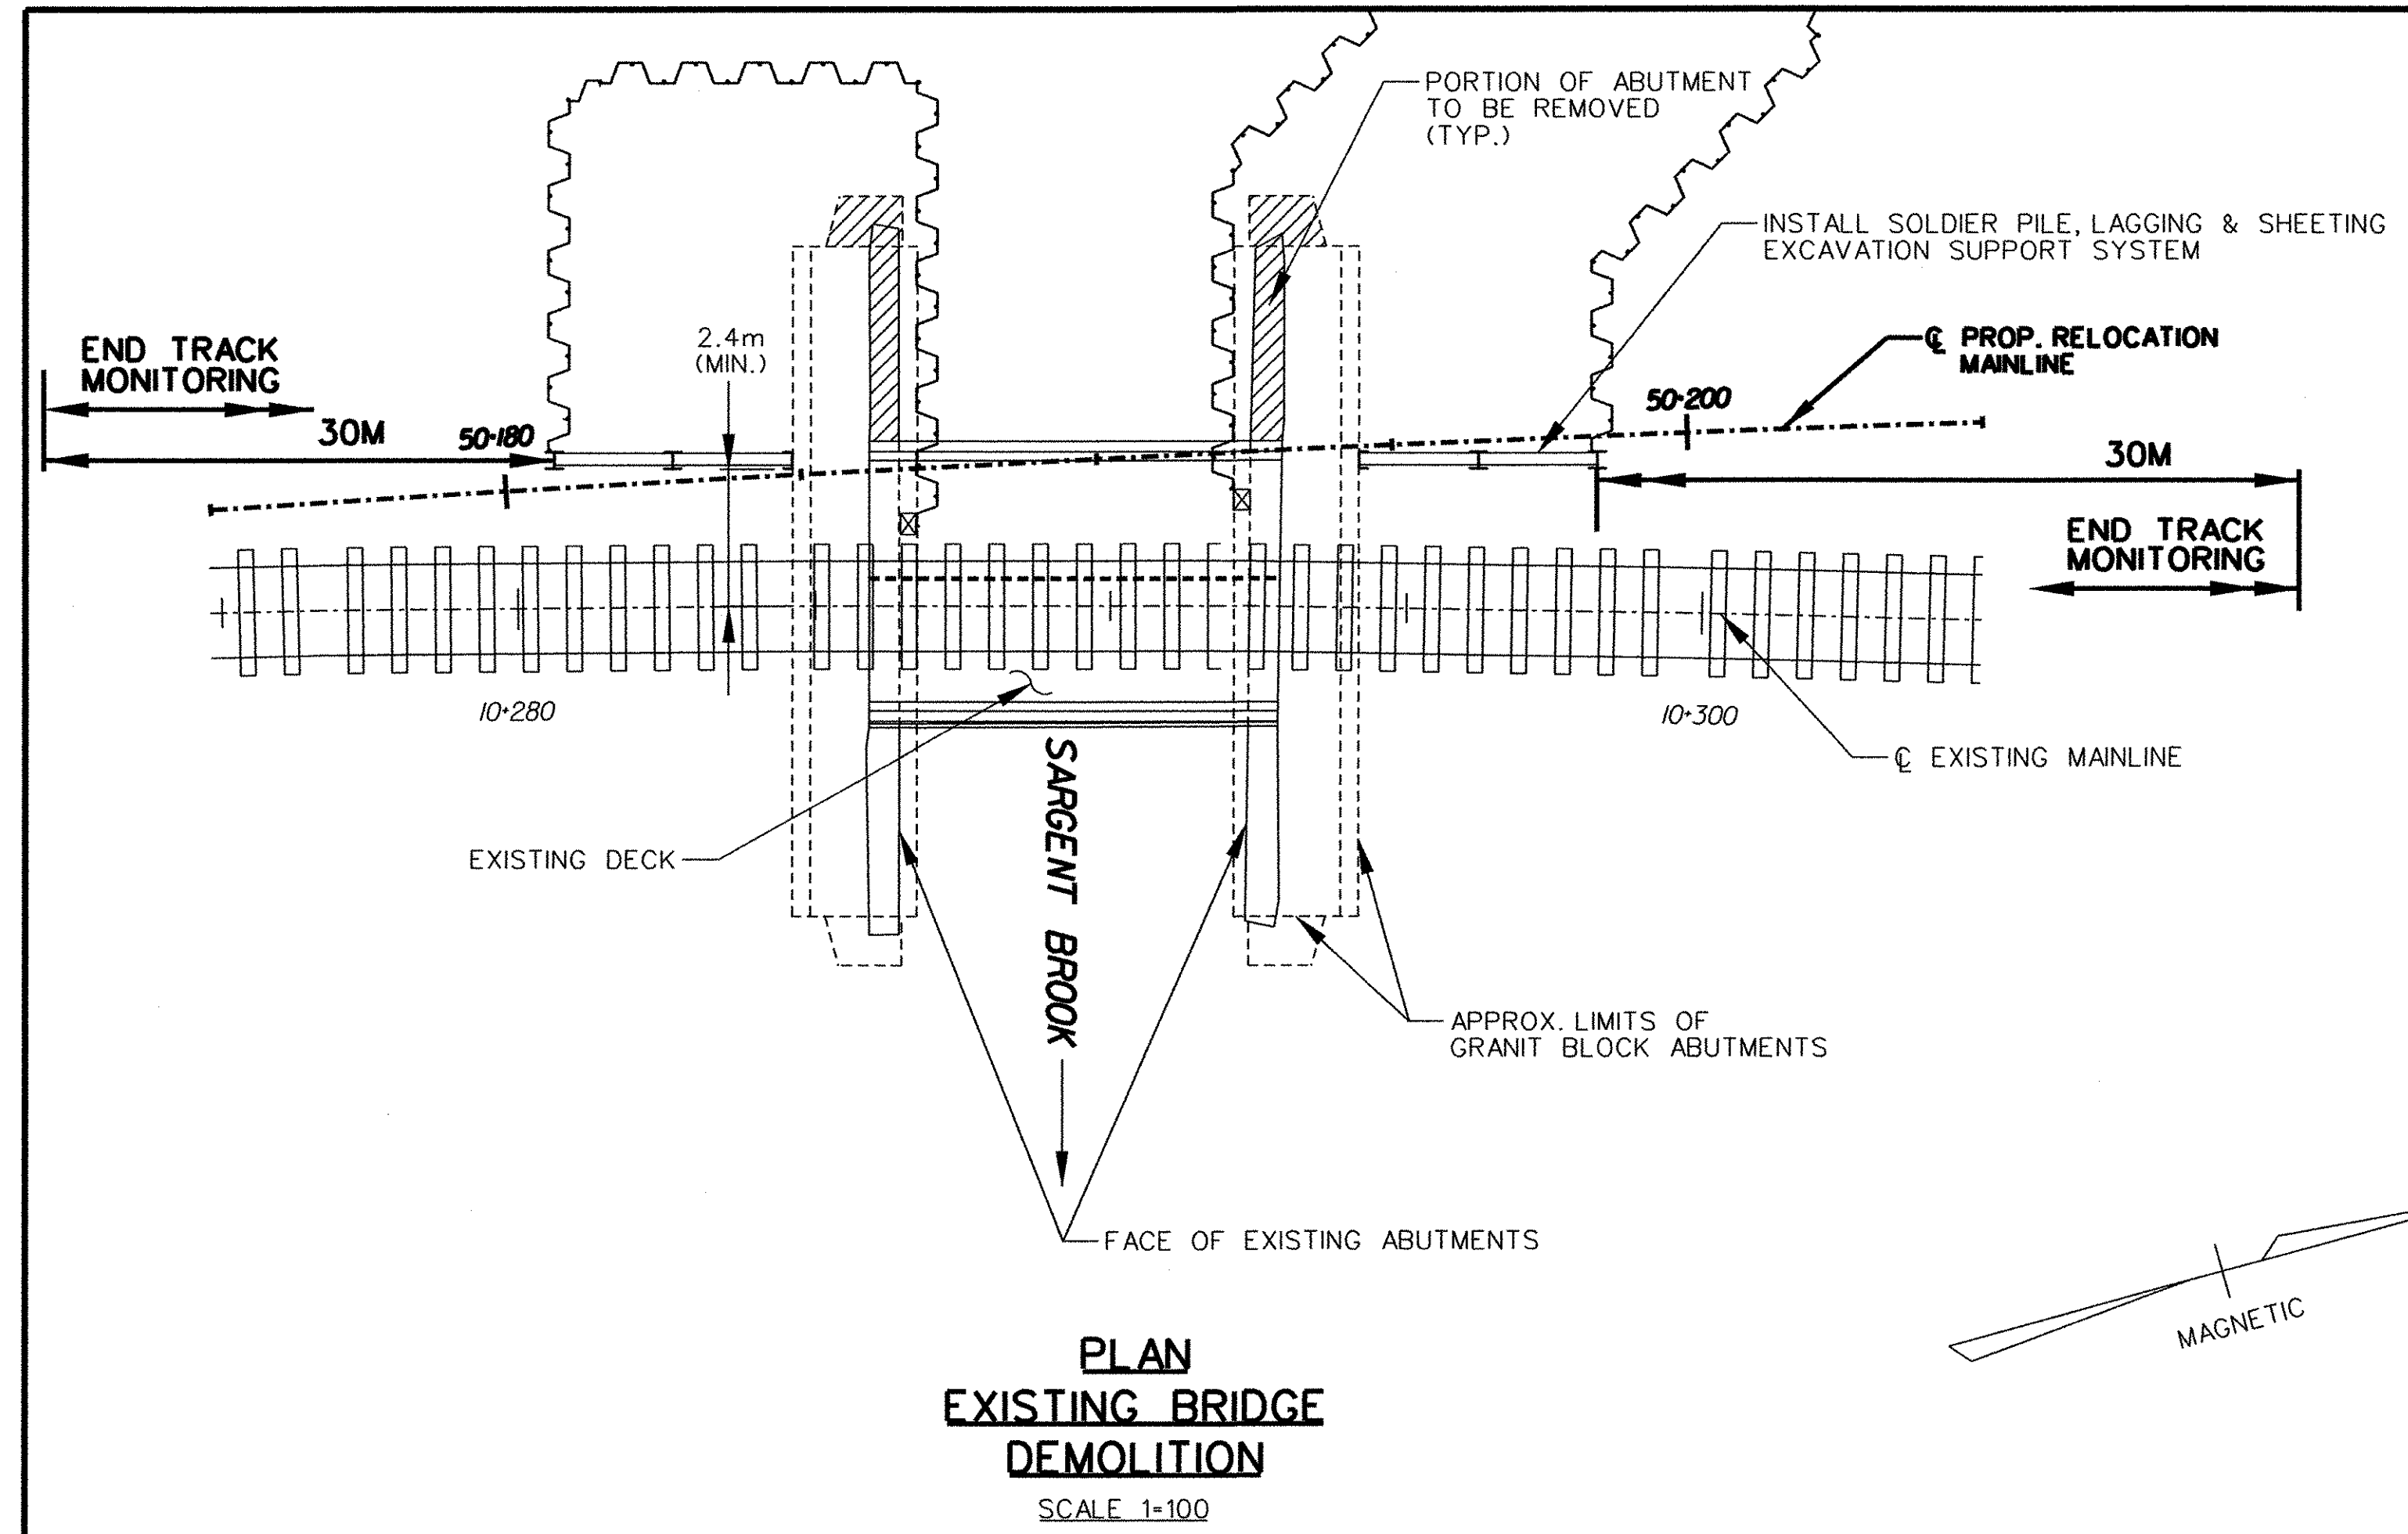


STATE OF VERMONT AGENCY OF TRANSPORTATION			
Town Of	BRATTLEBORO	Bridge No.	62.51
Highway No.	VT. ROUTE 9	Log Sta.	
		Surv. Sta.	
SARGENT BROOK			
CONSTRUCTION STAGING			
Designed By	GJB	Drawn By	DHL
Checked By	TEM	Bridge Design Supervisor	JHR
	Date	Date	
PROJECT	BRATTLEBORO	PROJECT NO.	NH 010-2(2)
I.G.C. Info.			
Bridge Sheet No. 6		Sheet 95 of 145	

EACH	SIZE	LENGTH	MARK	TYPE	A	B	C	D	E	F	G	H	J	K	R	O	ITEM	EACH	SIZE	LENGTH	MARK	TYPE	A	B	C	D	E	F	G	H	J	K	R	O			
Sargent Brook Bridge - Abutment 1A (South Abutment)																																					
16	16	0.900	1A1601	STR																																	
3	16	5.390	1A1602	STR																																	
13	16	2.000	1A1603	STR																																	
14	16	0.700	1A1604	STR																																	
13	16	4.375	1A1605	STR																																	
30	16	0.890	1A1606	17		0.300	0.290	0.300																													
30	16	1.098	1A1607	STR																																	
6	16	0.595	1A1608	STR																																	
10	16	1.298	1A1609	STR																																	
5	16	1.000	1A1610	17		0.300	0.400	0.300																													
6	16	1.125	1A1611	STR																																	
16	16	0.725	1A1612	STR																																	
56	25	0.900	1A2501	STR																																	
Sargent Brook Bridge - Wingwall 1A1W (South Abutment)																																					
16	16	4.675	1A1W1601	17		2.120	0.435	2.120																													
27	19	0.800	1A1W1901	17		0.400	0.400	0.000																													
27	19	3.110	1A1W1902	27		0.565	1.745					0.400																									
27	19	2.600	1A1W1903	27		0.550	1.270					0.390																									
27	19	1.658	1A1W1904	17		0.610	0.438	0.610																													
Sargent Brook Bridge - Abutment 2A (North Abutment)																																					
16	16	0.900	2A1601	STR																																	
3	16	4.792	2A1602	STR																																	
12	16	1.250	2A1603	STR																																	
11	16	0.750	2A1604	STR																																	
13	16	4.375	2A1605	STR																																	
30	16	0.890	2A1606	17		0.300	0.290	0.300																													
30	16	1.098	2A1607	STR																																	
6	16	0.595	2A1608	STR																																	
10	16	1.298	2A1609	STR																																	
5	16	1.000	2A1610	17		0.300	0.400	0.300																													
6	16	1.125	2A1611	STR																																	
16	16	0.725	2A1612	STR																																	
50	25	0.900	2A2501	STR																																	
Sargent Brook Bridge - Wingwall 2A2W (North Abutment)																																					
17	16	0.900	2A1W1601	STR																																	
28	16	0.600	2A1W1602	STR																																	
28	16	5.780	2A1W1603	STR																																	
19	16	3.500	2A1W1604	STR																																	
19	16	4.950	2A1W1605	STR																																	



~ NOTES ~

- UNLESS OTHERWISE DESIGNATED, ALL BAR REINFORCEMENT FOR CONCRETE IN SIZES UP TO AND INCLUDING 55M SHALL CONFORM TO THE REQUIREMENTS OF THE "SPECIFICATIONS FOR DEFORMED BILLET-STEEL BARS FOR CONCRETE REINFORCEMENT", AASHTO M 31M (ASTM A 615M-SI). ALL BARS SHALL BE GRADE 420, UNLESS OTHERWISE DESIGNATED.
- FOR TYPICAL BENDING DETAILS, RECOMMENDED PIN DIAMETER "D" OF BENDS AND HOOKS, AND OTHER STANDARD PRACTICE, SEE CURRENT CONCRETE REINFORCING STEEL INSTITUTE "MANUAL OF STANDARD PRACTICE".
- BARS WHICH REQUIRE MORE ACCURATE BENDING THAN STANDARD PRACTICES SHOULD HAVE LIMITS INDICATED.
- ALL DIMENSIONS ARE OUT TO OUT OF BAR EXCEPT "A" AND "G" ON STANDARD 180 DEGREE AND 135 DEGREE HOOKS.
- "J" DIMENSION ON 180 DEGREE HOOKS TO BE SHOWN ONLY WHERE NECESSARY TO RESTRICT HOOK SIZE. OTHERWISE, STANDARD HOOKS ARE TO BE USED.
- "H" DIMENSION ON STIRRUPS TO BE SHOWN ONLY WHEN NECESSARY TO MAINTAIN CLEARANCES.
- WHERE SLOPE DIFFERS FROM 45 DEGREES, DIMENSIONS "H" AND "K" MUST BE SHOWN.
- DENOTES BARS TO BE CUT IN FIELD.
- ◆ DENOTES ONE EXTRA BAR ADDED FOR TESTING PURPOSES.
- ⊕ DENOTES TWO EXTRA BARS ADDED FOR TESTING PURPOSES.
- "E" IN PREFIX DENOTES EPOXY COATED REINFORCING STEEL.


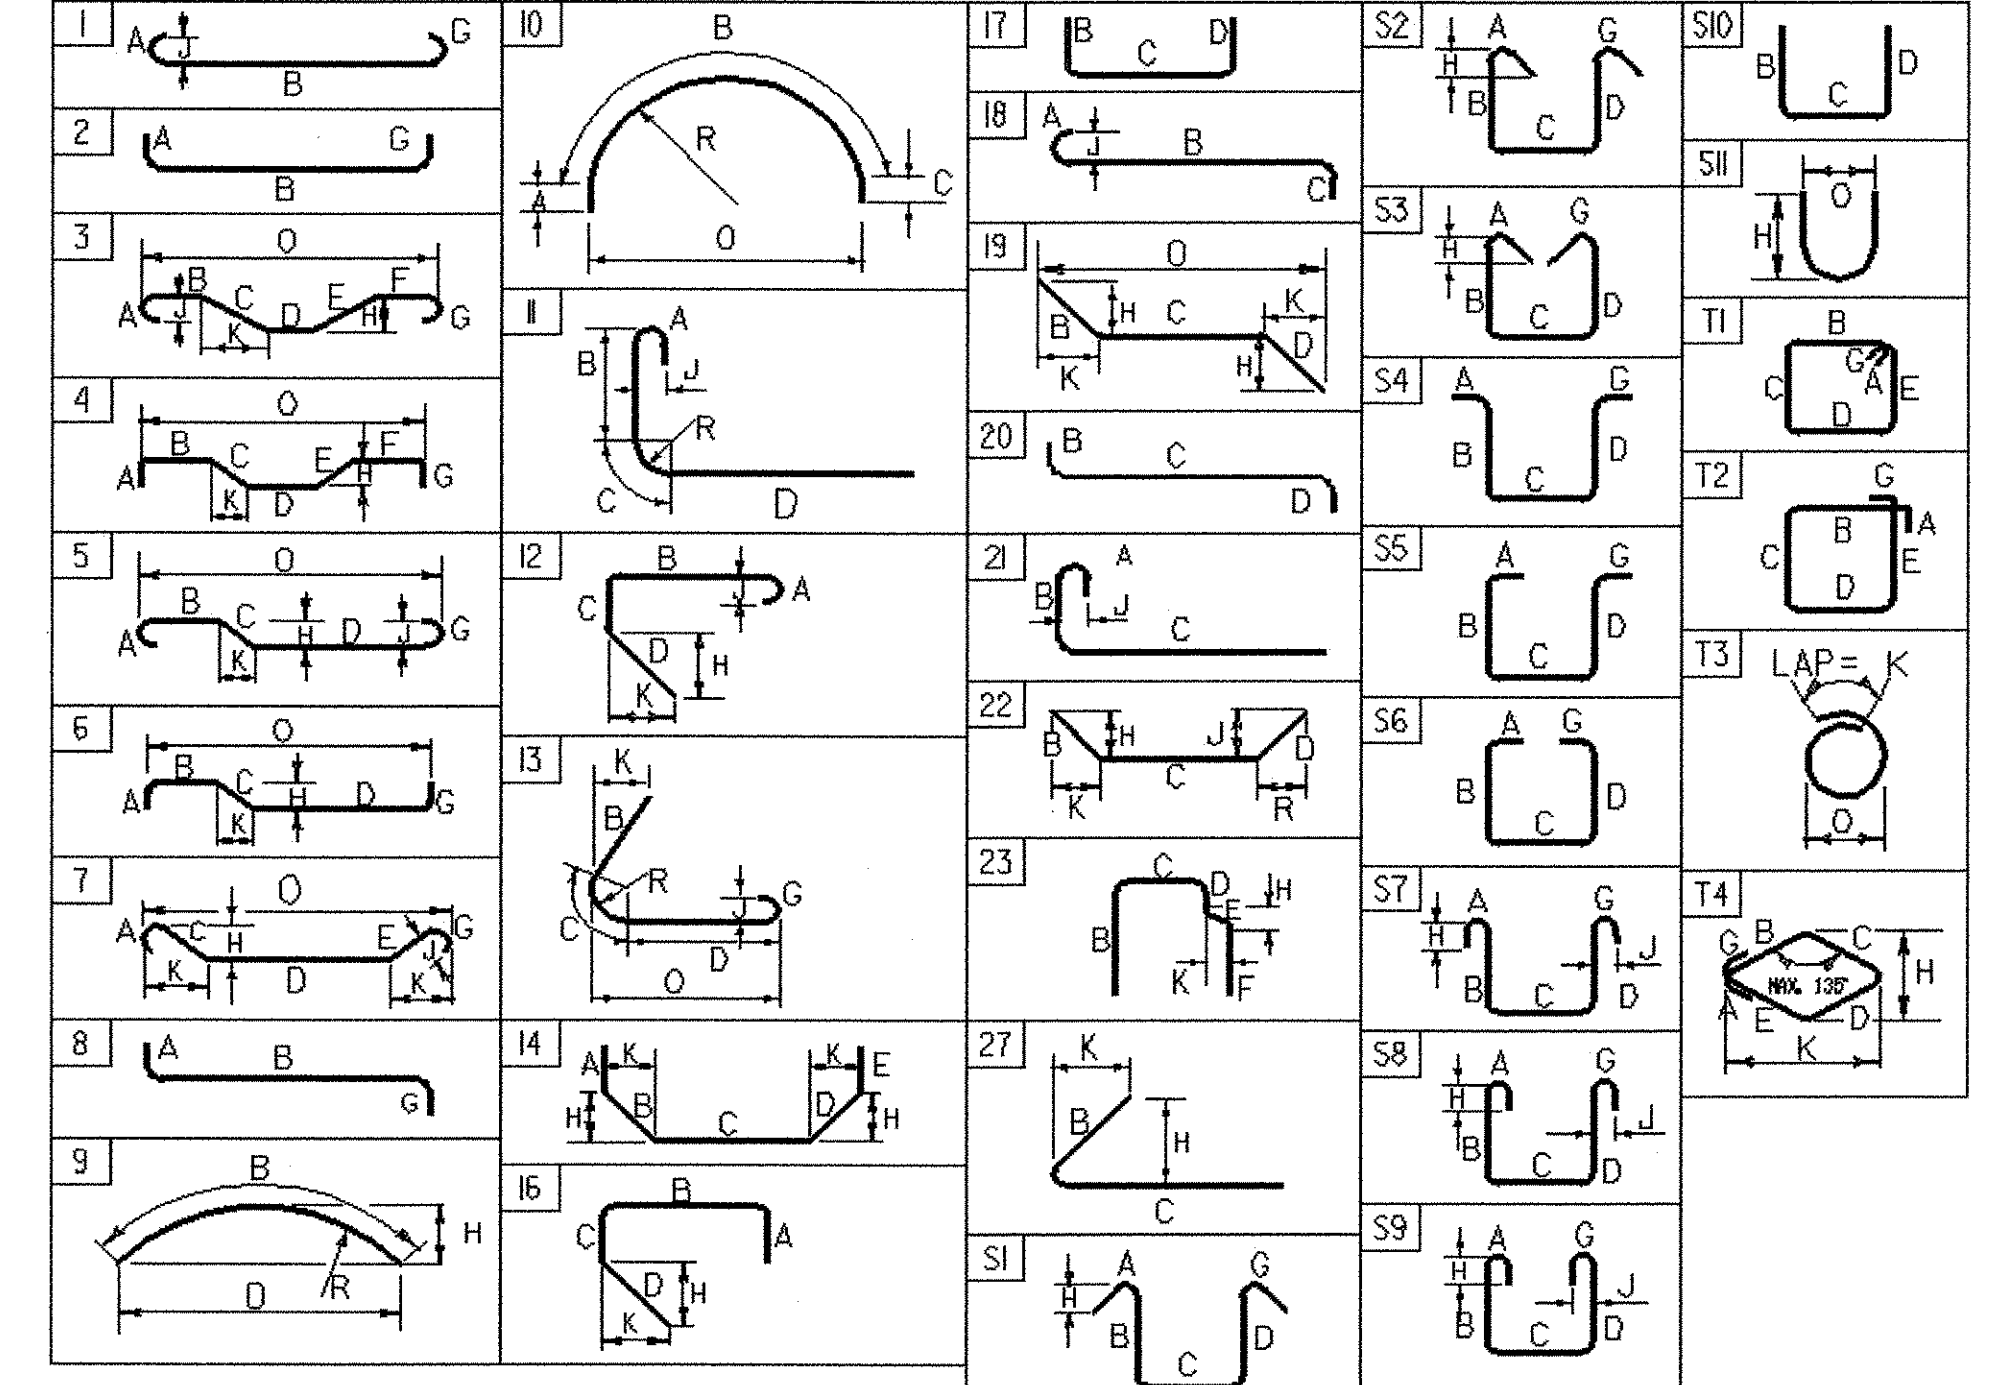


BAR SIZE	NOMINAL MASS (Kg/m)	NOMINAL DIMENSIONS ROUND SECTION		
		DIAMETER (mm)	CROSS SECTIONAL AREA (mm ²)	PERIMETER (mm)
#10	0.560	9.5	71	29.84
#13	0.994	12.7	129	39.90
#16	1.552	15.9	199	49.95
#19	2.235	19.1	284	60.00
#22	3.042	22.2	387	69.74
#25	3.973	25.4	510	79.80
#29	5.060	28.7	645	90.16
#32	6.404	32.3	819	101.47
#36	7.907	35.8	1006	112.47
#43	11.380	43.0	1452	135.09
#57	20.240	57.3	2581	180.01



PROJECT NAME: **BRATTLEBORO**
 PROJECT NUMBER: **NH 010-2(2)**
 FILE NAME: **7010100100** PLOT DATE: **10-02-2002**
 PROJECT LEADER: **JHR** DRAWN BY: **LRD**
 DESIGNED BY: **GJB** CHECKED BY: **JHR**
REINFORCING STEEL SCHEDULE - SARGENT SHEET **97** OF **145**

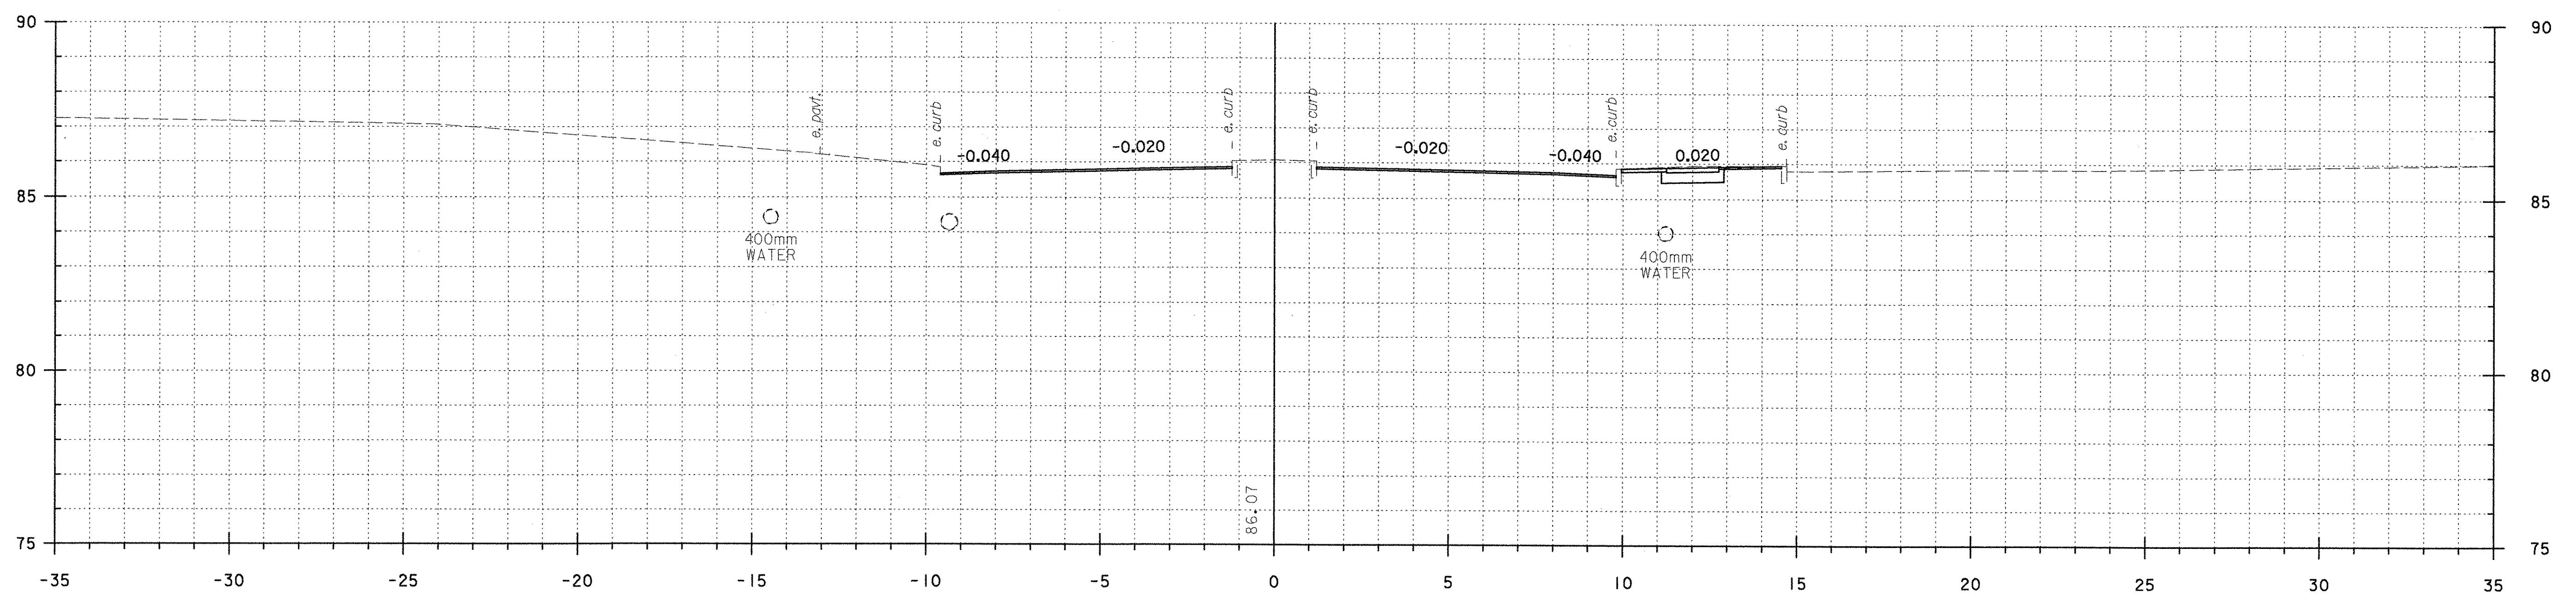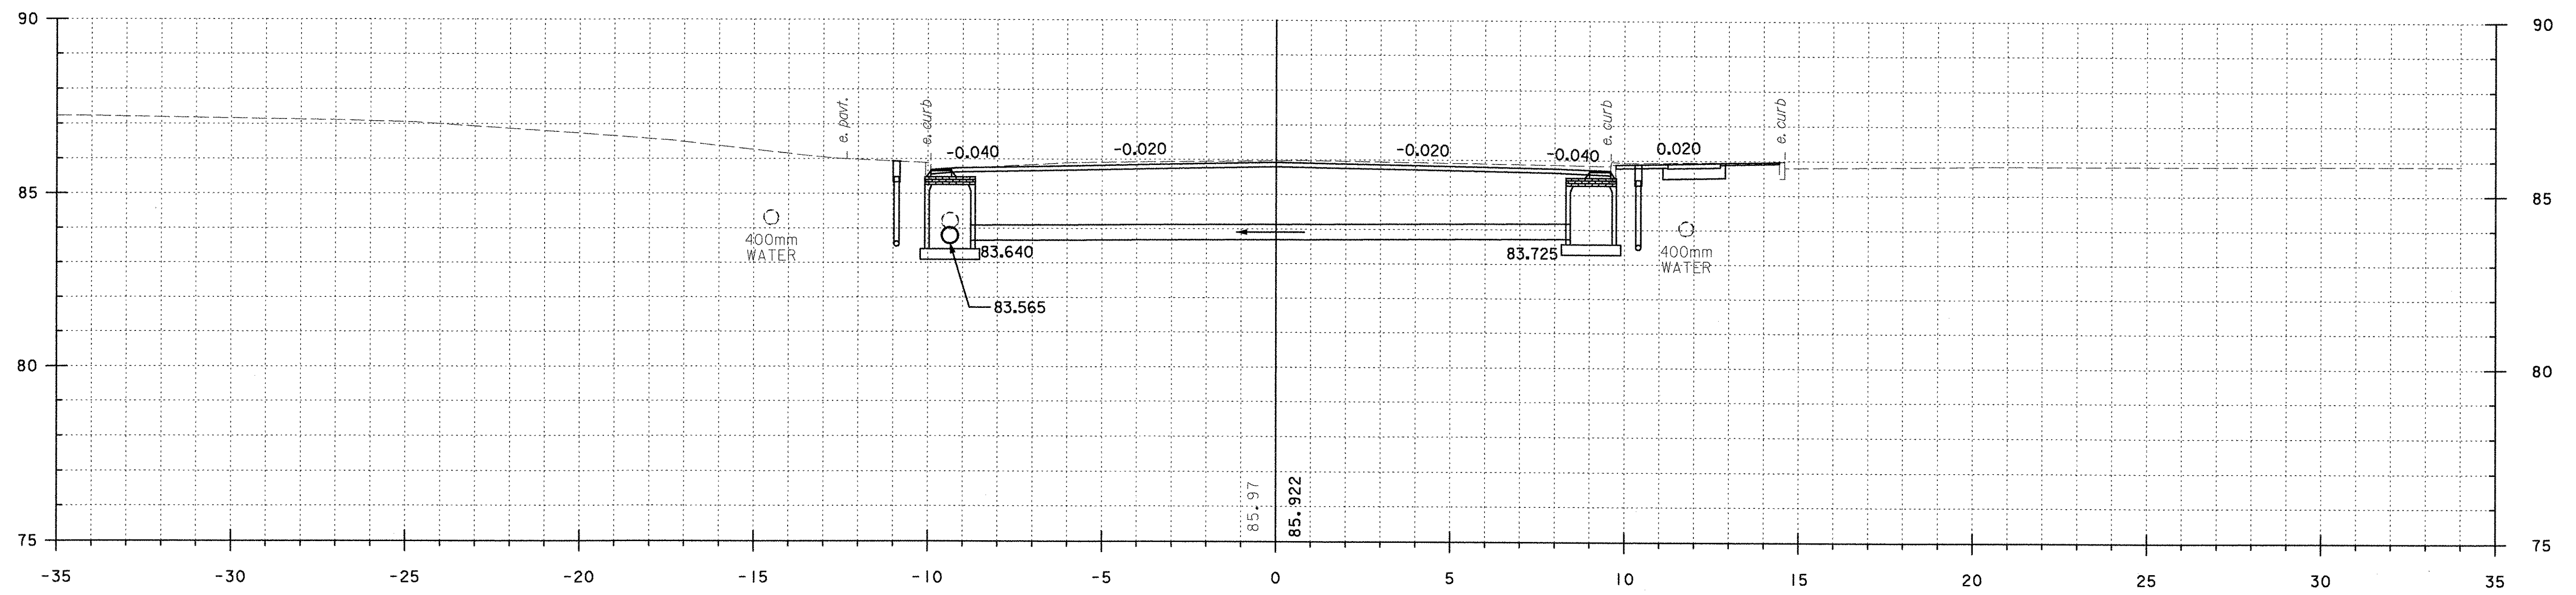



PROJECT: BRATTLEBORO	PROJECT NO.: NH 010-2(2)
DESIGN FILE NAME: ...zb270xs2.dgn	PLOT DATE: 09/23/2002
VT ROUTE 9	
FROM STA: 30+080.000 TO STA: 30+090.000 SHEET: 98 OF 145	

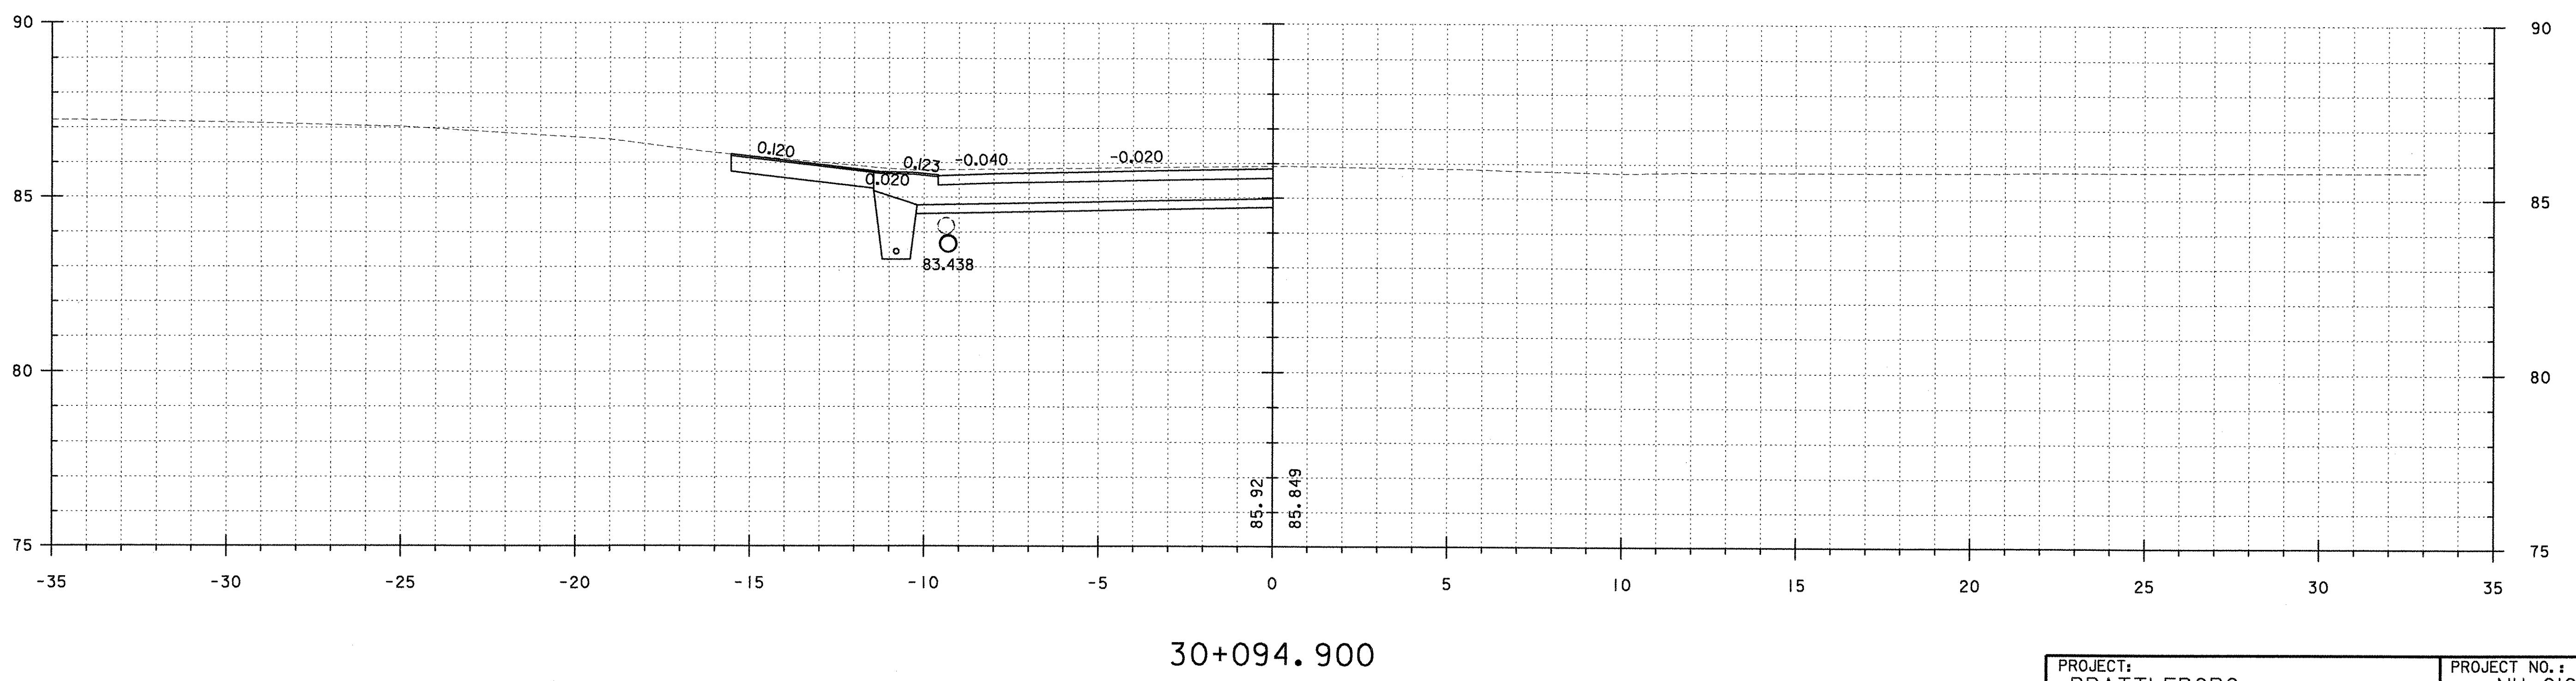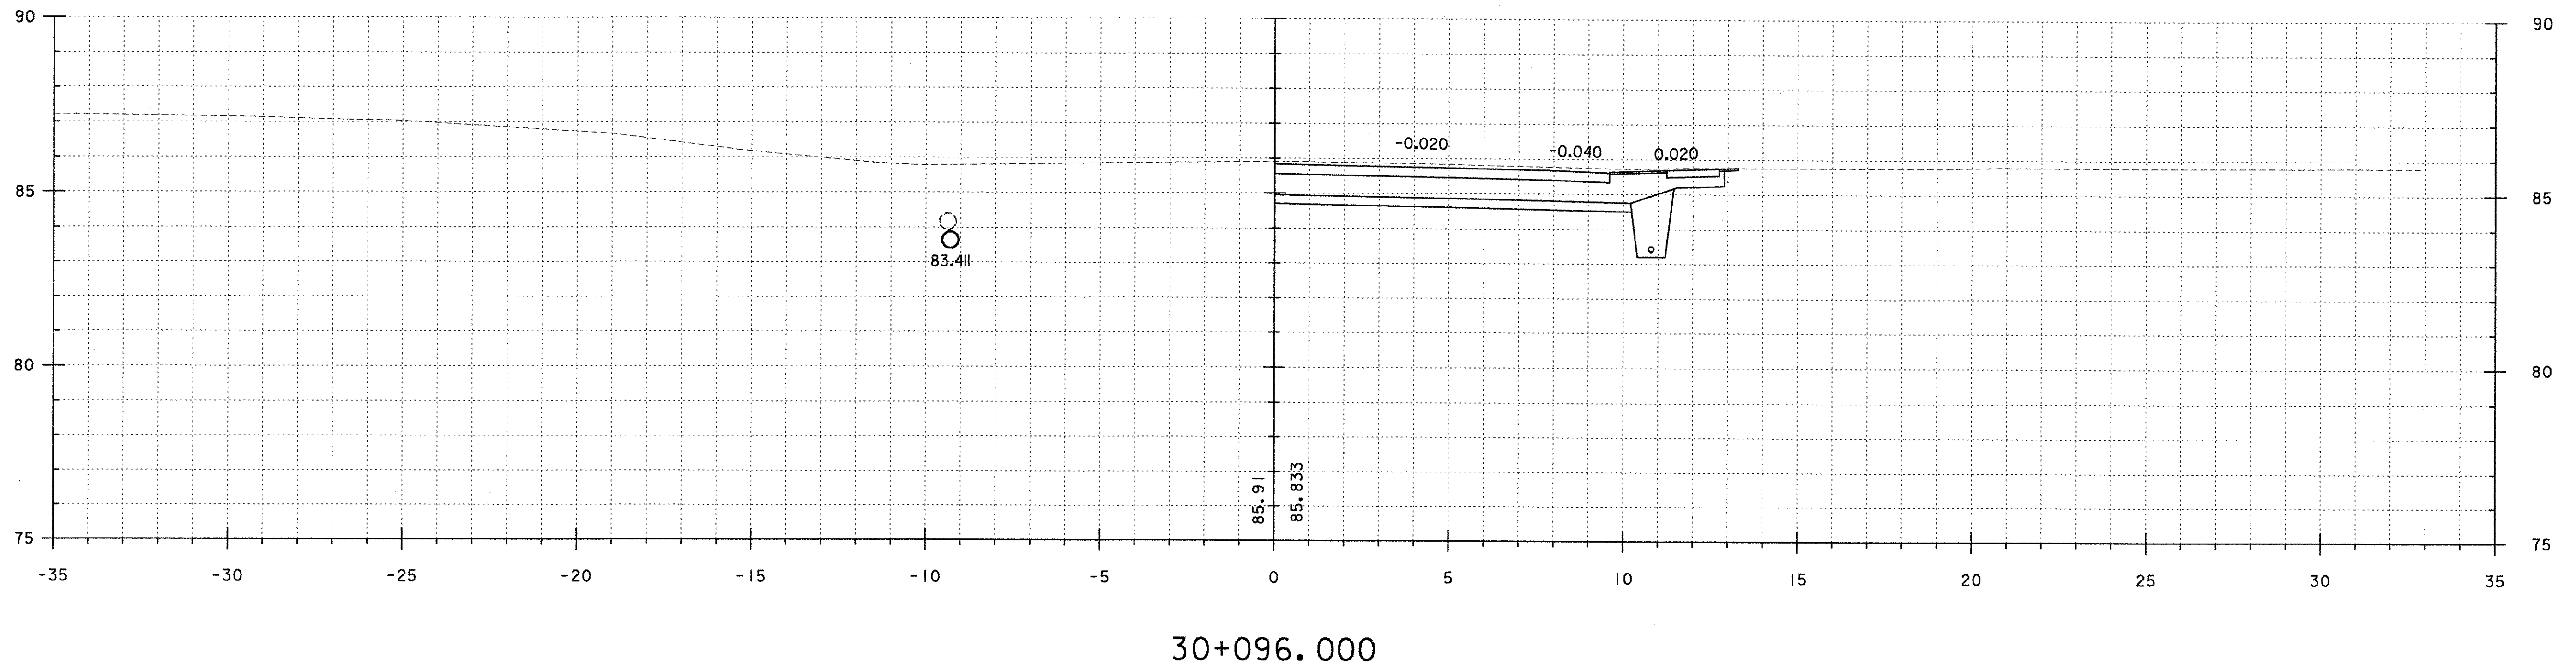




PROJECT: BRATTLEBORO	PROJECT NO. : NH 010-2(2)
DESIGN FILE NAME: ...zb270xs2.dgn	PLOT DATE: 09/23/2002
VT ROUTE 9	
FROM STA: 30+094.900 TO STA: 30+096.000 SHEET: 99 OF 145	

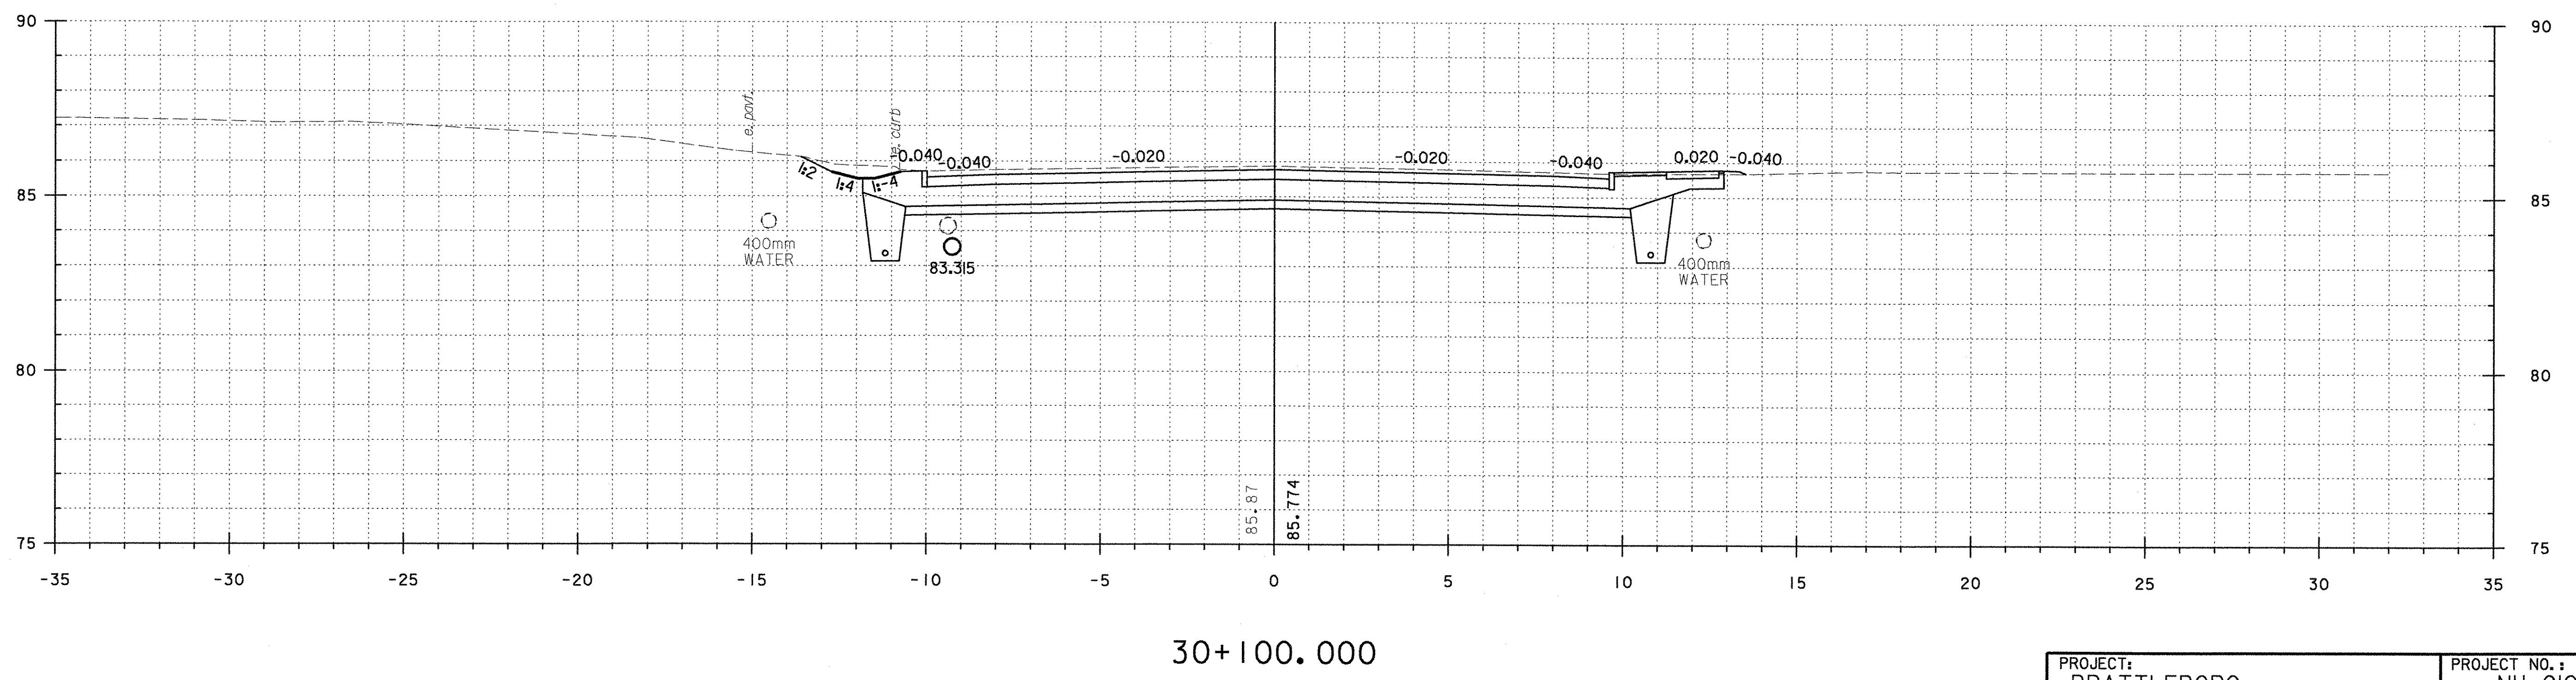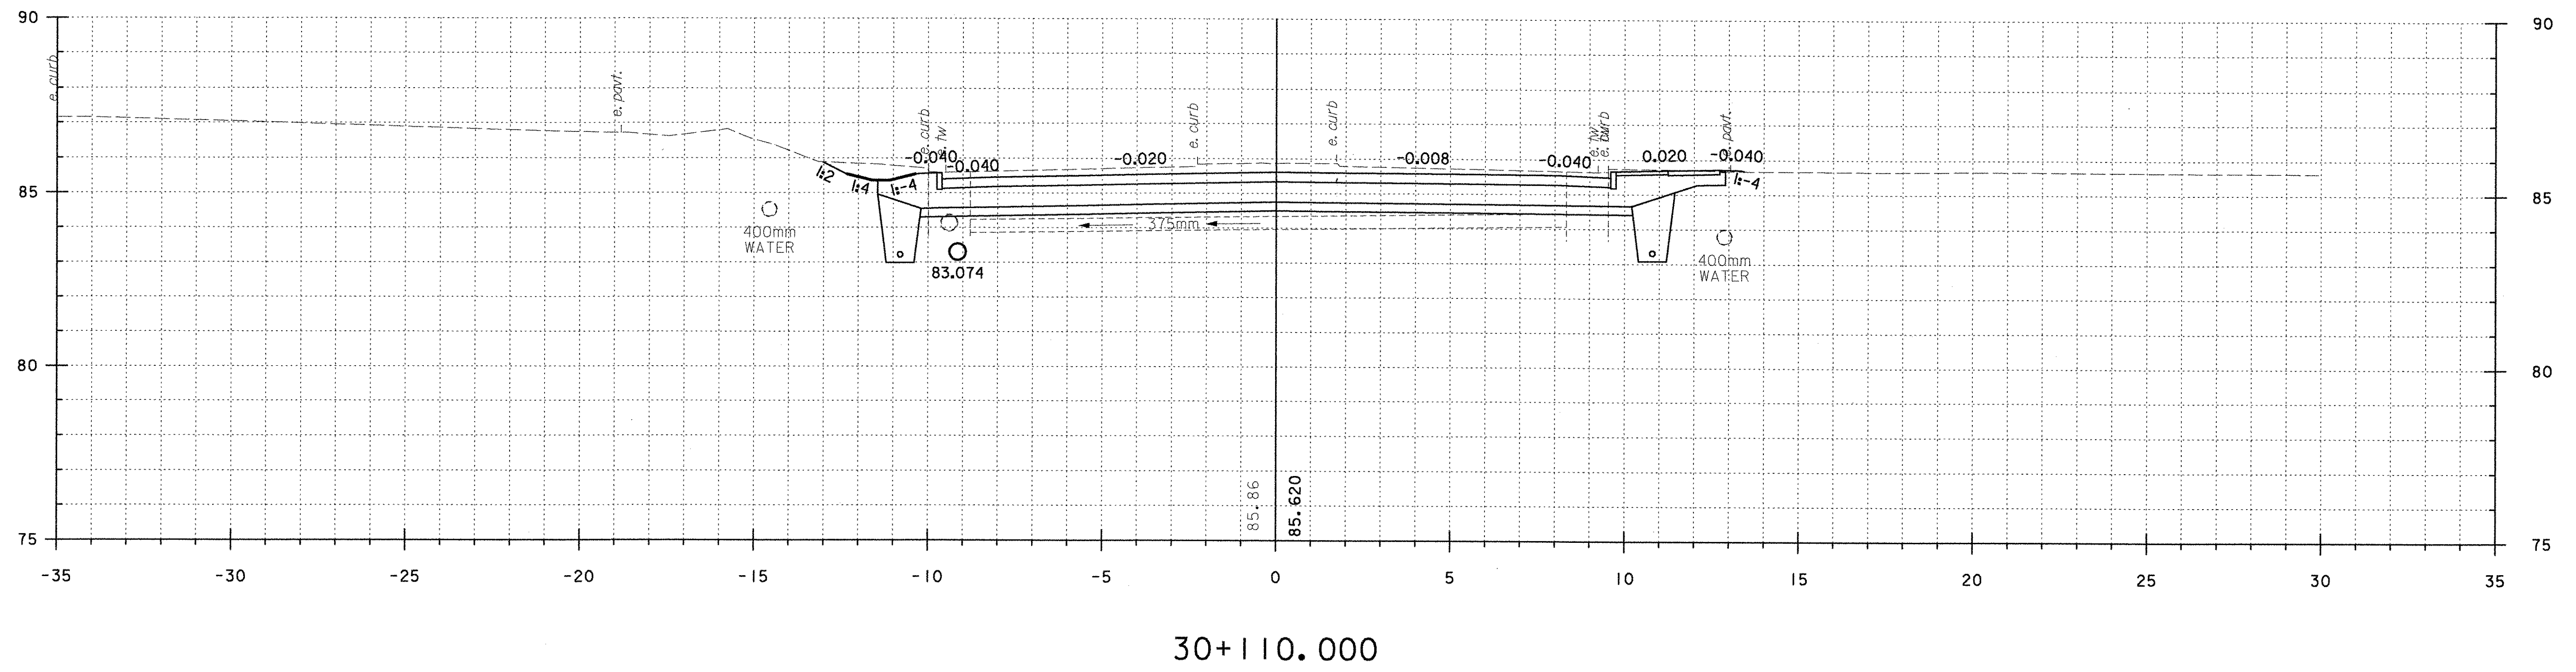



PROJECT: BRATTLEBORO	PROJECT NO.: NH 010-2(2)
DESIGN FILE NAME: ... \zb270xs2.dgn	PLOT DATE: 09/23/2002
VT ROUTE 9	
FROM STA: 30+100.000 TO STA: 30+110.000 SHEET: 100 OF 145	

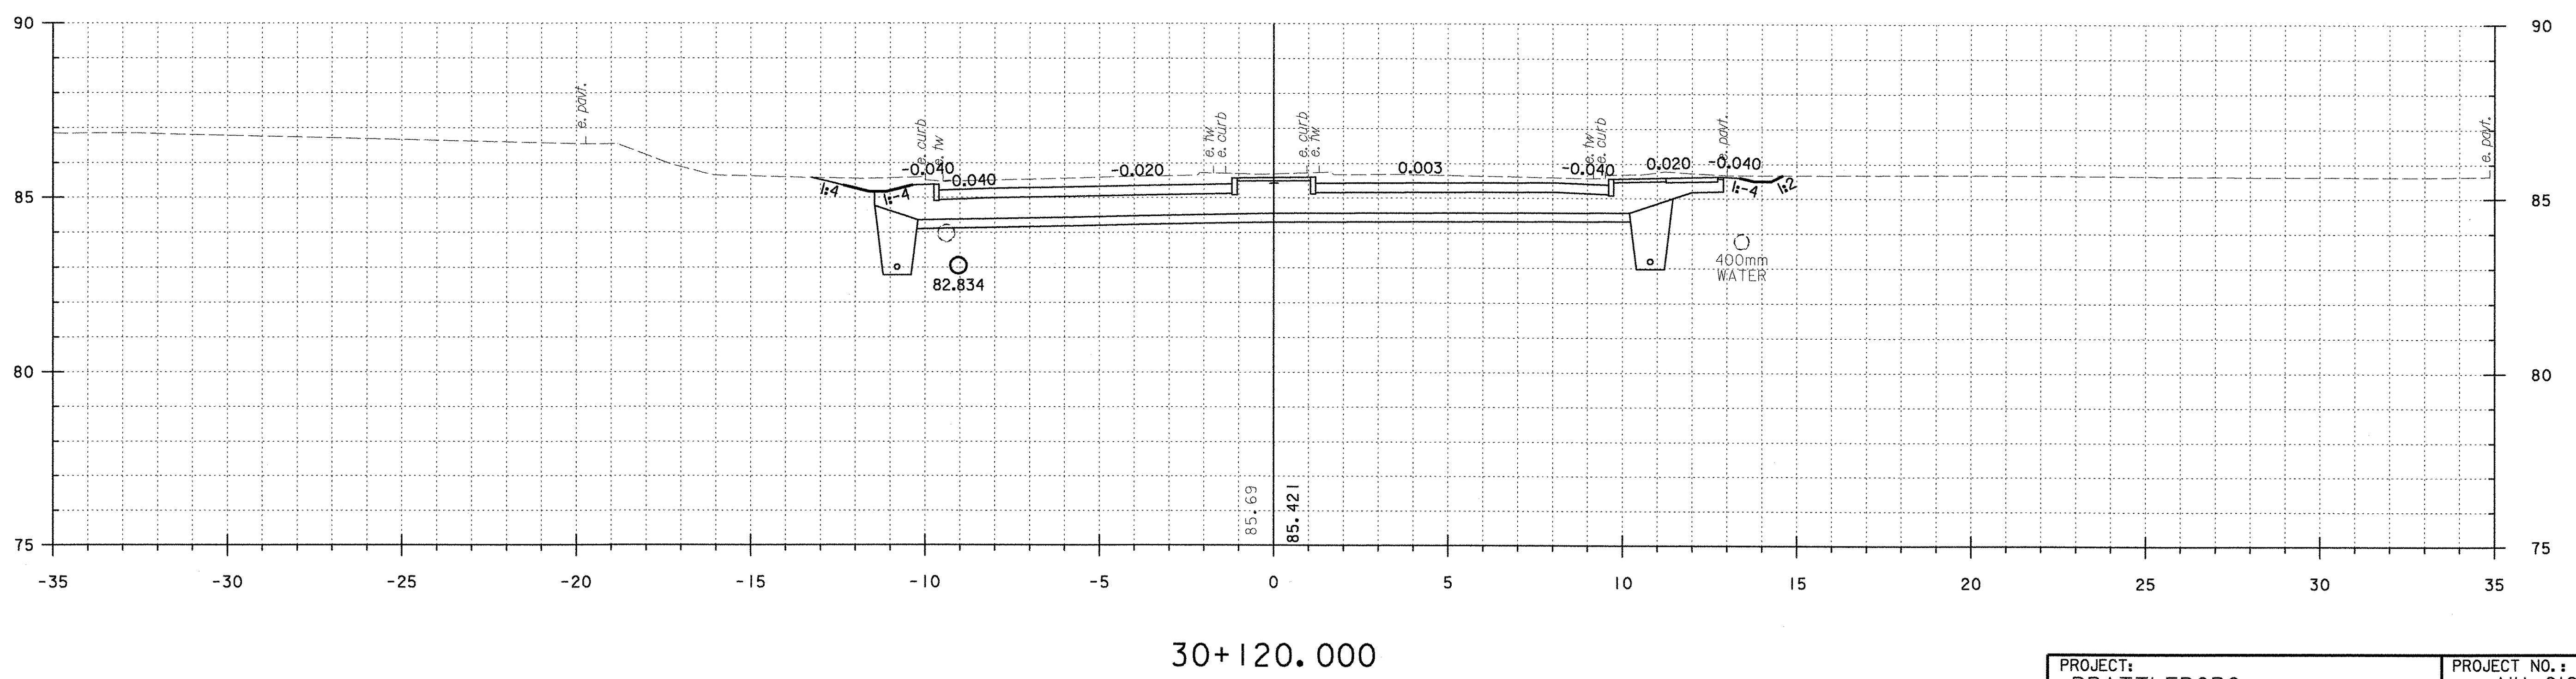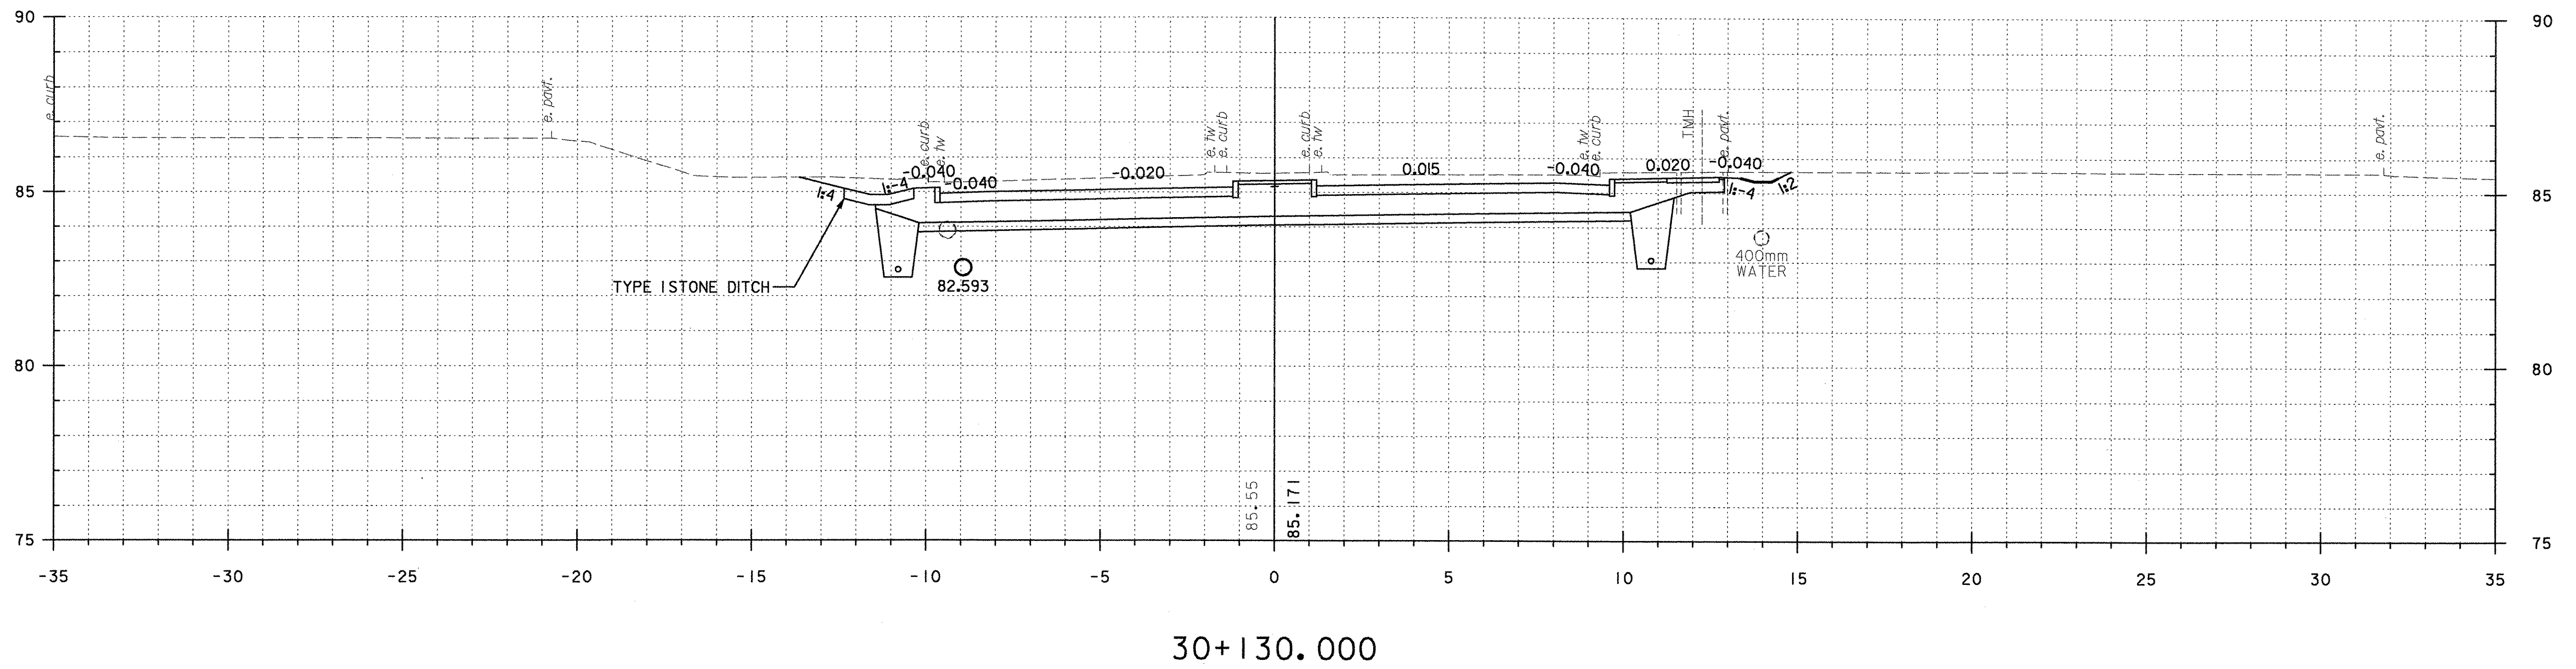


PROJECT: BRATTLEBORO	PROJECT NO. : NH 010-2(2)
DESIGN FILE NAME: ...z270xs2.dgn	PLOT DATE: 09/23/2002
IPARM FILE NAME:	VT ROUTE 9
FROM STA: 30+120.000 TO STA: 30+130.000 SHEET: 101 OF 145	

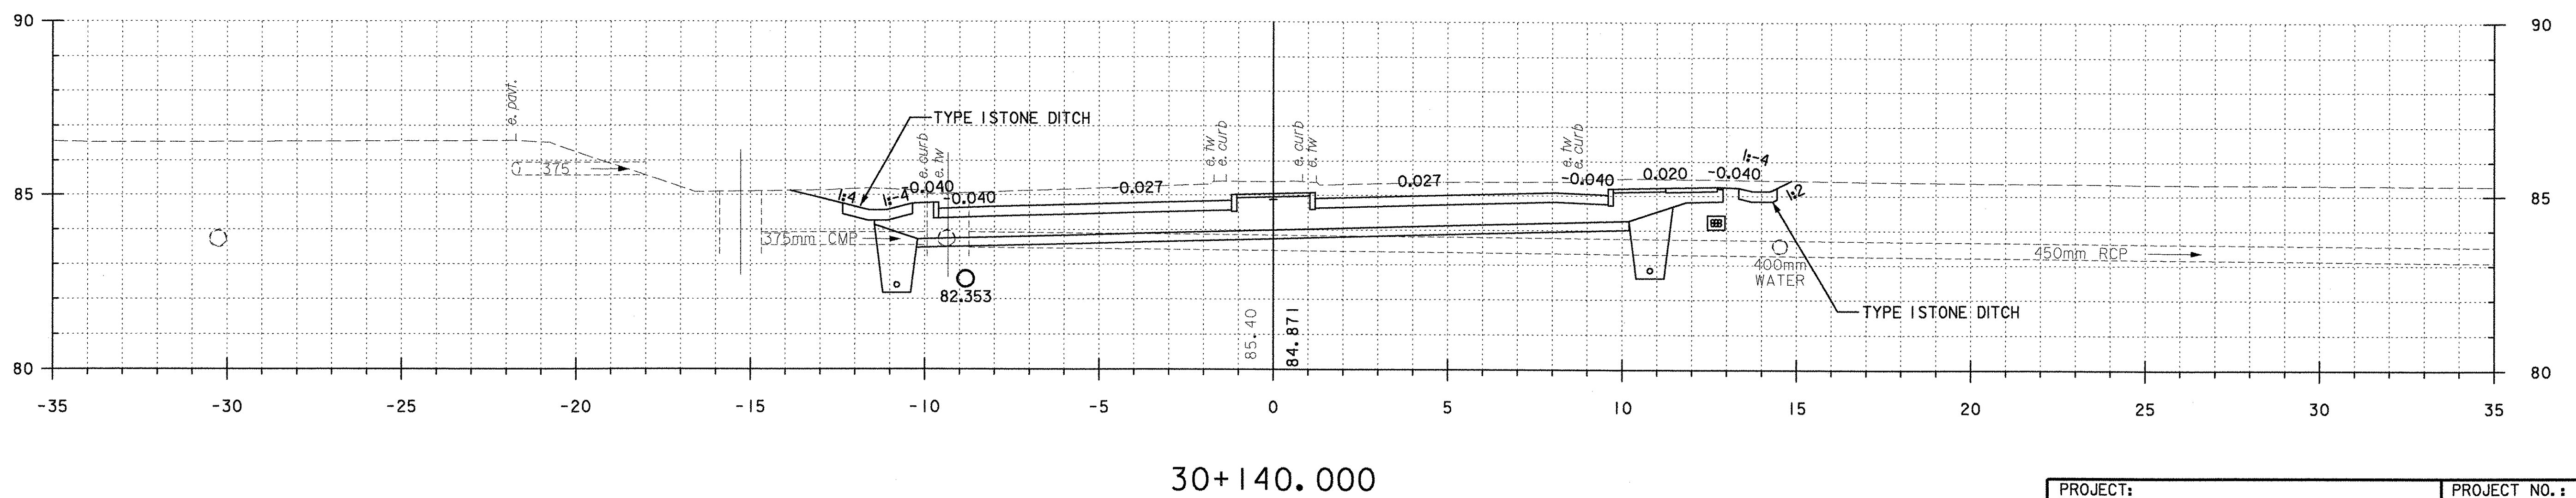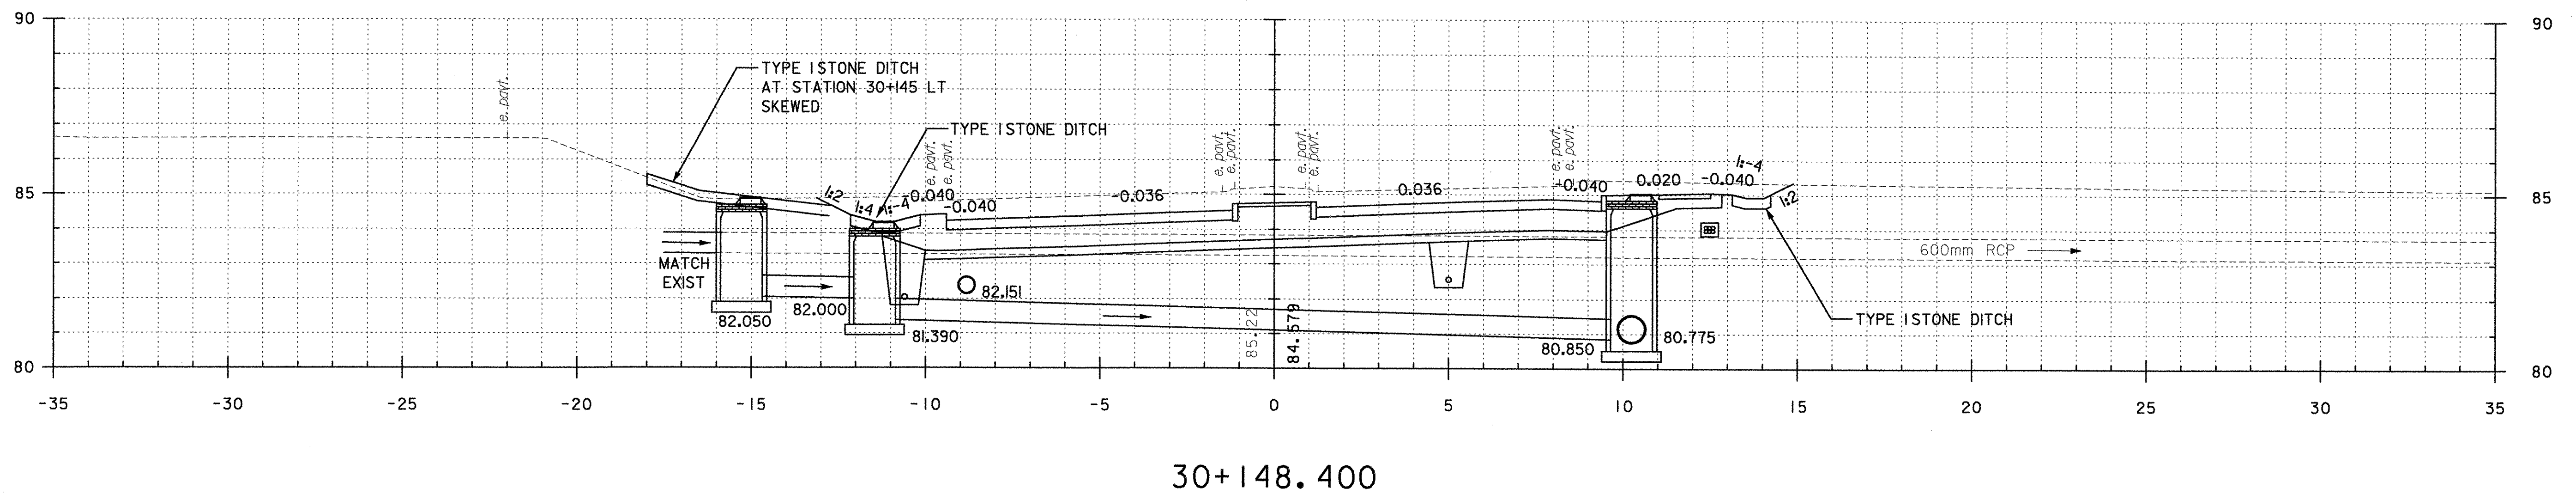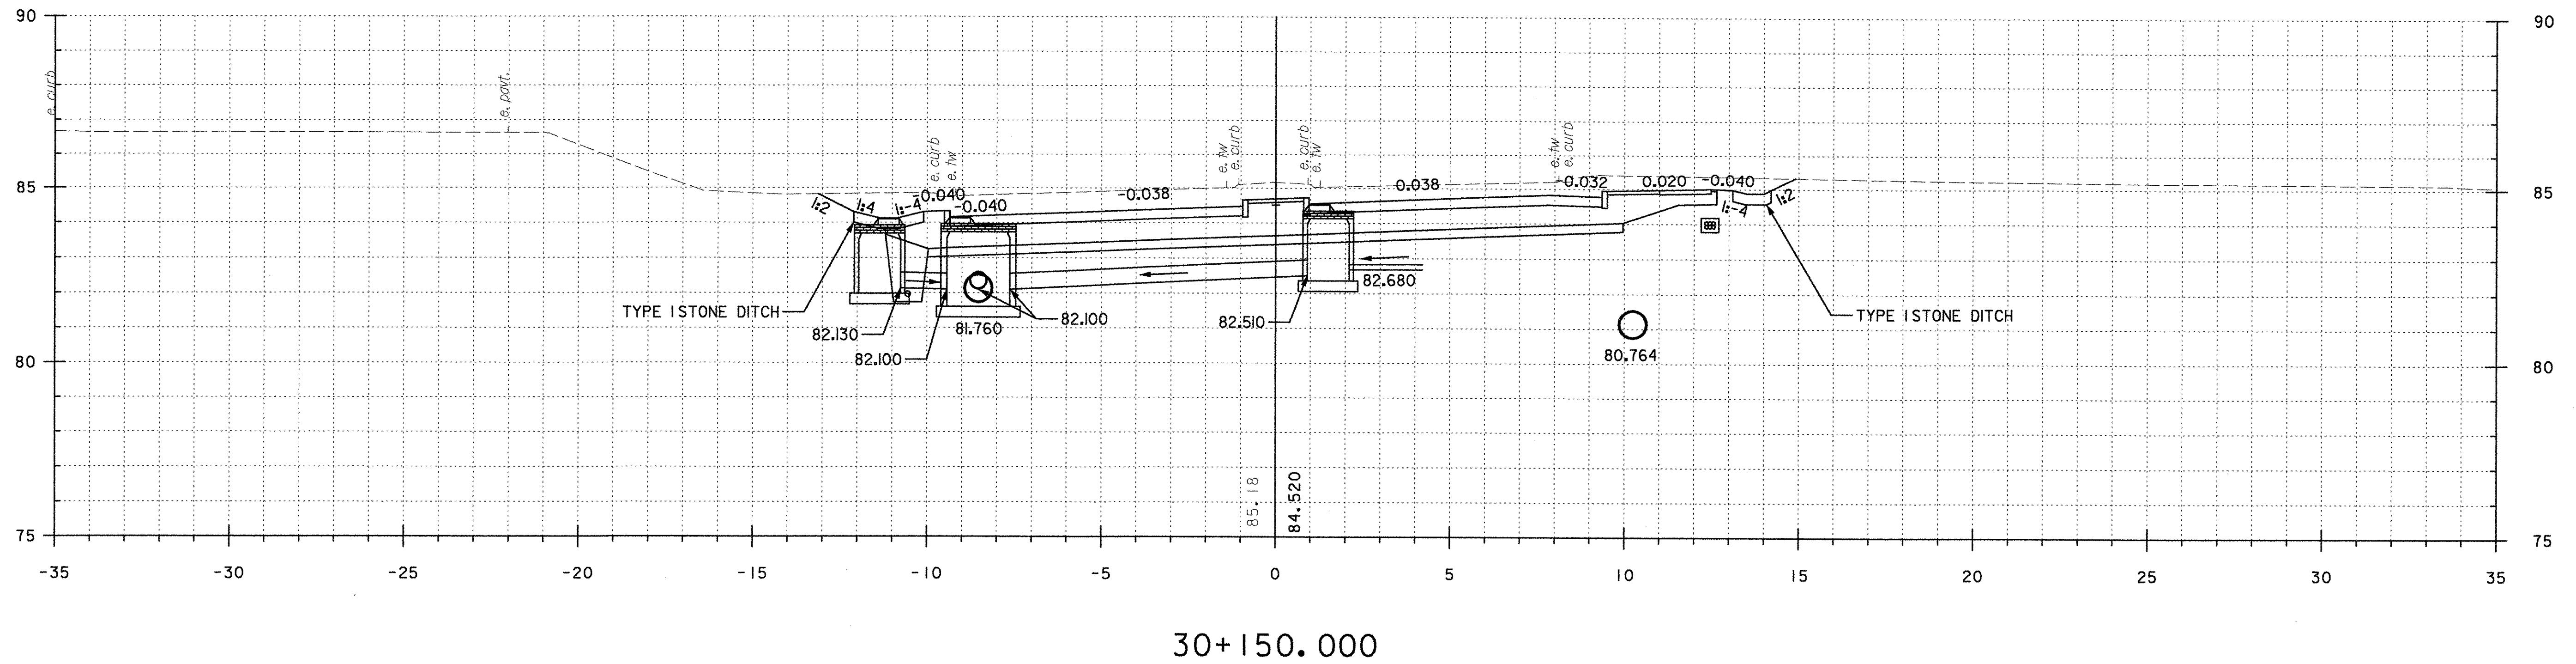


PROJECT: BRATTLEBORO	PROJECT NO. : NH 010-2(2)
DESIGN FILE NAME: ...zb270xs2.dgn	PLOT DATE: 09/23/2002
IPARM FILE NAME:	VT ROUTE 9
FROM STA: 30+140.000 TO STA: 30+150.000 SHEET: 102 OF 145	

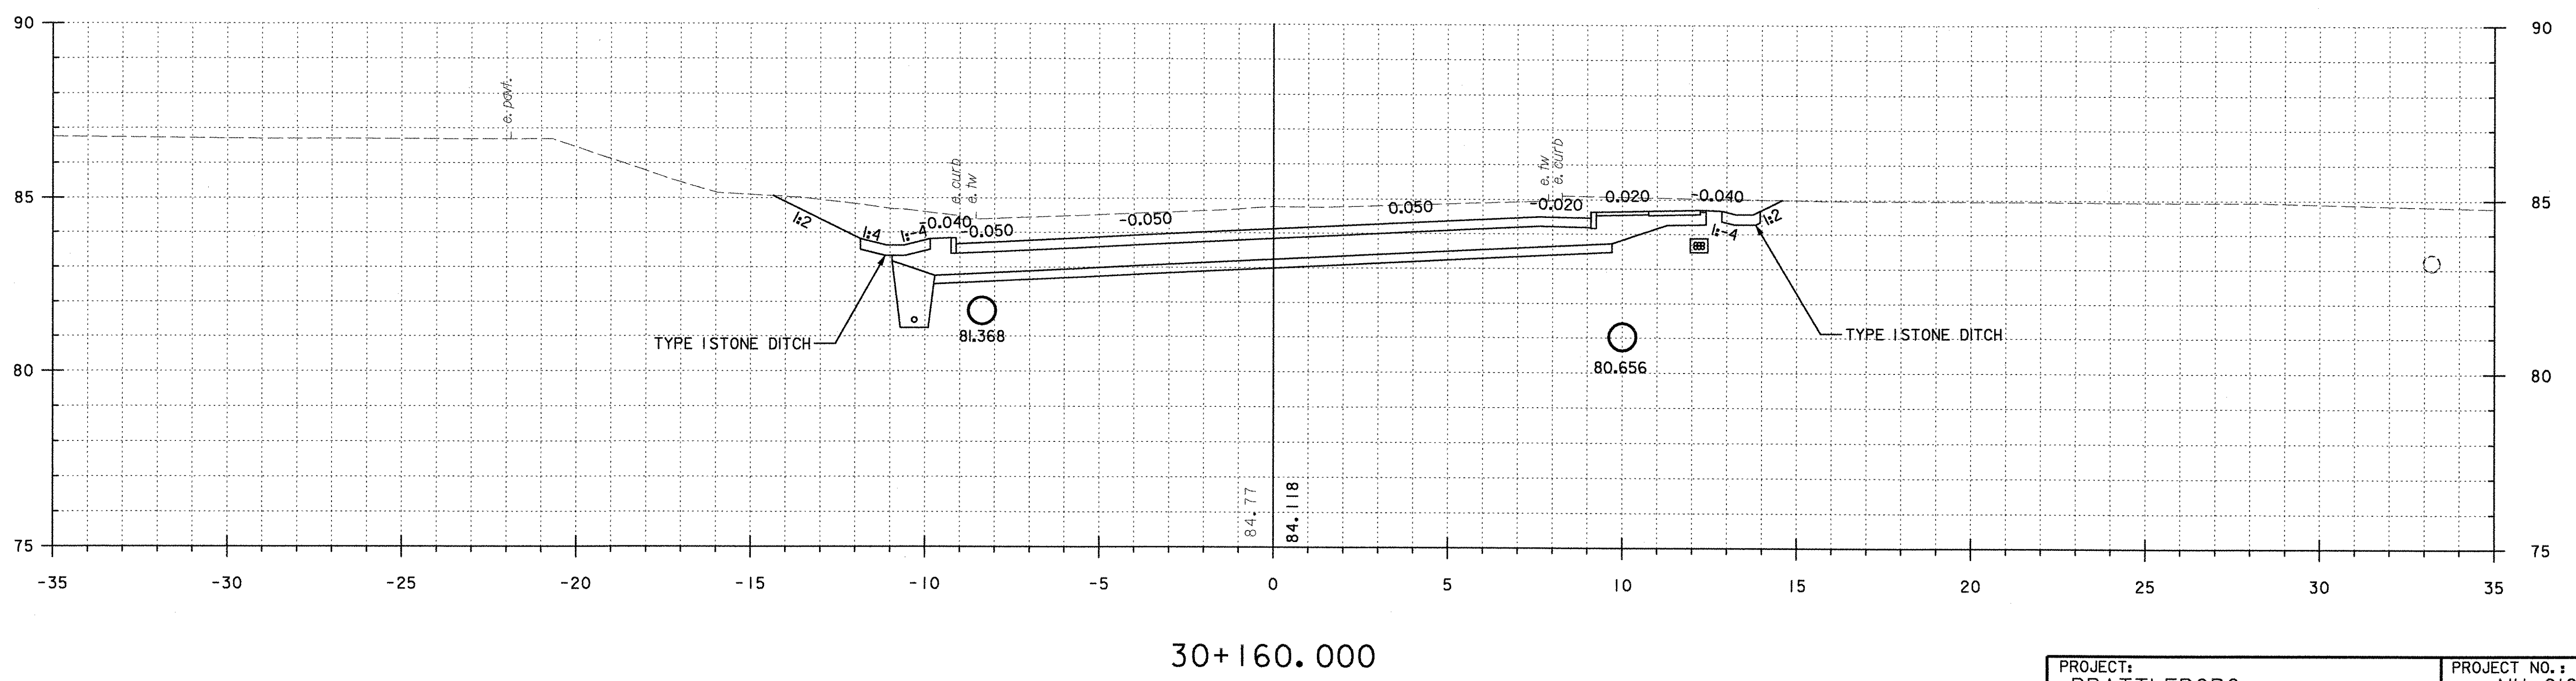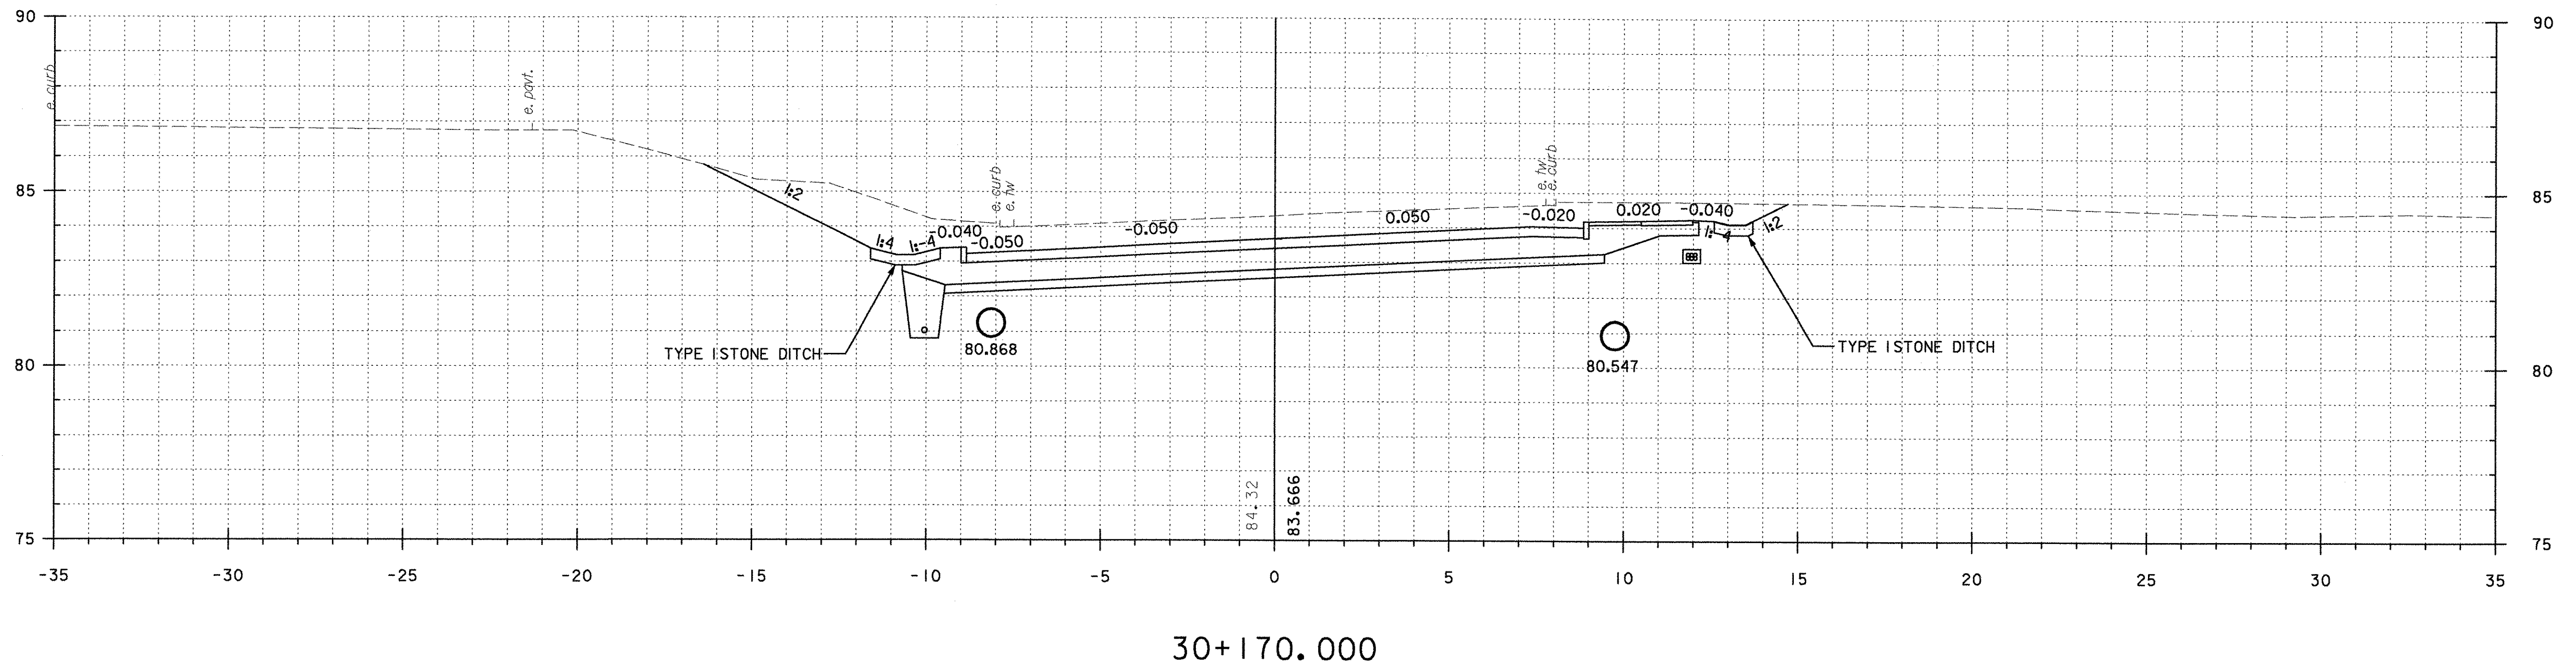

PROJECT: BRATTLEBORO	PROJECT NO.: NH 010-2(2)
DESIGN FILE NAME: ...zb270xs2.dgn	PLOT DATE: 09/23/2002
IPARM FILE NAME:	VT ROUTE 9
FROM STA: 30+160.000 TO STA: 30+170.000 SHEET: 103 OF 145	

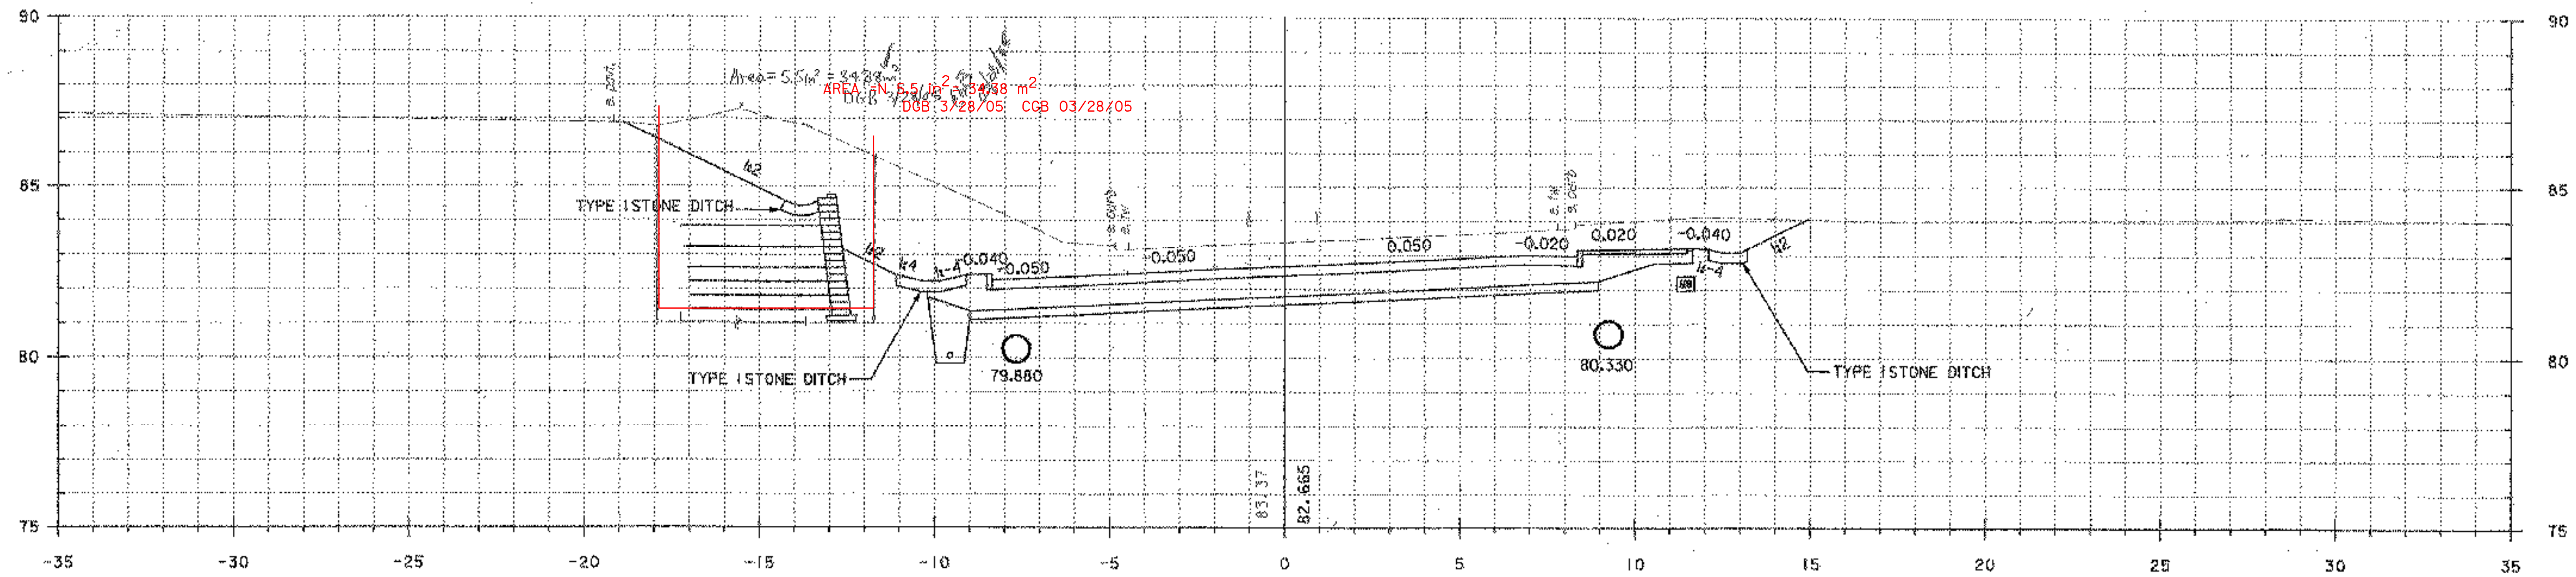


30+190.000

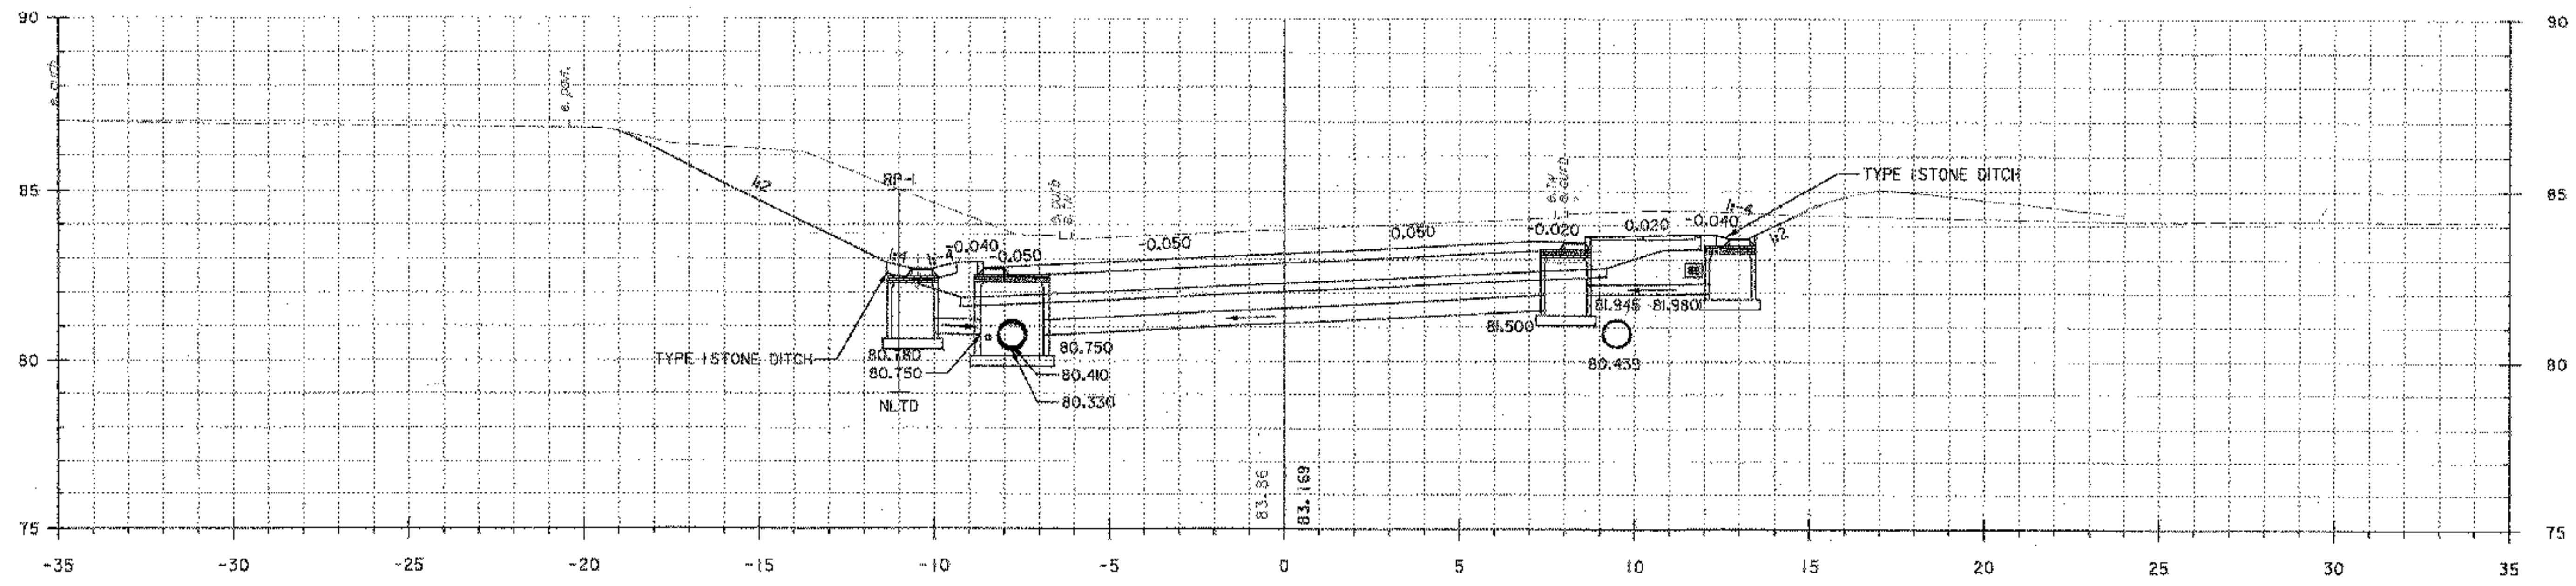


30+180.000

PROJECT:	BRATTLEBORO	PROJECT NO.:	NH 010-2(2)
DESIGN FILE NAME:	...z270xs2.dgn	PLOT DATE:	09/23/2002
IPARM FILE NAME:			
VT ROUTE 9			
FROM STA: 30+180.000 TO STA: 30+190.000 SHEET: 104 OF 145			

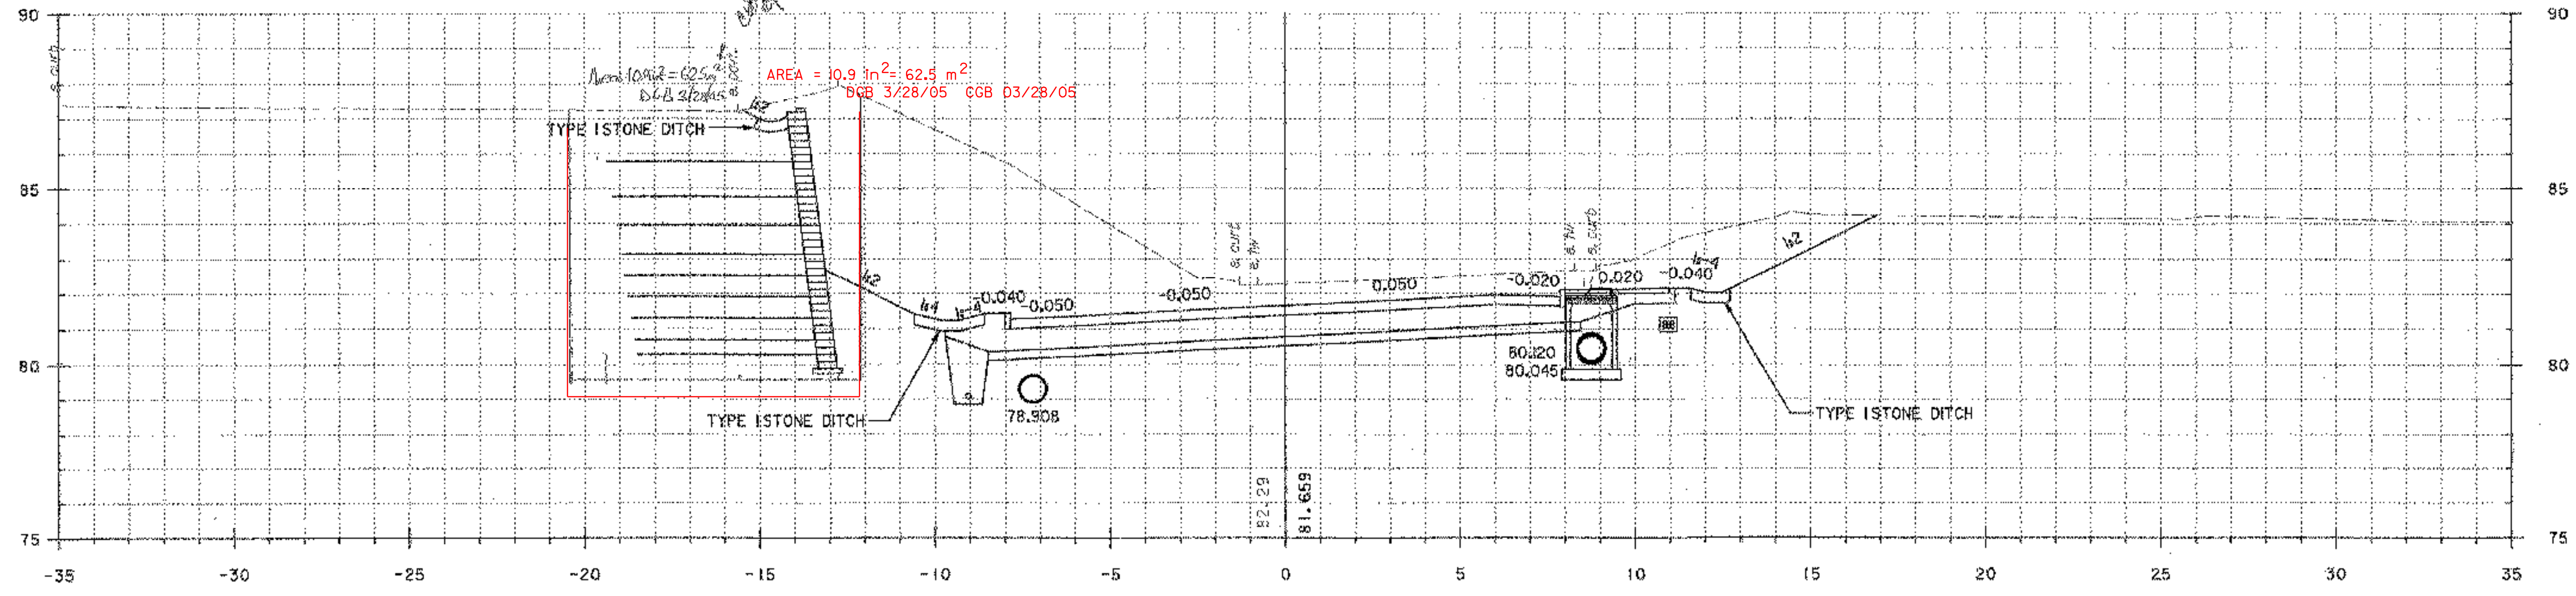


30+210.000

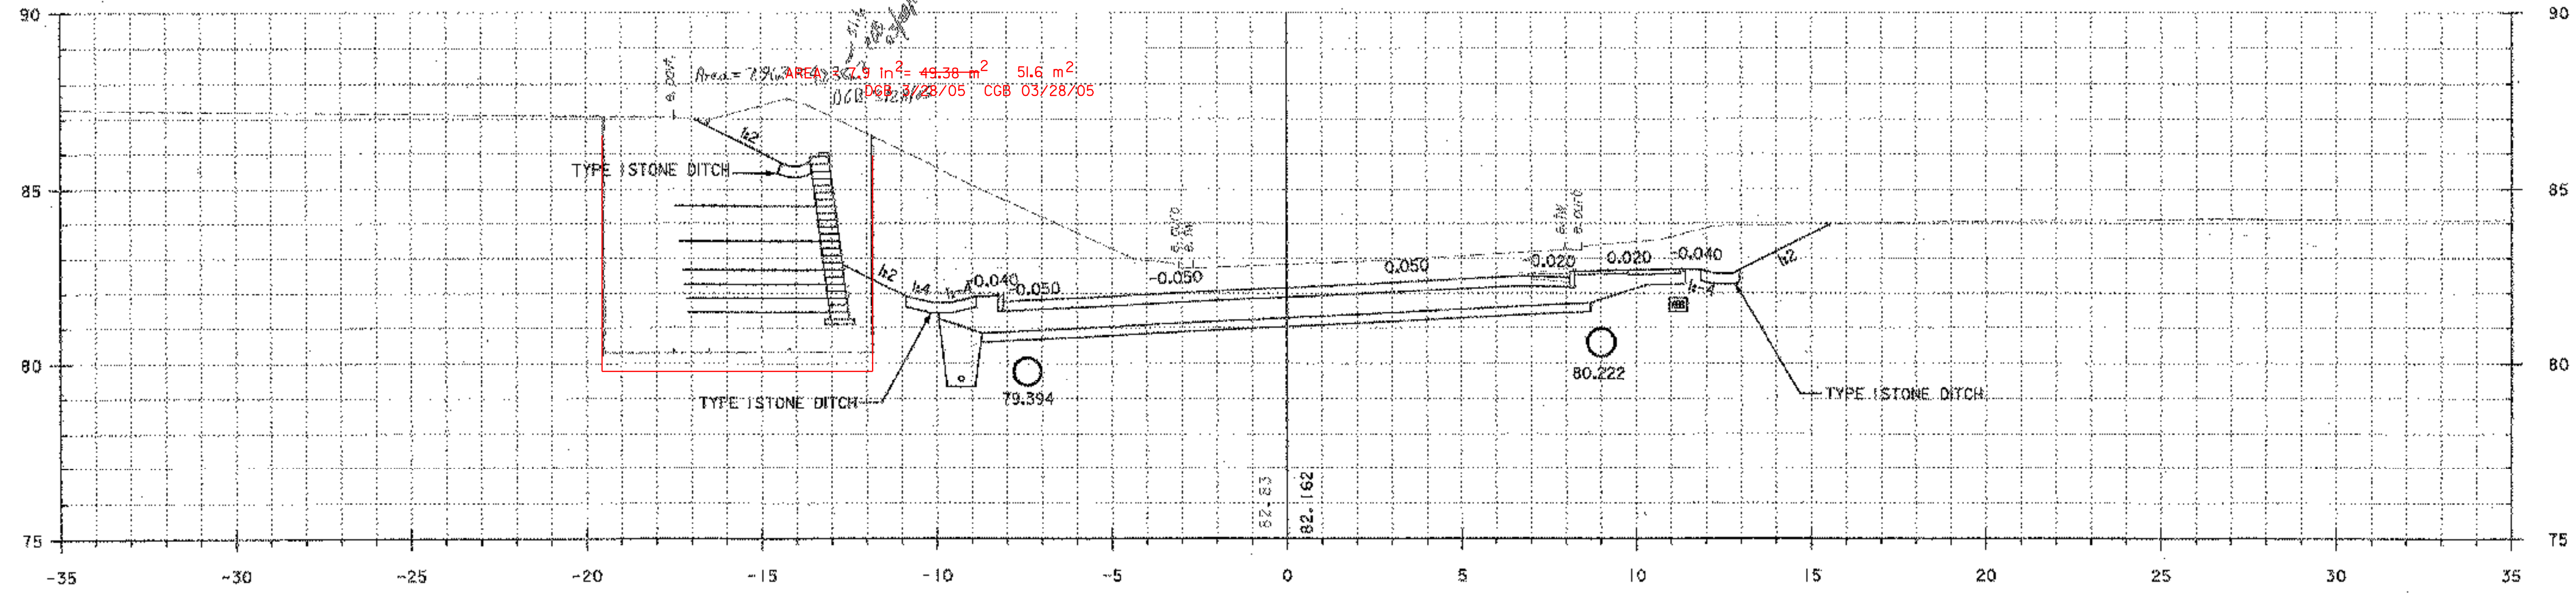


30+200.000

PROJECT: BRATTLEBORO	PROJECT NO.: NH 010-2(2)
DESIGN FILE NAME: ...zlb270x.e2.dgn	PLOT DATE: 09/23/2002
IPARM FILE NAME:	VT ROUTE 9
FROM STA: 30+200.000 TO STA: 30+210.000 SHEET: 105 OF 145	

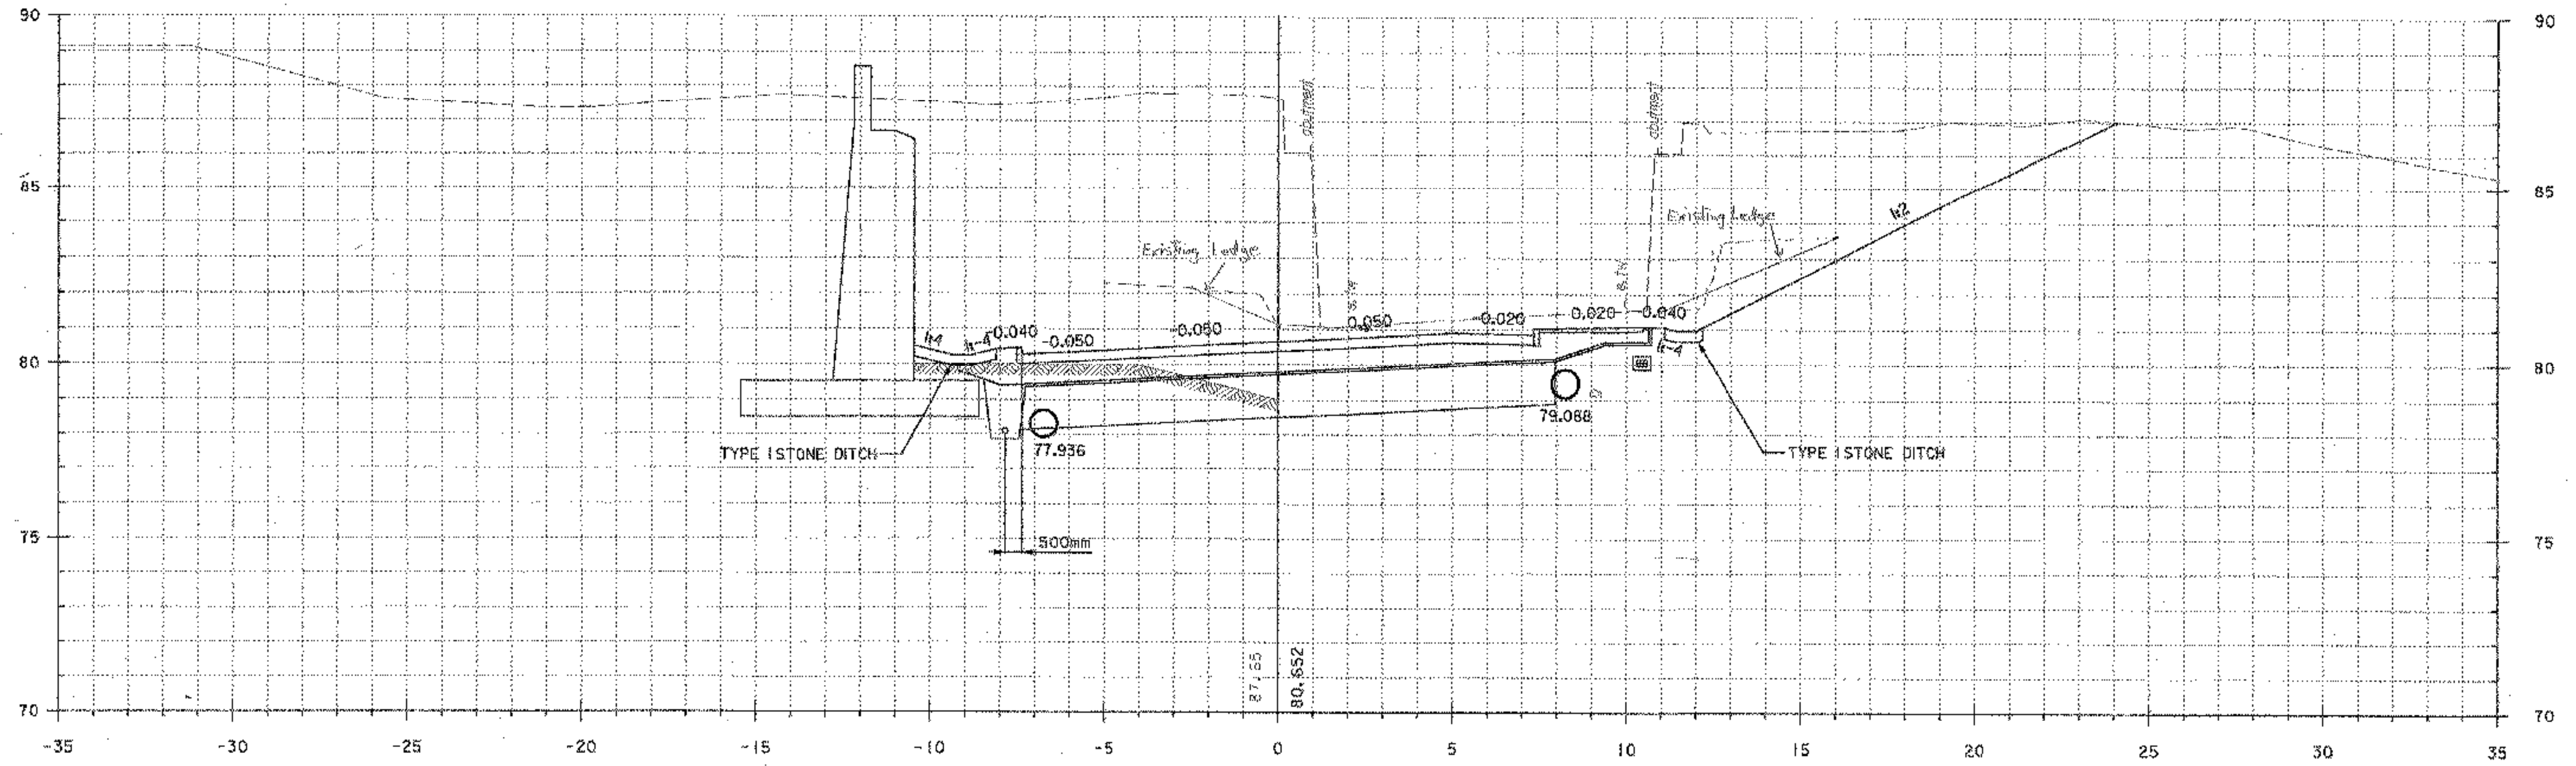


30+230.000

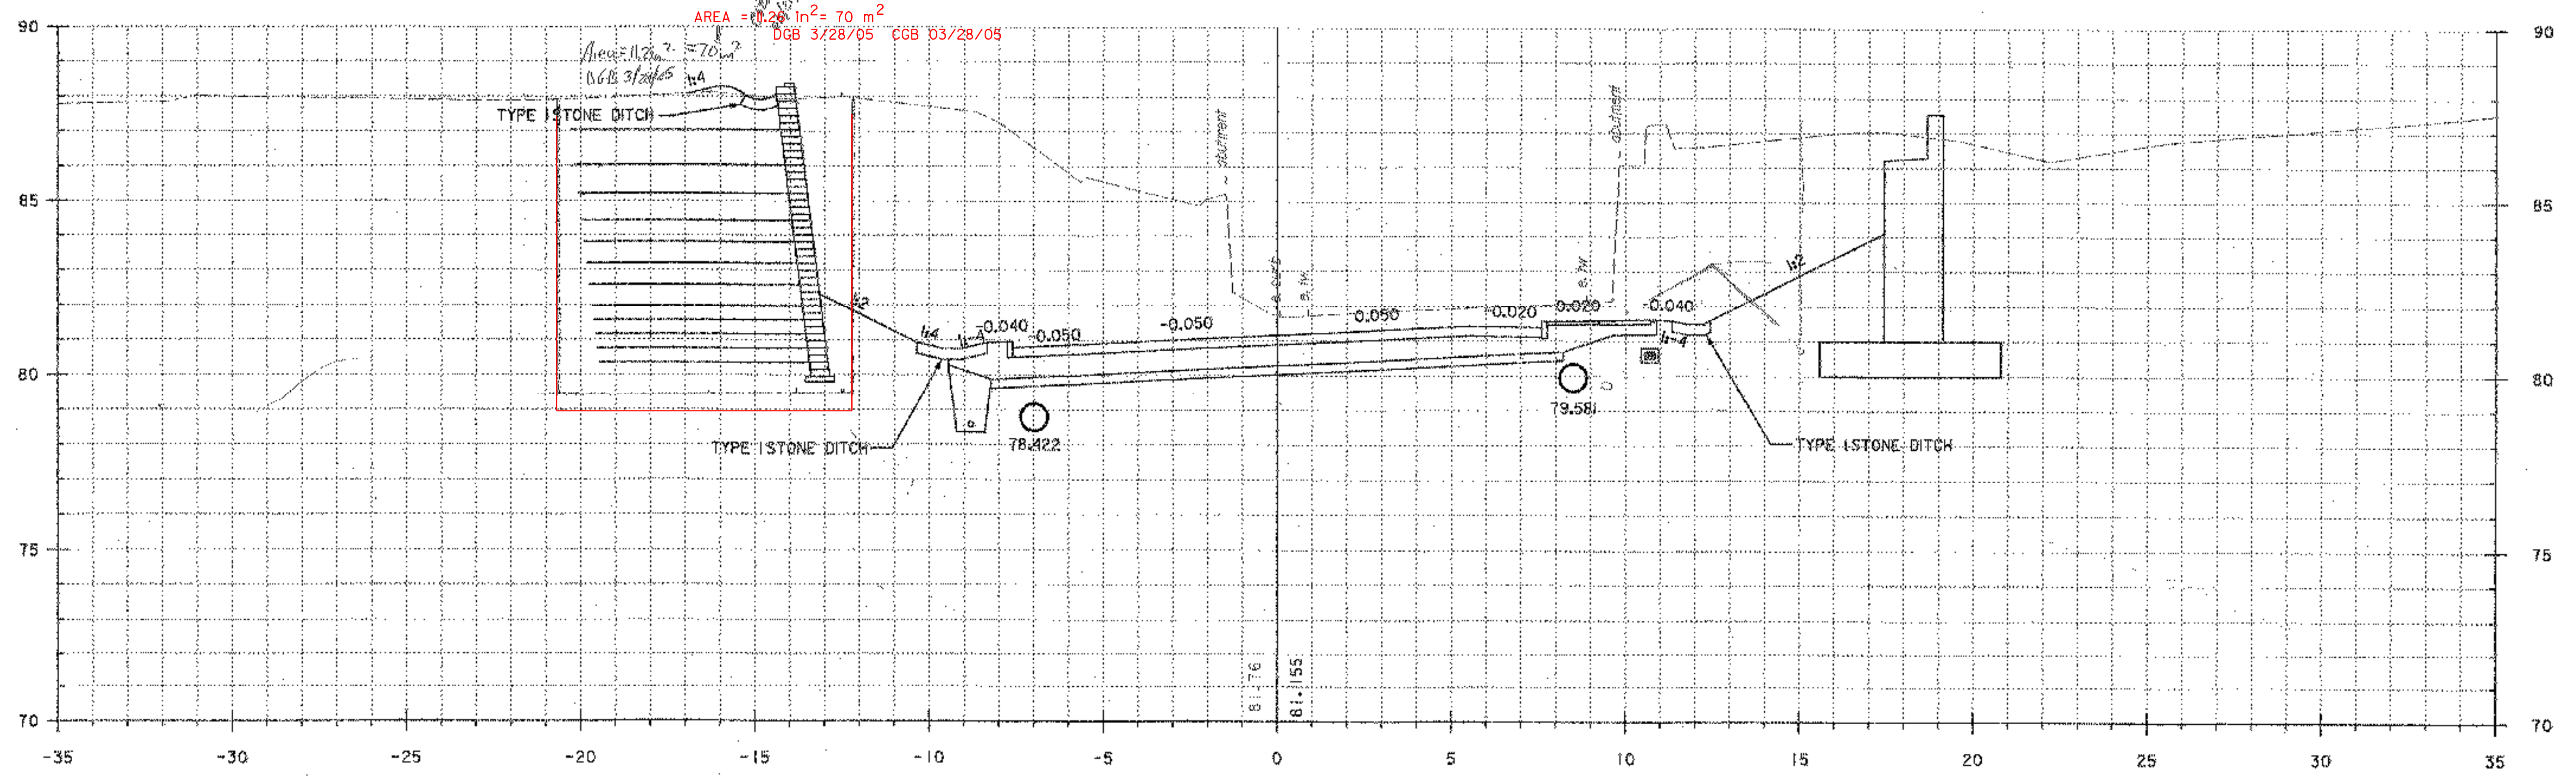


30+220.000

PROJECT:	BRATTLEBORO	PROJECT NO.:	NH 010-2(2)
DESIGN FILE NAME:	...zb270xs2.dgn	PLOT DATE:	09/23/2002
IPARM FILE NAME:			
VT ROUTE 9			
FROM STA: 30+220.000 TO STA: 30+230.000 SHEET: 106 OF 145			

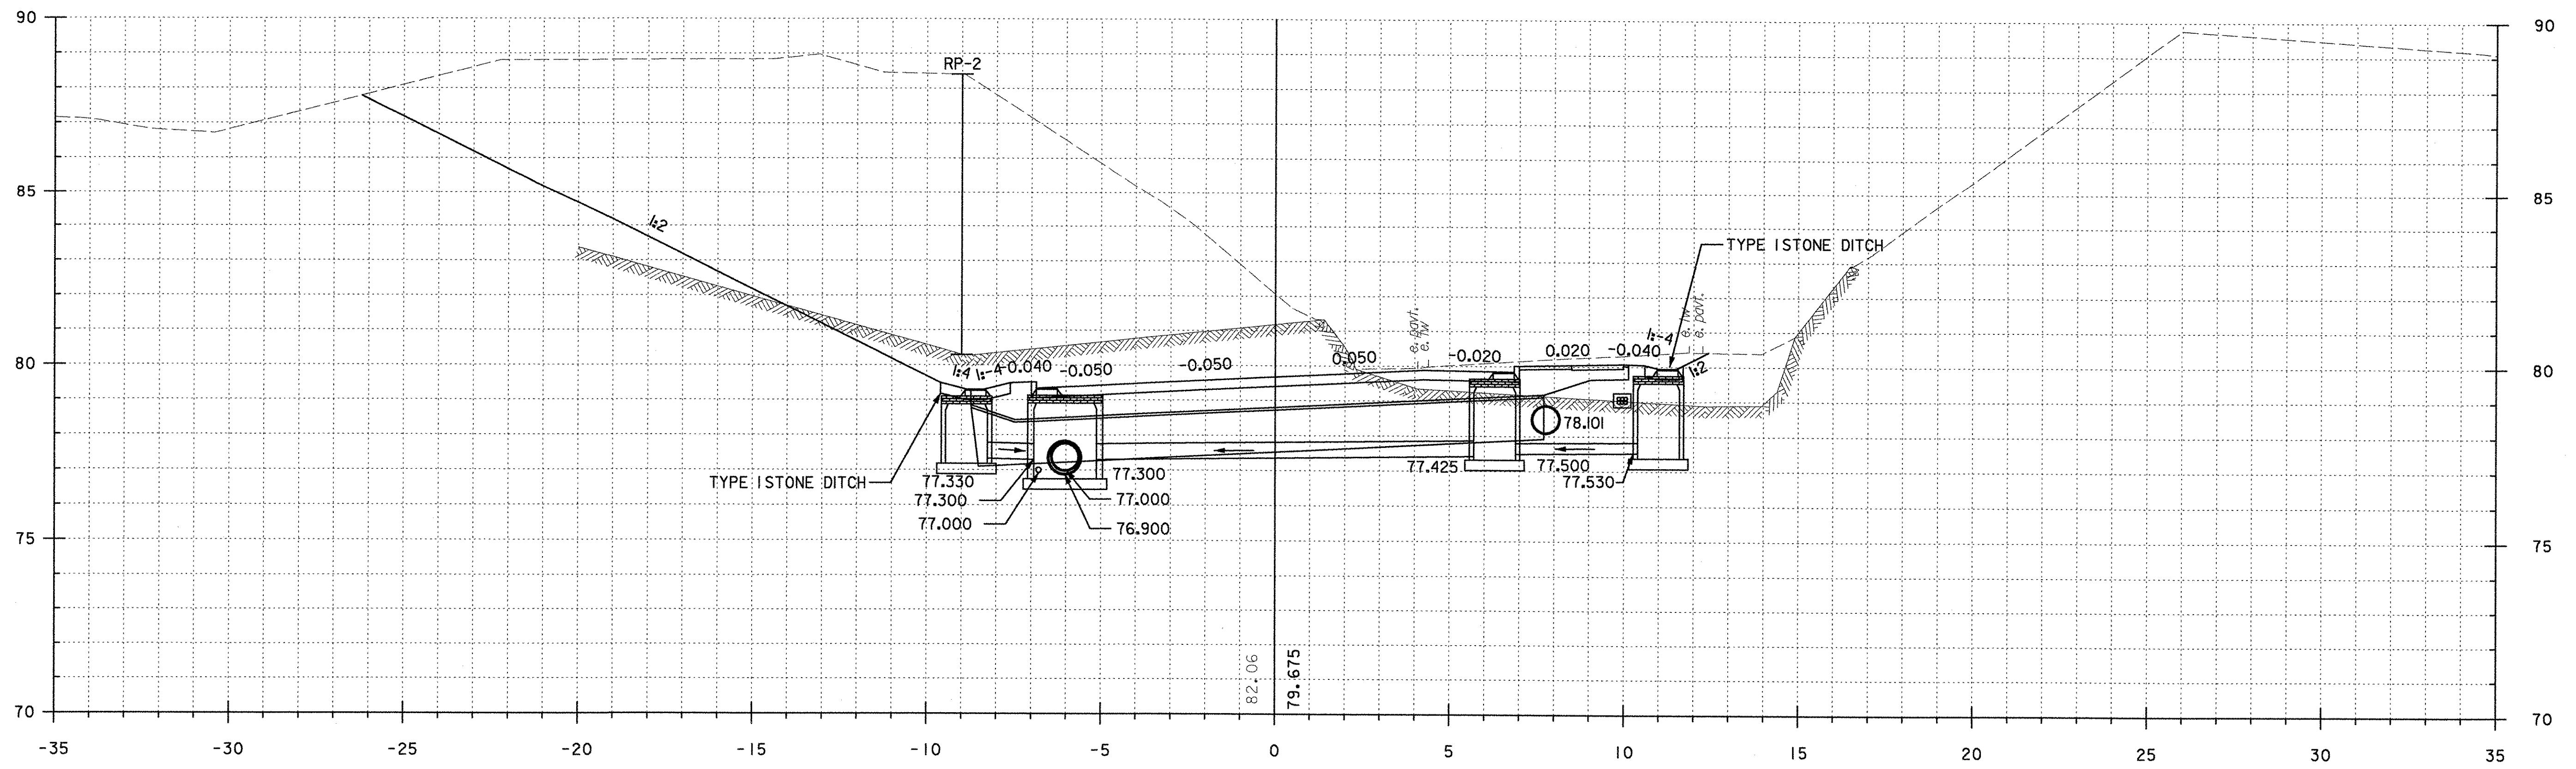


30+250.000

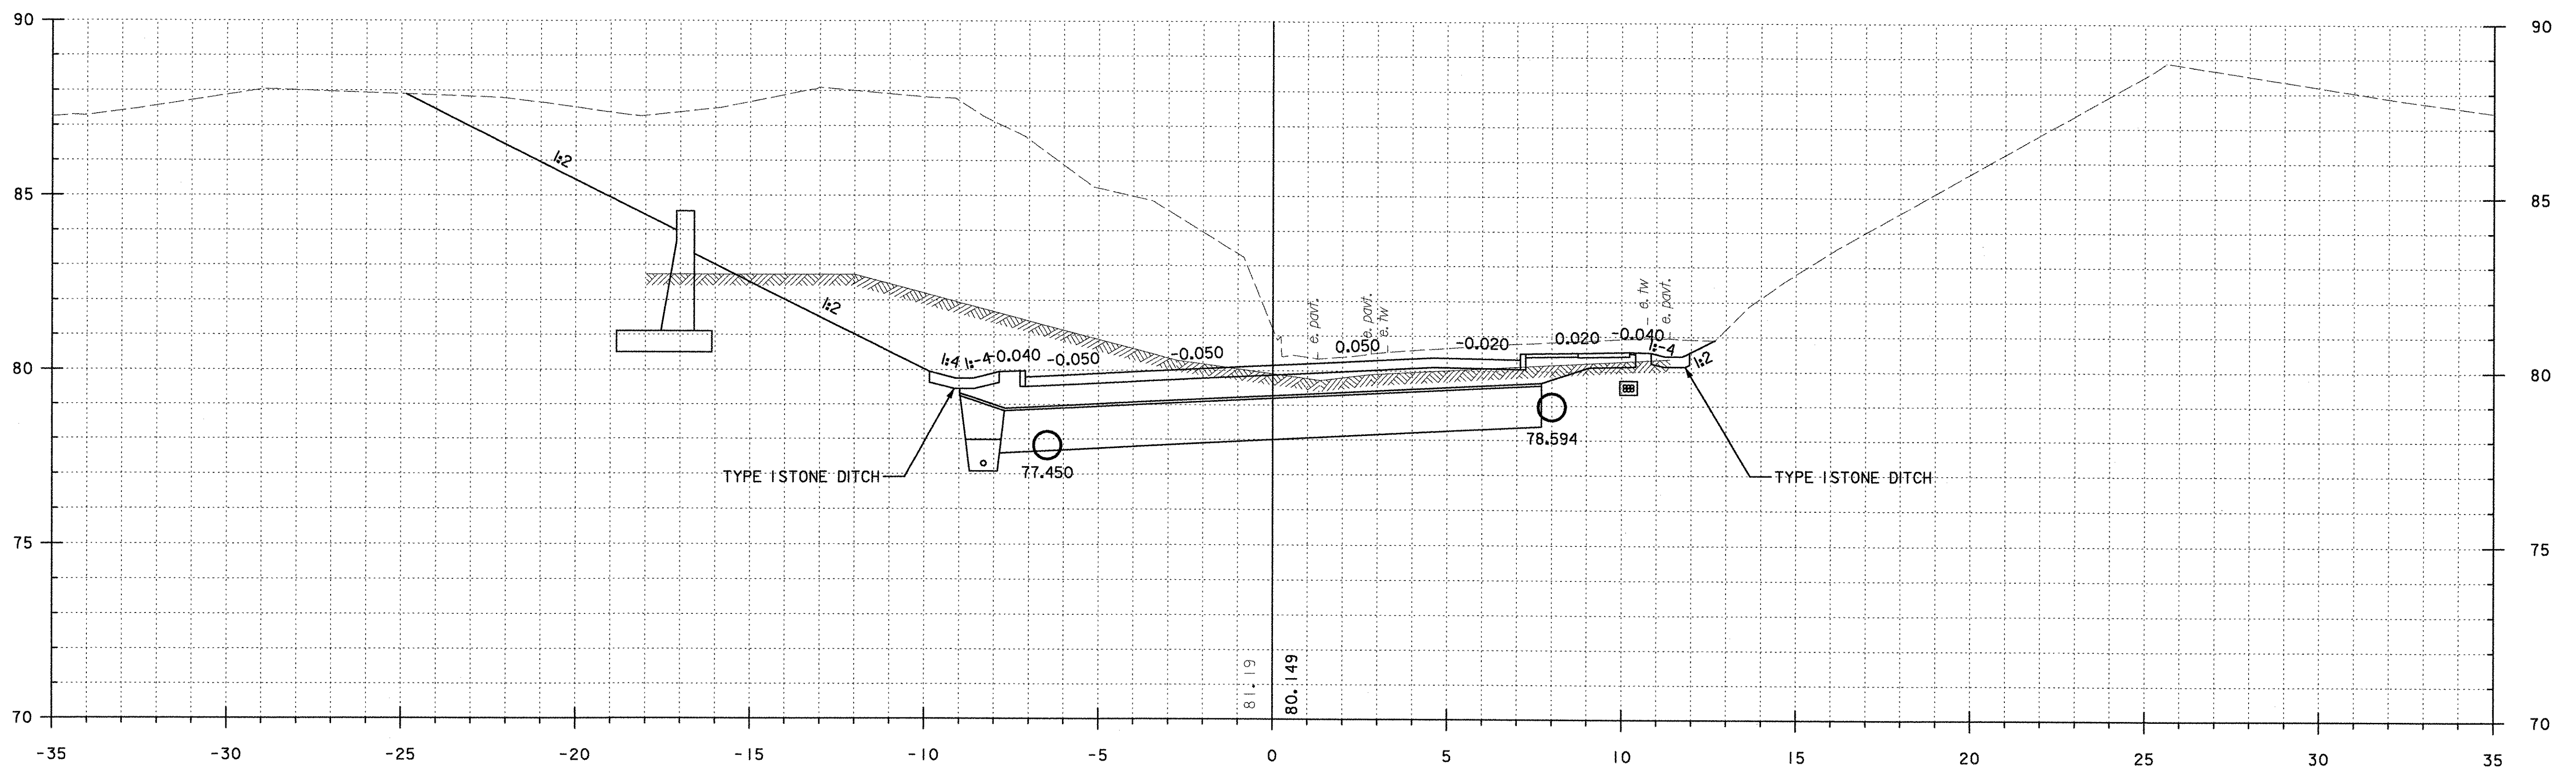


30+240.000

PROJECT: BRATTLEBORO	PROJECT NO.: NH 010-2(2)
DESIGN FILE NAME: ...zb270xs2.dgn	PLOT DATE: 09/23/2002
IPARM FILE NAME: VT ROUTE 9	
FROM STA: 30+240.000 TO STA: 30+250.000 SHEET: 107 OF 145	

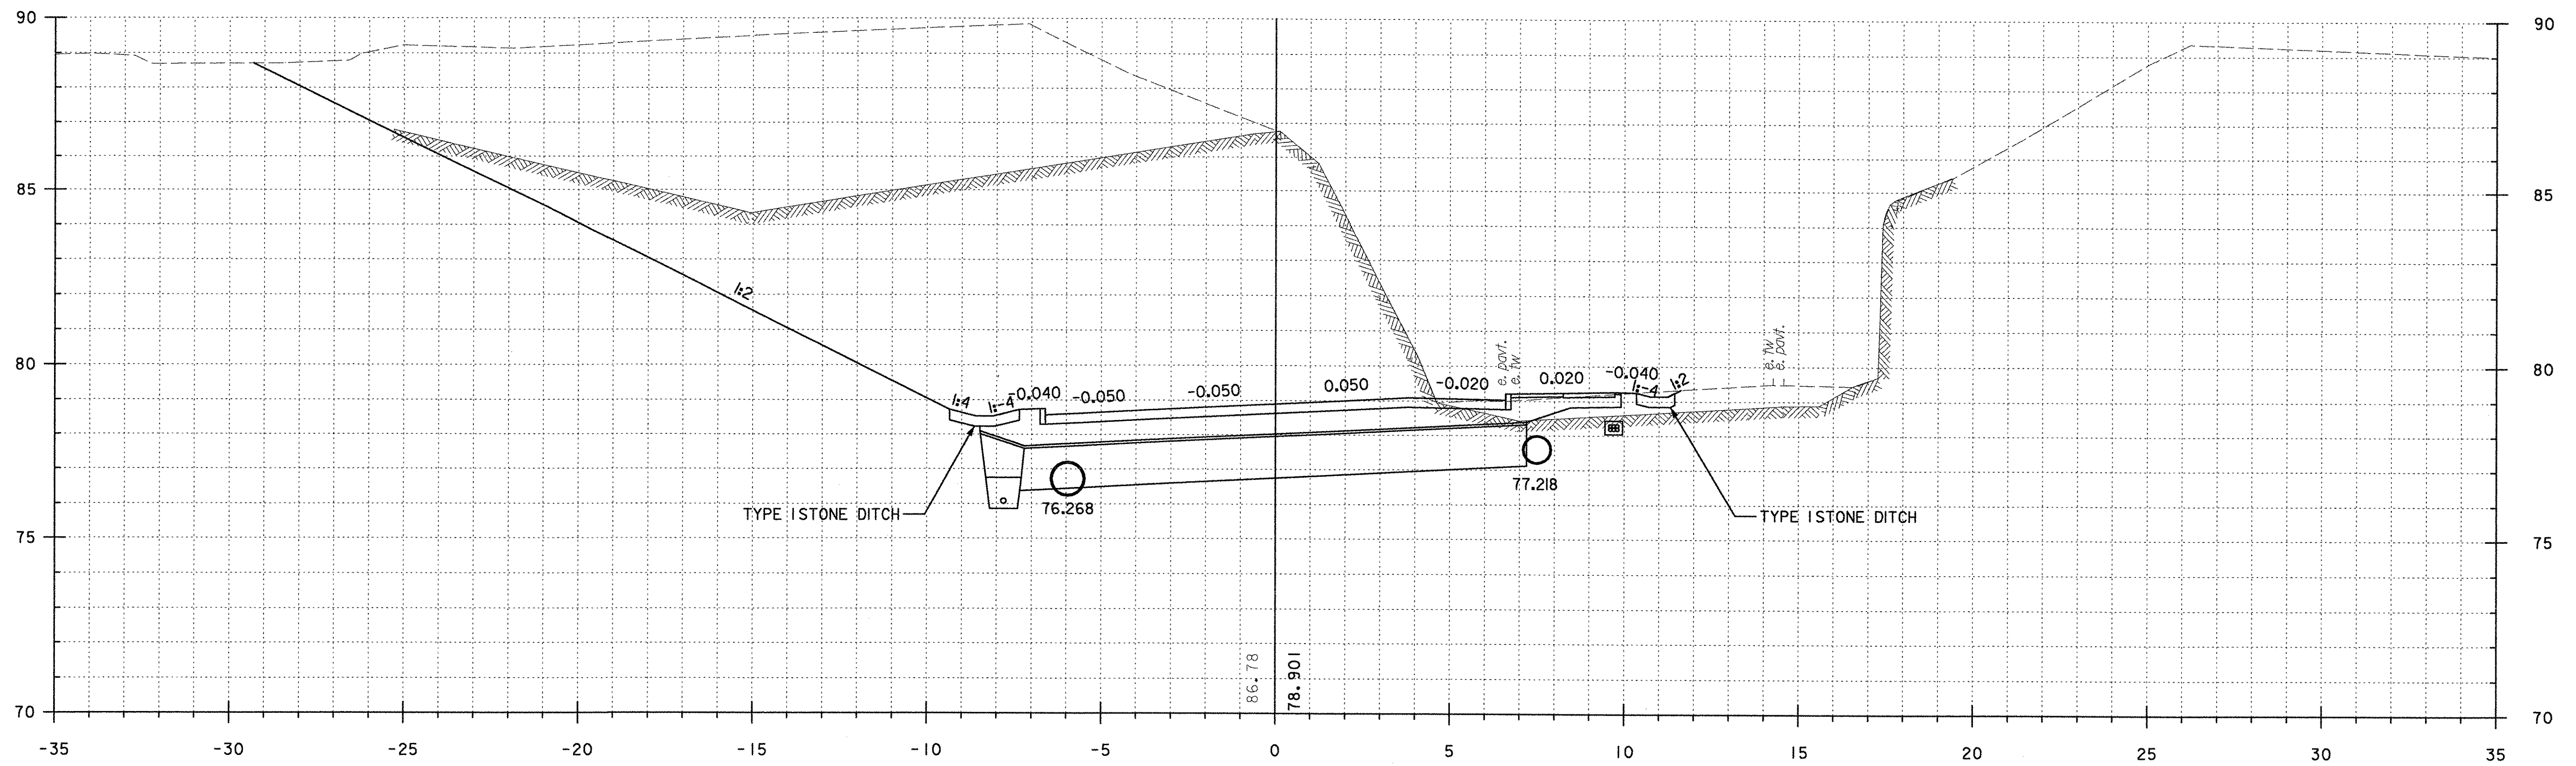


30+270.000

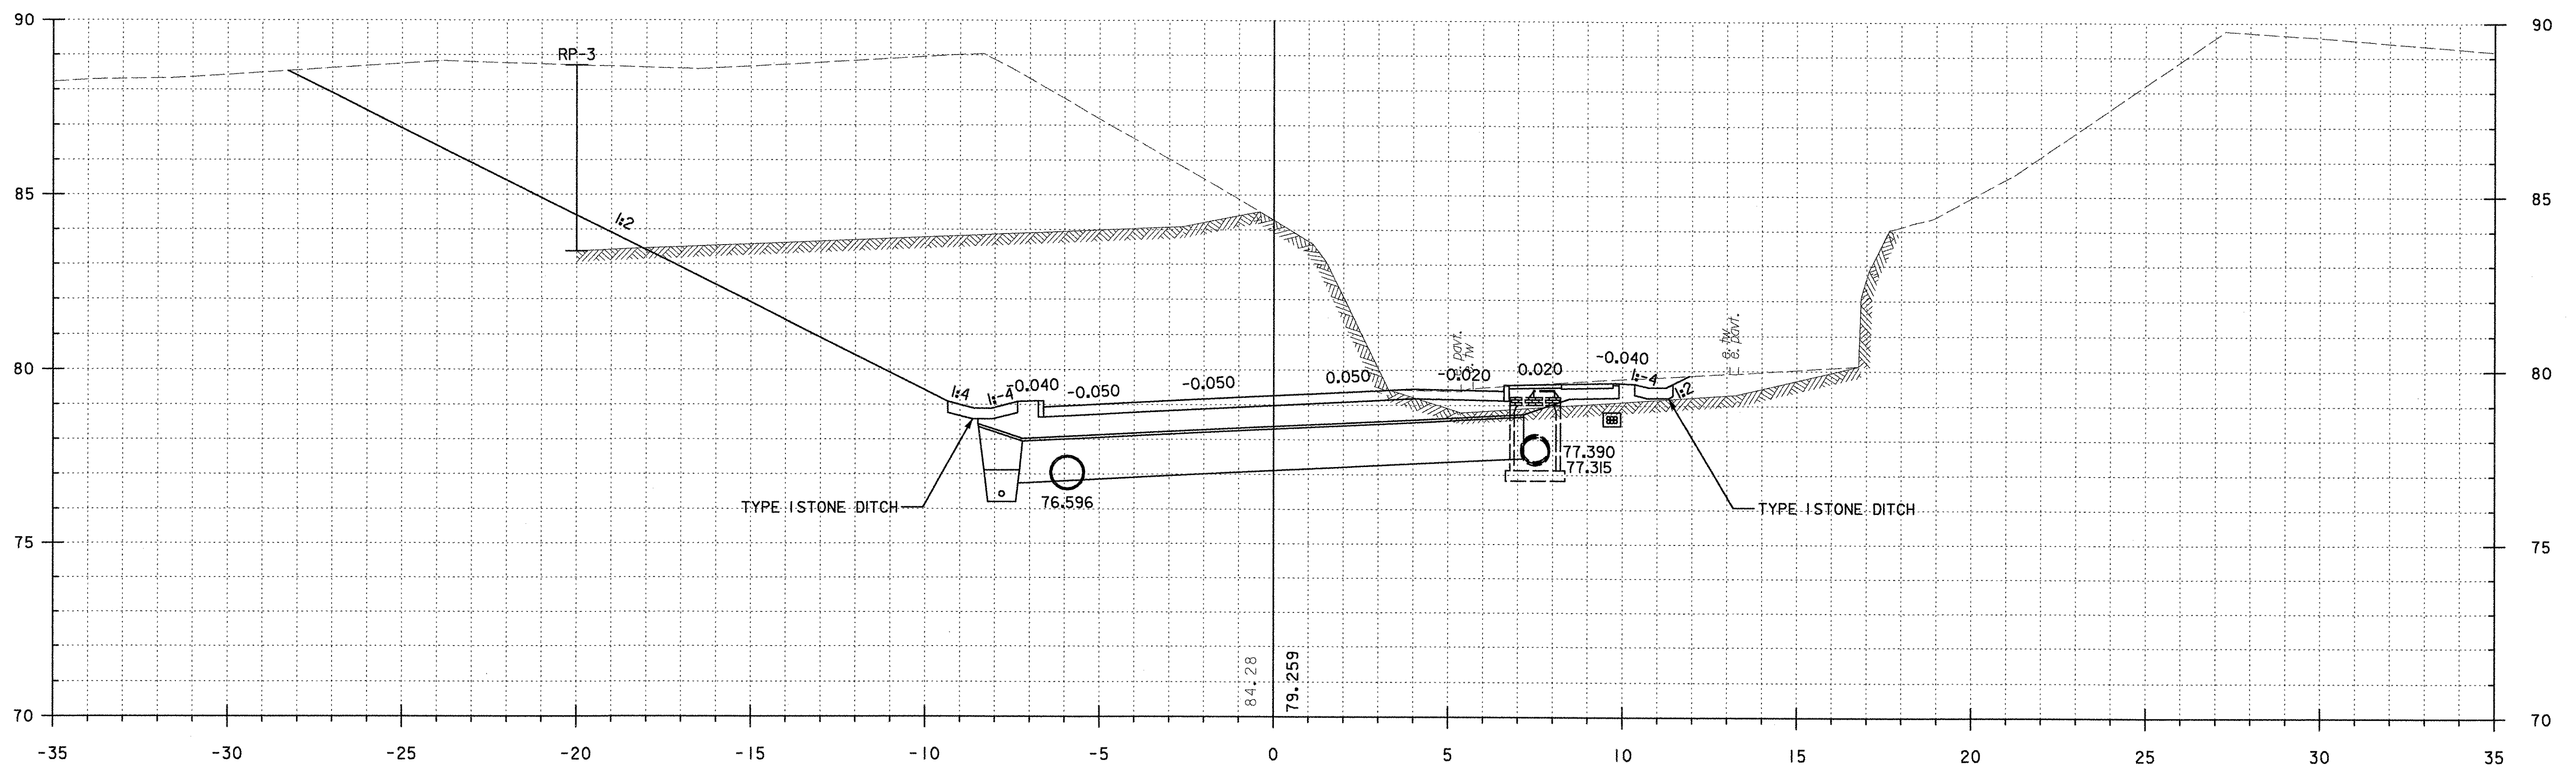


30+260.000

PROJECT: BRATTLEBORO	PROJECT NO. : NH 010-2(2)
DESIGN FILE NAME: ...zb270xs2.dgn	PLOT DATE: 09/23/2002
IPARM FILE NAME:	VT ROUTE 9
FROM STA: 30+260.000 TO STA: 30+270.000 SHEET: 108 OF 145	


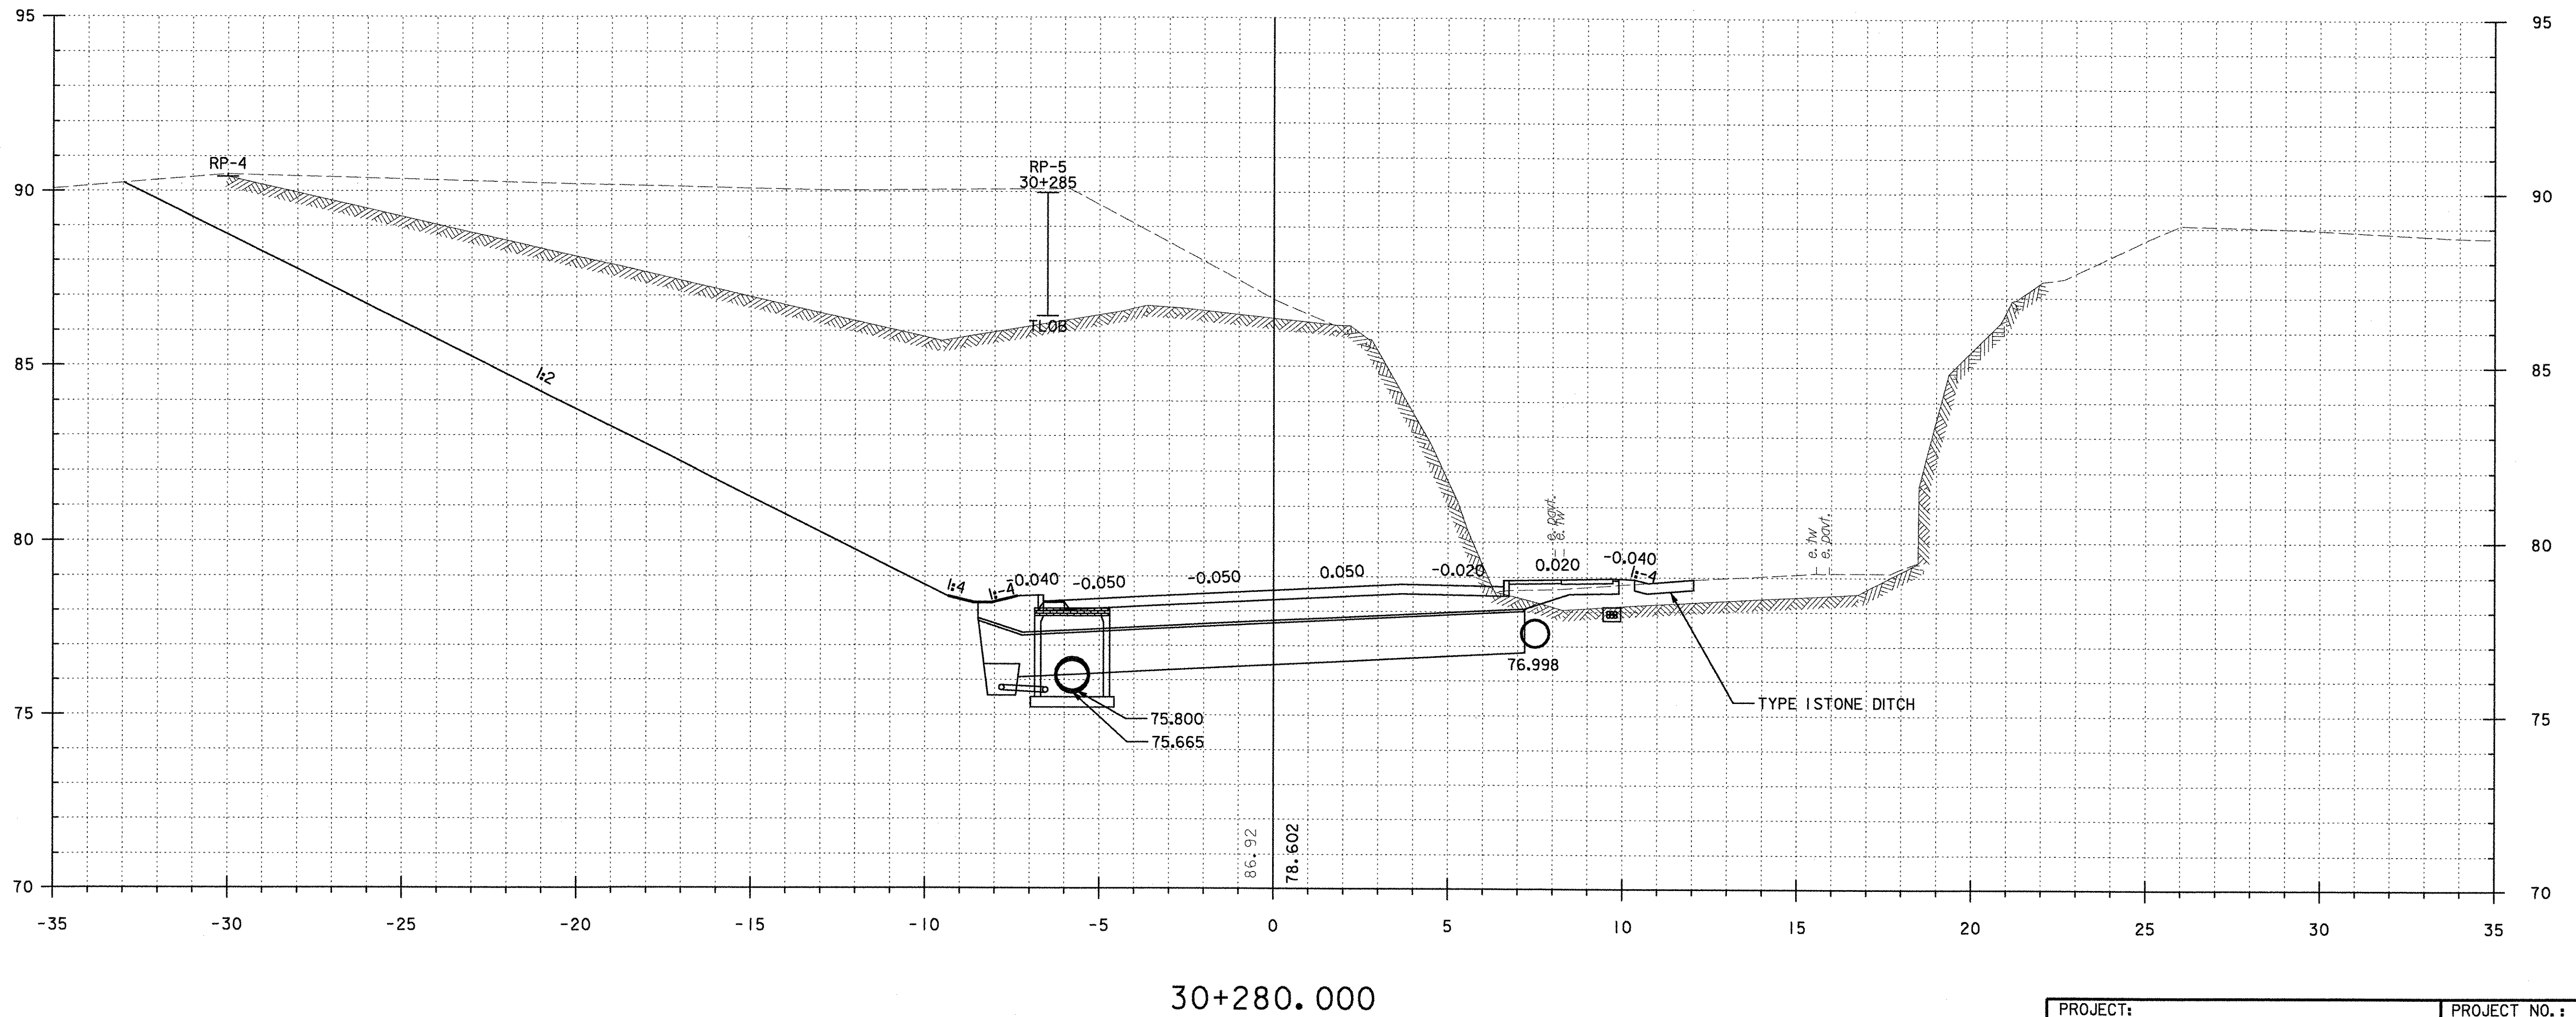


PROJECT:	BRATTLEBORO	PROJECT NO.:	NH 010-2(2)
DESIGN FILE NAME:	...zb270xs2.dgn	PLOT DATE:	09/23/2002
IPARM FILE NAME:			
VT ROUTE 9			
FROM STA: 30+280.000 TO STA: 30+280.000 SHEET: 109 OF 145			

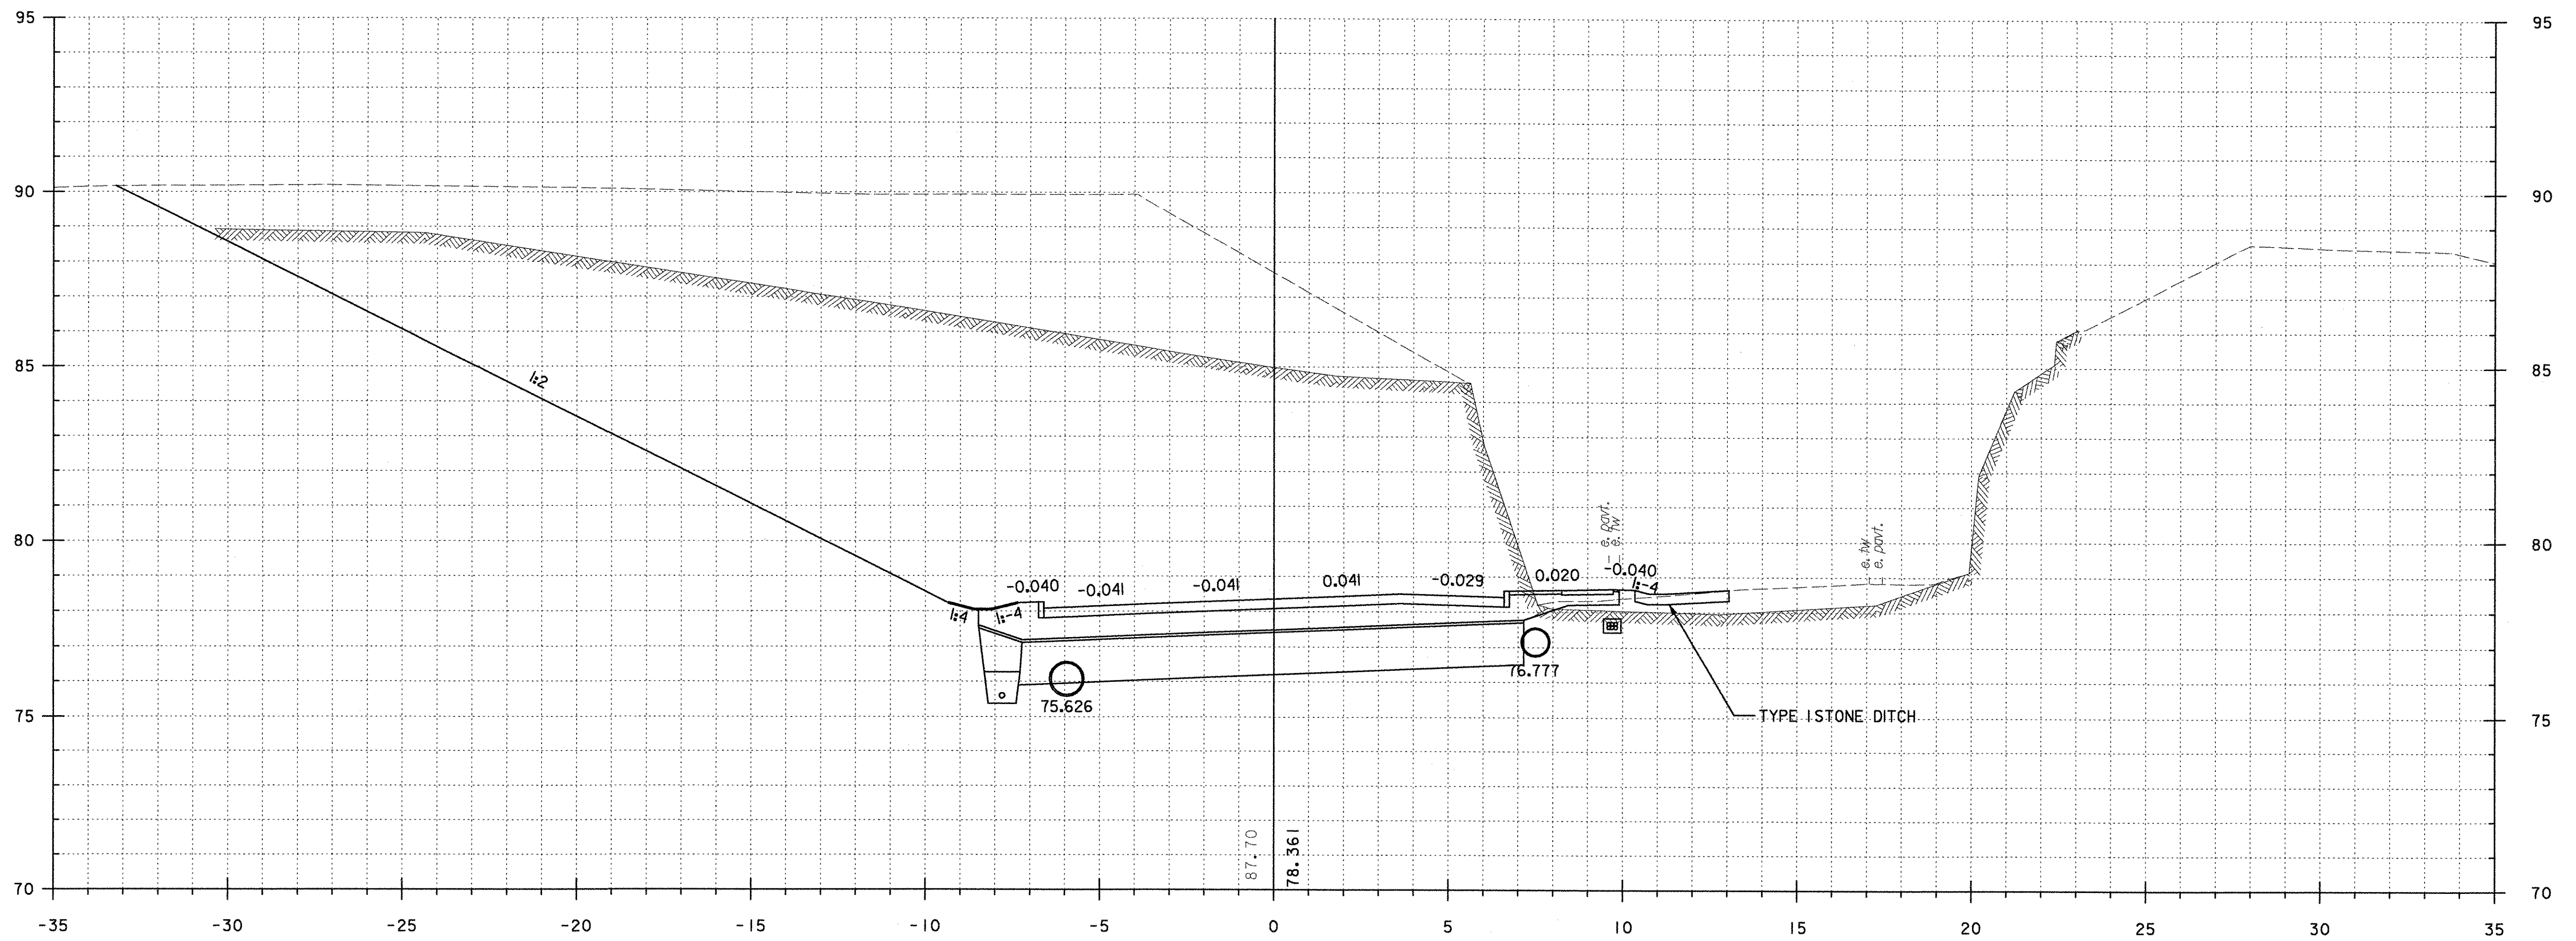


30+290.000


PROJECT: BRATTLEBORO	PROJECT NO.: NH 010-2(2)
DESIGN FILE NAME: ...zb270xs2.dgn	PLOT DATE: 09/23/2002
IPARM FILE NAME:	VT ROUTE 9
FROM STA: 30+290.000 TO STA: 30+290.000 SHEET: 110 OF 145	

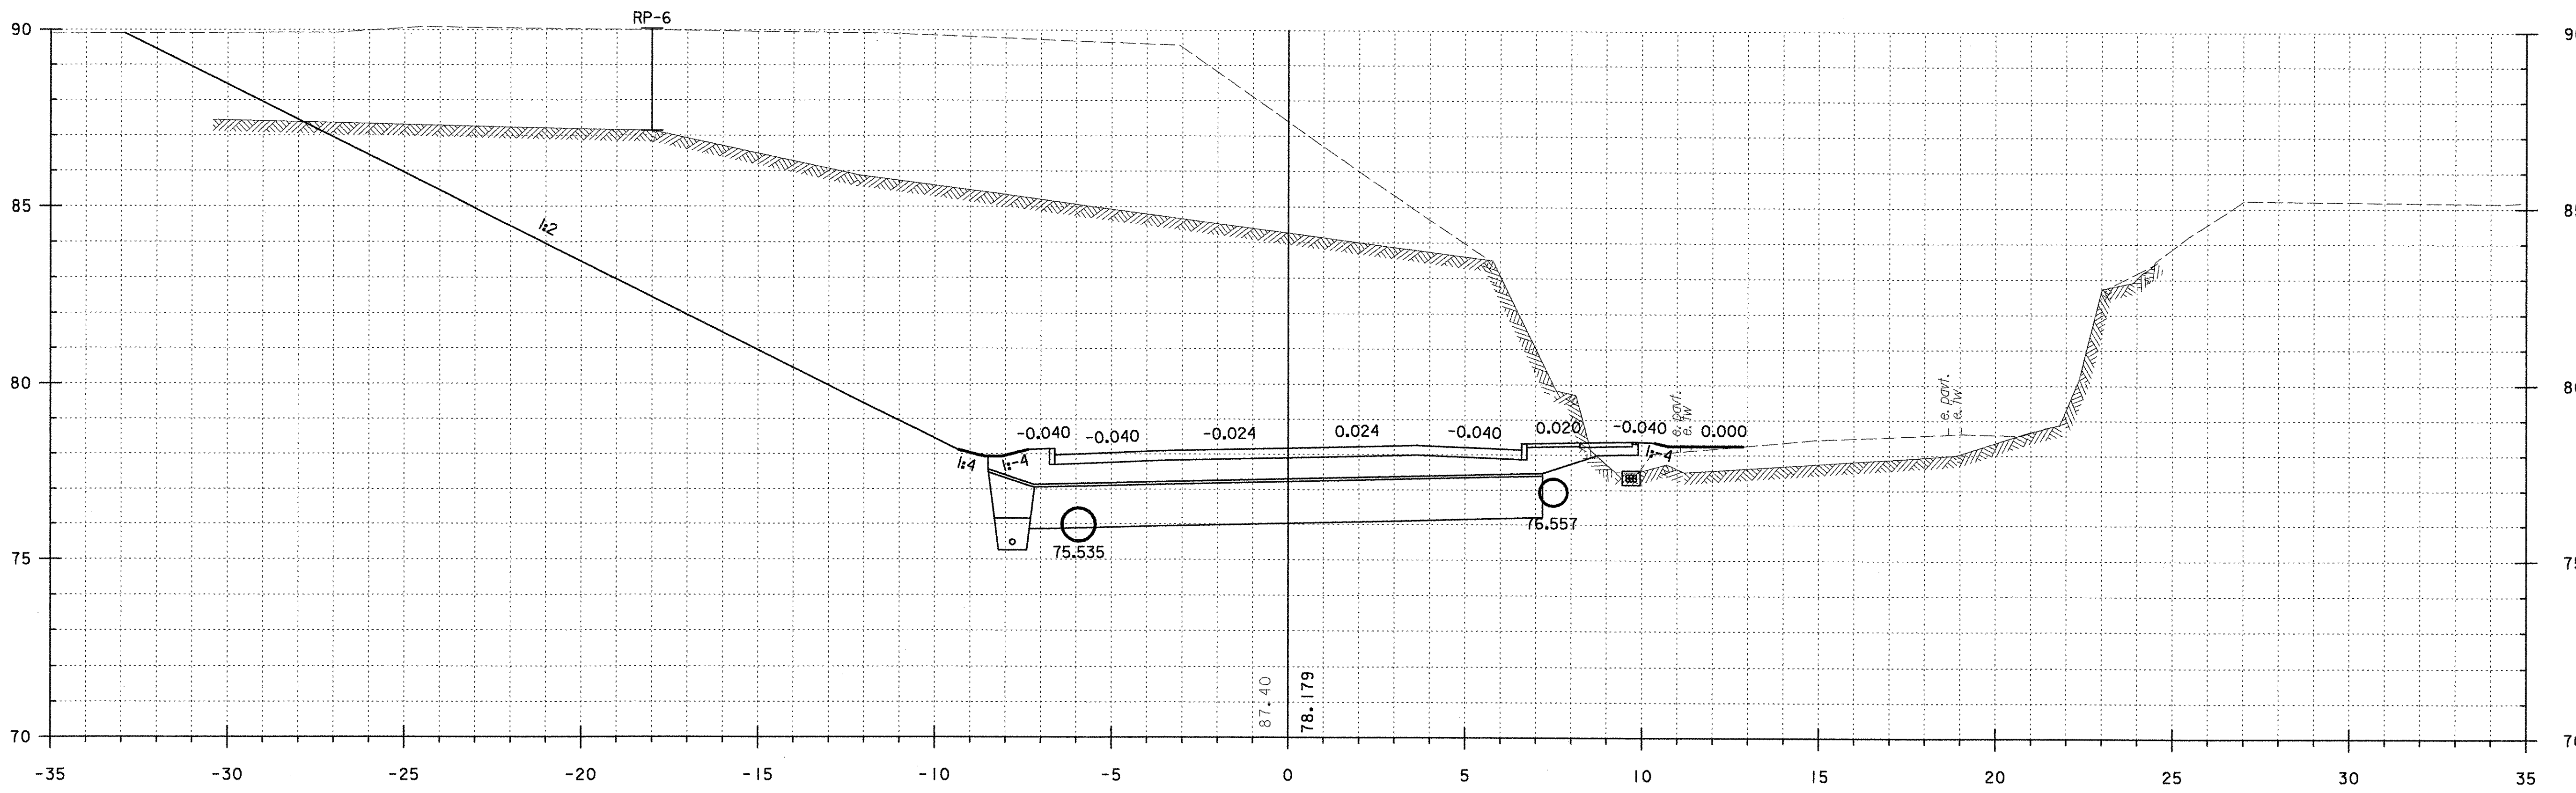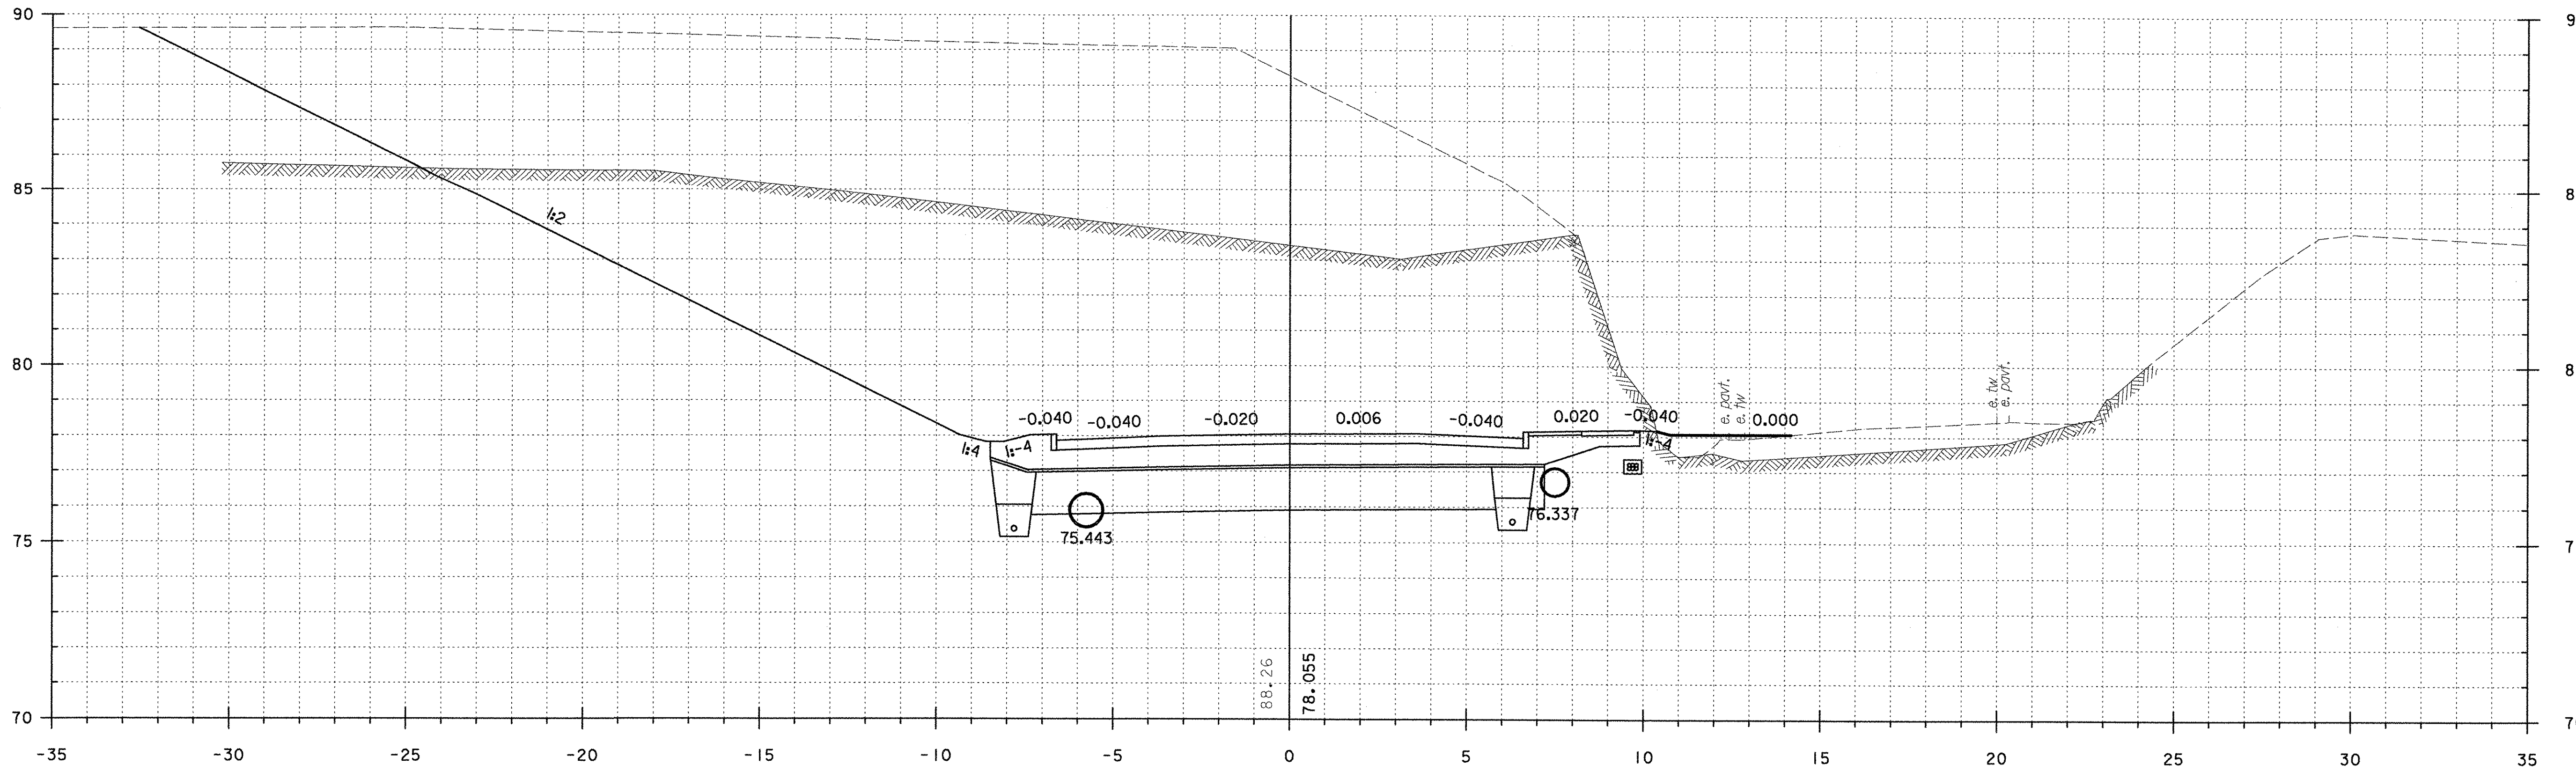

PROJECT: BRATTLEBORO	PROJECT NO. : NH 010-2(2)
DESIGN FILE NAME: ...\\zb270xs2.dgn	PLOT DATE: 09/23/2002
IPARM FILE NAME:	VT ROUTE 9
FROM STA: 30+300.000 TO STA: 30+310.000 SHEET: 111 OF 145	

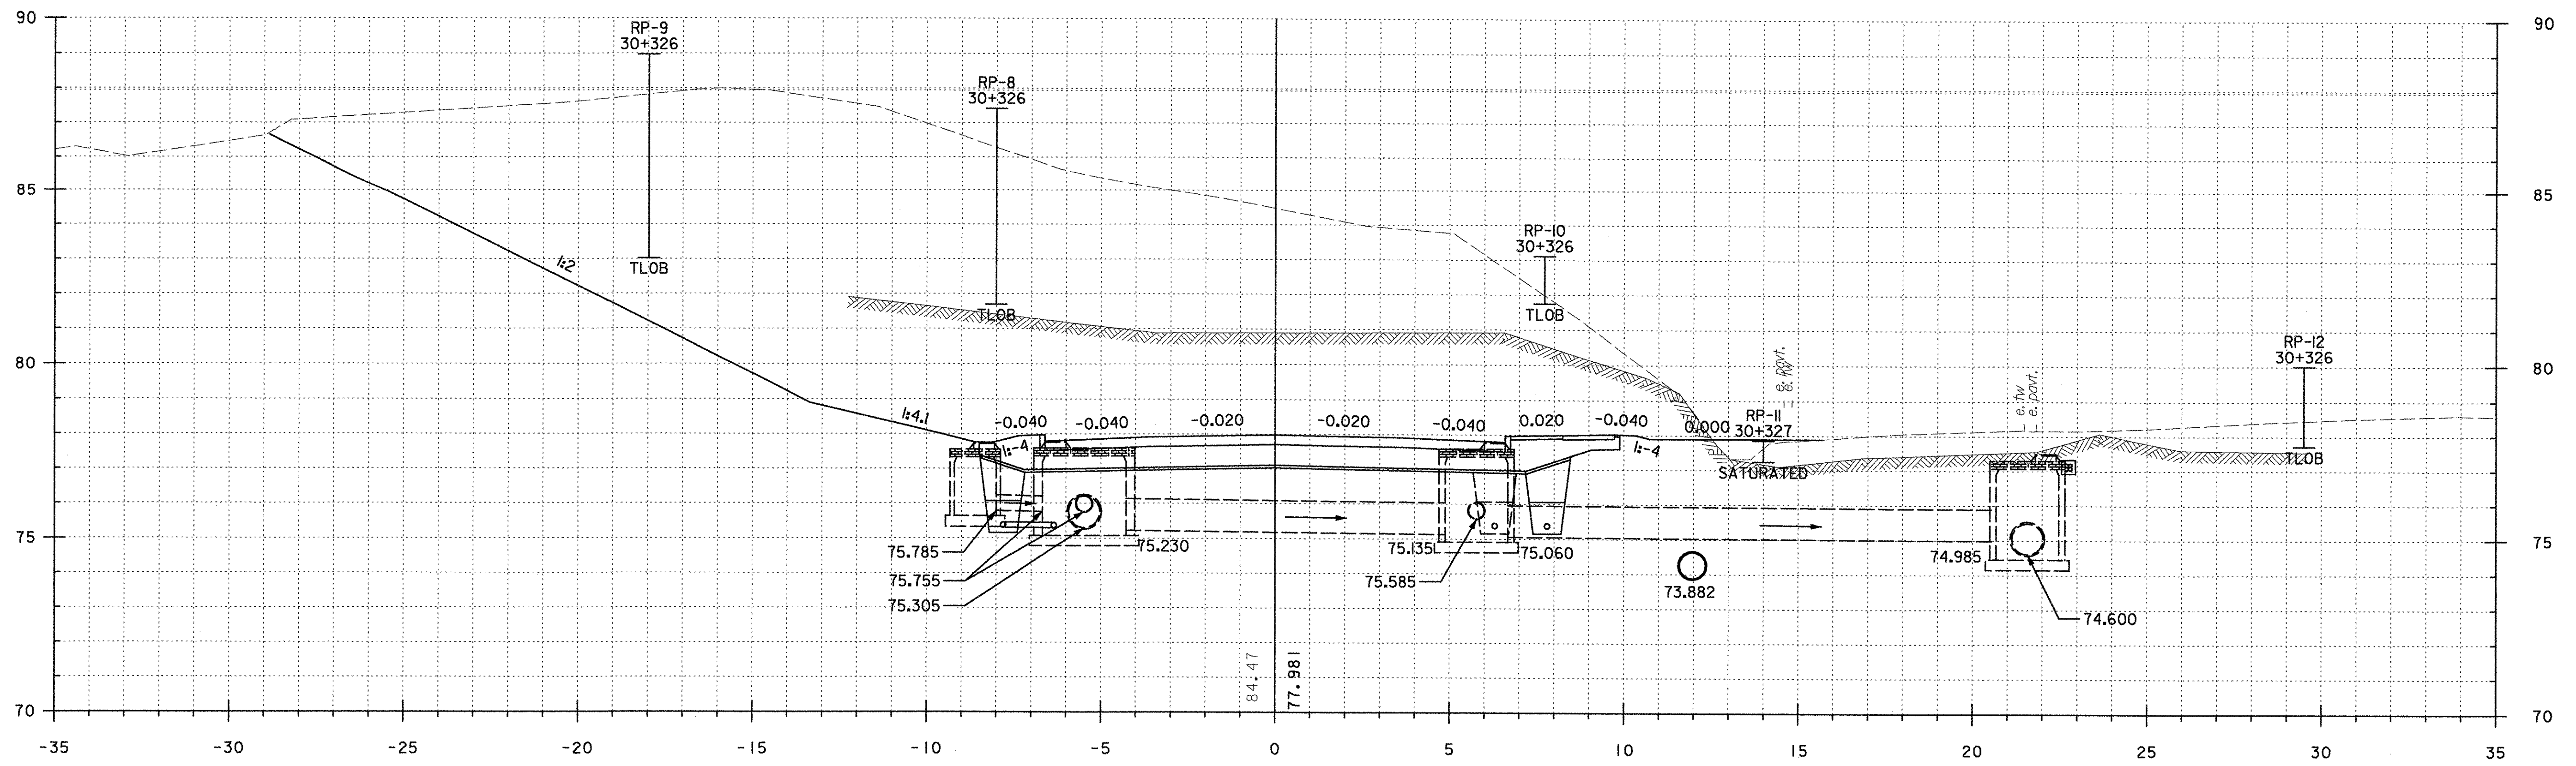


30+330.000

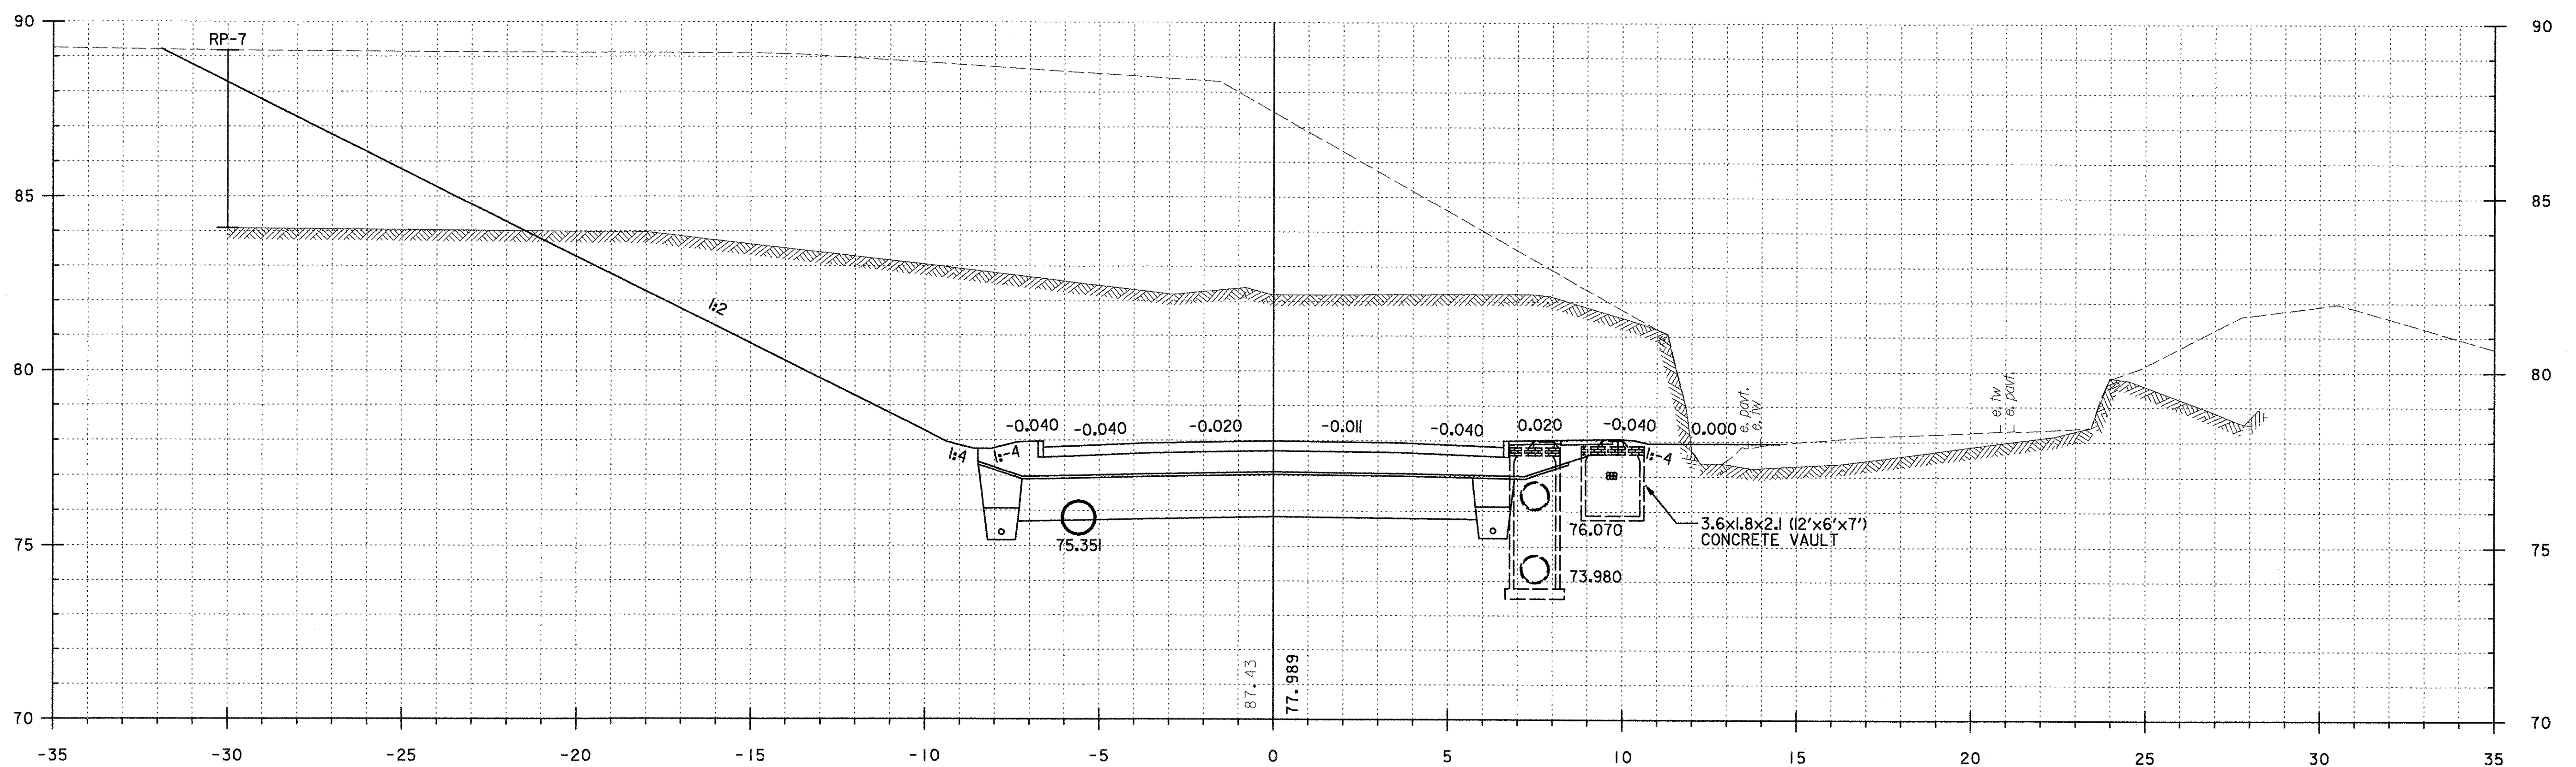


30+320.000


PROJECT: BRATTLEBORO	PROJECT NO. : NH 010-2(2)
DESIGN FILE NAME: ...zb270xs2.dgn	PLOT DATE: 09/23/2002
VT ROUTE 9	
FROM STA: 30+320.000 TO STA: 30+330.000 SHEET: 112 OF 145	

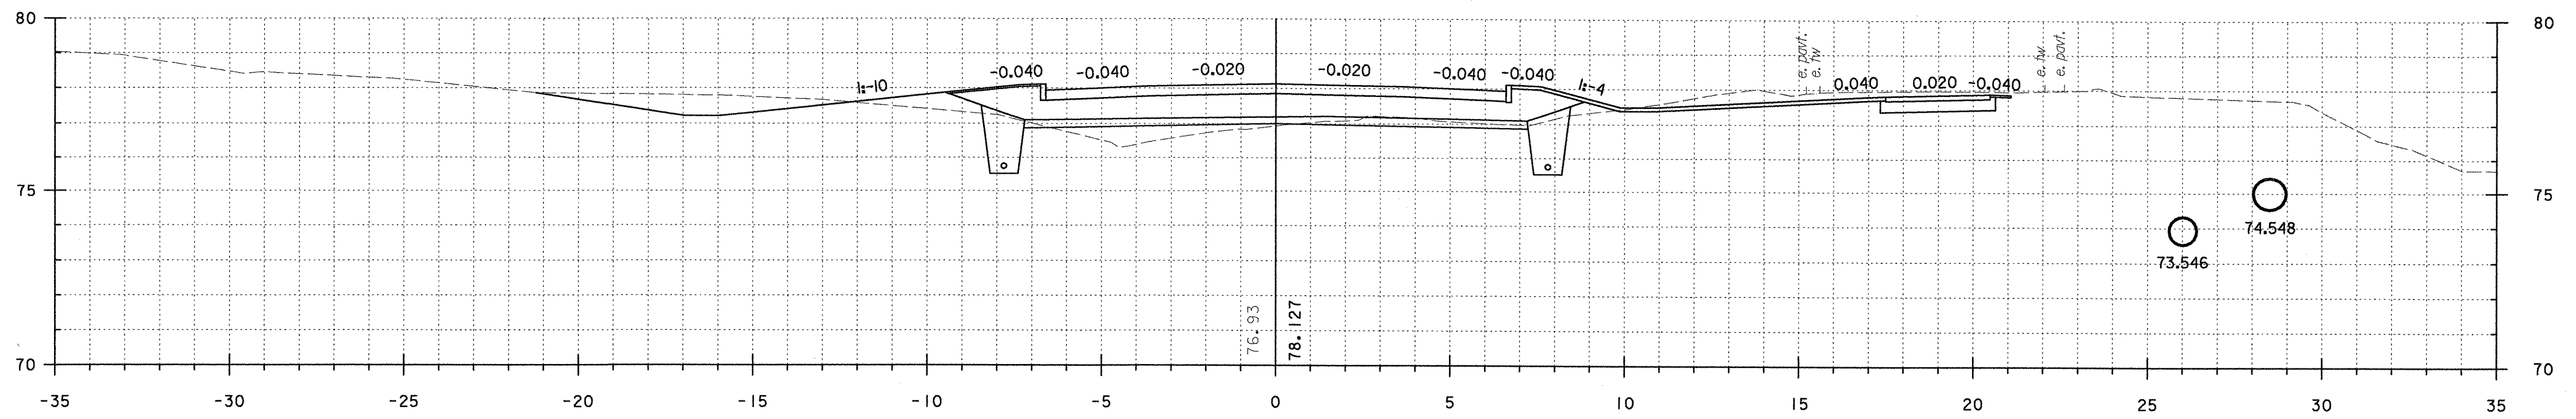

A 203+50.000



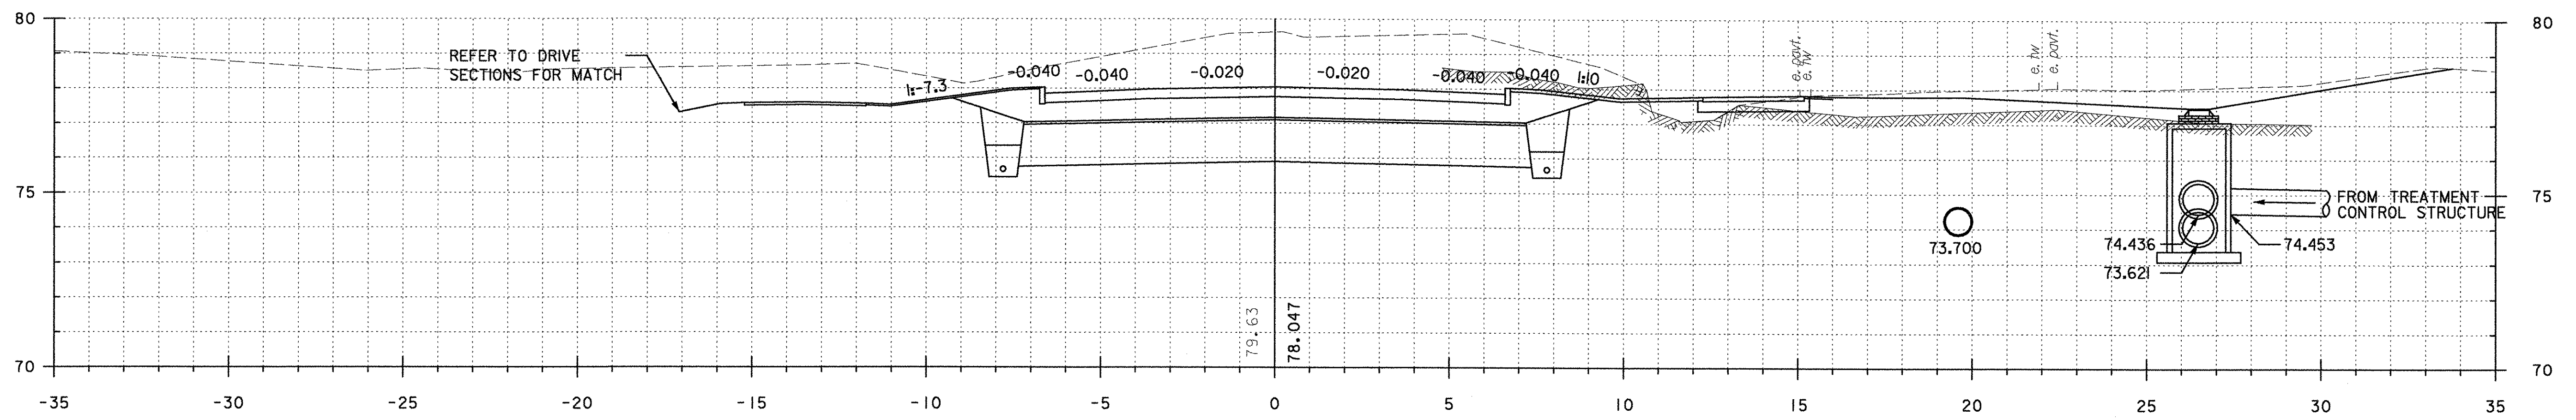


A 203+40.000




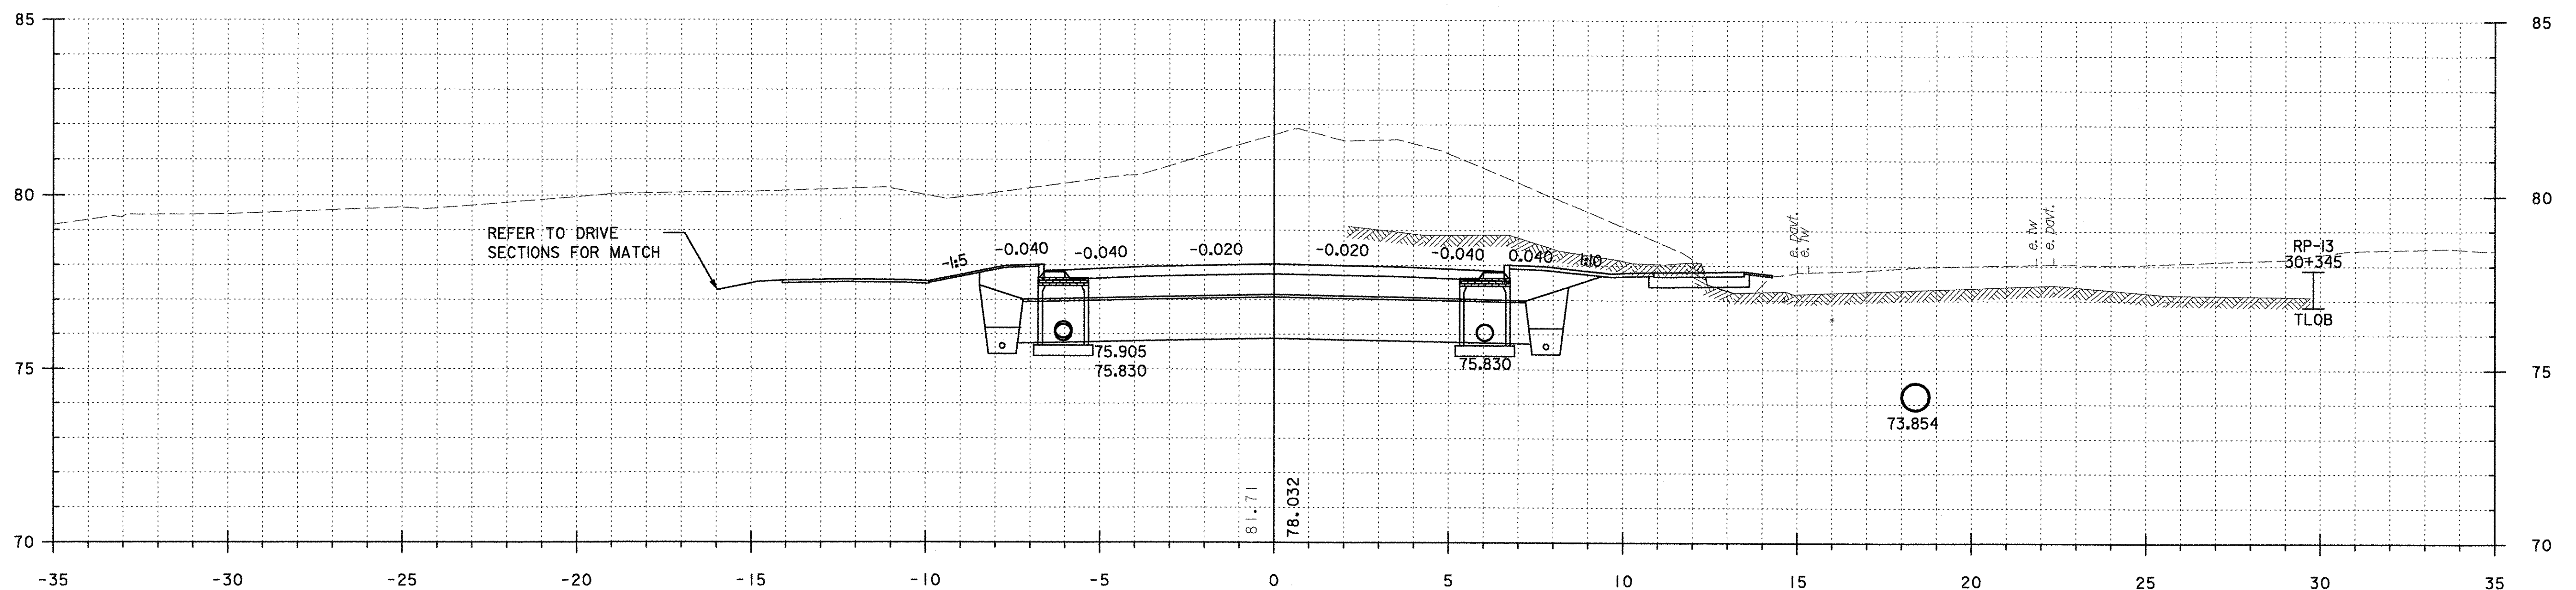


30+340.000

PROJECT: BRATTLEBORO	PROJECT NO. : NH 010-2(2)
DESIGN FILE NAME: ...zb270xs2.dgn	PLOT DATE: 09/23/2002
IPARM FILE NAME:	VT ROUTE 9
FROM STA: 30+340.000 TO STA: A203+50.000 SHEET: 113 OF 145	

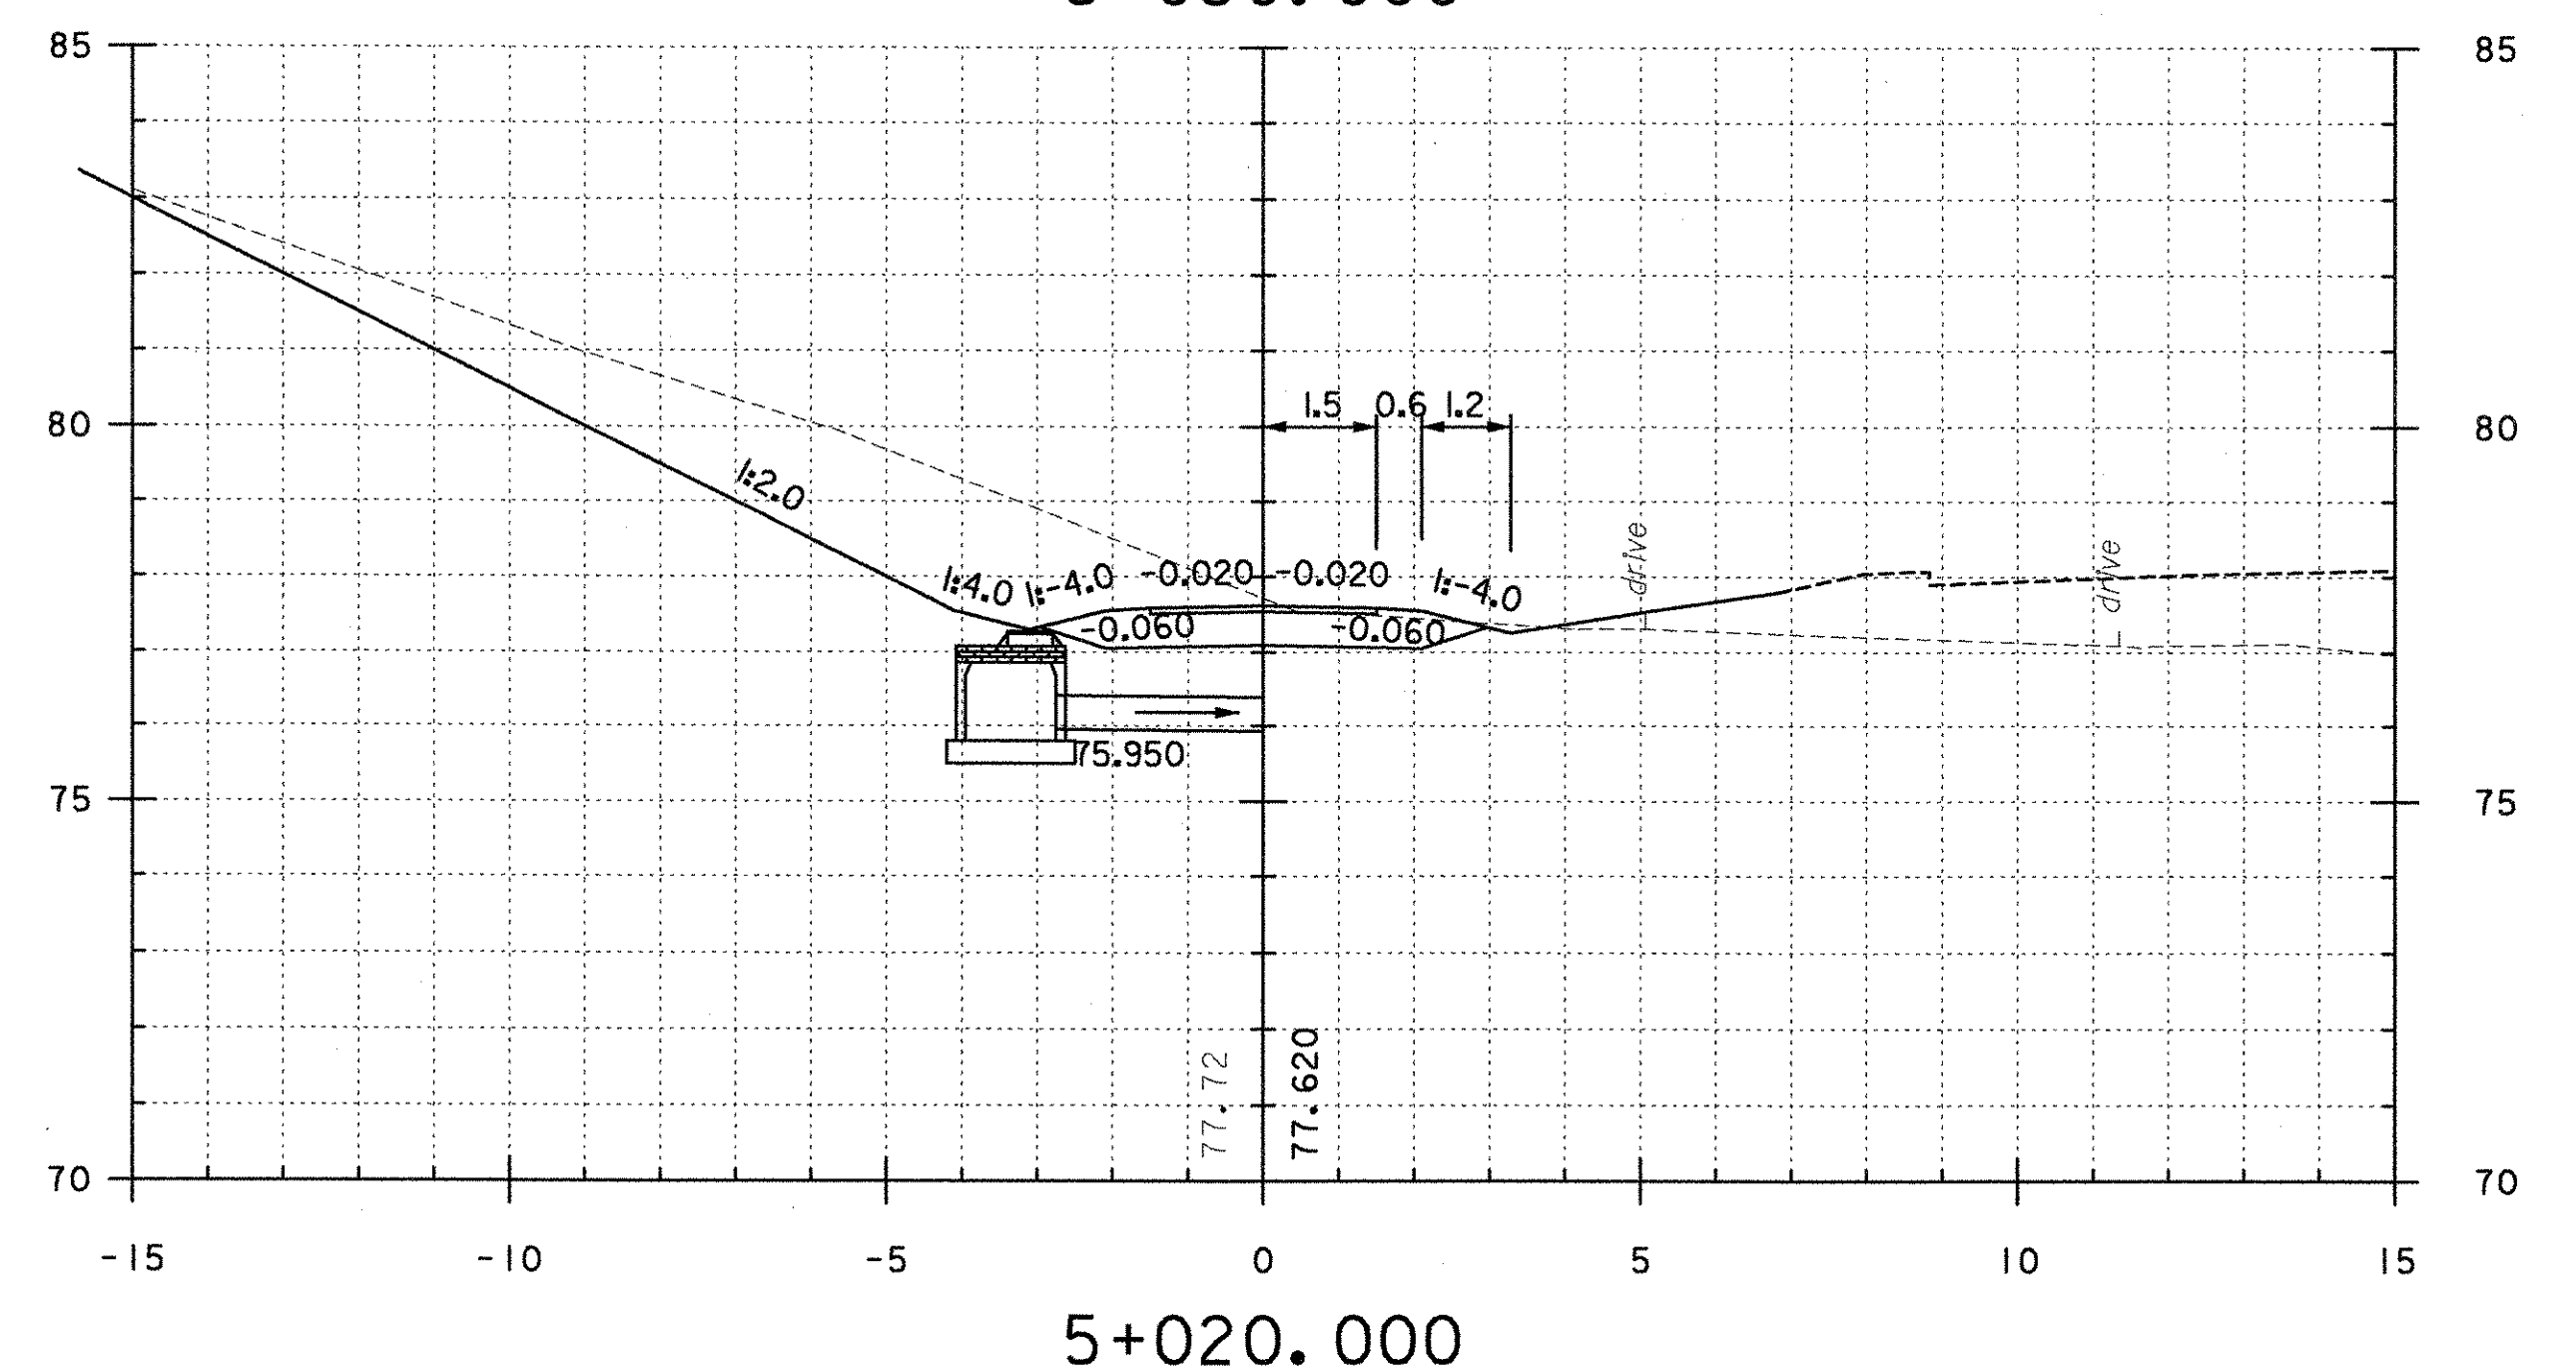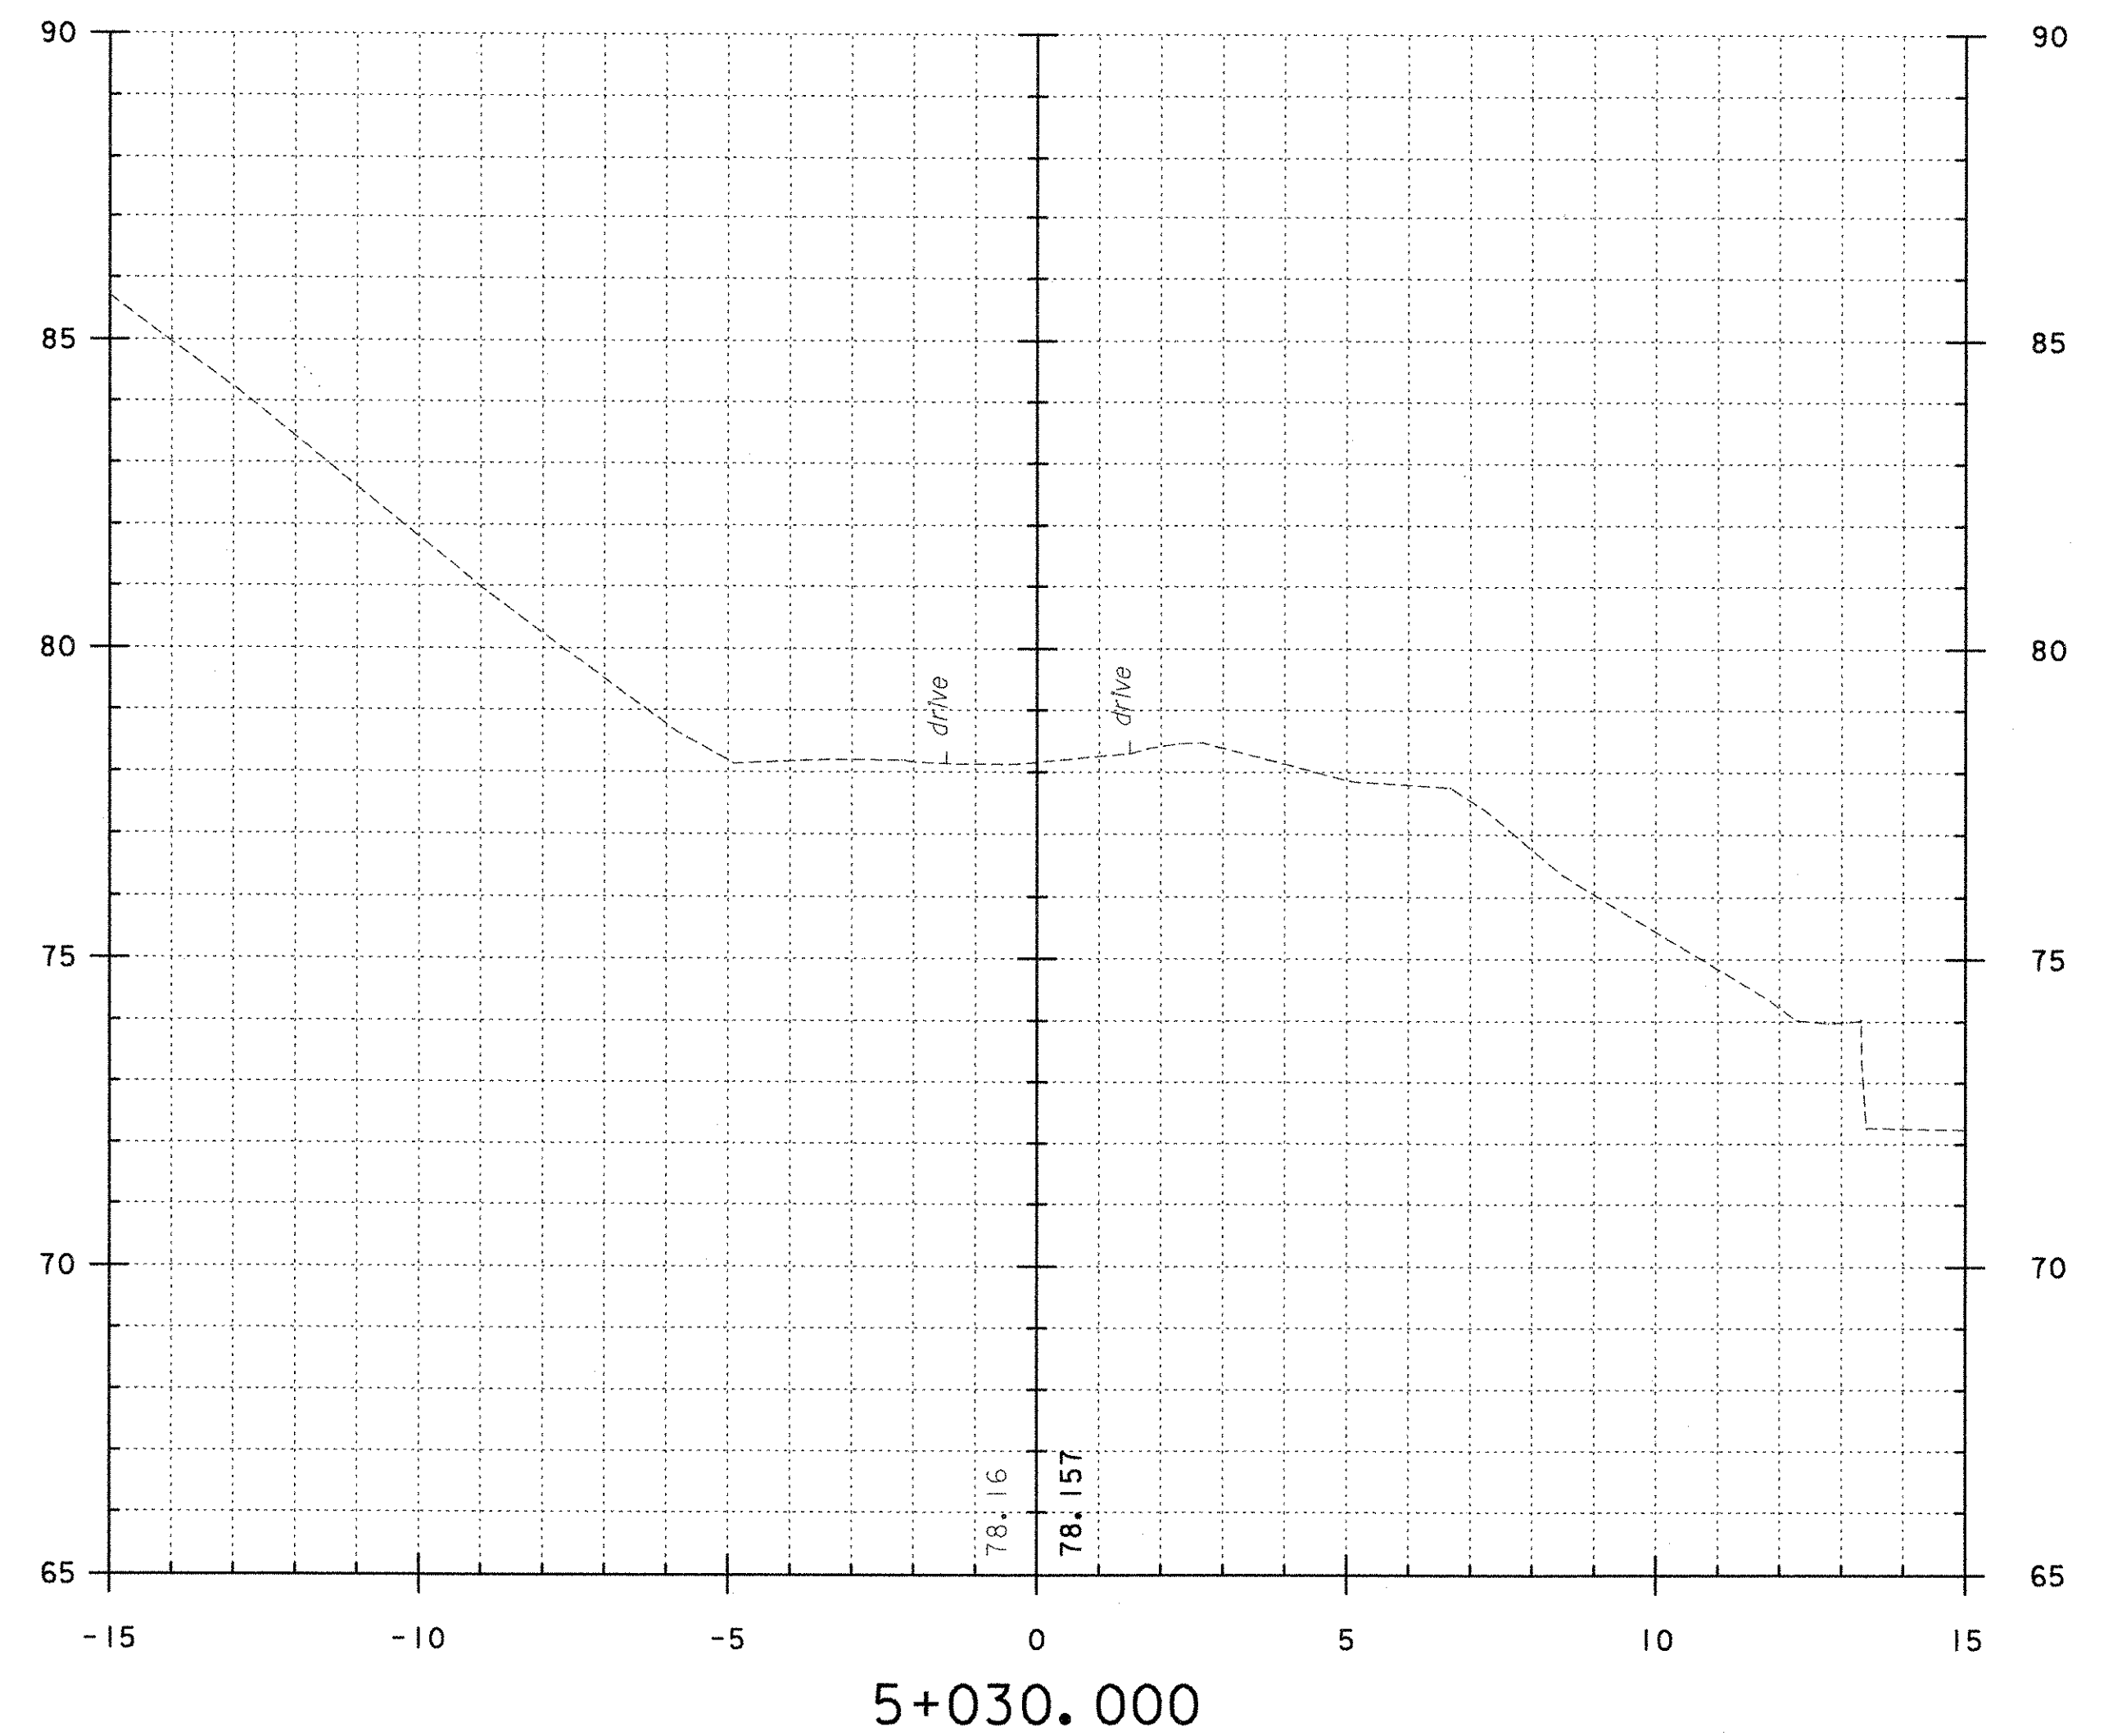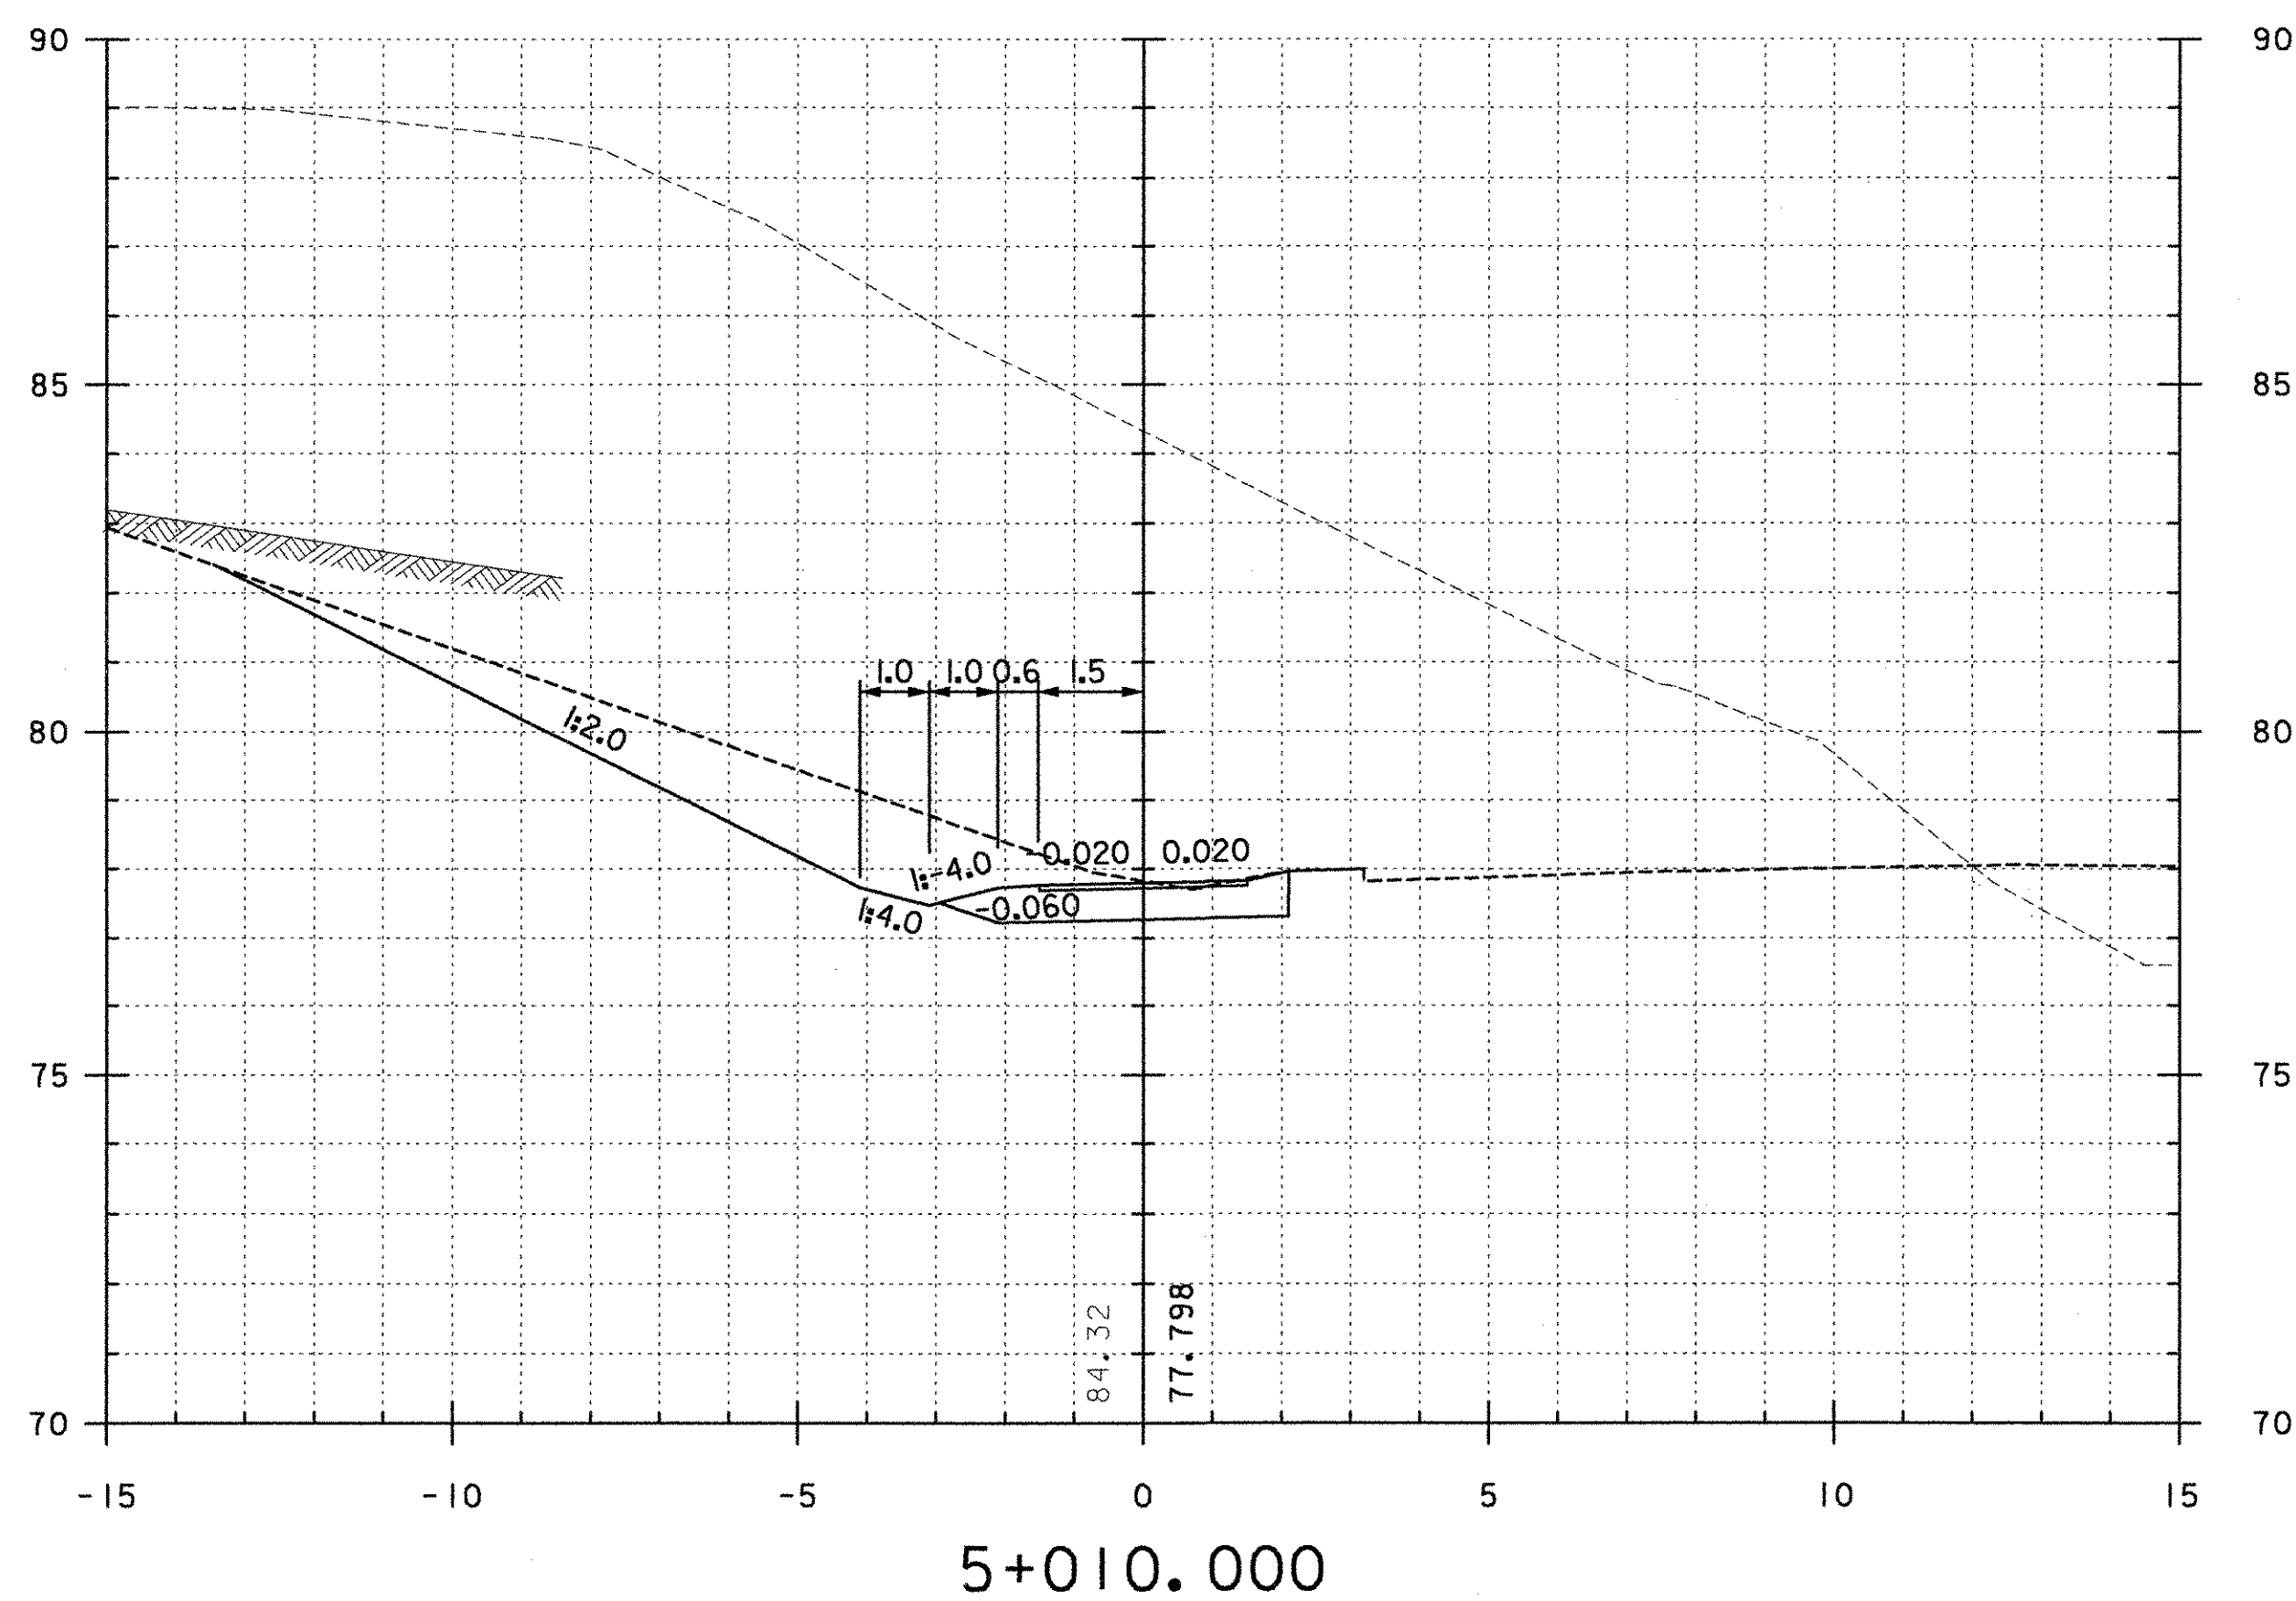


PROJECT: BRATTLEBORO	PROJECT NO. : NH 010-2(2)
DESIGN FILE NAME: ...zb270xs2.dgn	PLOT DATE: 09/23/2002
IPARM FILE NAME:	DRIVEWAY STA 30+330 LT
FROM STA: 5+000.000	TO STA: 5+030.000
SHEET: 114 OF 145	

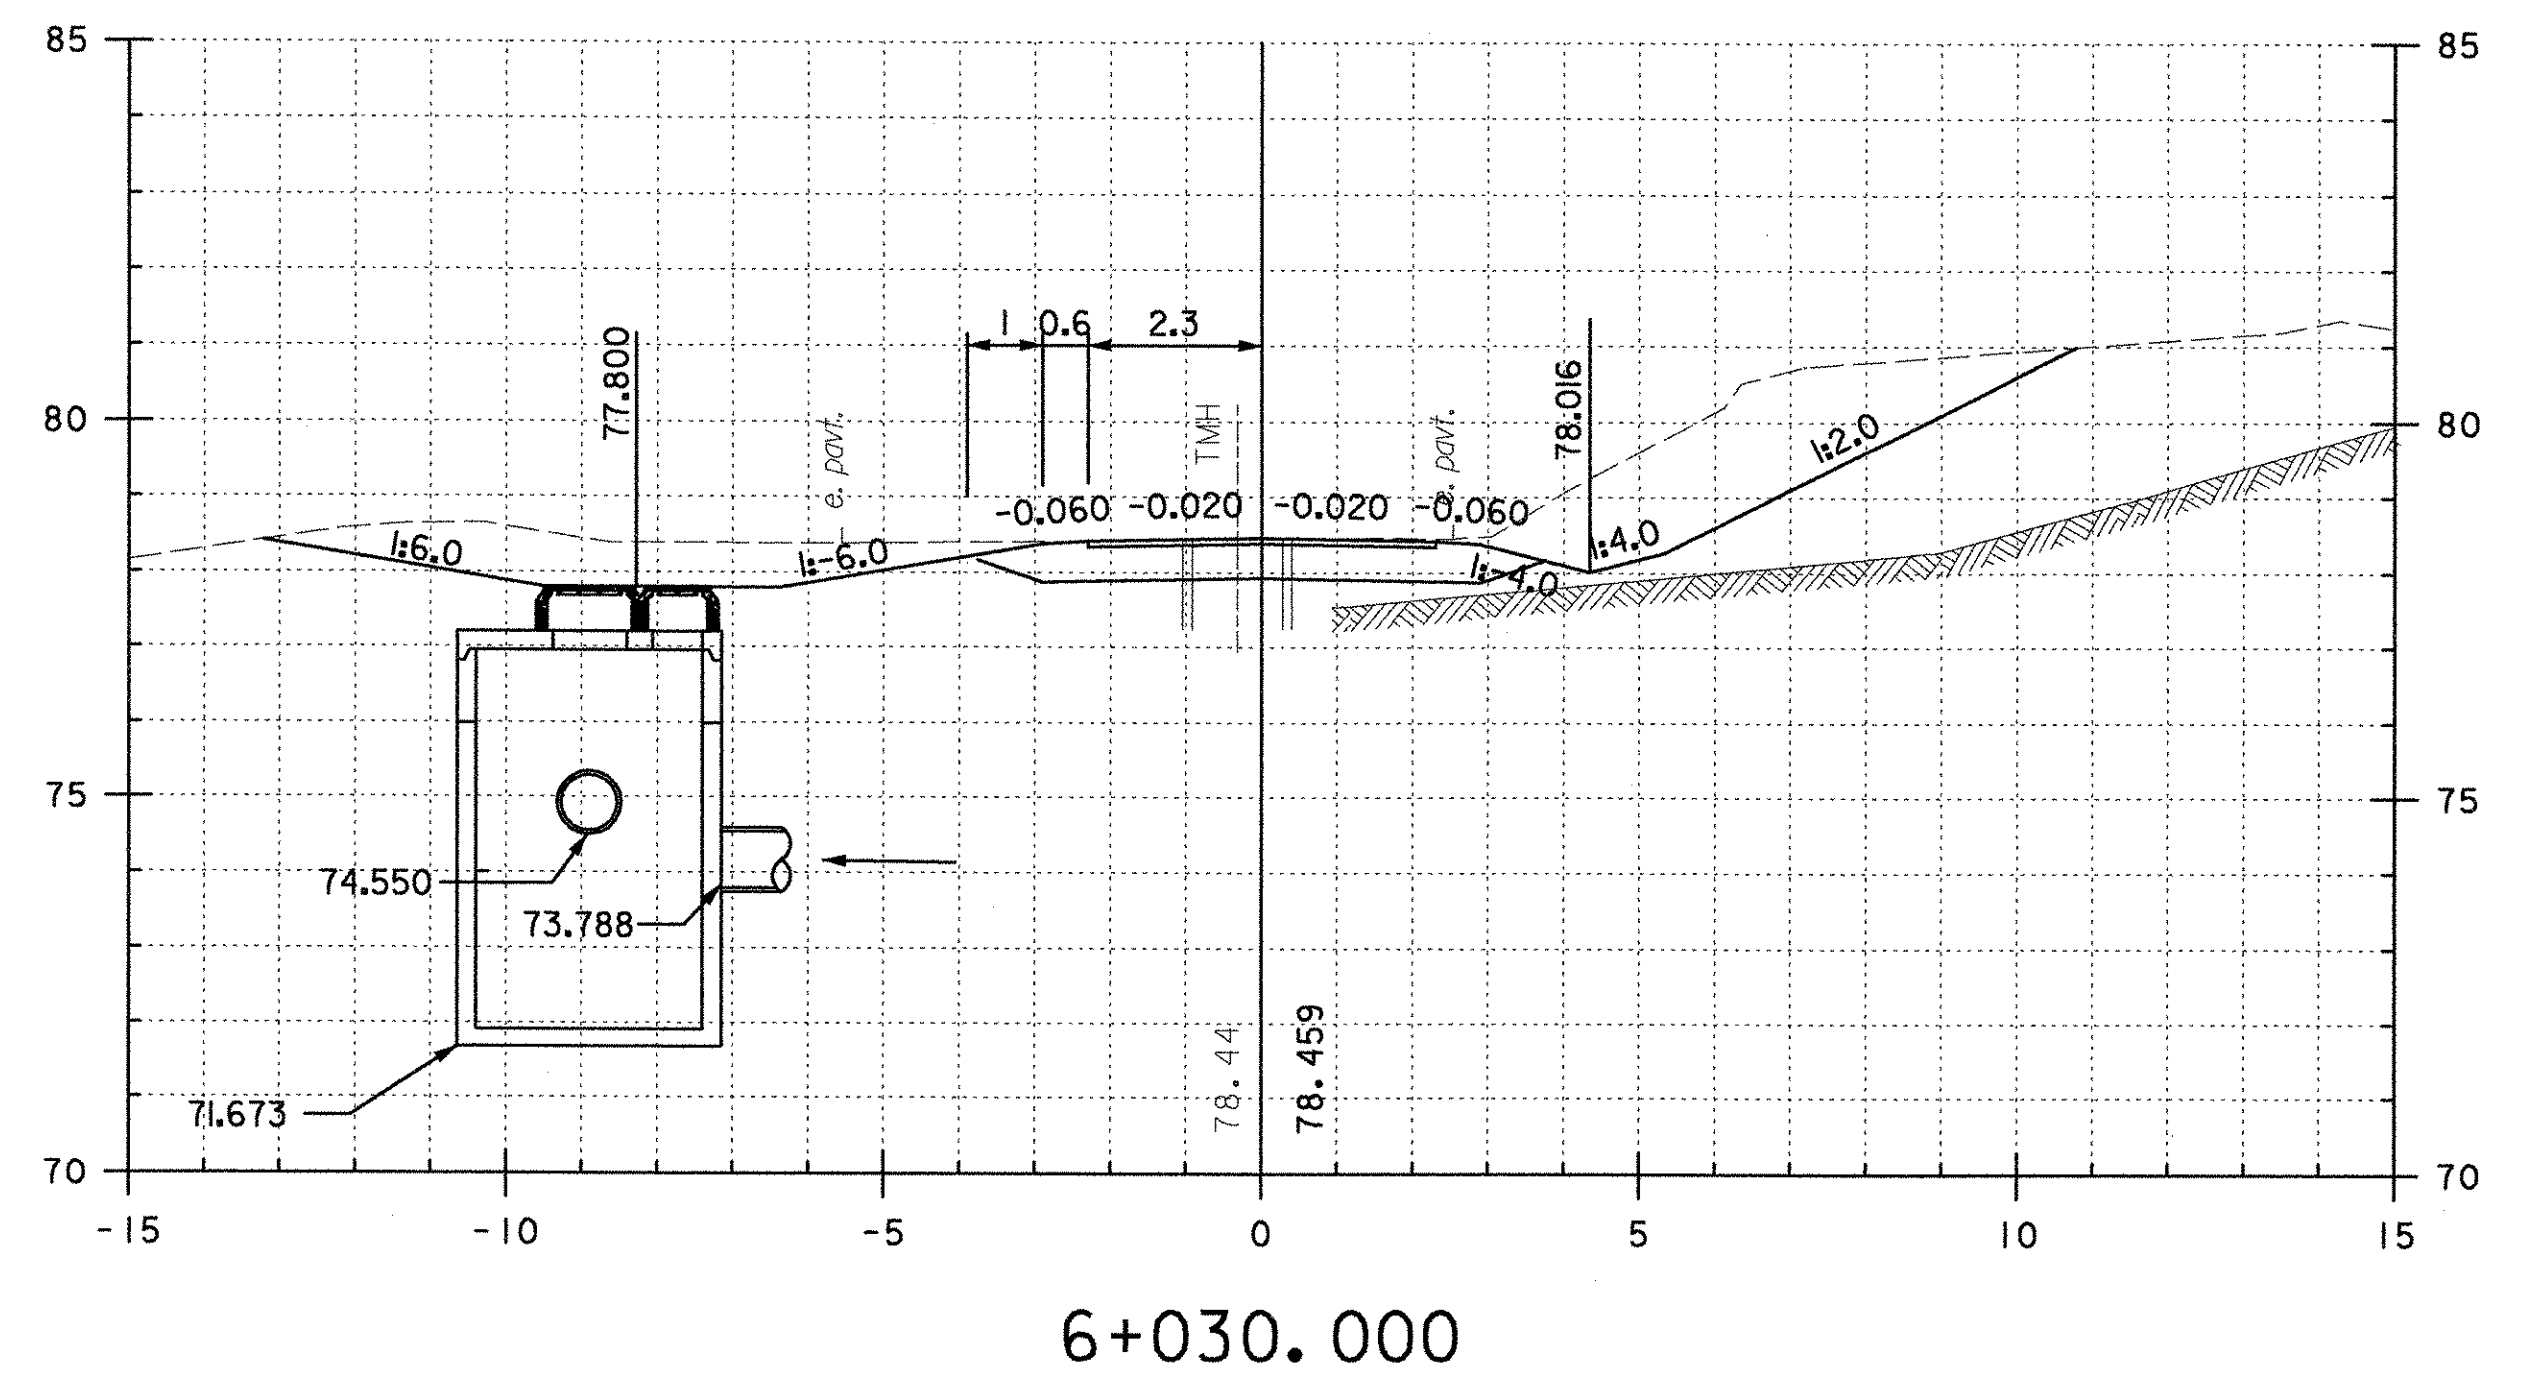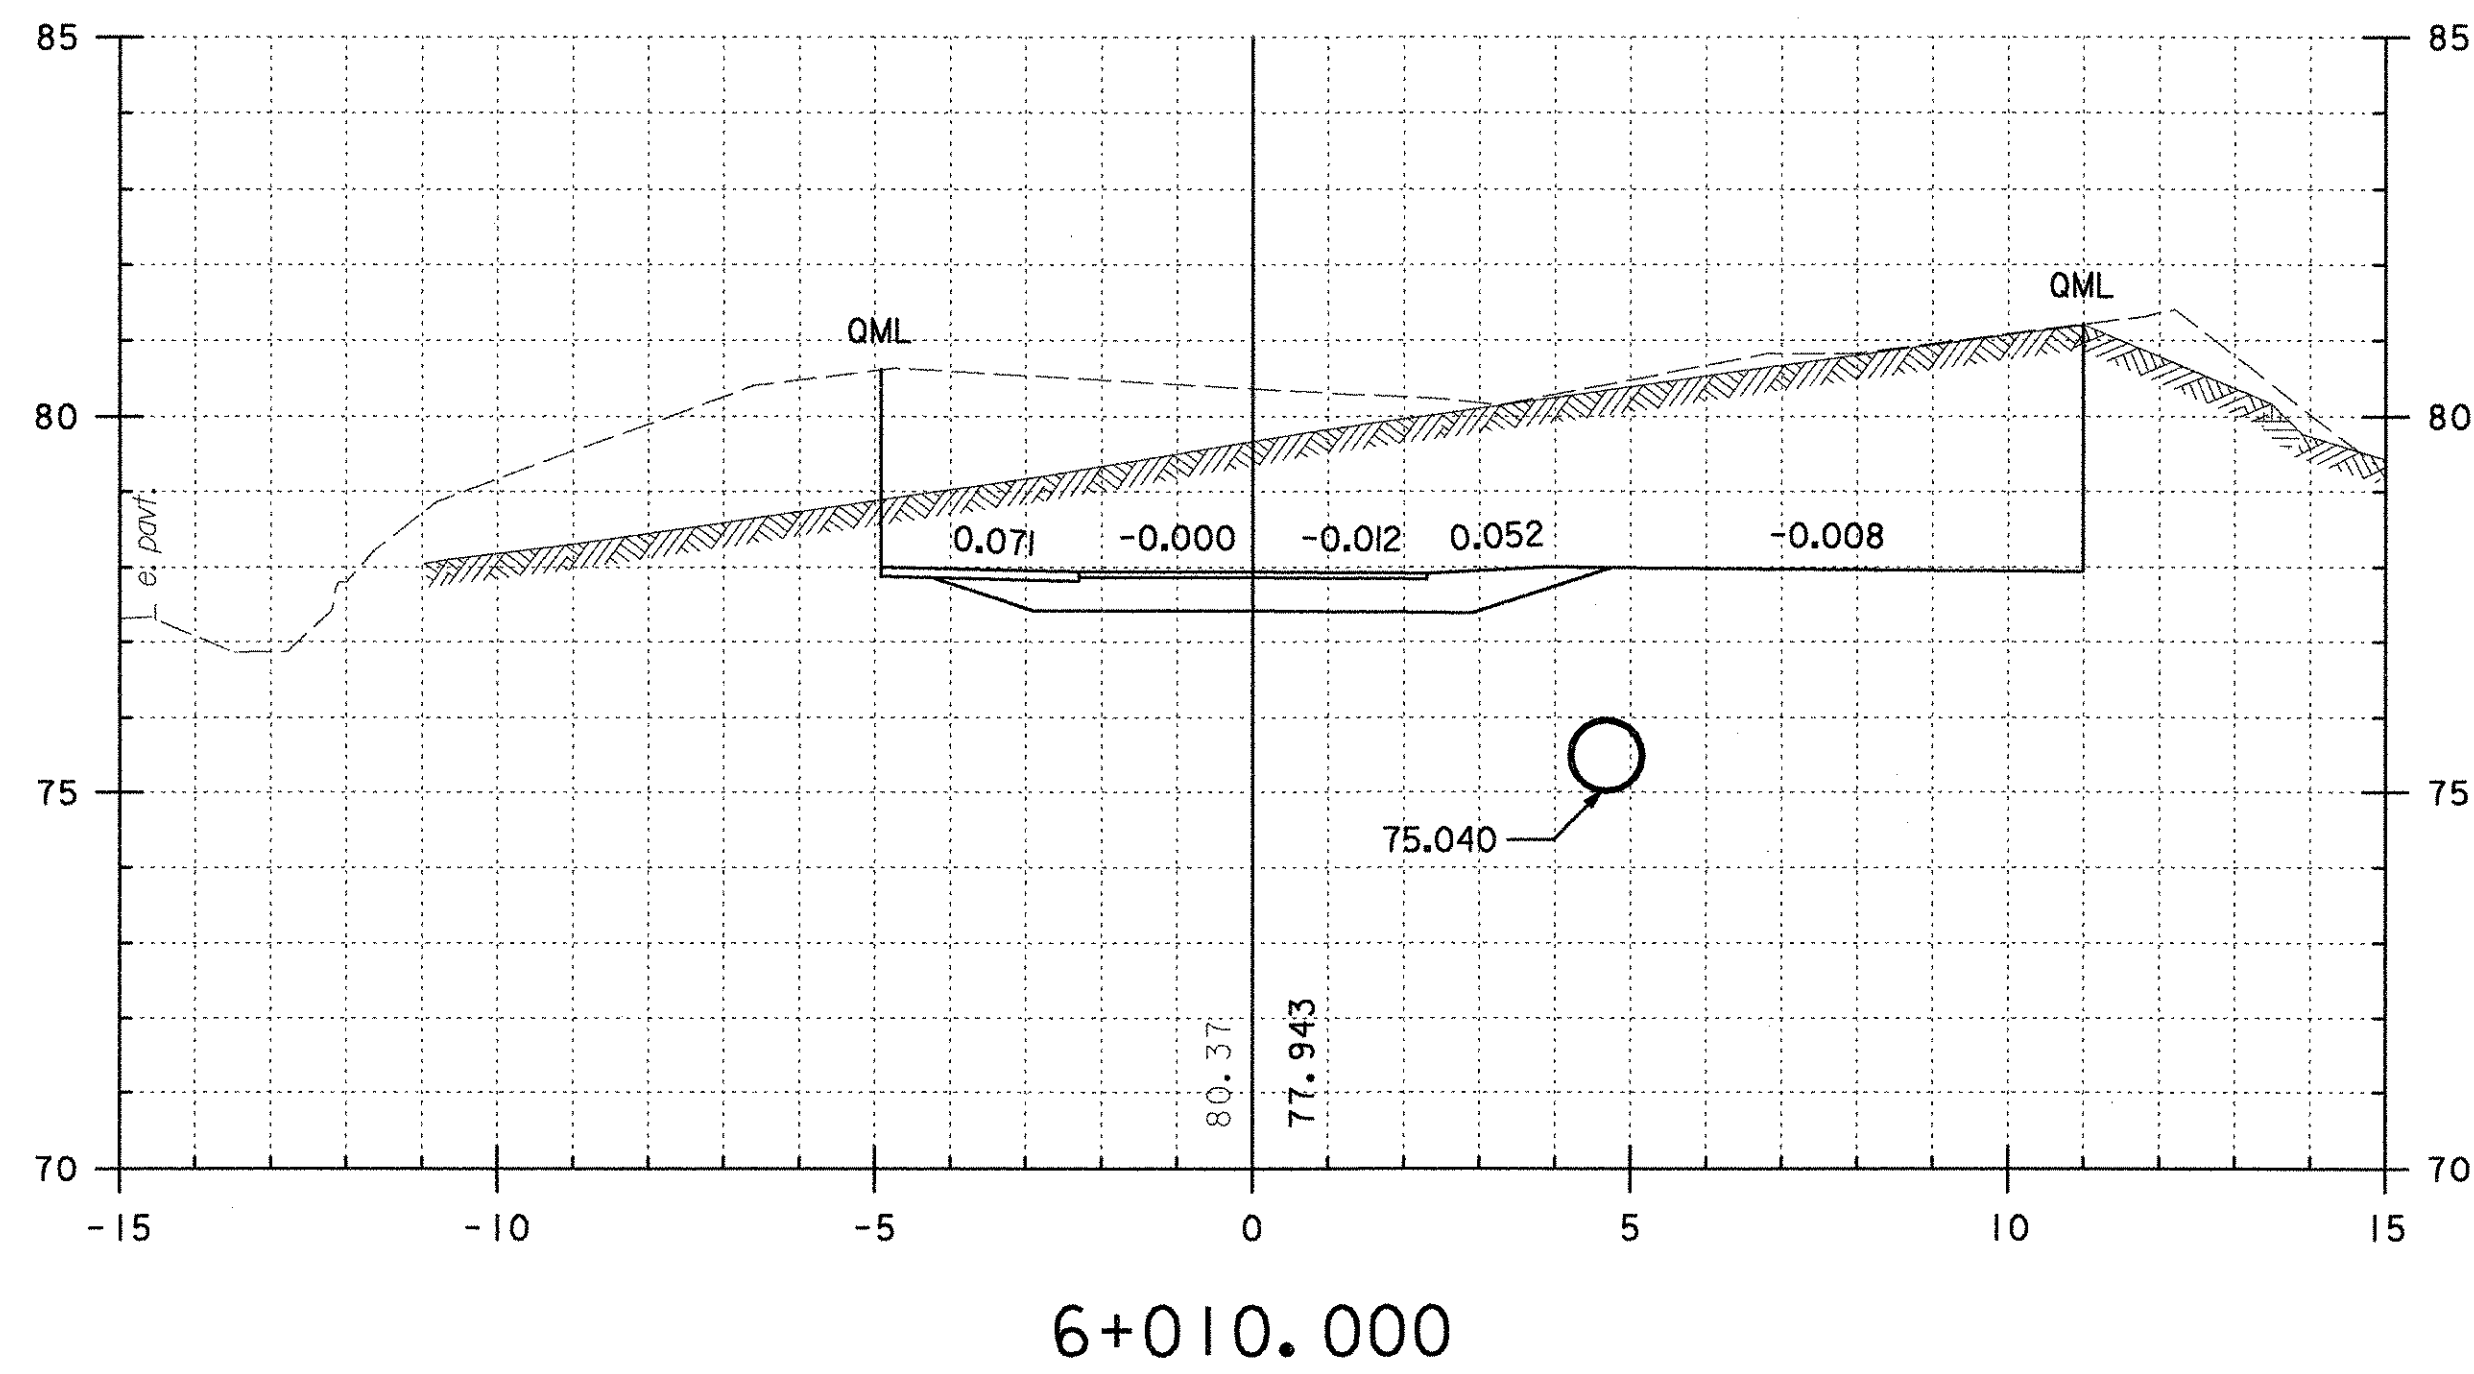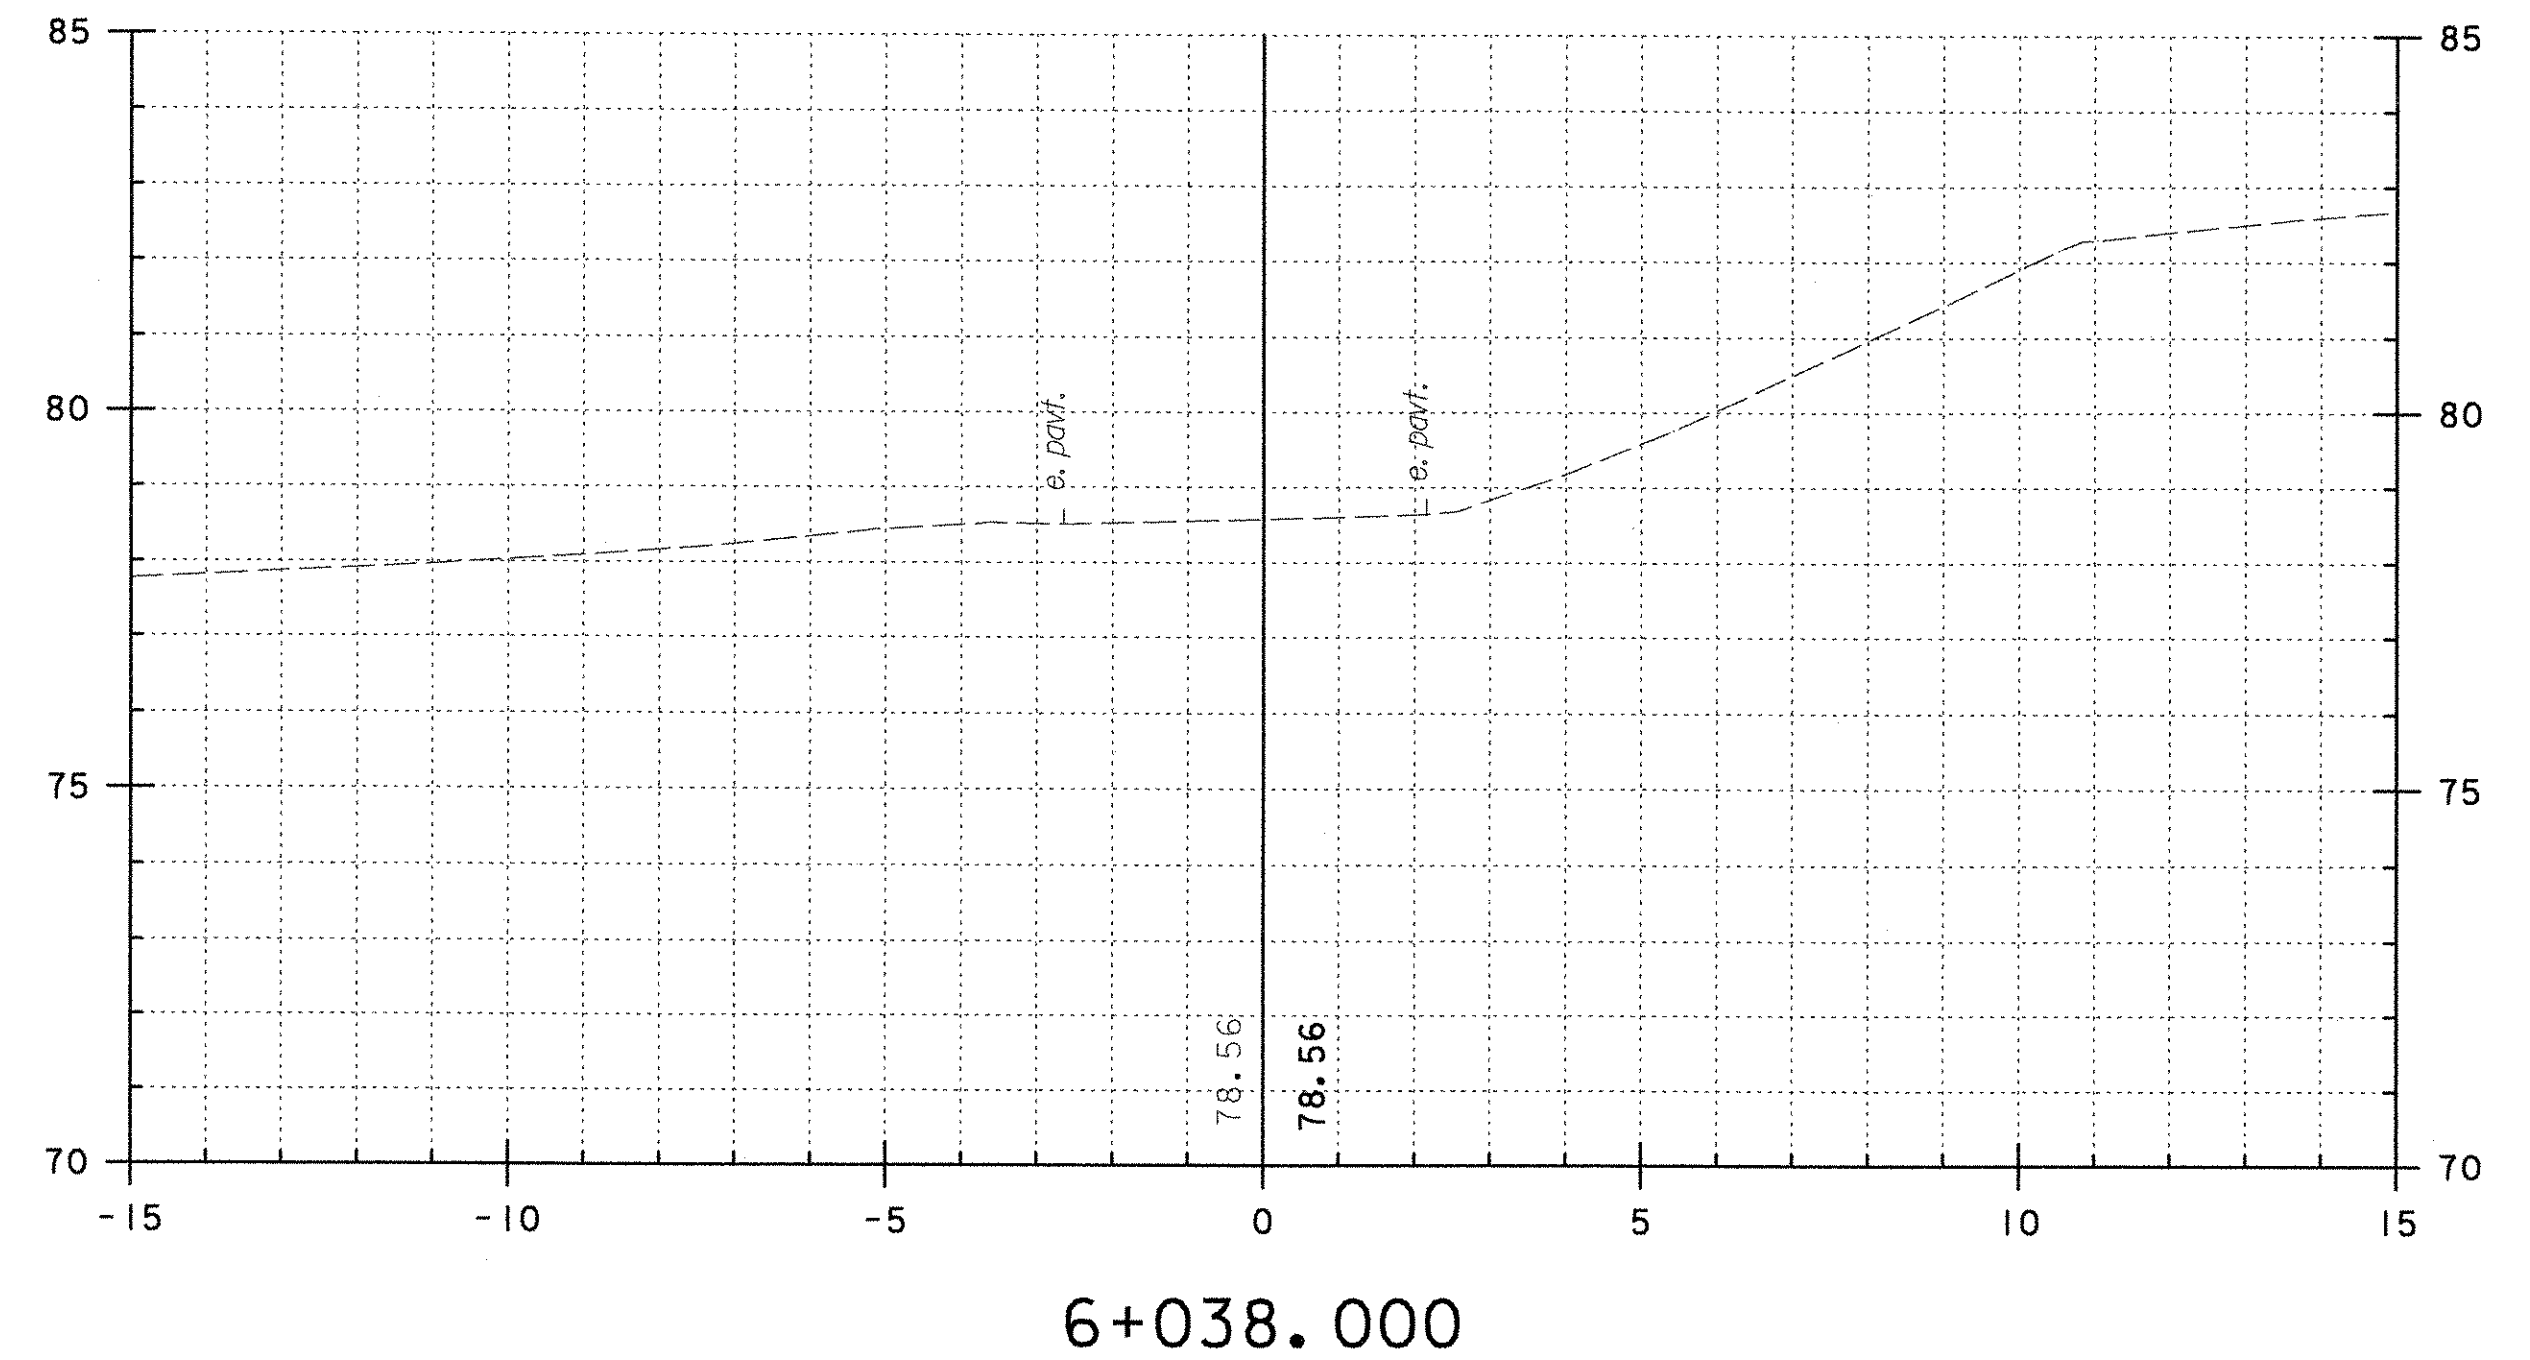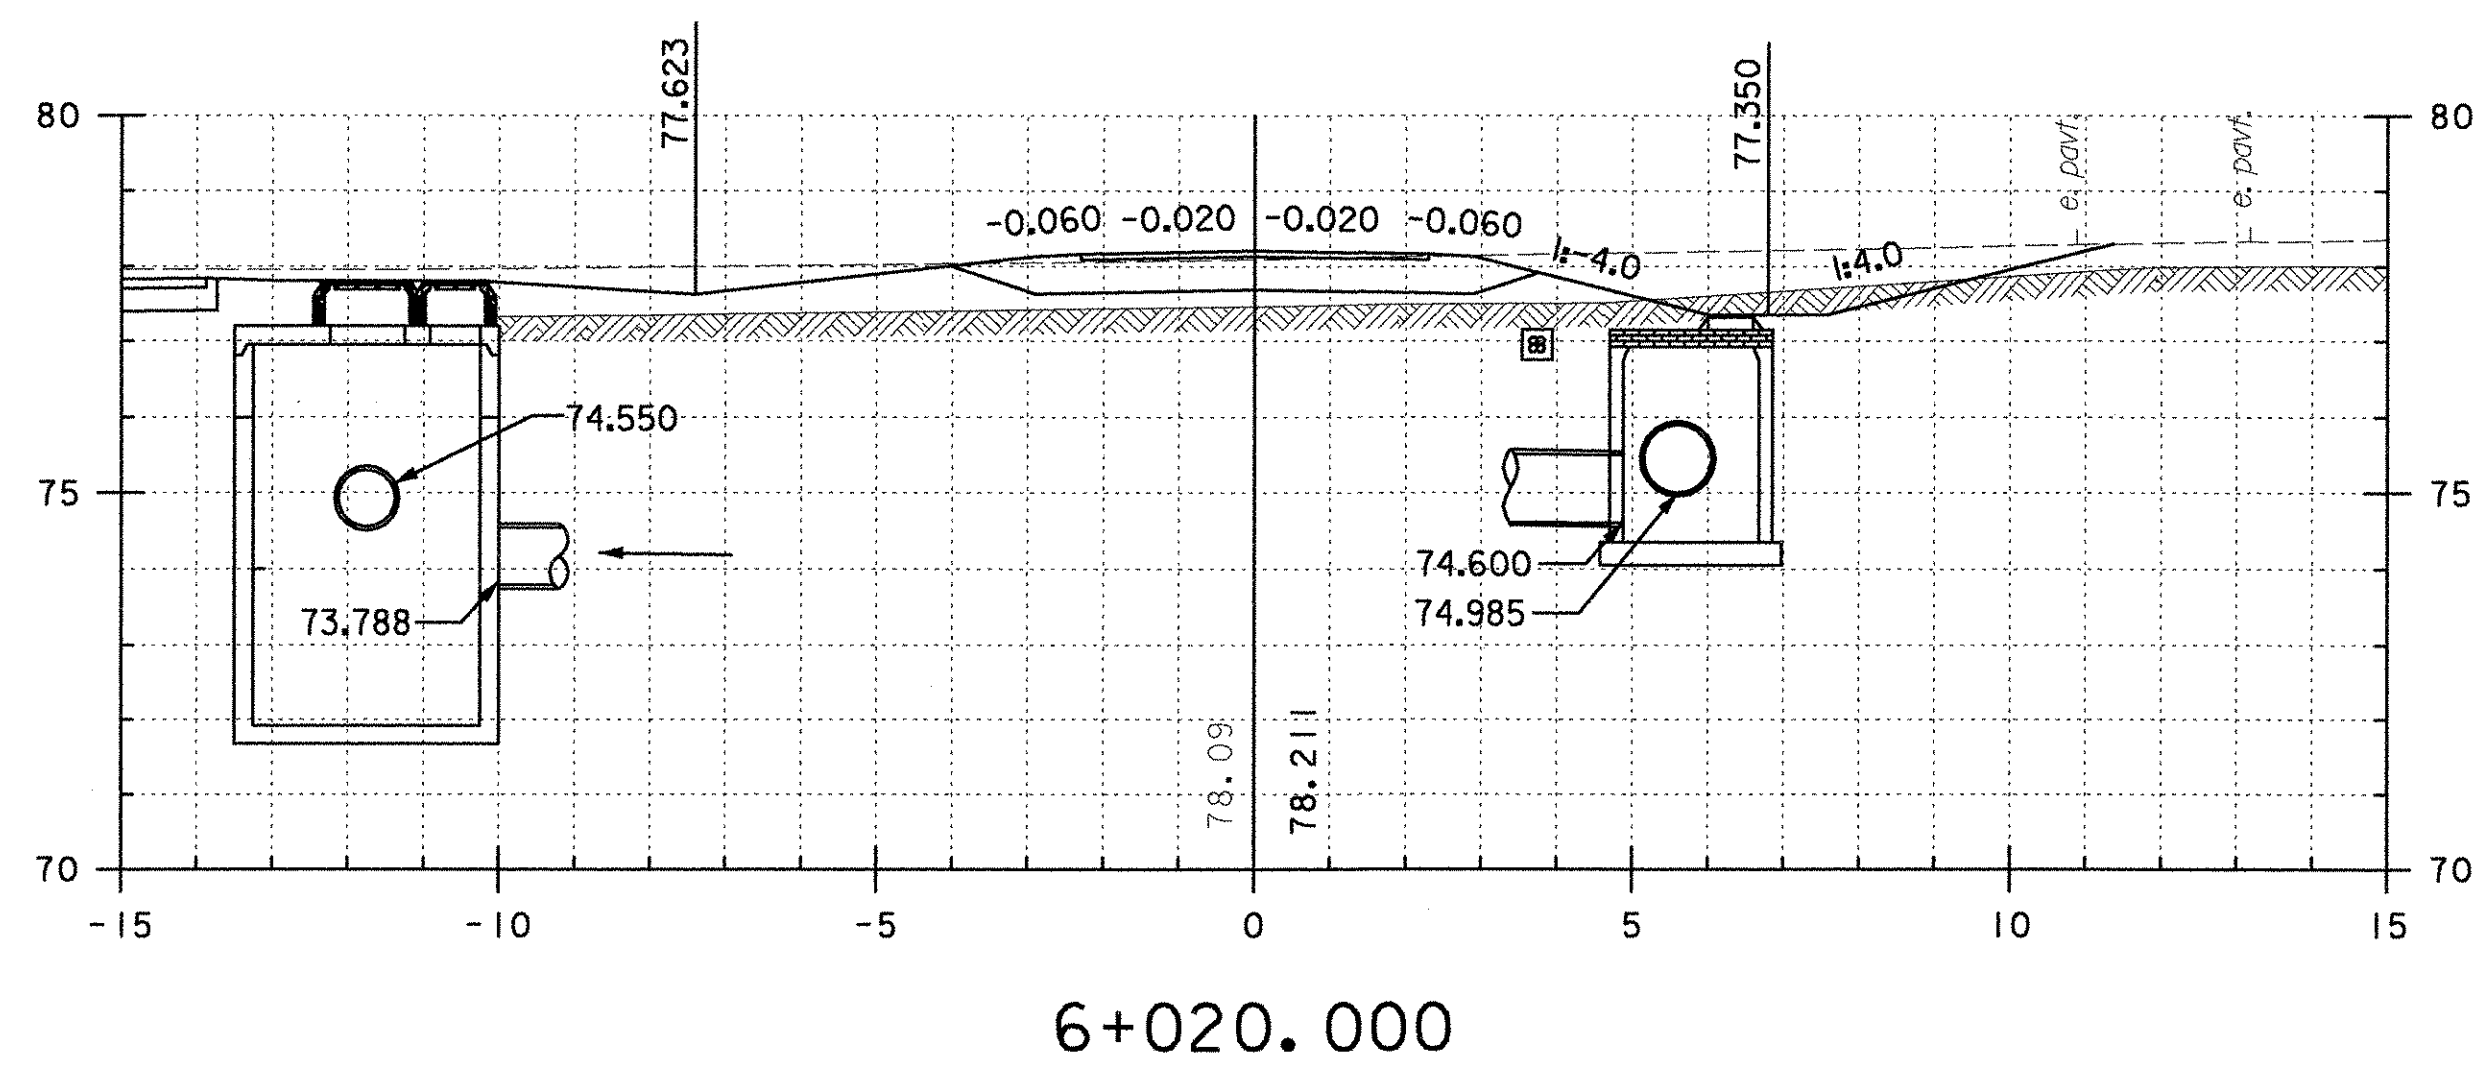


PROJECT: BRATTLEBORO	PROJECT NO. : NH 010-2(2)
DESIGN FILE NAME: ...zb270xs2.dgn	PLOT DATE: 09/23/2002
IPARM FILE NAME:	DRIVEWAY STA 30+330 RT
FROM STA: 6+010.000	TO STA: 6+038.000
SHEET: 115 OF 145	

RAILROAD CROSS SECTIONS

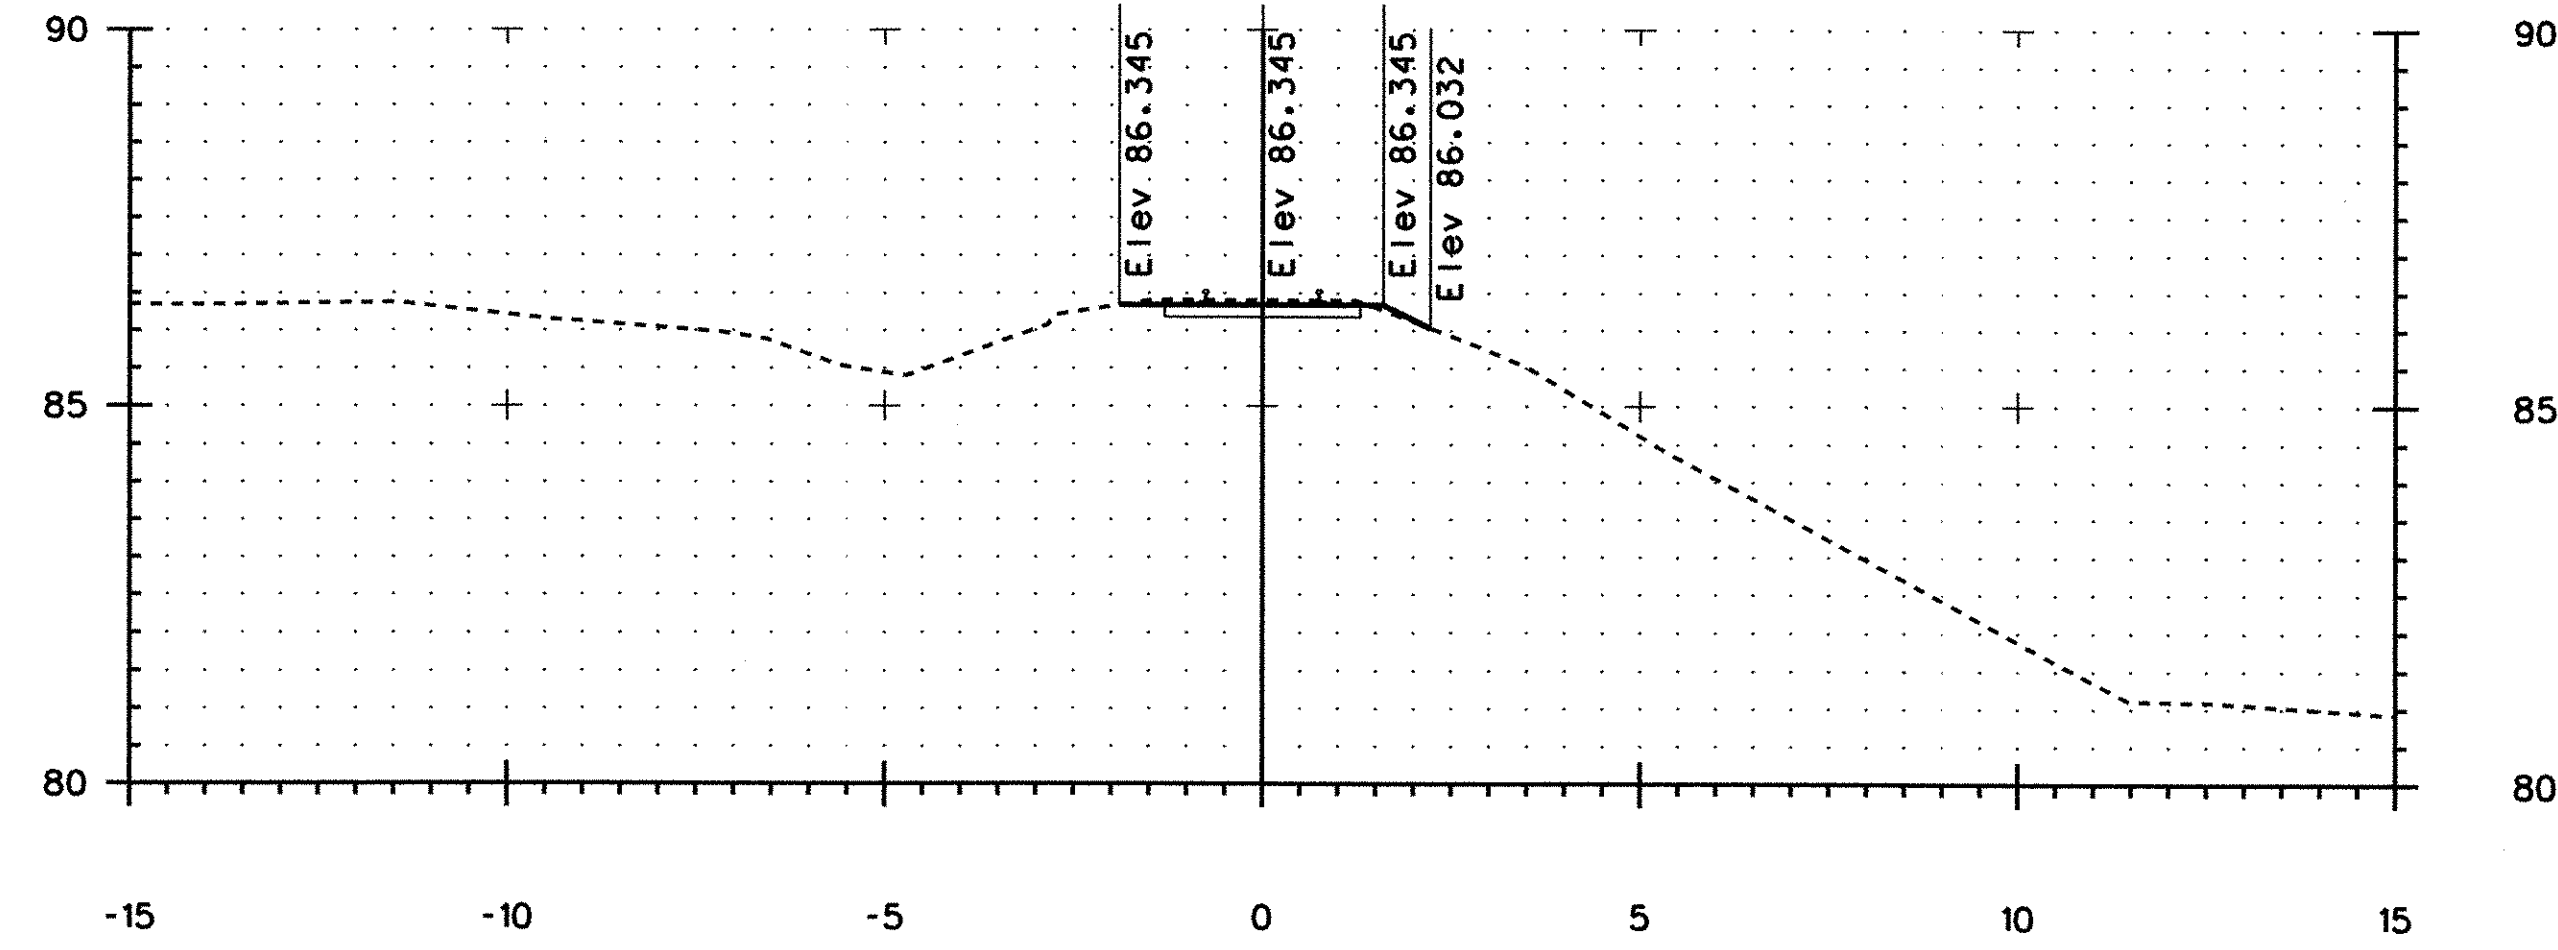


50+020.000

BEGINNING OF RAILROAD CONSTRUCTION
 MEET EXISTING AT STA. 50+020.000
 BEGIN TRACK REHABILITATION

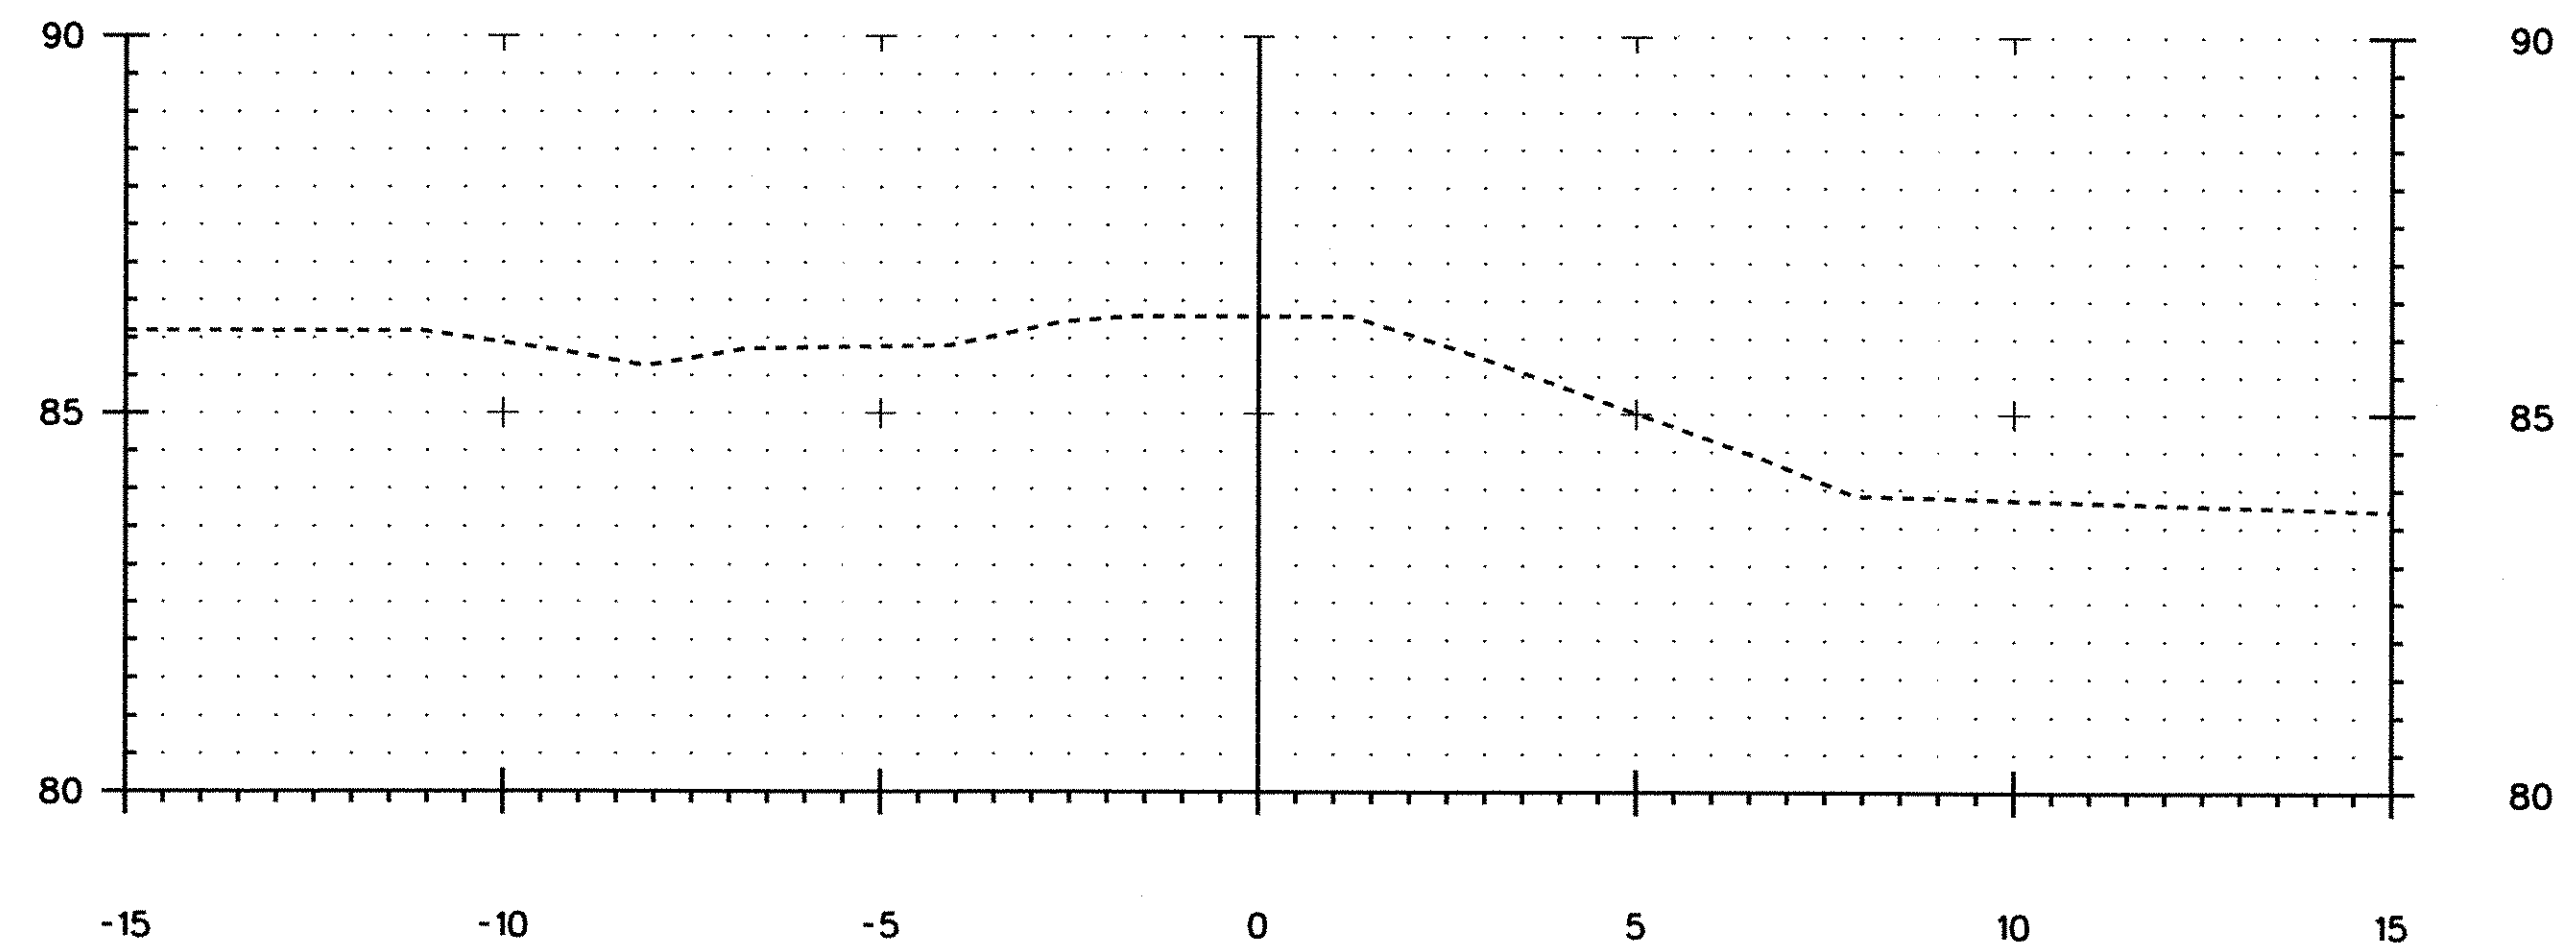


50+000.000

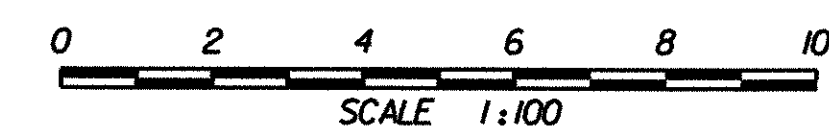


PROJECT:	BRATTLEBORO	PROJECT NO.:	NH 010-2(2)
DESIGN FILE NAME:	U:\99123-Brattleboro\dgn\zb270xs1.dgn		
IPARM FILE NAME:	PLOT DATE: 10-02-2002		
FROM STA: 50+000.000 TO STA: 50+020.000 SHEET: 116 OF 145			

RAILROAD CROSS SECTIONS

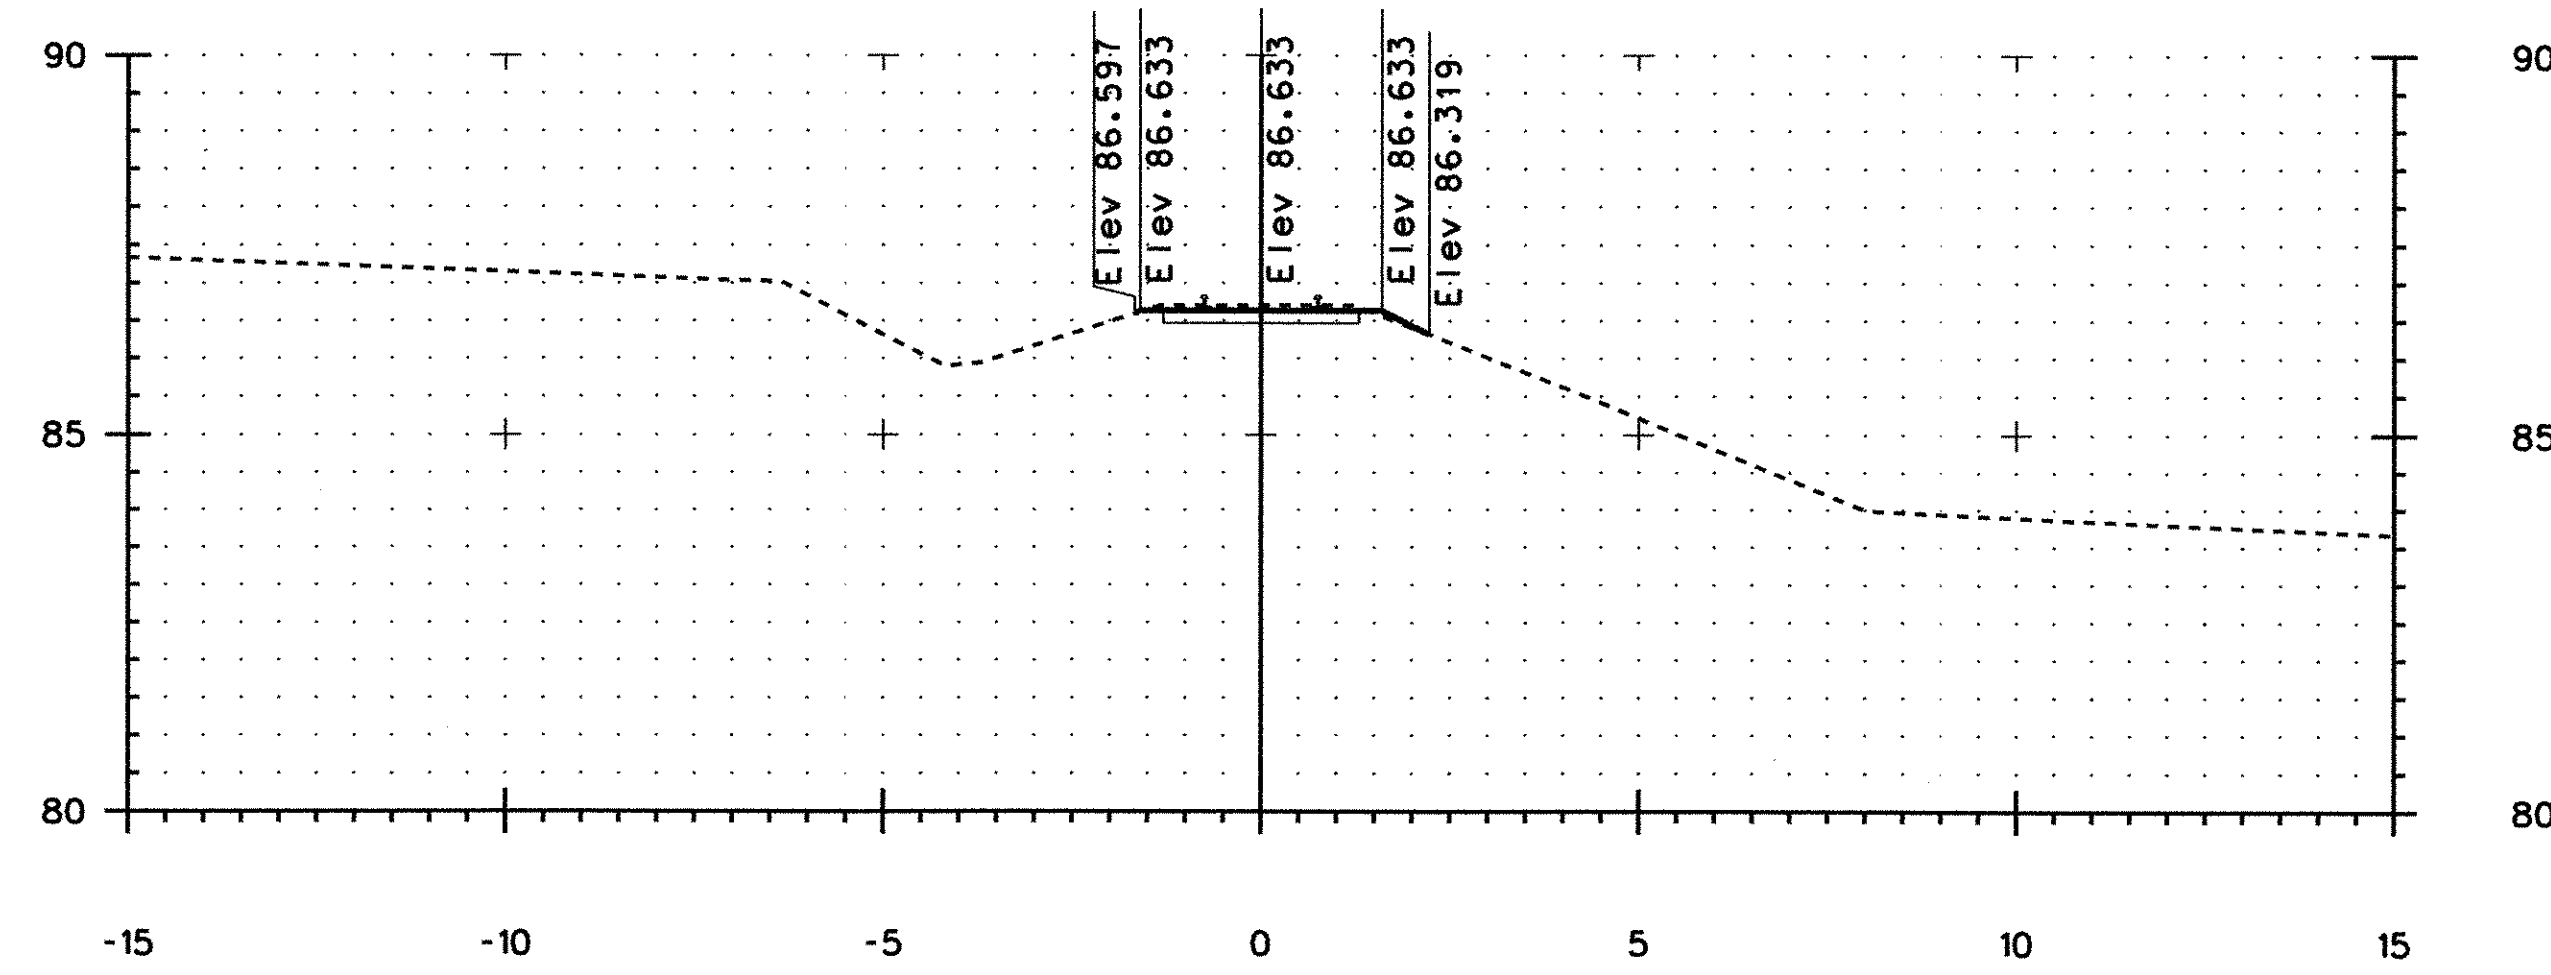

50+060.000

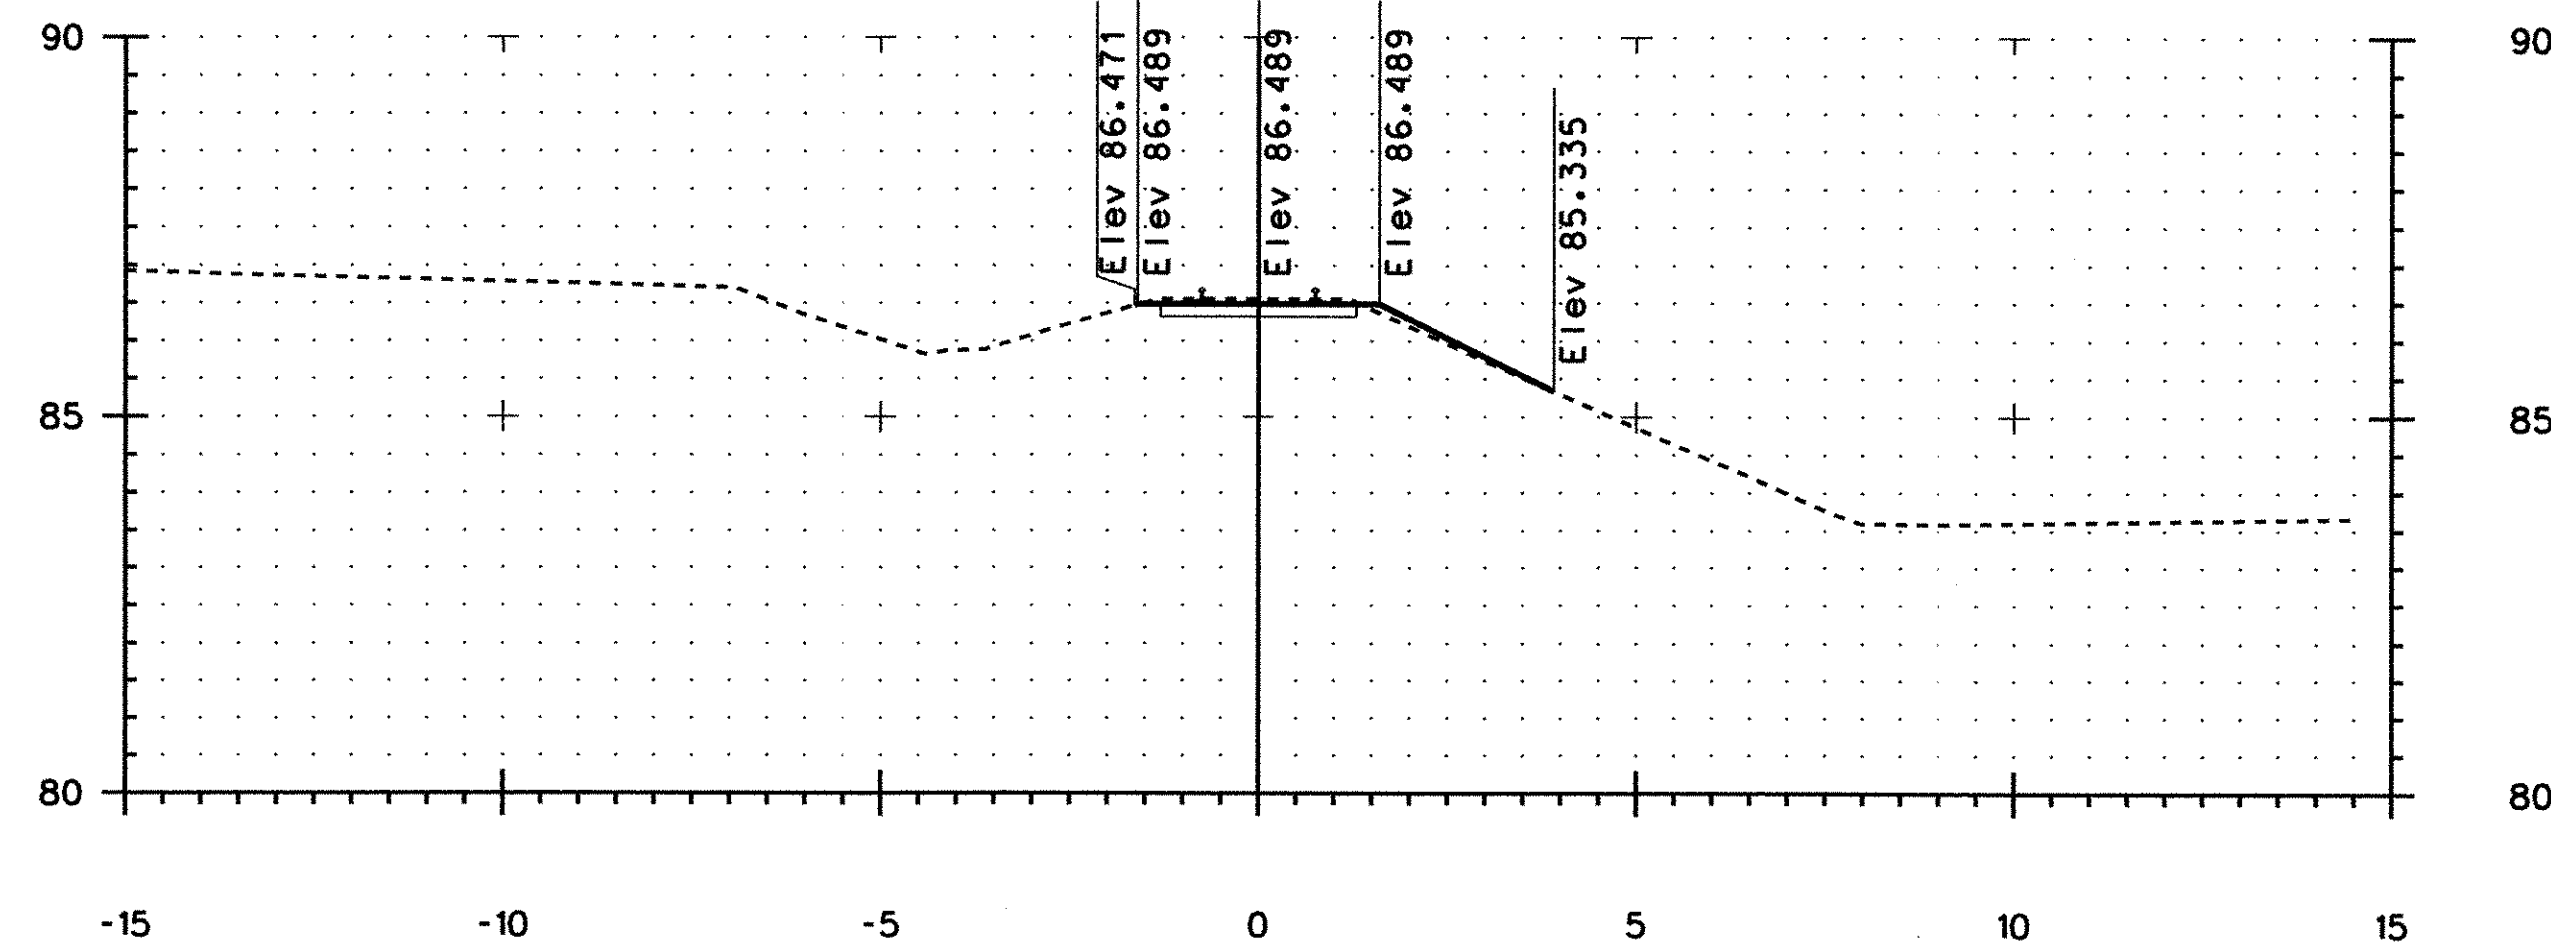


50+040.000




PROJECT:	BRATTLEBORO	PROJECT NO.:	NH 010-2(2)
DESIGN FILE NAME:	U:\99123-Brattleboro\dgn\zb270xs1.dgn		
IPARM FILE NAME:	PLOT DATE: 10-02-2002		
FROM STA: 50-040.000 TO STA: 50-060.000 SHEET: 117 OF 145			


RAILROAD CROSS SECTIONS

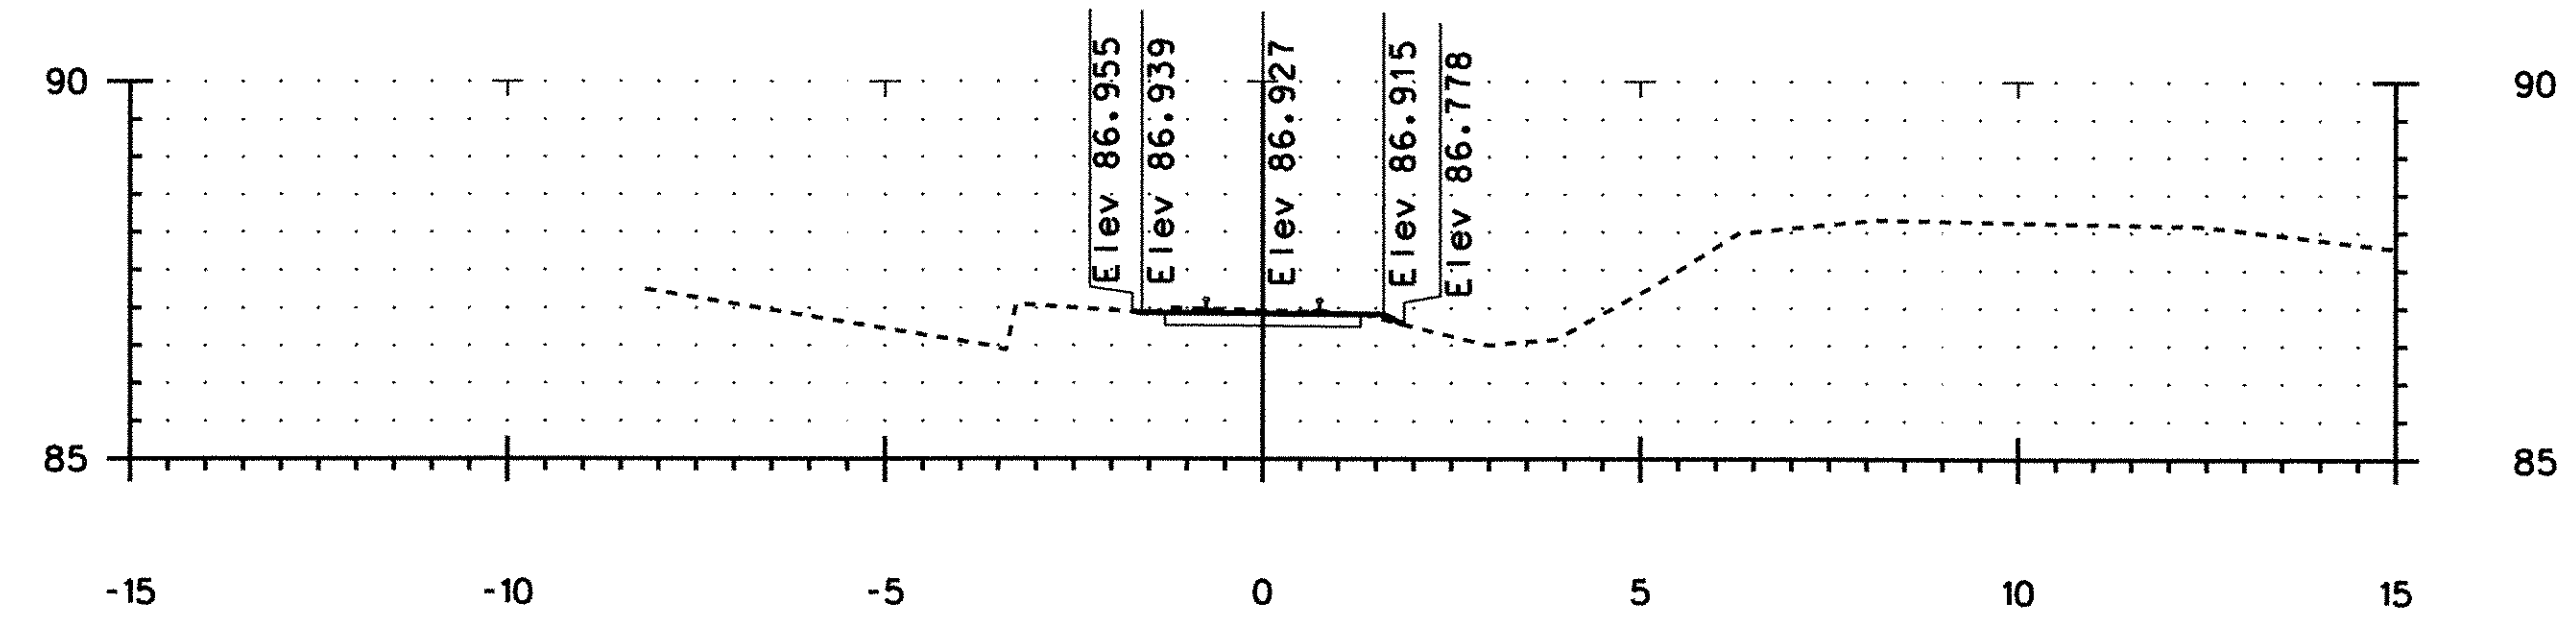

50+100.000

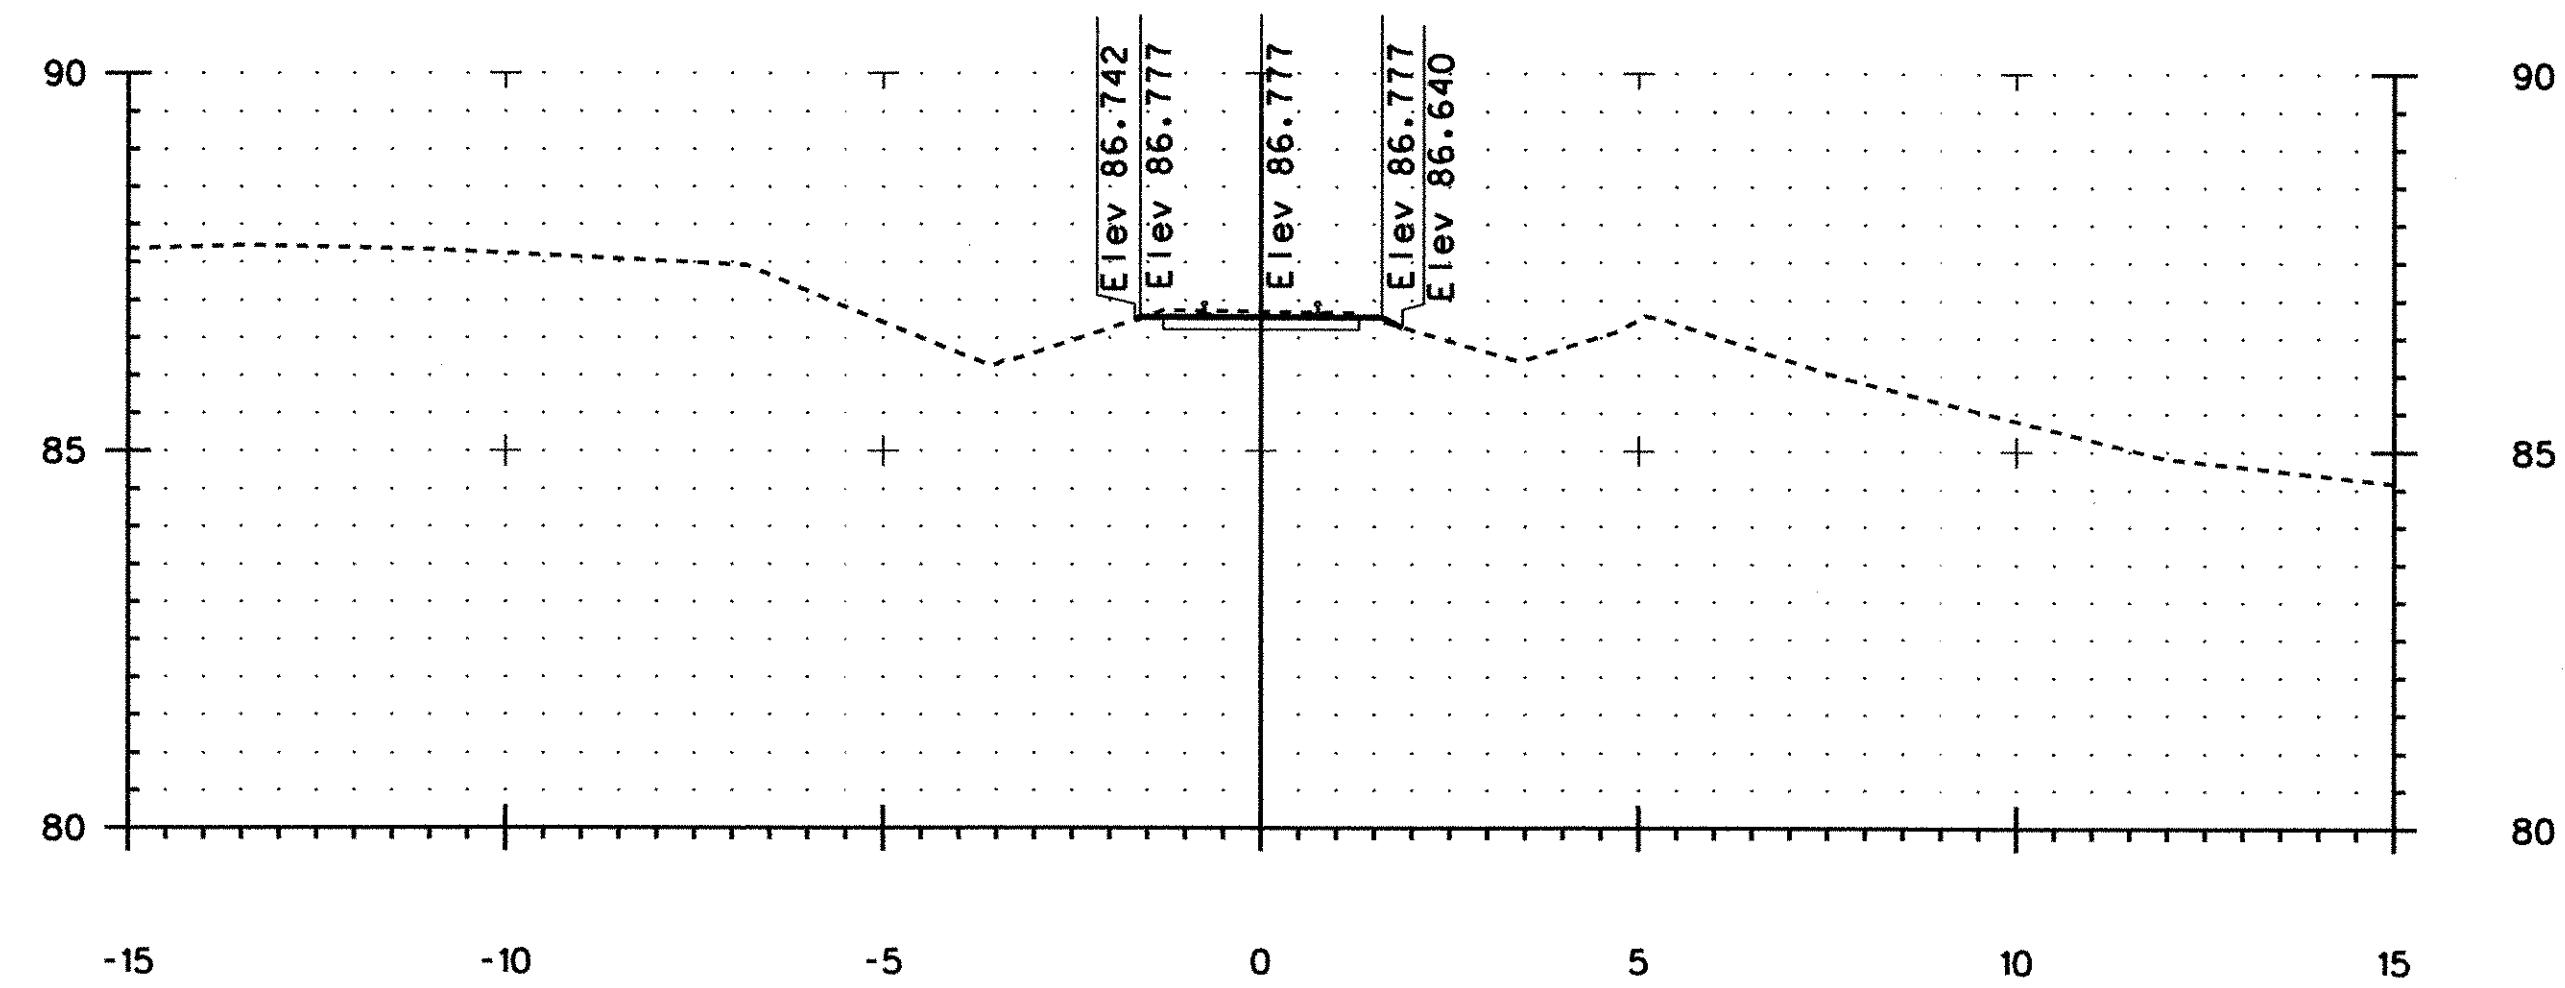


50+080.000

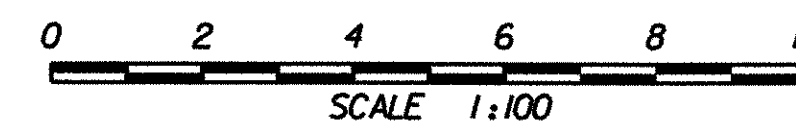


PROJECT:	BRATTLEBORO	PROJECT NO.:	NH 010-2(2)
DESIGN FILE NAME:	U:\99123-Brattleboro\dgn\zb270xs1.dgn		
IPARM FILE NAME:	PLOT DATE: 10-02-2002		
FROM STA: 50+080.000 TO STA: 50+100.000 SHEET: 118 OF 145			

RAILROAD CROSS SECTIONS

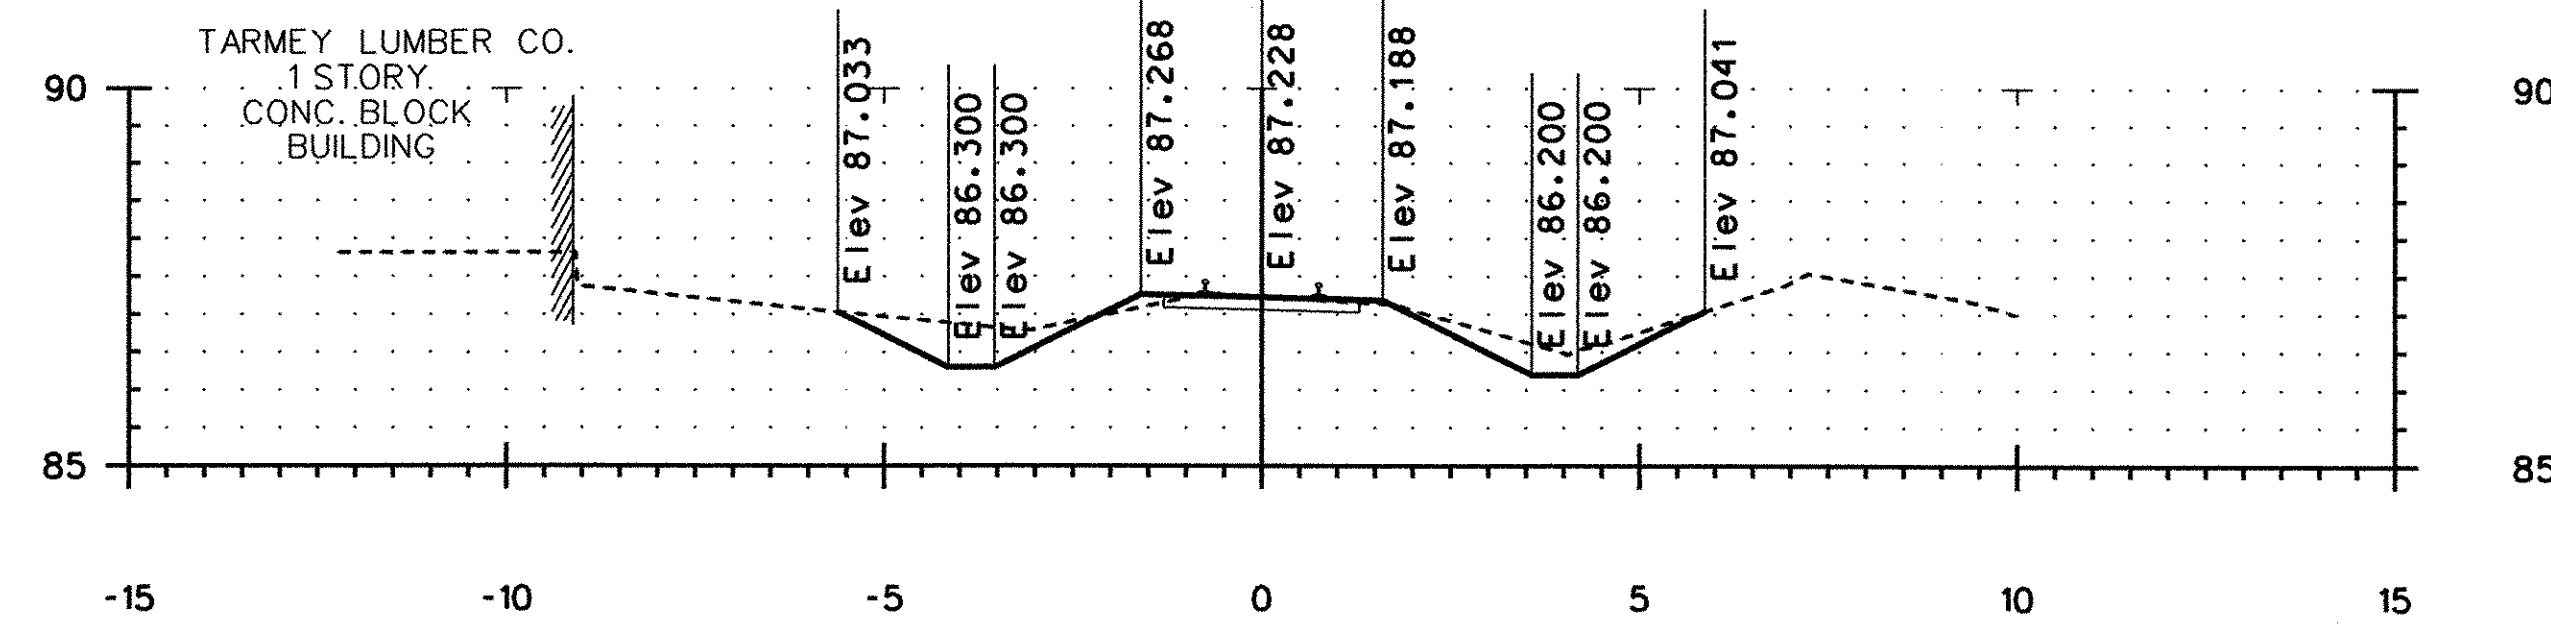


50+140.000

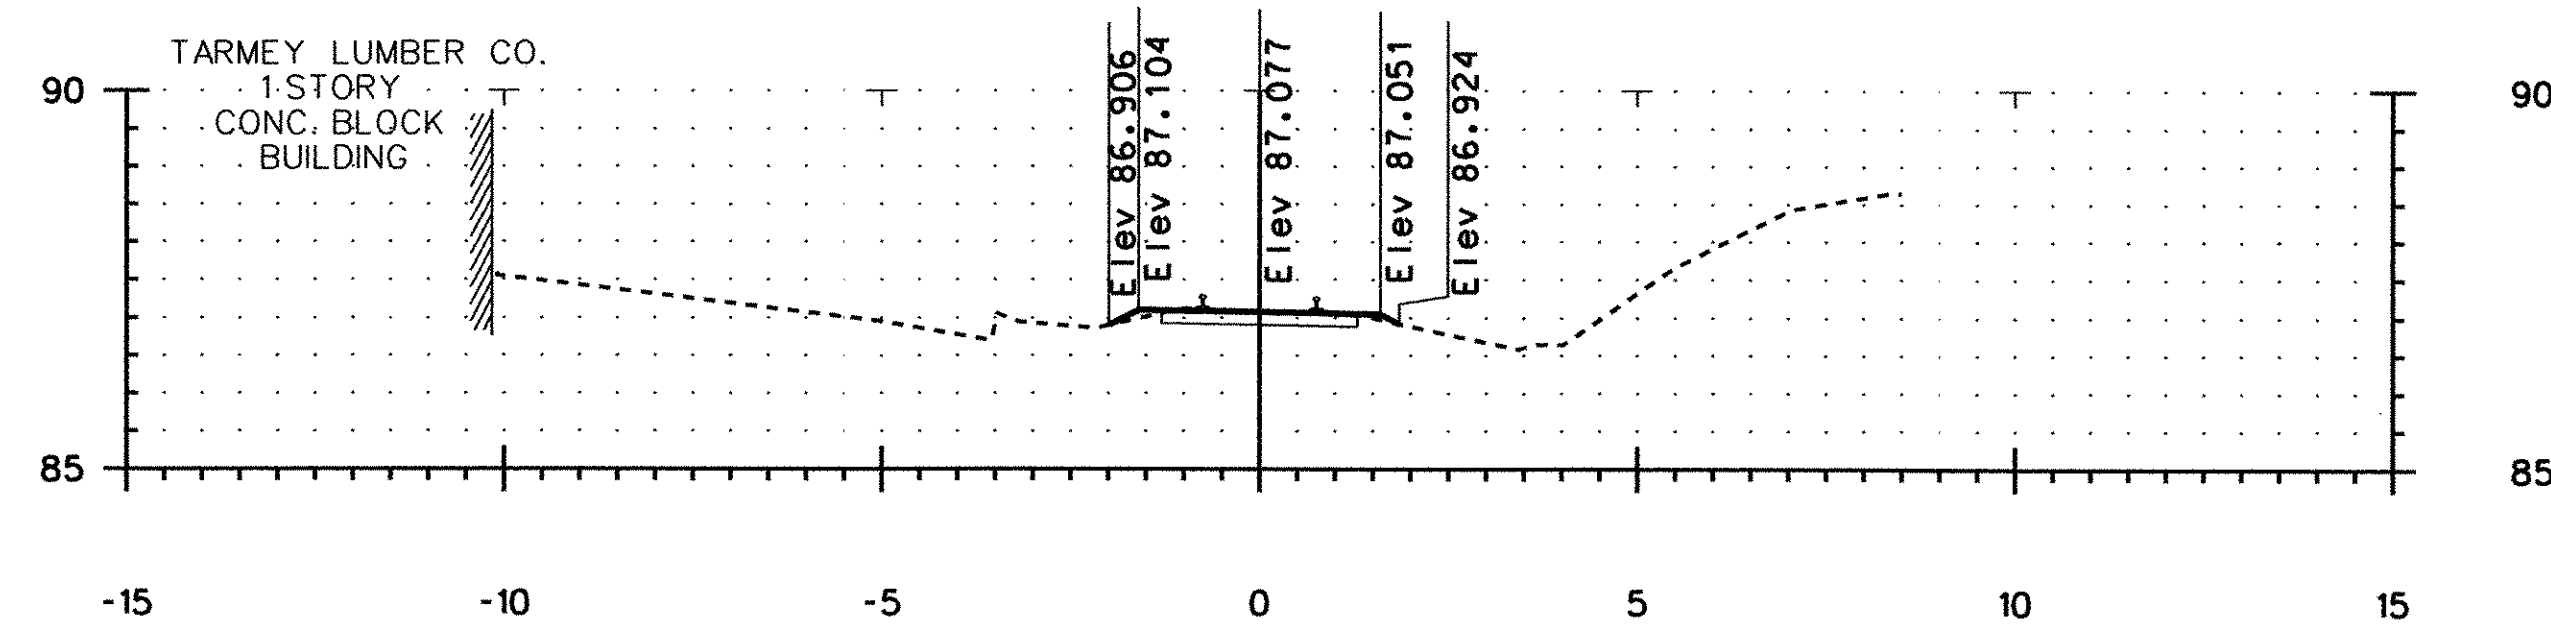


50+120.000

END TRACK REHABILITATION
BEGIN TRANSITION SECTION

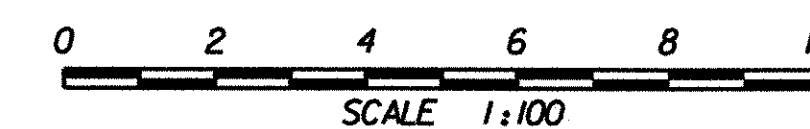


PROJECT:	BRATTLEBORO	PROJECT NO.:	NH 010-2(2)
DESIGN FILE NAME:	U:\99123-Brattleboro\dgn\zb270xs1.dgn		
IPARM FILE NAME:	PLOT DATE: 7 AUG 2000		
FROM STA: 50+120.000 TO STA: 50+140.000 SHEET: 119 OF 145			

RAILROAD CROSS SECTIONS

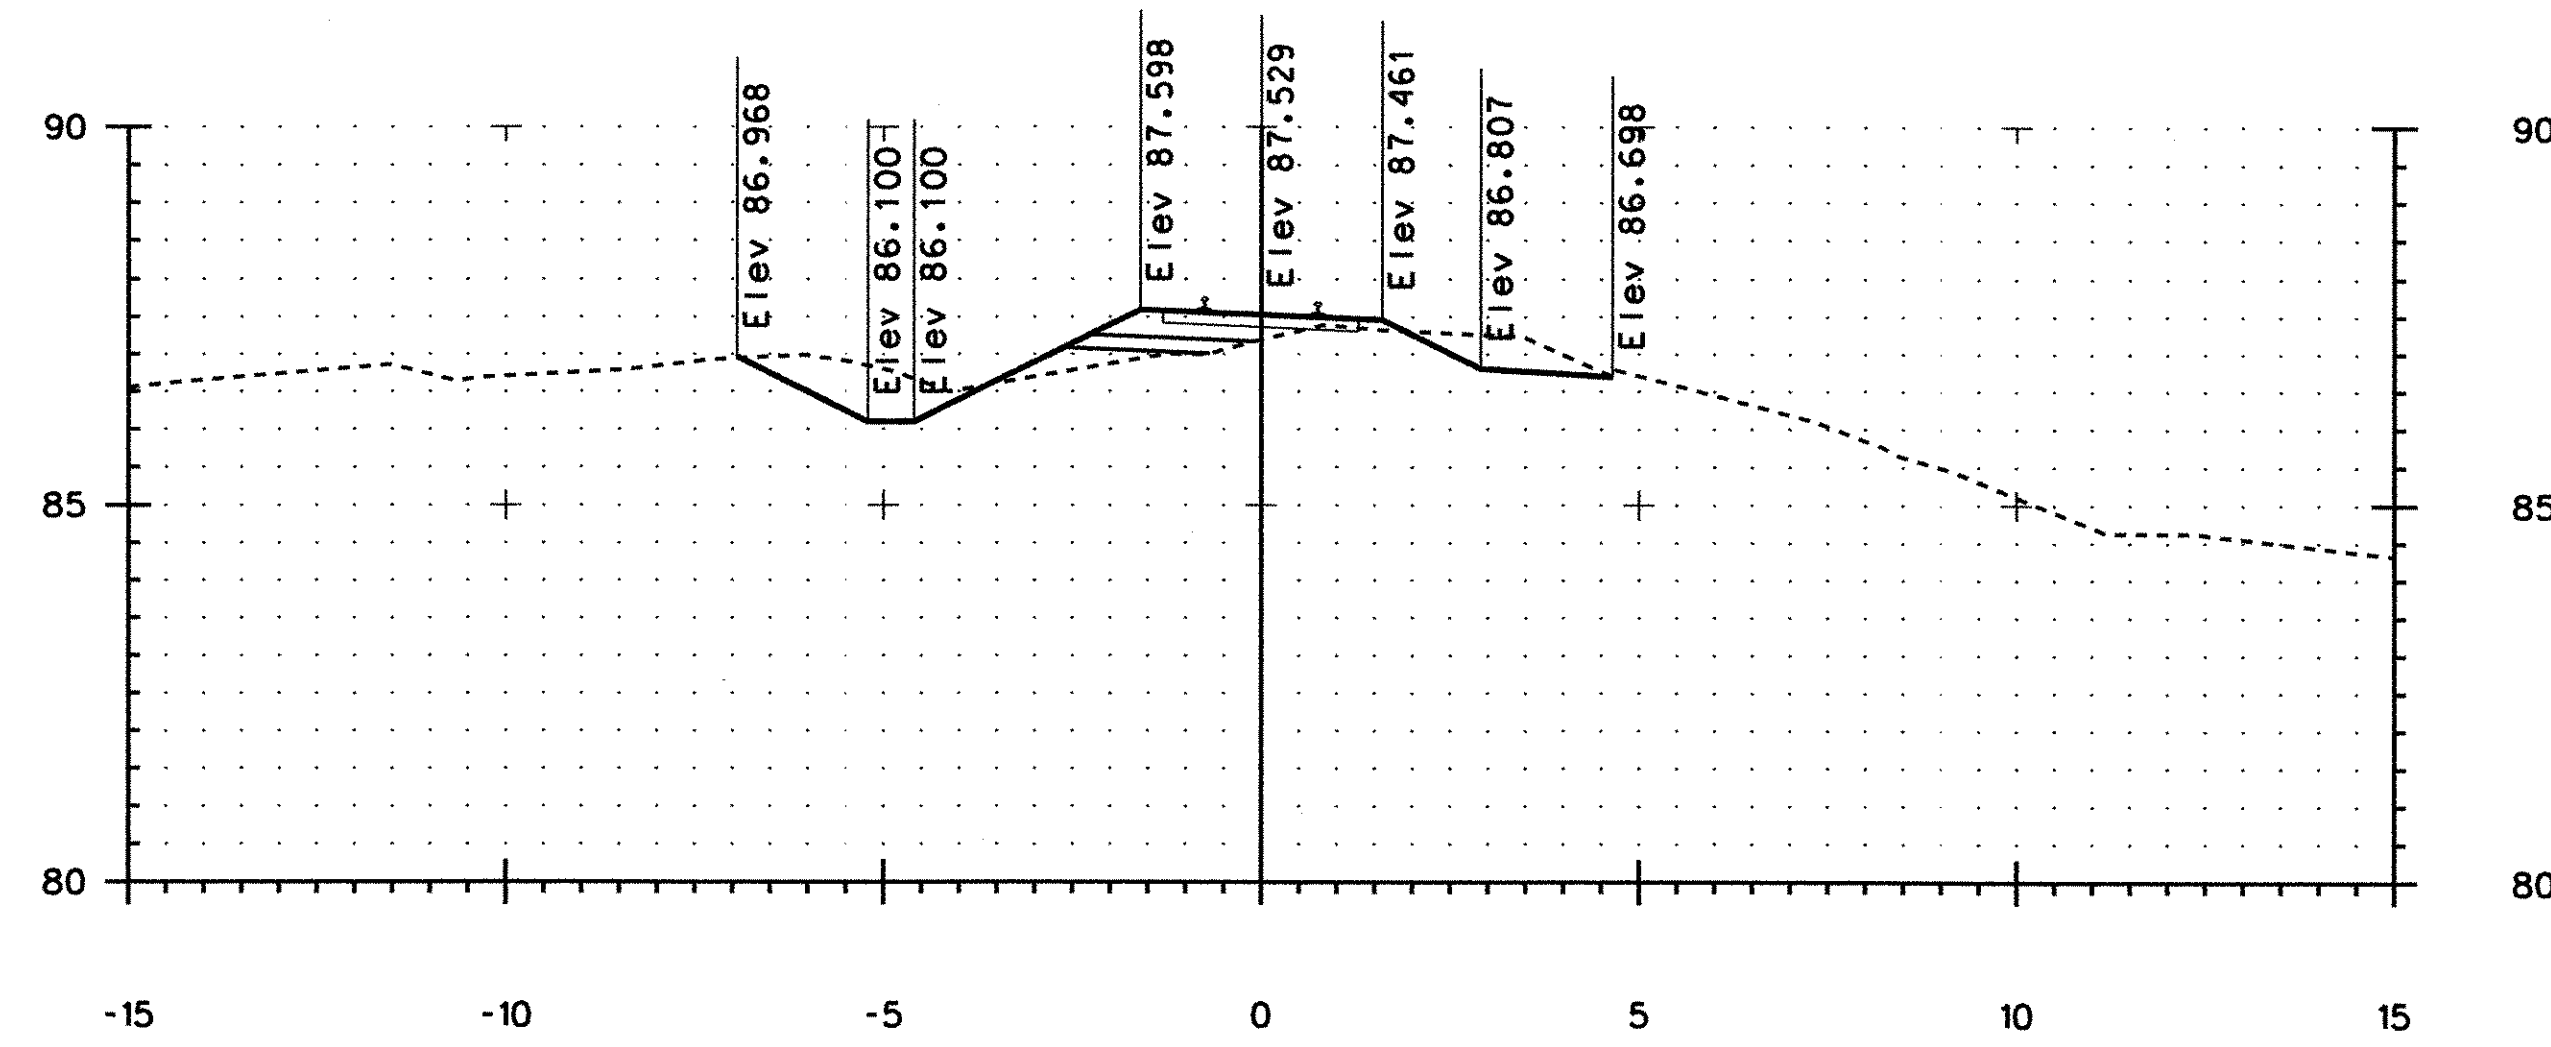

50+180.000

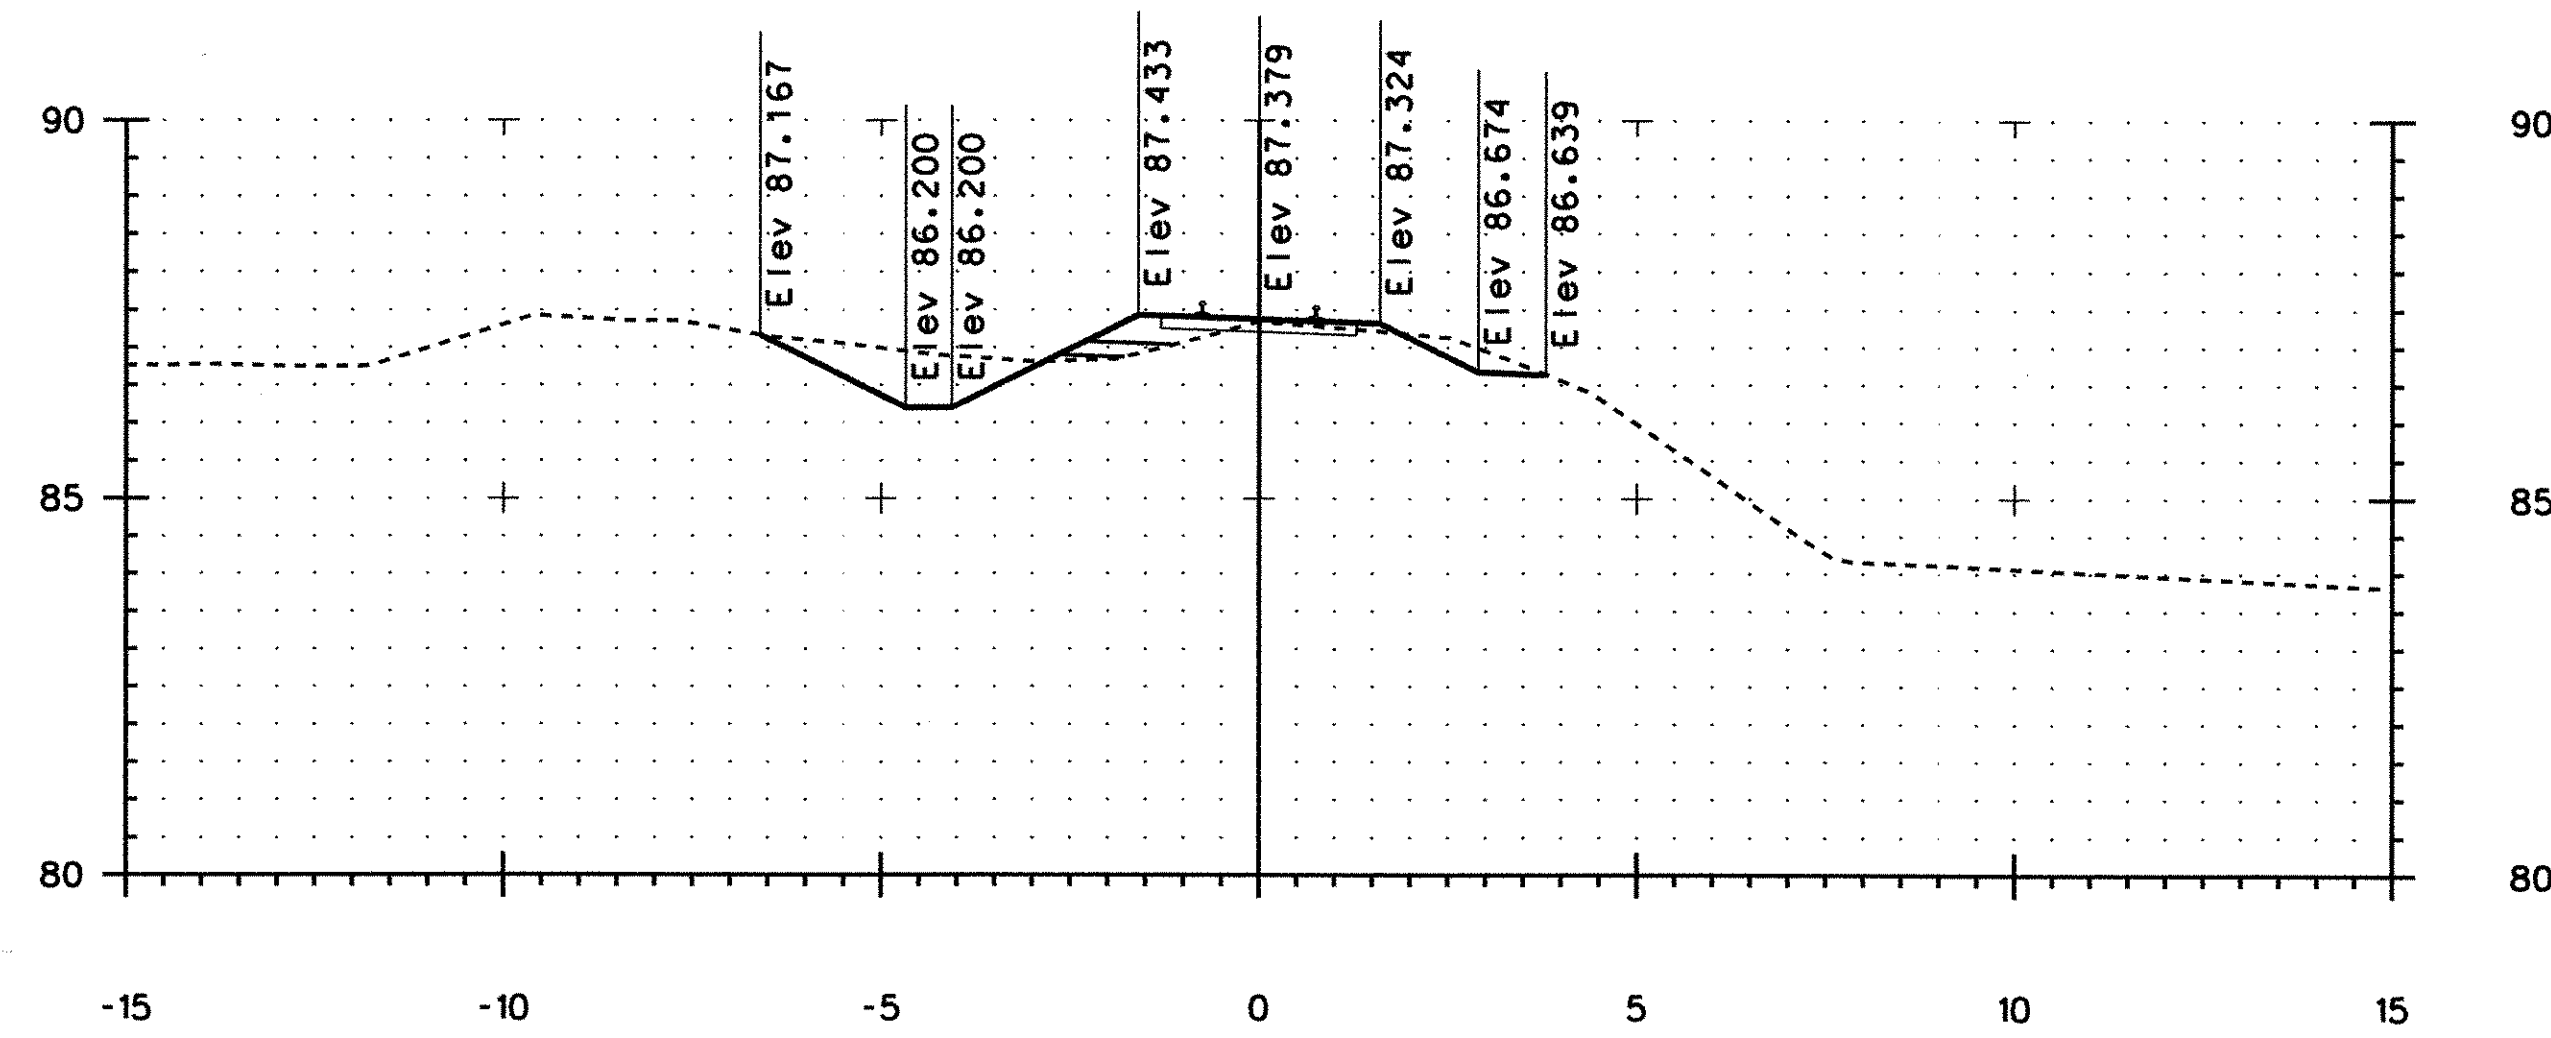


50+160.000




PROJECT:	BRATTLEBORO	PROJECT NO.:	NH 010-2(2)
DESIGN FILE NAME:	U:\99123-Brattleboro\dgn\zb270xs1.dgn		
IPARM FILE NAME:	PLOT DATE: 7 AUG 2000		
FROM STA: 50+160.000 TO STA: 50+180.000 SHEET: 120 OF 145			

RAILROAD CROSS SECTIONS

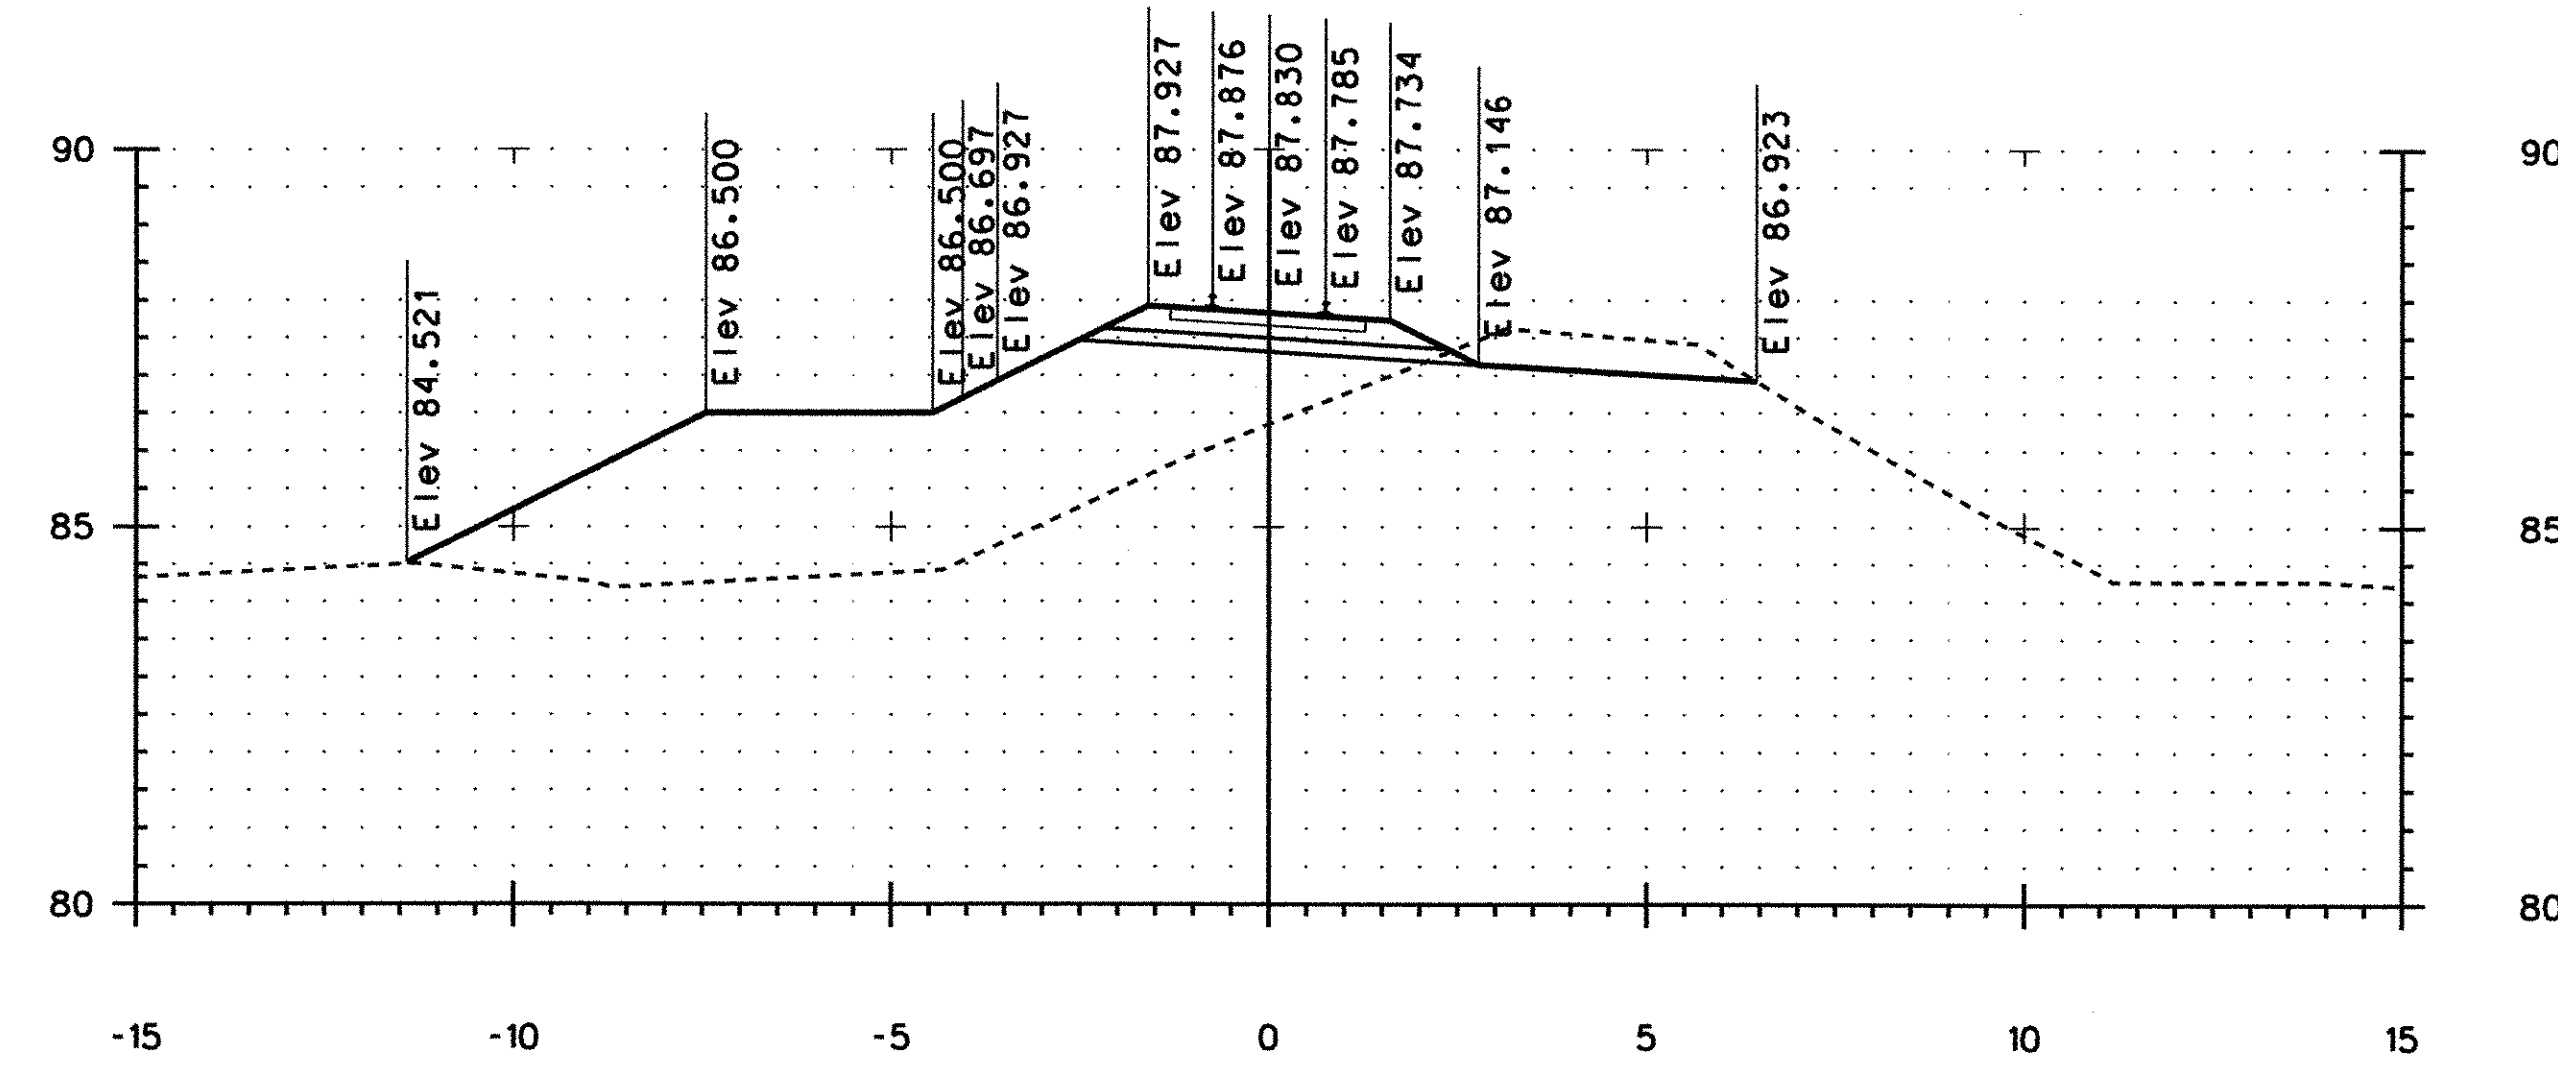

50+220.000

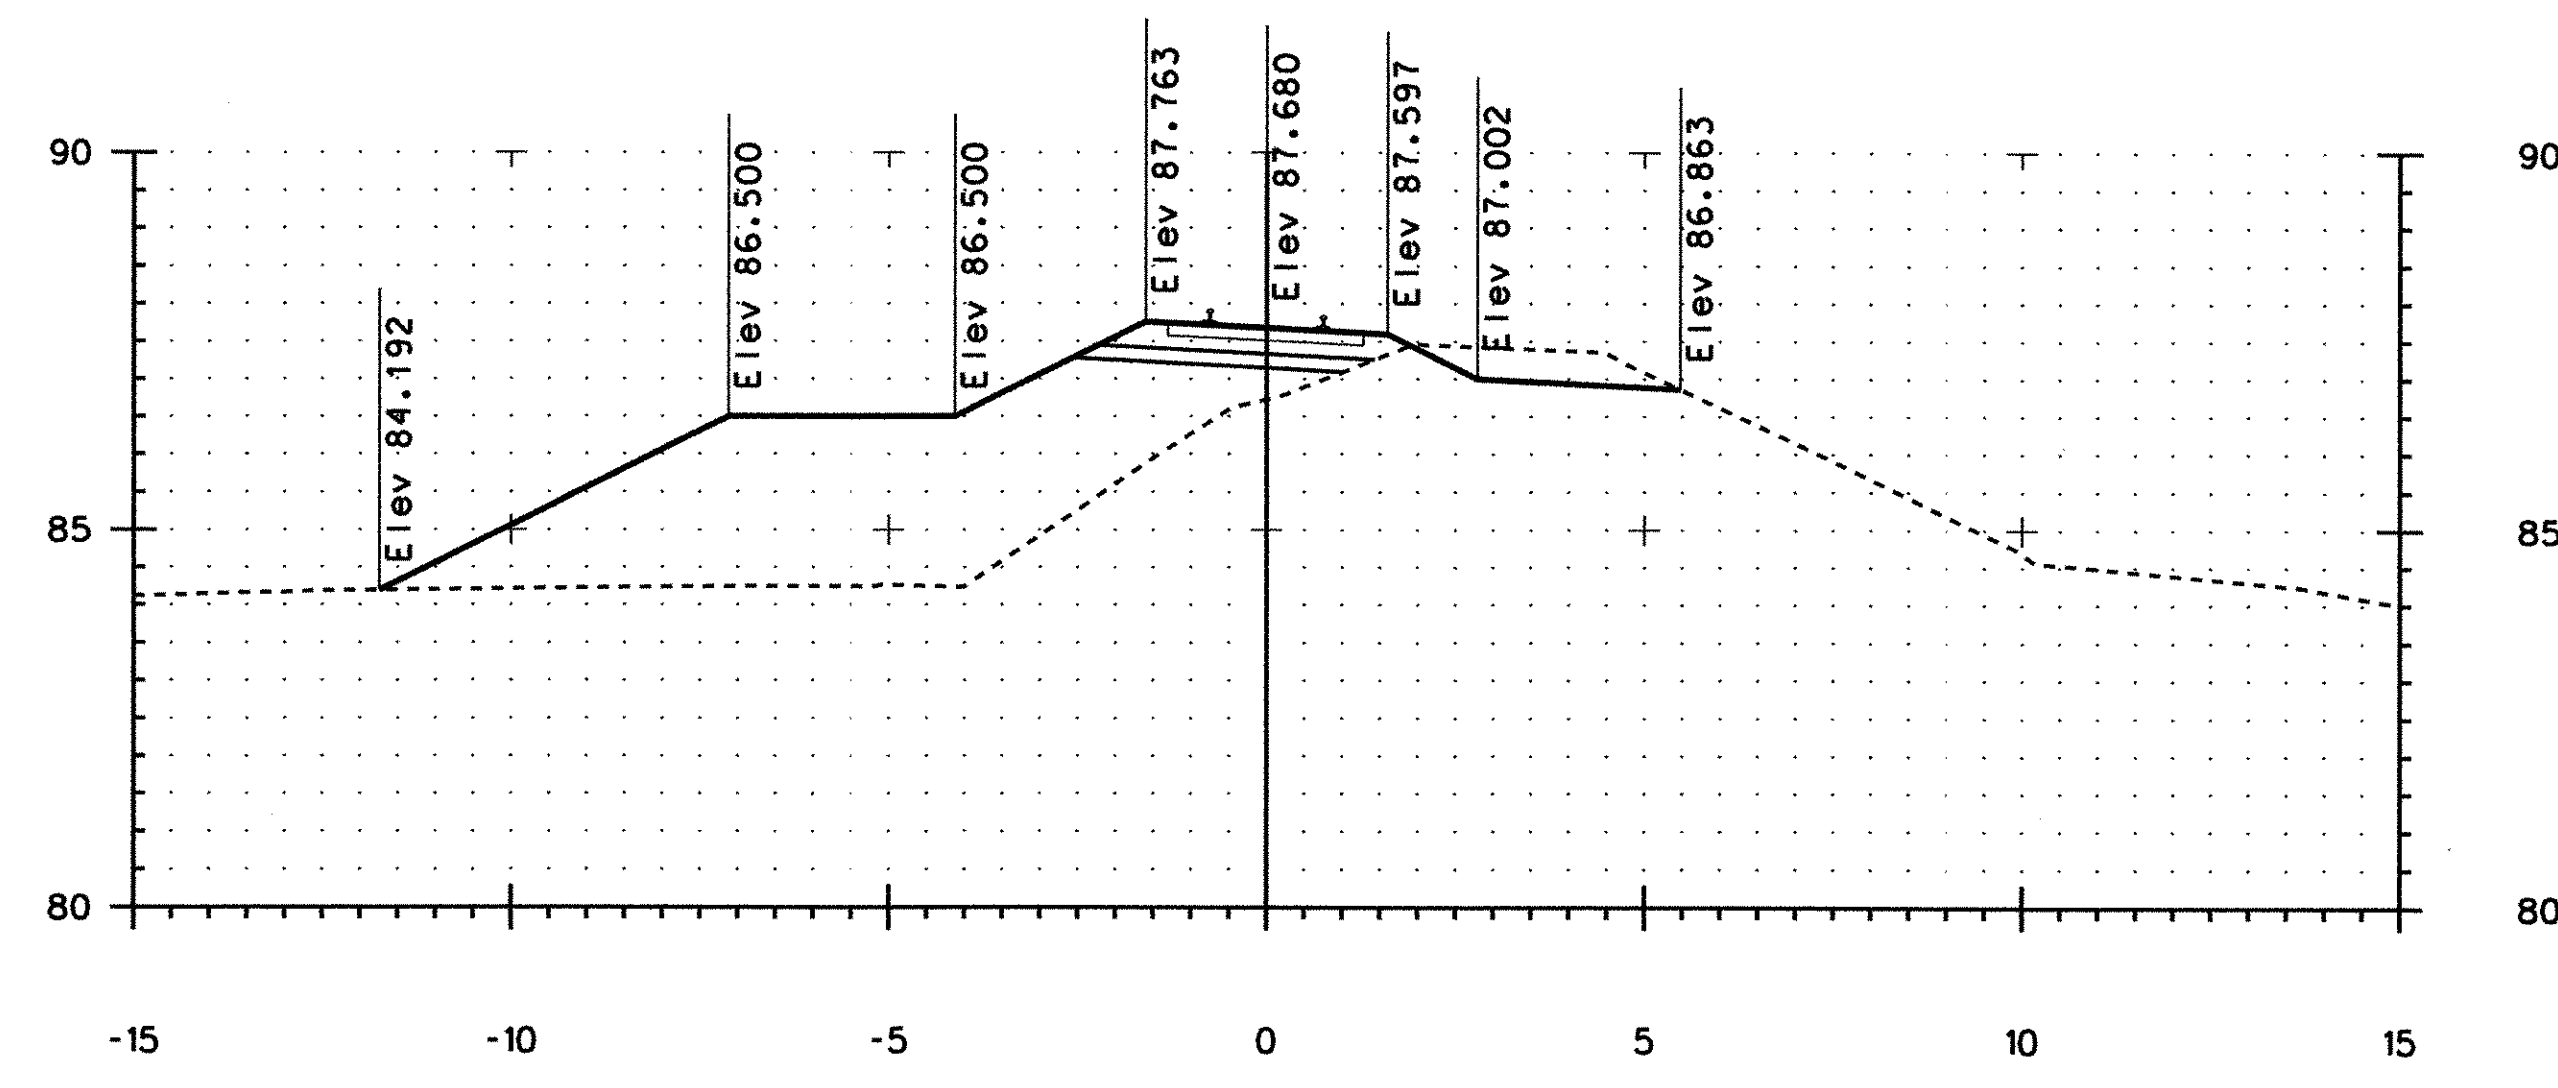


50+200.000


END TRANSITION SECTION
BEGIN FULL DEPTH CONSTRUCTION




PROJECT:	BRATTLEBORO	PROJECT NO.:	NH 010-2(2)
DESIGN FILE NAME:	U:\99123-Brattleboro\dgn\zb270xs1.dgn		
IPARM FILE NAME:	PLOT DATE: 10-02-2002		
FROM STA: 50+200.000 TO STA: 50+220.000 SHEET: 121 OF 145			

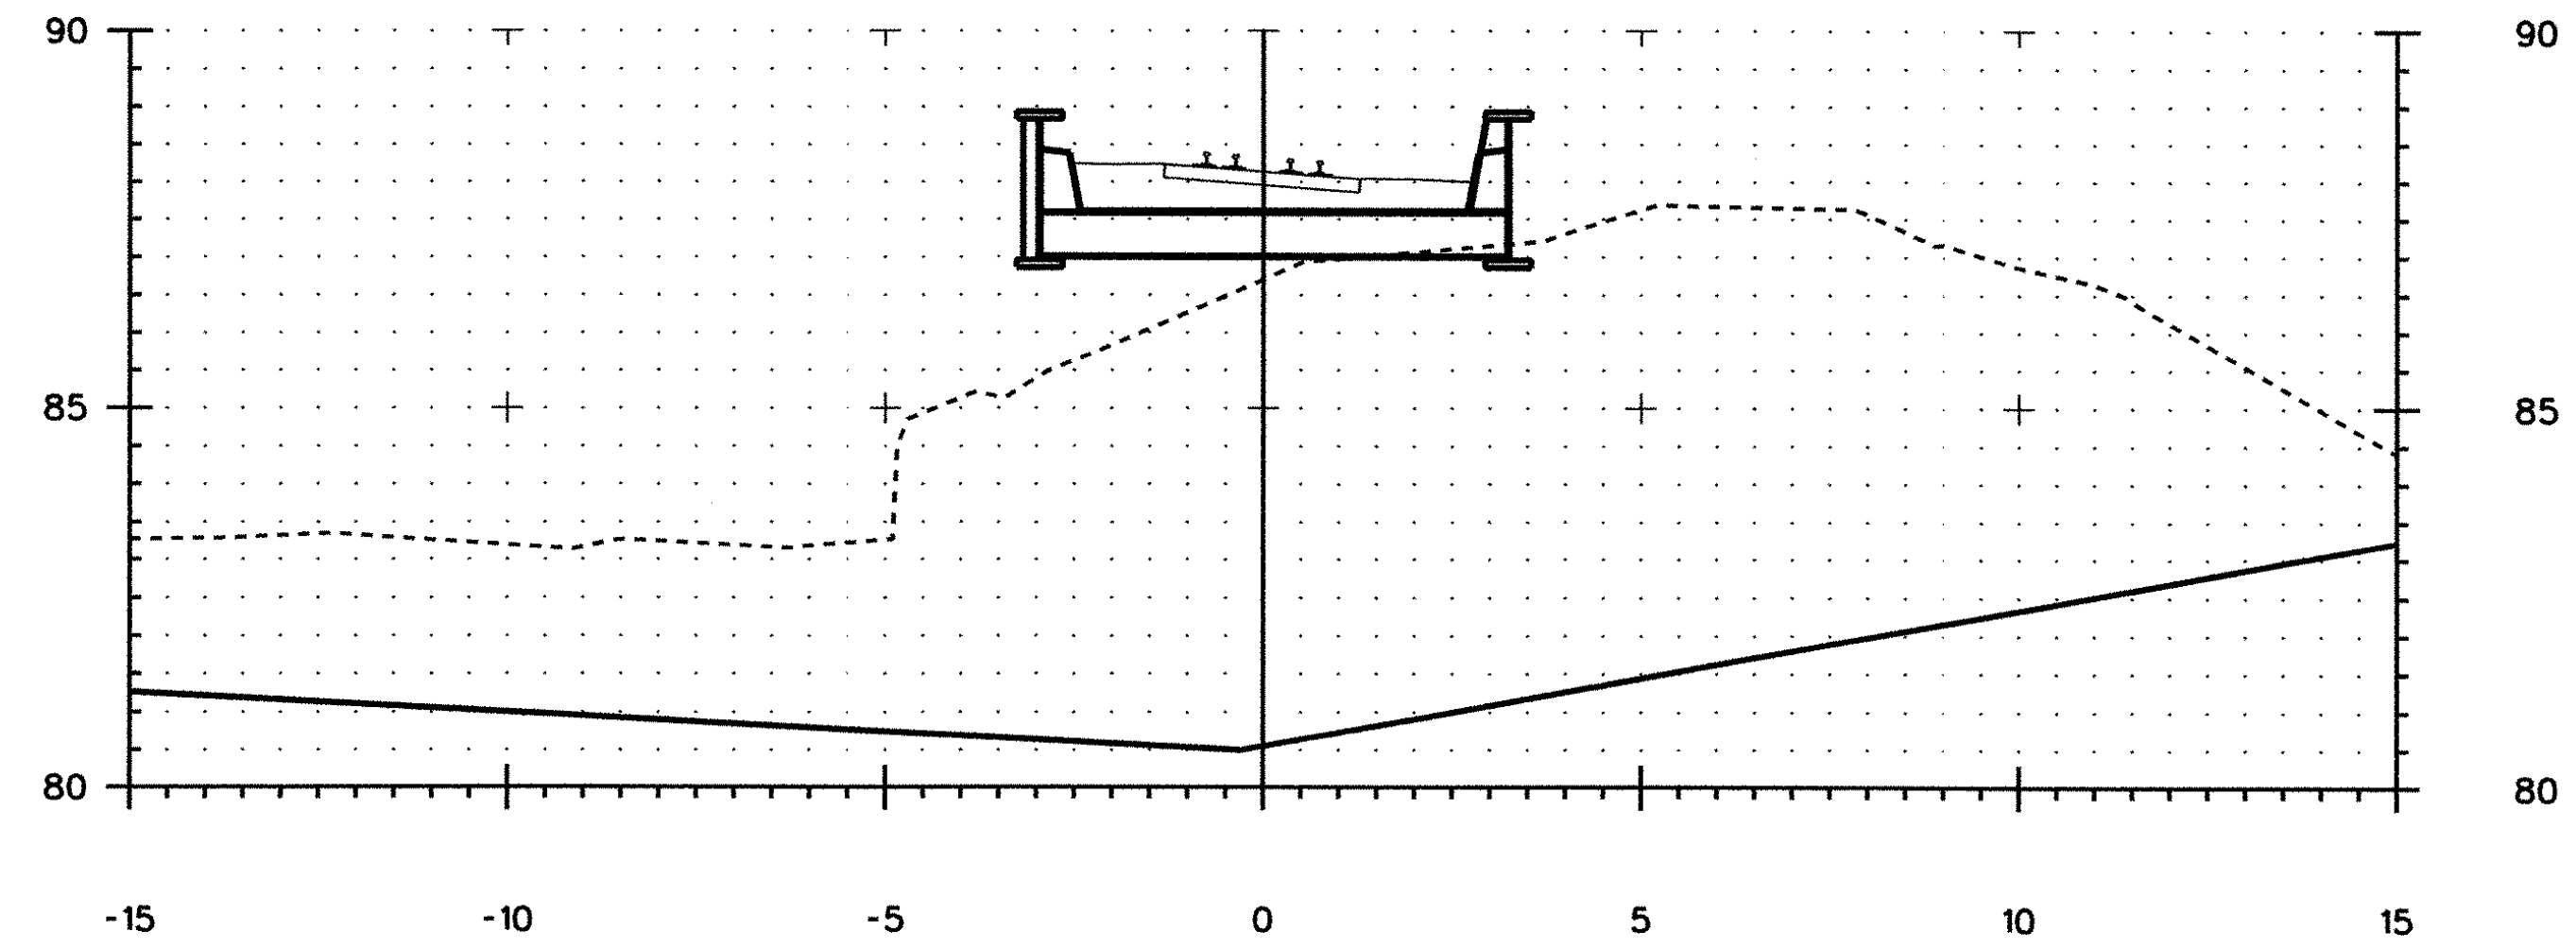

50+260.000

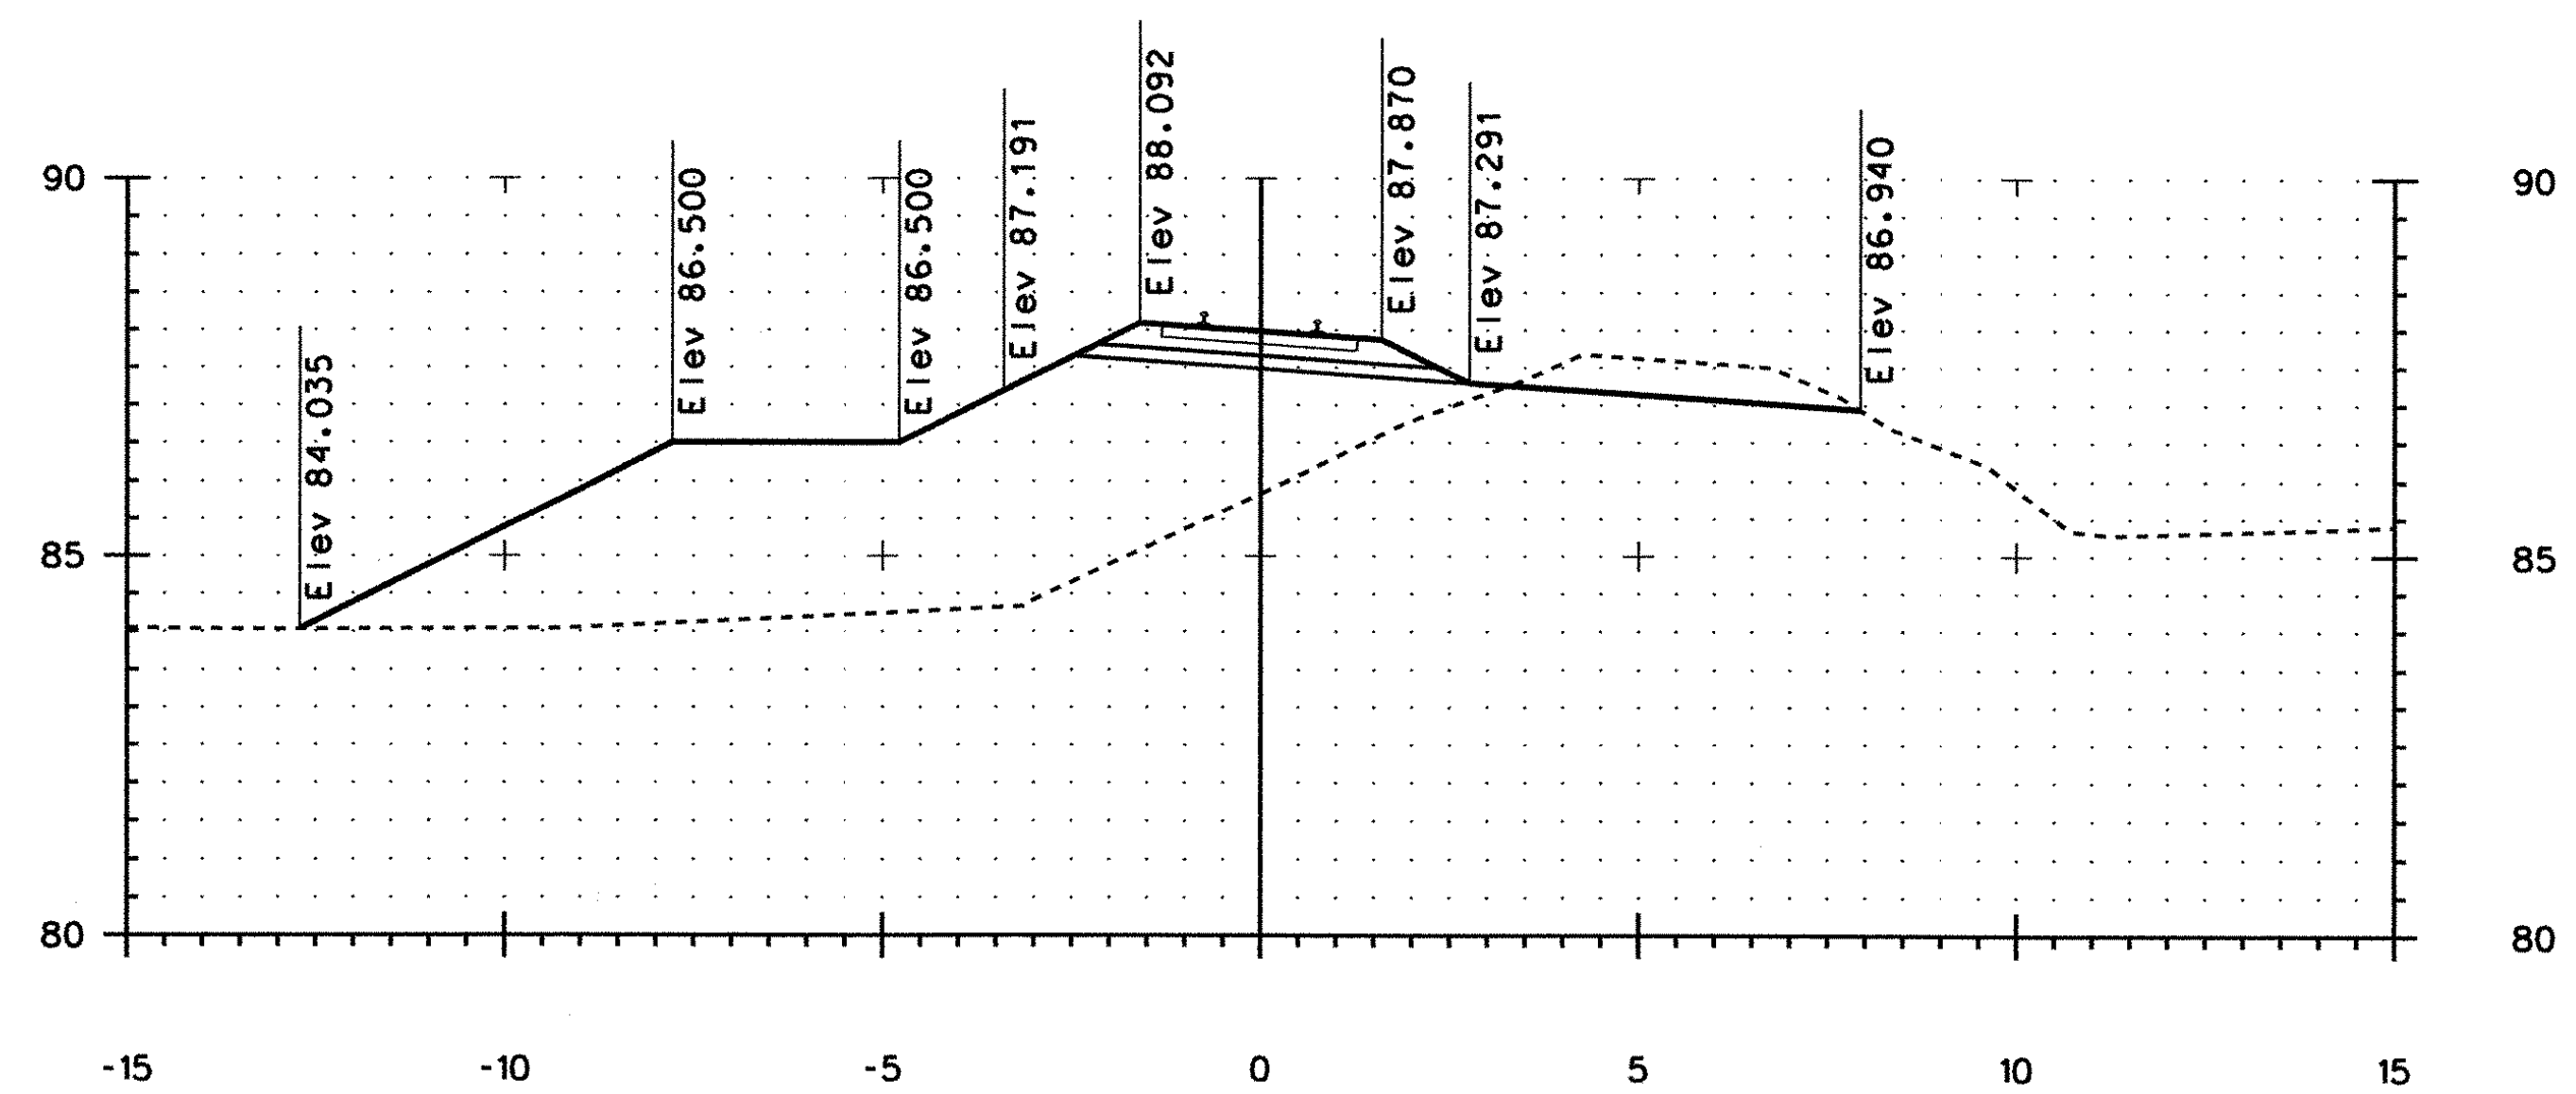


50+240.000

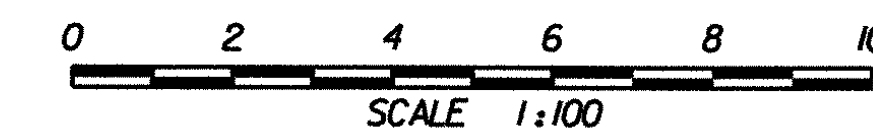


PROJECT: BRATTLEBORO	PROJECT NO.: NH 010-2(2)
DESIGN FILE NAME: U:\99123-Brattleboro\dgn\zb270xsl.dgn	PLOT DATE: 10-02-2002
FROM STA: 50+240.000 TO STA: 50+260.000 SHEET: 122 OF 145	

RAILROAD CROSS SECTIONS

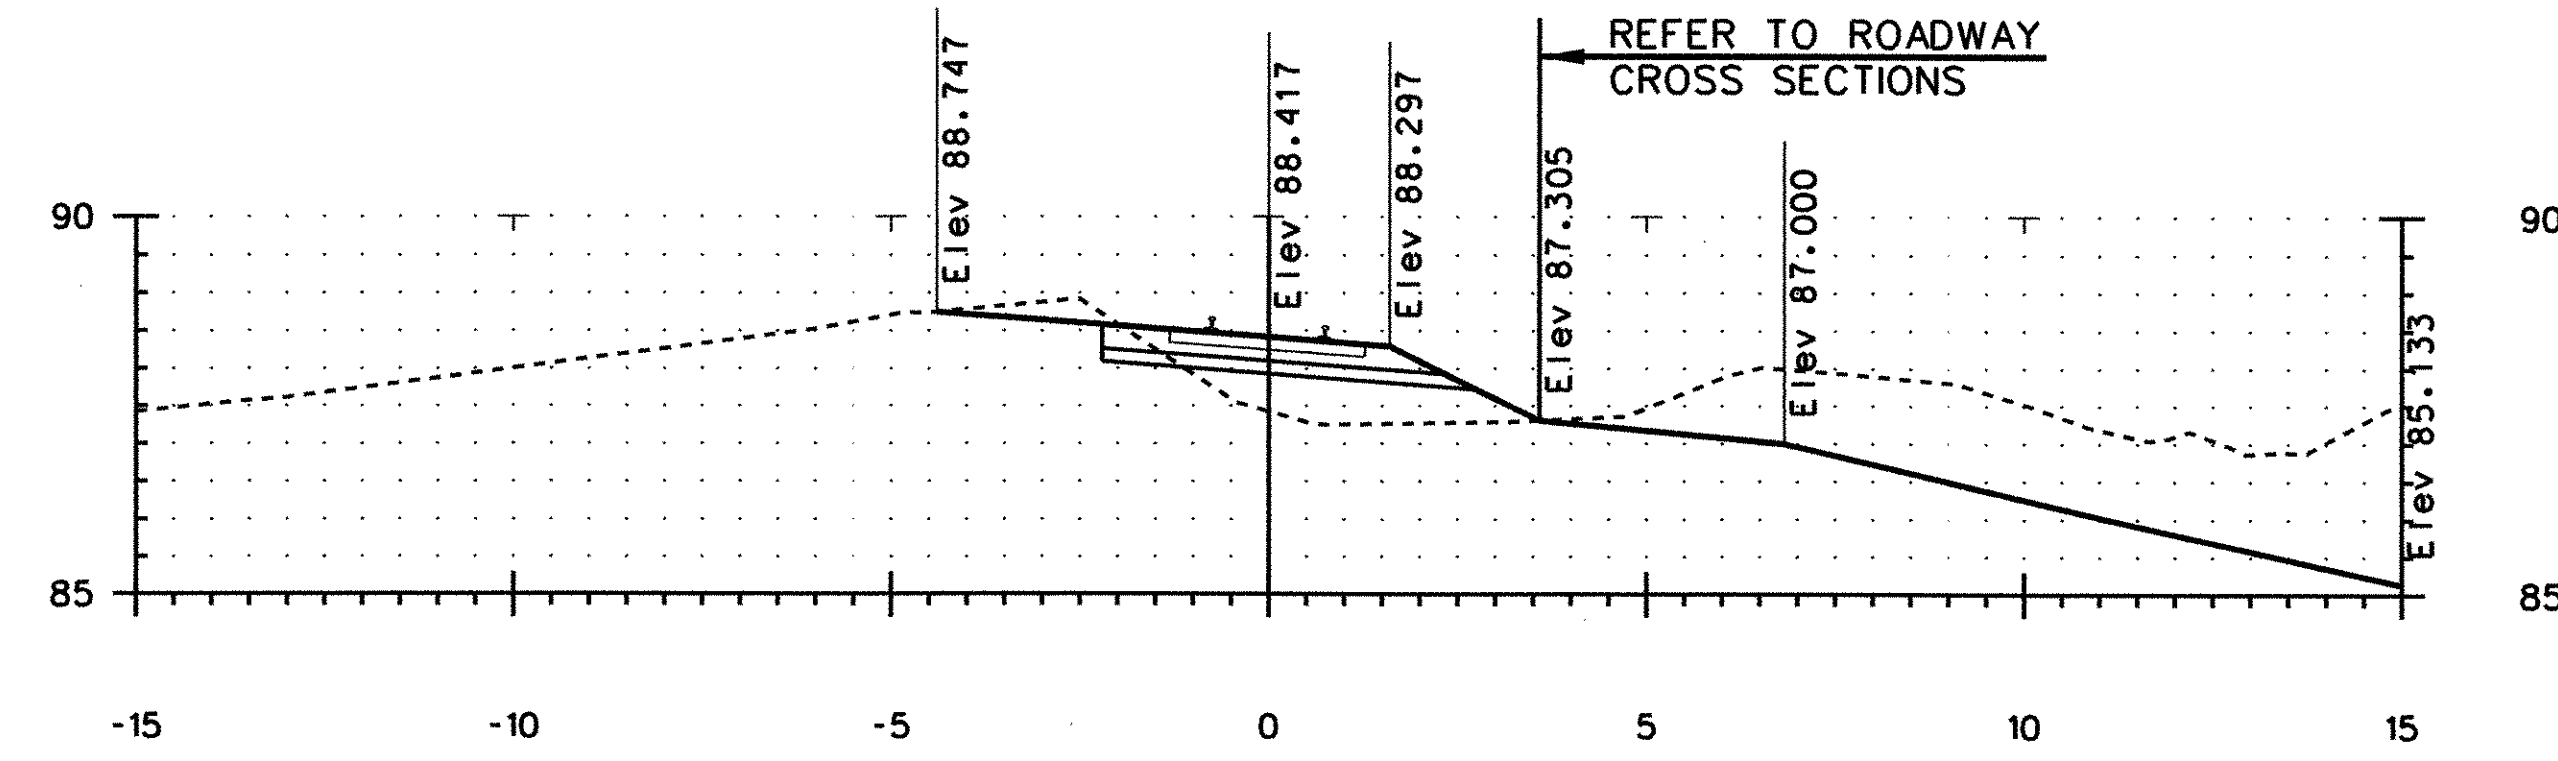

50+300.000

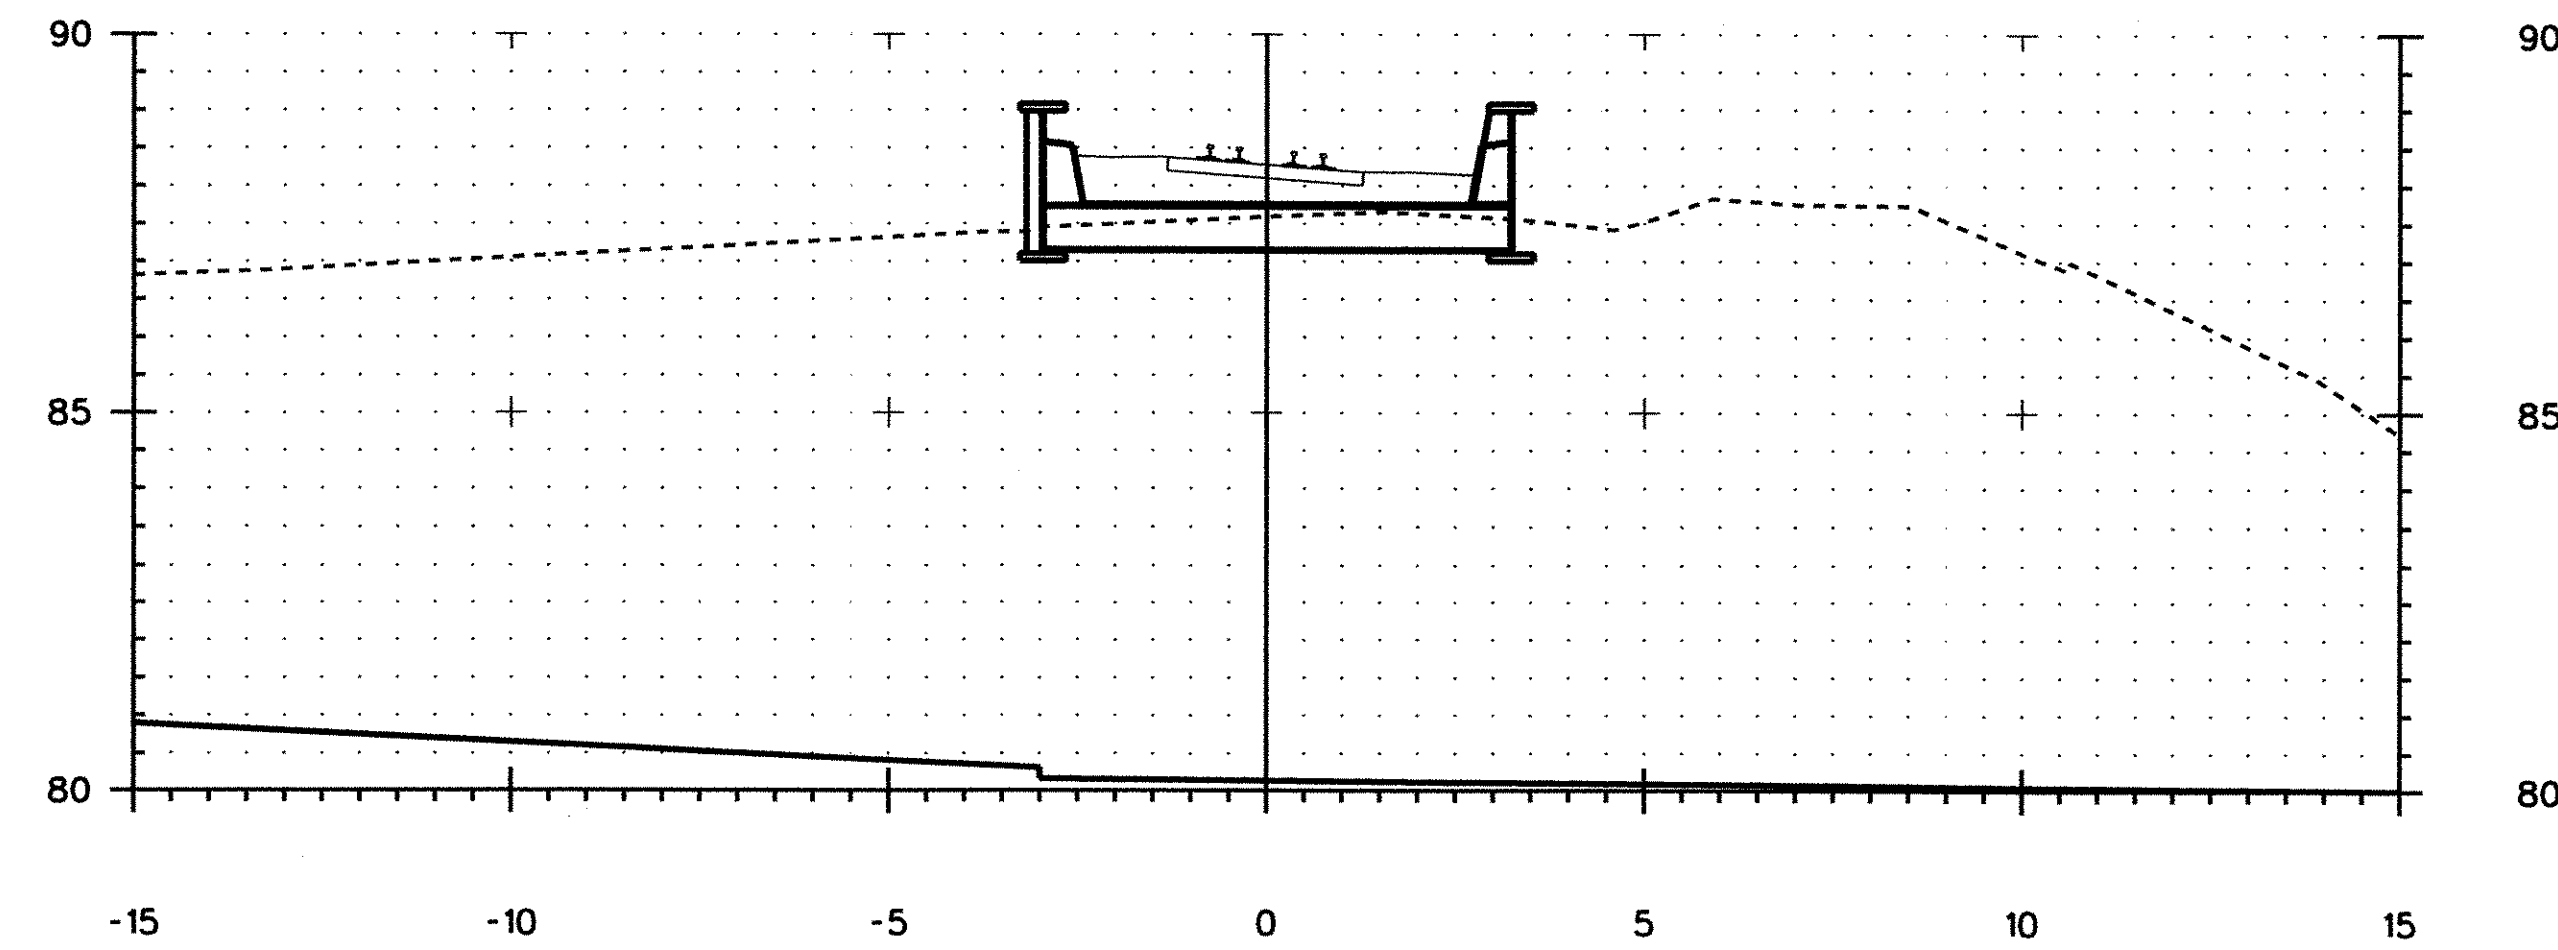


50+280.000




PROJECT:	BRATTLEBORO	PROJECT NO.:	NH 010-2(2)
DESIGN FILE NAME:	U:\99123-Brattleboro\dgn\zb270xs1.dgn		PLOT DATE: 10-02-2002
IPARM FILE NAME:			
FROM STA: 50+280.000 TO STA: 50+300.000 SHEET: 123 OF 145			

RAILROAD CROSS SECTIONS

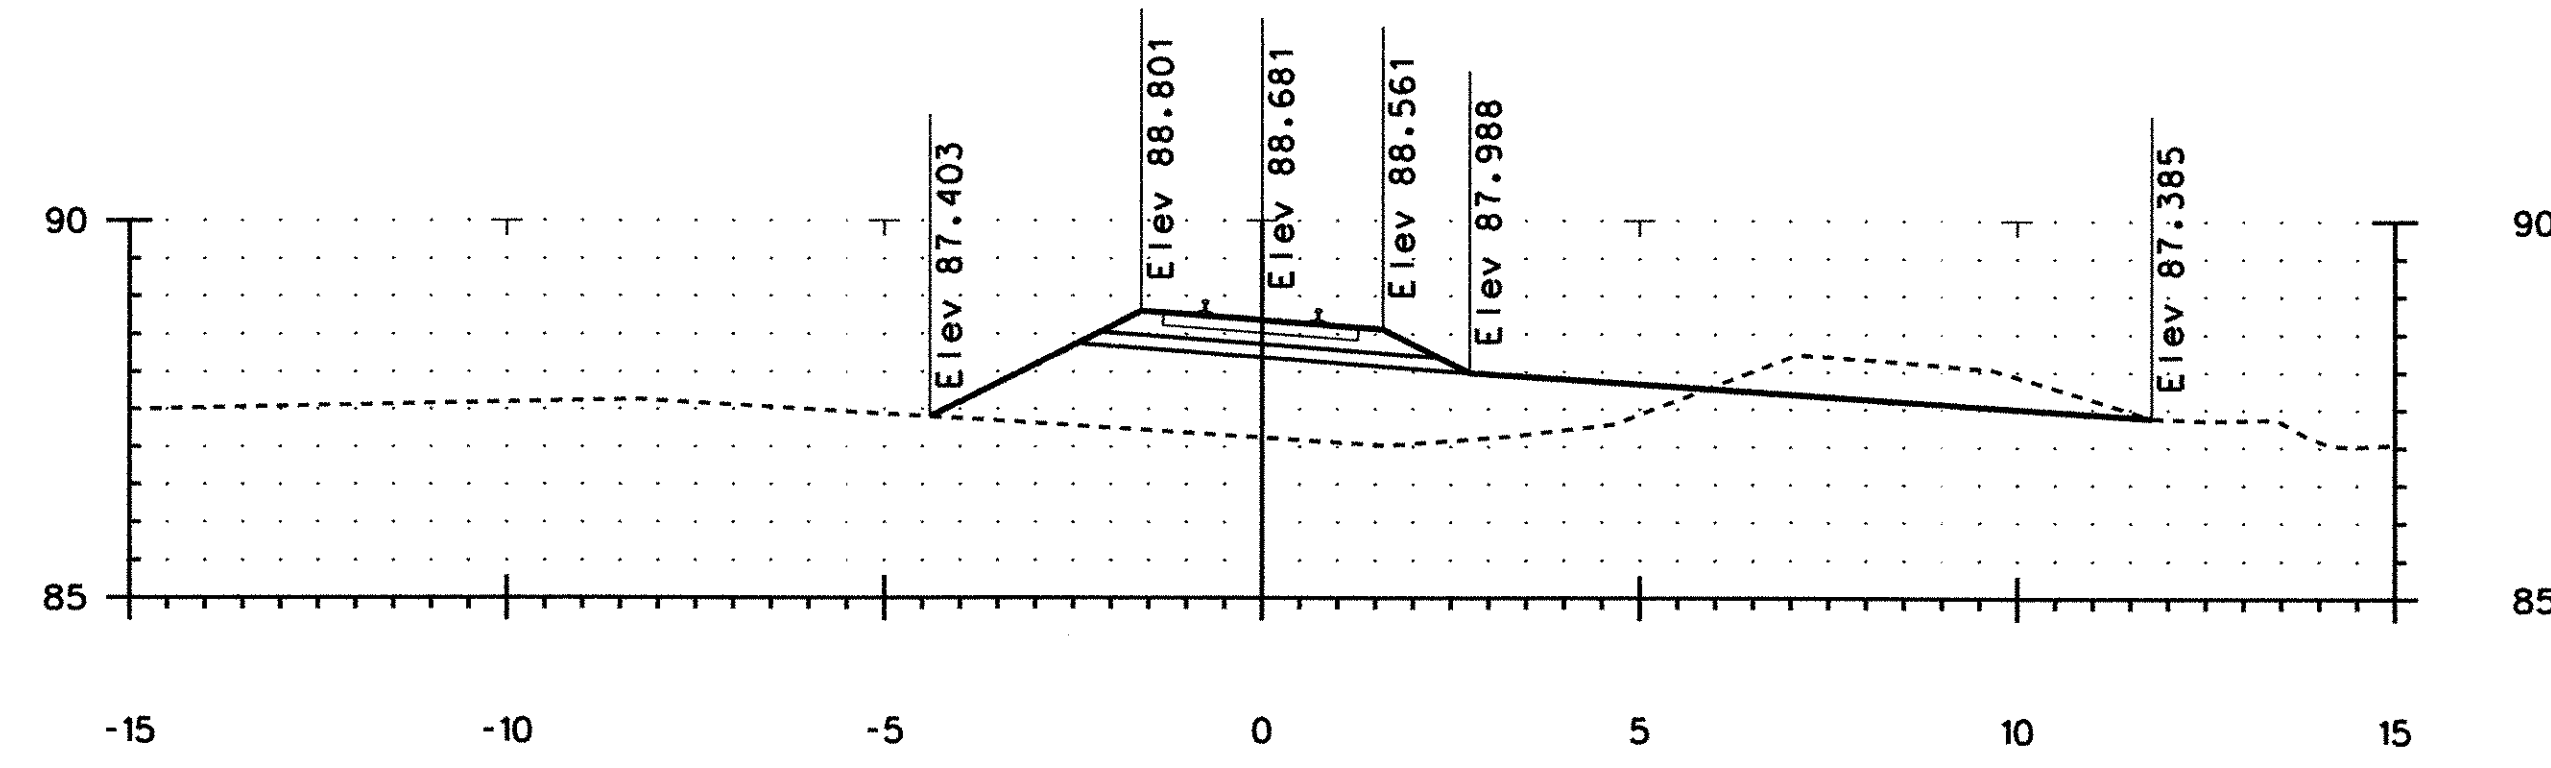

50+340.000

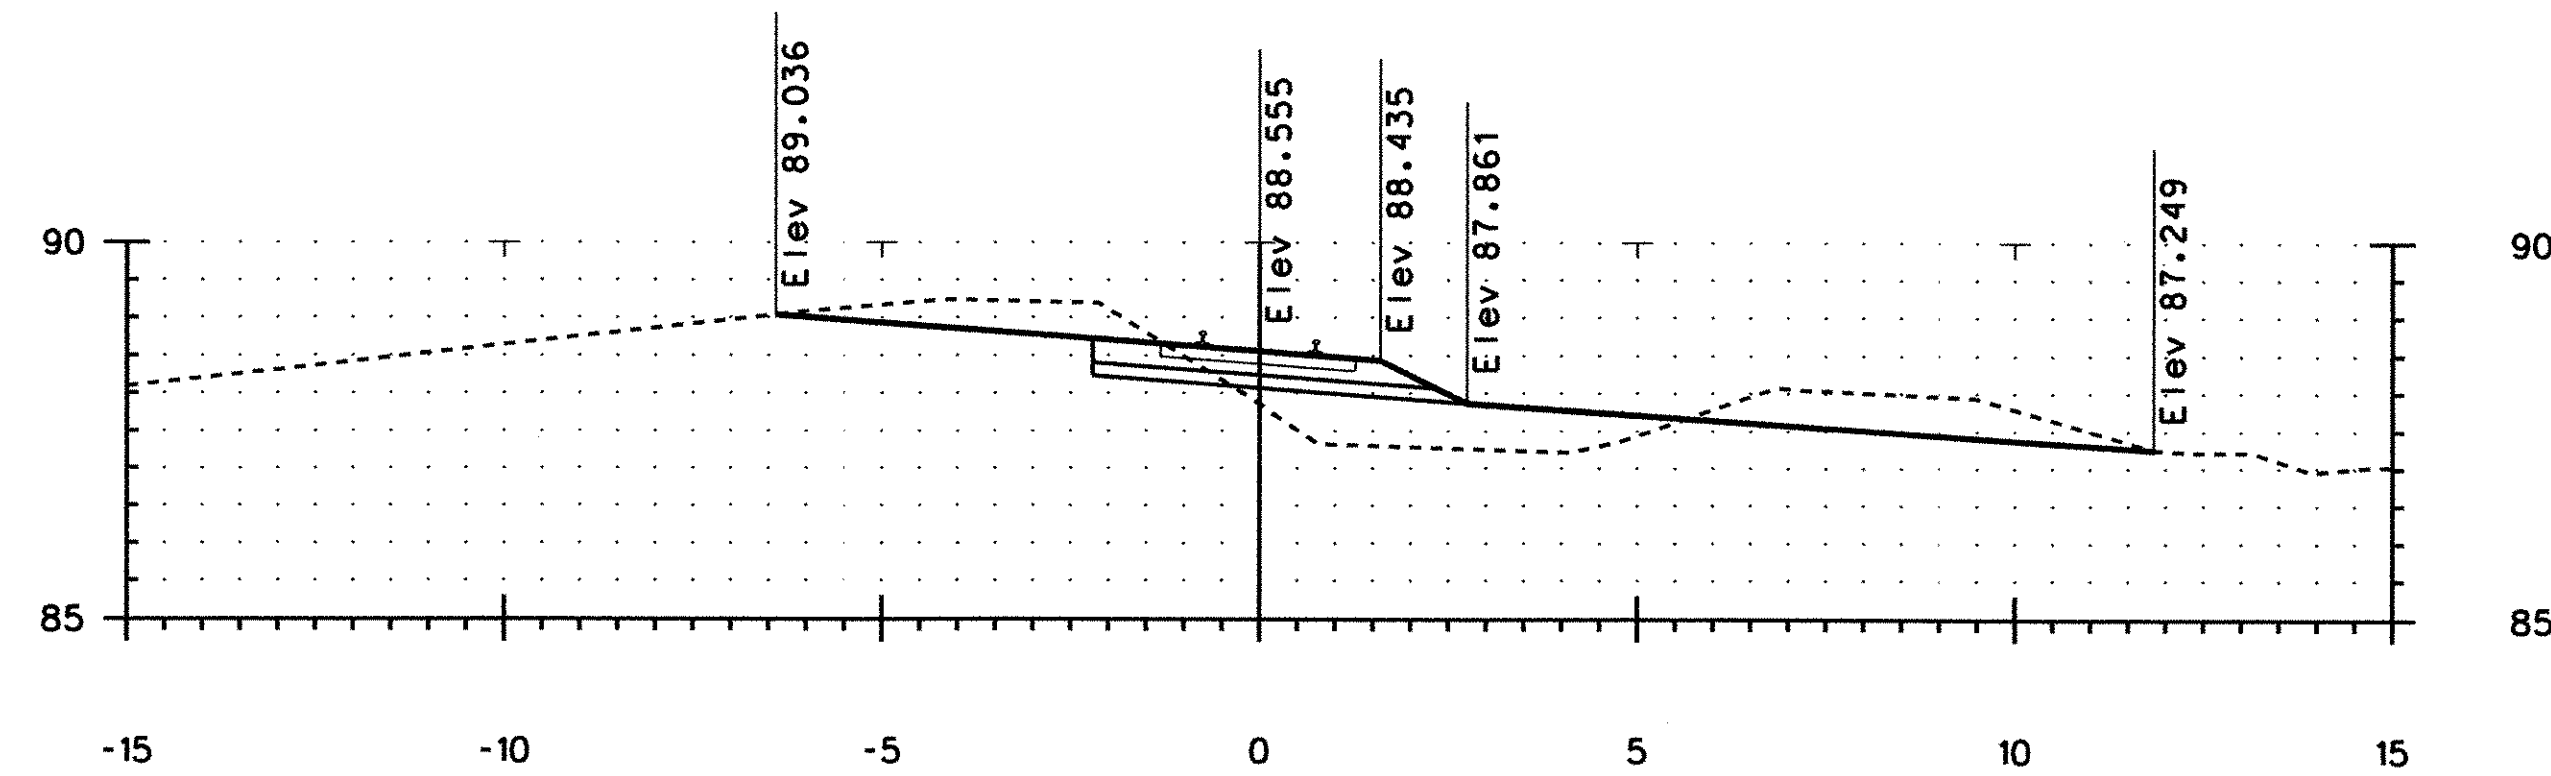


50+320.000




PROJECT:	BRATTLEBORO	PROJECT NO.:	NH 010-2(2)
DESIGN FILE NAME:	U:\99123-Brattleboro\dgn\zb270xs1.dgn		
IPARM FILE NAME:	PLOT DATE: 10-02-2002		
FROM STA: 50+320.000 TO STA: 50+340.000 SHEET: 124 OF 145			


RAILROAD CROSS SECTIONS

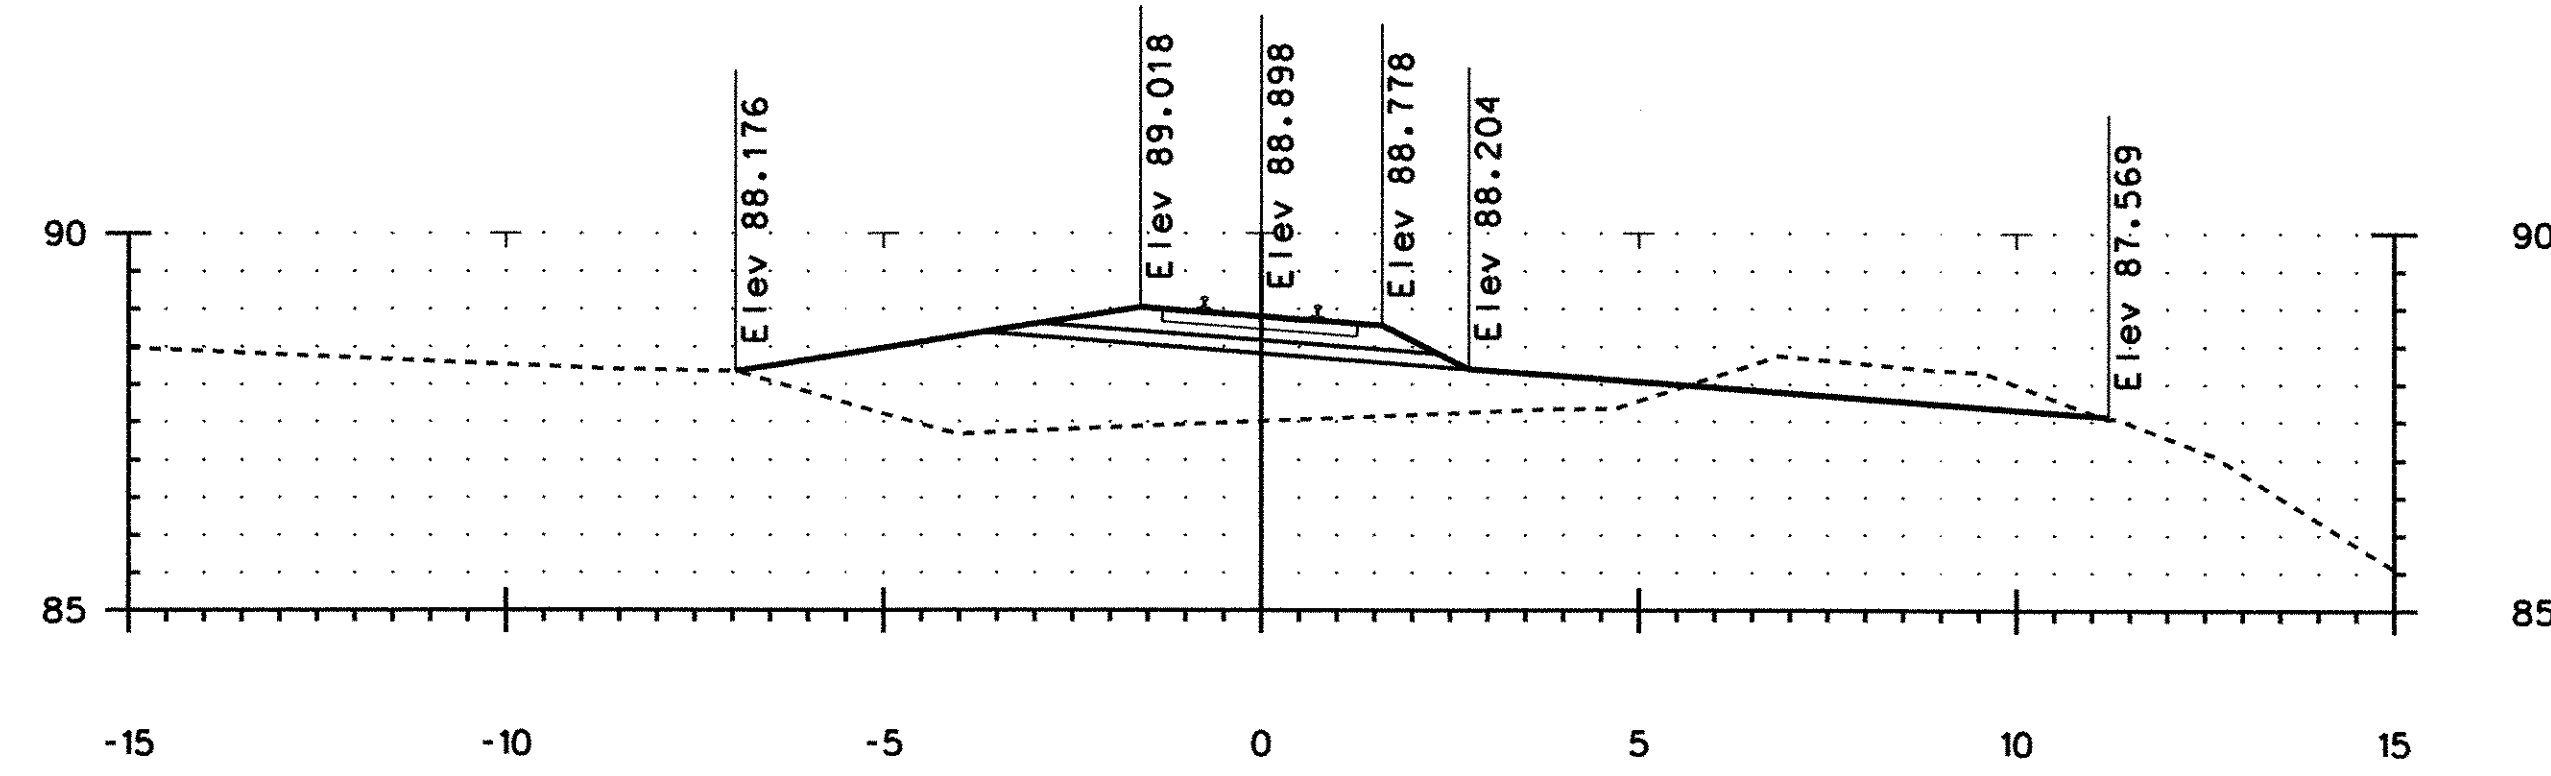

50+380.000

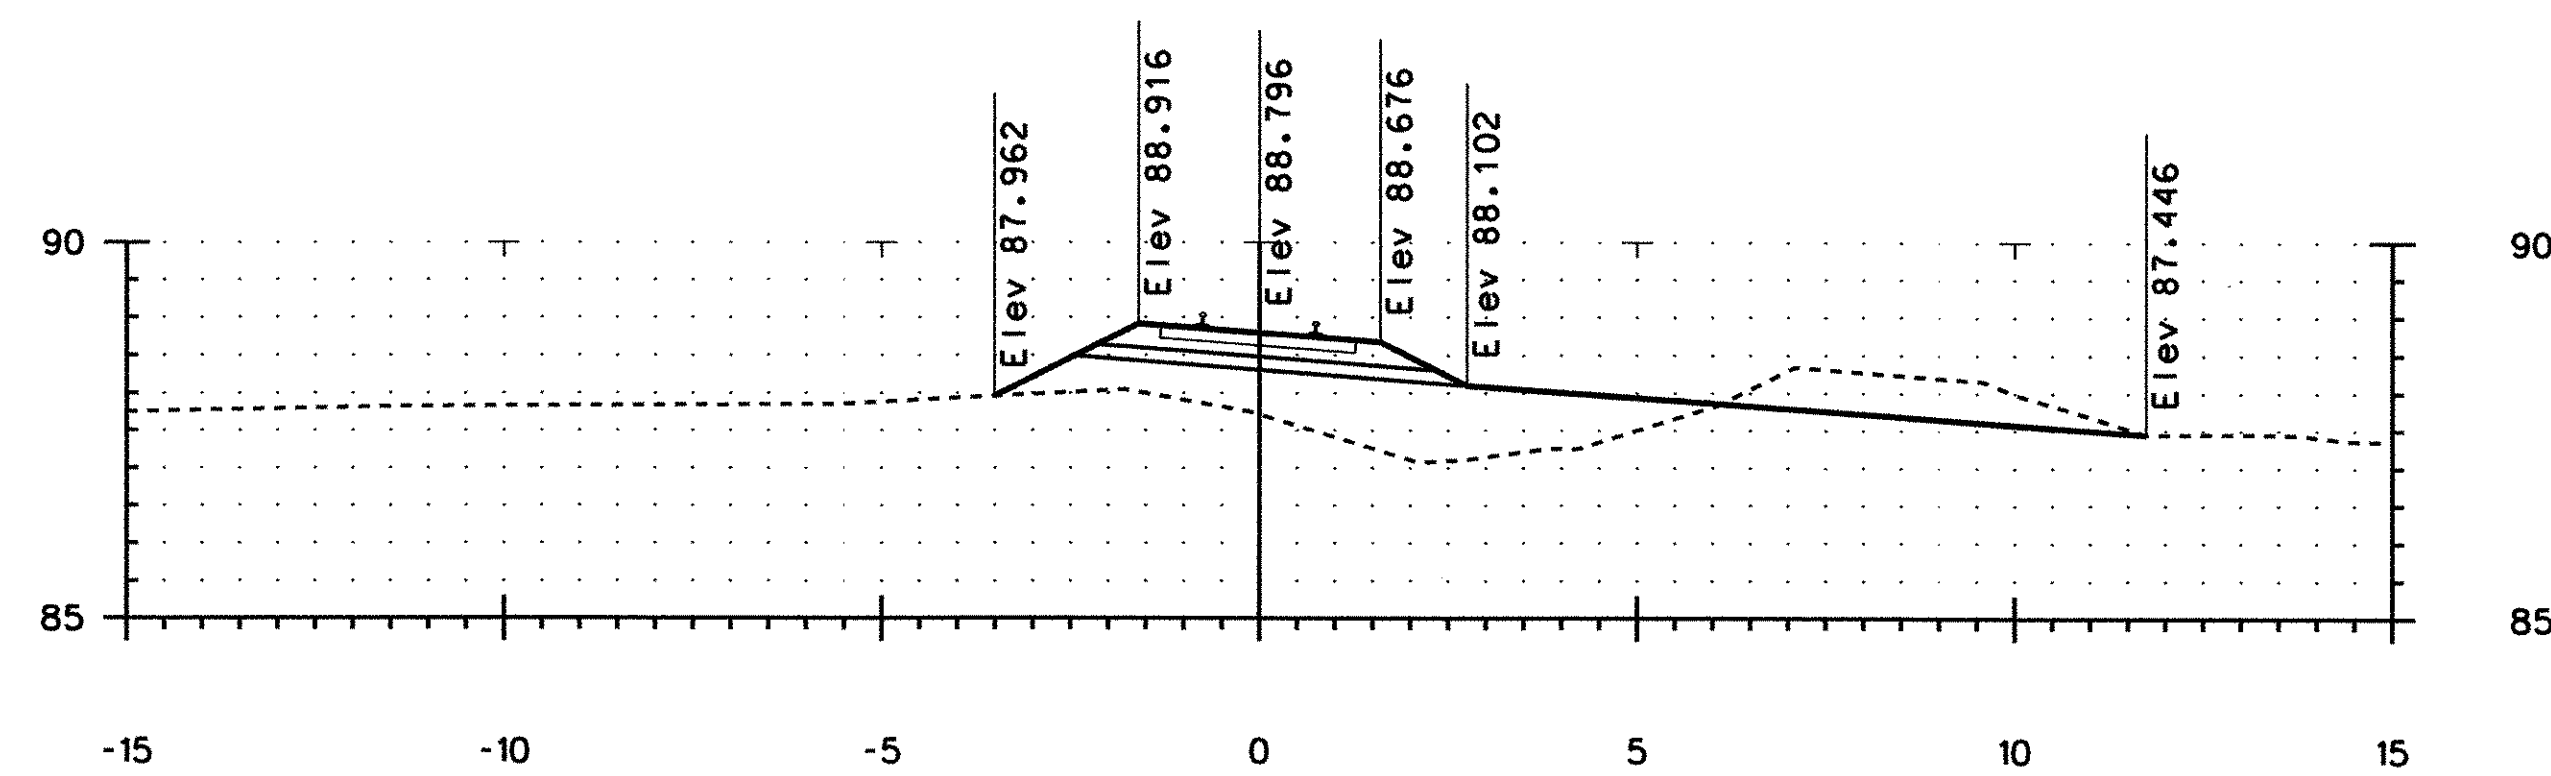


50+360.000

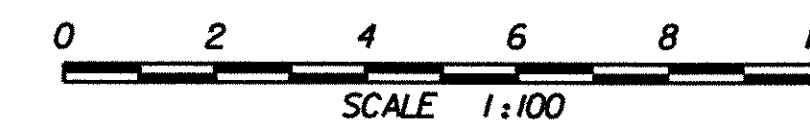


PROJECT:	BRATTLEBORO	PROJECT NO.:	NH 010-2(2)
DESIGN FILE NAME:	U:\99123-Brattleboro\dgn\zb270xs1.dgn		
IPARM FILE NAME:	PLOT DATE: 10-02-2002		
FROM STA: 50+360.000 TO STA: 50+380.000 SHEET: 125 OF 145			


RAILROAD CROSS SECTIONS

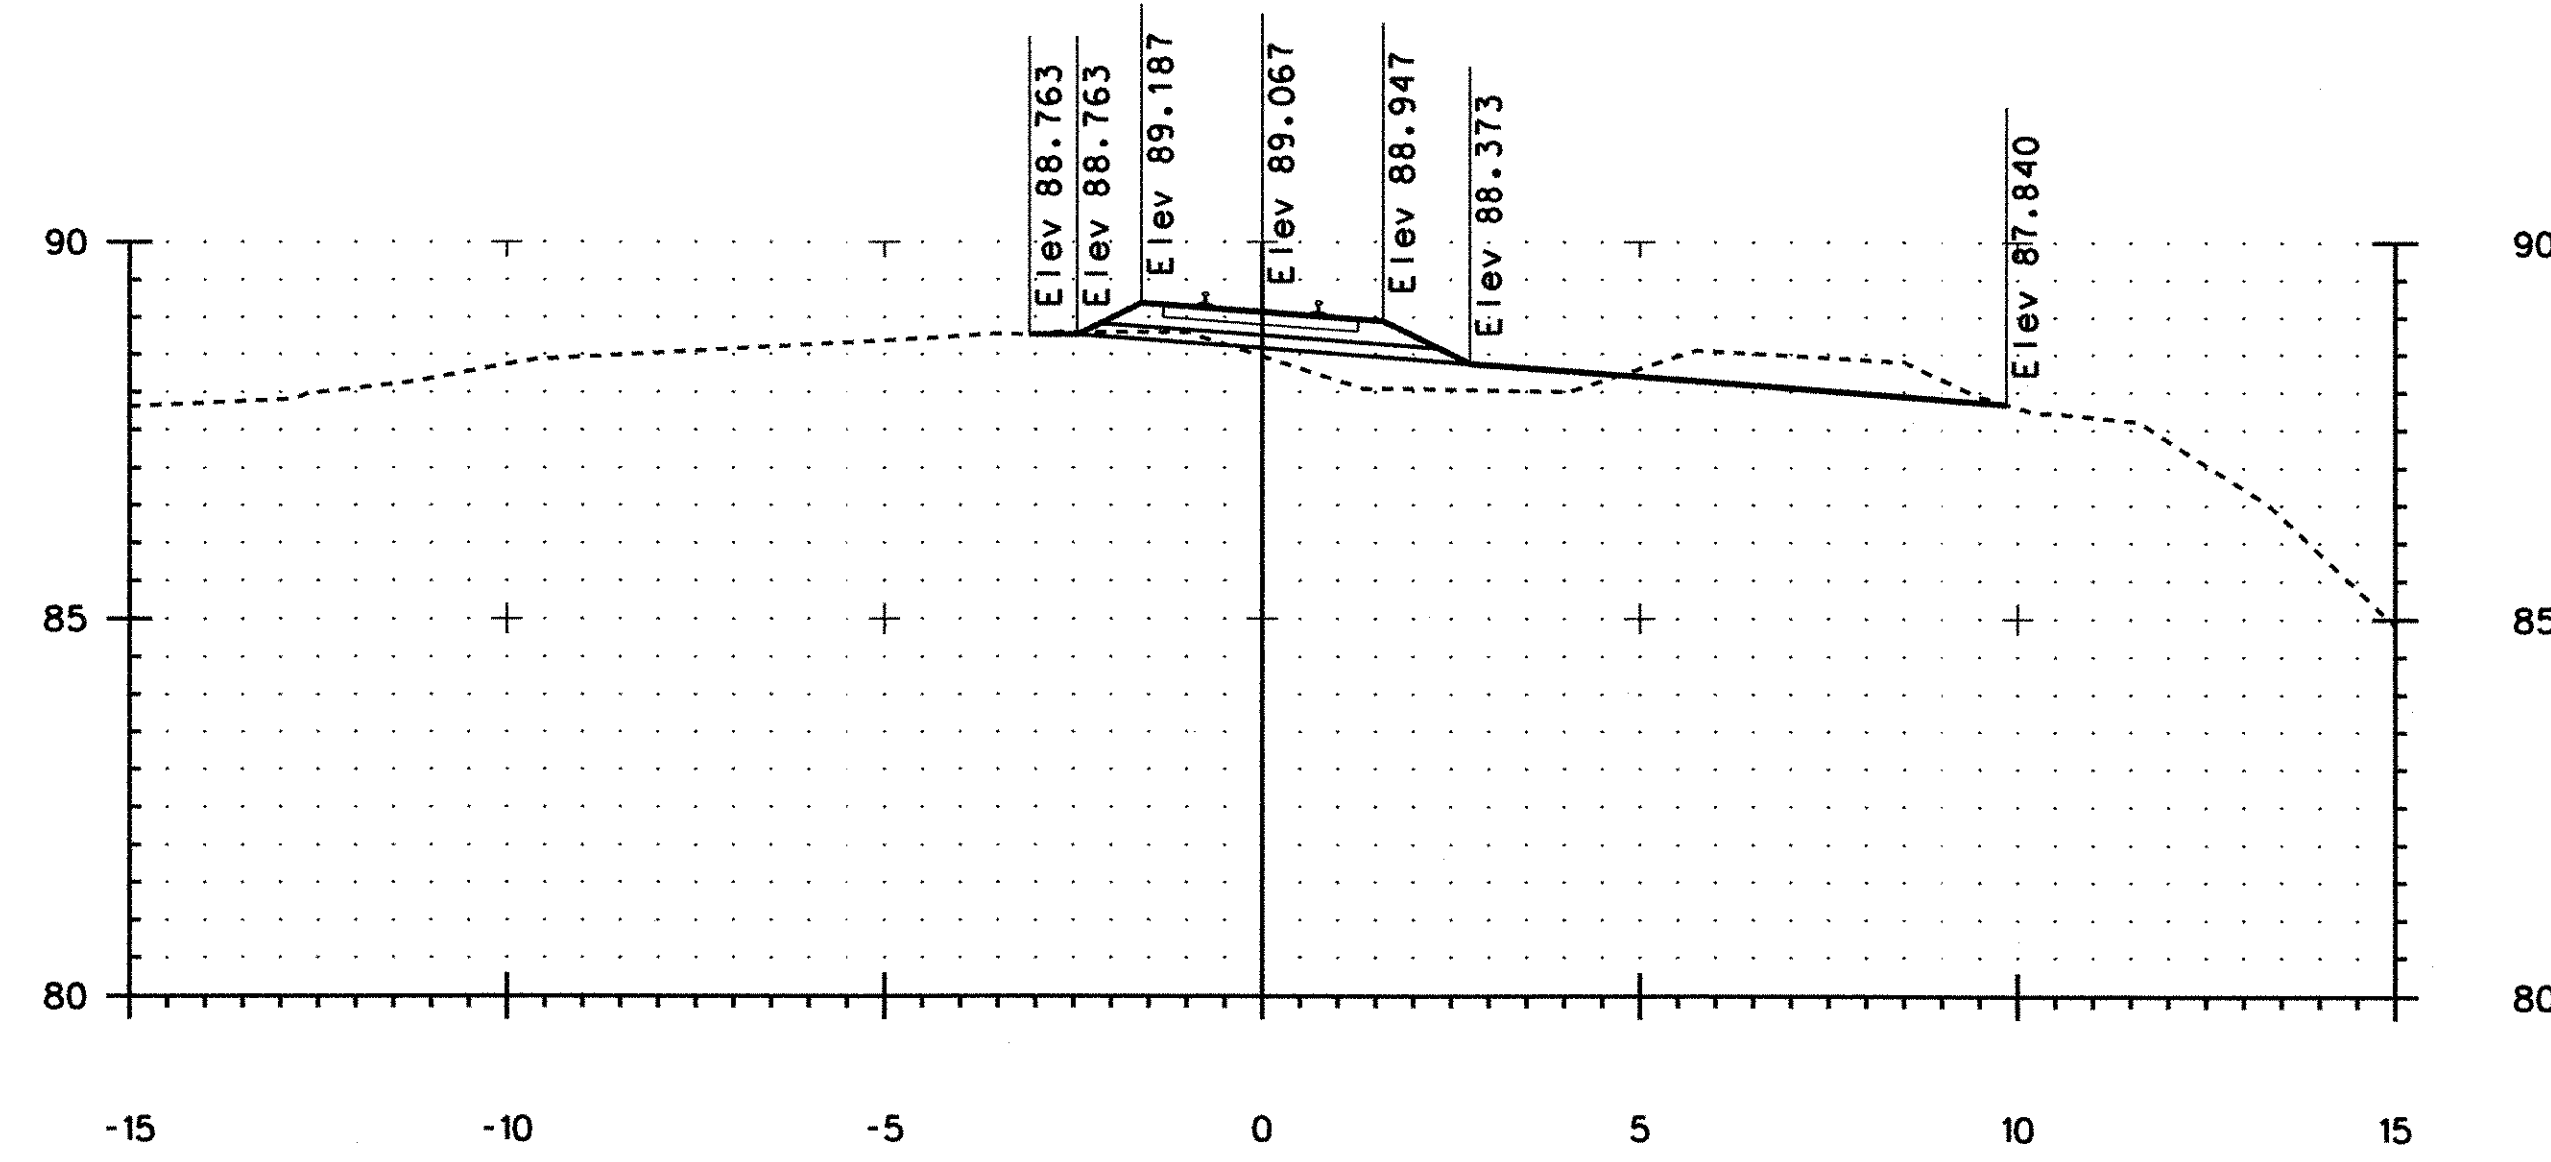

50+420.000

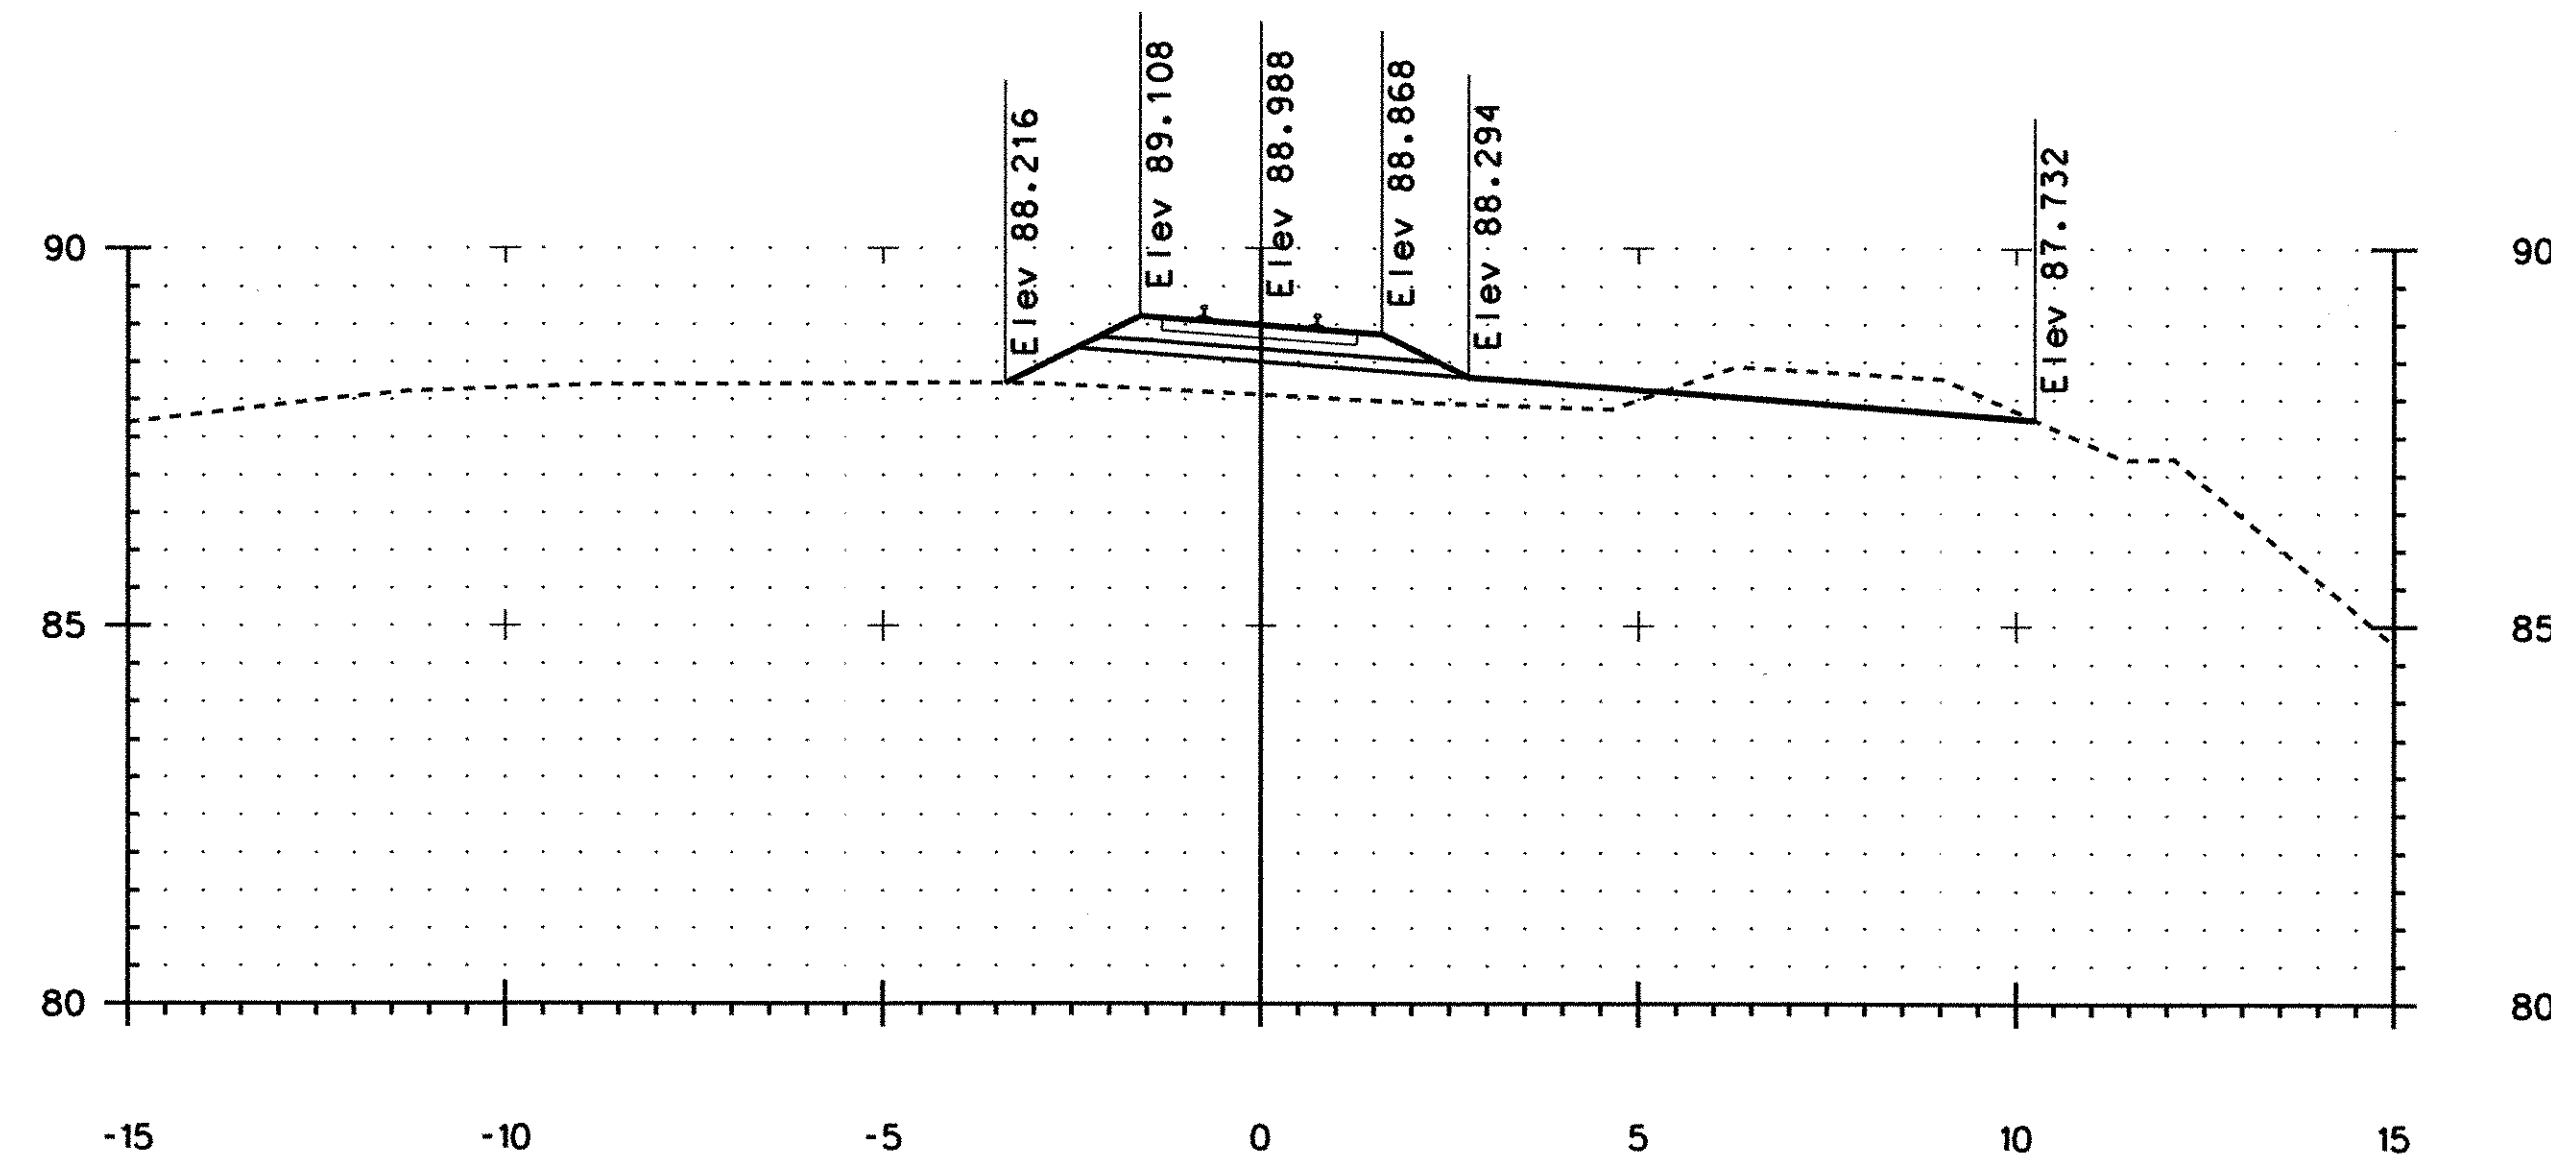


50+400.000

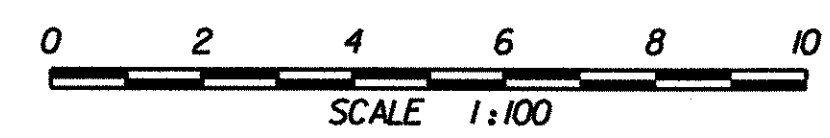


PROJECT:	BRATTLEBORO	PROJECT NO.:	NH 010-2(2)
DESIGN FILE NAME:	U:\99123-Brattleboro\dgn\zb270xs1.dgn		
IPARM FILE NAME:	PLOT DATE: 10-02-2002		
FROM STA: 50+400.000 TO STA: 50+420.000 SHEET: 126 OF 145			

RAILROAD CROSS SECTIONS

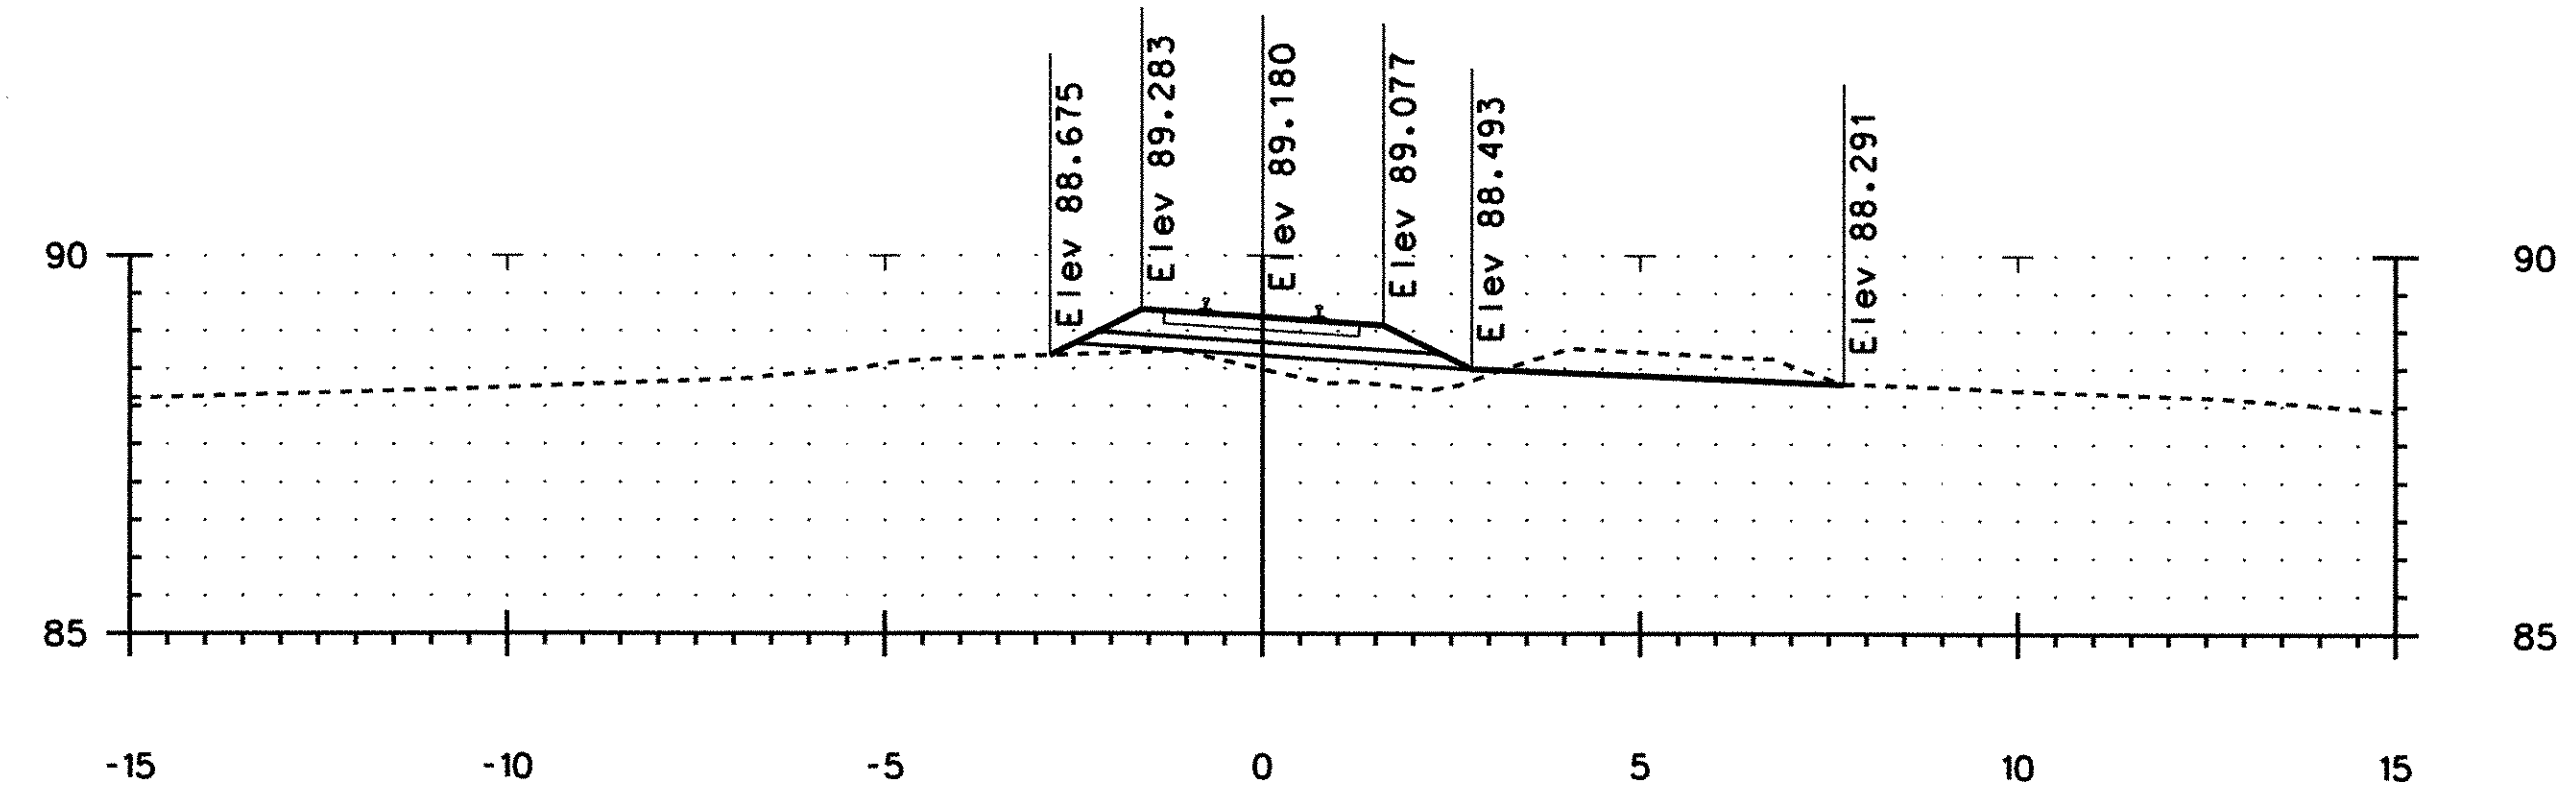

50+460.000

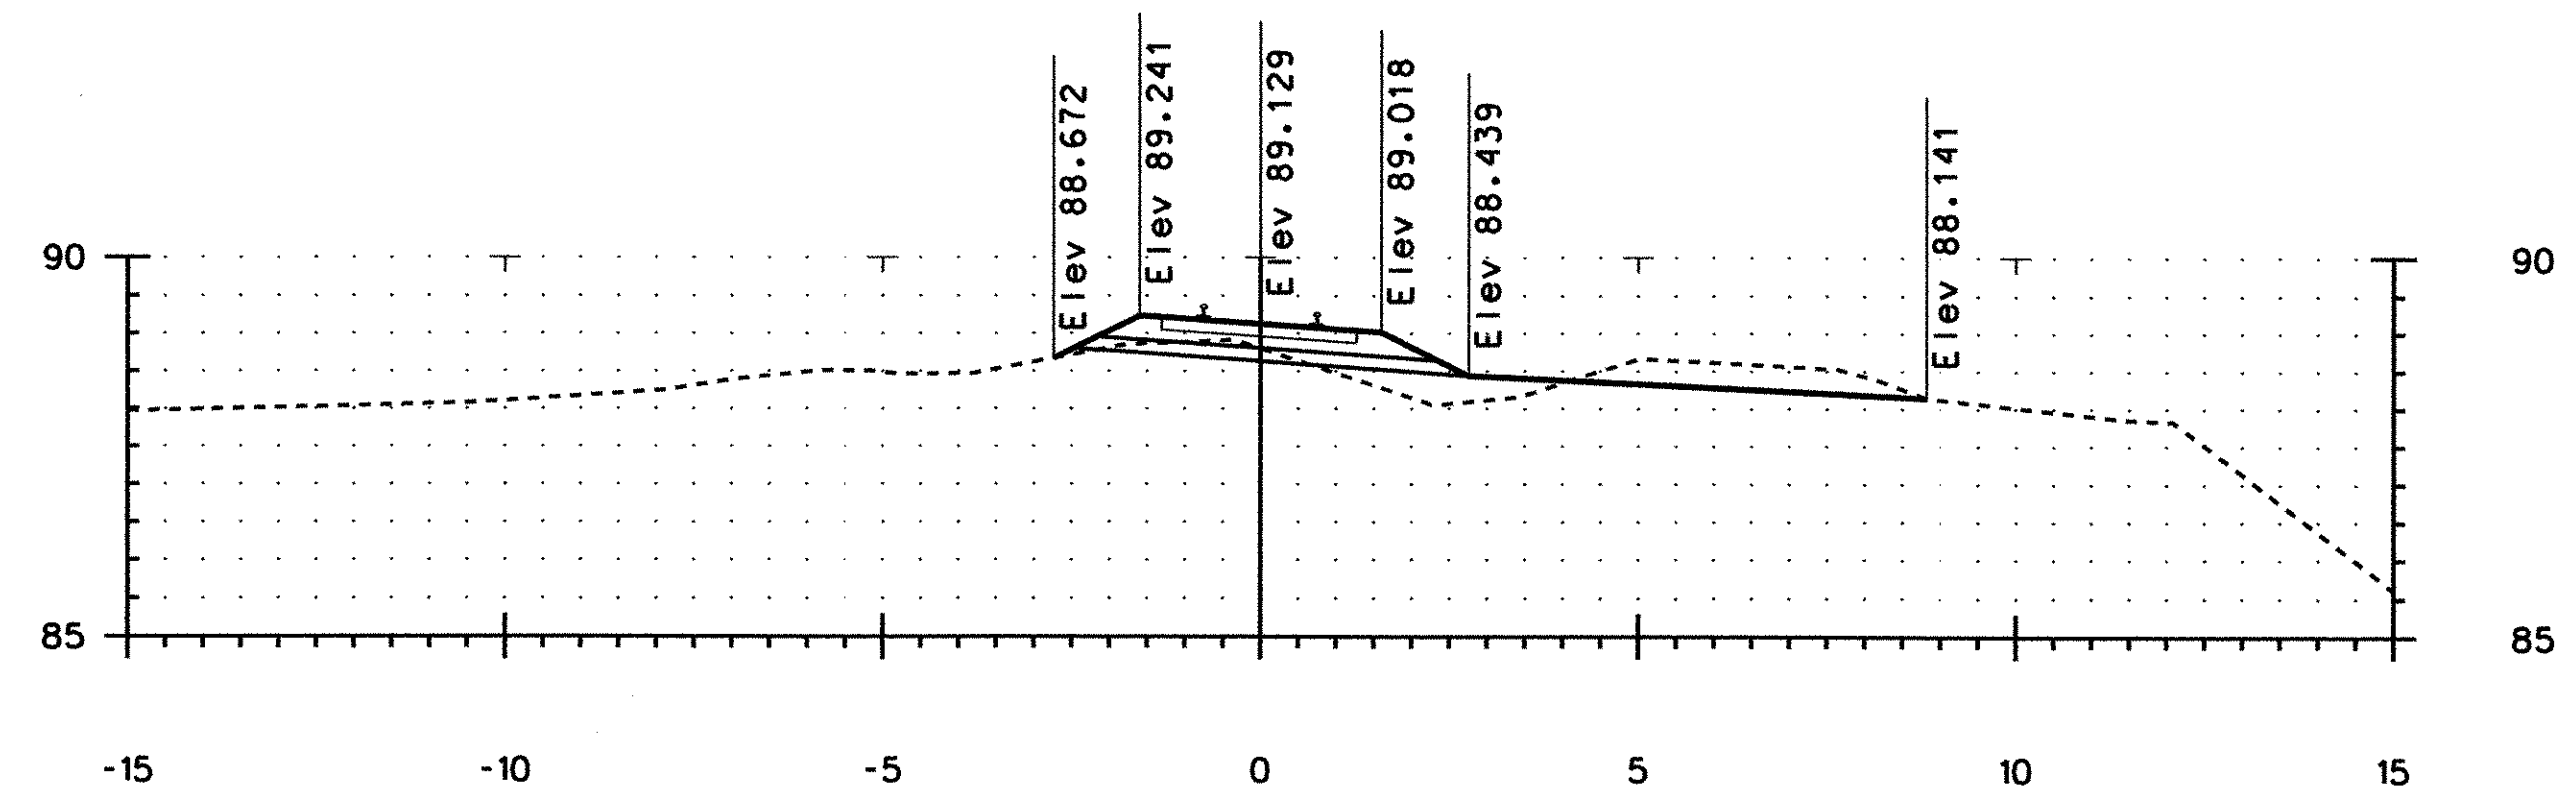


50+440.000




PROJECT:	BRATTLEBORO	PROJECT NO.:	NH 010-2(2)
DESIGN FILE NAME:	U:\99123-Brattleboro\dgn\zb270xs1.dgn		
IPARM FILE NAME:	PLOT DATE: 10-02-2002		
FROM STA: 50+440.000 TO STA: 50+460.000 SHEET: 127 OF 145			

RAILROAD CROSS SECTIONS

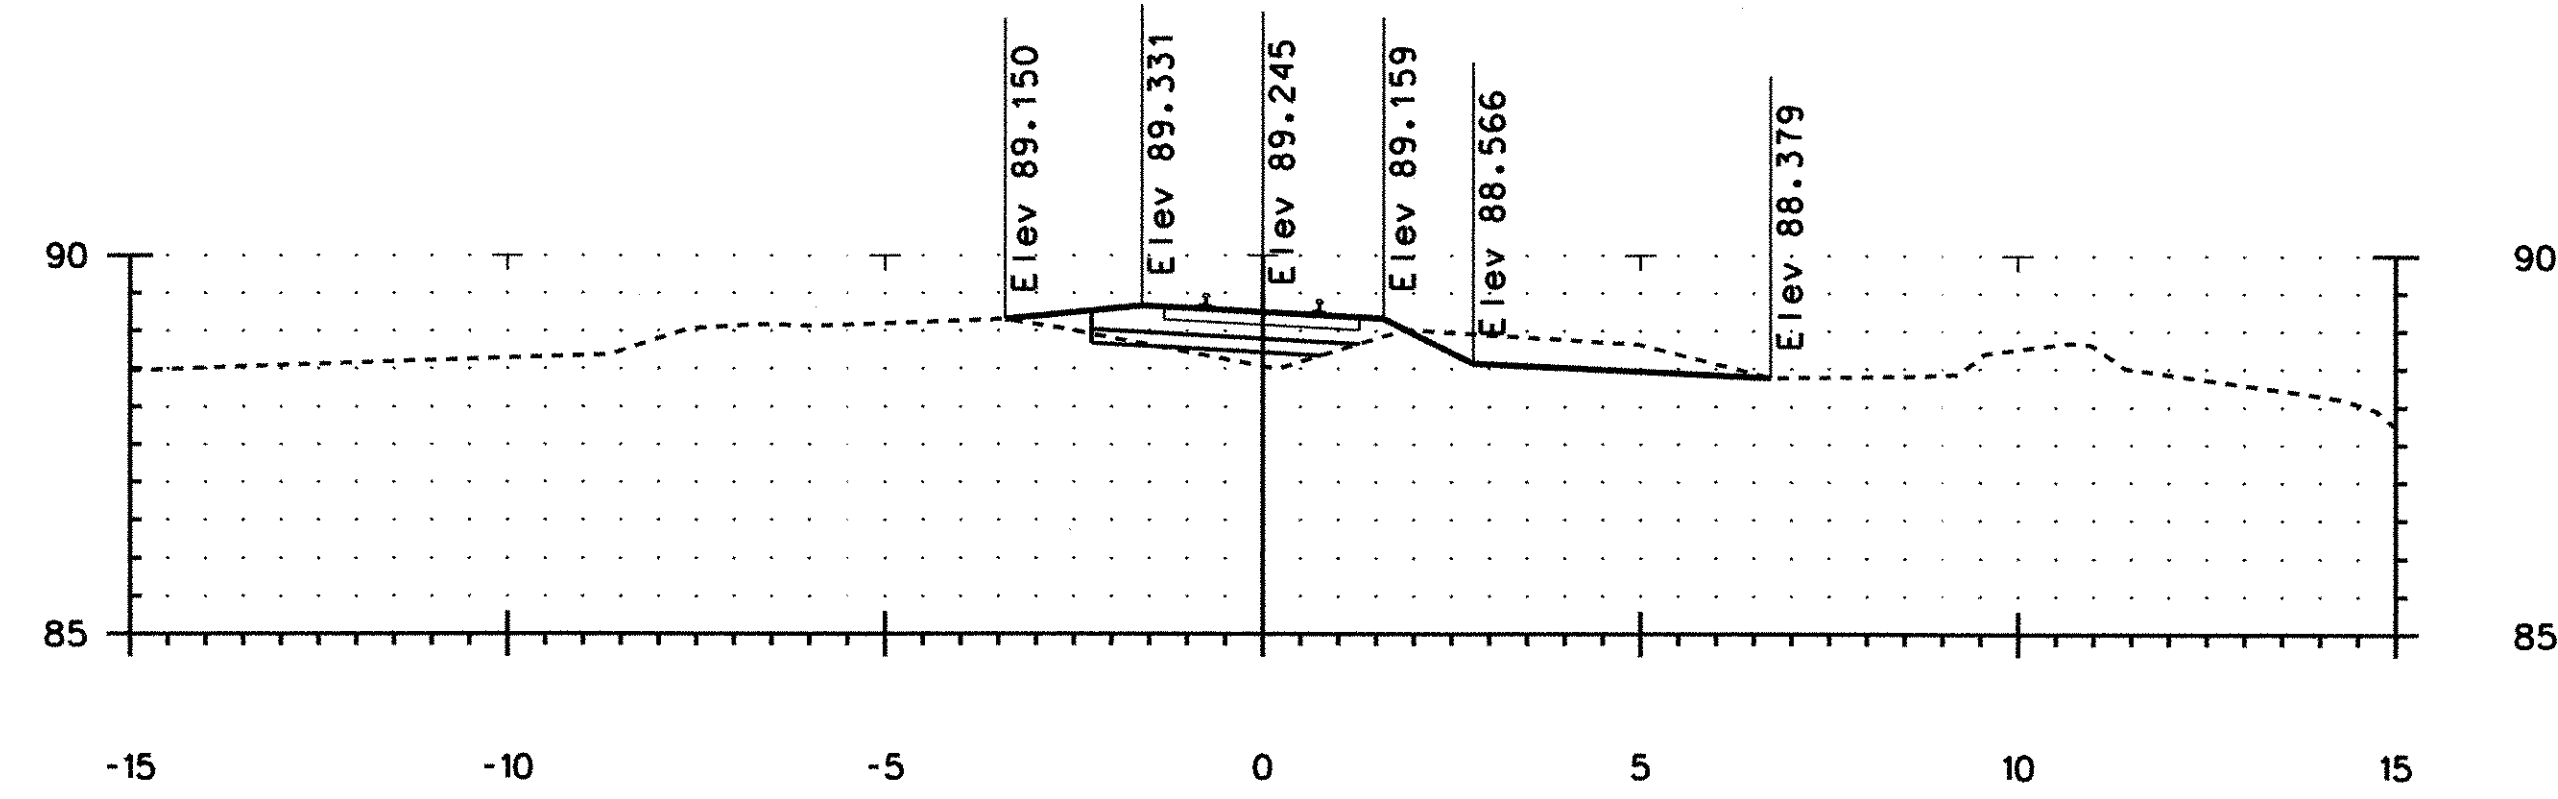


50+500.000

END FULL DEPTH CONSTRUCTION
BEGIN TRANSITION SECTION

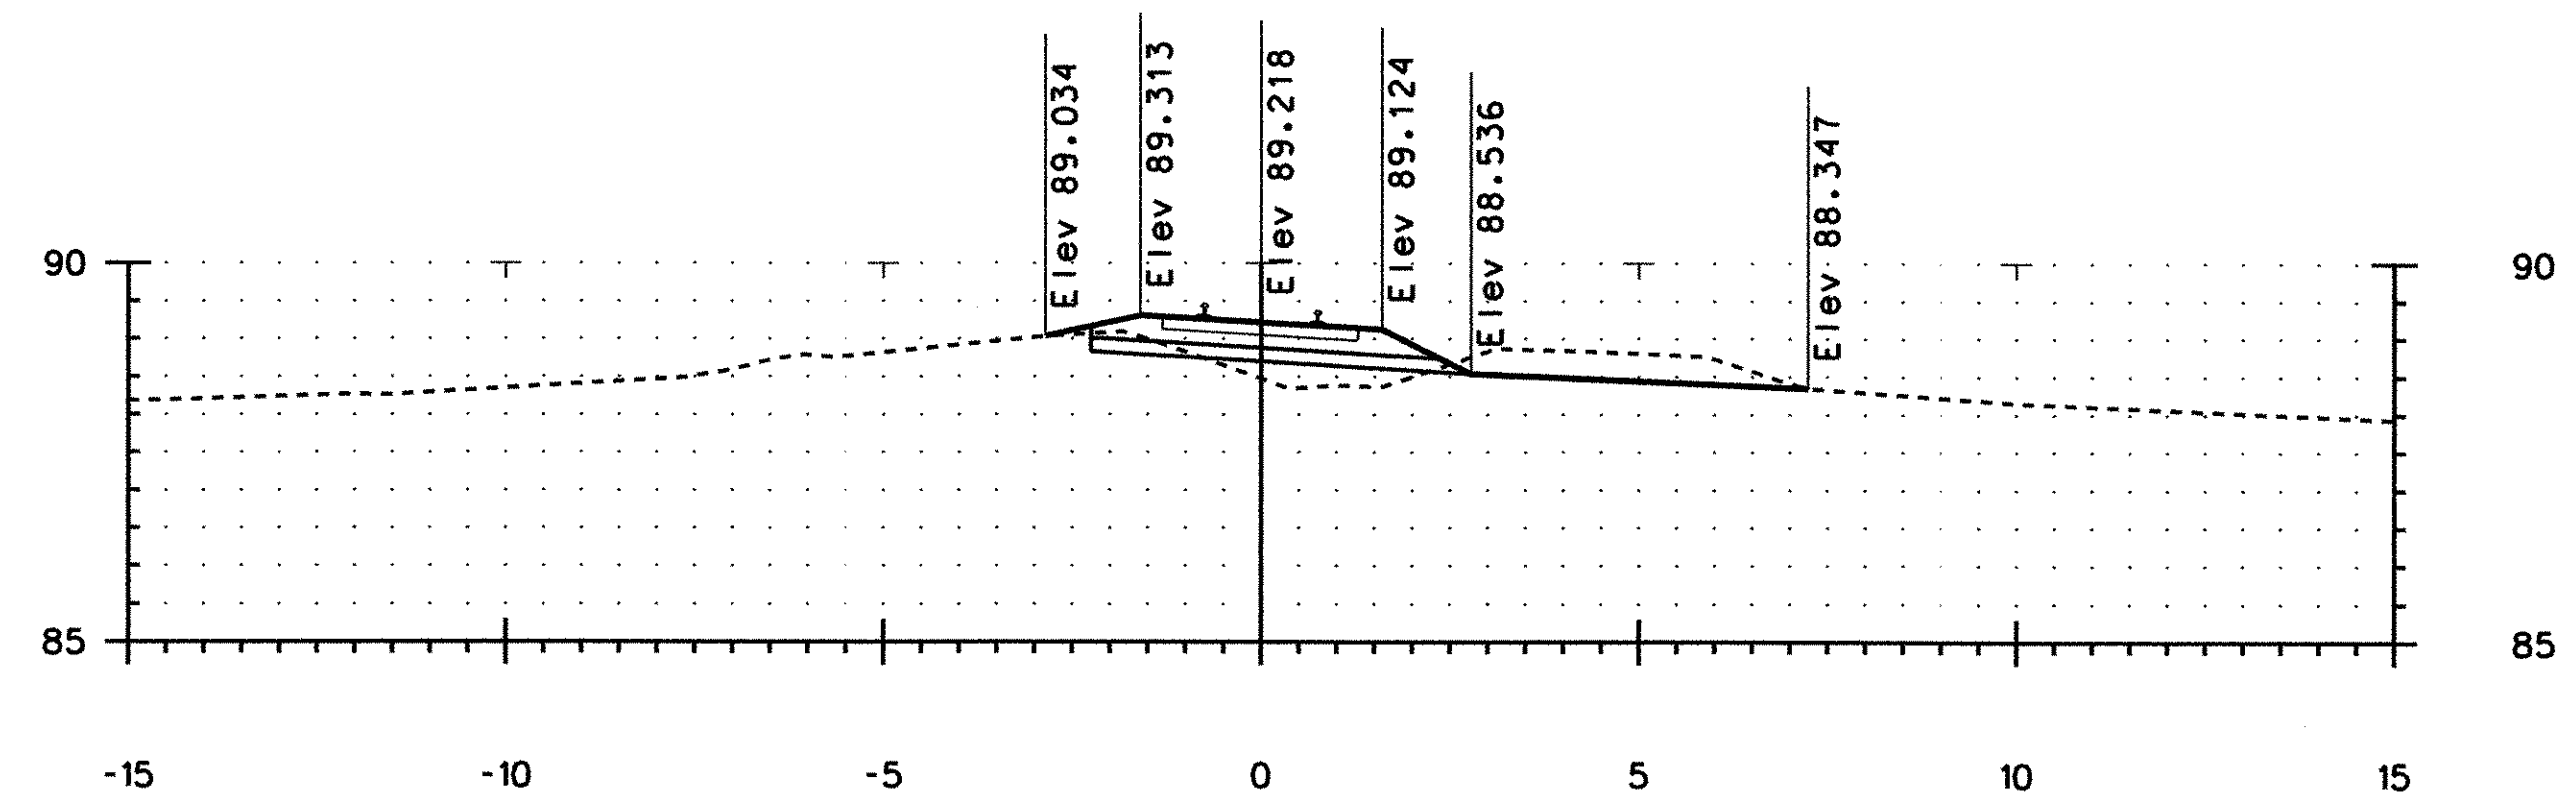


50+480.000

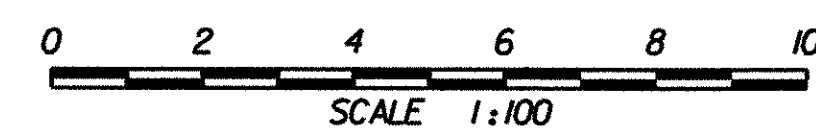


PROJECT: BRATTLEBORO	PROJECT NO.: NH 010-2(2)
DESIGN FILE NAME: U:\99123-Brattleboro\dgn\zb270xs1.dgn	IPARM FILE NAME:
	PLOT DATE: 10-02-2002
FROM STA: 50+480.000 TO STA: 50+500.000 SHEET: 128 OF 145	

RAILROAD CROSS SECTIONS

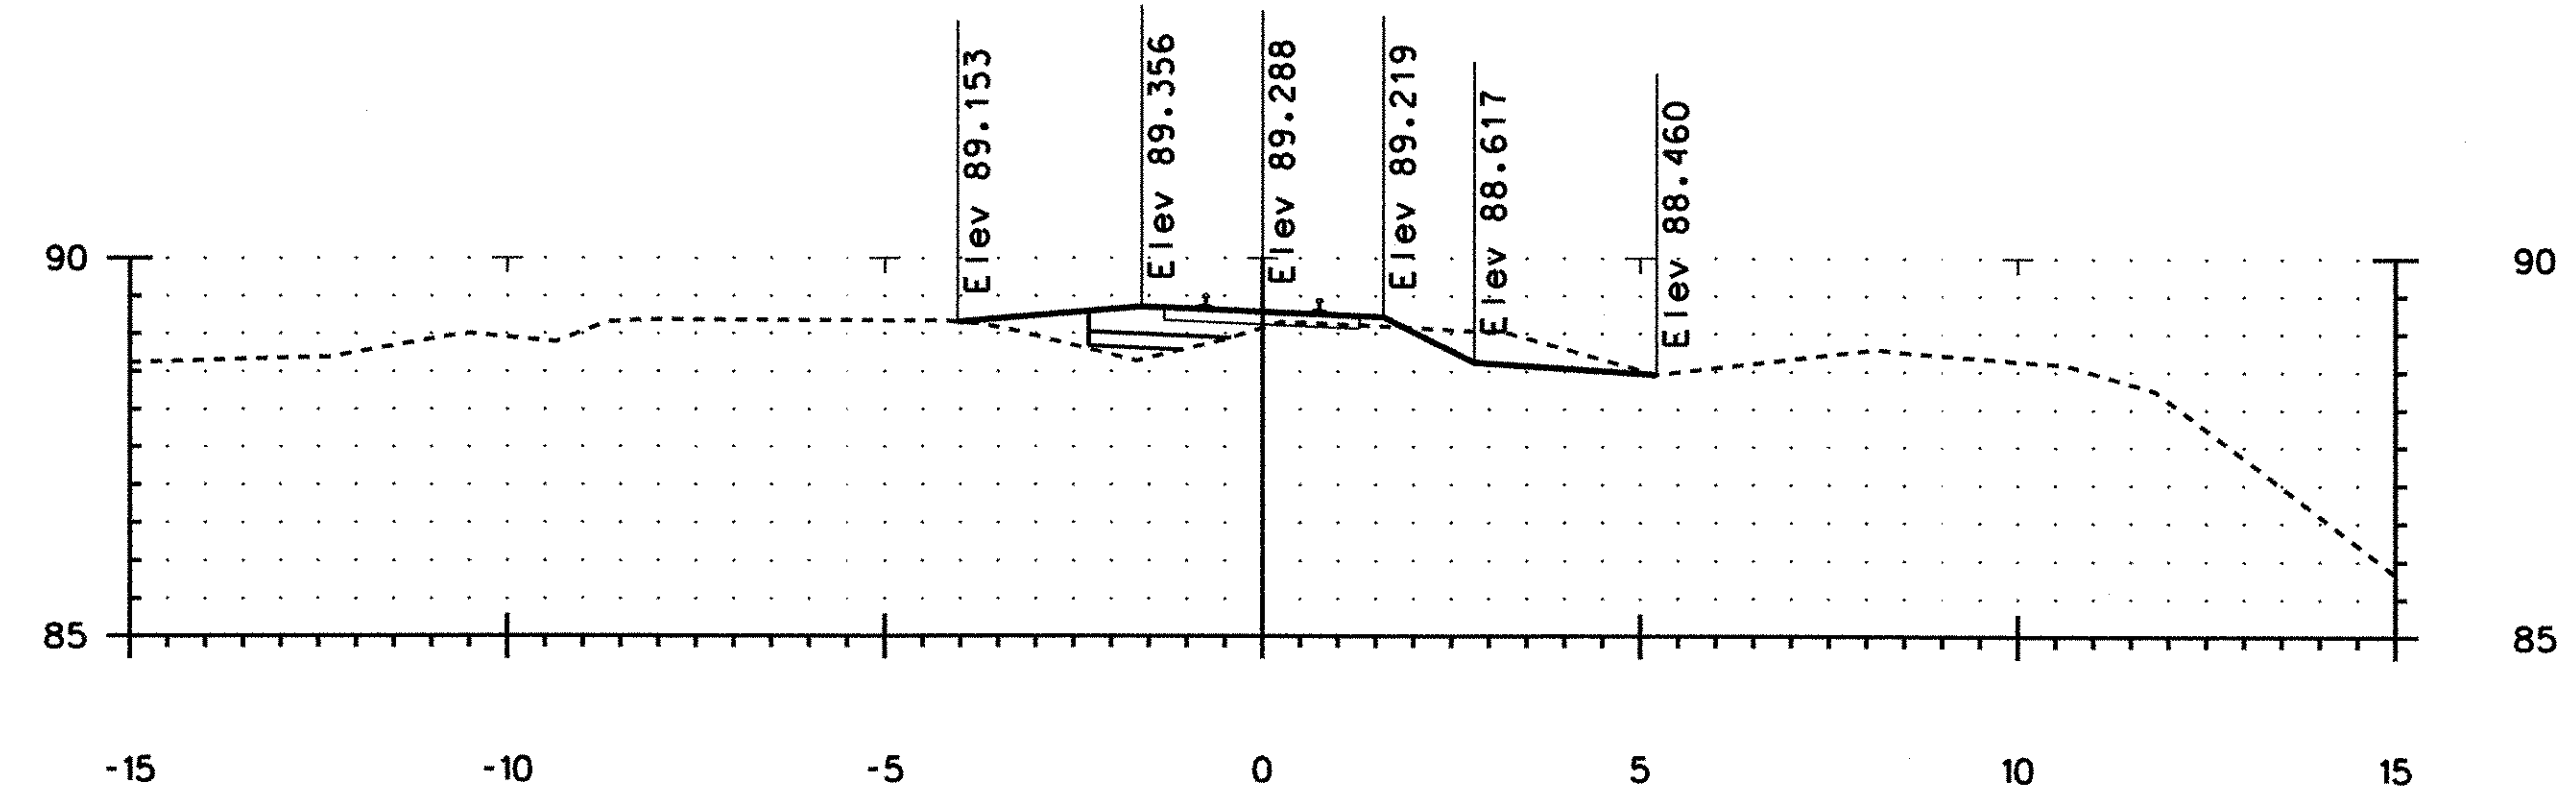

50+540.000

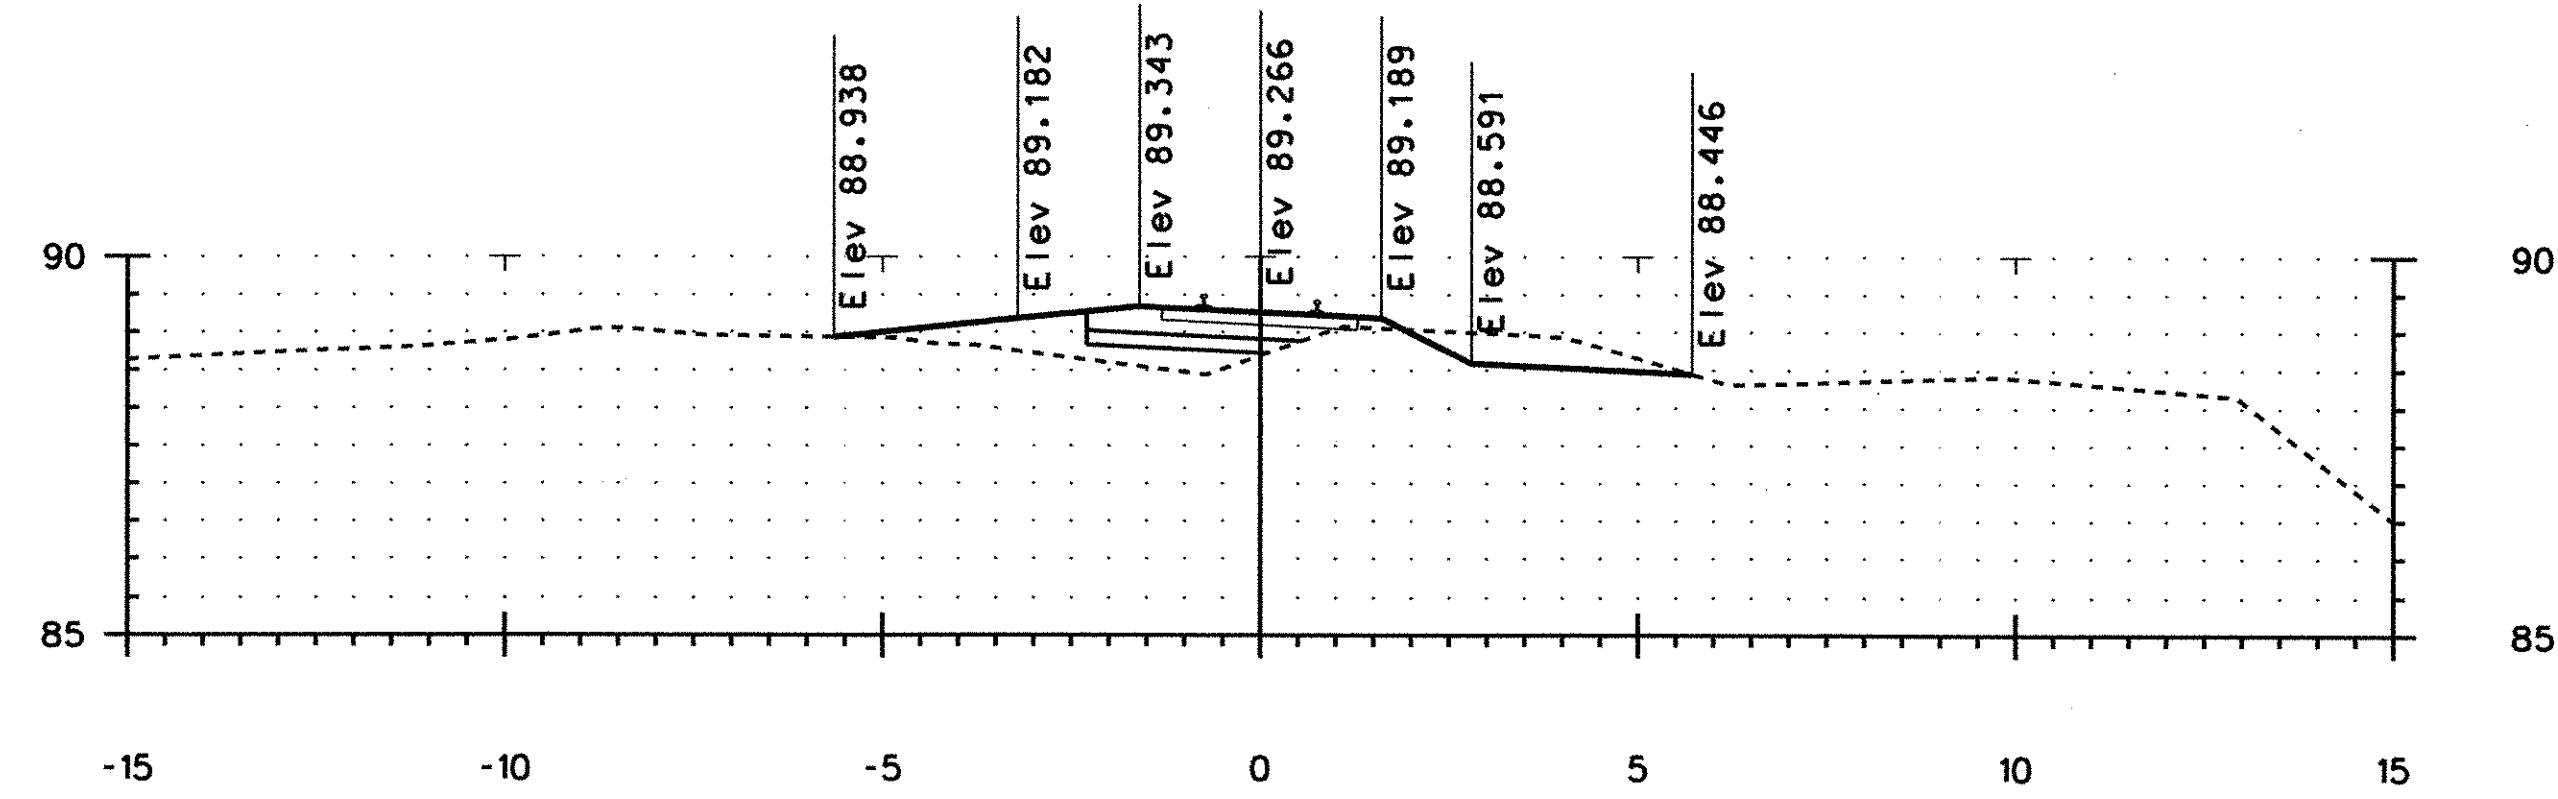


50+520.000




PROJECT:	BRATTLEBORO	PROJECT NO.:	NH 010-2(2)
DESIGN FILE NAME:	U:\99123-Brattleboro\dgn\zb270xs1.dgn		
IPARM FILE NAME:	PLOT DATE: 10-02-2002		
FROM STA: 50+520.000 TO STA: 50+540.000 SHEET: 129 OF 145			

RAILROAD CROSS SECTIONS

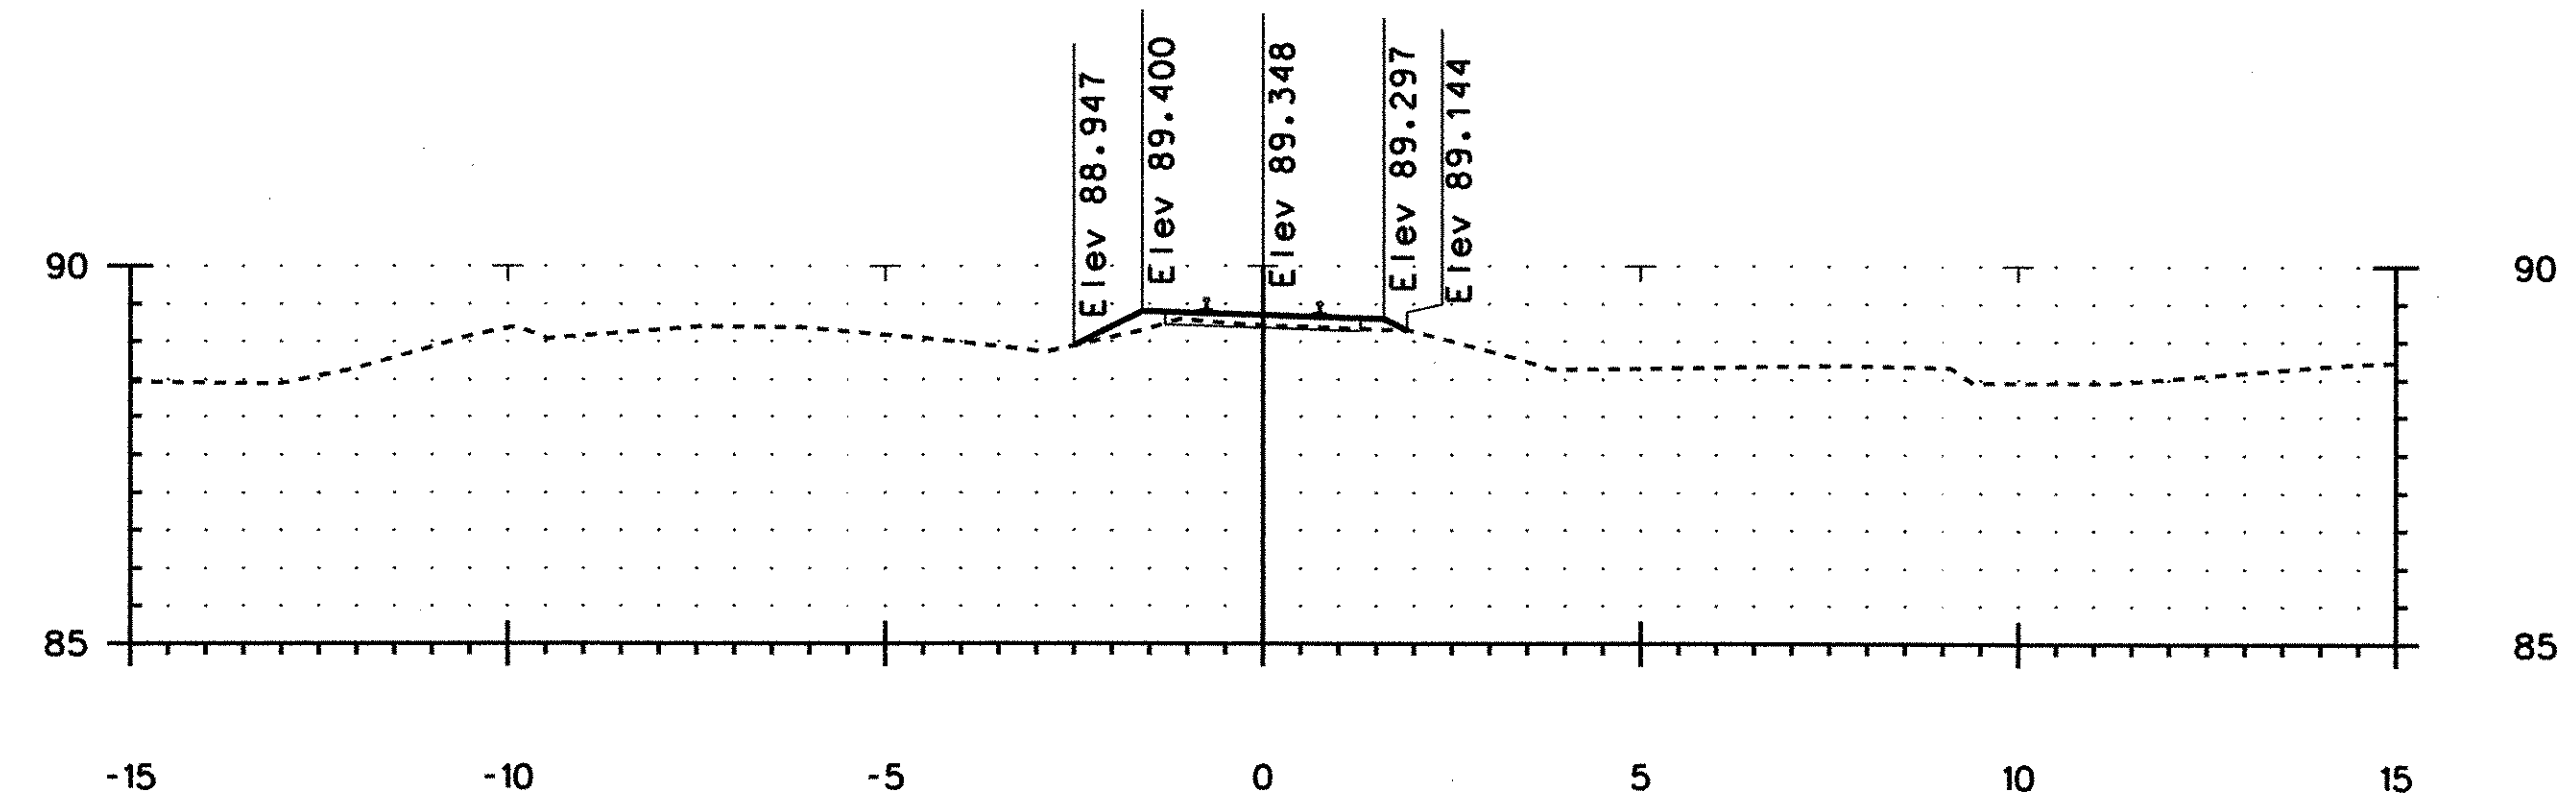

50+580.000

END TRANSITION SECTION
BEGIN TRACK REHABILITATION


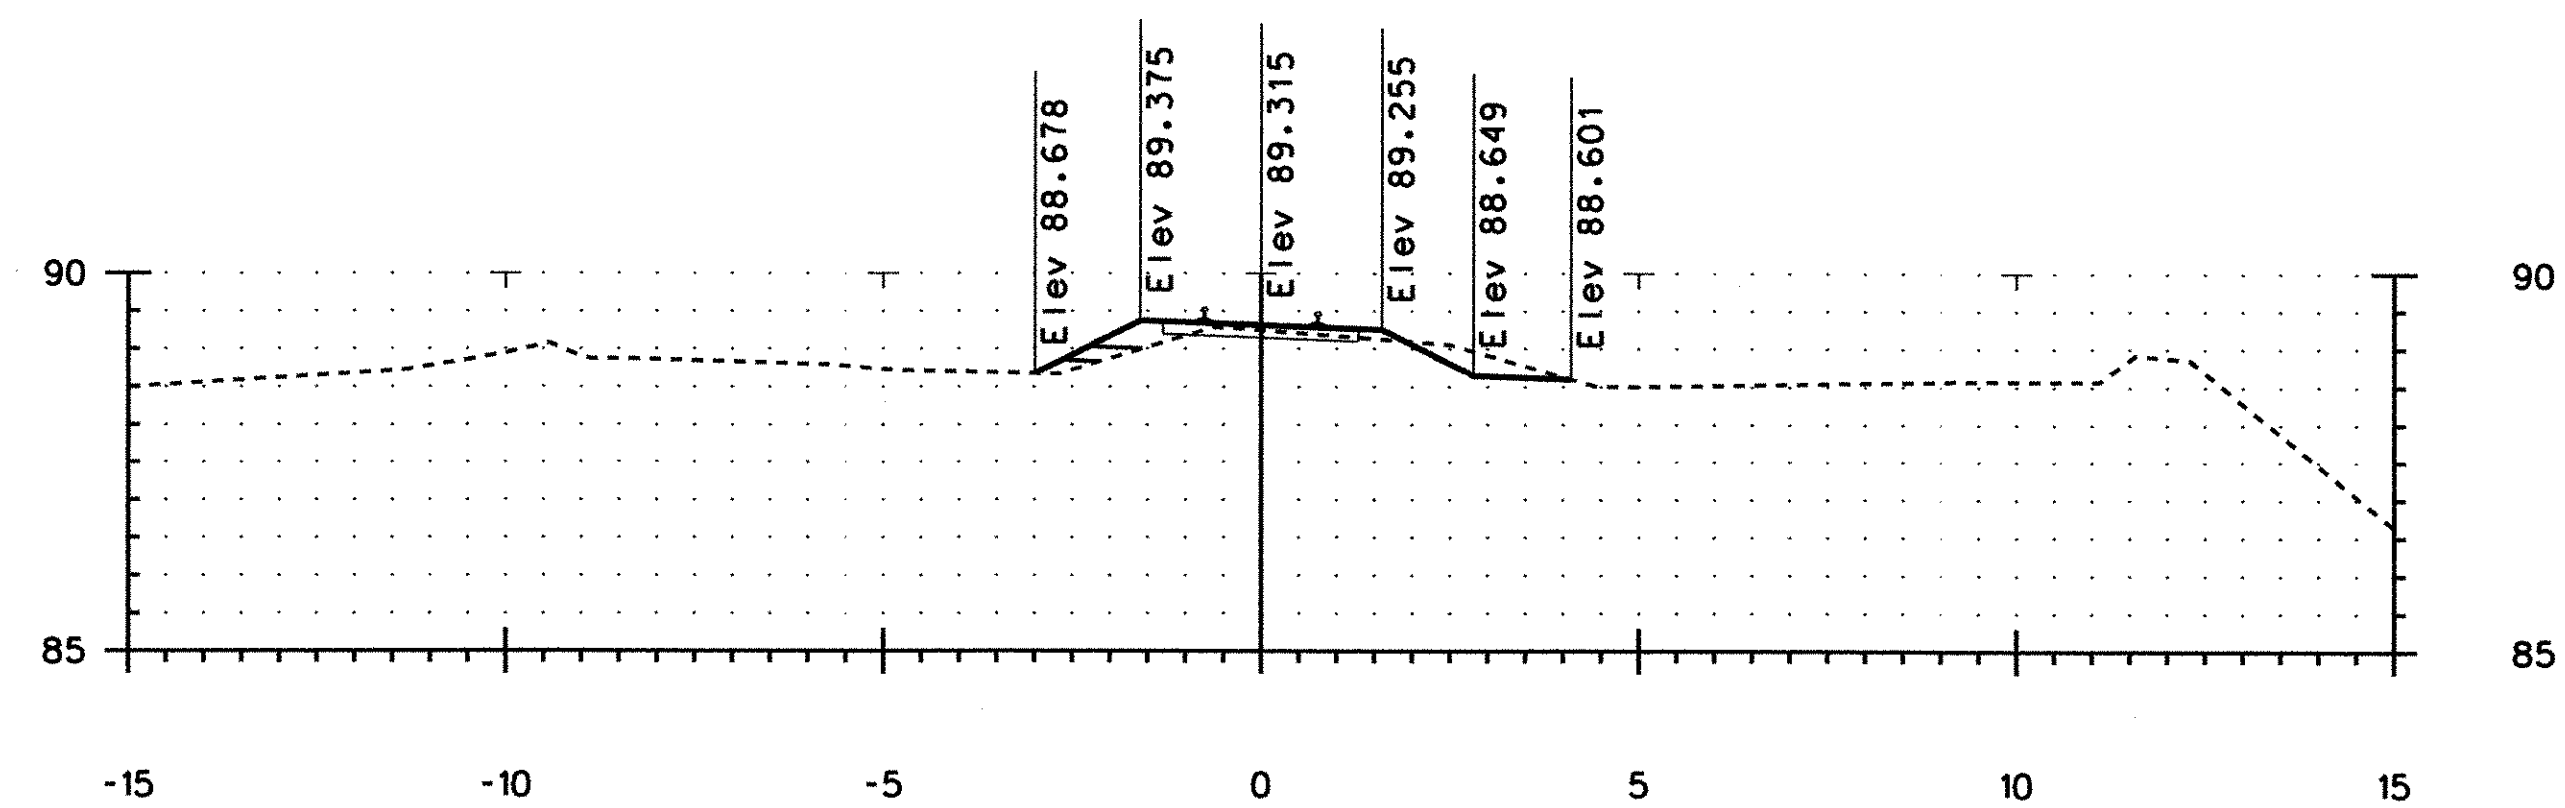


50+560.000






PROJECT:	BRATTLEBORO	PROJECT NO.:	NH 010-2(2)
DESIGN FILE NAME:	U:\99123-Brattleboro\dgn\zb270xs1.dgn		
IPARM FILE NAME:	PLOT DATE: 10-02-2002		
FROM STA: 50+560.000 TO STA: 50+580.000 SHEET: 130 OF 145			

RAILROAD CROSS SECTIONS

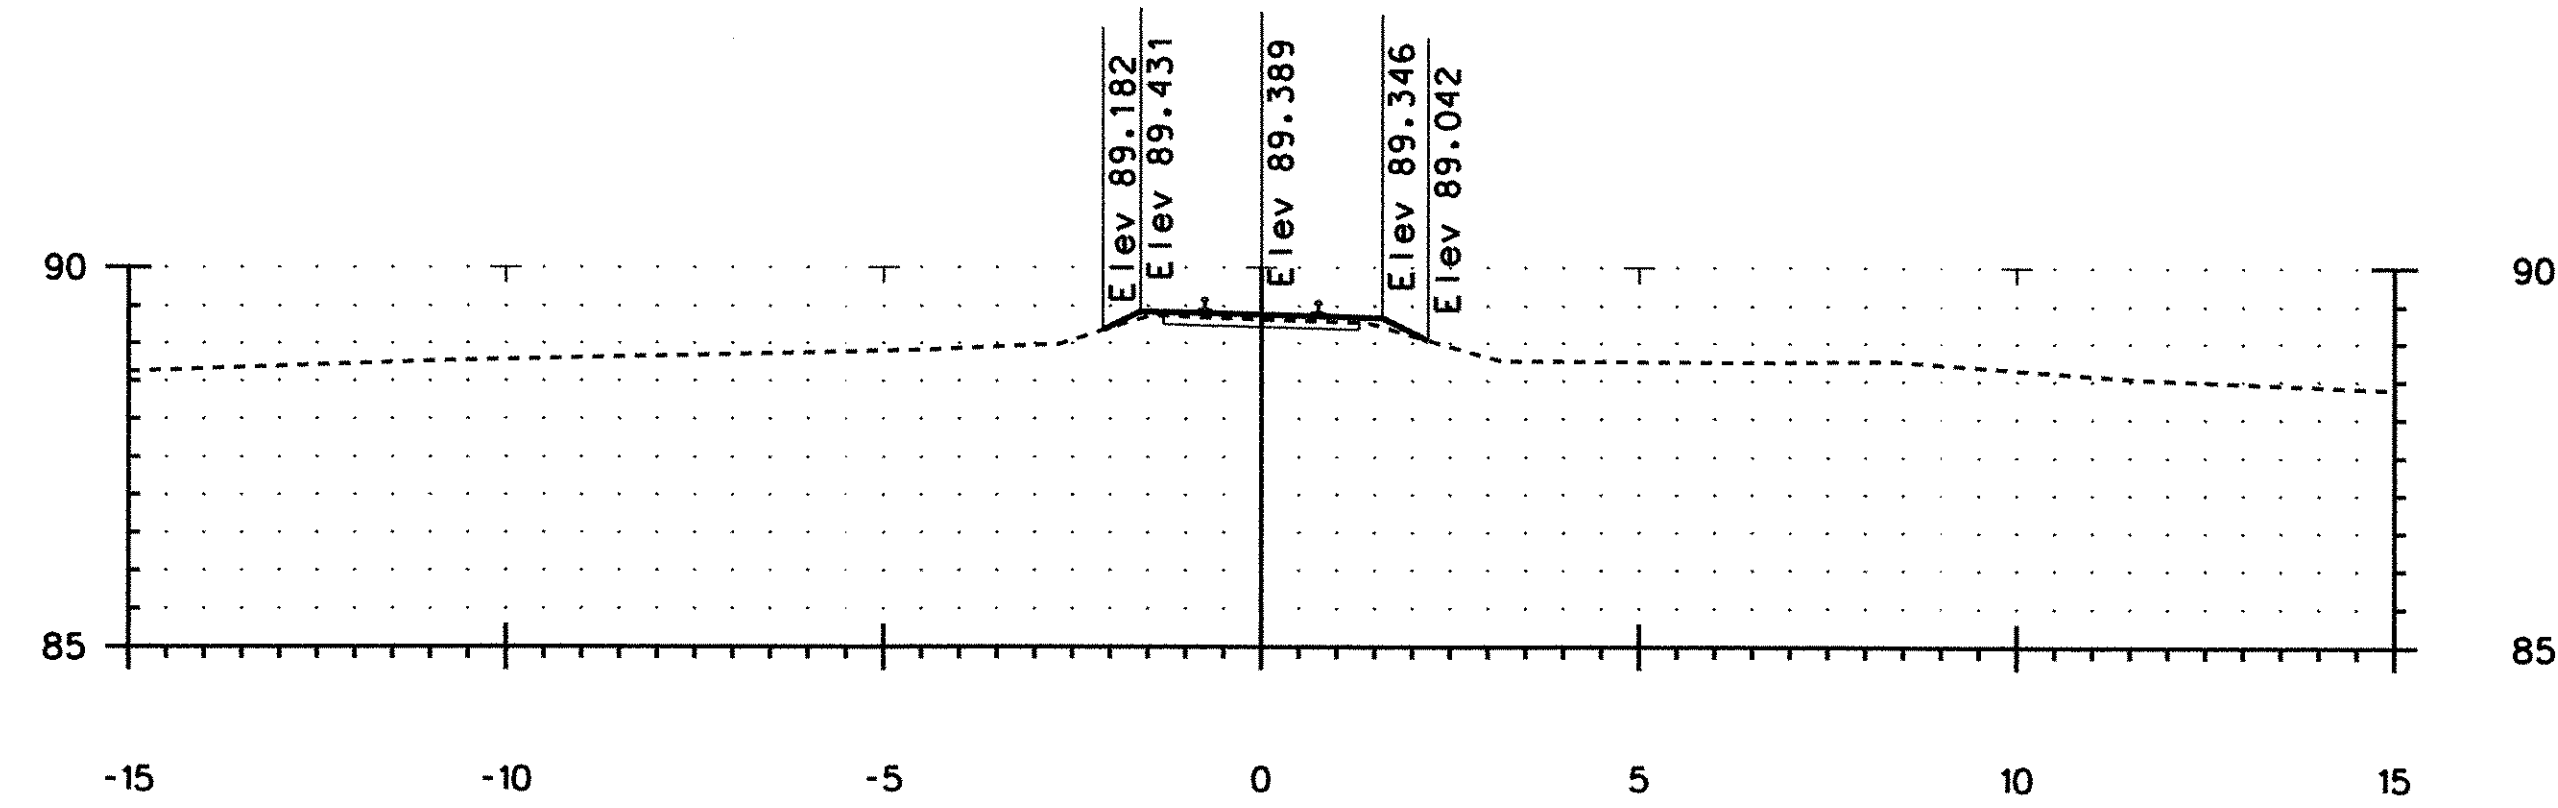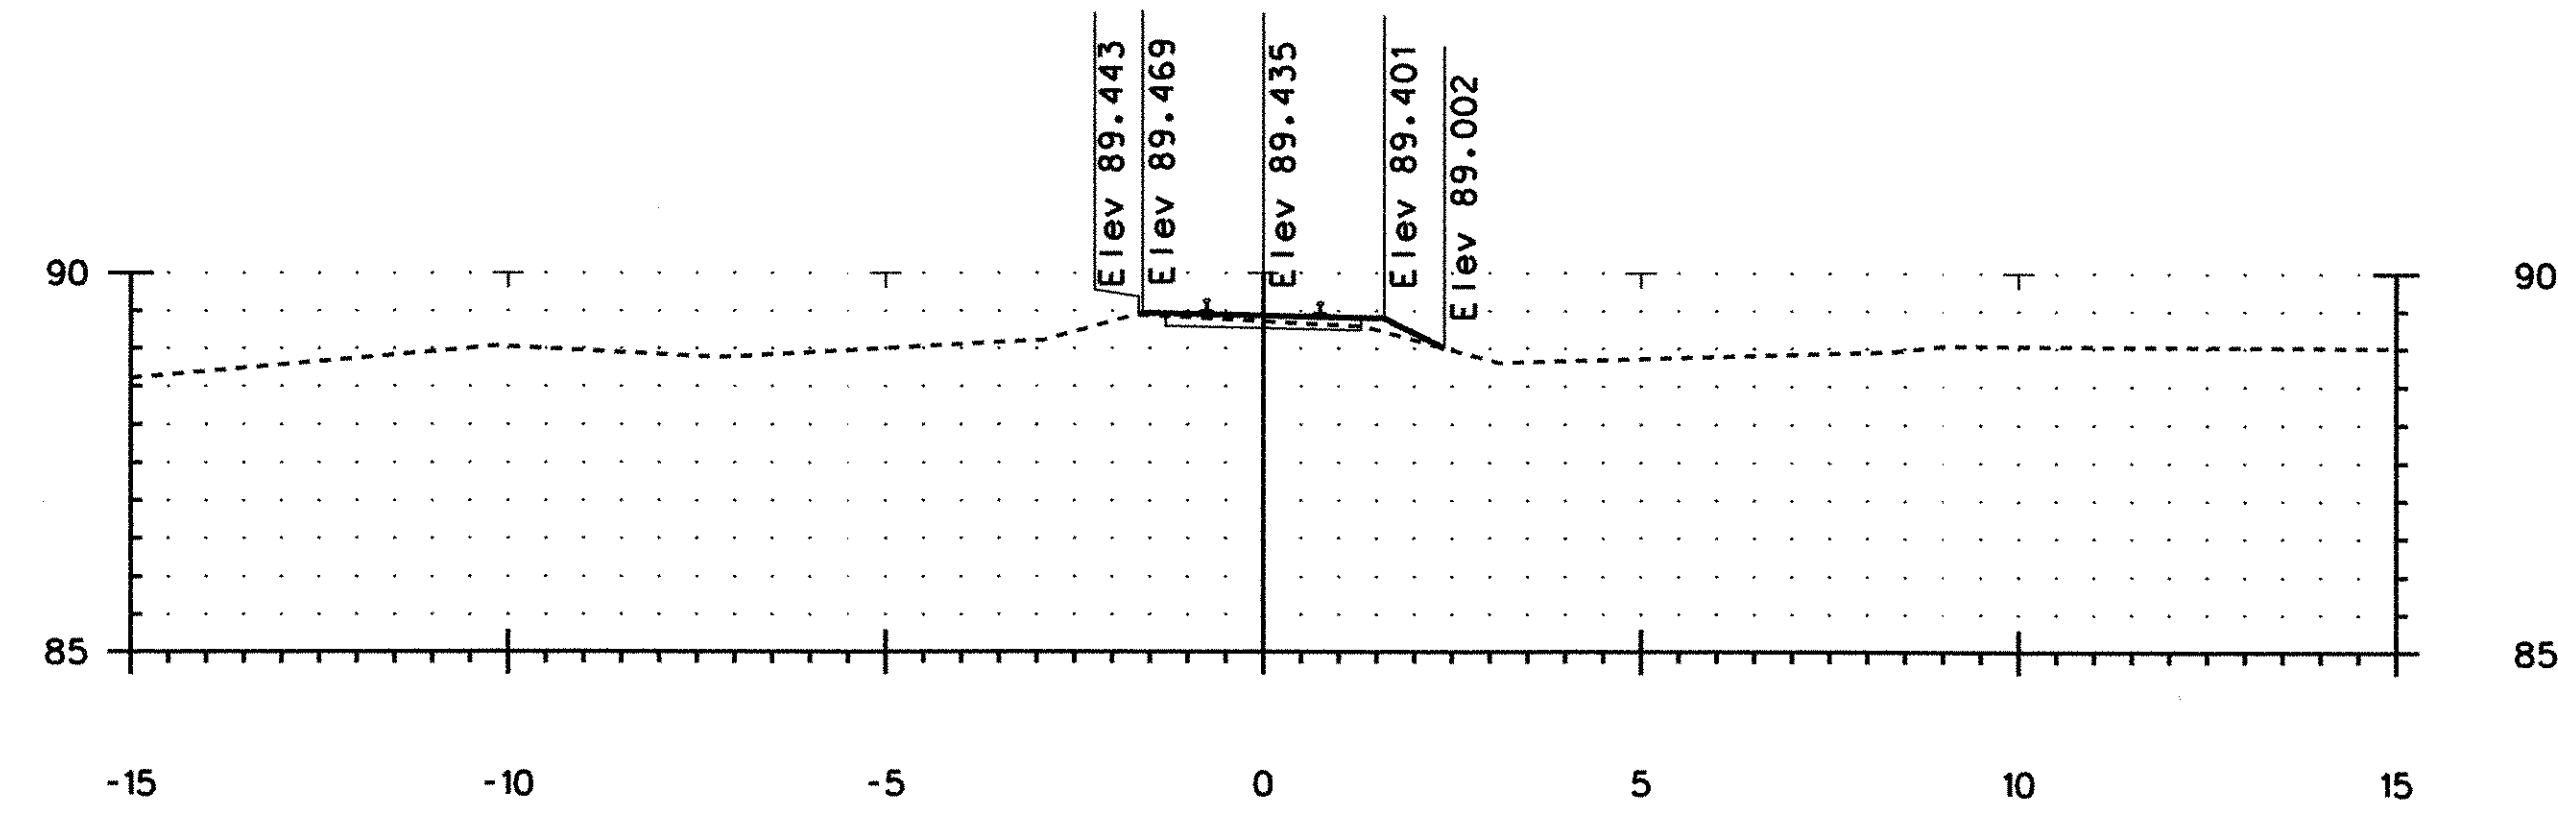


PROJECT:	BRATTLEBORO	PROJECT NO.:	NH 010-2(2)
DESIGN FILE NAME:	U:\99123-Brattleboro\dgn\b270xs1.dgn		
IPARM FILE NAME:	PLOT DATE: 10-02-2002		
FROM STA: 50-600.000 TO STA: 50-620.000 SHEET: 131 OF 145			

RAILROAD CROSS SECTIONS

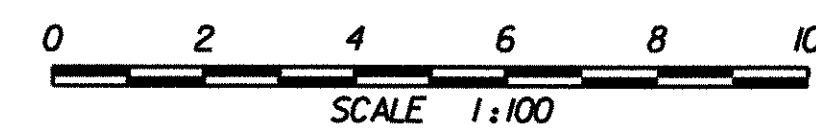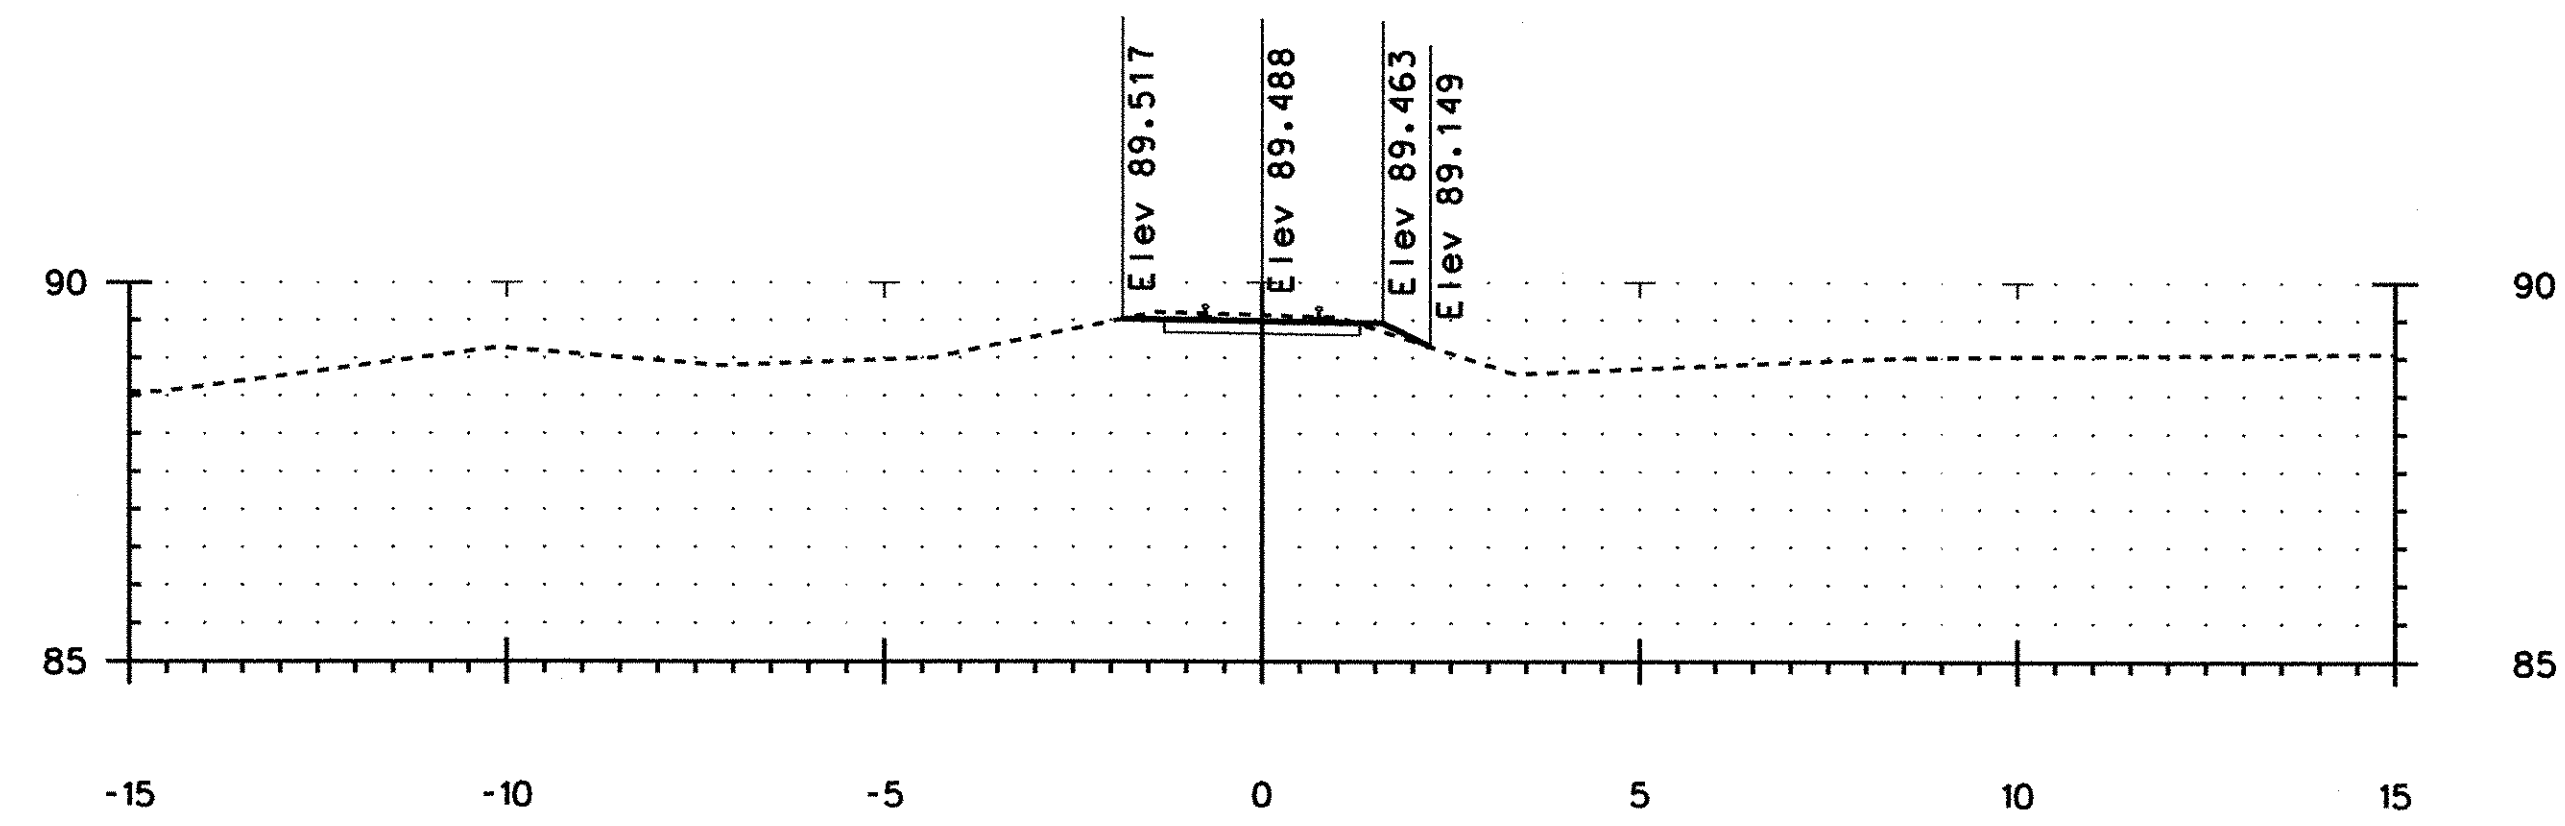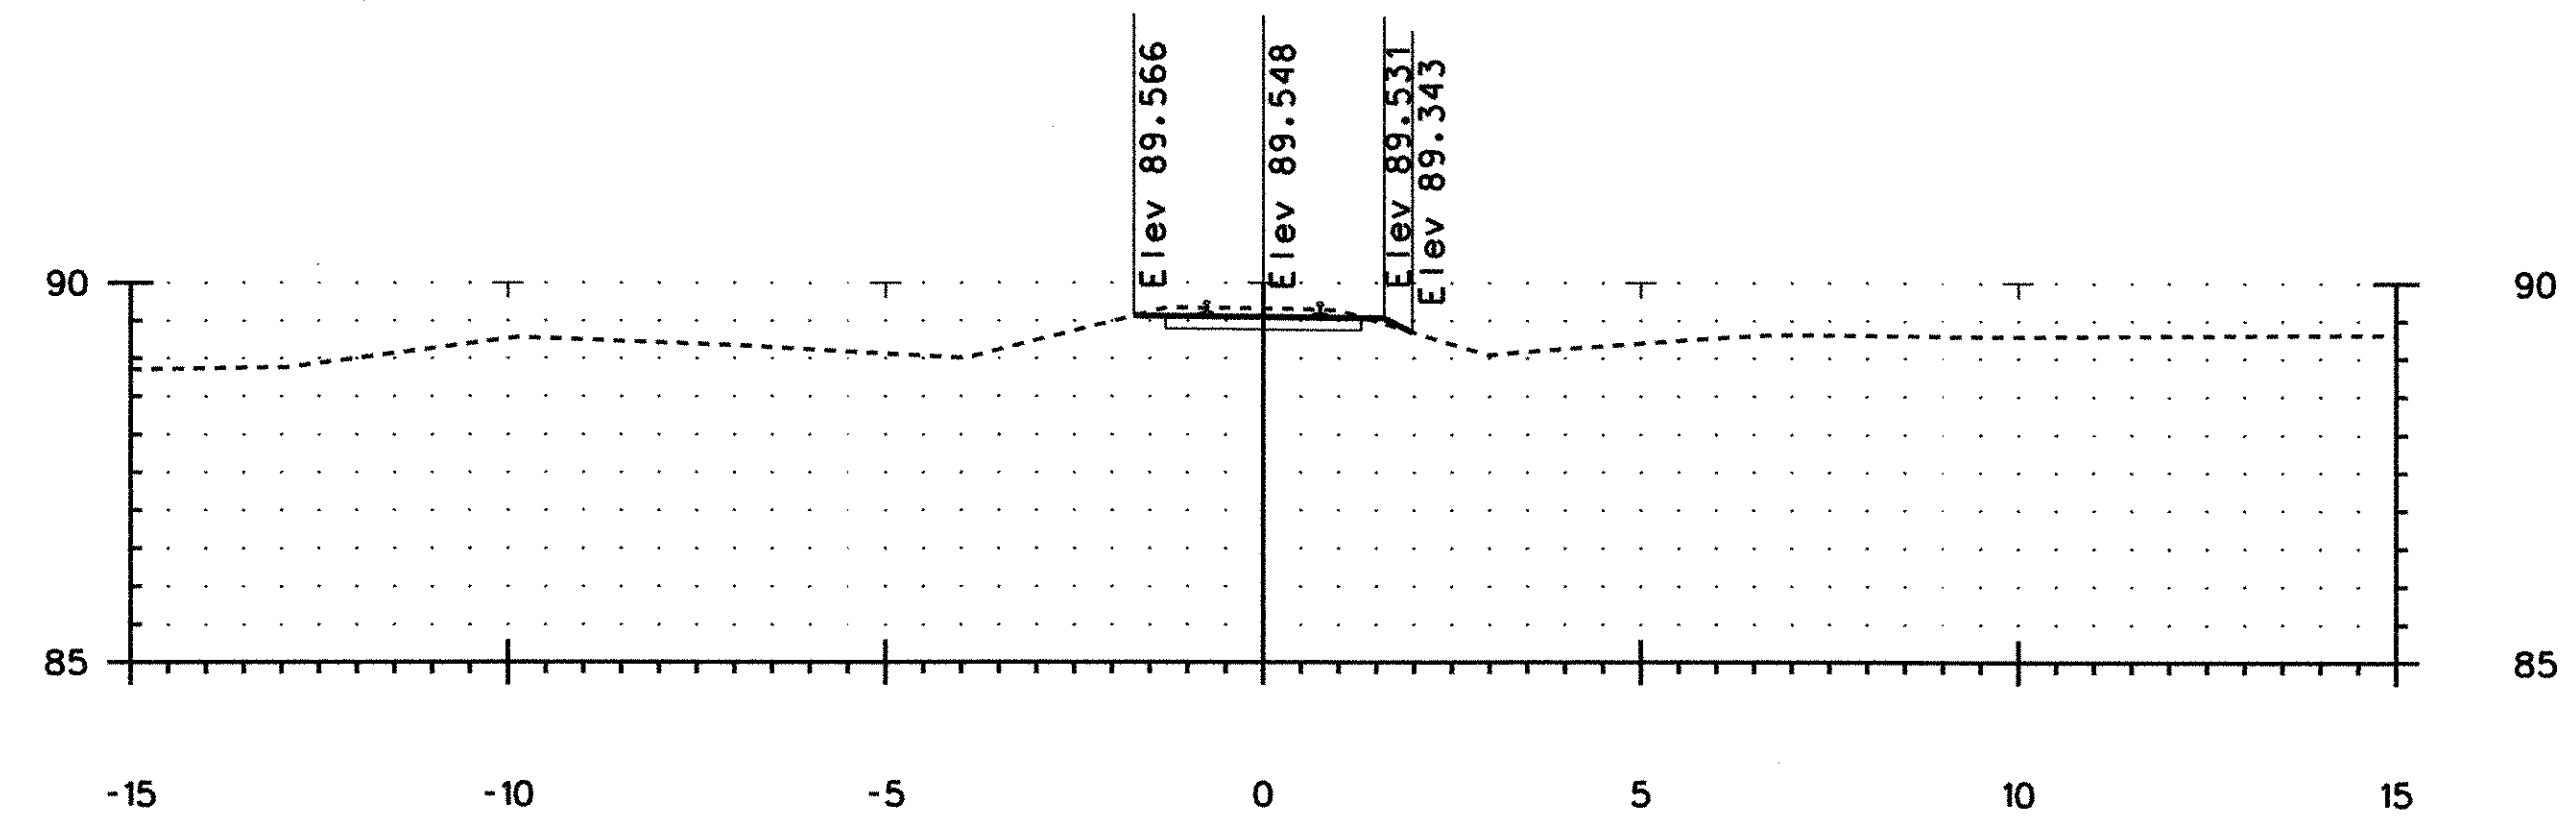


PROJECT:	BRATTLEBORO	PROJECT NO.:	NH 010-2(2)
DESIGN FILE NAME:	U:\99123-Brattleboro\dgn\zb270xs1.dgn		
IPARM FILE NAME:	PLOT DATE: 10-02-2002		
FROM STA: 50+640.000 TO STA: 50+660.000 SHEET: 132 OF 145			

RAILROAD CROSS SECTIONS

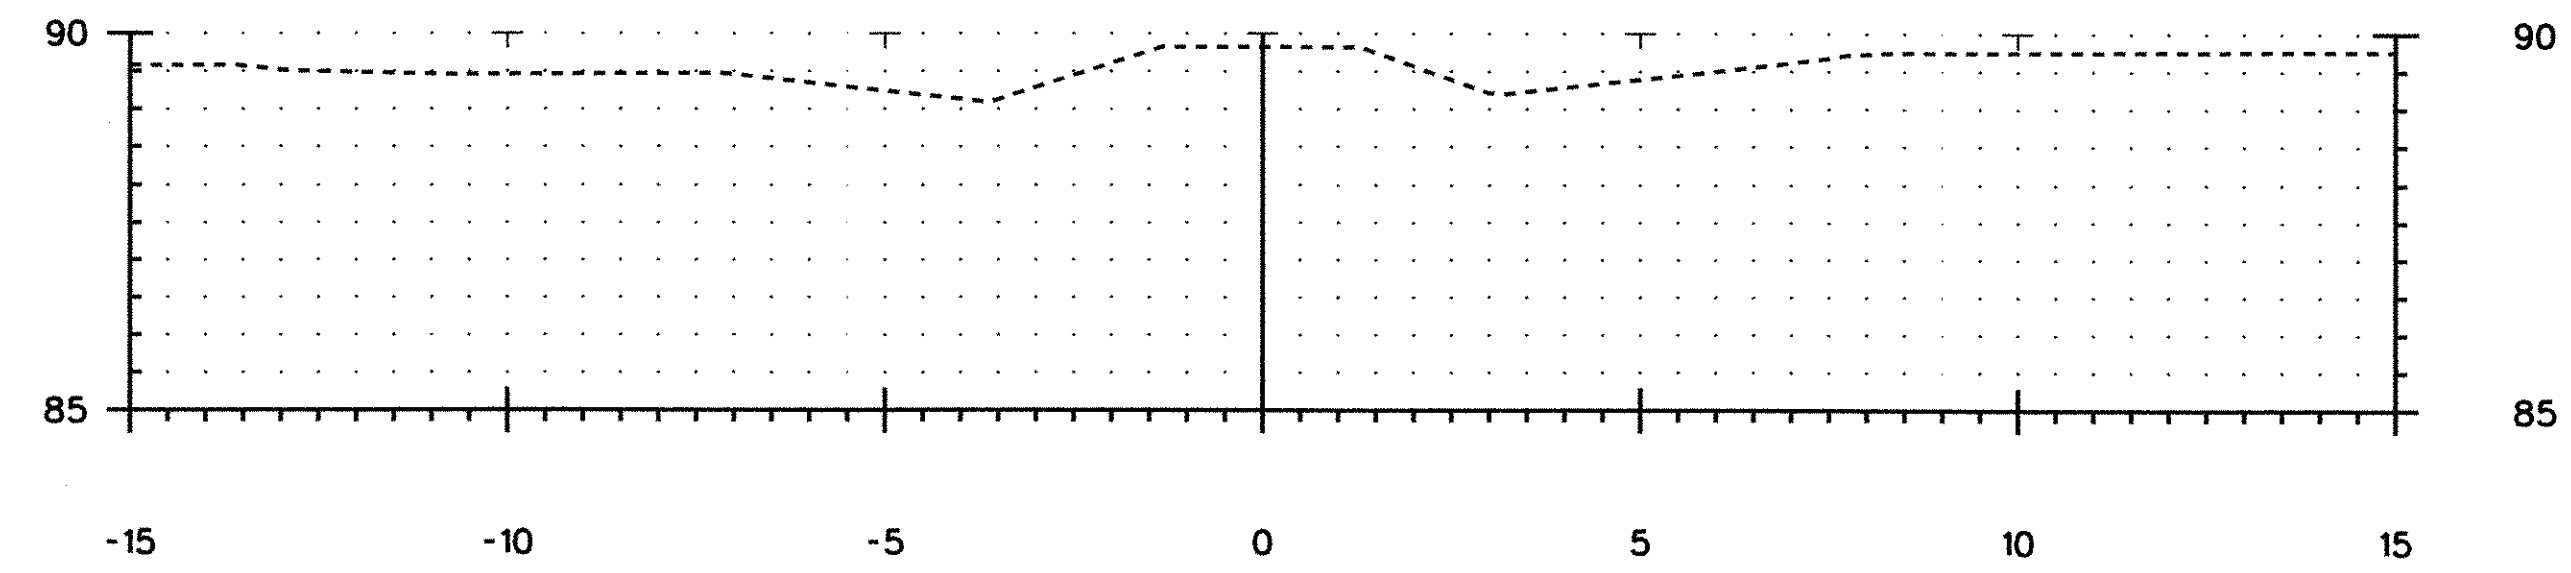


50+700.000

END OF RAILROAD CONSTRUCTION
MEET EXISTING AT STA. 50+698.603
END TRACK REHABILITATION

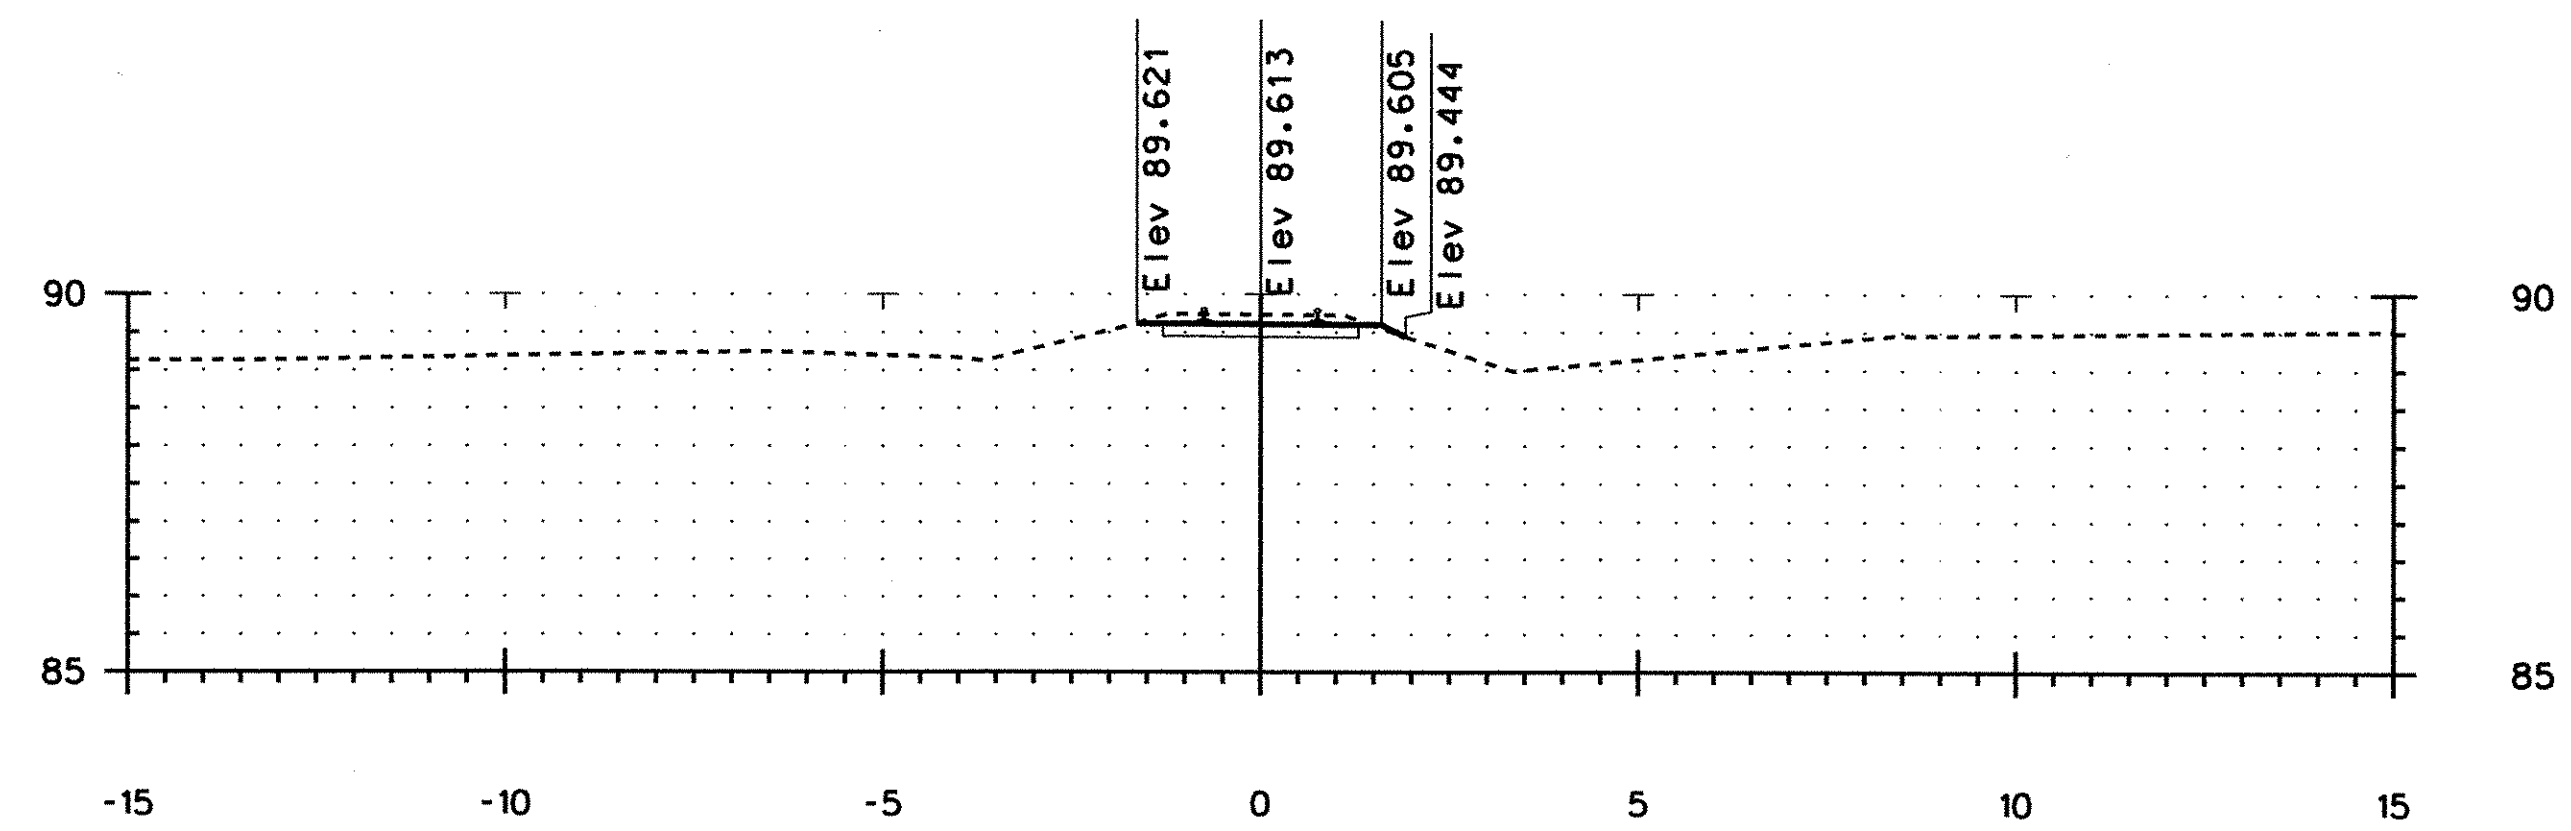


50+680.000

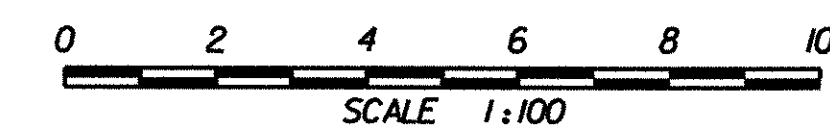


PROJECT:	BRATTLEBORO	PROJECT NO.:	NH 010-2(2)
DESIGN FILE NAME:	U:\99123-Brattleboro\dgn\zb270xs1.dgn		PLOT DATE: 10-02-2002
IPARM FILE NAME:			
FROM STA: 50-680.000 TO STA: 50-700.000 SHEET: 133 OF 145			

SARGENT BROOK CROSS SECTIONS

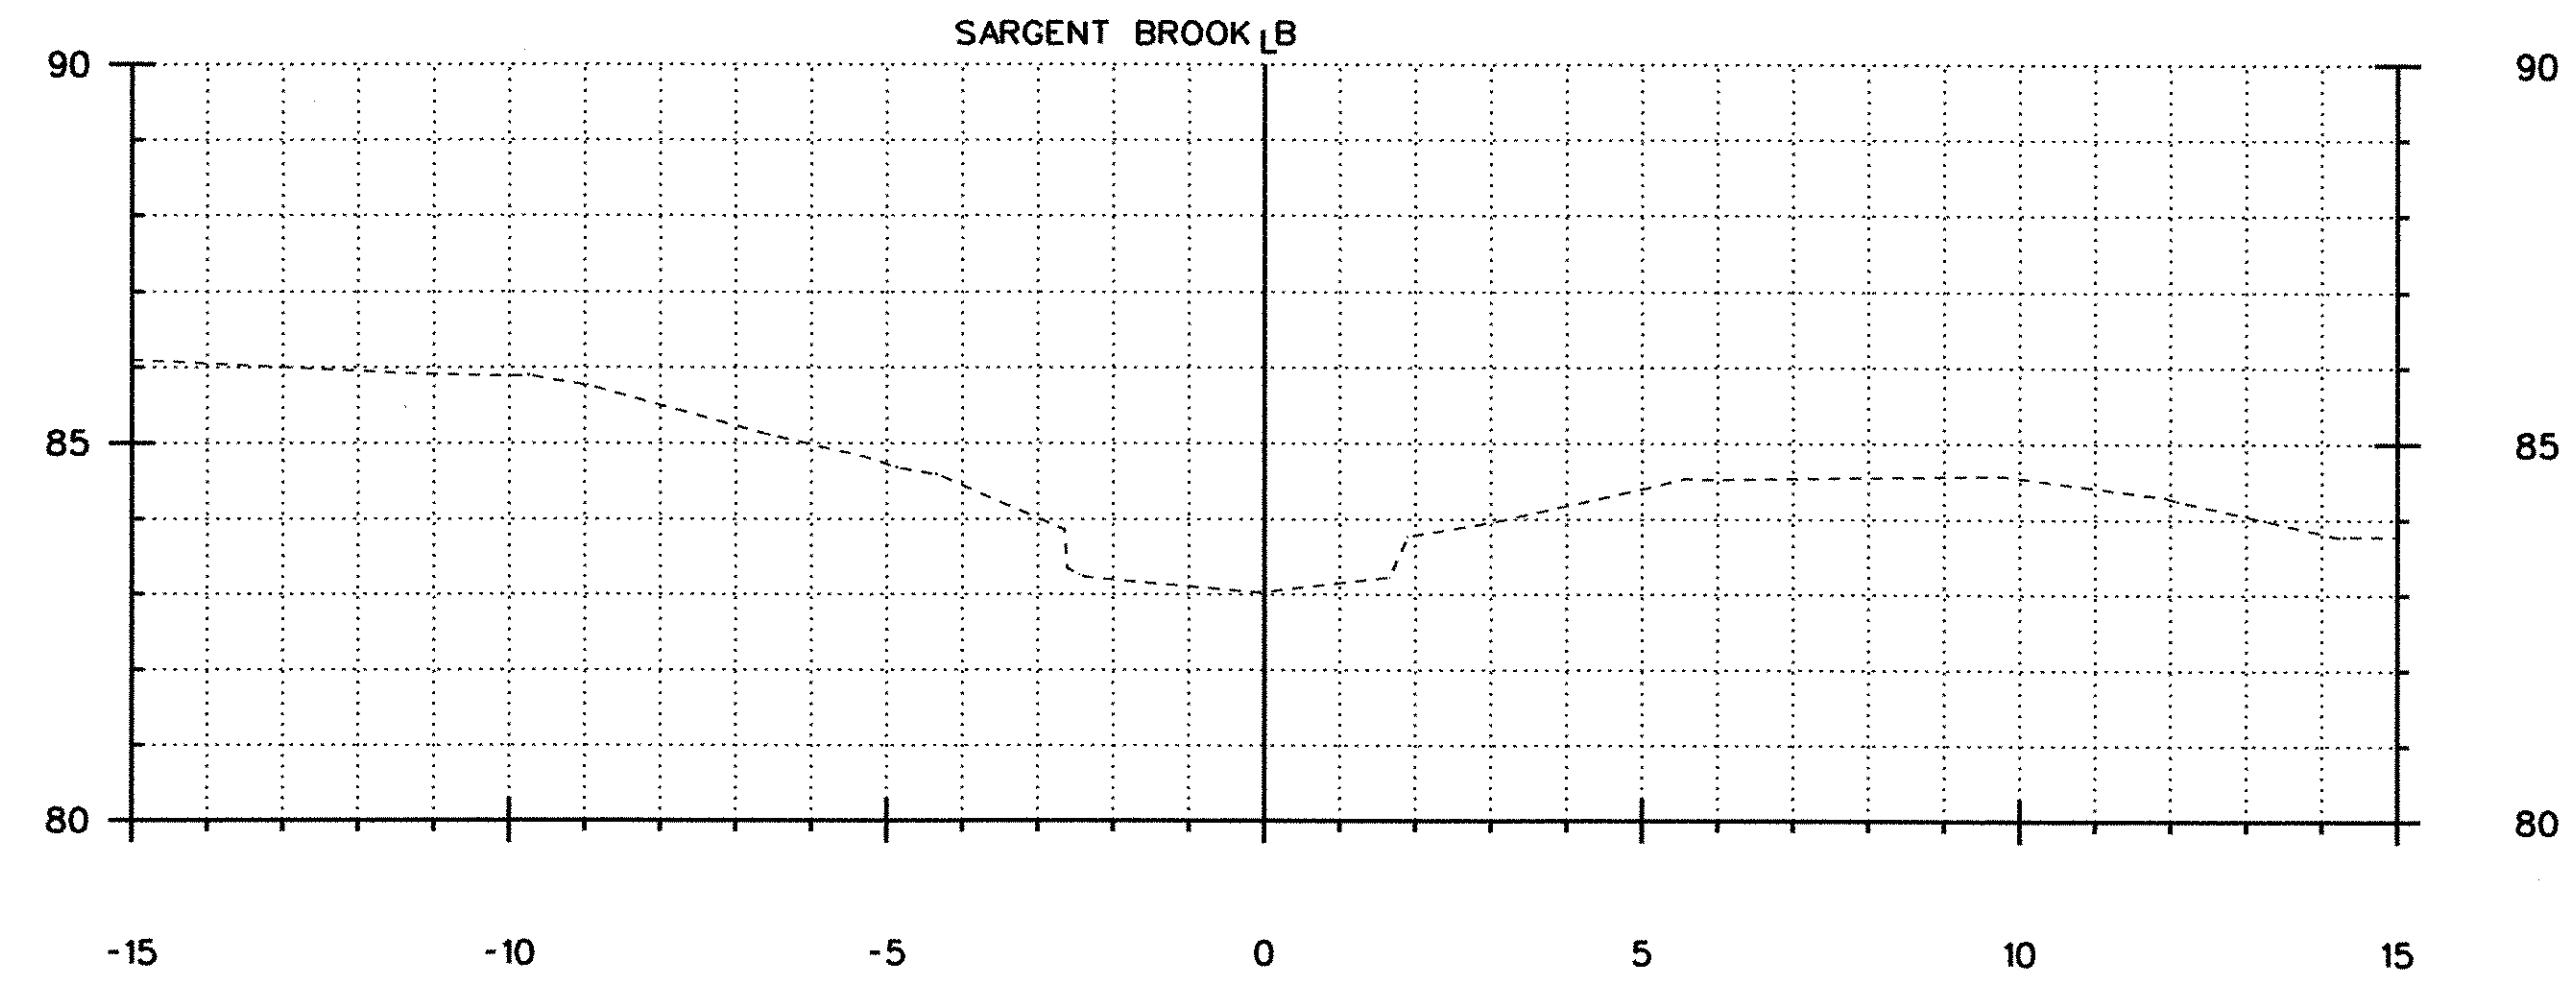

0+025.000


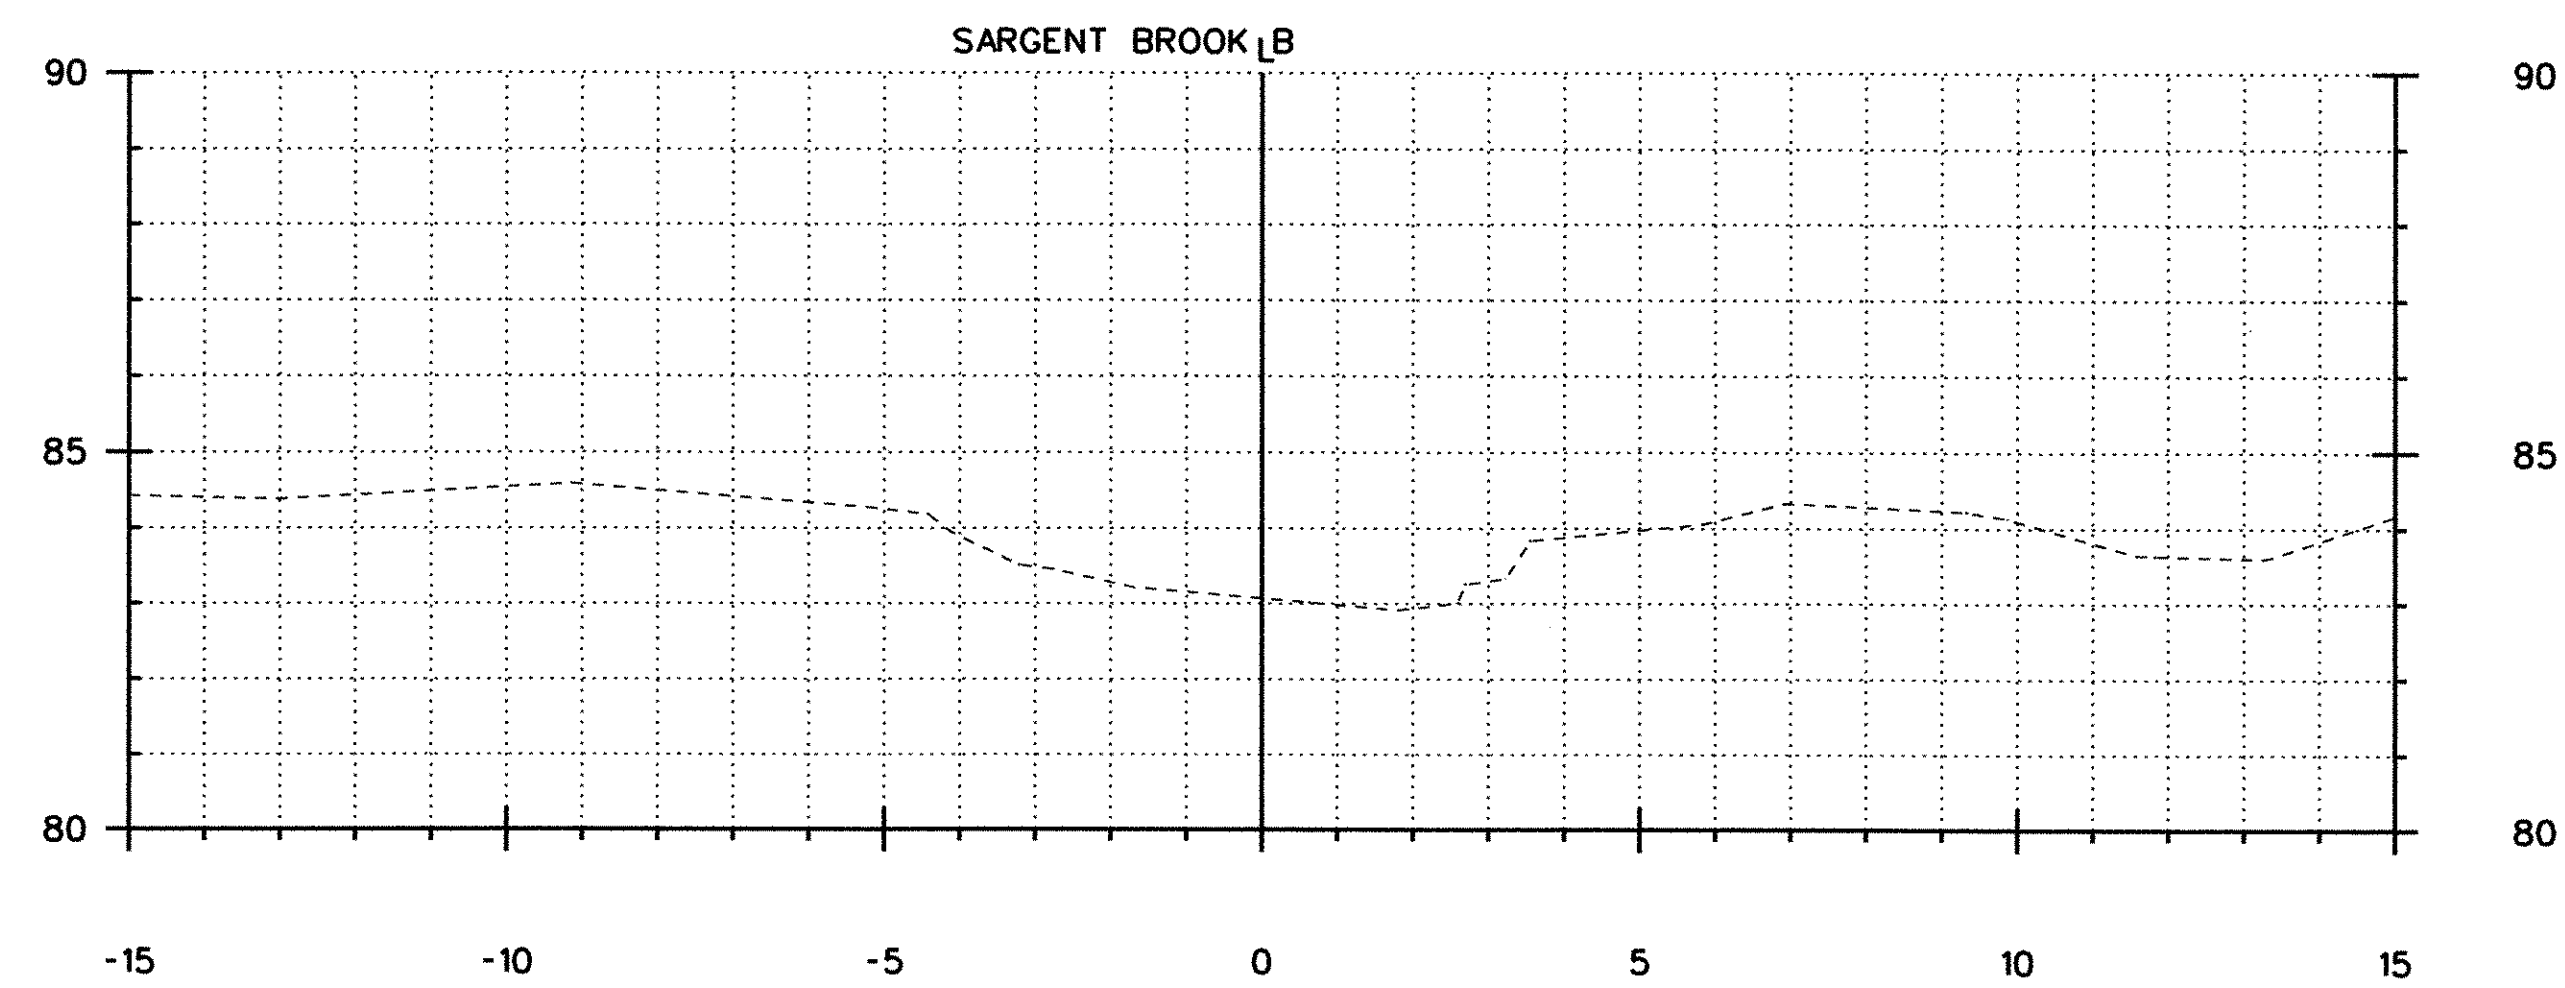


0+020.000





PROJECT:	BRATTLEBORO	PROJECT NO.:	NH 010-2(2)
DESIGN FILE NAME:	U:\99123-Brattleboro\dgn\b270xs1.dgn		PLOT DATE: 10-02-2002
IPARM FILE NAME:			
FROM STA: 0+020.000 TO STA: 0+025.000 SHEET: 134 OF 145			

SARGENT BROOK CROSS SECTIONS

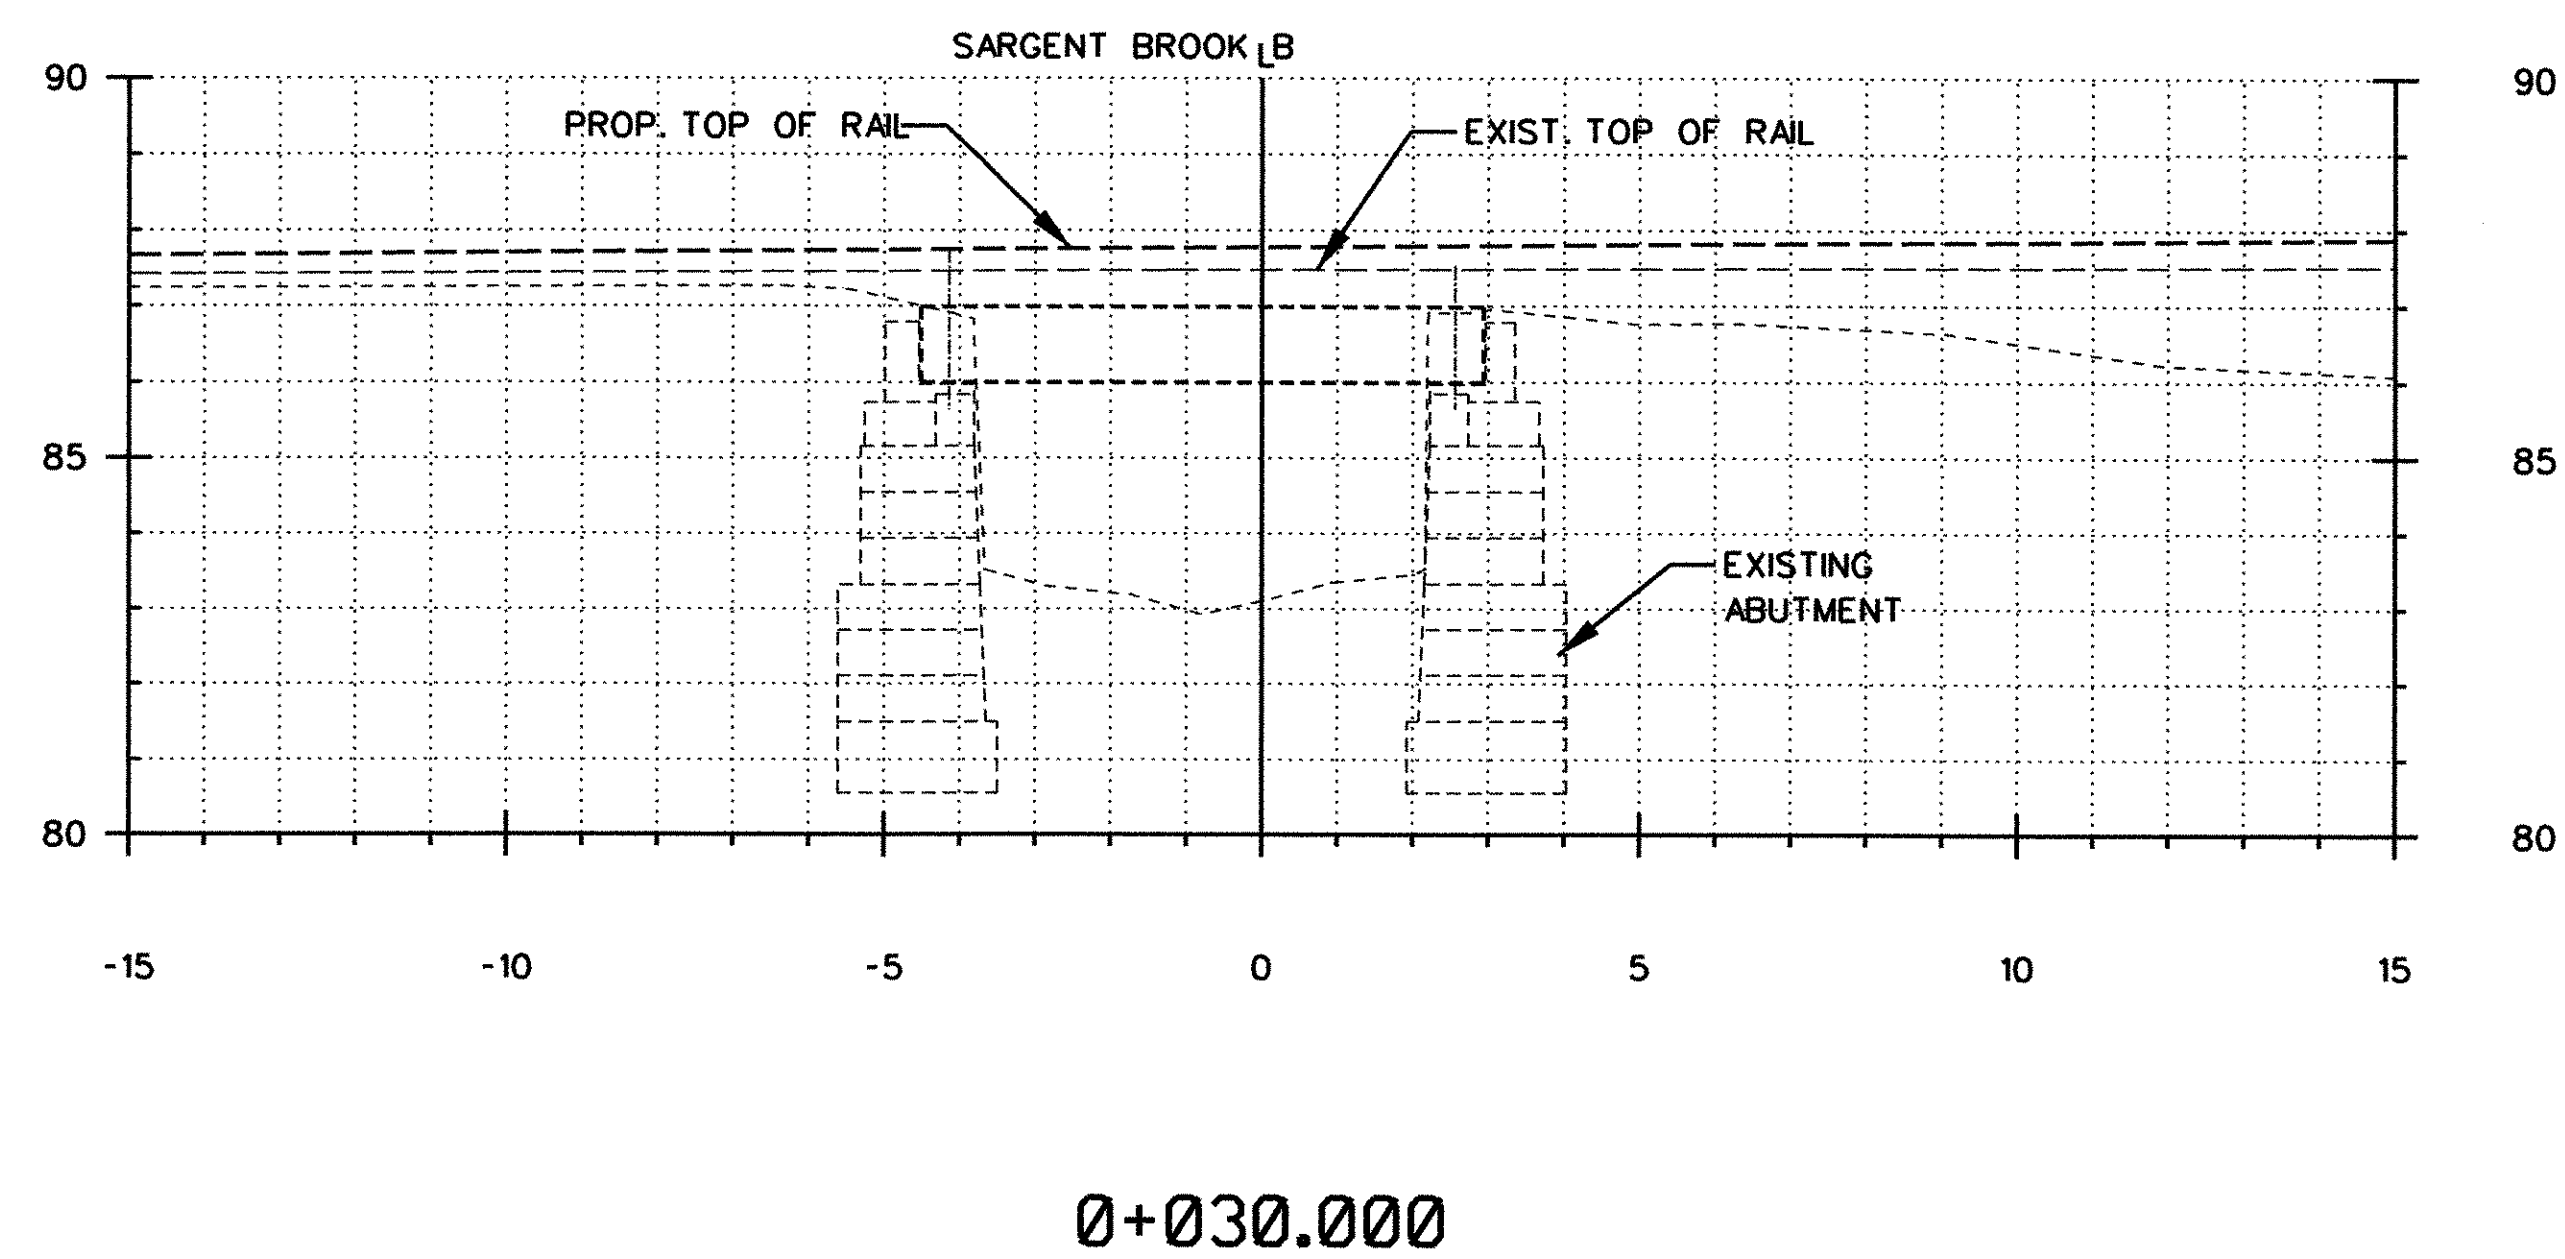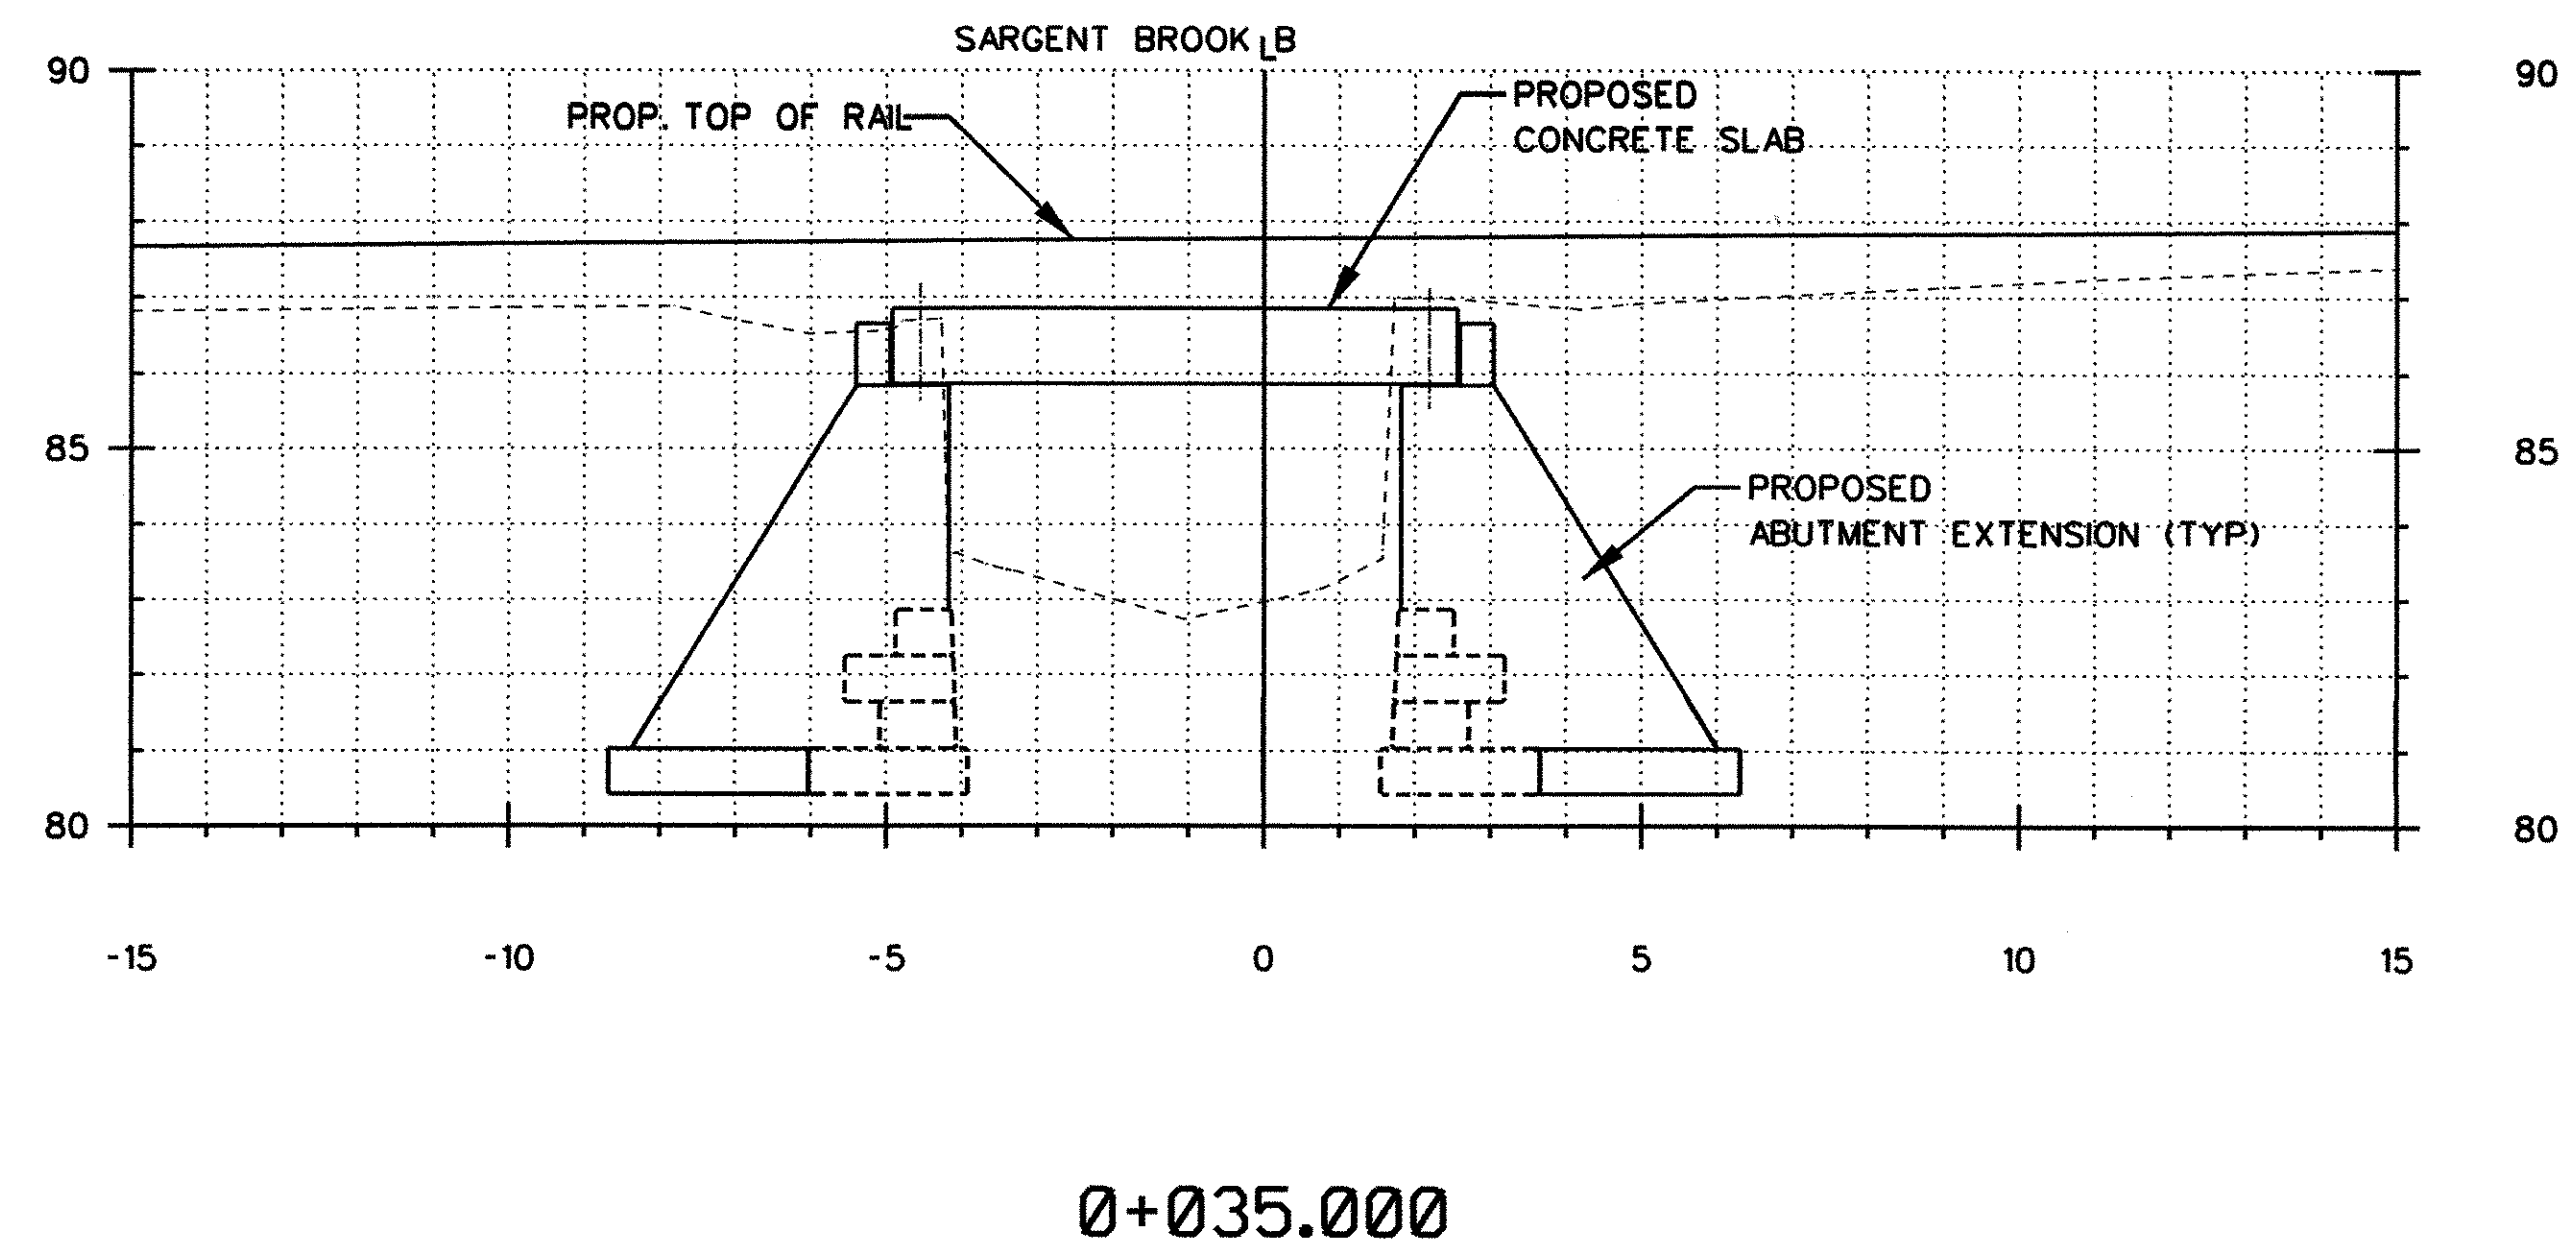


PROJECT:	BRATTLEBORO	PROJECT NO.:	NH 010-2(2)
DESIGN FILE NAME:	U:\99123-Brattleboro\dgn\zb270xs1.dgn		
IPARM FILE NAME:	PLOT DATE: 10-02-2002		
FROM STA: 0+030.000 TO STA: 0+035.000 SHEET: 135 OF 145			

SARGENT BROOK CROSS SECTIONS

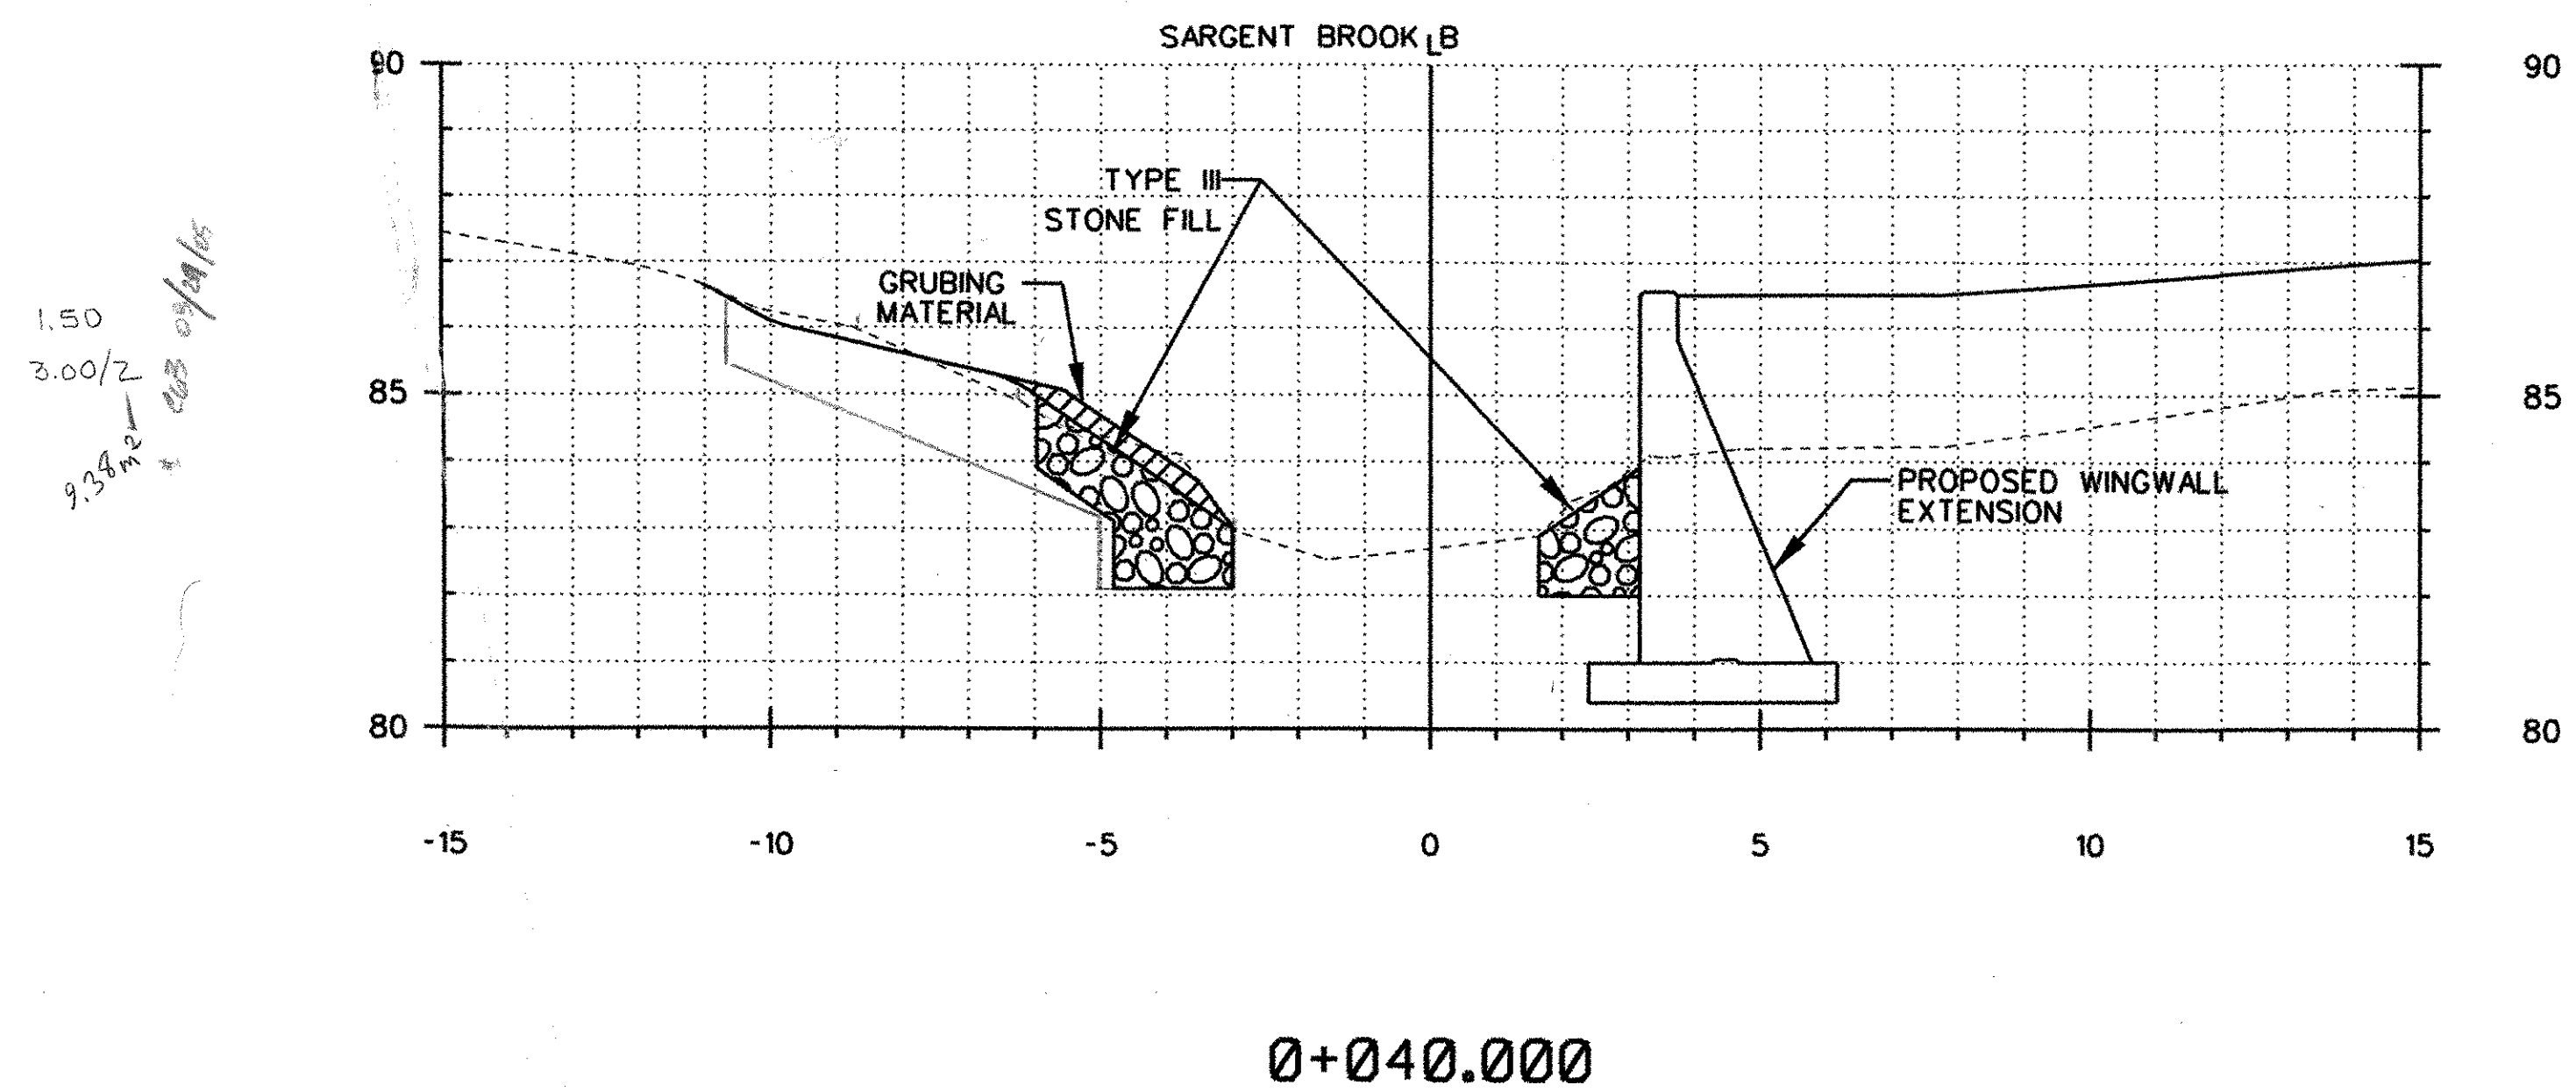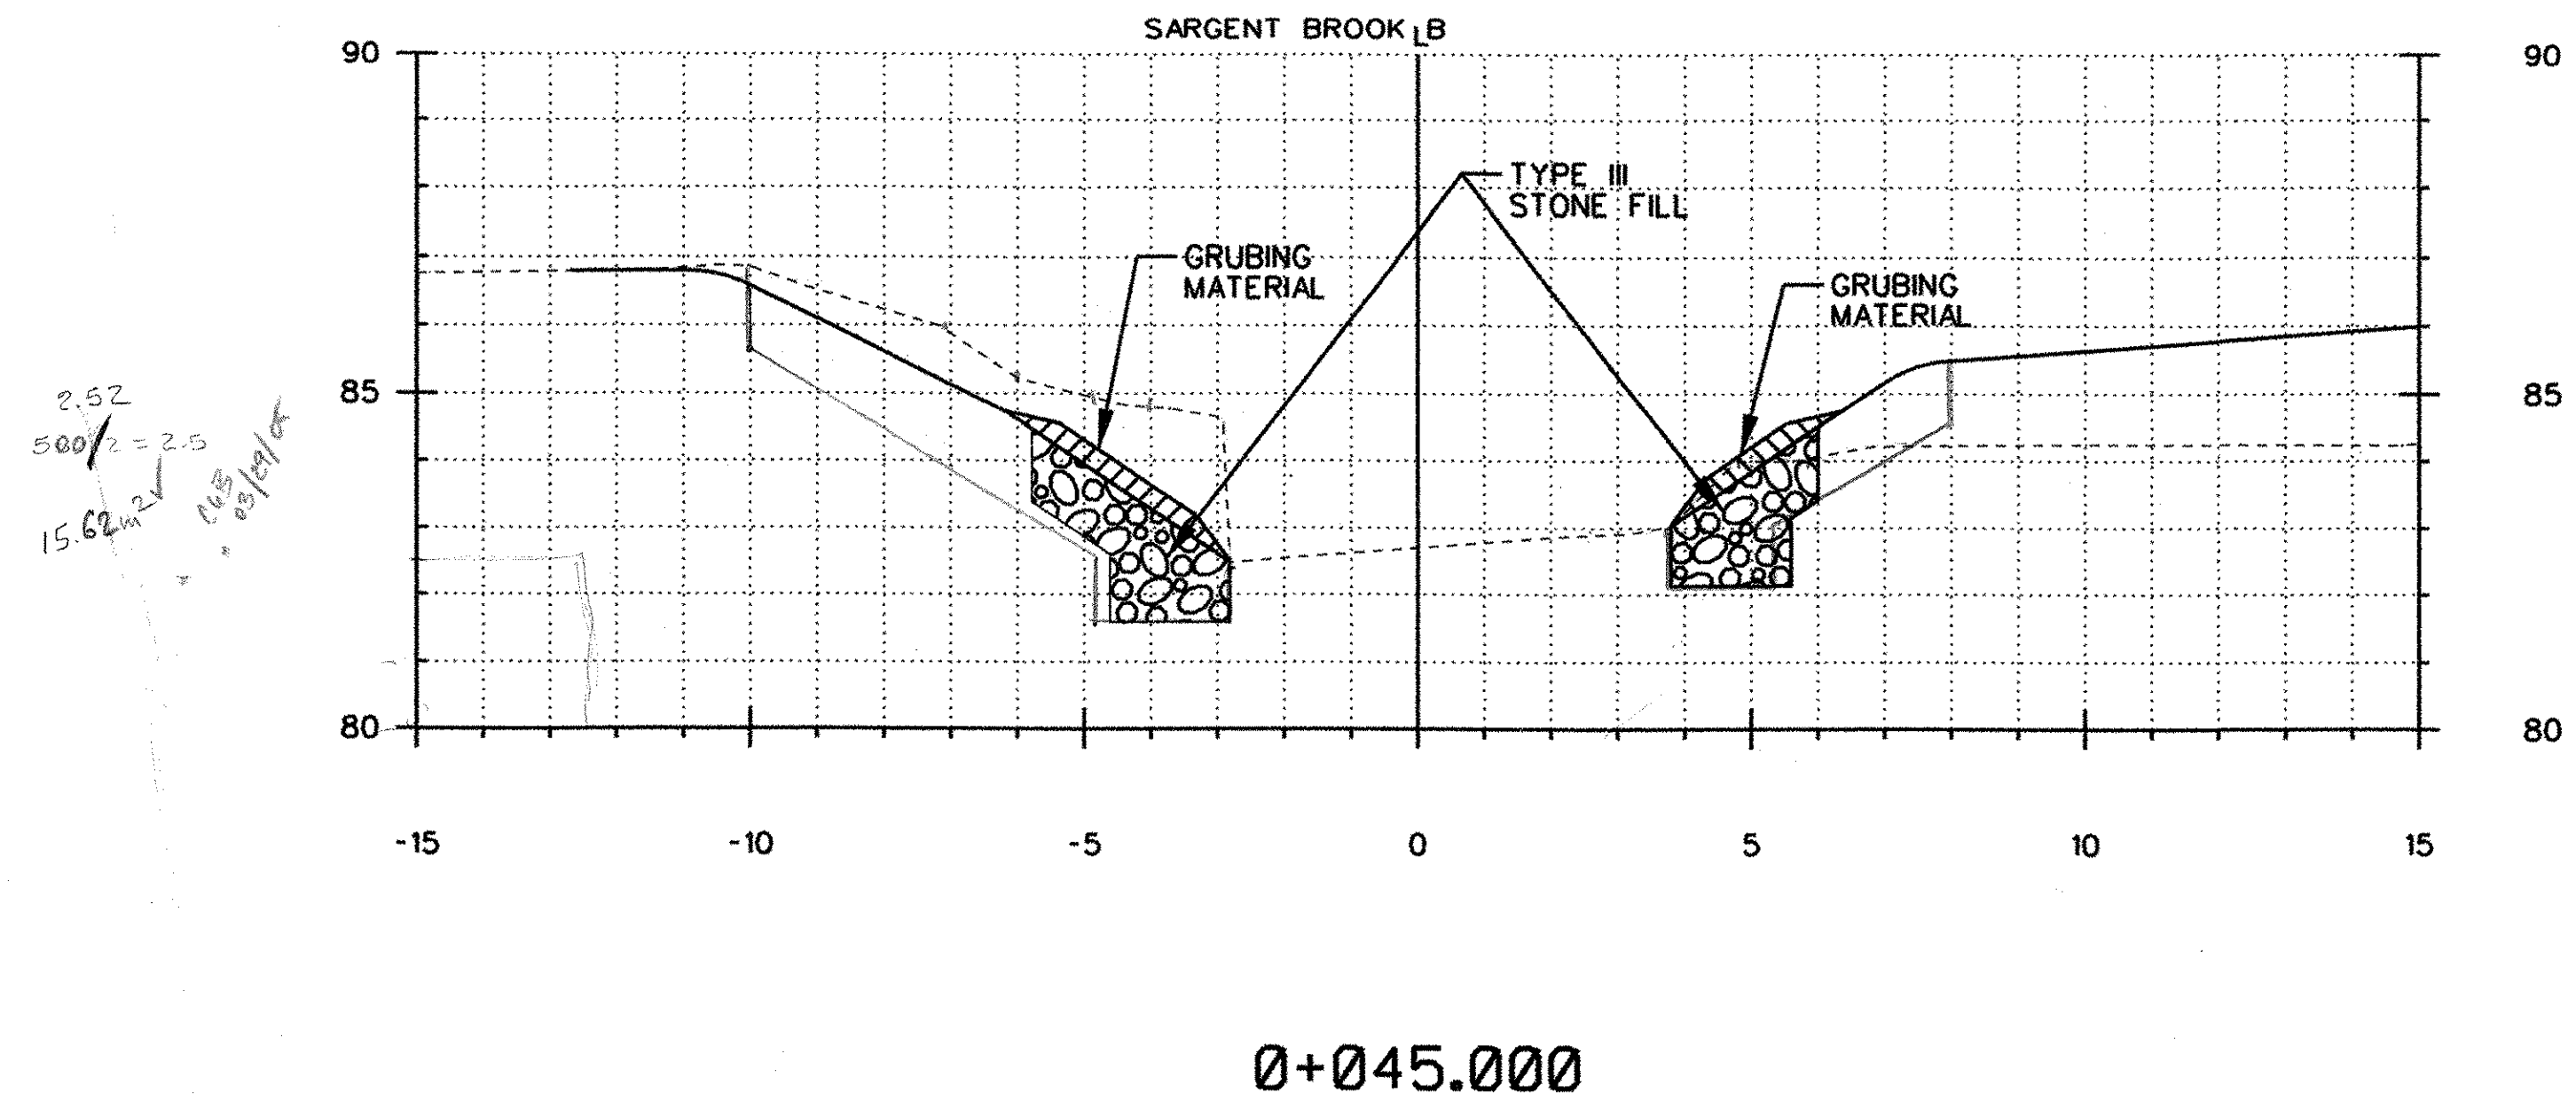


PROJECT:	BRATTLEBORO	PROJECT NO.:	NH 010-2(2)
DESIGN FILE NAME:	U:\99123-Brattleboro\dgn\zb270xs1.dgn		
IPARM FILE NAME:	PLOT DATE: 10-02-2002		
FROM STA: 0+040.000 TO STA: 0+045.000 SHEET: 136 OF 145			

SARGENT BROOK CROSS SECTIONS

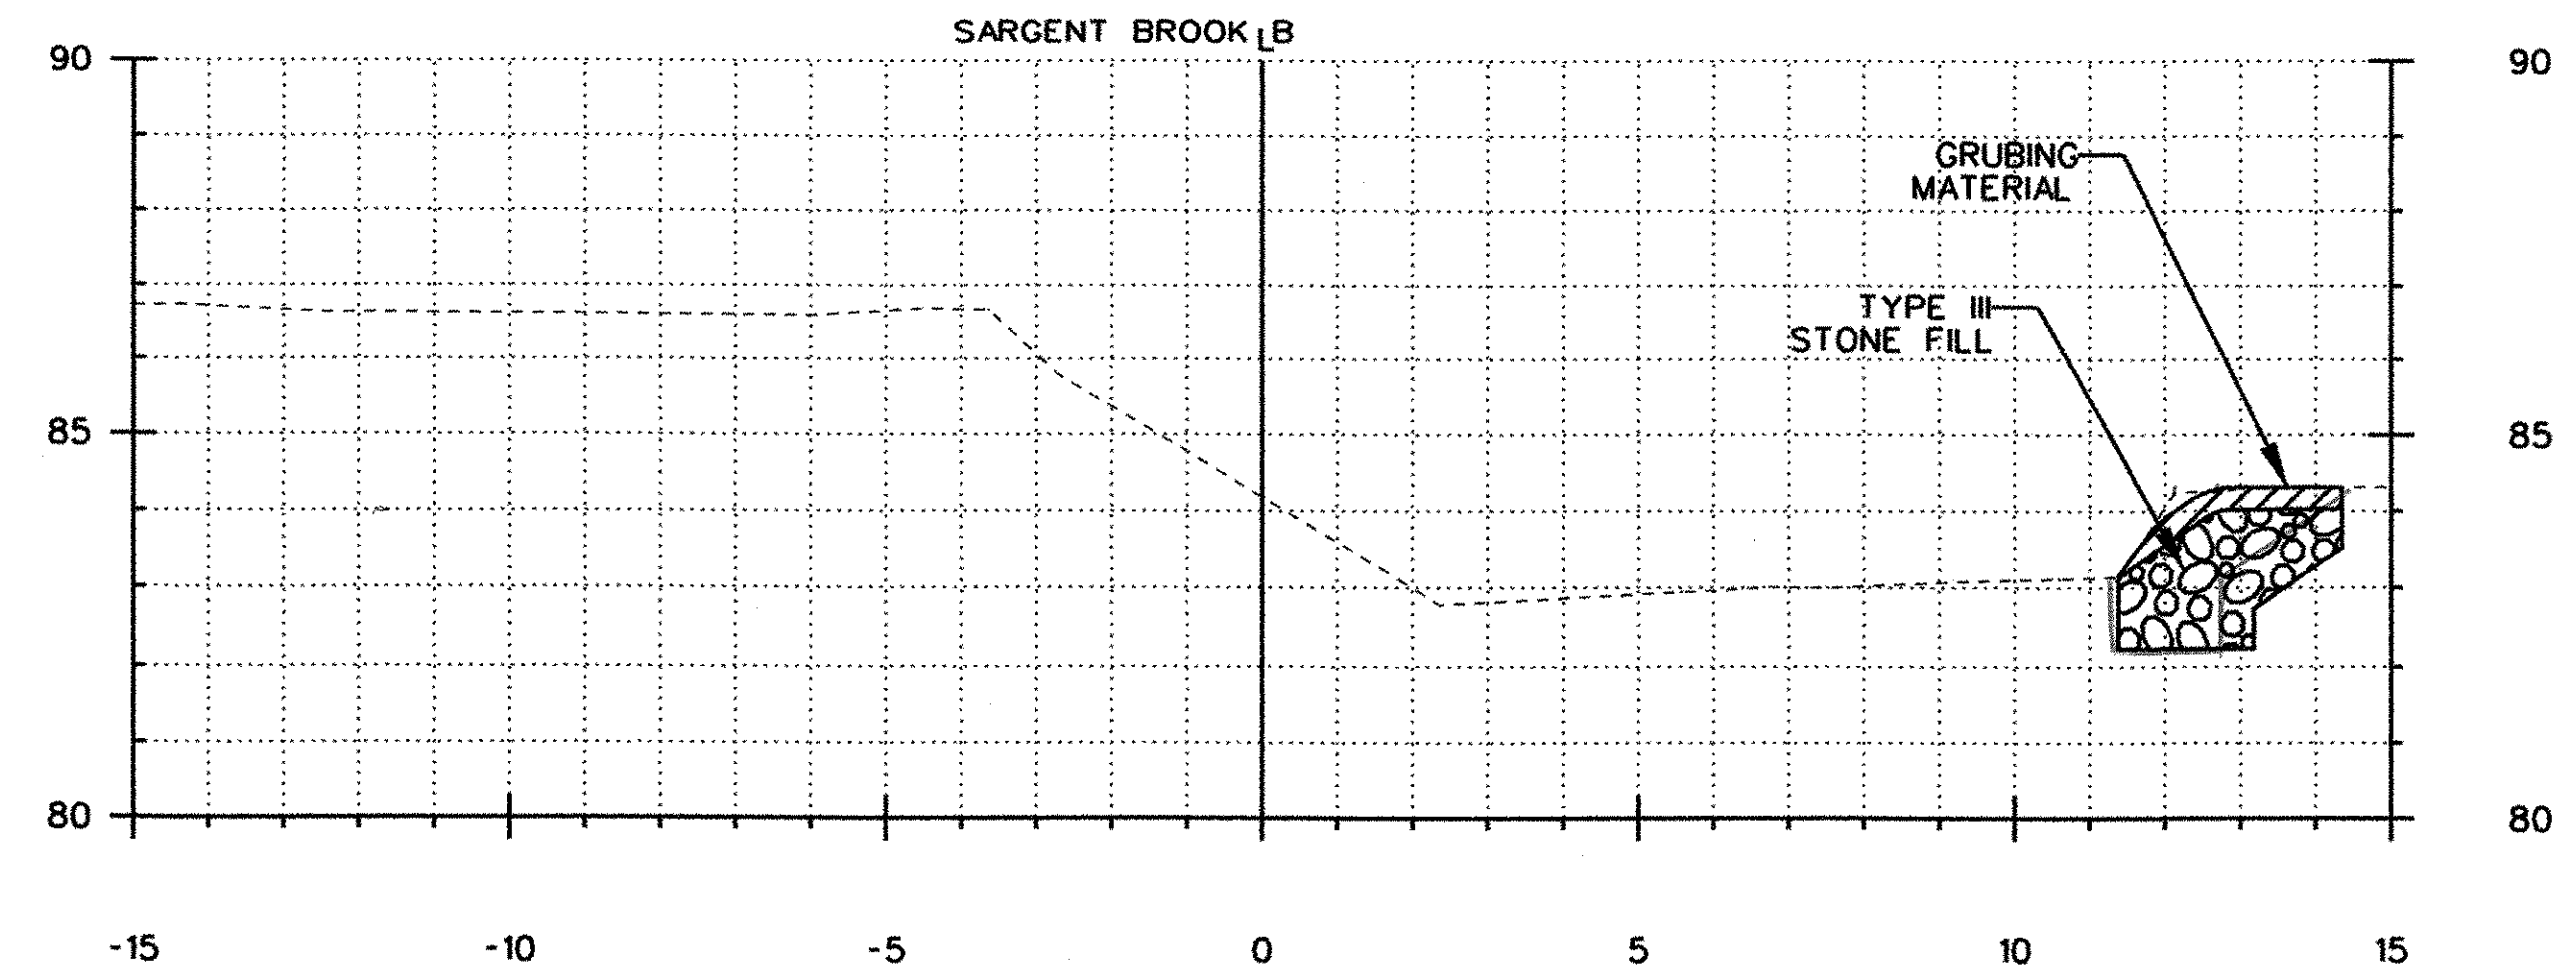

0.51
1.02/2
3.20m² ✓ 100% 07/16

0+055.000

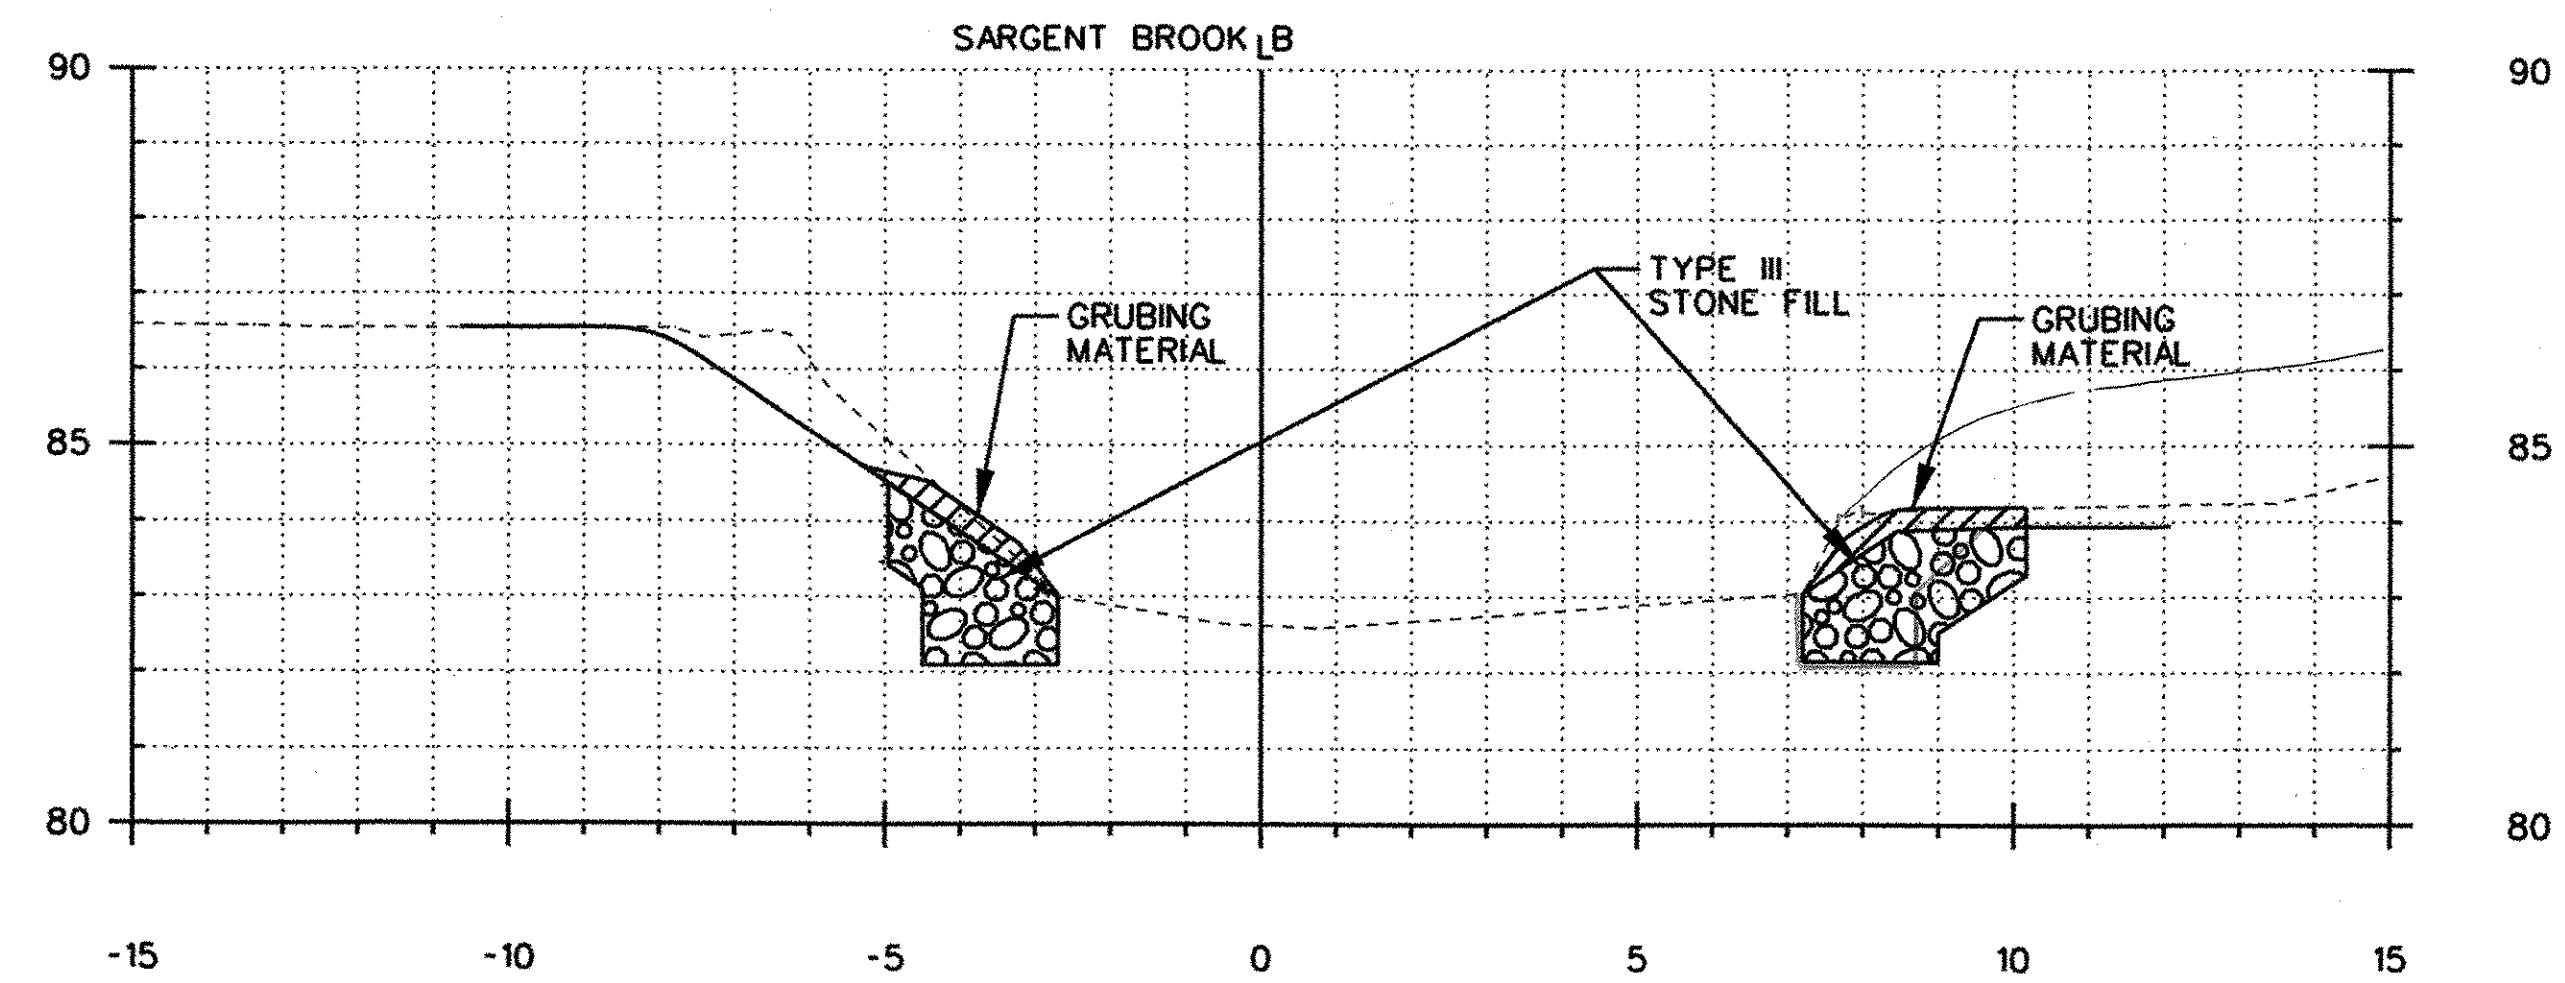


0.50
1.02/2
3.19m² ✓ 100% 07/16

0+050.000





PROJECT:	BRATTLEBORO	PROJECT NO.:	NH 010-2(2)
DESIGN FILE NAME:	U:\99123-Brattleboro\dgn\zb270xs1.dgn		
IPARM FILE NAME:	PLOT DATE: 10-02-2002		
FROM STA: 0+050.000		TO STA: 0+055.000 SHEET: 137 OF 145	

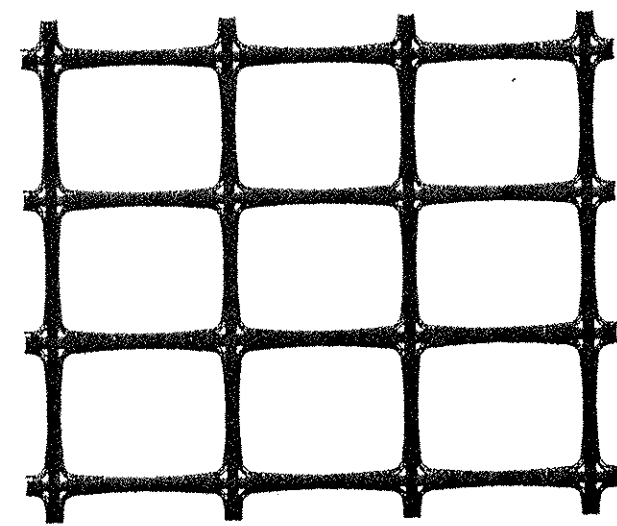

Tensar
Earth Technologies, Inc.

CONSTRUCTION DRAWINGS
Prepared For

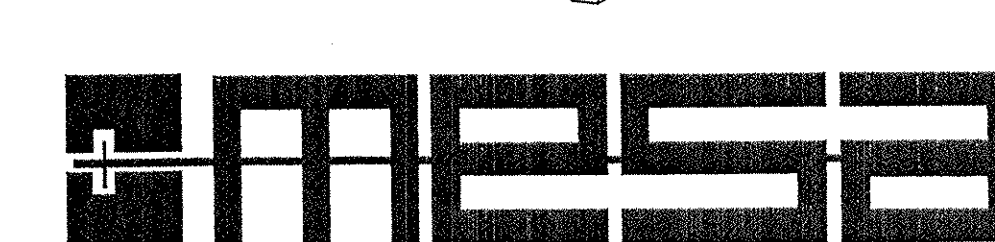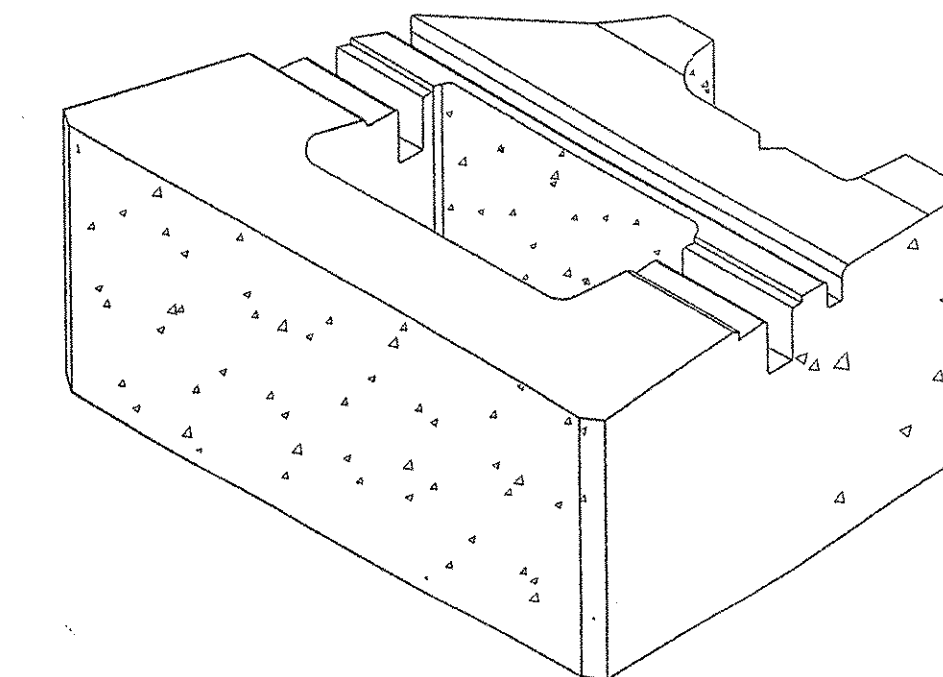

VERMONT ROUTE - 9

BRATTLEBORO,

VERMONT


INDEX

SHEET	DESCRIPTION
1.	Title Sheet
2.	Construction Notes
3.	Plan View
4.	Elevation View
5.	Typical Cross-Section
6.	Typical Details
7.	Typical Details



M1087501.DWG

THIS DESIGN IS BASED UPON SPECIFIC PROPERTIES OF TENSAR PRODUCTS (GEOGRIDS, DRAINAGE COMPOSITES AND EROSION MEDIA), WHICH ARE PROPRIETARY TO THE TENSAR CORPORATION 1210 CITIZENS PARKWAY, MORROW GA. 30260. ANY SUBSTITUTION OF THE SPECIFIED PRODUCTS WILL INVALIDATE THIS DESIGN. THIS DRAWING IS BEING FURNISHED FOR USE ON THIS SPECIFIC PROJECT ONLY. ANY PARTY ACCEPTING THIS DOCUMENT DOES SO IN CONFIDENCE AND AGREES THAT IT SHALL NOT BE DUPLICATED WHOLE OR IN PART, NOR DISCLOSED TO OTHERS, WITHOUT THE CONSENT OF TENSAR EARTH TECHNOLOGIES, INC.

COPYRIGHT 2001, TENSAR EARTH TECHNOLOGIES, INC.

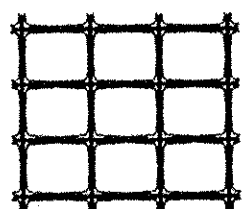

TENSAR
EARTH TECHNOLOGIES, INC.
5883 Glenridge Drive
Suite 200
Atlanta, Georgia 30328
(404) 250-1290

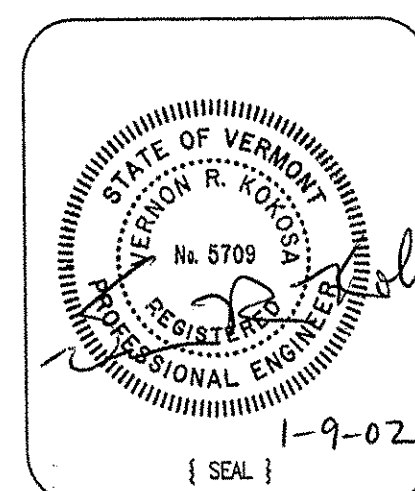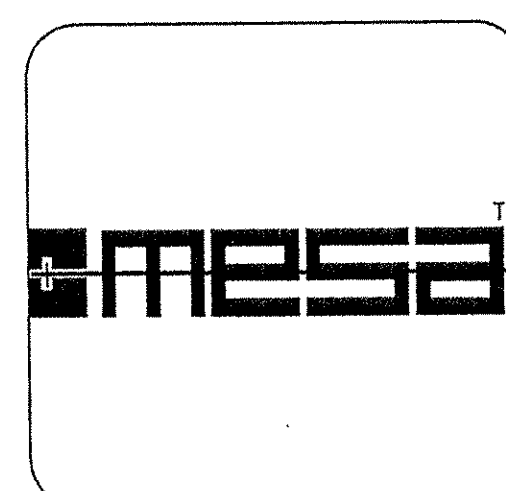

REVISIONS \ ISSUE			
0	10/19/01	ISSUED FOR BID	
1	12/3/01	ISSUED FOR REVIEW	
2	1/7/02	ISSUED FOR BID	<i>al</i>

Project Number M10875
Date Drawn 10/19/01
Scale As Shown
Designed by WL
Drawn by KJK
Checked by <i>al</i>

VERMONT ROUTE - 9

BRATTLEBORO, VERMONT

TITLE SHEET

Sheet Number
1 of 7

CONSTRUCTION NOTES FOR PLACEMENT OF TENSAR GEOGRIDS AND BACKFILL SOILS FOR TENSAR / MESA REINFORCED WALLS

1.0 MATERIAL

1.1 BACKFILL SOILS

1.1.1 REINFORCED BACKFILL SHALL CONSIST OF FREE-DRAINING GRANULAR MATERIAL FREE FROM LOAM, SILT, CLAY, ORGANIC OR FROZEN MATERIAL THAT MEETS THE REQUIREMENTS FOR ITEM 704.08, GRANULAR BACKFILL FOR STRUCTURES AS SPECIFIED IN THE STATE OF VERMONT AGENCY OF TRANSPORTATION, STANDARD SPECIFICATIONS FOR CONSTRUCTION, LATEST EDITION. THE GRADATION REQUIREMENTS ARE REPRODUCED AS FOLLOWS:

SIEVE SIZE	PERCENT PASSING
76mm (3-inch)	100
63mm (2 1/2-inch)	90 - 100
#40	50 - 75
#100	0 - 12
#200	0 - 6

1.1.2 GRANULAR BACKFILL SHALL CONSIST OF BANK RUN SAND AND/OR GRAVEL FREE FROM LOAM, SILT, CLAY, ORGANIC, FROZEN, OR OTHER DELETERIOUS MATERIAL THAT MEETS THE REQUIREMENTS FOR ITEM 703.04, GRANULAR BORROW AS SPECIFIED IN THE STATE OF VERMONT AGENCY OF TRANSPORTATION, STANDARD SPECIFICATIONS FOR CONSTRUCTION, LATEST EDITION THE GRADATION REQUIREMENTS ARE REPRODUCED AS FOLLOWS:

SIEVE SIZE	PERCENT PASSING
#4	20 - 100
#200	0 - 12

1.1.3 FURTHERMORE, REINFORCED BACKFILL, GRANULAR BACKFILL AND RETAINED SOIL/FILL MATERIALS SHALL BE FREE OF EXCESS MOISTURE, ROOTS, MUCK, SOD, SNOW, FROZEN LUMPS, ORGANIC MATTER OR OTHER DELETERIOUS MATERIALS. ALL ROCK PARTICLES AND HARD EARTH CLODS SHALL BE LESS THAN 75mm IN THE LONGEST DIMENSION REINFORCED BACKFILL MATERIALS WHICH DO NOT MEET THIS CRITERIA SHALL BE CONSIDERED UNSUITABLE AND SHALL BE REMOVED.

1.2 GEOGRID REINFORCEMENT SHALL BE TENSAR UNIAXIAL GEOGRIDS MANUFACTURED BY TENSAR CORPORATION, MORROW, GEORGIA.

1.3 BODKIN BARS SHALL BE 38mm x 6.4mm HDPE BARS MANUFACTURED BY TENSAR CORPORATION, MORROW, GEORGIA.

1.4 CONNECTORS SHALL BE SUPPLIED BY THE TENSAR CORPORATION, MORROW, GEORGIA.

1.5 DRAINAGE MATERIALS

1.5.1 DRAINAGE STONE SHALL BE VT DOT ITEM 704.02B COARSE AGGREGATE AND GEOTEXTILE WRAP AROUND DRAIN SHALL MEET VT DOT ITEM 649.41 REQUIREMENTS.

2.0 TECHNICAL REQUIREMENTS

2.1 THE OWNER OR OWNER'S REPRESENTATIVE SHALL SUBMIT TO TENSAR EARTH TECHNOLOGIES, INC. THE GRADATION AND STRENGTH PARAMETERS OF THE REINFORCED BACKFILL MATERIAL, RETAINED SOIL/FILL AND FOUNDATION SOIL, FOR APPROVAL, PRIOR TO PROCEEDING WITH CONSTRUCTION.

2.2 PRIOR TO CONSTRUCTION OF THE TENSAR REINFORCED WALL, THE CONTRACTOR SHALL CLEAR AND GRUB THE REINFORCED BACKFILL ZONE AREA, REMOVING TOP SOIL, BRUSH, SOD OR OTHER ORGANIC OR DELETERIOUS MATERIAL. ANY UNSUITABLE SOILS SHALL BE OVER-EXCAVATED, REPLACED AND COMPACTED WITH REINFORCED BACKFILL MATERIAL TO PROJECT SPECIFICATIONS OR OTHERWISE DIRECTED BY THE OWNER OR OWNER'S REPRESENTATIVE.

2.3 FOUNDATION SHALL BE PROOF ROLL INSPECTED USING A LOADED TRUCK WITH 18 KIP AXLE LOADS OR PER PROJECT SPECIFICATIONS, THE OWNER OR OWNER'S REPRESENTATIVE SHALL CONFIRM THAT THE SITE HAS BEEN PROPERLY PREPARED AND THE DESIGN PARAMETERS IN SECTION 7.0 ARE APPROPRIATE PRIOR TO FILL PLACEMENT.

2.4 FILL SHALL BE PLACED IN HORIZONTAL LAYERS NOT EXCEEDING 200mm IN UNCOMPACTED THICKNESS FOR HEAVY COMPACTION EQUIPMENT. FOR ZONES WHERE COMPACTION IS ACCOMPLISHED WITH HAND OPERATED EQUIPMENT, FILL SHALL BE PLACED IN HORIZONTAL LAYERS NOT EXCEEDING 150mm IN UNCOMPACTED THICKNESS. ONLY HAND-OPERATED EQUIPMENT SHALL BE ALLOWED WITHIN ONE METER OF THE BACK FACE OF WALL.

2.5 FILL MATERIALS SHALL BE PLACED FROM THE BACK OF THE MESA FACING UNITS TOWARDS THE ENDS OF THE GEOGRID TO ENSURE FURTHER TENSIONING.

2.6 FILL SHALL BE COMPACTED AS SPECIFIED BY PROJECT SPECIFICATIONS OR TO A MINIMUM OF 95 PERCENT OF THE MAXIMUM DRY DENSITY AS DETERMINED IN ACCORDANCE WITH AASHTO T-99 (STANDARD PROCTOR), AT A MOISTURE CONTENT NO GREATER THAN 2 PERCENTAGE POINTS WET AND NO LESS THAN 1 PERCENTAGE POINT DRY OF OPTIMUM.

2.7 TESTING METHODS AND FREQUENCY, AND VERIFICATION OF MATERIAL SPECIFICATIONS AND COMPACTION SHALL BE THE RESPONSIBILITY OF THE OWNER OR OWNER'S REPRESENTATIVE.

2.8 MESA CAP UNITS SHALL BE PERMANENTLY SECURED TO THE MESA STANDARD UNITS USING AN APPROVED CONSTRUCTION ADHESIVE PER BLOCK MANUFACTURER'S RECOMMENDATIONS.

2.9 A COMPLETE SET OF APPROVED CONSTRUCTION DRAWINGS AND CONTRACT SPECIFICATIONS SHALL BE ON-SITE AT ALL TIMES, DURING CONSTRUCTION OF THE TENSAR REINFORCED RETAINING WALL.

3.0 TENSAR GEOGRID PLACEMENT

3.1 TENSAR GEOGRIDS SHALL BE PLACED AT THE LOCATIONS AND ELEVATIONS SHOWN ON THE DRAWINGS.

3.2 TENSAR GEOGRID LENGTHS SHALL BE AS SHOWN ON THE CONSTRUCTION DRAWINGS. REINFORCED FILL ZONES LENGTH IS MEASURED FROM THE FRONT FACE OF THE WALL, EXTENDING TO THE TAIL OF THE GEOGRIDS.

3.2.1 TENSAR GEOGRID REINFORCEMENT SHALL BE CONTINUOUS THROUGHOUT THEIR EMBEDMENT LENGTH(S). BODKIN CONNECTION SHALL NOT BE UTILIZED UNLESS PRE-APPROVED BY THE OWNER OR OWNER'S REPRESENTATIVE PRIOR TO CONSTRUCTION.

3.2.2 IF PRE-APPROVED, TENSAR UNIAXIAL GEOGRIDS MAY BE SPLICED UTILIZING THE BODKIN CONNECTION DETAIL. NO MORE THAN ONE SPICE SHALL BE ALLOWED IN ANY ONE LENGTH OF REINFORCEMENT AND NO SPICE SHALL BE ALLOWED FOR GEOGRIDS LESS THAN 1.80m IN LENGTH (EACH). THE BODKIN CONNECTION SHALL NOT BE PLACED LESS THAN 1.80m BELOW PLANNED FINISHED GRADE. THE BODKIN CONNECTION SHALL NOT BE PLACED HORIZONTALLY OR VERTICALLY ADJACENT TO ANOTHER BODKIN CONNECTION.

3.3 PRIOR TO PLACING FILL, THE GEOGRID MATERIALS SHALL BE PLACED OVER THE SLOT IN THE TOP OF THE MESA BLOCK. DRIVE CONNECTOR BAR FINGERS THROUGH THE GEOGRID APERTURES BEHIND THE FIRST TRANSVERSE BAR. REMOVE SLACK AND ANCHOR.

3.4 TRACKED CONSTRUCTION EQUIPMENT SHALL NOT BE OPERATED DIRECTLY ON THE GEOGRID. A MINIMUM BACKFILL THICKNESS OF SIX INCHES IS REQUIRED FOR OPERATION OF TRACKED VEHICLES OVER THE GEOGRID. TURNING OF TRACKED VEHICLES SHOULD BE KEPT TO A MINIMUM TO PREVENT CRACKS FROM DISPLACING THE FILL AND/OR THE GEOGRID.

3.5 RUBBER-TIRED VEHICLES MAY PASS OVER THE GEOGRID REINFORCEMENT AT SLOW SPEEDS, LESS THAN 16 km/h. SUDDEN BRAKING AND SHARP TURNING SHALL BE AVOIDED.

3.6 TENSAR UNIAXIAL GEOGRID SHALL BE ROLLED OUT WITH THE LONG AXIS OF THE APERTURES (MACHINE DIRECTION) PERPENDICULAR TO THE WALL FACE.

3.7 UNIAXIAL GEOGRIDS SHALL BE CUT NEXT TO THE CROSS MACHINE DIRECTION BAR. THE CROSS MACHINE DIRECTION BAR SHALL BE PLACED AS OUTLINED IN SECTION 3.3 AND PULLED TAUT PRIOR TO FILL PLACEMENT.

3.8 A MINIMUM OF 75mm OF FILL MATERIAL SHALL BE REQUIRED BETWEEN LAYERS OF UNIAXIAL GEOGRIDS, UNLESS OTHERWISE SHOWN.

4.0 CHANGES TO GEOGRID LAYOUT OR PLACEMENT

4.1 NO CHANGES TO THE TENSAR GEOGRID LAYOUT, INCLUDING, BUT NOT LIMITED TO, LENGTH, GEOGRID TYPE, OR ELEVATION, SHALL BE MADE WITHOUT THE EXPRESSED PRIOR TO WRITTEN CONSENT OF TENSAR EARTH TECHNOLOGIES, INC.

5.0 DRAINAGE

5.1 AT THE END OF EACH WORK DAY, BACKFILL SURFACE SHALL BE GRADED AWAY FROM THE SLOPE FACE A MINIMUM OF 2 PERCENT SLOPE AND A TEMPORARY SOIL BERM SHALL BE CONSTRUCTED NEAR THE WALL CREST TO PREVENT SURFACE WATER RUNOFF FROM OVERTOPPING THE WALL.

5.2 AT THE END OF EACH WORK DAY, BACKFILL SURFACE SHALL BE COMPACTED WITH A SMOOTH WHEEL ROLLER TO MINIMIZE PONDING OF WATER AND SATURATION OF THE BACKFILL.

5.3 THE ENGINEERING, DESIGN, ANALYSIS, DETAILING AND MITIGATION OF BOTH SURFACE DRAINAGE AND SEEPAGE OF GROUNDWATER SHALL BE THE RESPONSIBILITY OF THE OWNER OR OWNER'S REPRESENTATIVE.

5.4 PERMANENT SURFACE WATER DIVERSION SHALL BE REQUIRES AND PROVIDED BY THE OWNER OR OWNER'S REPRESENTATIVE.

5.5 THE TENSAR REINFORCED WALL HAS BEEN DESIGNED ON THE ASSUMPTION THAT THE REINFORCED BACKFILL MATERIAL SHALL BE FREE OF SUBSURFACE DRAINAGE OF WATER (SEEPAGE). PERMANENT SUBSURFACE WATER (SEEPAGE) COLLECTION AND DIVERSION SHALL BE THE RESPONSIBILITY OF THE OWNER OR OWNER'S REPRESENTATIVE

6.0 METHOD OF PAYMENT

SEE CONTRACT DOCUMENTS.

7.0 DESIGN PARAMETERS

7.1 DESIGN OF THE REINFORCED SOIL STRUCTURE IS BASED ON THE FOLLOWING PARAMETERS.

	EFFECTIVE FRICTION ANGLE	EFFECTIVE COHESION	MOIST UNIT WT.
REINFORCED FILL	34°	0 kPa	22.0 kN/m ³
RETAINED SOIL	30°	0 kPa	22.0 kN/m ³
FOUNDATION SOIL	30°	0 kPa	22.0 kN/m ³

7.2 FACTORS OF SAFETY:

	STATIC	SEISMIC
INTERNAL STABILITY		
MINIMUM FACTORS OF SAFETY FOR UNCERTAINTIES	= 1.5	= N/A
MINIMUM FACTORS OF SAFETY FOR GEOGRID PULLOUT	= 1.5	= N/A
MINIMUM FACTORS OF SAFETY FOR SLIDING AT GEOGRID	= 1.5	= N/A

SOIL-GEOGRID INTERACTION COEFFICIENT = 0.8
PERCENT COVERAGE OF GEOGRID = 100%

7.2.2 EXTERNAL STABILITY

MINIMUM FACTORS OF SAFETY FOR SLIDING AT BASE = 1.5
MINIMUM FACTORS OF SAFETY FOR OVERTURNING = 2.0

7.2.3 GLOBAL STABILITY:

GLOBAL STABILITY HAS NOT BEEN CONSIDERED IN THIS DESIGN.

7.3 SURCHARGE LOADING

= 13.2 kPa

7.4 HYDROSTATIC DESIGN

= NONE

GROUNDWATER/PHREATIC SURFACES NOT CONSIDERED IN WALL DESIGN. WATER SURFACE ASSUMED TO BE SUFFICIENTLY BELOW BOTTOM OF WALL AS NOT TO INFLUENCE INTERNAL AND EXTERNAL STABILITY.

7.5 SEISMIC DESIGN

= NONE

7.6 MAXIMUM APPLIED BEARING PRESSURE

= 281 kPa

8.0 SPECIAL PROVISIONS

8.1 THE DESIGN PRESENTED HEREIN IS BASED ON SOIL PARAMETERS, FOUNDATION CONDITIONS, GROUNDWATER CONDITIONS, AND LOADINGS STATED IN SECTION 7.0.

8.2 WALL ELEVATION VIEWS AND LOCATIONS AND GEOMETRY OF EXISTING STRUCTURES SHALL BE VERIFIED BY THE OWNER OR OWNER'S REPRESENTATIVE PRIOR TO CONSTRUCTION.

8.3 TENSAR EARTH TECHNOLOGIES, INC. ASSUMES NO LIABILITY FOR INTERPRETATION OR VERIFICATION OF SUBSURFACE CONDITIONS, SUITABILITY OF SOIL DESIGN PARAMETERS AND INTERPRETATION OF SUBSURFACE GROUNDWATER CONDITIONS.

8.4 THE OWNER OR OWNER'S REPRESENTATIVE IS RESPONSIBLE FOR REVIEWING AND VERIFYING THAT THE ACTUAL SITE CONDITIONS ARE AS DESCRIBED IN SECTION 7.0 PRIOR TO CONSTRUCTION. THE OWNER OR OWNER'S REPRESENTATIVE SHALL BE ON-SITE TO ASSURE THE PROVISIONS OF THE CONSTRUCTION NOTES ARE FOLLOWED.

8.5 IT IS THE RESPONSIBILITY OF THE OWNER OR OWNER'S REPRESENTATIVE TO PROVIDE SOIL THAT MEETS THE GRADATION LISTED IN SECTION 1.1.1 AND PARAMETERS LISTED IN SECTION 7.1.

8.6 IF ANY ROCK FORMATIONS AND/OR GROUNDWATER ARE ENCOUNTERED DURING CONSTRUCTION, IMMEDIATELY CONTACT TENSAR EARTH TECHNOLOGIES, INC. AT 404-250-1290 AND THE OWNER'S REPRESENTATIVE.

8.7 ANY REVISIONS TO DESIGN PARAMETERS STATED IN SECTION 7.0 OR STRUCTURE GEOMETRY SHALL REQUIRE DESIGN MODIFICATIONS PRIOR TO PROCEEDING WITH CONSTRUCTION.



8.8 THIS DESIGN IS ONLY VALID FOR THE PROPOSED TENSAR RETAINING WALL(S) AS SHOWN HEREIN.

8.9 TOTAL SETTLEMENT AND DIFFERENTIAL SETTLEMENT IN EXCESS OF 1/100 AND ITS EFFECTS ON THE TENSAR RETAINING WALL SYSTEM SHALL BE THE RESPONSIBILITY OF THE OWNER OR OWNER'S REPRESENTATIVE.

8.10 GLOBAL STABILITY AND BEARING CAPACITY SHALL BE THE RESPONSIBILITY OF THE OWNER OR OWNER'S REPRESENTATIVE.

M1087502.DWG

THIS DESIGN IS BASED UPON SPECIFIC PROPERTIES OF TENSAR PRODUCTS (GEOGRIDS, DRAINAGE COMPOSITES AND EROSION MEDIA), WHICH ARE PROPRIETARY TO THE TENSAR CORPORATION 1210 CITIZENS PARKWAY, MORROW GA. 30260. ANY SUBSTITUTION OF THE SPECIFIED PRODUCTS WILL INVALIDATE THIS DESIGN. THIS DRAWING IS BEING FURNISHED FOR USE ON THIS SPECIFIC PROJECT ONLY. ANY PARTY ACCEPTING THIS DOCUMENT DOES SO IN CONFIDENCE AND AGREES THAT IT SHALL NOT BE DUPLICATED WHOLE OR IN PART, NOR DISCLOSED TO OTHERS, WITHOUT THE CONSENT OF TENSAR EARTH TECHNOLOGIES, INC.

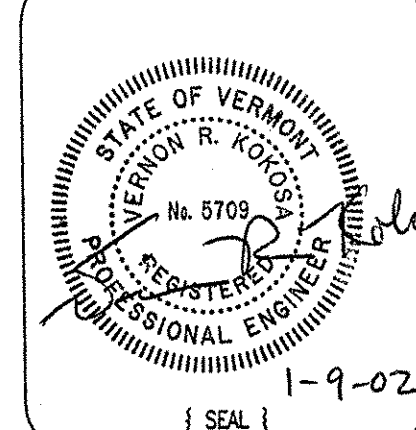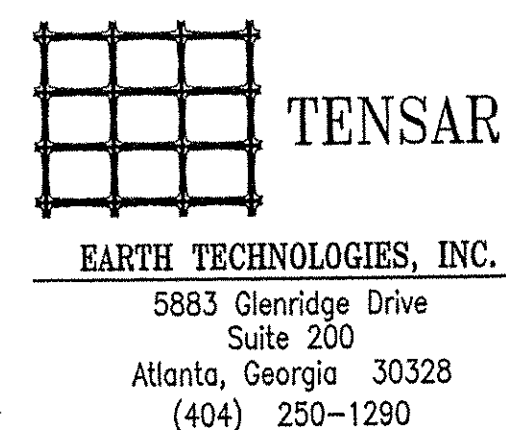

REVISIONS \ ISSUE			
0	10/19/01	ISSUED FOR BID	
1	12/3/01	ISSUED FOR REVIEW	
2	1/7/02	ISSUED FOR BID	aj

Project Number	M10875
Date Drawn	10/19/01
Scale	
As Shown	
Designed by	WL
Drawn by	KJK
Checked by	aj


VERMONT ROUTE - 9

BRATTLEBORO, VERMONT

CONSTRUCTION NOTES

Sheet Number 2 of 7

PROJECT NO. NH BRF 012-I(33) Sheet 139 of 145

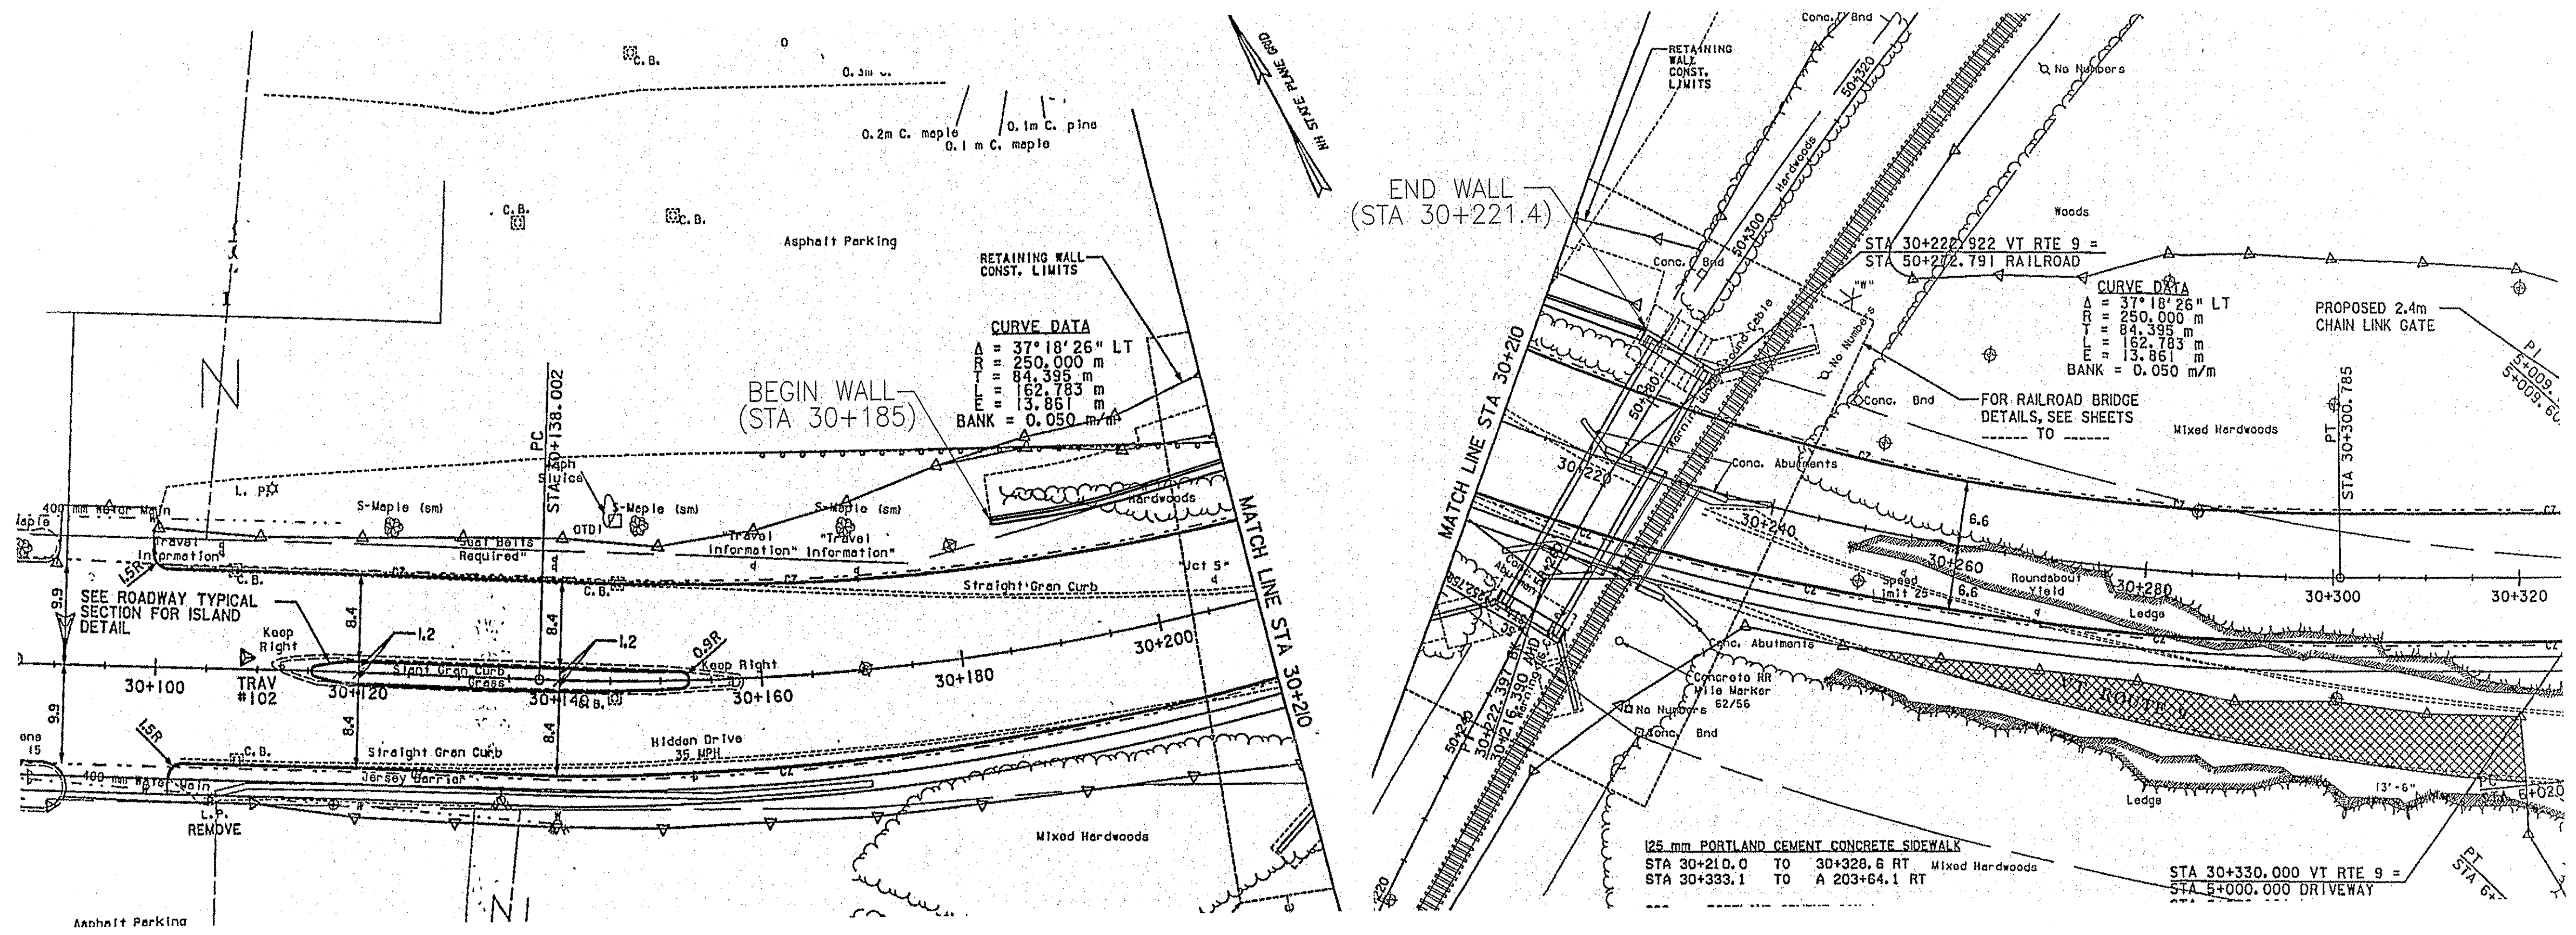

NOTE:
 PLAN VIEW IS SHOWN FOR ILLUSTRATIVE PURPOSE ONLY.
 PLAN VIEW IS REPRODUCED FROM CONTRACT DRAWINGS
 PROVIDED BY VERMONT STATE DOT, DATED 8/28/00.
 REFER TO CONTRACT DRAWINGS FOR EXACT WALL LOCATION.

PLAN VIEW
 NOT TO SCALE

M1087503.DWG

THIS DESIGN IS BASED UPON SPECIFIC PROPERTIES OF TENSAR PRODUCTS (GEOGRIDS, DRAINAGE COMPOSITES AND EROSION MEDIA), WHICH ARE PROPRIETARY TO THE TENSAR CORPORATION 1210 CITIZENS PARKWAY, MORROW GA. 30260. ANY SUBSTITUTION OF THE SPECIFIED PRODUCTS WILL INVALIDATE THIS DESIGN. THIS DRAWING IS BEING FURNISHED FOR USE ON THIS SPECIFIC PROJECT ONLY. ANY PARTY ACCEPTING THIS DOCUMENT DOES SO IN CONFIDENCE AND AGREES THAT IT SHALL NOT BE DUPLICATED WHOLE OR IN PART, NOR DISCLOSED TO OTHERS, WITHOUT THE CONSENT OF TENSAR EARTH TECHNOLOGIES, INC.

TENSAR
 EARTH TECHNOLOGIES, INC.
 5883 Glenridge Drive
 Suite 200
 Atlanta, Georgia 30328
 (404) 250-1290

MESA

STATE OF VERMONT
 GERRON R. KOPPEL
 No. 6709
 REGISTERED PROFESSIONAL ENGINEER
 1-9-02
 [SEAL]

REVISIONS \ ISSUE	
0	10/19/01 ISSUED FOR BID
1	12/3/01 ISSUED FOR REVIEW
2	1/7/02 ISSUED FOR BID


Project Number M10875
Date Drawn 10/19/01
Scale
As Shown
Designed by WL
Drawn by KJK
Checked by [Signature]

VERMONT ROUTE - 9
 BRATTLEBORO, VERMONT

PLAN VIEW

Sheet Number
3 of 7

PROJECT NO. NH BRF 012-(K33) Sheet 140 of 145

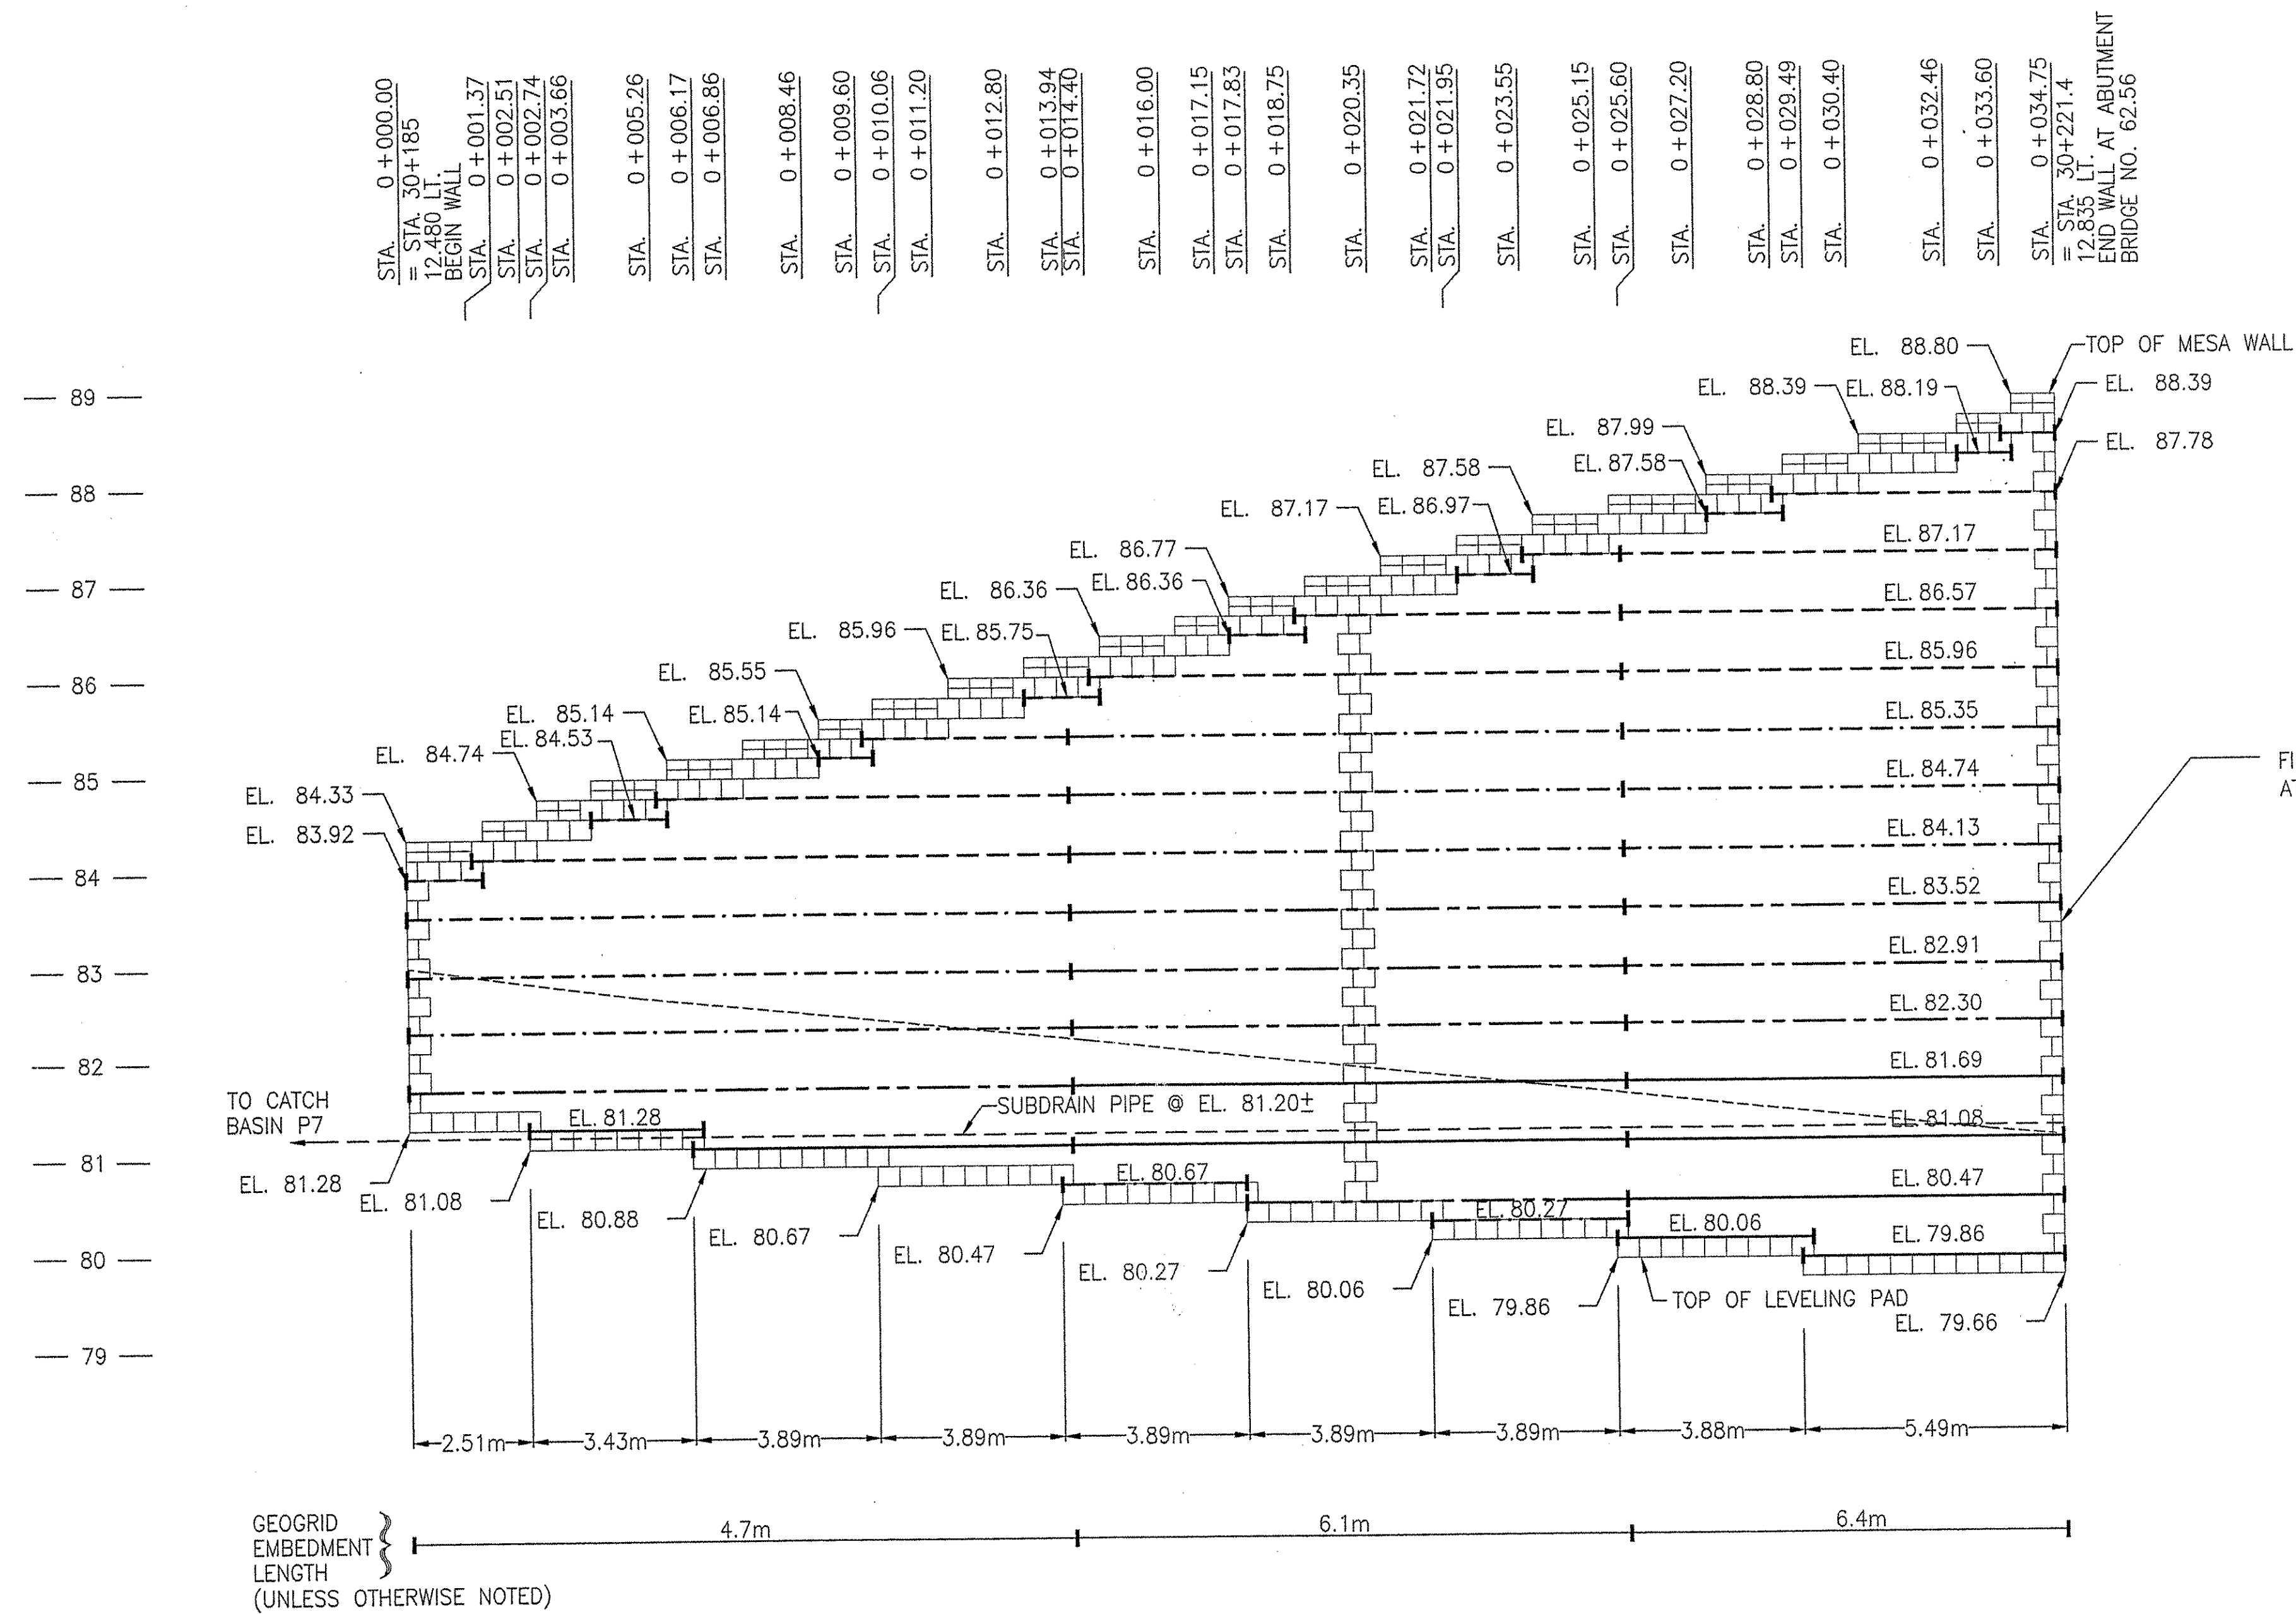

FRONT FACE ELEVATION VIEW

LEGEND

- MESA CAP UNIT
- MESA STANDARD UNIT
- - - - - PROPOSED GRADE
- - - - - CHANGE IN EMBEDMENT LENGTH OR GEOGRID TERMINATION
- - - - - TENSAR MESA3 GEOGRID
- - - - - TENSAR MESA4 GEOGRID
- - - - - TENSAR MESA5 GEOGRID
- - - - - TENSAR MESA6 GEOGRID
- EL. XXX.X (X.Xm) APPROX. GEOGRID ELEVATION
- (XX%) GEOGRID EMBEDMENT LENGTH
- (XX%) GEOGRID PERCENT COVERAGE

0 HORIZONTAL 5
0 VERTICAL 2.5

M1087504.DWG

THIS DESIGN IS BASED UPON SPECIFIC PROPERTIES OF TENSAR PRODUCTS (GEOGRIDS, DRAINAGE COMPOSITES AND EROSION MEDIA), WHICH ARE PROPRIETARY TO THE TENSAR CORPORATION 1210 CITIZENS PARKWAY, MORROW GA. 30260. ANY SUBSTITUTION OF THE SPECIFIED PRODUCTS WILL INVALIDATE THIS DESIGN. THIS DRAWING IS BEING FURNISHED FOR USE ON THIS SPECIFIC PROJECT ONLY. ANY PARTY ACCEPTING THIS DOCUMENT DOES SO IN CONFIDENCE AND AGREES THAT IT SHALL NOT BE DUPLICATED WHOLE OR IN PART, NOR DISCLOSED TO OTHERS, WITHOUT THE CONSENT OF TENSAR EARTH TECHNOLOGIES, INC.

TENSAR
EARTH TECHNOLOGIES, INC.
5883 Glenridge Drive
Suite 200
Atlanta, Georgia 30328
(404) 250-1290




1-9-02
[SEAL]

REVISIONS \ ISSUE		
0	10/19/01	ISSUED FOR BID
1	12/3/01	ISSUED FOR REVIEW
2	1/7/02	ISSUED FOR BID


Project Number	M10875
Date Drawn	10/19/01
Scale	As Shown
Designed by	WL
Drawn by	KJK
Checked by	[Signature]

VERMONT ROUTE - 9
BRATTLEBORO, VERMONT

ELEVATION VIEW
Sheet Number 4 of 7

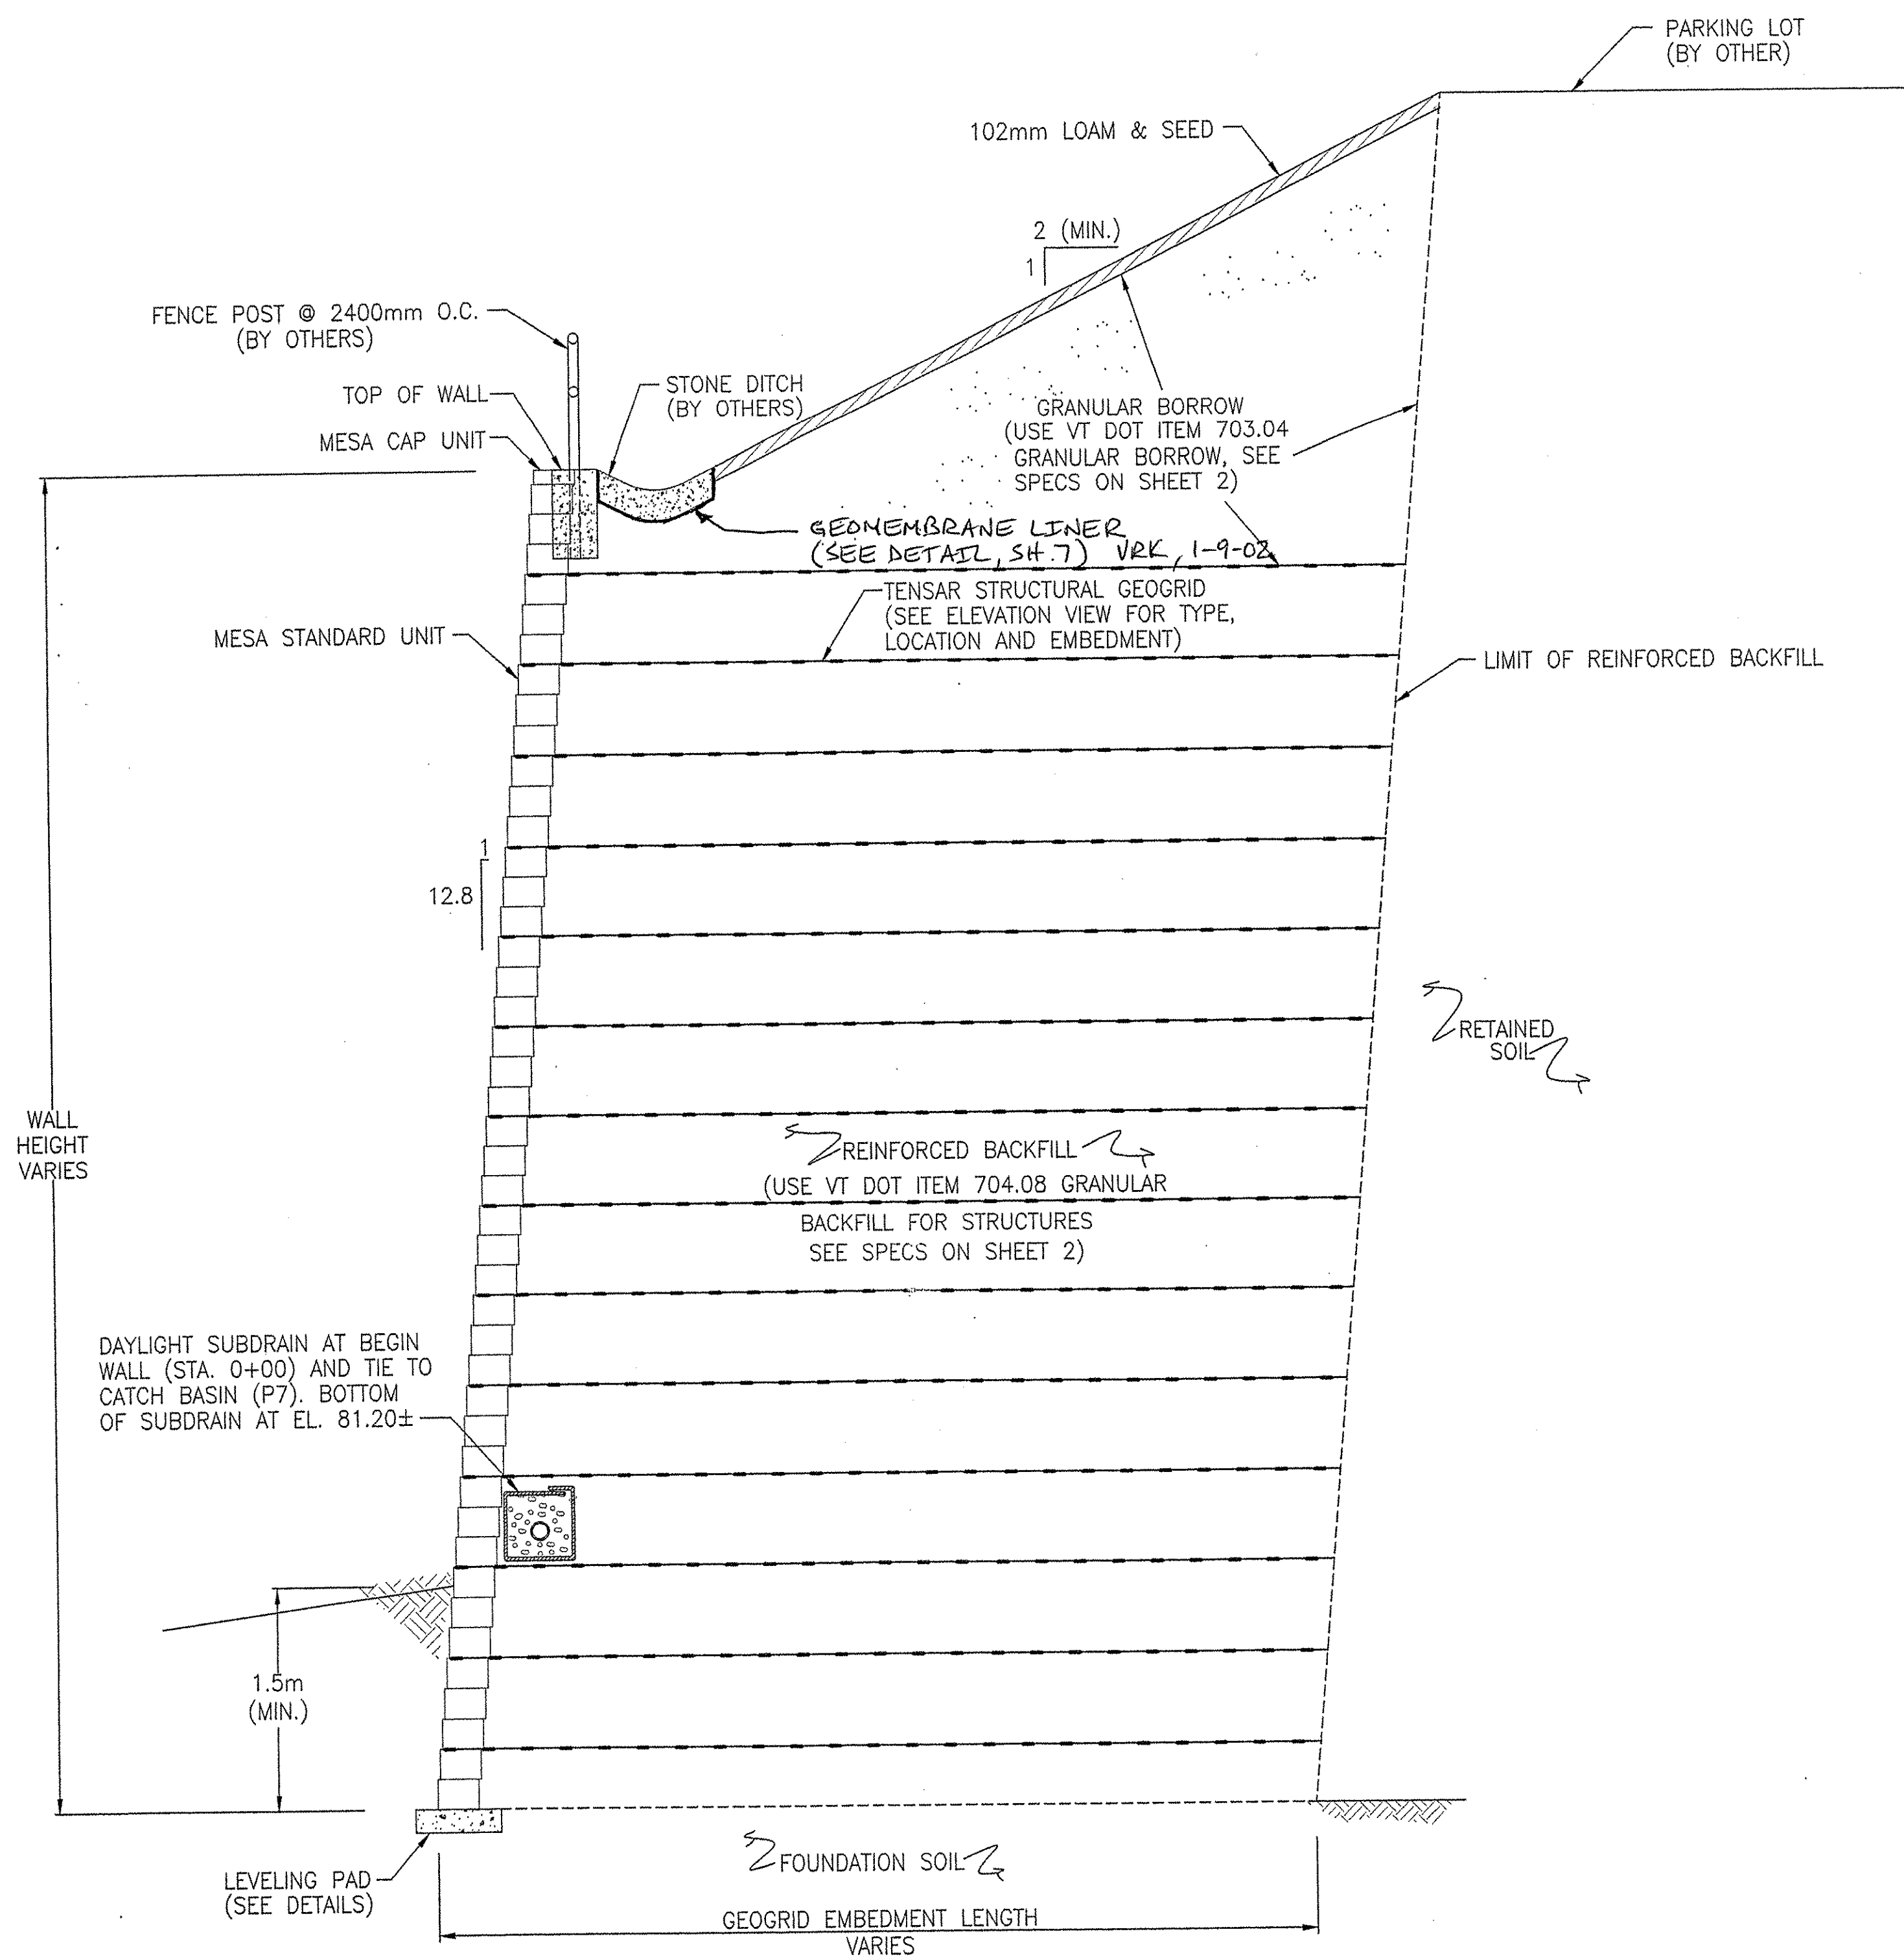


TYPICAL CROSS-SECTION

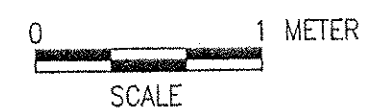

M1087505.DWG

THIS DESIGN IS BASED UPON SPECIFIC PROPERTIES OF TENSAR PRODUCTS (GEOGRIDS, DRAINAGE COMPOSITES AND EROSION MEDIA), WHICH ARE PROPRIETARY TO THE TENSAR CORPORATION 1210 CITIZENS PARKWAY, MORROW GA. 30260. ANY SUBSTITUTION OF THE SPECIFIED PRODUCTS WILL INVALIDATE THIS DESIGN. THIS DRAWING IS BEING FURNISHED FOR USE ON THIS SPECIFIC PROJECT ONLY. ANY PARTY ACCEPTING THIS DOCUMENT DOES SO IN CONFIDENCE AND AGREES THAT IT SHALL NOT BE DUPLICATED WHOLE OR IN PART, NOR DISCLOSED TO OTHERS, WITHOUT THE CONSENT OF TENSAR EARTH TECHNOLOGIES, INC.

TENSAR
EARTH TECHNOLOGIES, INC.
5883 Glenridge Drive
Suite 200
Atlanta, Georgia 30328
(404) 250-1290

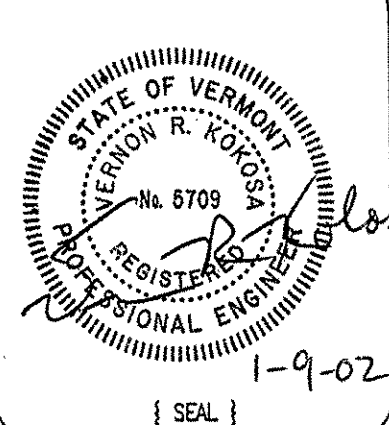


REVISIONS \ ISSUE	
0	10/19/01 ISSUED FOR BID
1	12/3/01 ISSUED FOR REVIEW
2	1/7/02 ISSUED FOR BID

Project Number	M10875
Date Drawn	10/19/01
Scale	As Shown
Designed by	WL
Drawn by	KJK
Checked by	W


VERMONT ROUTE - 9
BRATTLEBORO, VERMONT

TYPICAL CROSS-SECTION


Sheet Number 5 of 7

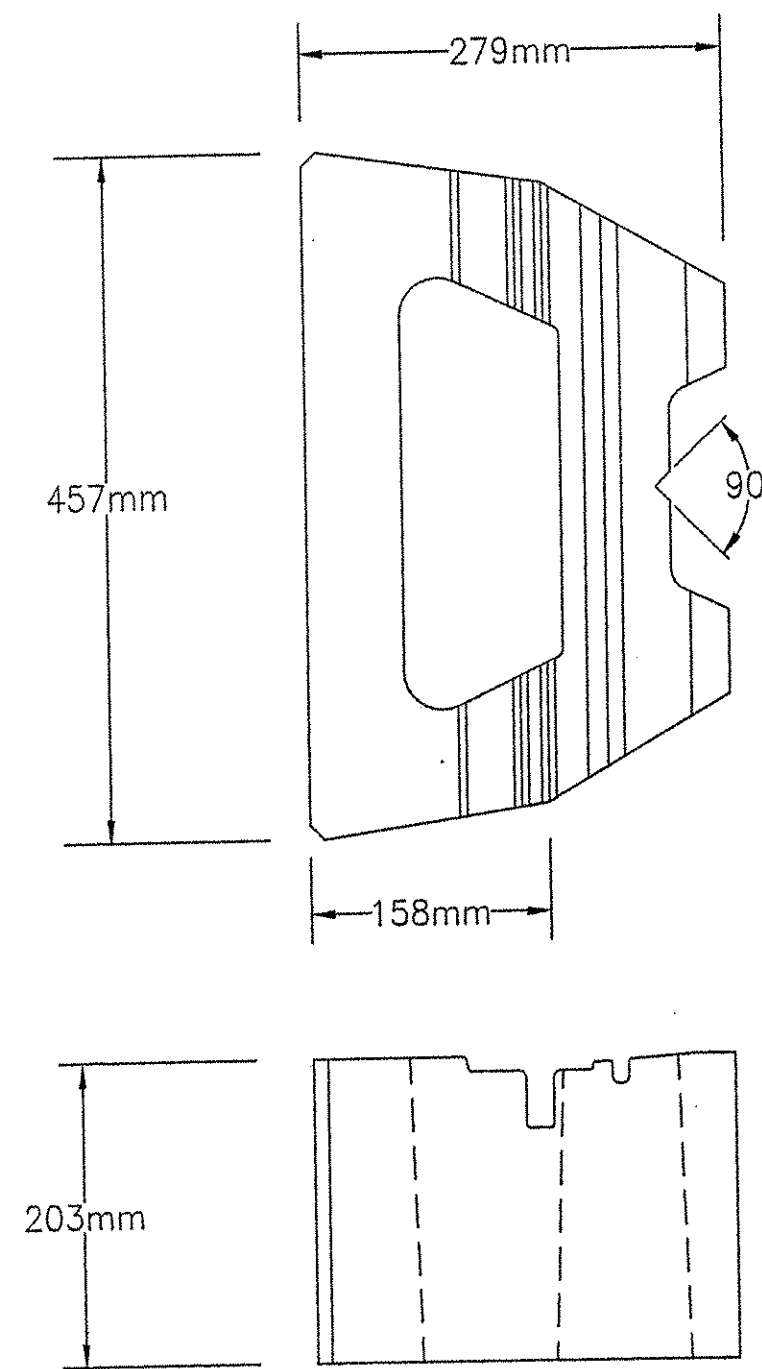


MESA STANDARD BLOCK
NOT TO SCALE

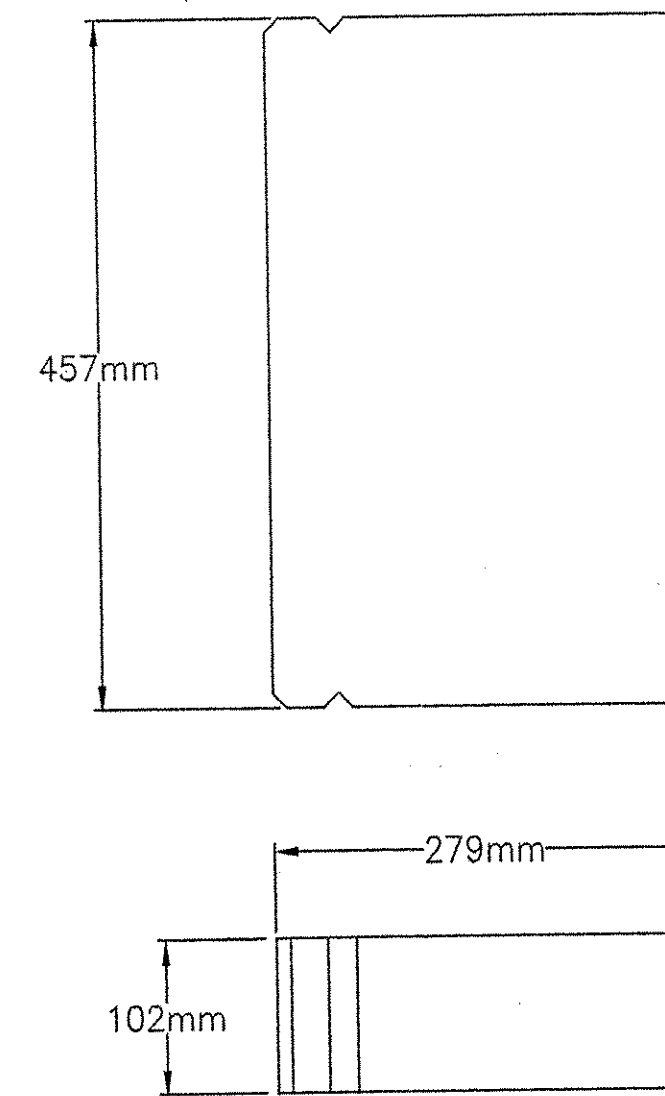


MESA STRAIGHT SIDED CAP UNIT
NOT TO SCALE

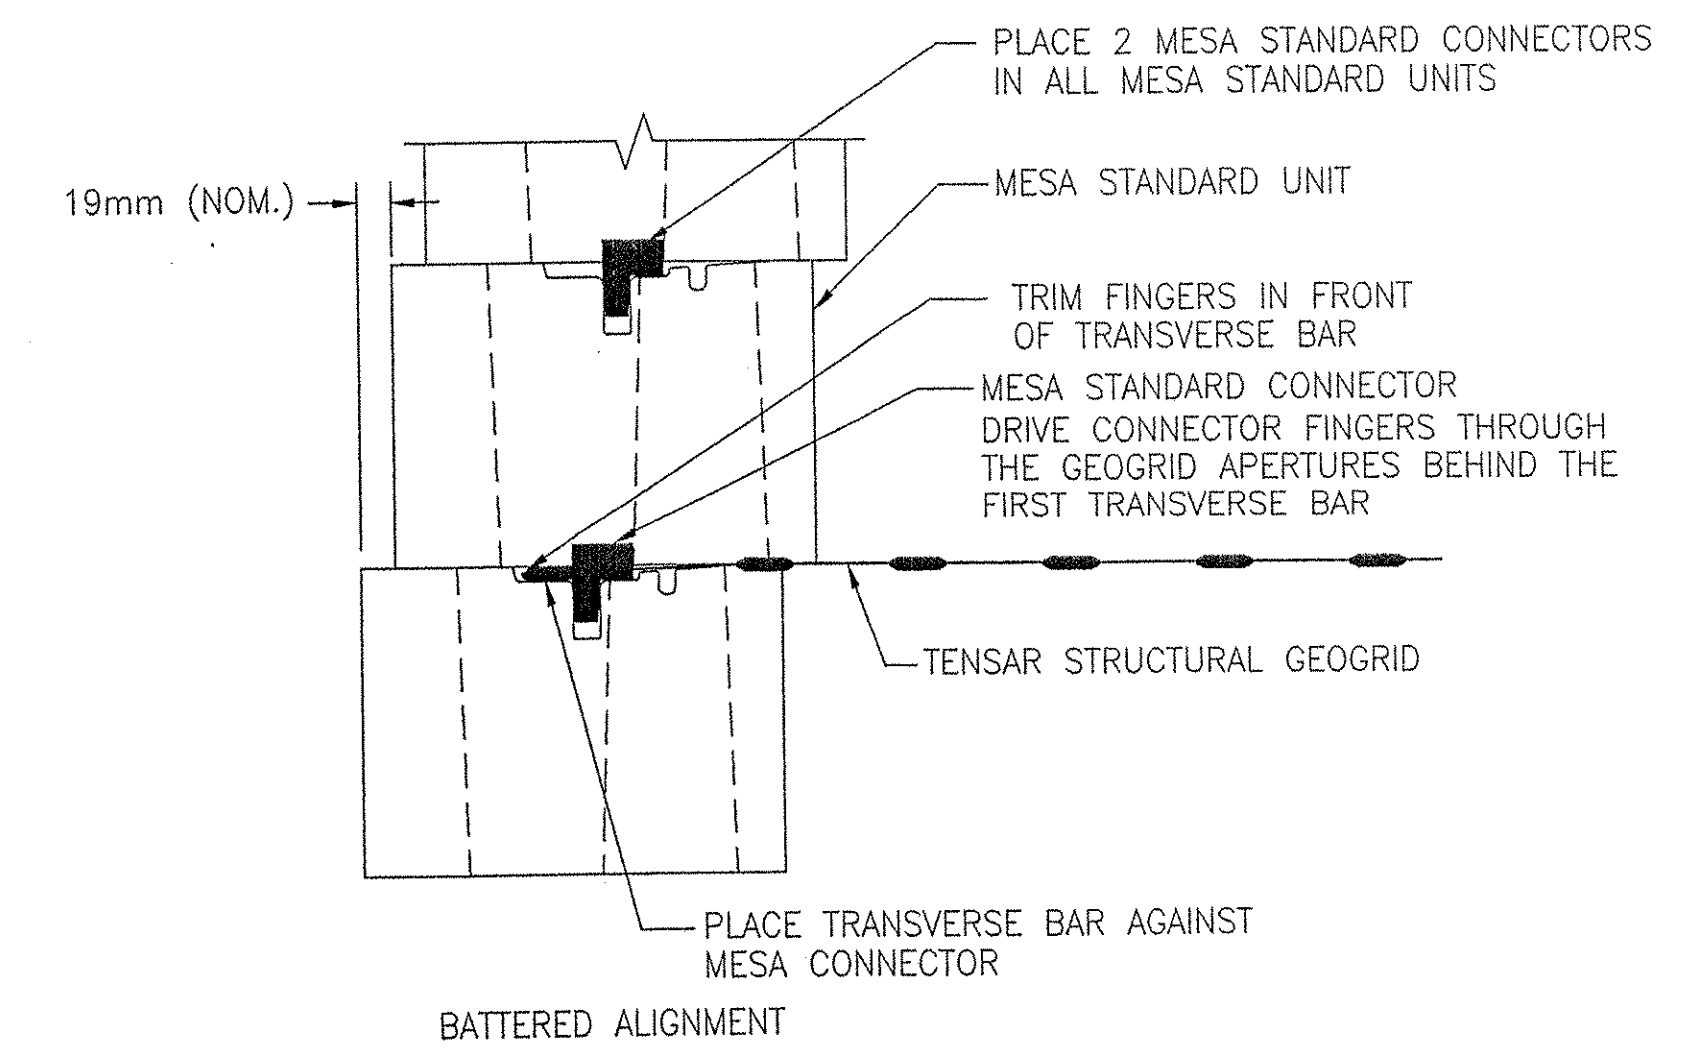


MESA STANDARD UNIT AND GEOGRID CONNECTION DETAIL
NOT TO SCALE

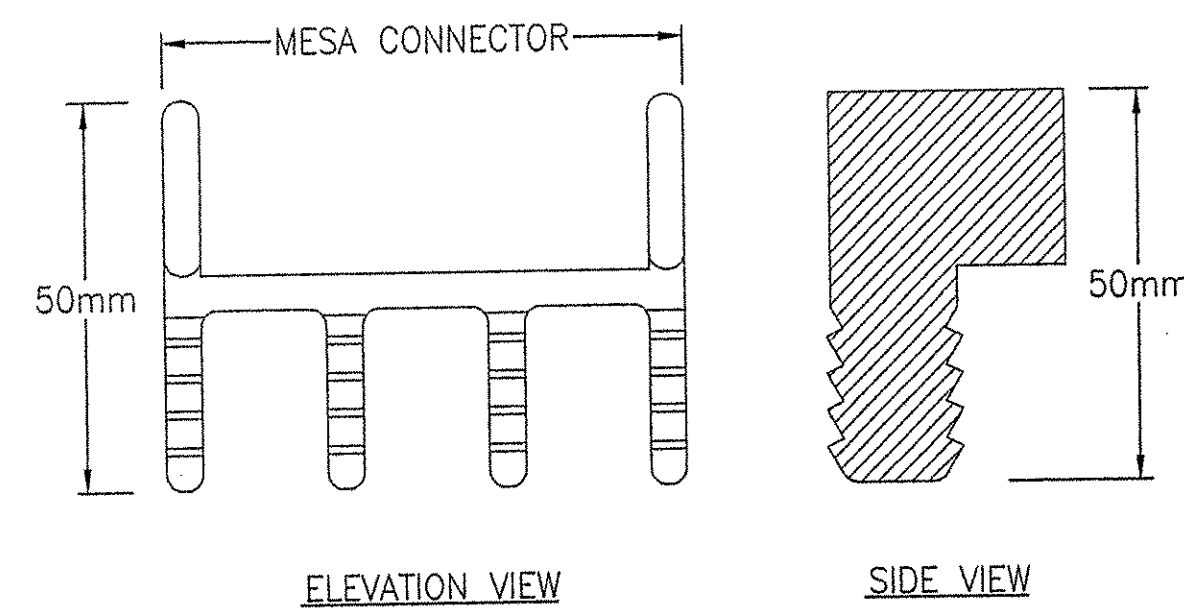

MESA STANDARD CONNECTOR
NOT TO SCALE

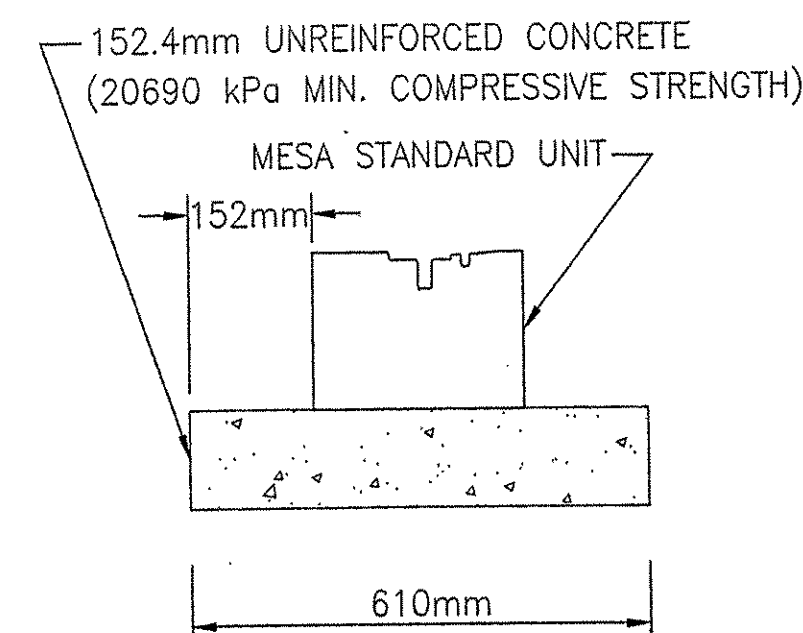



LEVELING PAD DETAIL
NOT TO SCALE

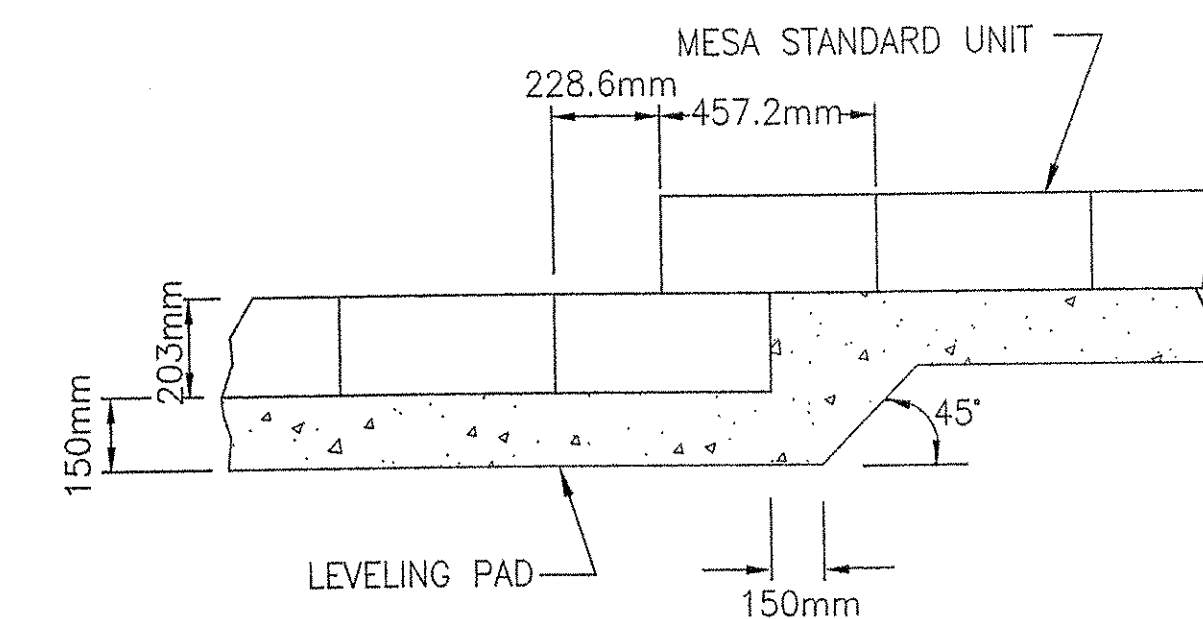

TYPICAL LEVELING PAD STEP DETAIL
NOT TO SCALE

M1087506.DWG

THIS DESIGN IS BASED UPON SPECIFIC PROPERTIES OF TENSAR PRODUCTS (GEOGRIDS, DRAINAGE COMPOSITES AND EROSION MEDIA), WHICH ARE PROPRIETARY TO THE TENSAR CORPORATION 1210 CITIZENS PARKWAY, MORROW CA. 30260. ANY SUBSTITUTION OF THE SPECIFIED PRODUCTS WILL INVALIDATE THIS DESIGN. THIS DRAWING IS BEING FURNISHED FOR USE ON THIS SPECIFIC PROJECT ONLY. ANY PARTY ACCEPTING THIS DOCUMENT DOES SO IN CONFIDENCE AND AGREES THAT IT SHALL NOT BE DUPLICATED WHOLE OR IN PART, NOR DISCLOSED TO OTHERS, WITHOUT THE CONSENT OF TENSAR EARTH TECHNOLOGIES, INC.

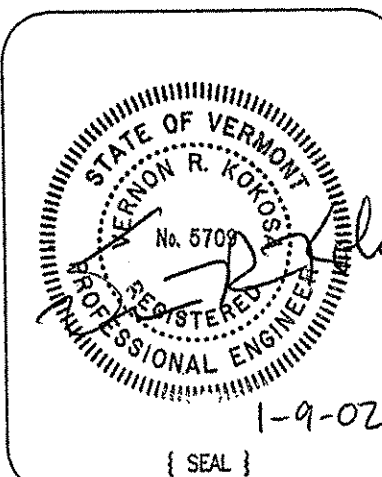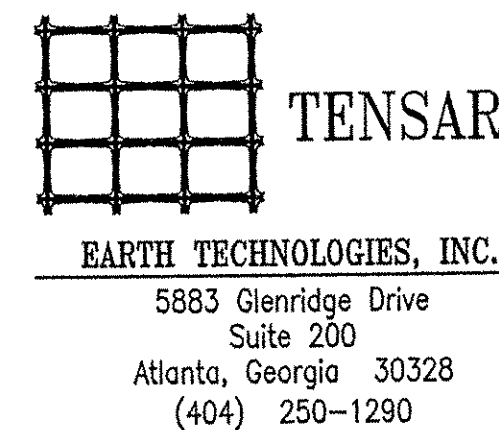


REVISIONS \ ISSUE		
0	10/19/01	ISSUED FOR BID
1	12/3/01	ISSUED FOR REVIEW
2	1/7/02	ISSUED FOR BID

Project Number M10875
Date Drawn 10/19/01
Scale
As Shown
Designed by WL
Drawn by KJK
Checked by CV


VERMONT ROUTE - 9
BRATTLEBORO, VERMONT

TYPICAL DETAILS


Sheet Number
6 of 7

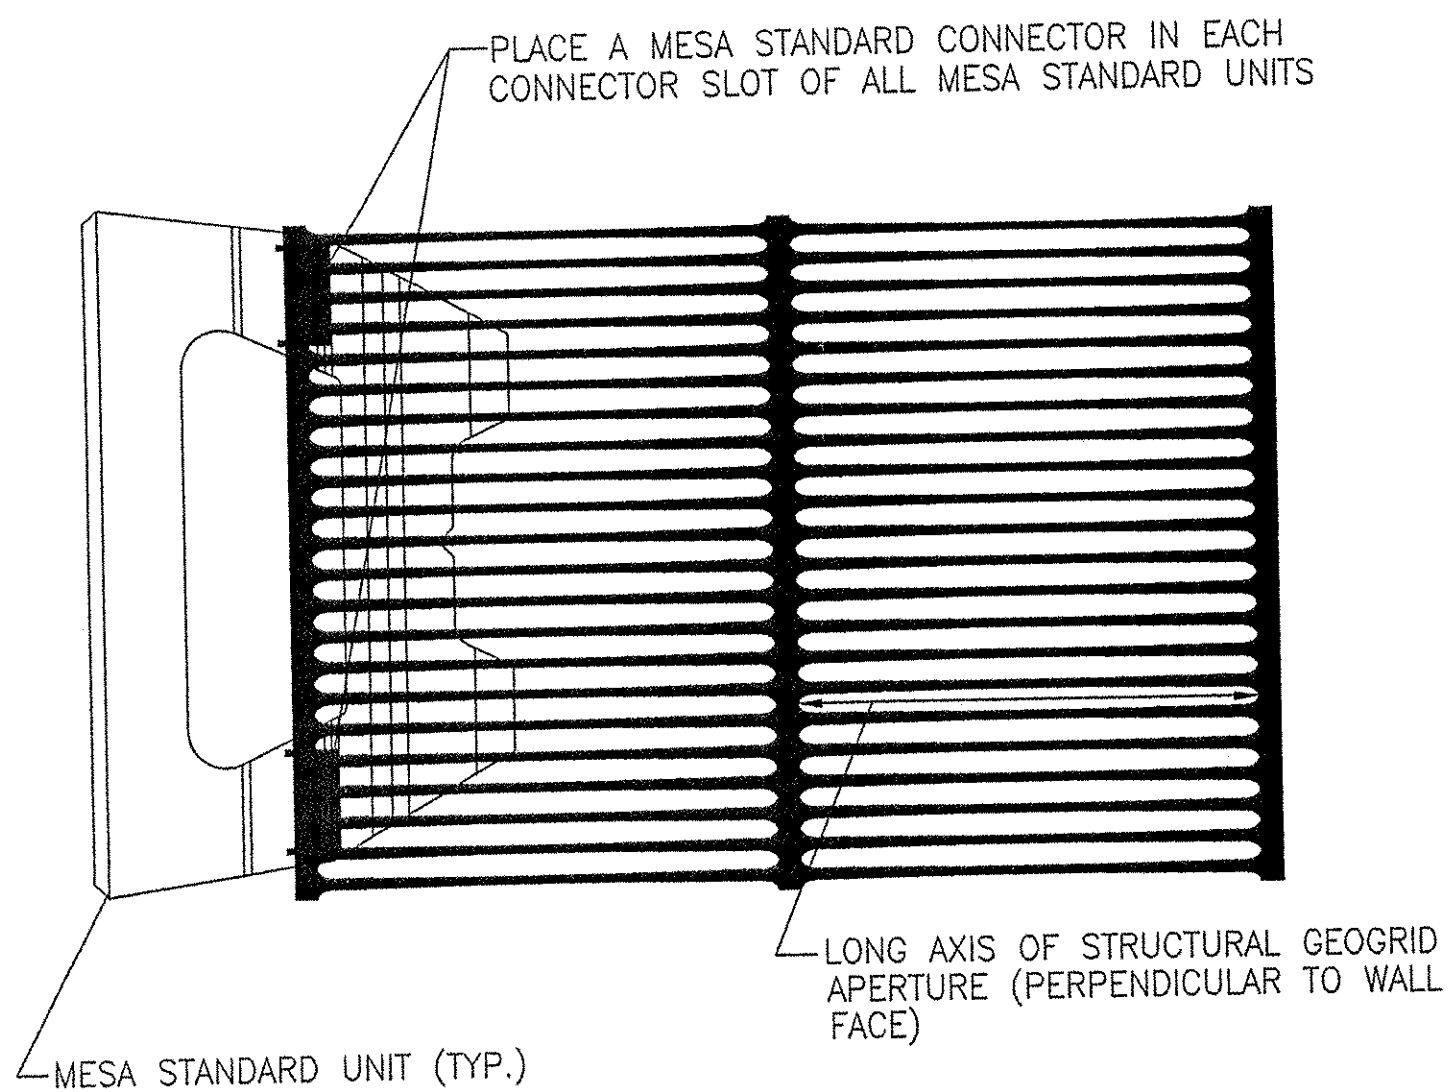

GEOGRID ORIENTATION
NOT TO SCALE

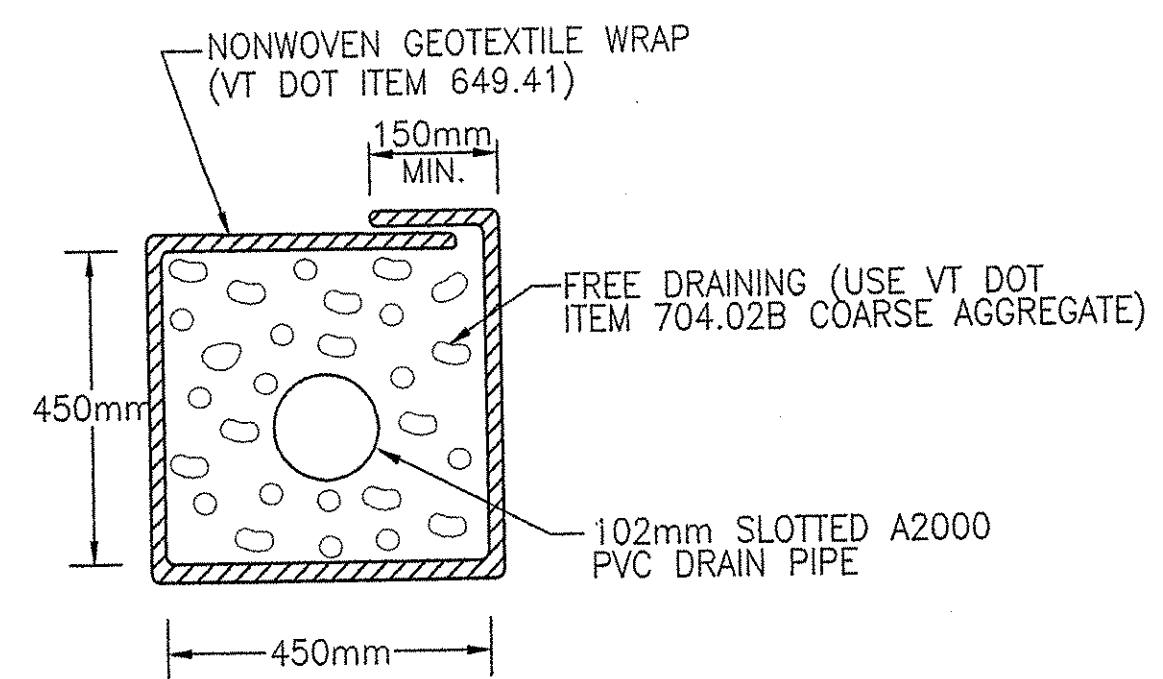


SUBDRAIN DETAIL
NOT TO SCALE

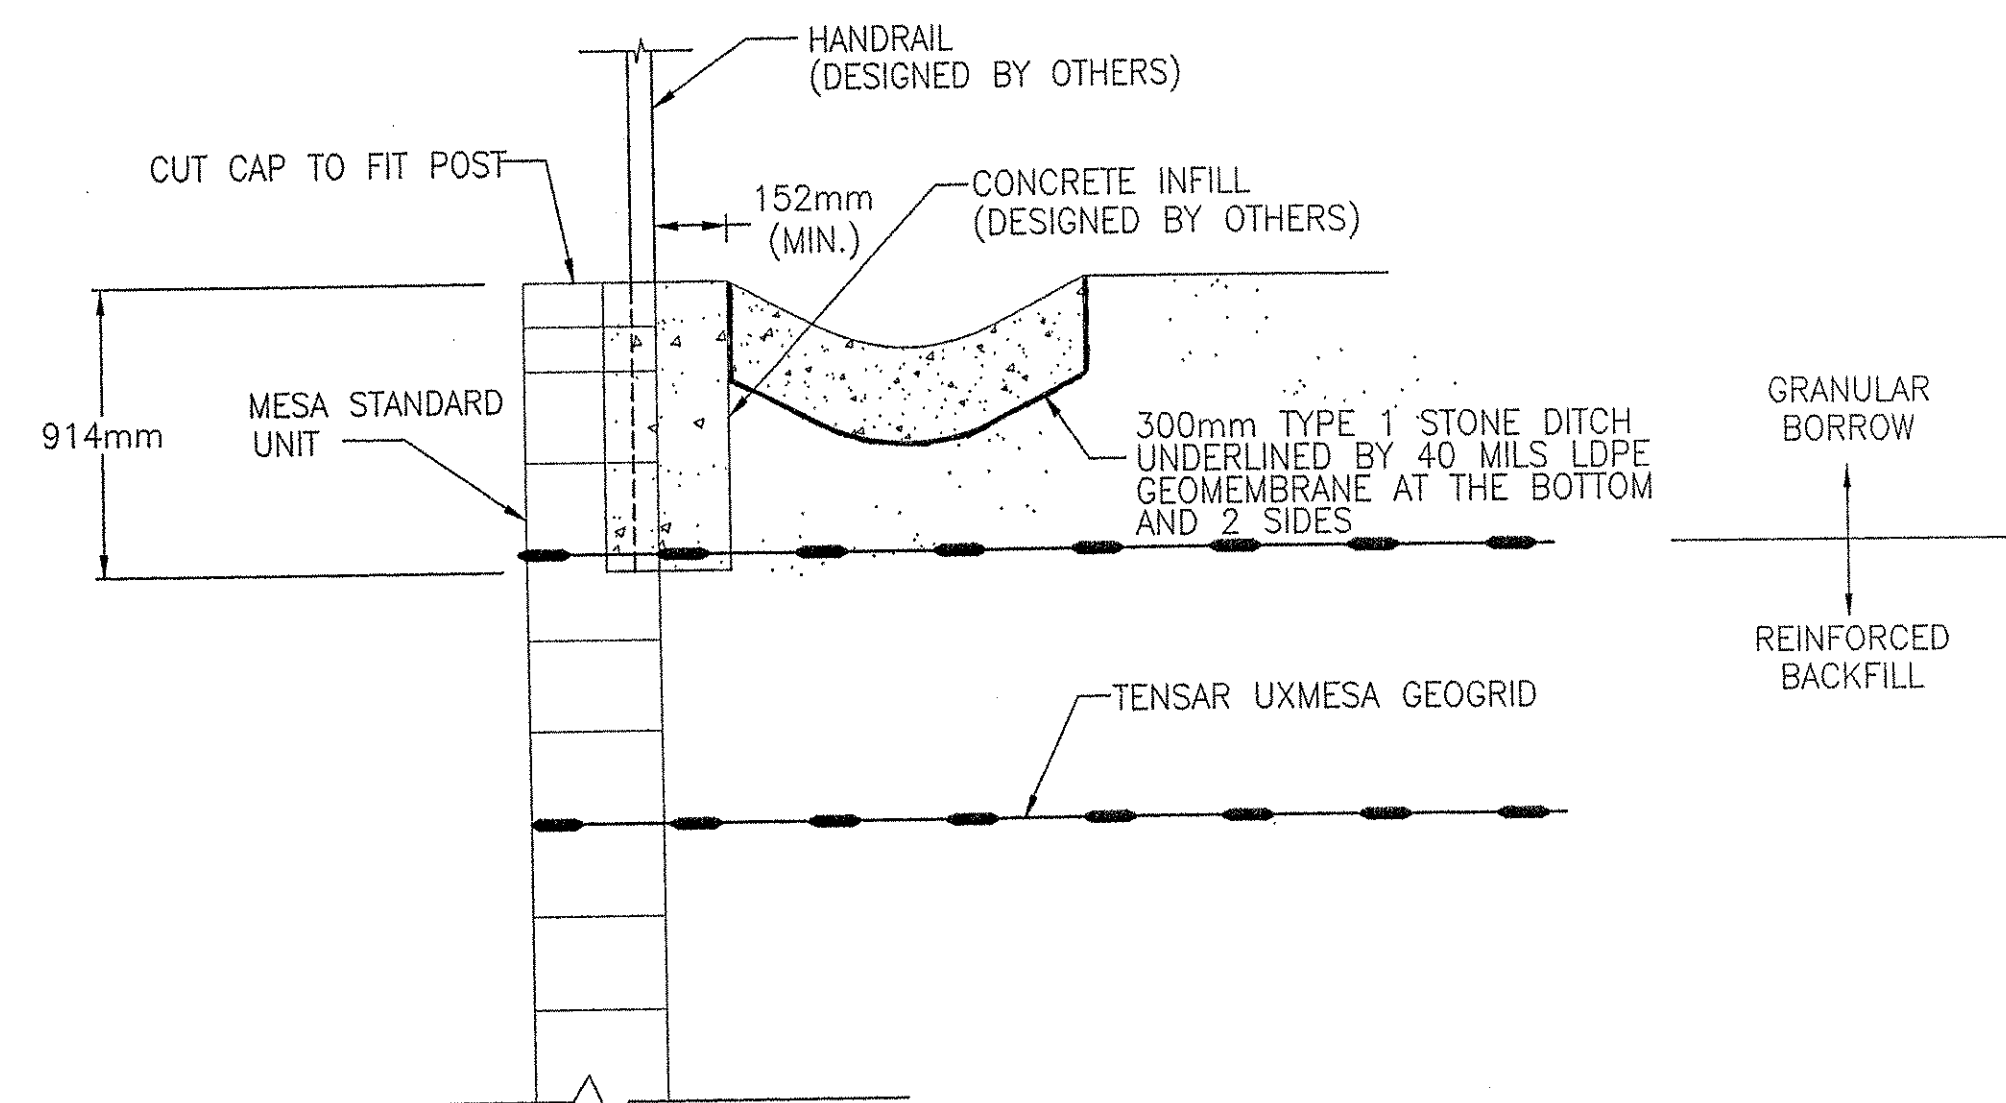


- STEP 1: PLACE AND COMPACT REINFORCED BACKFILL TO BOTTOM OF HANDRAIL.
- STEP 2: PLACE TOP LAYER OF TENSAR UXMESA GEOGRID AND REMAINING MESA STANDARD UNITS ABOVE IT.
- STEP 3: CUT TENSAR UXMESA GEOGRID AND THEN SET HANDRAIL POST, FORM AND POUR CONCRETE INFILL AT TAIL OF MESA STANDARD UNITS.


HANDRAIL ON TOP OF WALL DETAIL
NOT TO SCALE

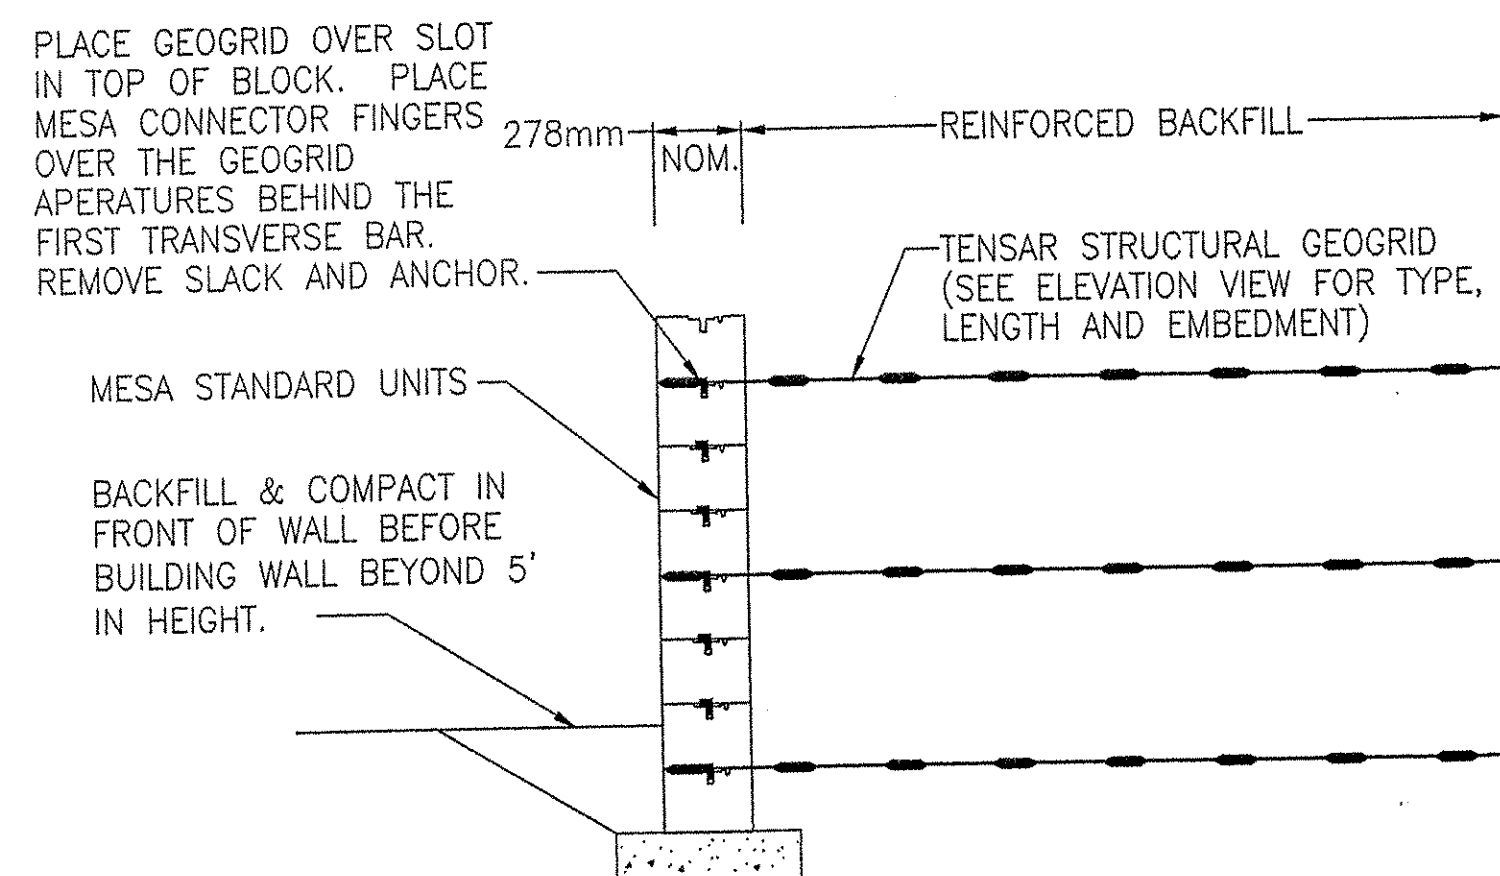

GEOGRID ATTACHMENT DETAIL
NOT TO SCALE

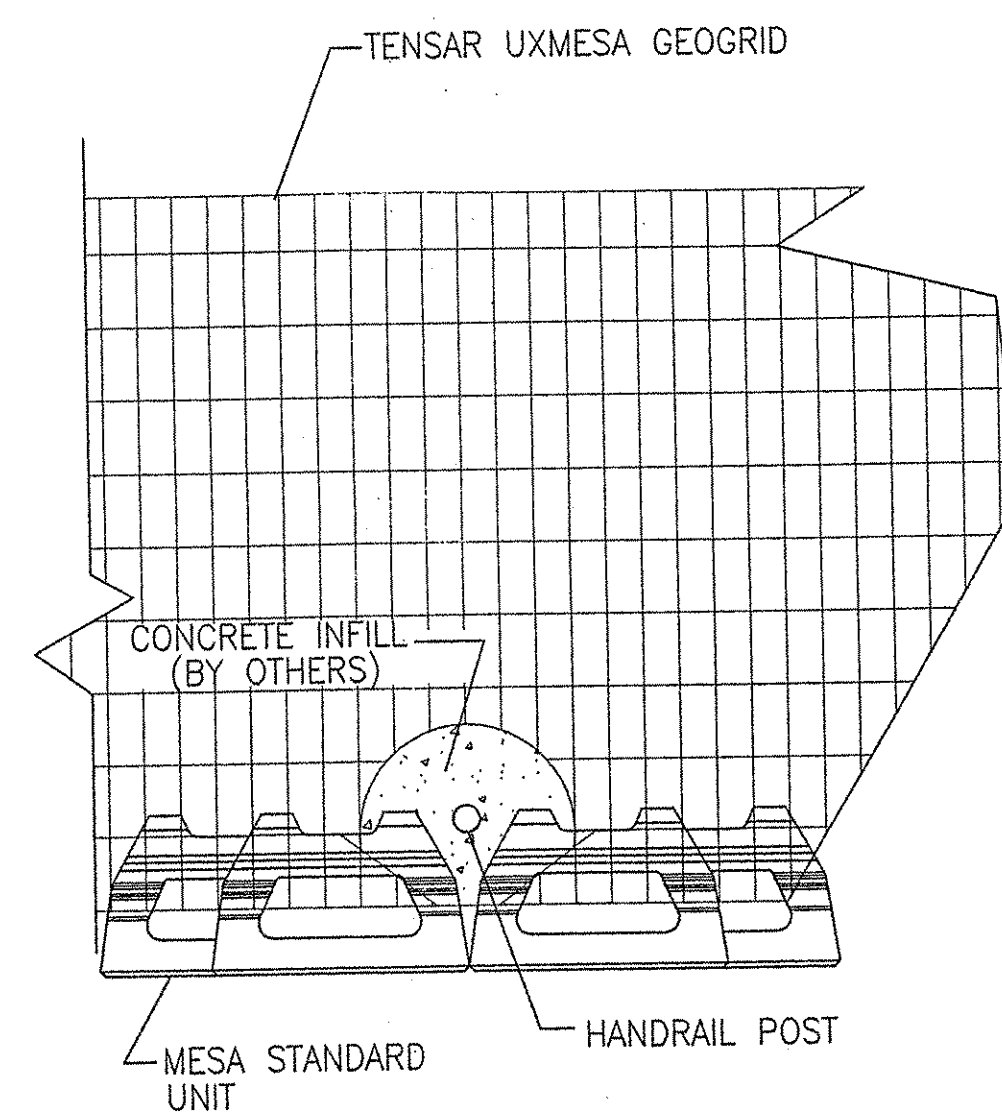

PLAN VIEW
DETAIL OF HANDRAIL ON TOP OF WALL
NOT TO SCALE

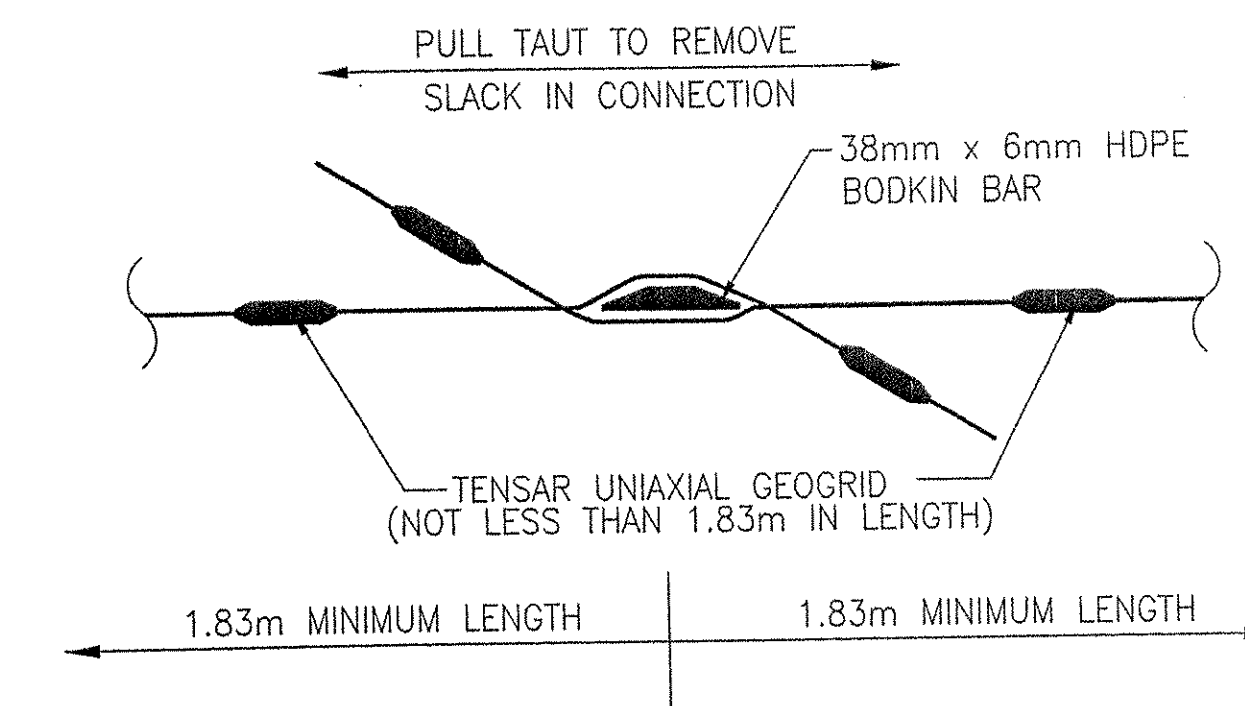

BODKIN CONNECTION
NOT TO SCALE

M1087507.DWG

THIS DESIGN IS BASED UPON SPECIFIC PROPERTIES OF TENSAR PRODUCTS (GEOGRIDS, DRAINAGE COMPOSITES AND EROSION MEDIA), WHICH ARE PROPRIETARY TO THE TENSAR CORPORATION 1210 CITIZENS PARKWAY, MORROW GA. 30260. ANY SUBSTITUTION OF THE SPECIFIED PRODUCTS WILL INVALIDATE THIS DESIGN. THIS DRAWING IS BEING FURNISHED FOR USE ON THIS SPECIFIC PROJECT ONLY. ANY PARTY ACCEPTING THIS DOCUMENT DOES SO IN CONFIDENCE AND AGREES THAT IT SHALL NOT BE DUPLICATED WHOLE OR IN PART, NOR DISCLOSED TO OTHERS, WITHOUT THE CONSENT OF TENSAR EARTH TECHNOLOGIES, INC.

TENSAR

EARTH TECHNOLOGIES, INC.

5883 Glenridge Drive
Suite 200
Atlanta, Georgia 30328
(404) 250-1290

MESA

STATE OF VERMONT
PROFESSIONAL ENGINEER
No. 5708
1-9-02
SEAL

REVISIONS \ ISSUE		
0	10/19/01	ISSUED FOR BID
1	12/3/01	ISSUED FOR REVIEW
2	1/7/02	ISSUED FOR BID

Project Number M10875
Date Drawn 10/19/01
Scale As Shown
Designed by WL
Drawn by KJK
Checked by CV

VERMONT ROUTE - 9

BRATTLEBORO, VERMONT

TYPICAL DETAILS


Sheet Number
7 of 7

PROJECT NO. NH BRF 012-I(33) Sheet 144 of 145


WORK ORDER

Notice: Not for Use/disclosure outside of VERIZON without written agreement

VERIZON

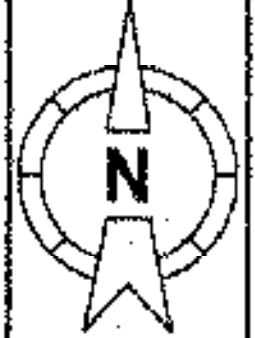	SAFETY NOTES: TRAFFIC, ROAD CONSTRUCTION		MOD/REV NO.	DATE	EWO NO.
	SIGNATURE				PRINT 1 OF
	DATE 3/1/2001				PREPARED BY:
PRE CT YES <input type="checkbox"/> NO <input checked="" type="checkbox"/>		TYPE: AERIAL	RECORD REF: 1-4E	C.O. /EXCHANGE NAME: BRATTLEBORO	
PRIMARY VOLTAGE TO GROUND 7.2 KV MGN SYSTEM		UNDERGROUND	BLOCK (NYT)	C.O. /EXCHANGE CODE: 4731	
CABLE PRESS. TRANSMISSION	UNDER PRESS. YES <input type="checkbox"/> NO <input checked="" type="checkbox"/>	CONDUIT	MANHOLE LOCATION MH# NA		
			AMT. BRIDGE TAP INPUT	KF	

PROJECT # 131104

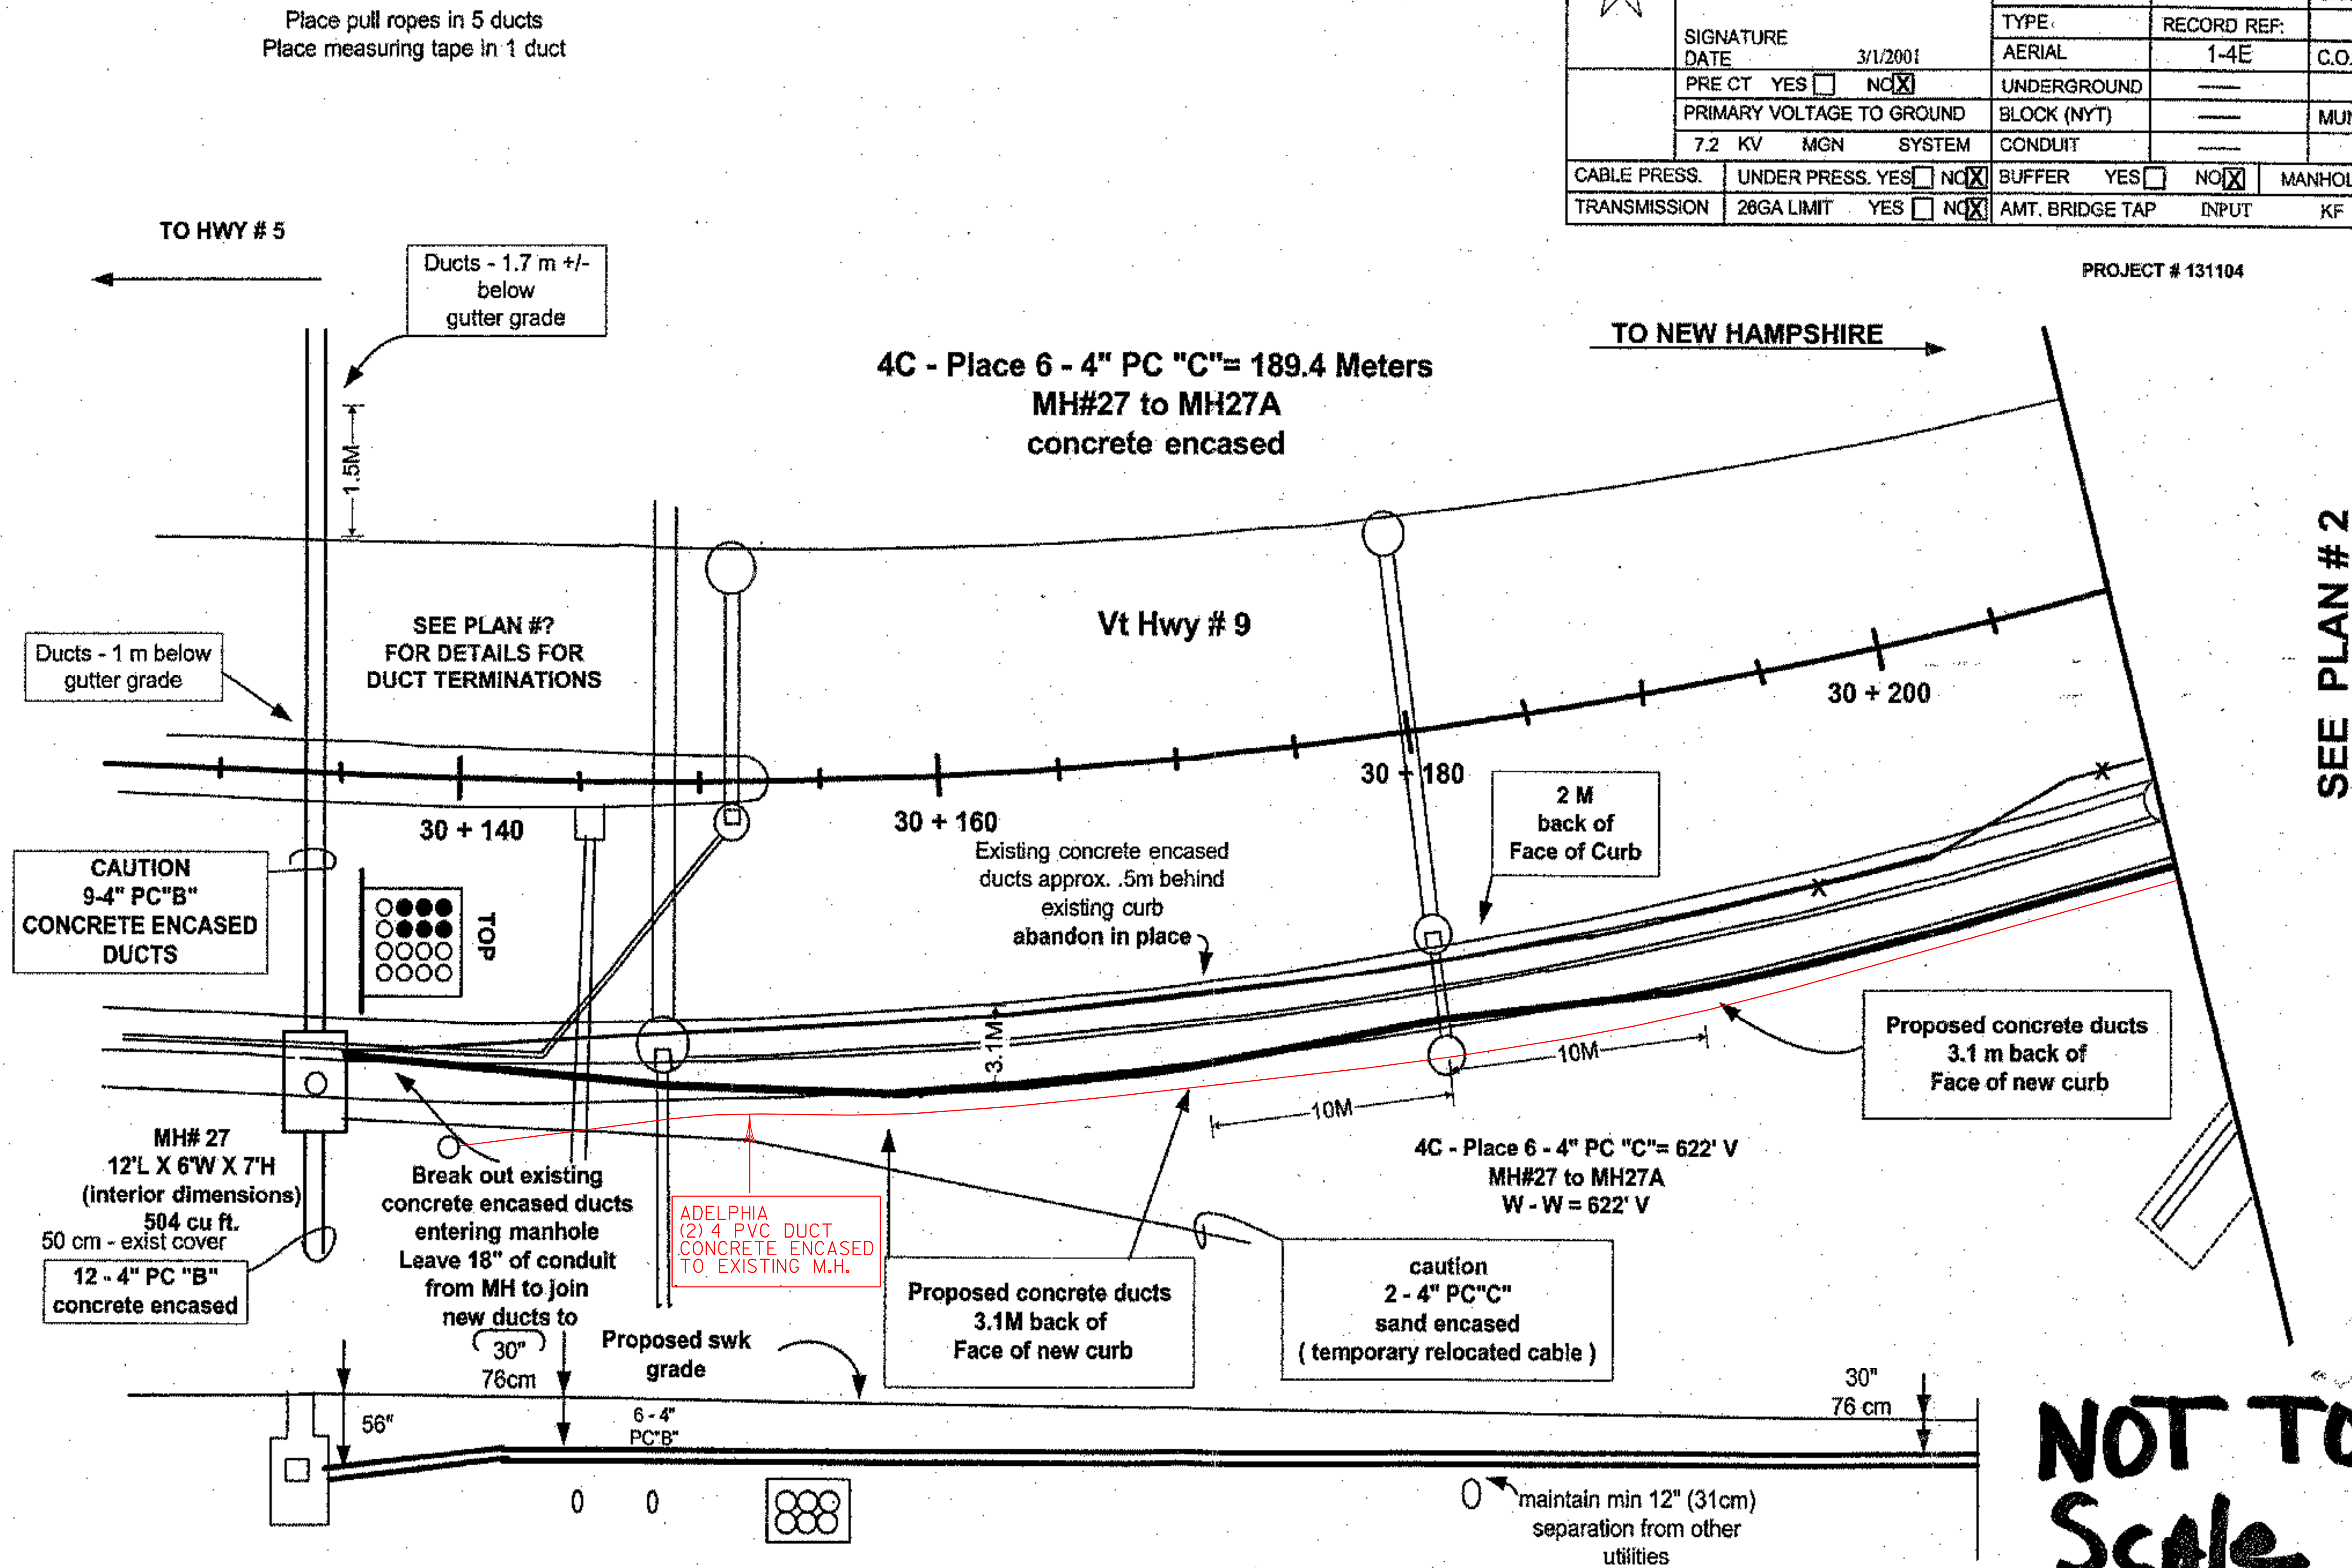

SEE PLAN # 2

NOT TO Scale


145 A

3/8/2001


WORK ORDER

Notice: Not for Use/disclosure outside of VERIZON without written agreement

VERIZON

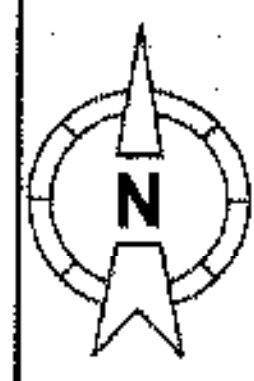	SAFETY NOTES: TRAFFIC, ROAD CONSTRUCTION		MOD/REV NO.	DATE	EWO NO.
	SIGNATURE				PRINT 2 OF
	DATE 3/1/2001				PREPARED BY:
	PRE CT YES <input type="checkbox"/> NO <input checked="" type="checkbox"/>				C.O. /EXCHANGE NAME:
PRIMARY VOLTAGE TO GROUND			TYPE	RECORD REF:	BRATTLEBORO
7.2 KV MGN SYSTEM			AERIAL	1-4E	C.O. /EXCHANGE CODE:
			UNDERGROUND		4731
			BLOCK (NYT)		MUNICIPALITY:
			CONDUIT		BRATTLEBORO
CABLE PRESS.	UNDER PRESS. YES <input type="checkbox"/> NO <input checked="" type="checkbox"/>	BUFFER YES <input type="checkbox"/> NO <input checked="" type="checkbox"/>	MANHOLE LOCATION MH# NA		
TRANSMISSION	26GA LIMIT YES <input type="checkbox"/> NO <input checked="" type="checkbox"/>	AMT. BRIDGE TAP INPUT	KF		

PROJECT # 131104

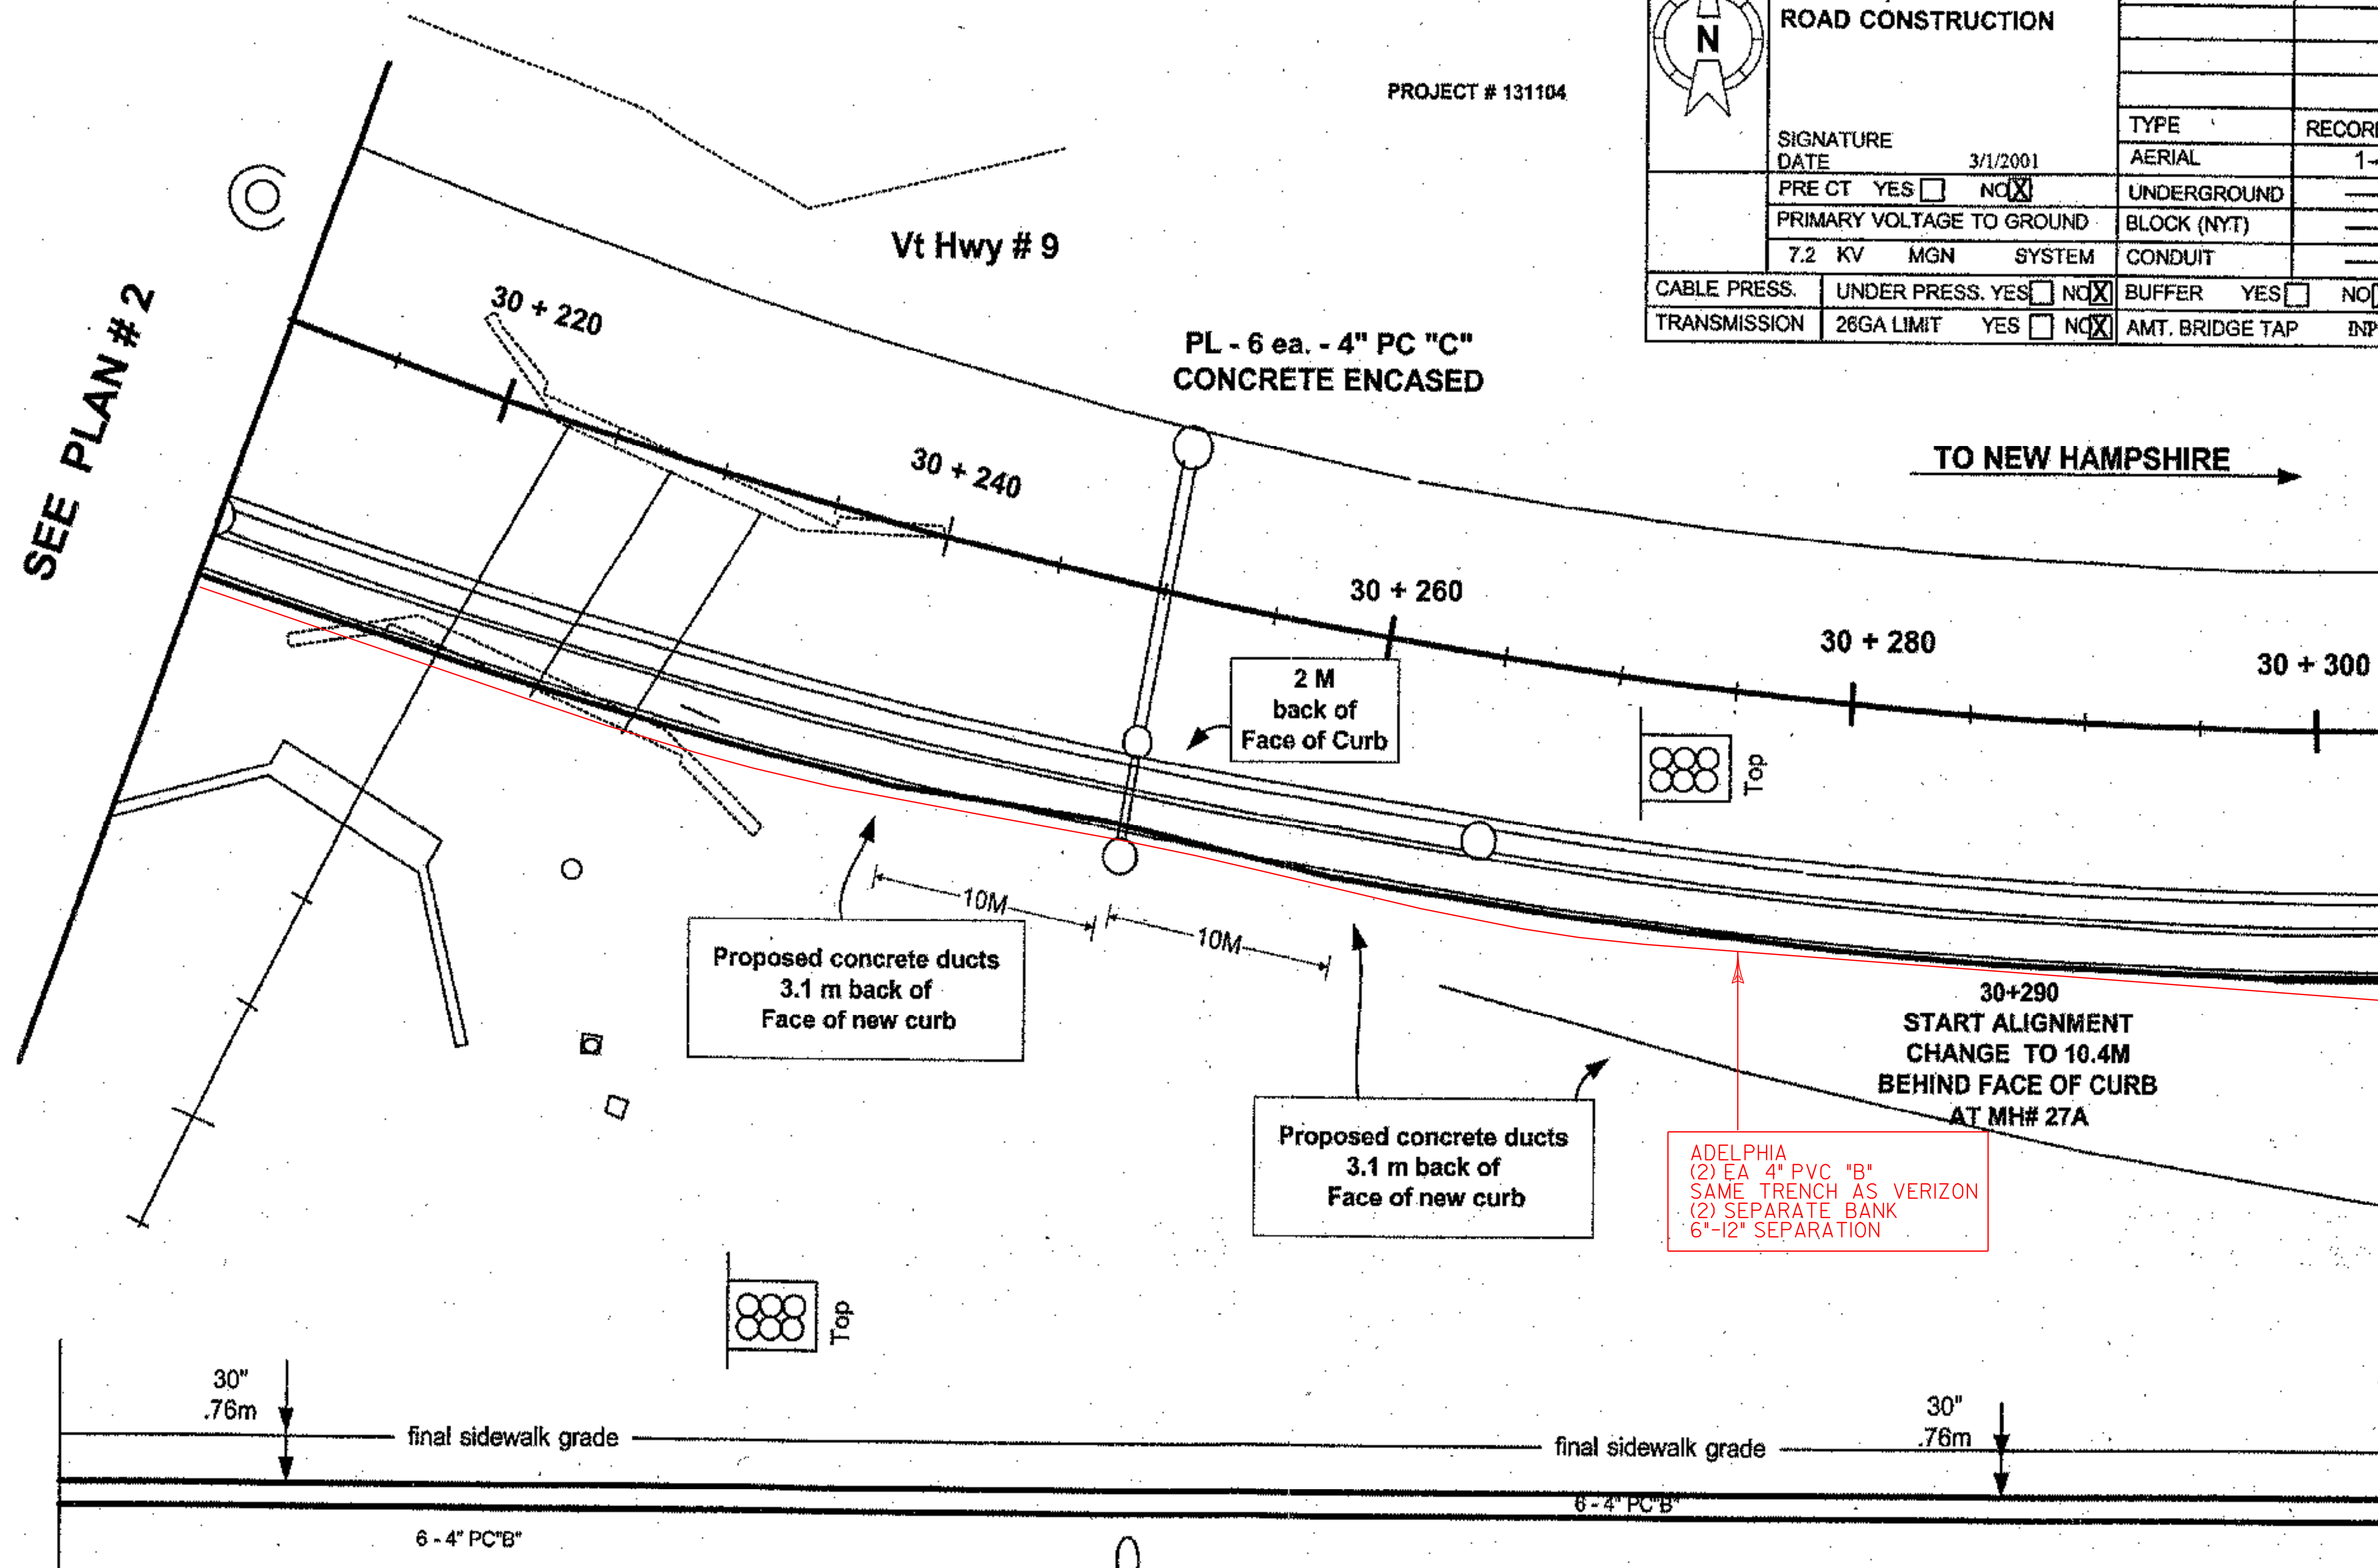

3/8/2001

NOT TO SCALE

145B

WORK ORDER

Notice: Not for Use/disclosure outside of VERIZON without written agreement

VERIZON

4X - ABIP - 12'x6'x7' MH -
(1982)
MH# 27A old
4X - ABIP -MH27A to Pt "A"
- 4 - 4"PC"B" -76'
Verify (1982)

10.4 M FROM C/L
STA 30+320

MH#27A
MH COVER BESIDE SWK
4C - PI - 1 ez - 12'L x 6" W x 7' H
3.66 m LX1.83m W X 2.13m H
E/W 30" (76cm) Frame And Cover
2 - Ladder steps
1 - 8'(2.44 m) hooked ladder -
galvanized

Construction to verify
Wall - Wall distance
MH 27A to MH 27B
=793' V



SAFETY NOTES:
**TRAFFIC,
ROAD CONSTRUCTION**

SIGNATURE
DATE 3/1/2001


PRE CT YES NO
PRIMARY VOLTAGE TO GROUND
7.2 KV MGN SYSTEM

CABLE PRESS. UNDER PRESS. YES NO
TRANSMISSION 26GA LIMIT YES NO

MOD/REV NO.	DATE	EWO NO.
		PRINT 3 OF
		PREPARED BY:
		C.O. /EXCHANGE NAME:
TYPE	RECORD REF:	BRATTLEBORO
AERIAL	1-4E	C.O. /EXCHANGE CODE:
UNDERGROUND		4731
BLOCK (NYT)		MUNICIPALITY:
CONDUIT		BRATTLEBORO
BUFFER YES <input type="checkbox"/> NO <input checked="" type="checkbox"/>	MANHOLE LOCATION MH# NA	
AMT. BRIDGE TAP INPUT	KF	


Project # 131104

SEE PLAN # 2

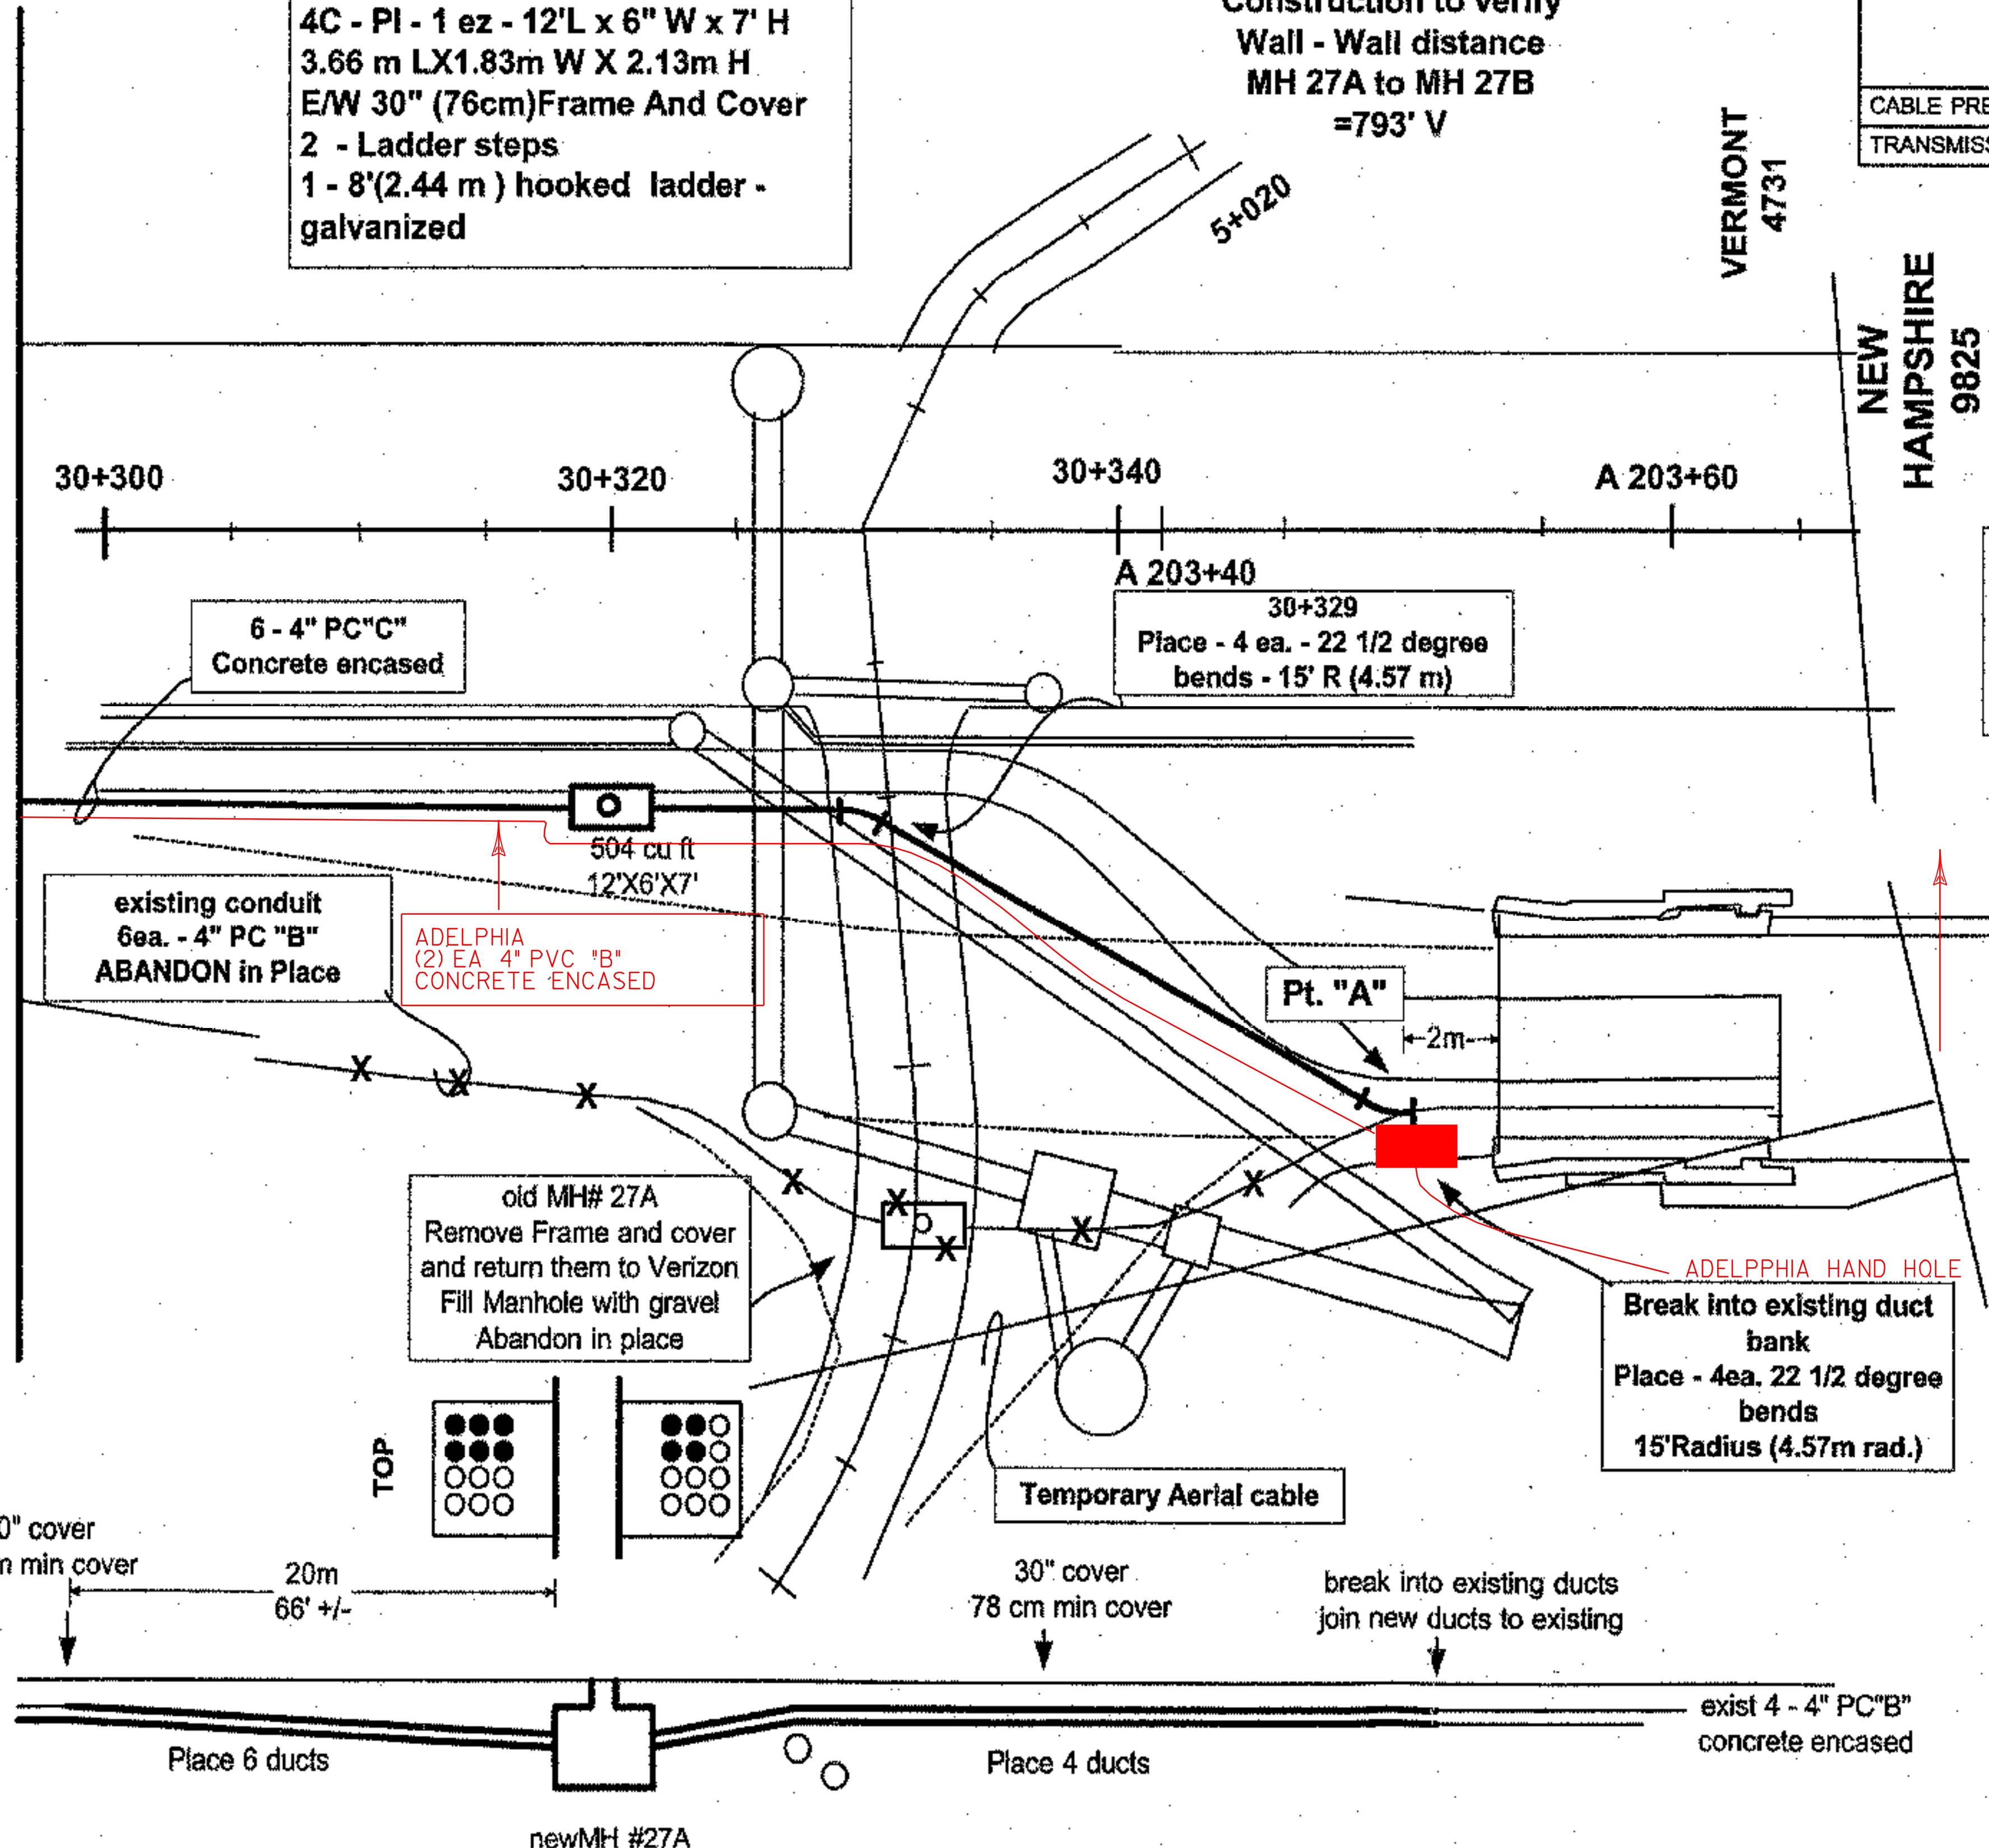

4C - Mh# 27A to Pt "A"
PI - 4 ea. - 4" PC"B"
34.6 m - Verify
114' - verify

CONNECTICUT RIVER

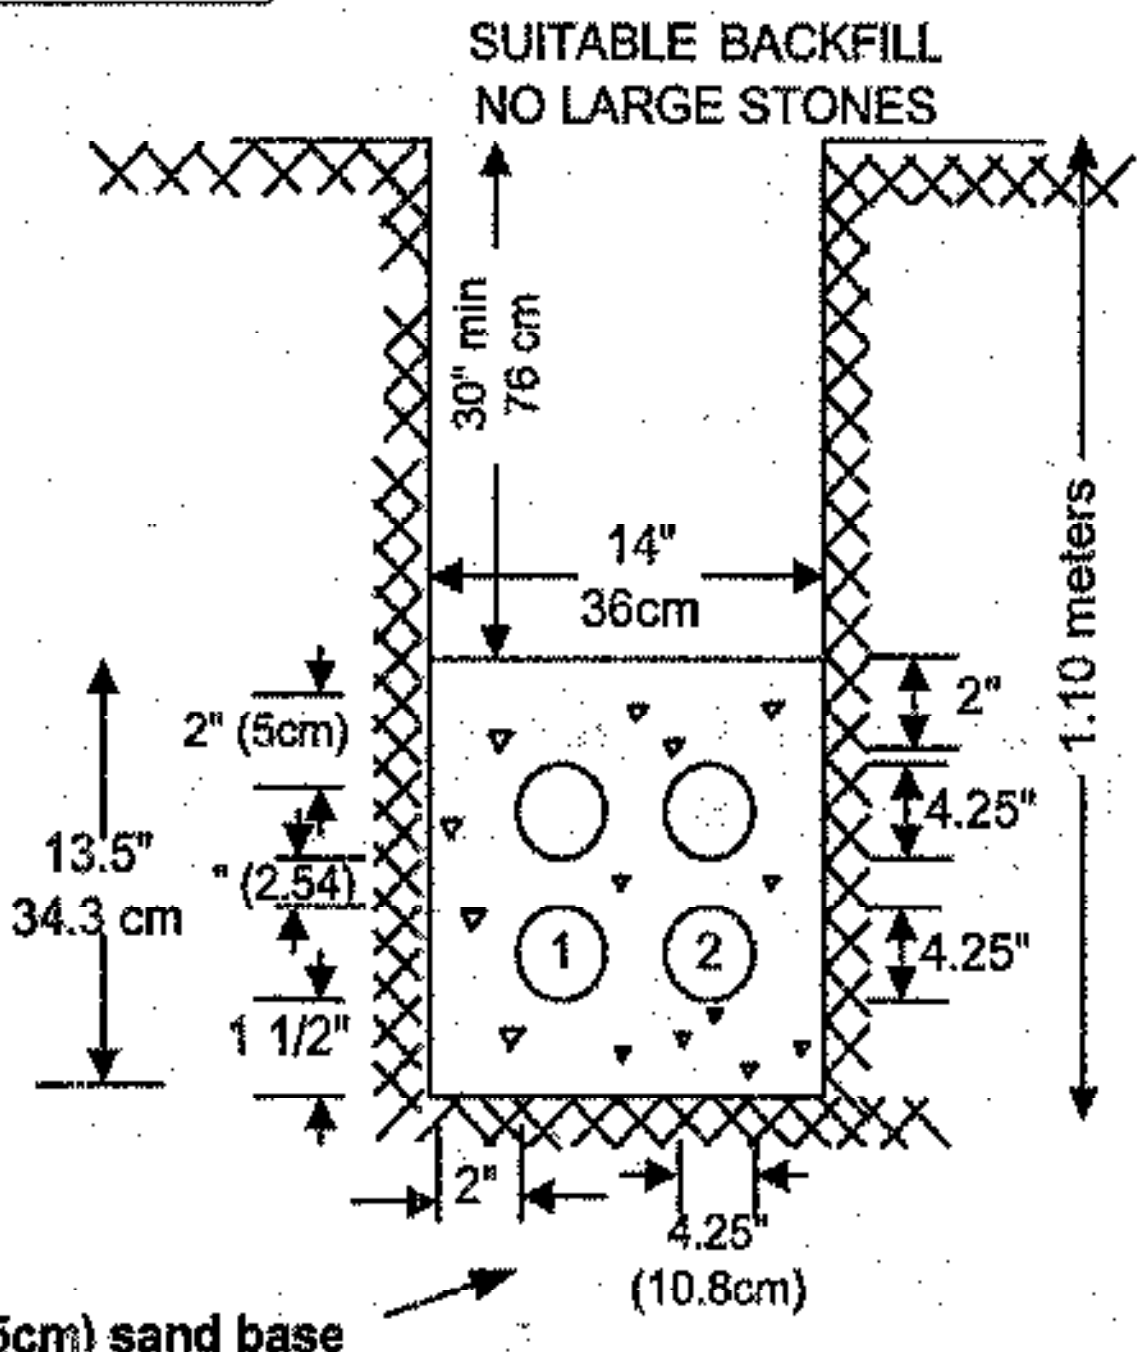

**NO TO
SCALE**

145C


3/8/2001


WORK ORDER

Notice: Not for Use/disclosure outside of Verizon without written agreement


VERIZON

NOTE - Pr#131104
 CONCRETE - MIN 2500 psi WITH 1/4" TO 3/8" AGGREGATE WITH MAX 9" SLUMP.
 DO NOT DROP THE CONCRETE MORE THAN 3 FEET - CAN BE BACKFILLED IN APPROX. 1 1/2 HOURS
 PLACE CONDUIT SPACERS EVERY 5' CONTRACTOR TO PLACE PULL ROPE IN ALL DUCTS
 CONTRACTOR TO PLACE MEASURING TAPE IN ONE DUCT

	SAFETY NOTES: Road construction traffic		MOD/REV NO.	DATE	EWO NO.
	SIGNATURE				PRINT 4 OF
	DATE March 30, 2000				PREPARED BY: J. BRIAN GRESL
	PRE CT YES <input type="checkbox"/> NO <input checked="" type="checkbox"/>				C.O. /EXCHANGE NAME: Brattleboro
PRIMARY VOLTAGE TO GROUND		TYPE	RECORD REF:	C.O. /EXCHANGE CODE: 4731	
7.2 KV MGN SYSTEM		AERIAL	1-4E	MUNICIPALITY: Brattleboro	
CABLE PRESS.	UNDER PRESS. YES <input type="checkbox"/> NO <input checked="" type="checkbox"/>	BLOCK (NYT)	CONDUIT	45-1, 45-3	MANHOLE LOCATION MH# NA
TRANSMISSION	26GA LIMIT YES <input type="checkbox"/> NO <input checked="" type="checkbox"/>	AMT. BRIDGE TAP	INPUT	KF	

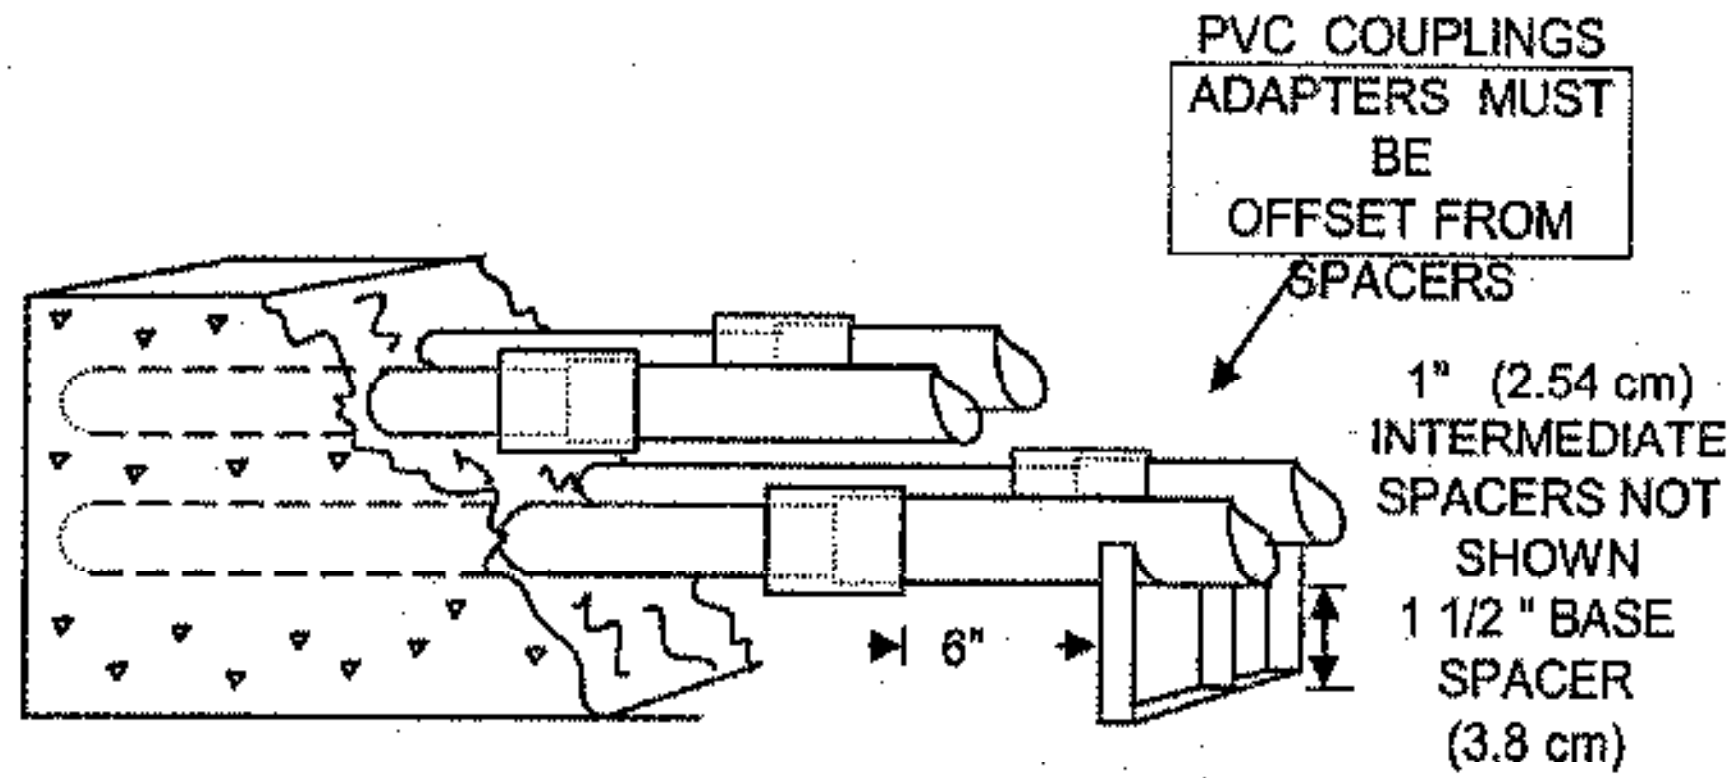

TYPICAL CONCRETE ENCASED DUCTS

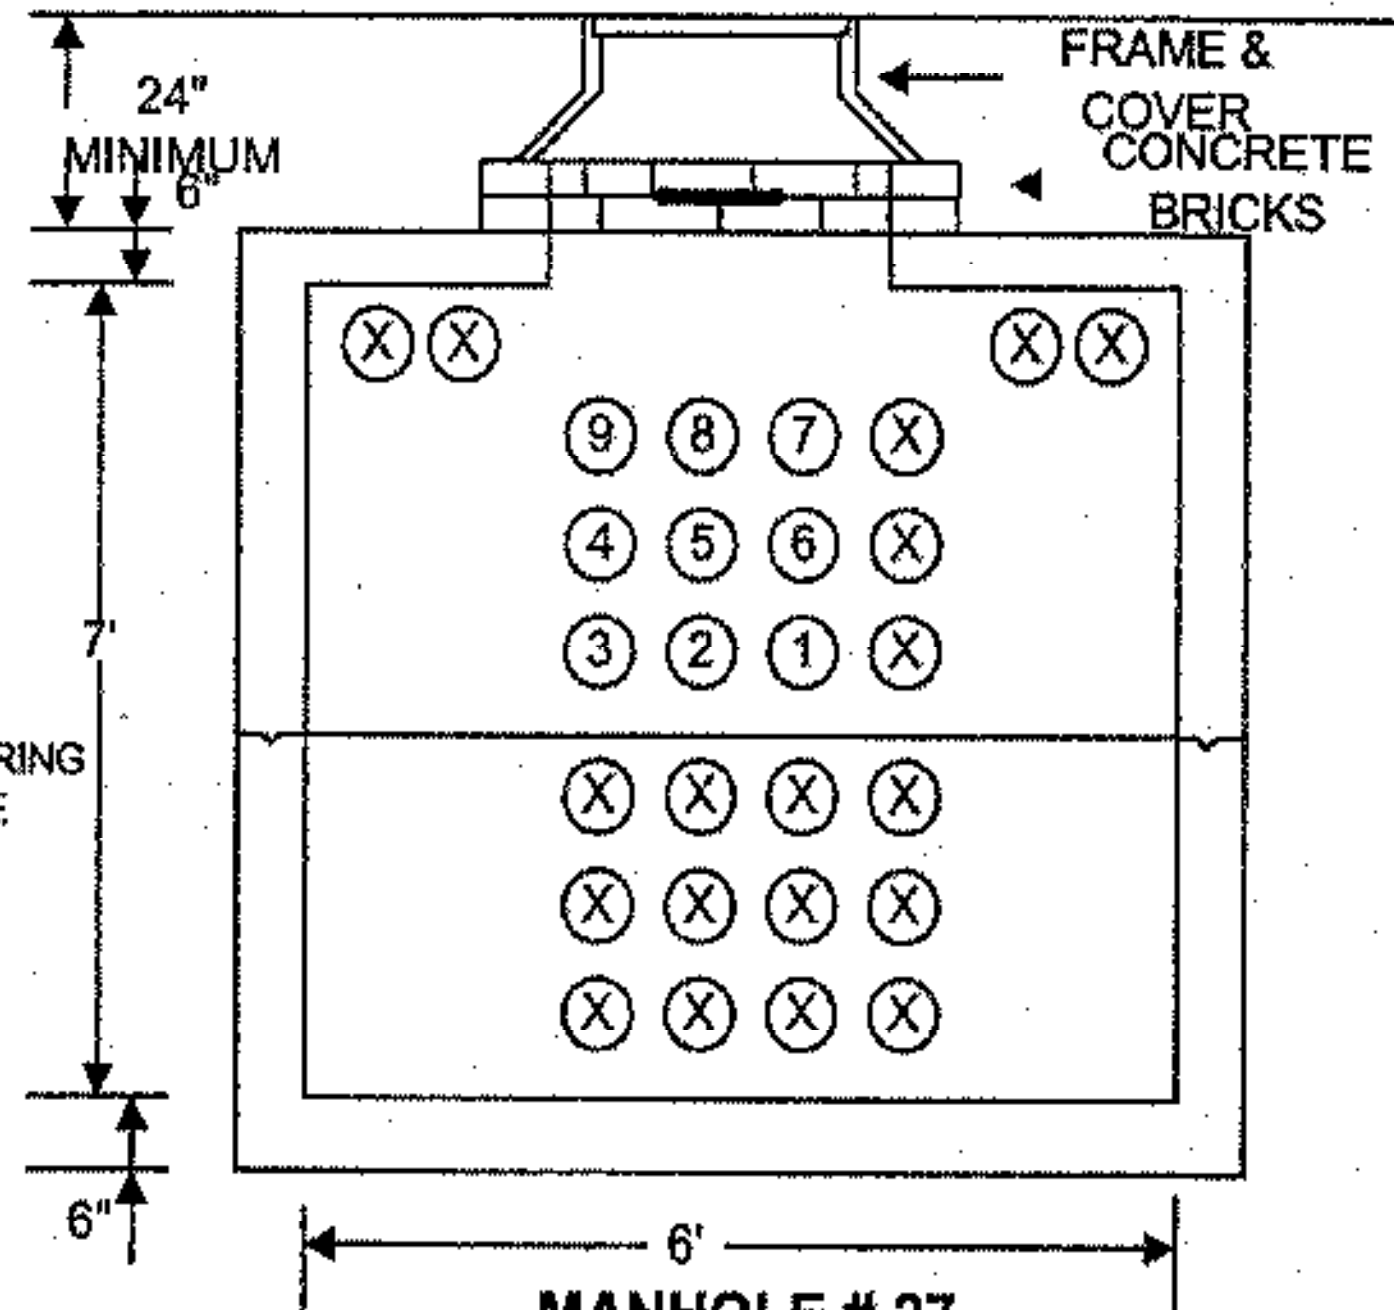


MANHOLE # 27
 12' L x 6' W x 7' H
 FACING NORTH
 FROM INSIDE MANHOLE


- Place 2ea. - Manhole steps in collar of manhole spaced - 12" (30cm) apart
- Place standard Verizon 30" (76 cm) frame and cover
- Place standard 8' (2.4m) galvanized MH ladder with hooks.

Place - 2ea. MH steps in collar


TOP 4 HOLES USED AS PER STEVE ATKINS ORDER ON SITE 06/04/04

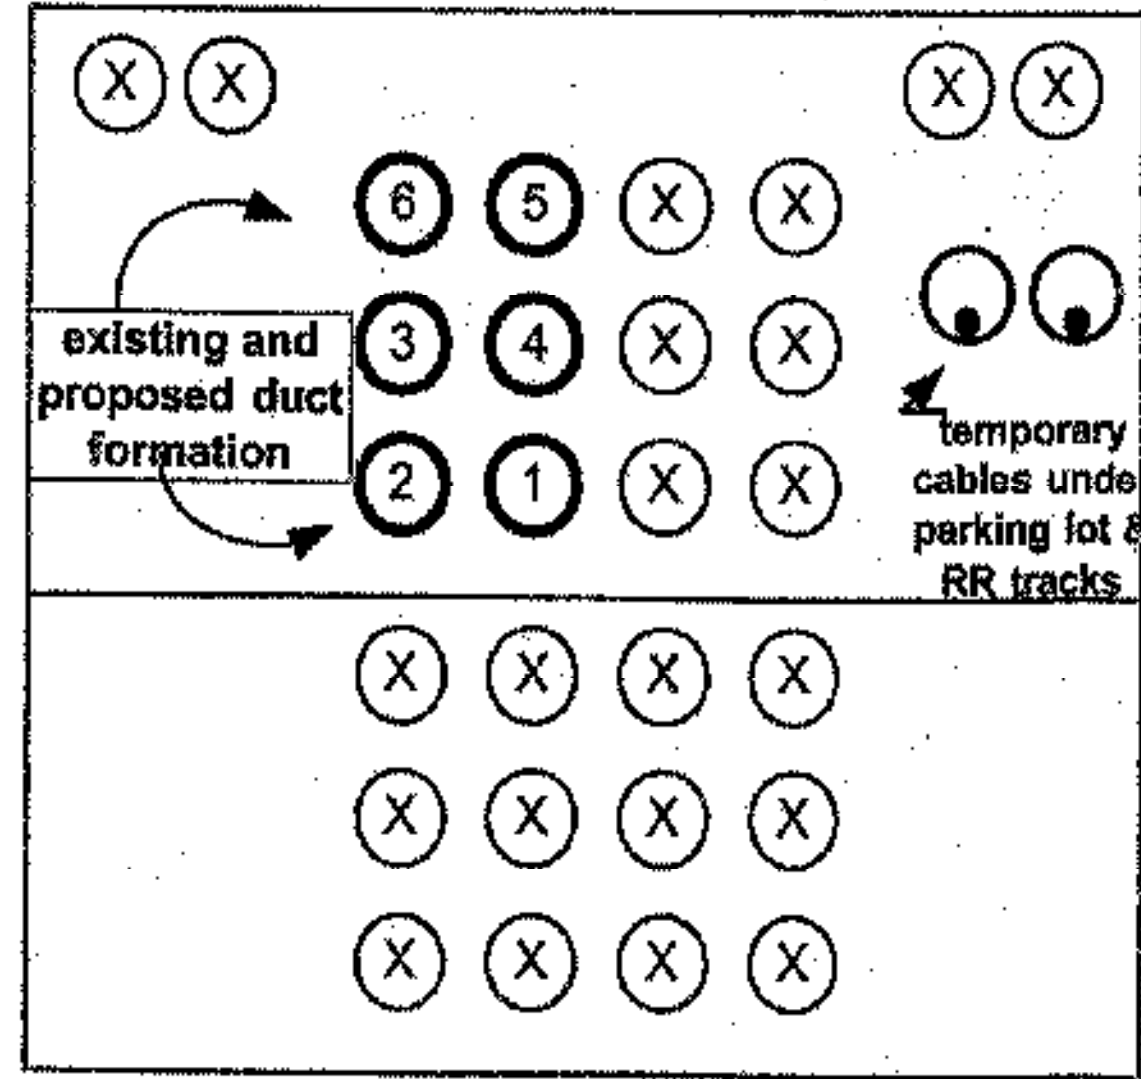



MANHOLE # 27
 FACING EAST
 FROM INSIDE MANHOLE

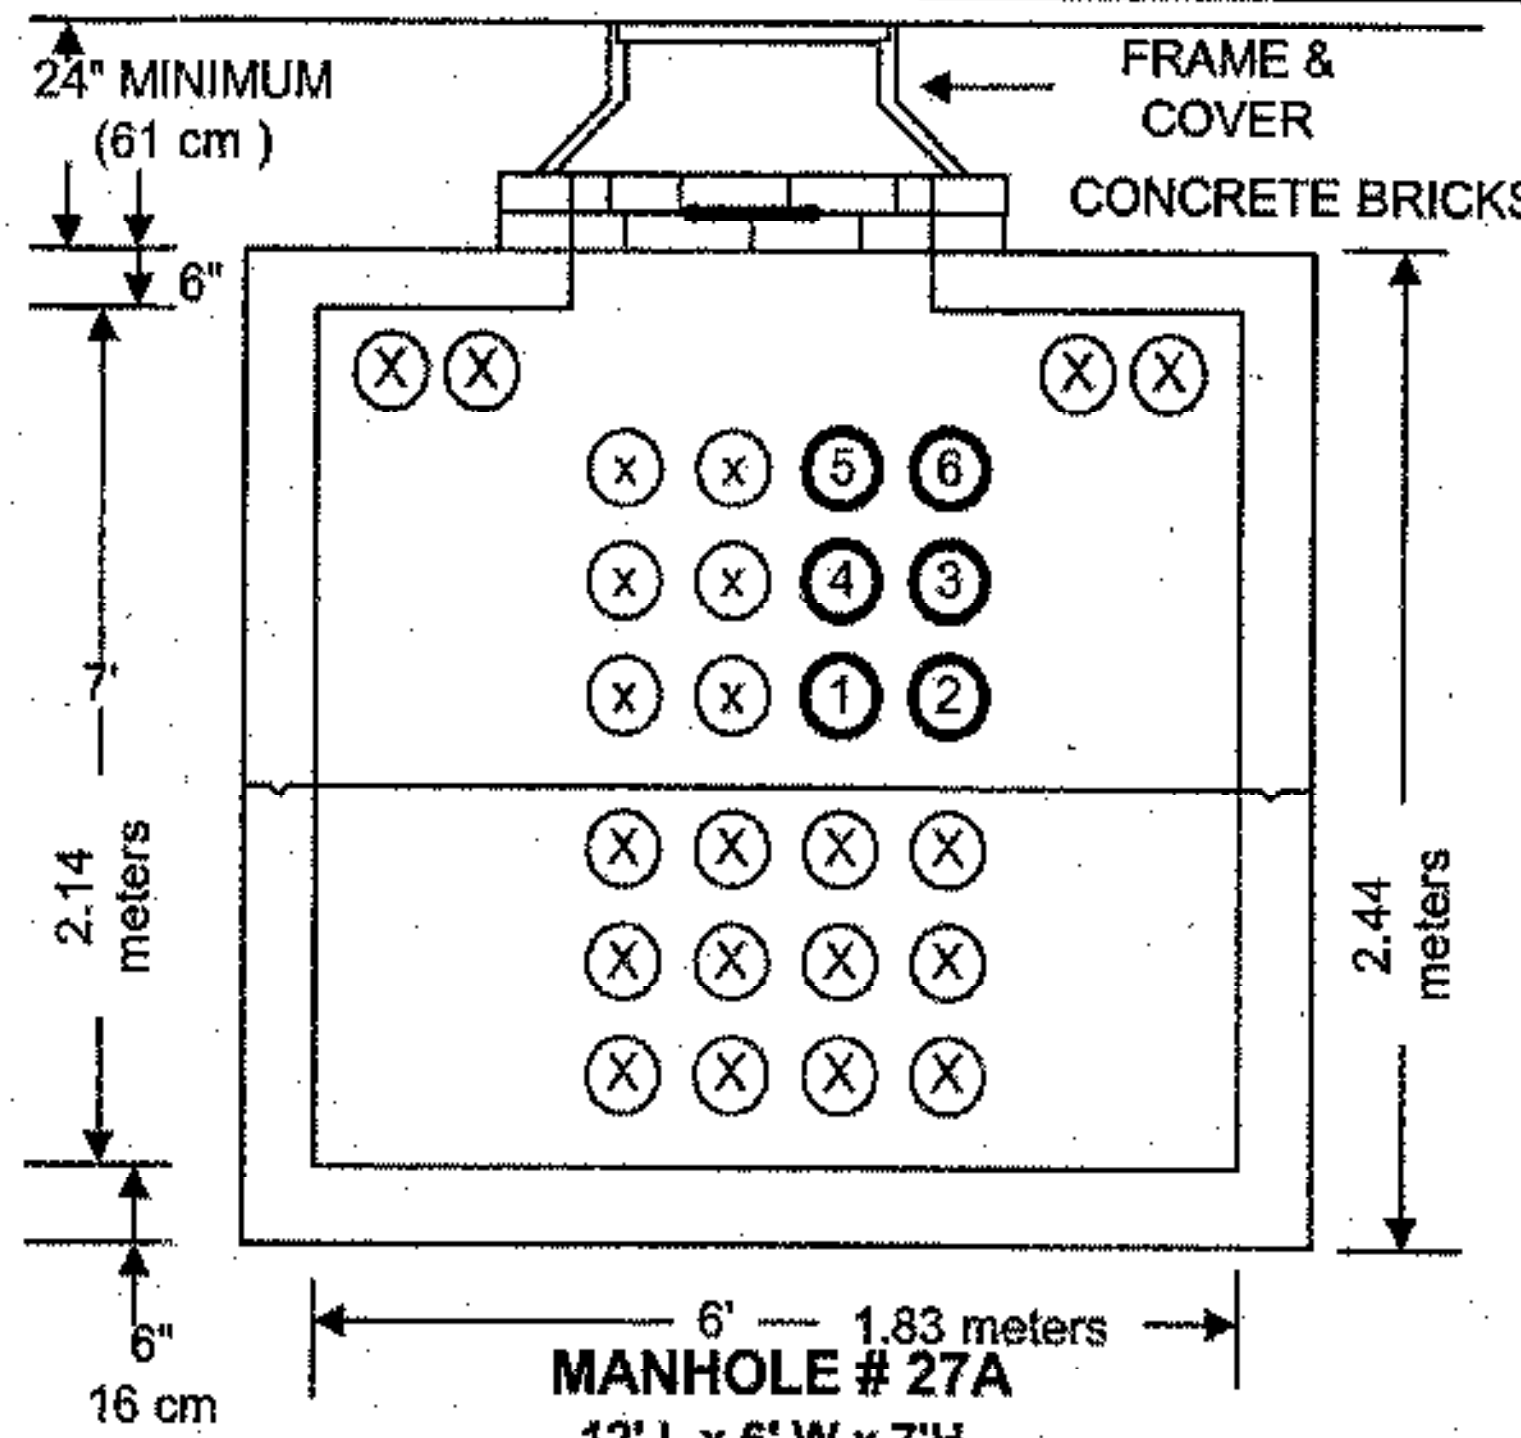

MANHOLE # 27A
 12' L x 6' W x 7' H
 FACING WEST
 FROM INSIDE MANHOLE

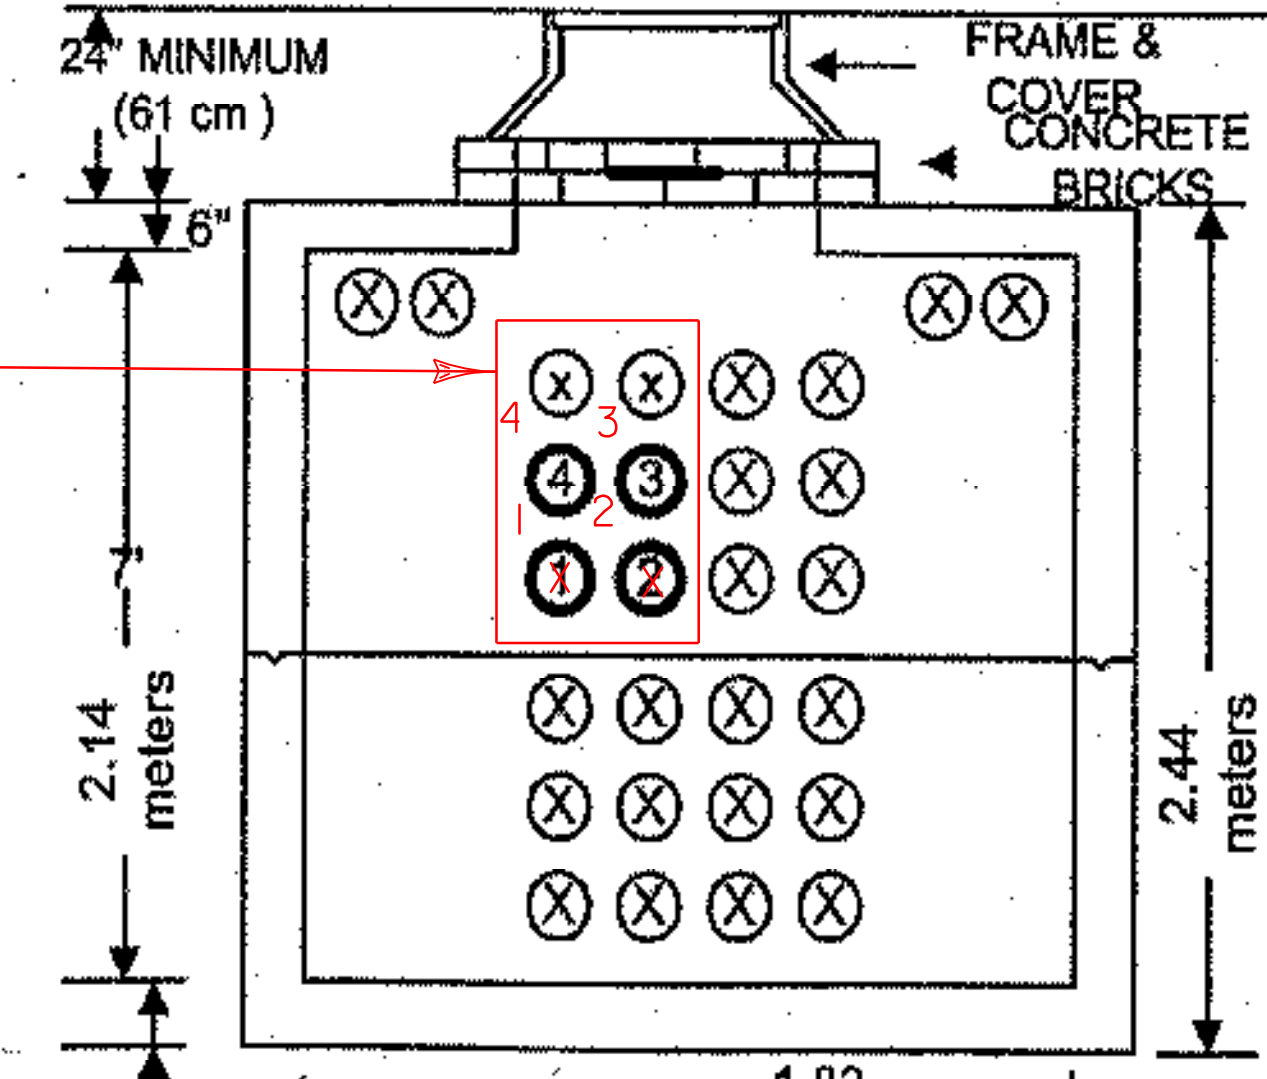

MANHOLE # 27A
 FACING EAST TOWARD NH
 FROM INSIDE MANHOLE

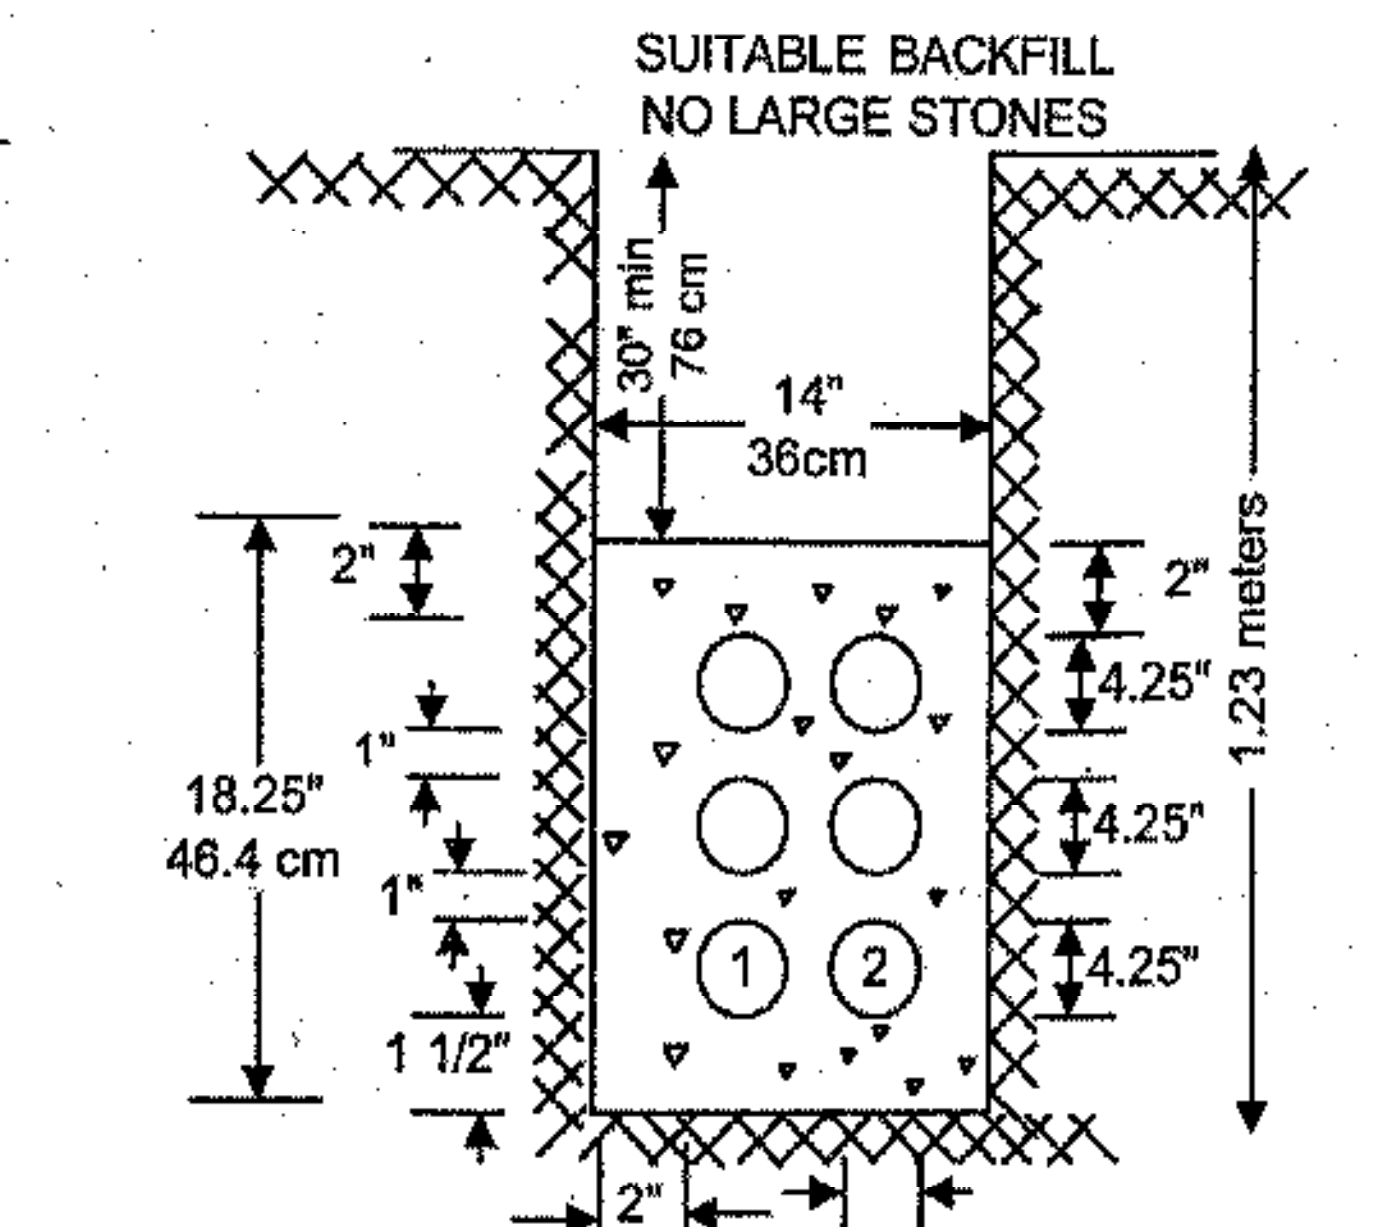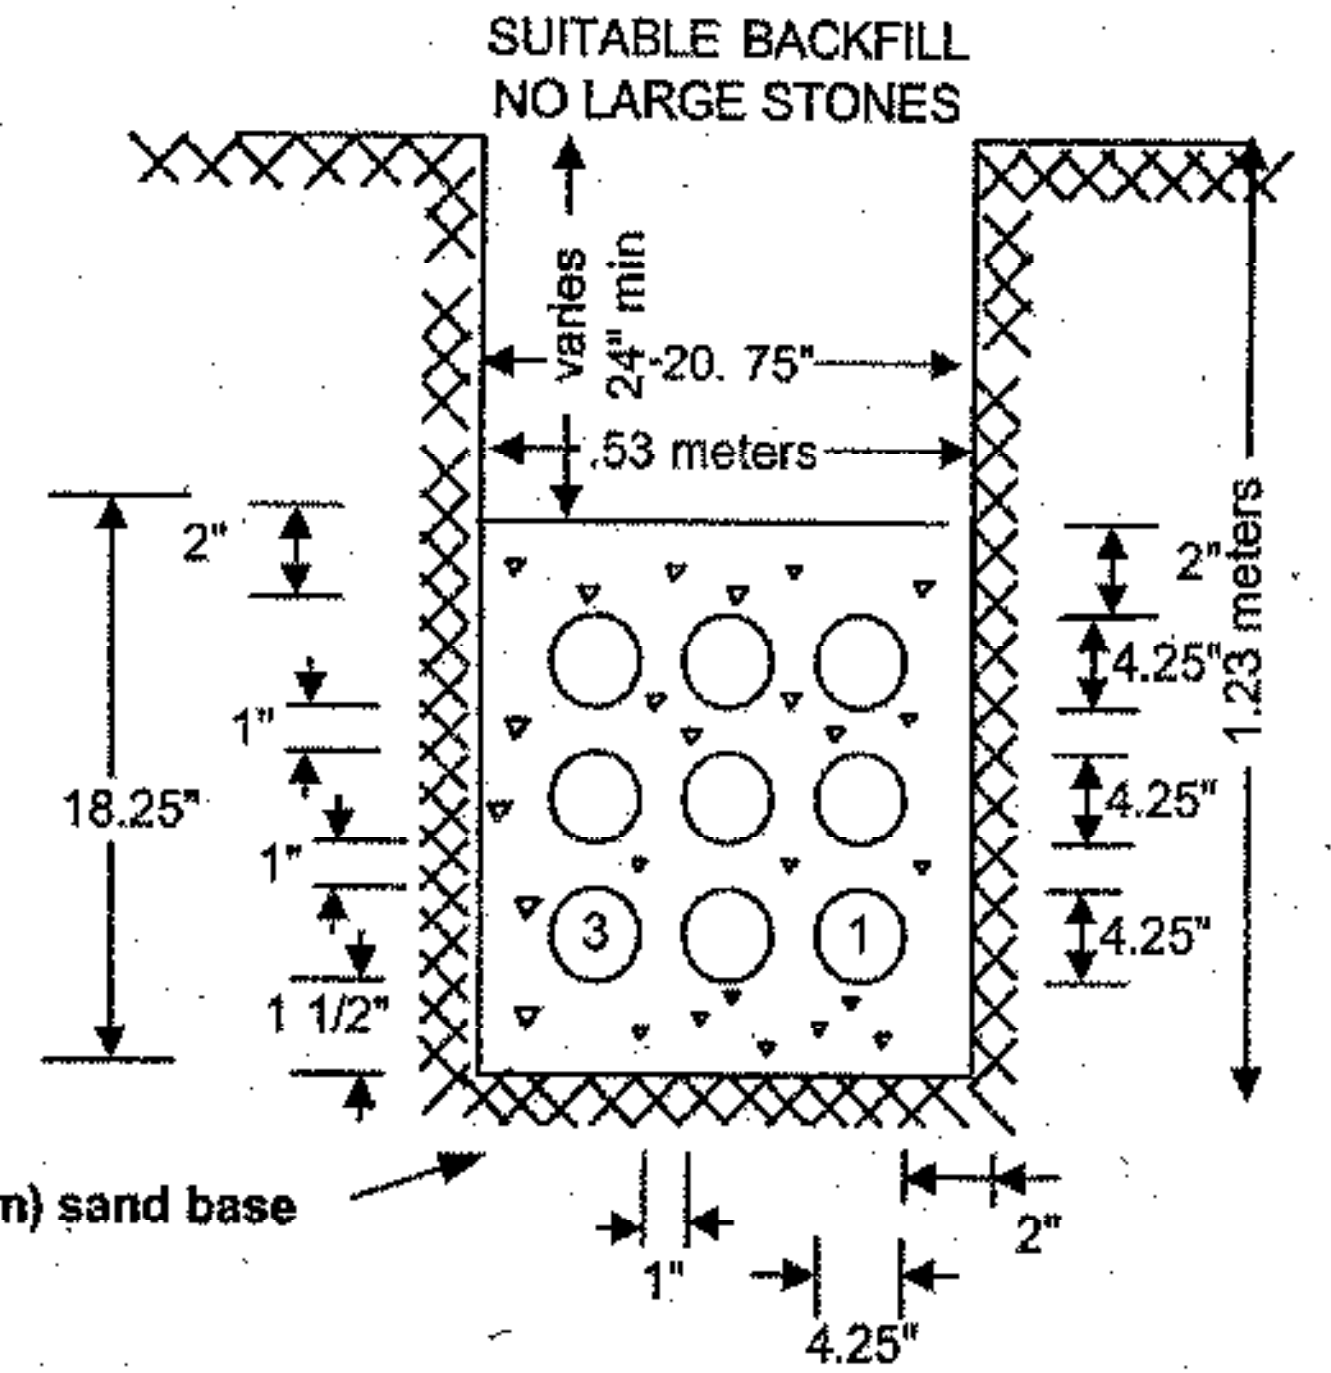

2" (5cm) sand base

NOT TO SCALE


1450

3/8/2001

WORK ORDER

Notice: Not for Use/disclosure outside of VERIZON without written agreement


VERIZON

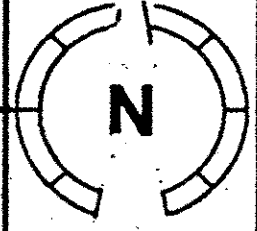	SAFETY NOTES: TRAFFIC, ROAD CONSTRUCTION		MOD/REV NO.	DATE	EWO NO.
	SIGNATURE DATE 3/1/2001				PRINT 5 OF
PRE CT YES <input type="checkbox"/> NO <input checked="" type="checkbox"/>		TYPE AERIAL		RECORD REF: 1-4E	
PRIMARY VOLTAGE TO GROUND 7.2 KV MGN SYSTEM		UNDERGROUND		C.O. /EXCHANGE NAME: BRATTLEBORO	
CABLE PRESS. UNDER PRESS. YES <input type="checkbox"/> NO <input checked="" type="checkbox"/>		BLOCK (NYT)		C.O. /EXCHANGE CODE: 4731	
TRANSMISSION 26GA LIMIT YES <input type="checkbox"/> NO <input checked="" type="checkbox"/>		CONDUIT		MUNICIPALITY: BRATTLEBORO	
		BUFFER YES <input type="checkbox"/> NO <input checked="" type="checkbox"/>		MANHOLE LOCATION MH# NA	
		AMT. BRIDGE TAP INPUT		KF	

PROJ # 131104

EXISTING CONDUIT

CAUTION

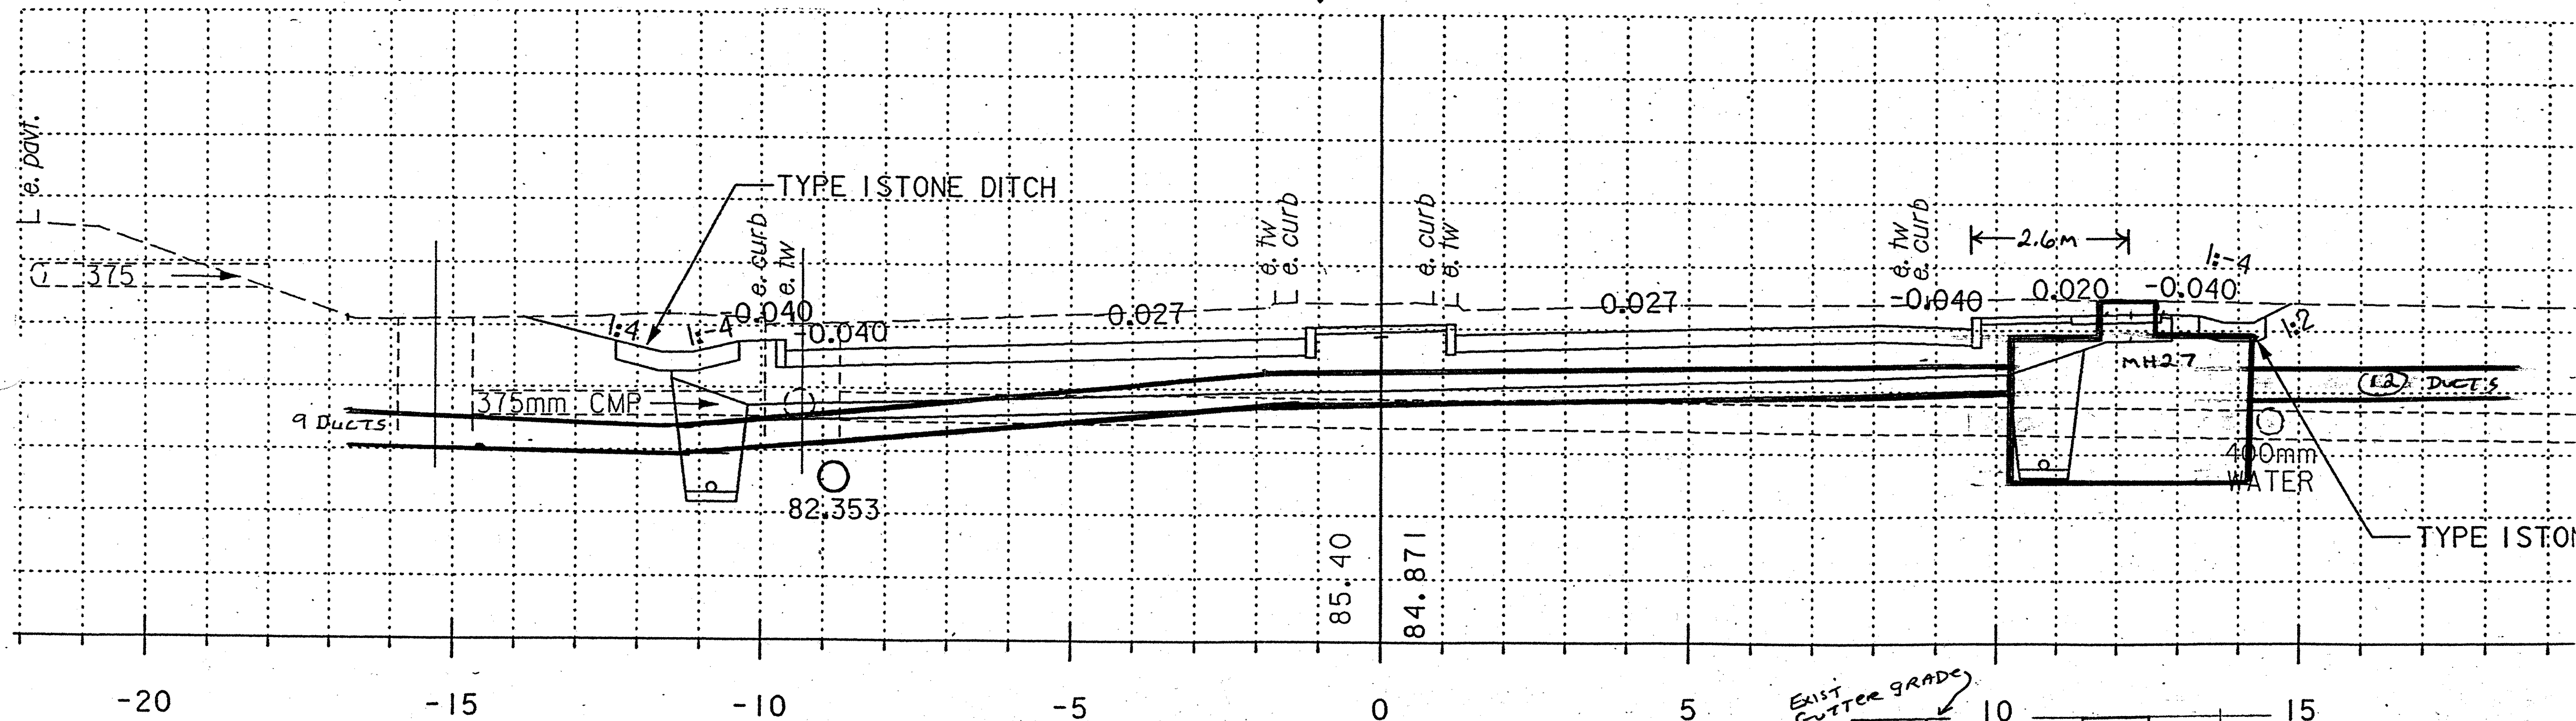


30+140.000

3/2/2001

5' BACK OF CURB (EXIST)
↑
APPROX 6' (1.8 M)
COVER
EXISTING GRADE

NOT TO SCALE


38" (96cm) ±
COVER
BELOW EXIST.
GUTTER
↑
48" (122cm) ±
COVER FROM EXISTING
GRADE IN CENTER
OF ISLAND

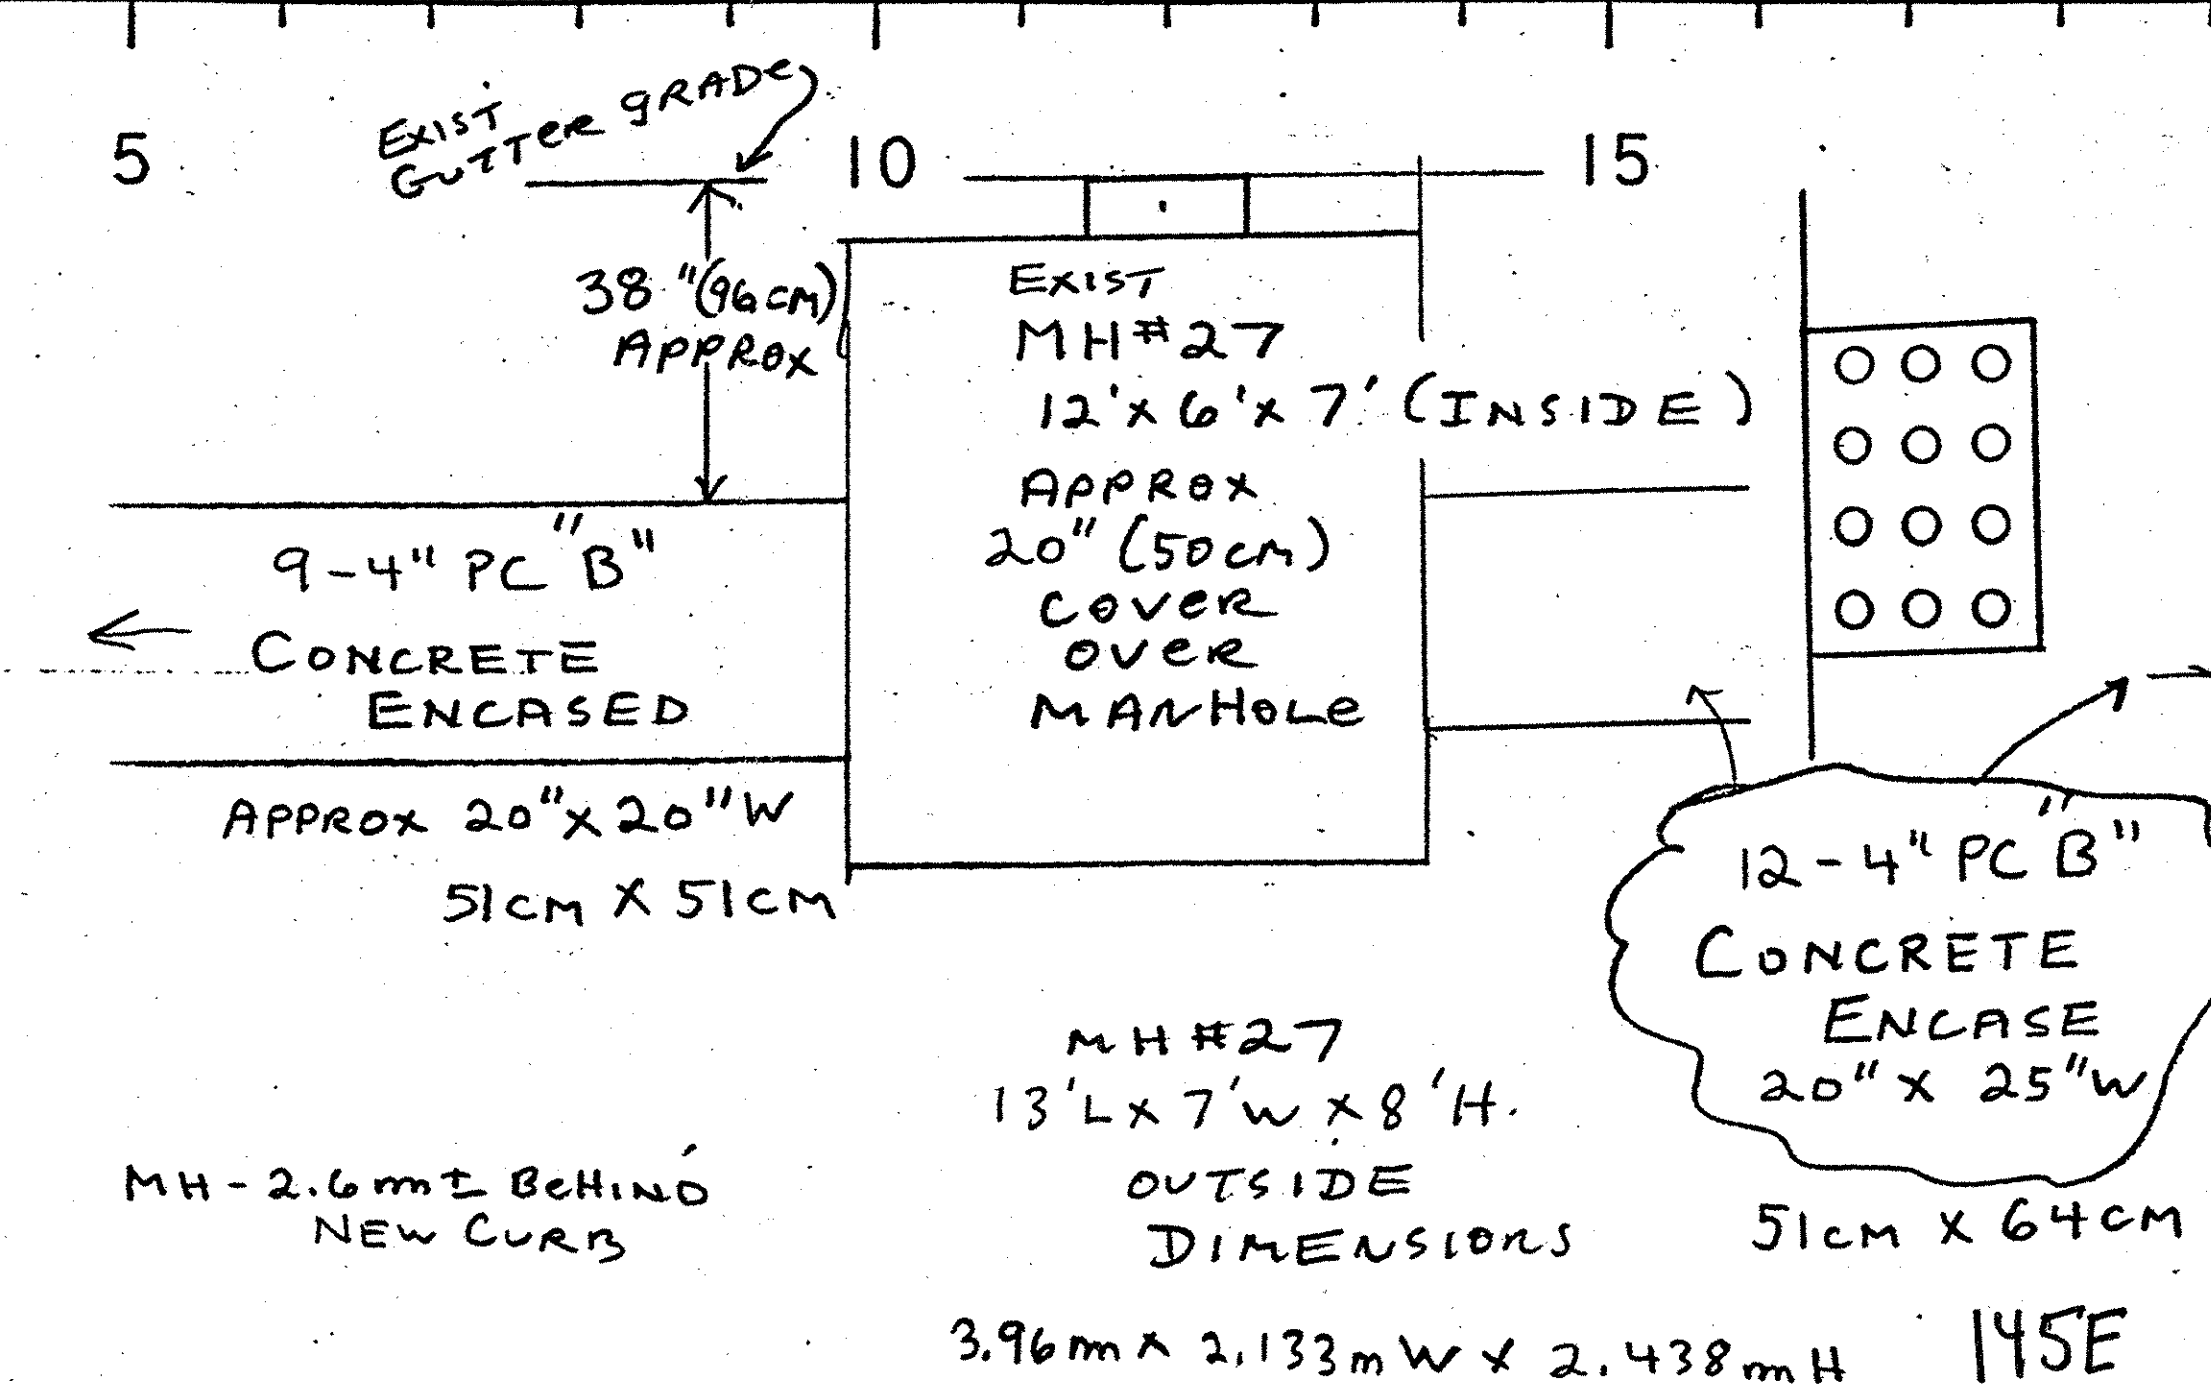

WORK ORDER

Notice: Not for Use/disclosure outside of VERIZON without written agreement


VERIZON

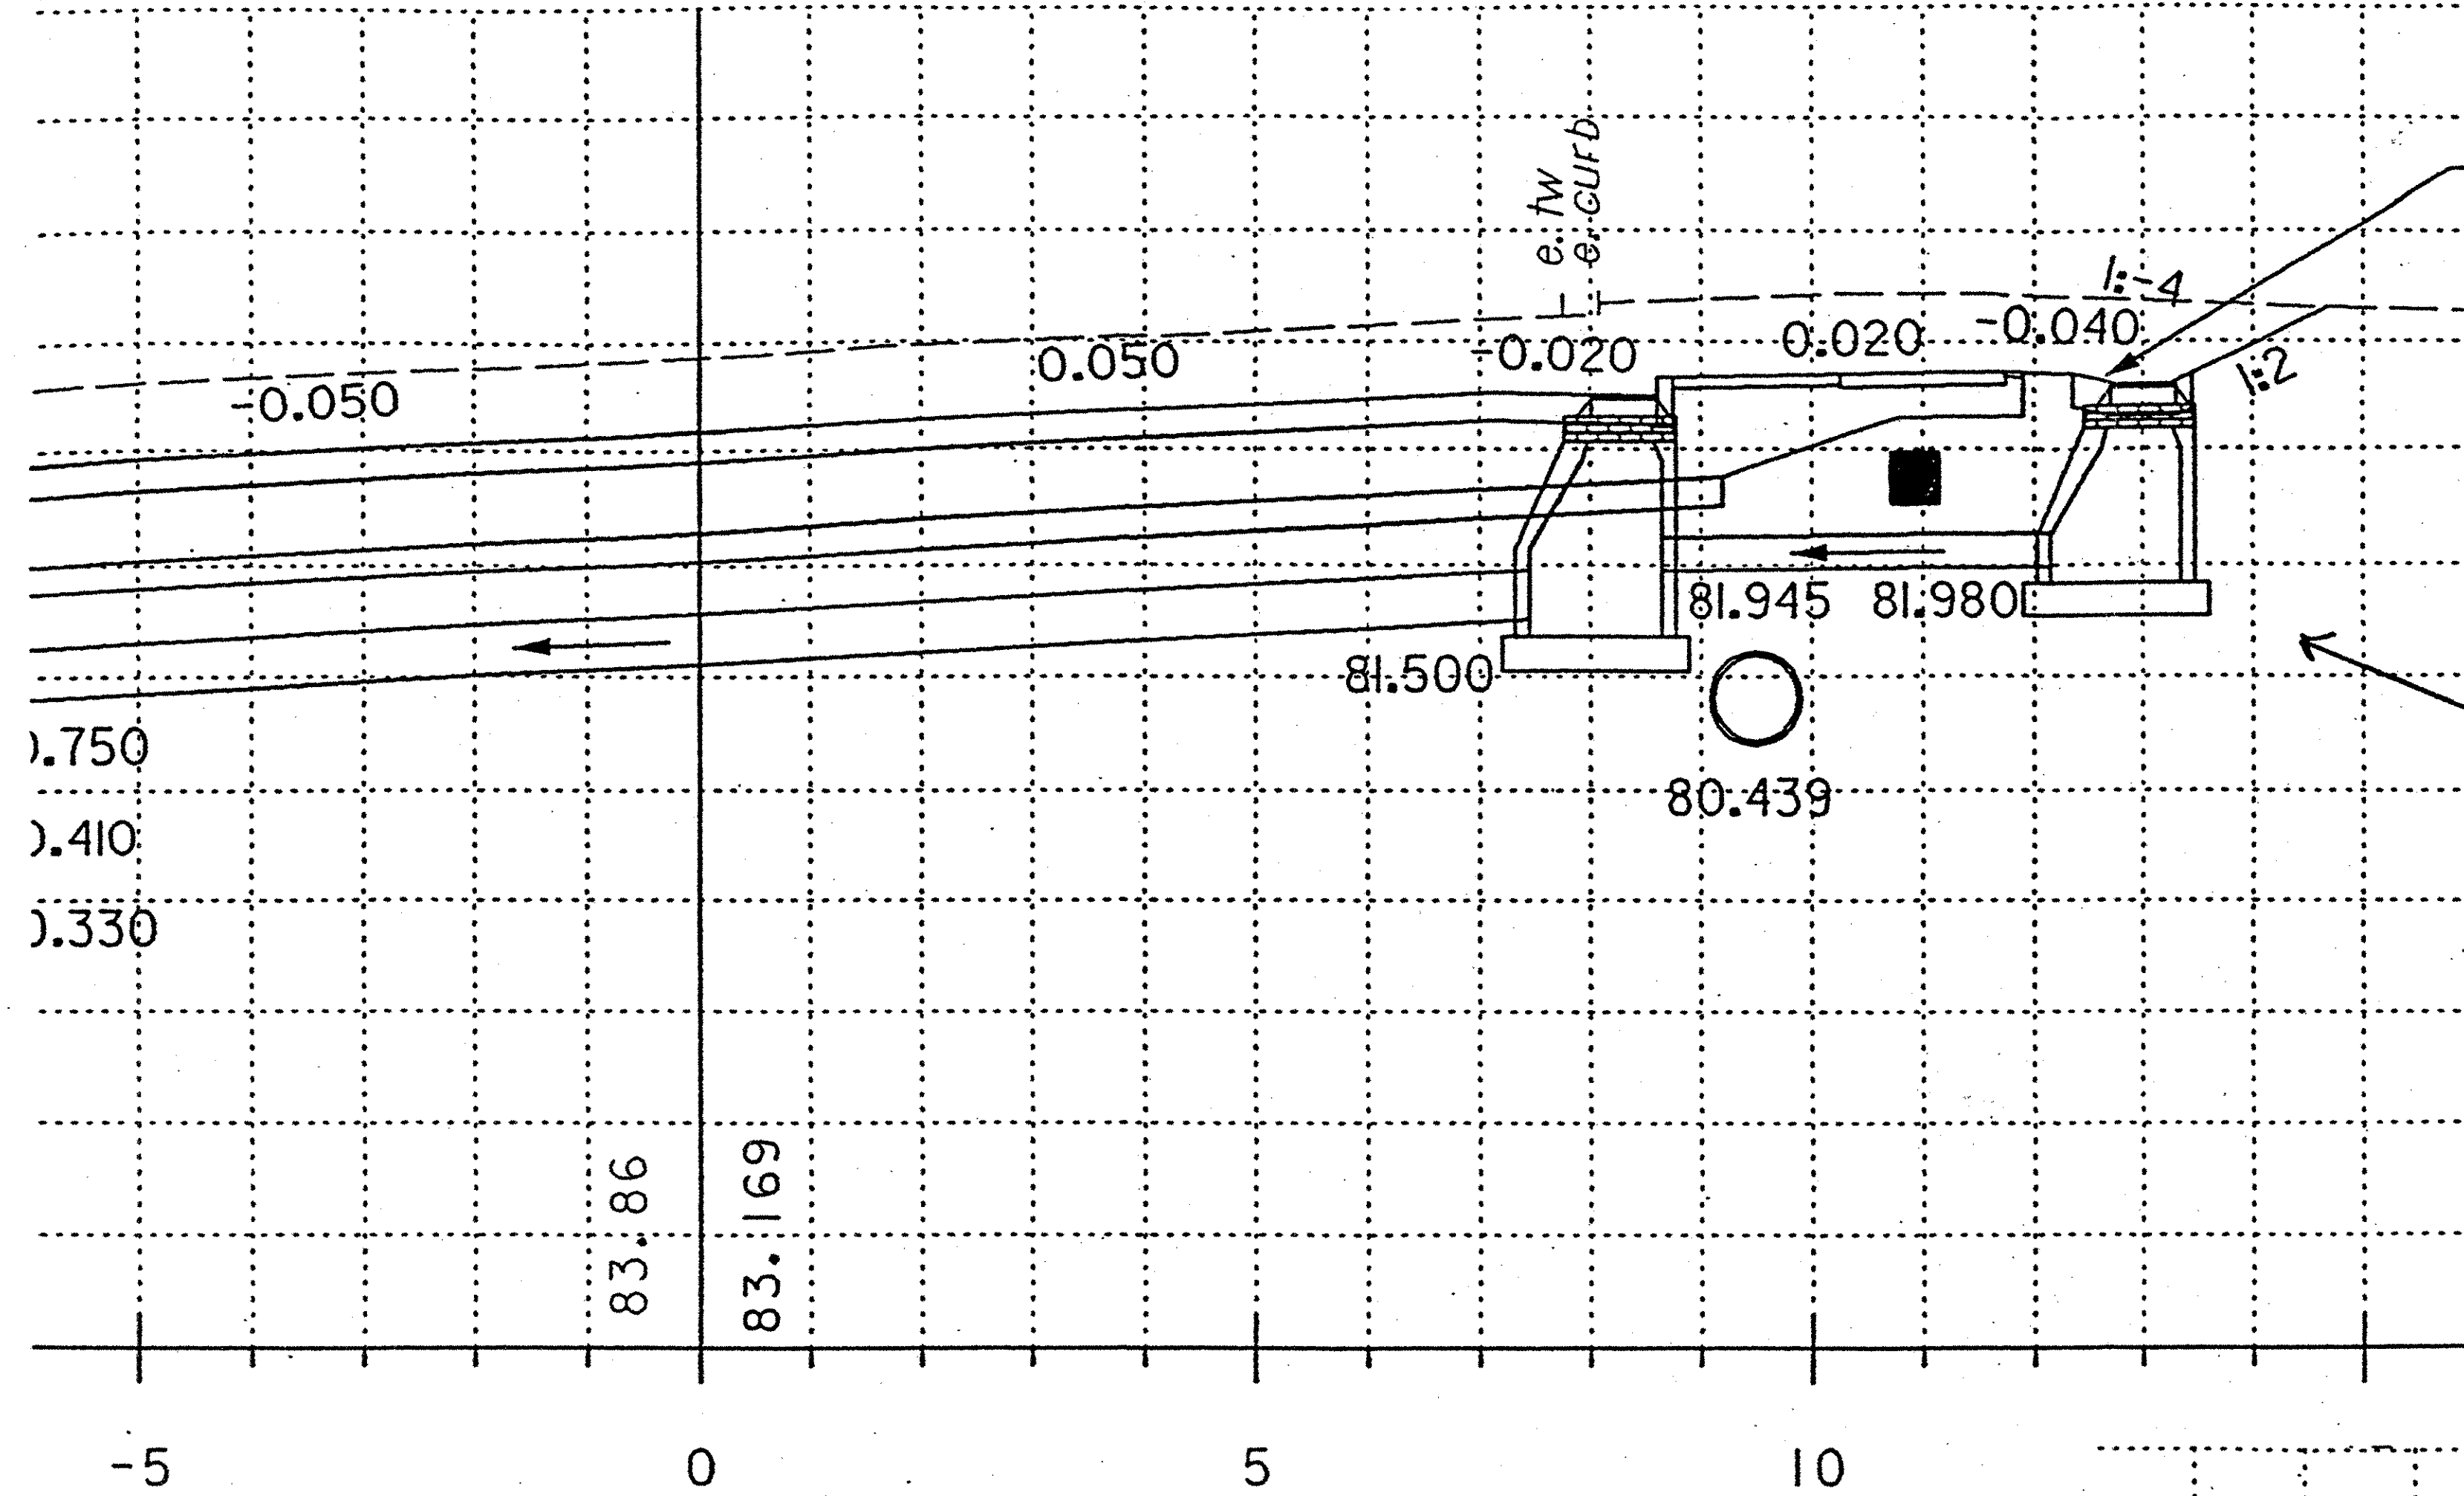

	SAFETY NOTES: TRAFFIC, ROAD CONSTRUCTION	MOD/REV NO.	DATE	EWO NO.
	SIGNATURE DATE 3/1/2001			PRINT 6 OF PREPARED BY:
PRE CT YES <input type="checkbox"/> NO <input checked="" type="checkbox"/>	7.2 KV MGN SYSTEM	AERIAL	RECORD REF: 1-4E	C.O. /EXCHANGE NAME: BRATTLEBORO
UNDER PRESS. YES <input type="checkbox"/> NO <input checked="" type="checkbox"/>	CONDUIT	UNDERGROUND		C.O. /EXCHANGE CODE: 4731
TRANSMISSION	26GA LIMIT YES <input type="checkbox"/> NO <input checked="" type="checkbox"/>	CONDUIT		MUNICIPALITY: BRATTLEBORO
		AMT. BRIDGE TAP	INPUT	MANHOLE LOCATION MH# NA
				KF

PROJECT #131104

30+180.000

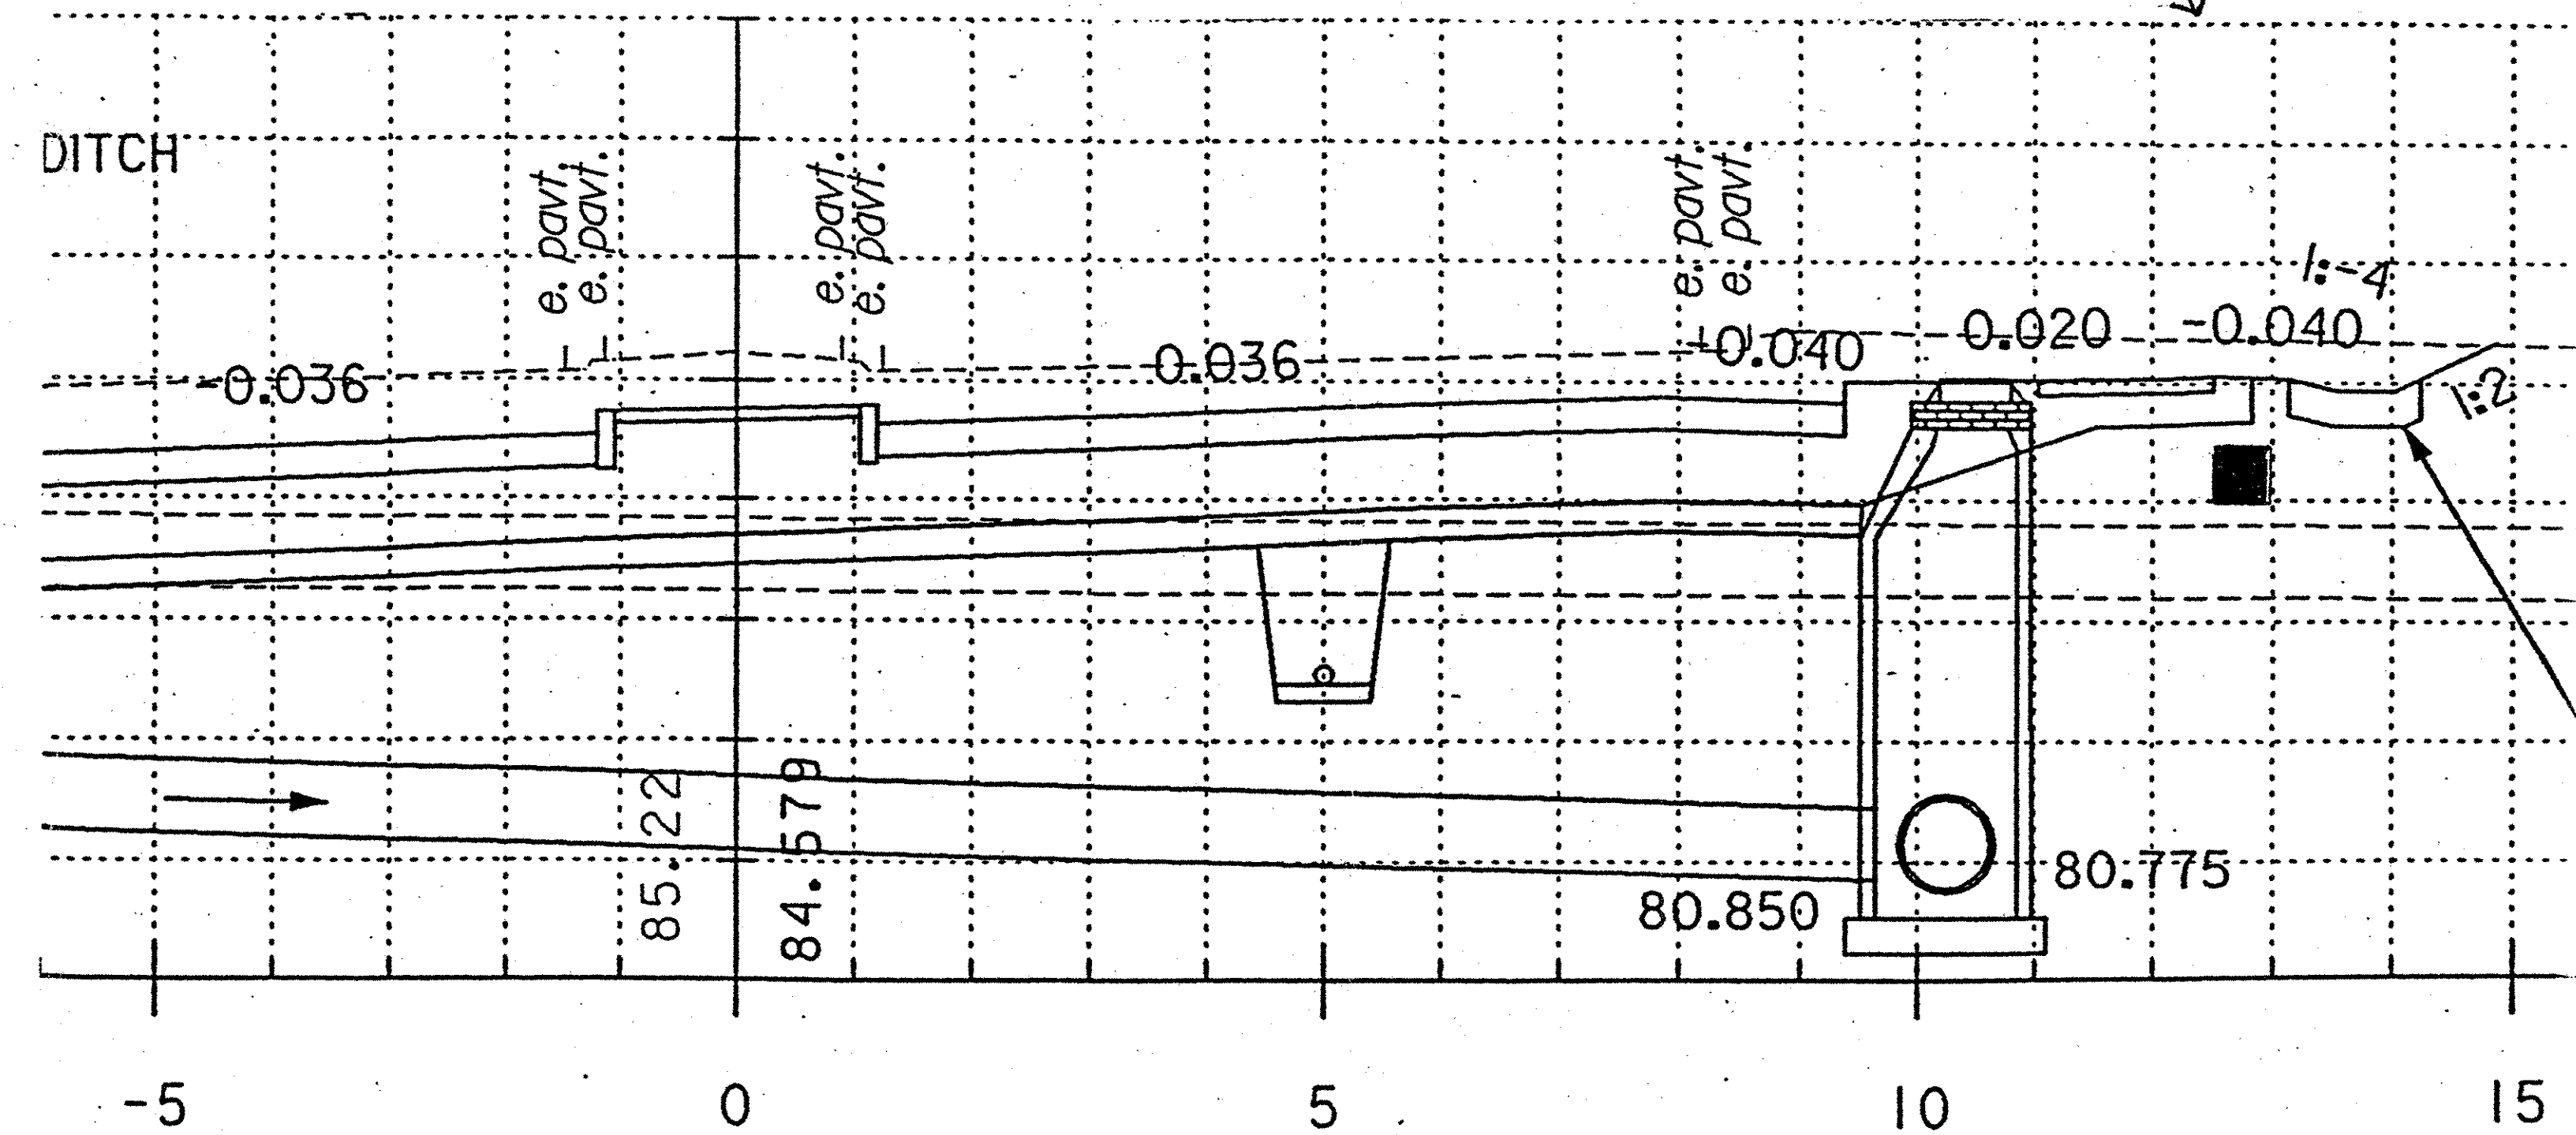


30+148.400

NOT TO SCALE

145F

3/2/2001

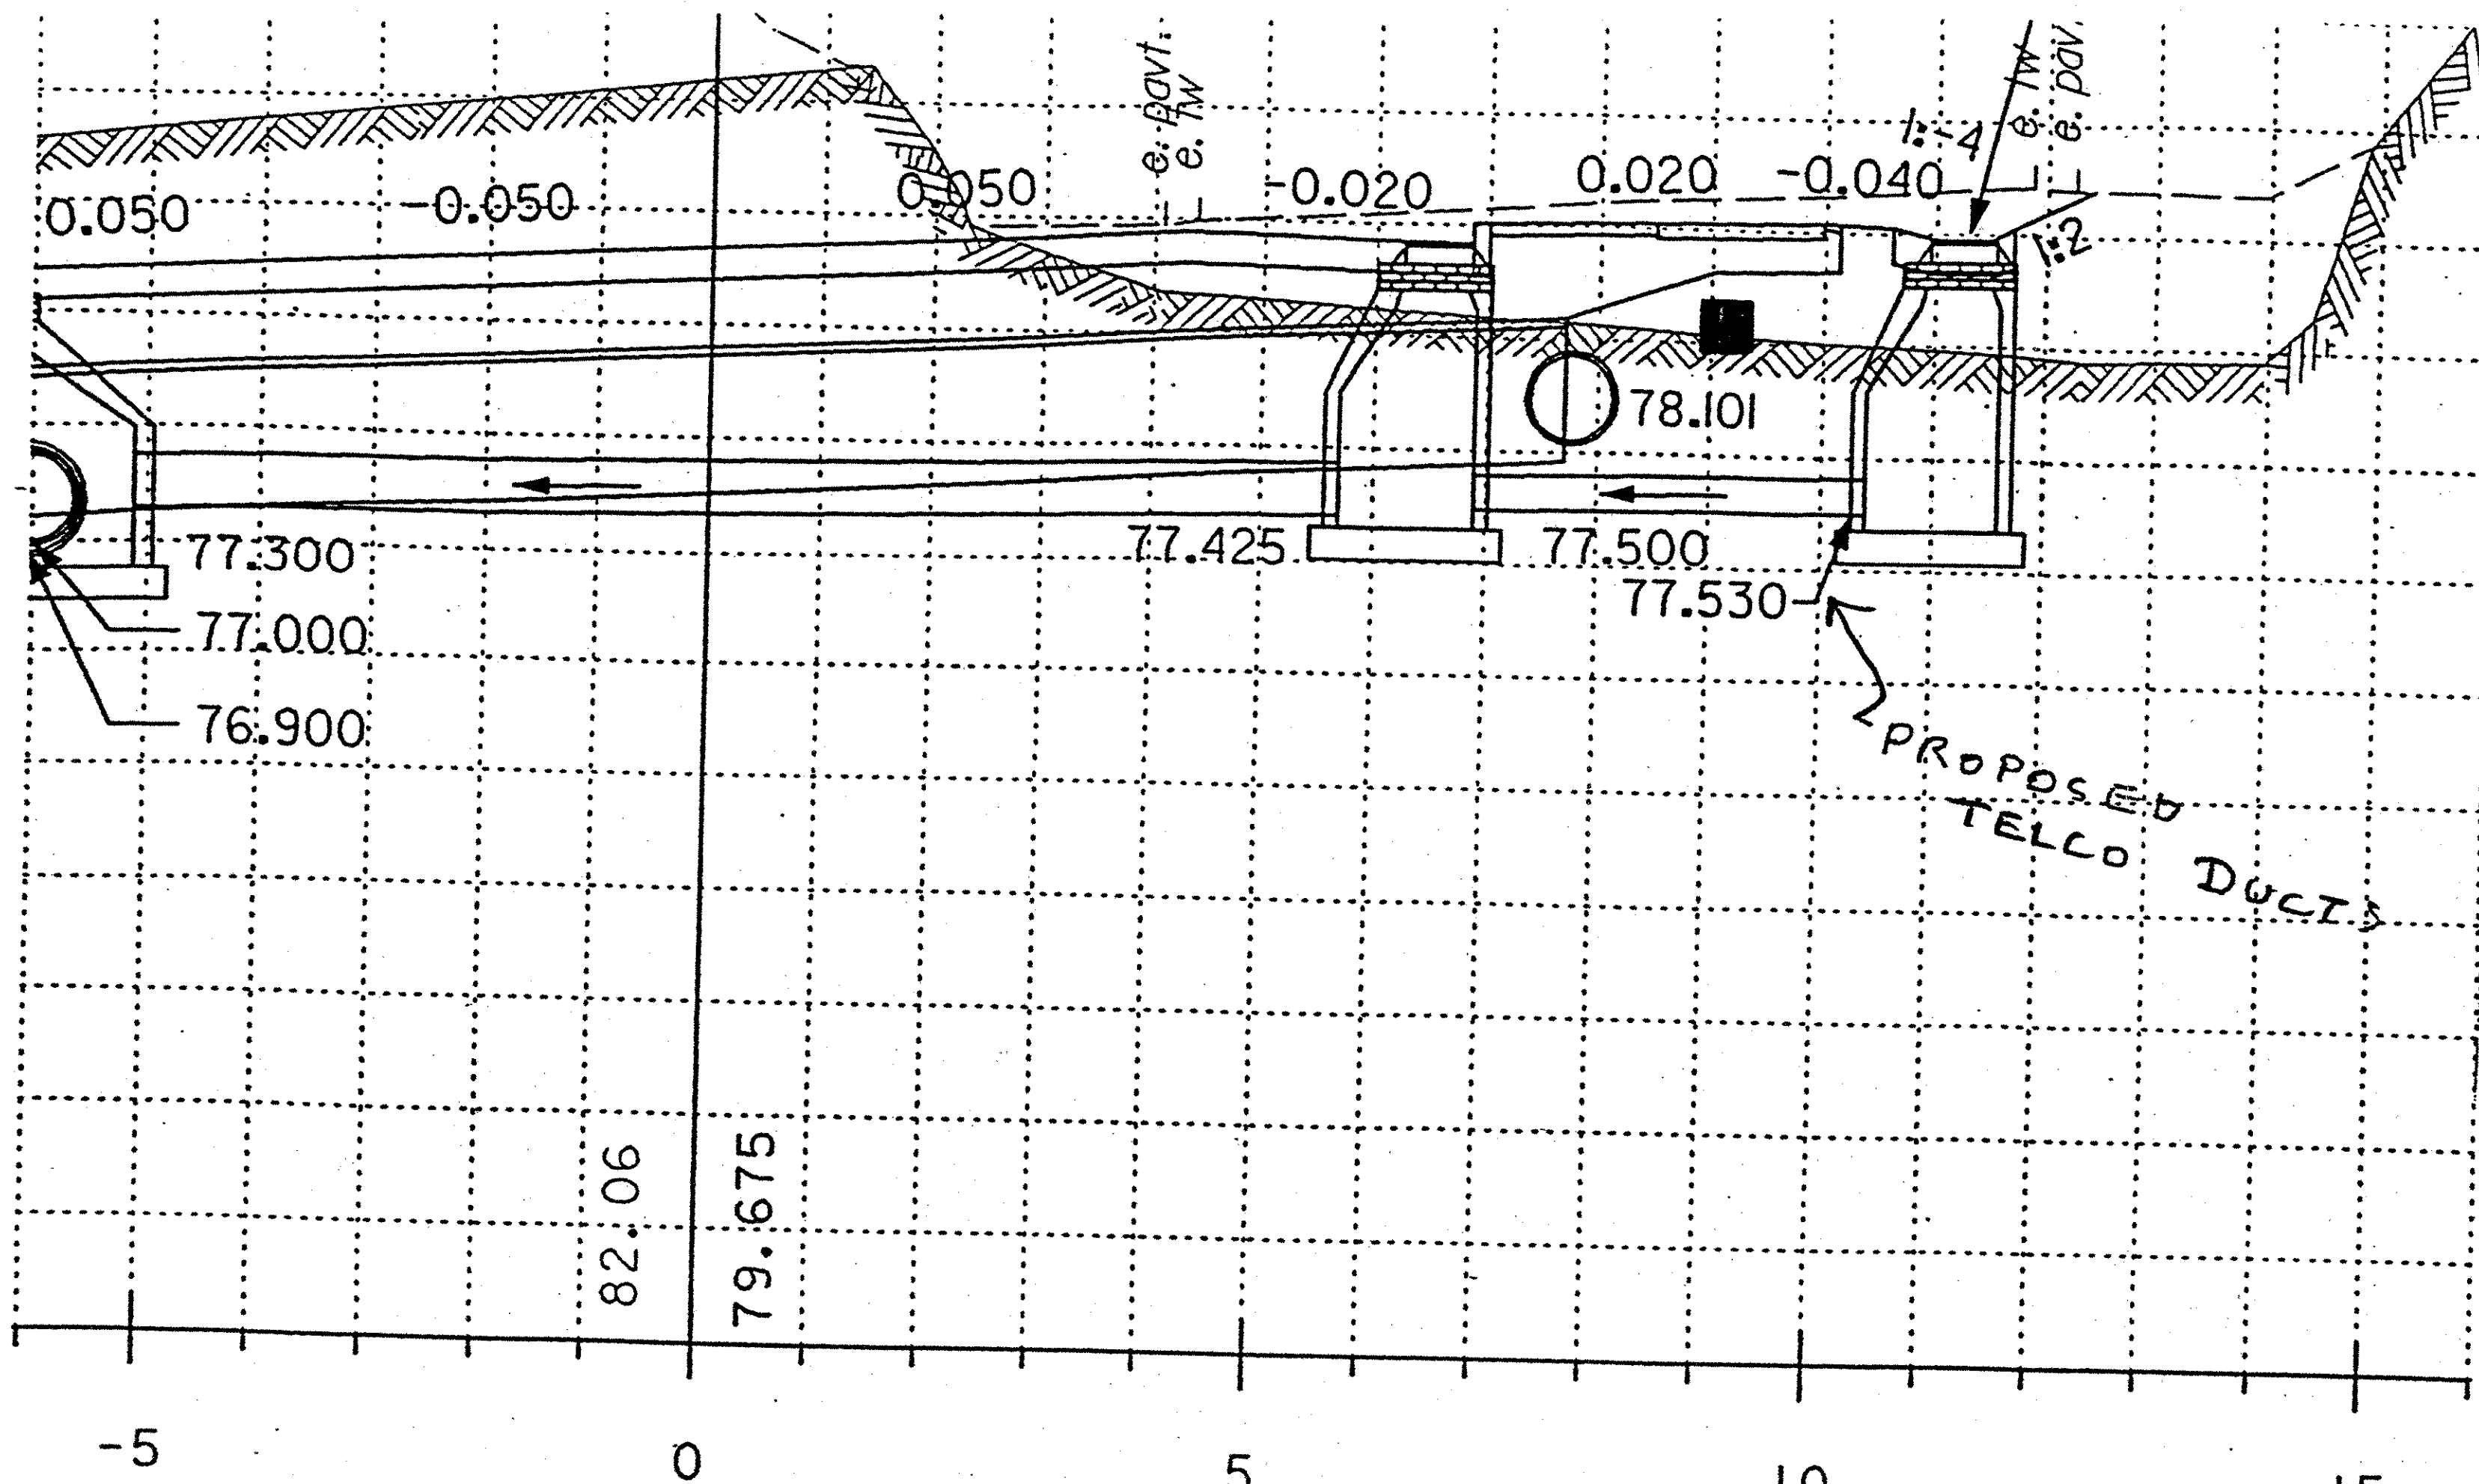

Use/disclosure outside of VERIZON without written agreement

VERIZON


	SAFETY NOTES: TRAFFIC, ROAD CONSTRUCTION	MOD/REV NO.	DATE	EWO NO.
				PRINT 7 OF
				PREPARED BY:
				C.O. /EXCHANGE NAME:
		TYPE	RECORD REF:	BRATTLEBORO
		AERIAL	1-4E	C.O. /EXCHANGE CODE:
		UNDERGROUND		4731
		BLOCK (NYT)		MUNICIPALITY:
		CONDUIT		BRATTLEBORO
	SIGNATURE DATE 3/1/2001 PRE CT YES <input type="checkbox"/> NO <input checked="" type="checkbox"/> PRIMARY VOLTAGE TO GROUND 7.2 KV MGN SYSTEM	BUFFER YES <input type="checkbox"/> NO <input checked="" type="checkbox"/> AMT. BRIDGE TAP INPUT	MANHOLE LOCATION MH# NA	
CABLE PRESS. UNDER PRESS. YES <input type="checkbox"/> NO <input checked="" type="checkbox"/> TRANSMISSION 26GA LIMIT YES <input type="checkbox"/> NO <input checked="" type="checkbox"/>				

PROJ. # 131104

Not to Scale

PROPOSED MH# 27A


30+250.000

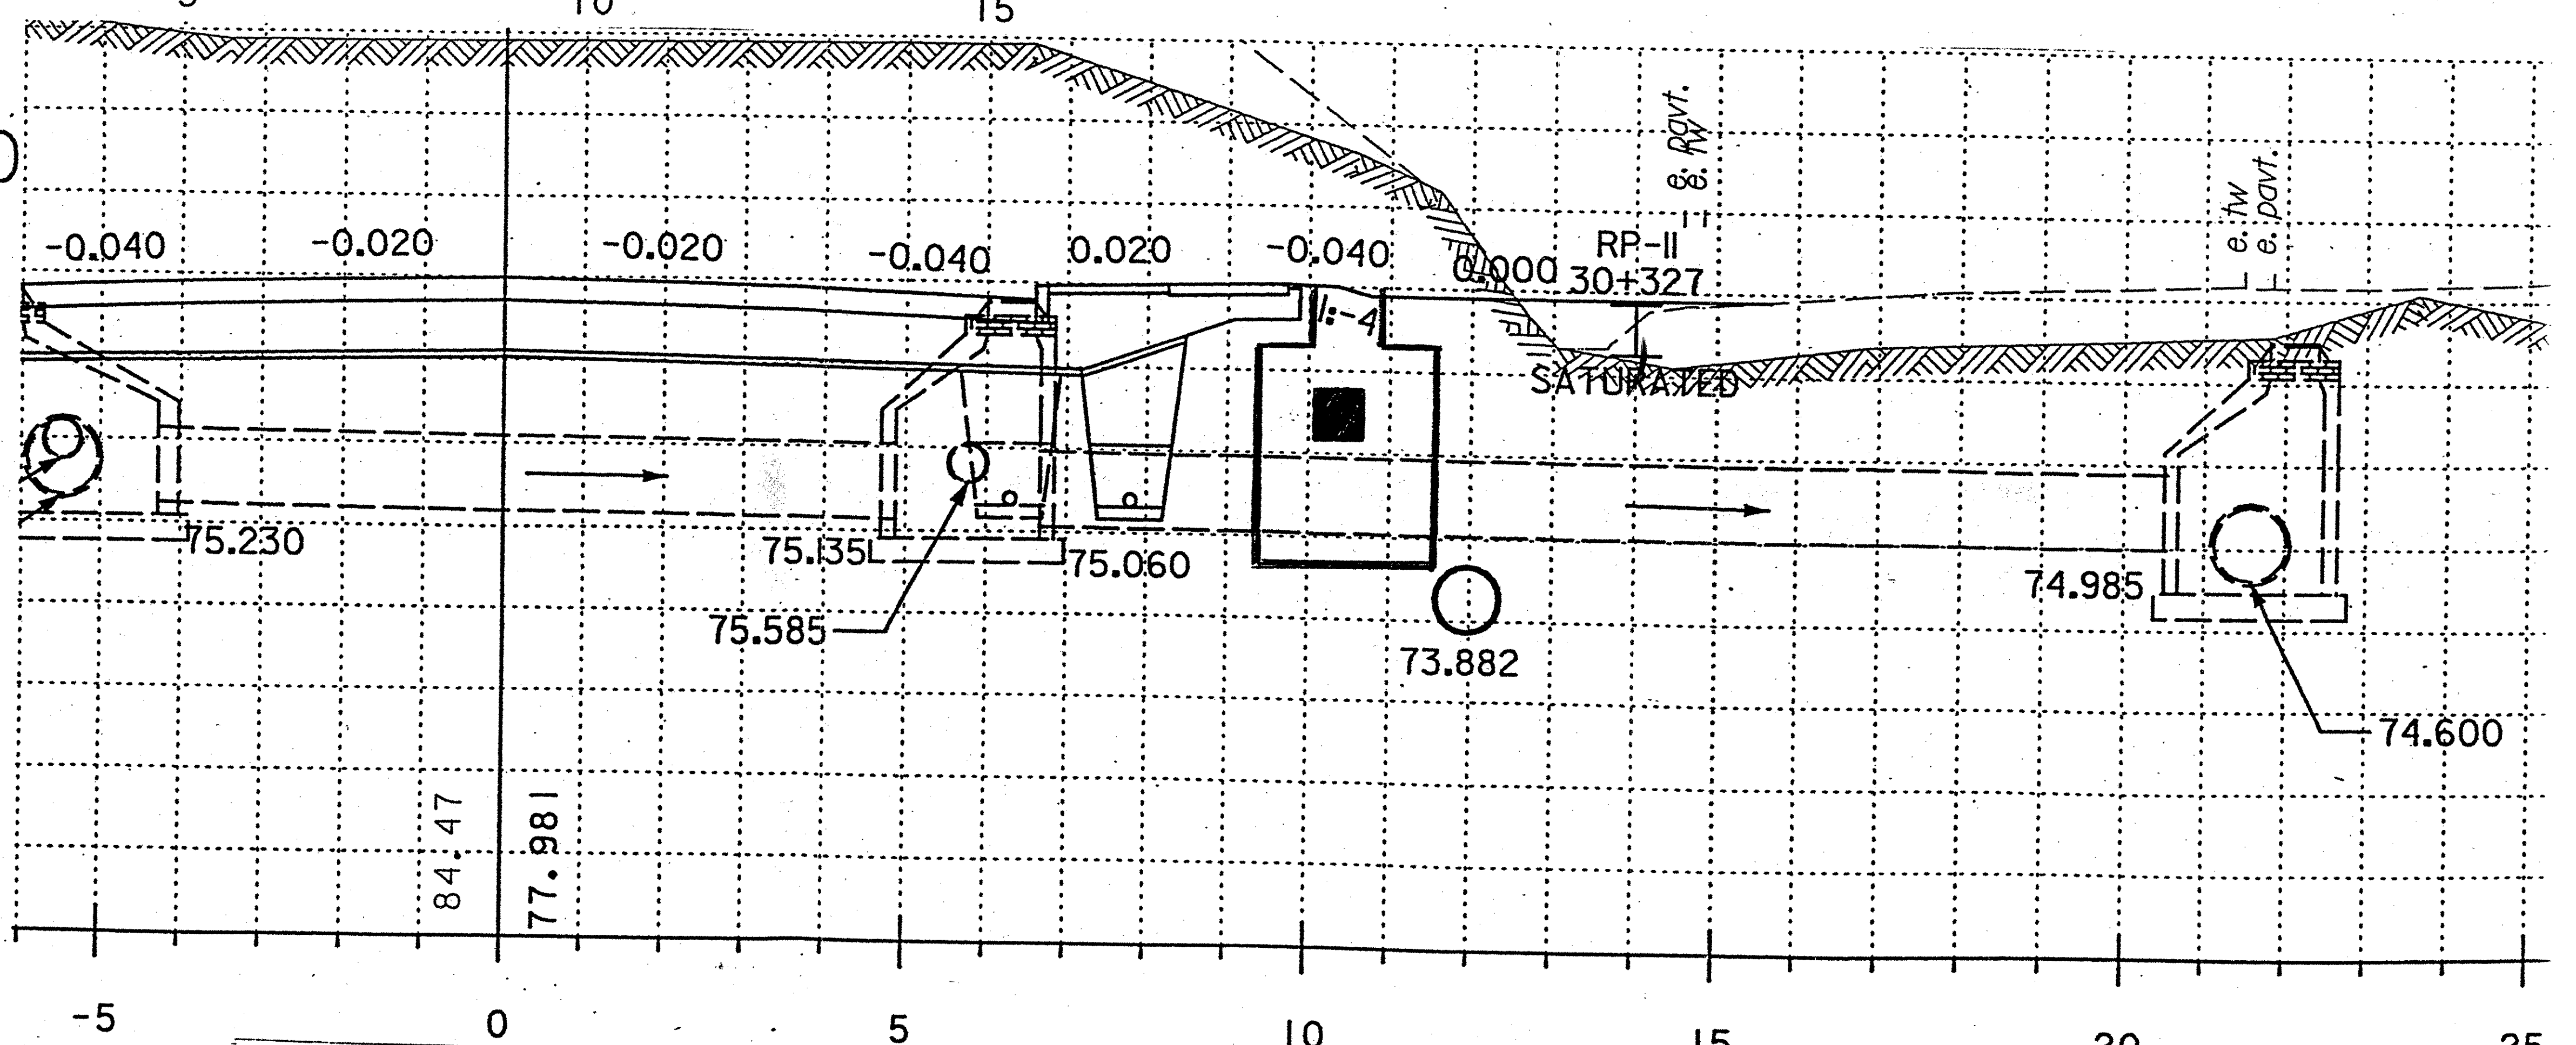

30+330.000

3/2/2001


1456

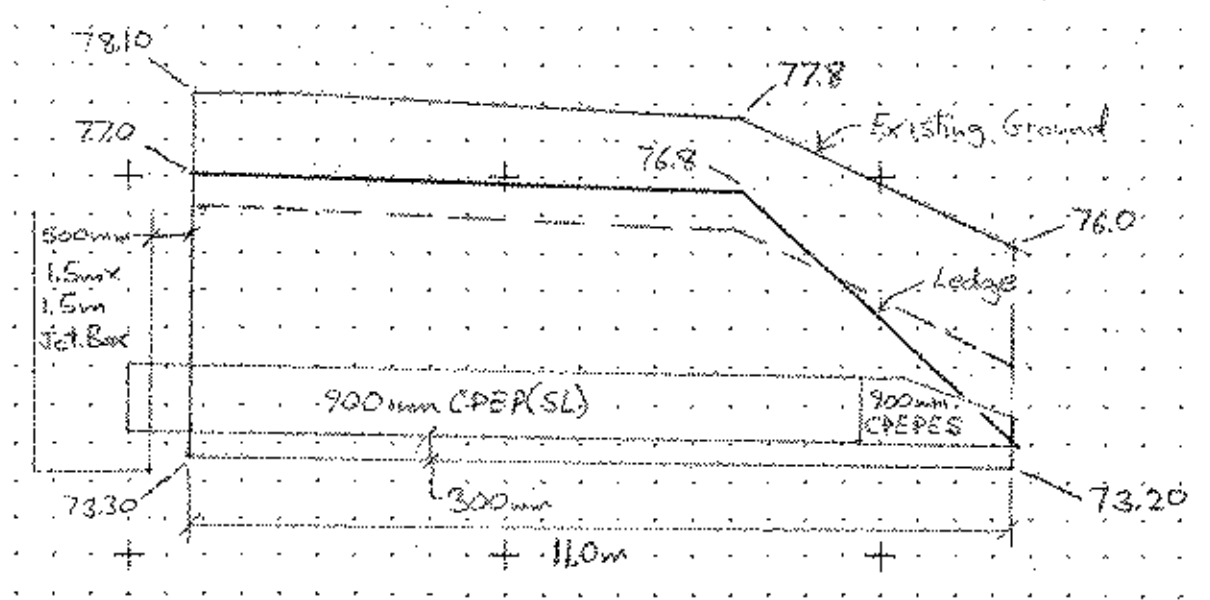

Areas from planimeter
 Trench width = 1.90m
 Trench Earth @ 1 = $12.03m^2 \cdot 1.90m = 22.86m^3$
 Trench Earth @ 1.5 = $1.30m^2 \cdot 1.90m = 2.47m^3$
 Trench Rock @ 1 = $4.0m^2 \cdot 1.90m = 7.60m^3$
 Trench Rock @ 1.5 = $27.9m^2 \cdot 1.90m = 56.21m^3$

D&B 3/10/05
 TSO 7/16/05


A202+43-A203+52 RT
 Jct. Box to Outfall

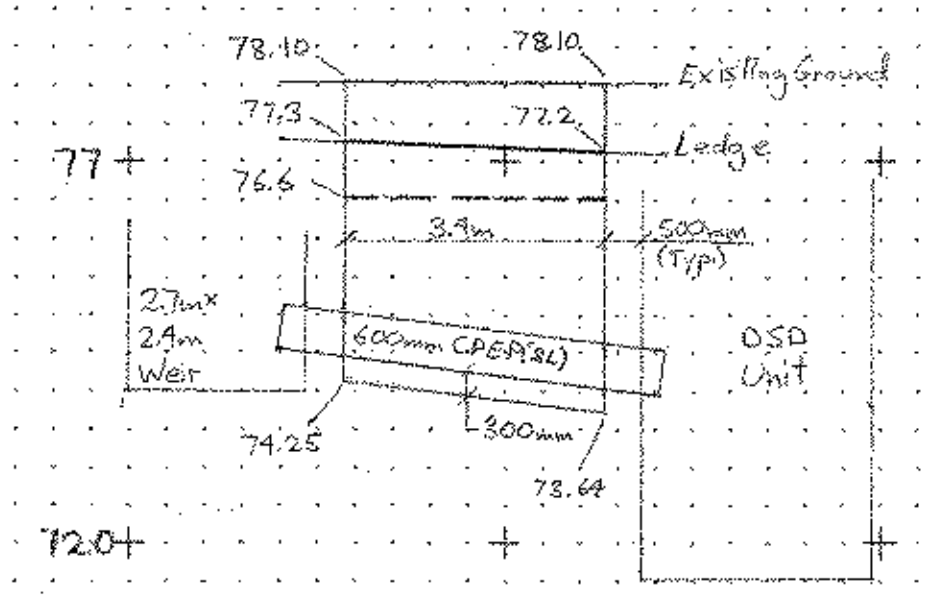

Trench width = 1.60m
 Trench Earth = $\frac{0}{2} \cdot \frac{W}{L} \cdot 1.60m \cdot 3.4m = 4.62m^3$
 Trench Rock = $\frac{0.7}{2} \cdot \frac{W}{L} \cdot 1.60m \cdot 3.4m = 3.54m^3$
 Trench Rock = $\frac{2.35}{2} \cdot \frac{W}{L} \cdot 1.60m \cdot 3.4m = 24.11m^3$

D&B 3/10/05
 TSO 7/16/05


30+338-30+339 RT
 Weir to DSD Unit

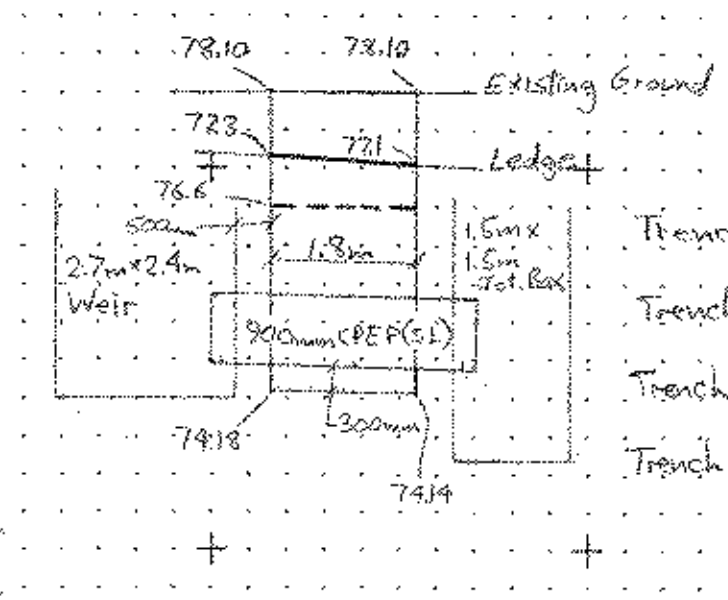

Trench width = 1.90m
 Trench Earth = $\frac{0}{2} \cdot \frac{W}{L} \cdot 1.90m \cdot 1.8m = 3.08m^3$
 Trench Rock = $\frac{0.7}{2} \cdot \frac{W}{L} \cdot 1.90m \cdot 1.8m = 2.05m^3$
 Trench Rock = $\frac{2.42}{2} \cdot \frac{W}{L} \cdot 1.90m \cdot 1.8m = 12.52m^3$

D&B 3/10/05
 TSO 7/16/05

30+338-A202+43 RT
 Weir to Jct. Box

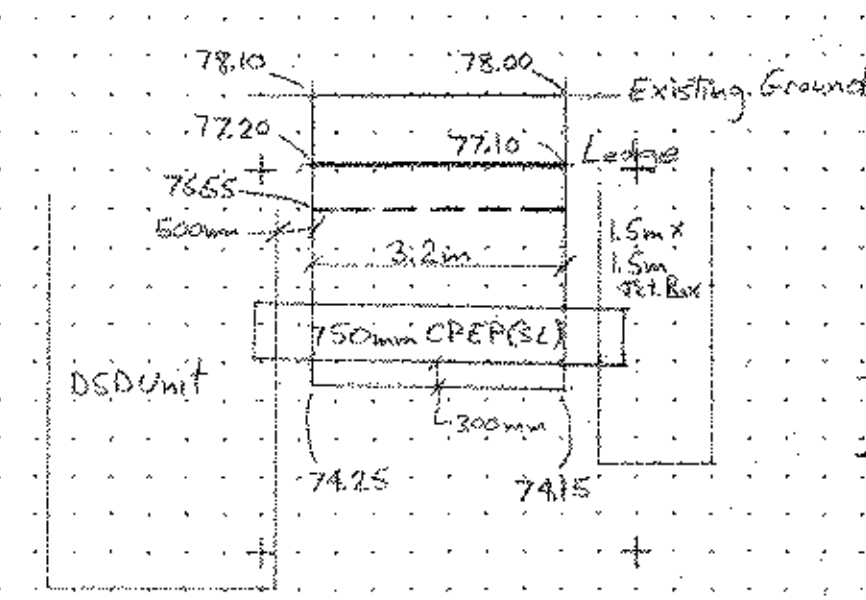

Trench width = 1.75m
 Trench Earth = $\frac{0}{2} \cdot \frac{W}{L} \cdot 1.75m \cdot 3.2m = 5.04m^3$
 Trench Rock = $\frac{0.65}{2} \cdot \frac{W}{L} \cdot 1.75m \cdot 3.2m = 3.36m^3$
 Trench Rock = $\frac{2.3}{2} \cdot \frac{W}{L} \cdot 1.75m \cdot 3.2m = 19.74m^3$


D&B 3/10/05
 TSO 7/16/05

30+339-A203+43 RT
 DSD Unit to Jct. Box

Scale 1:100


--- 1.5m depth limit
 --- Existing Ledge
 --- Pay Limits Authorized

PROJECT: Brattleboro	PROJECT NO.: NH010-2(2)
DESIGN FILE NAME: IPARM FILE NAME: Daryl Bassett	PLOT DATE: 01-MAY-1996
SHEET: 150 of 206	

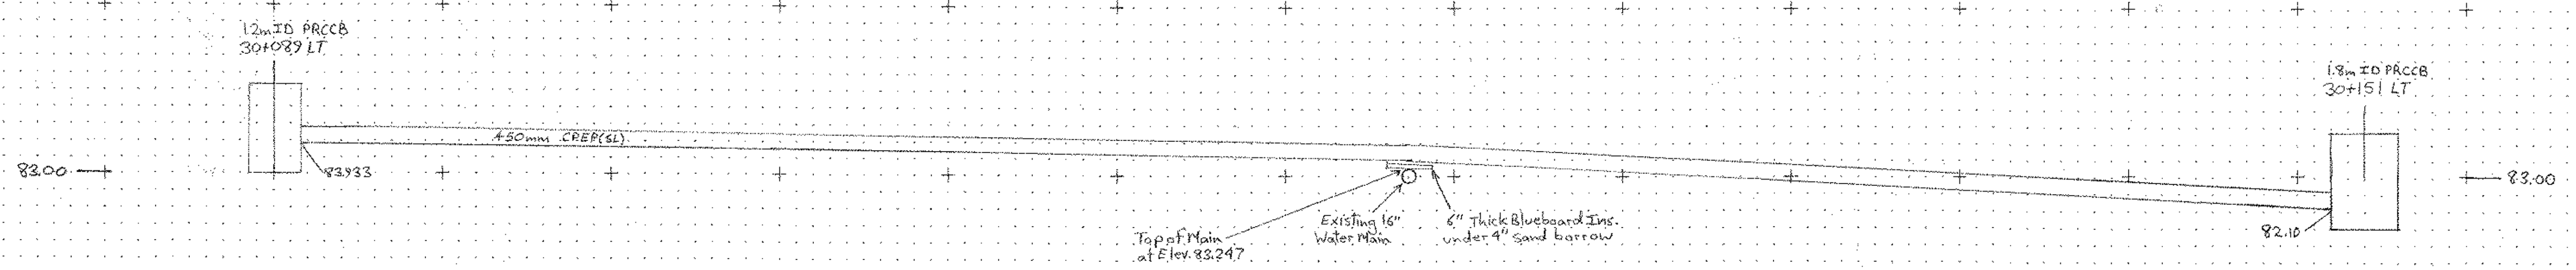


ML Sta. 30+089-30+151 LT Revised Profile
 Scale = 1:100

PROJECT: Brattleboro	PROJECT NO.: NH 010-2(2)
DESIGN FILE NAME: 2/16/05	PLOT DATE: 01 MAY 1996
IPARM FILE NAME: D. Bassett	SHEET: 151x50F

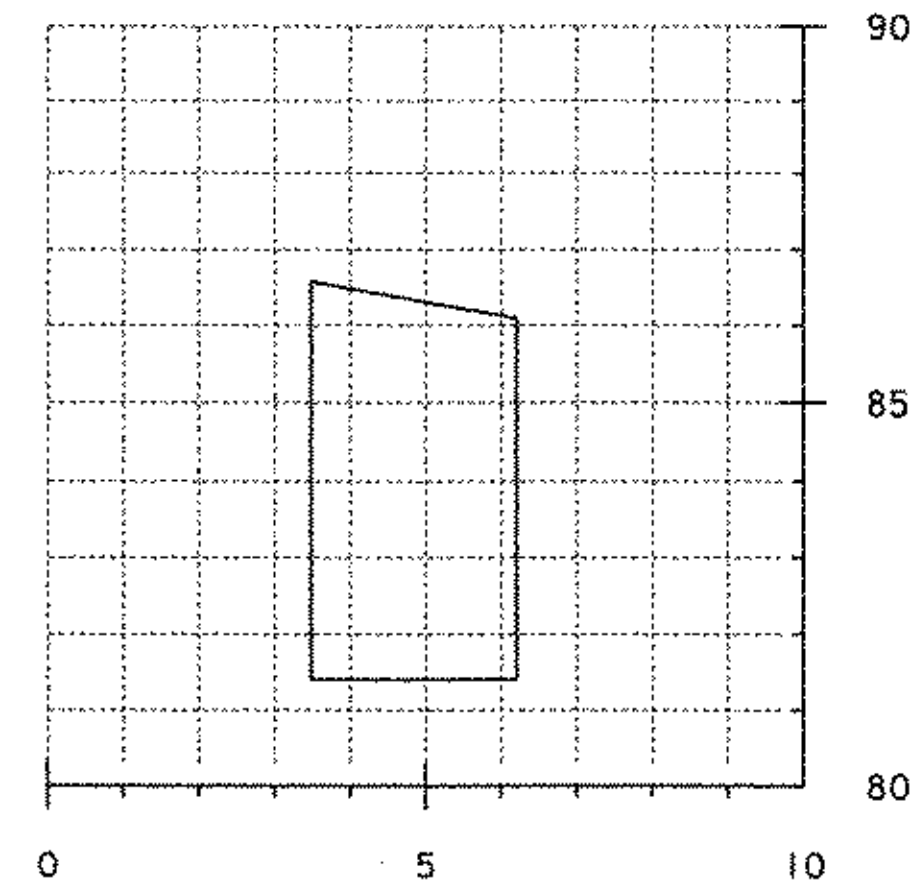


FRONT1 OF ABUTMENT FOOTING
AREA = 13.406m²

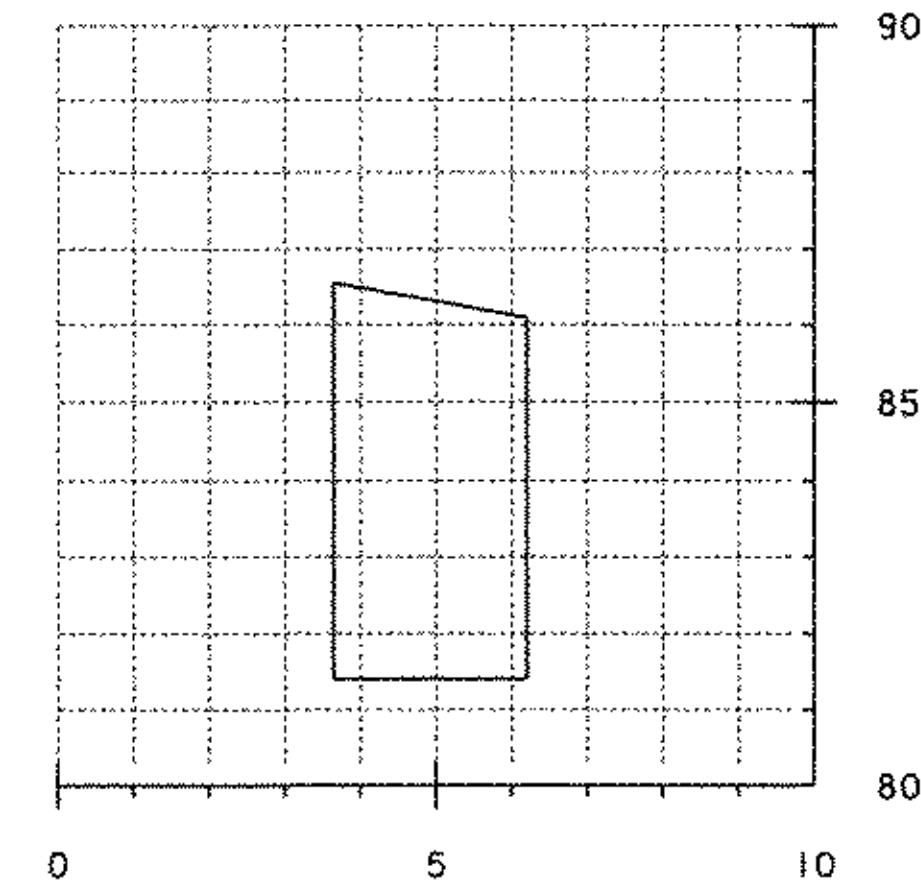


FRONT2 OF ABUTMENT FOOTING
AREA = 12.58m²


US 01/16/05

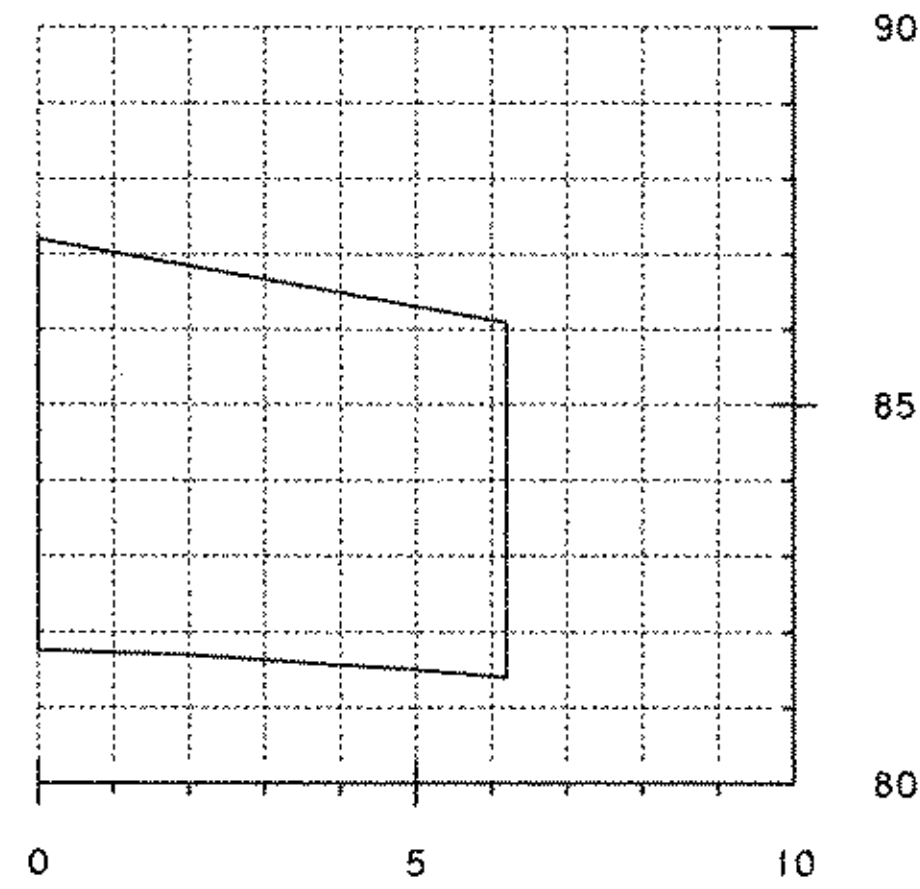

FRONT3 OF ABUTMENT FOOTING
AREA = 31.237m²

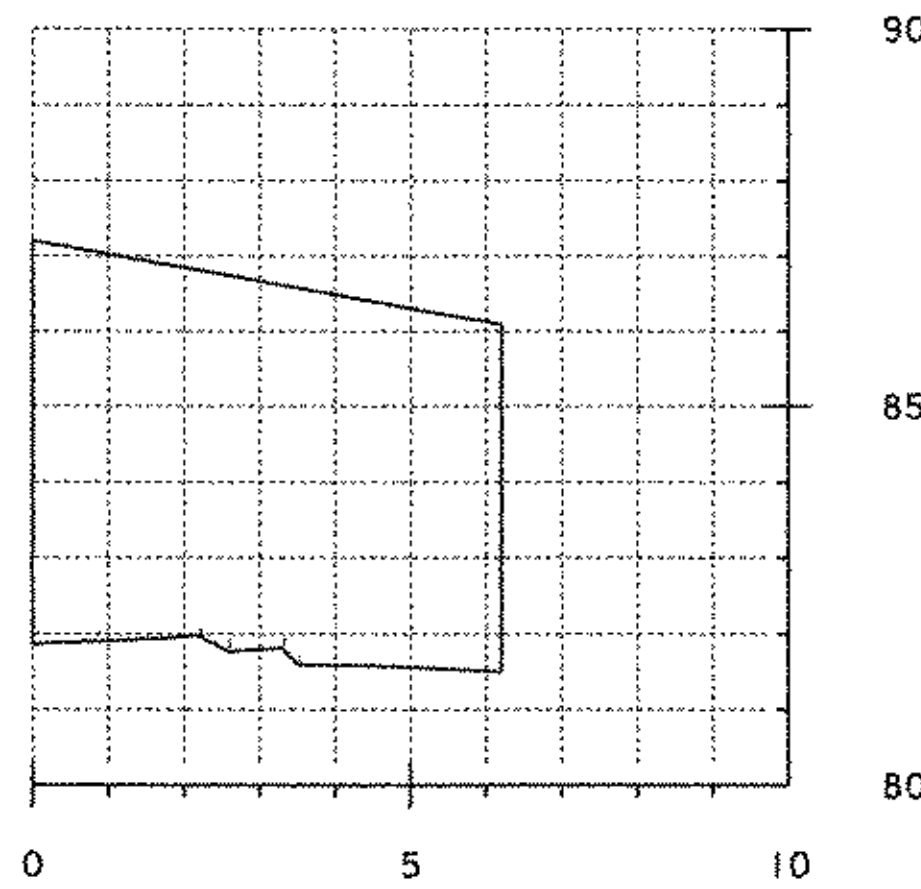


MIDDLE OF ABUTMENT FOOTING
AREA = 30.459m²

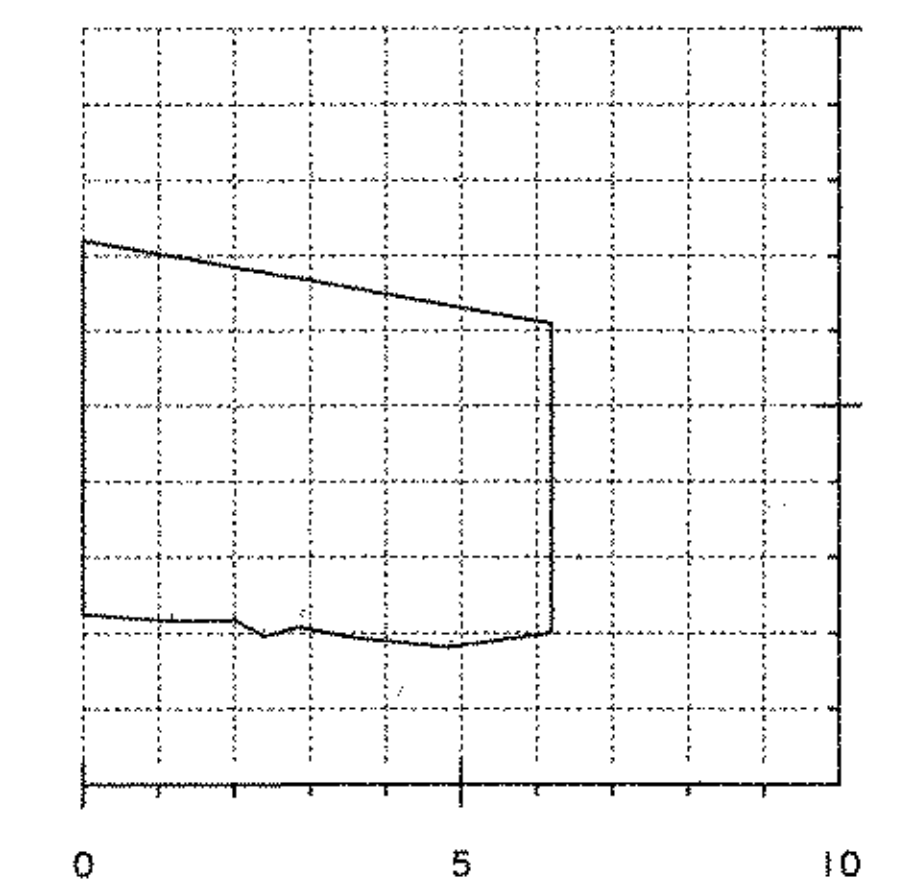


BACK OF ABUTMENT FOOTING
AREA = 28.666m²

US 01/16/05


SARGENT BROOK SOUTH
COFFERDAM EXCAVATION EARTH

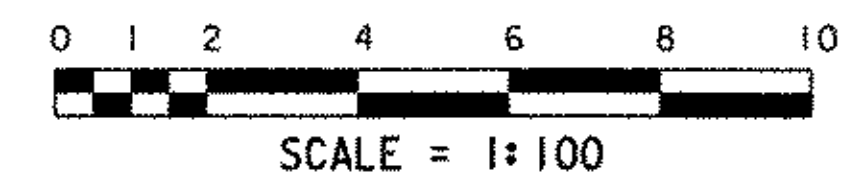

PROJECT: BRATTLEBORO	PROJECT NO.: NH 010-2(2)
PLOT DATE: 25-MAR-2005	
LEDGE SECTIONS 15343	

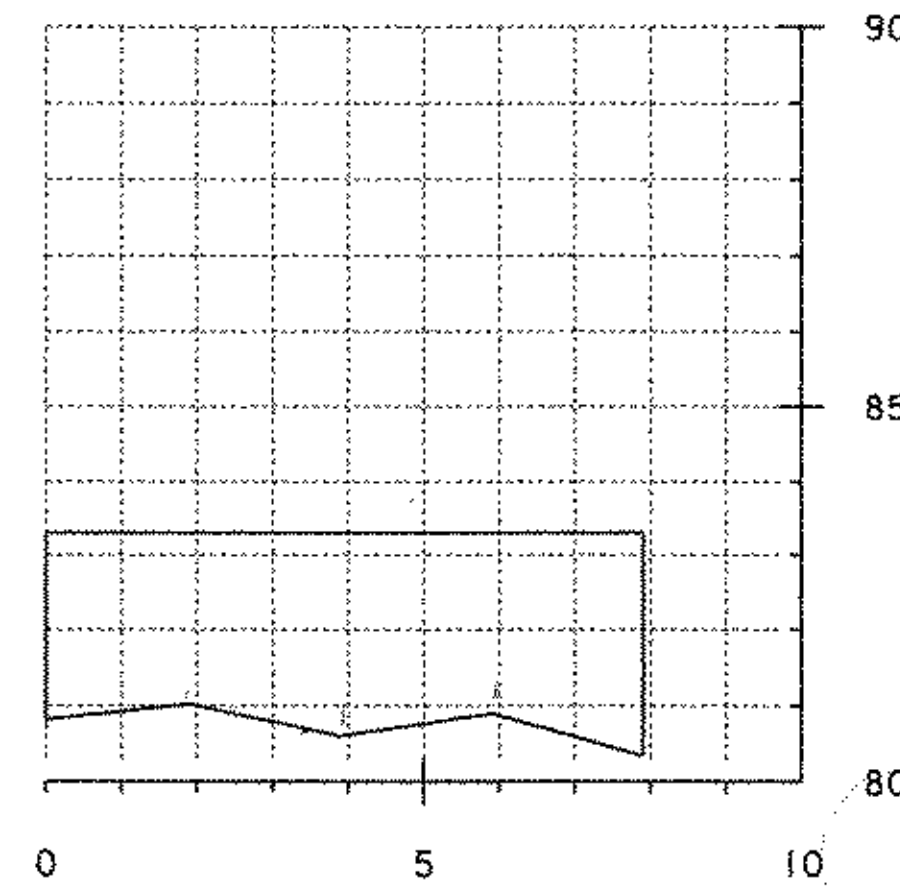


FRONT OF WINGWALL TWO FOOTING
AREA = 19.992m²

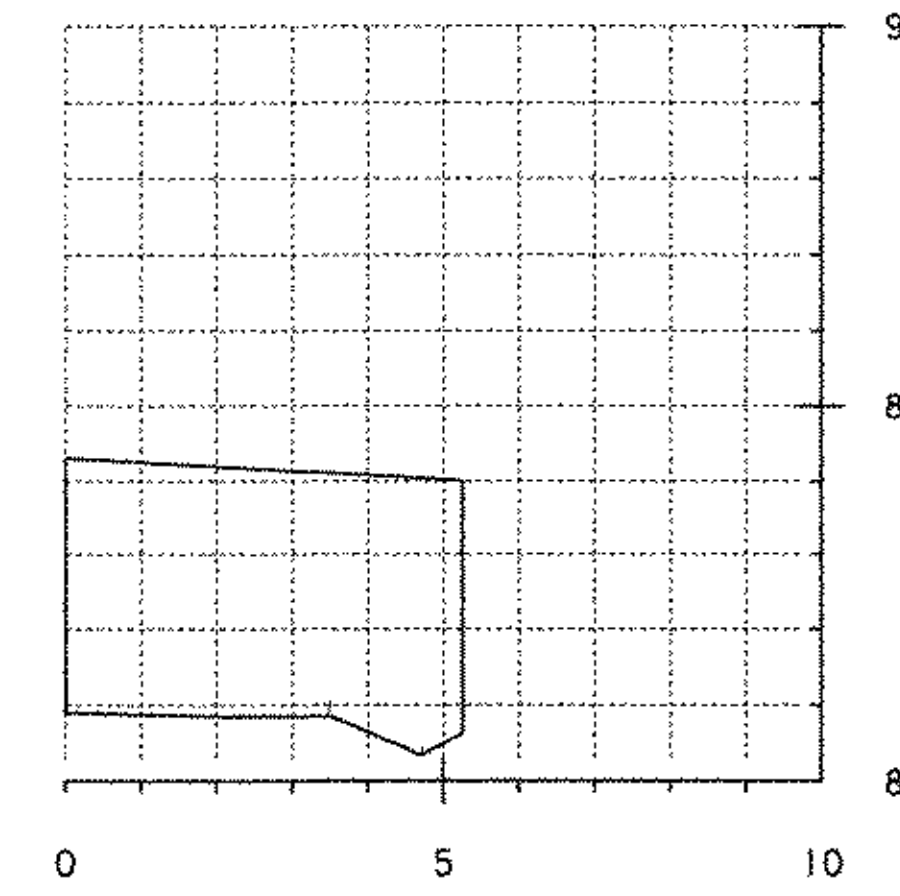


BACK OF WINGWALL TWO FOOTING
AREA = 17.785m²


6/25 03/20/05

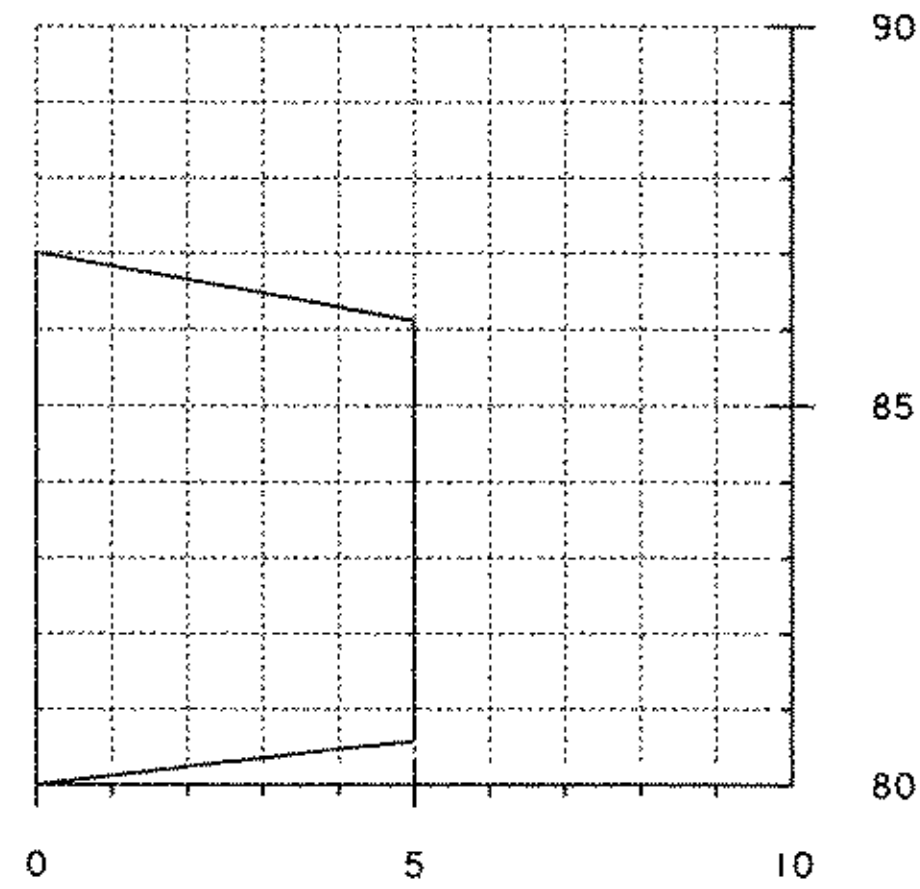

FRONT OF ABUTMENT FOOTING
AREA = 31.280m²

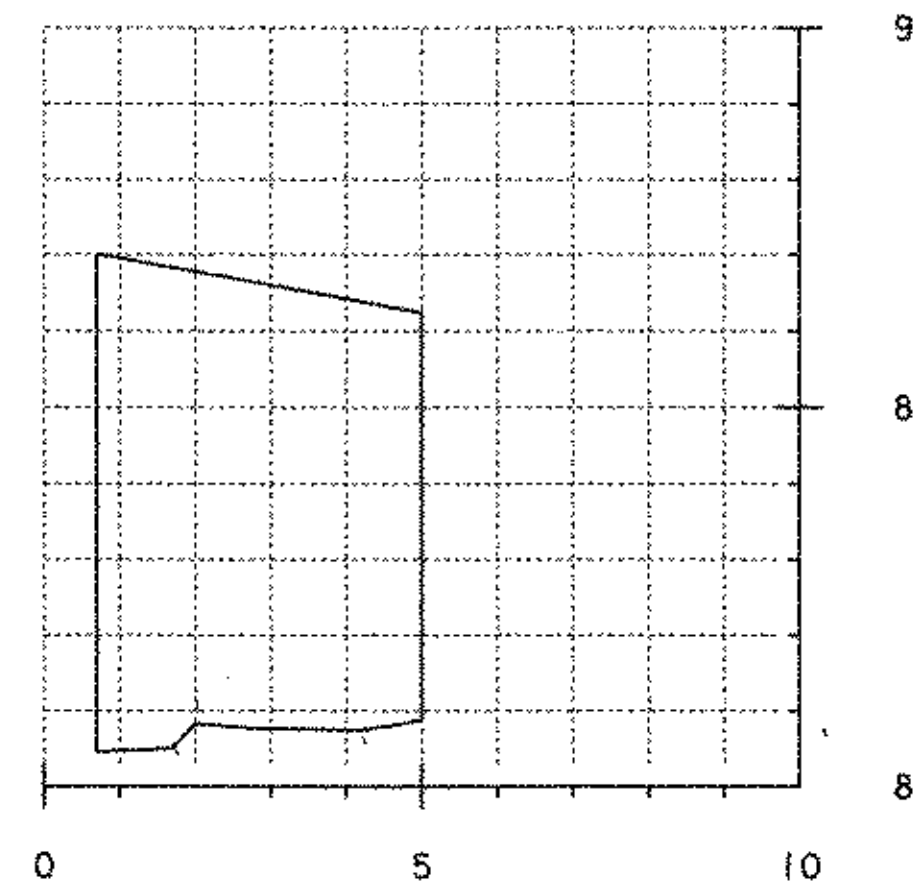


MIDDLE OF ABUTMENT FOOTING
AREA = 25.425m²

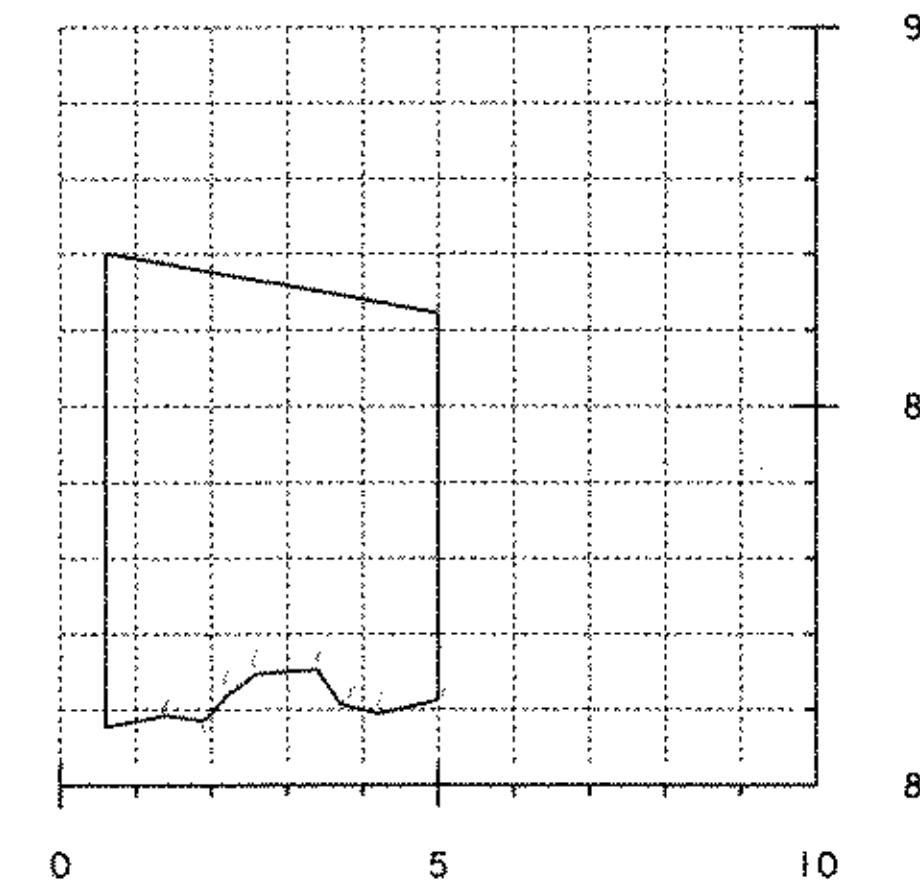


BACK OF ABUTMENT FOOTING
AREA = 24.194m²

6/25 03/20/05


SARGENT BROOK NORTH
COFFERDAM EXCAVATION EARTH

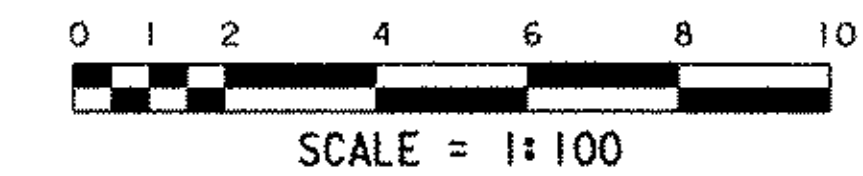


PROJECT: BRATTLEBORO	PROJECT NO.: NH 010-2(2)
PLOT DATE: 25-MAR-2005	
LEDGE SECTIONS <i>154 x 5</i>	

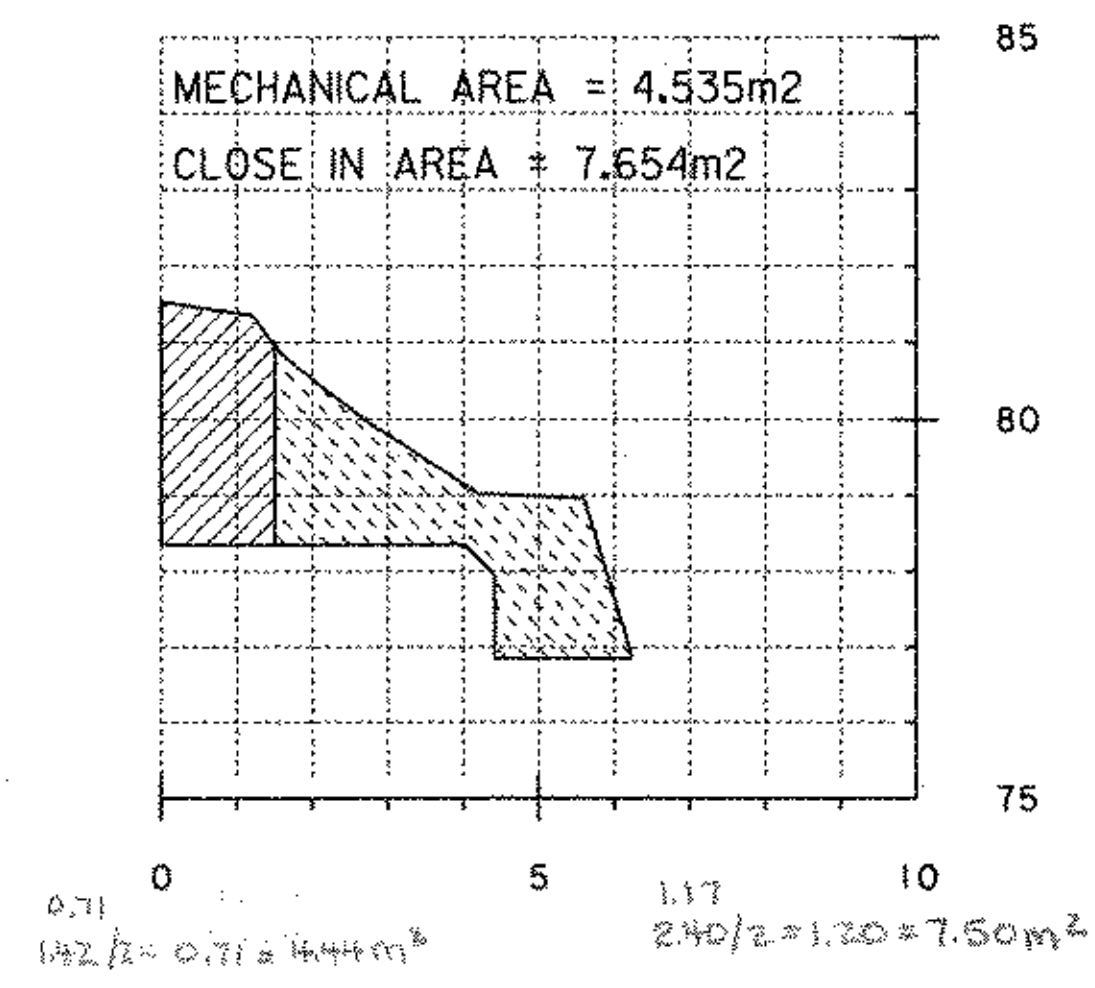


FRONT OF ABUTMENT FOOTING

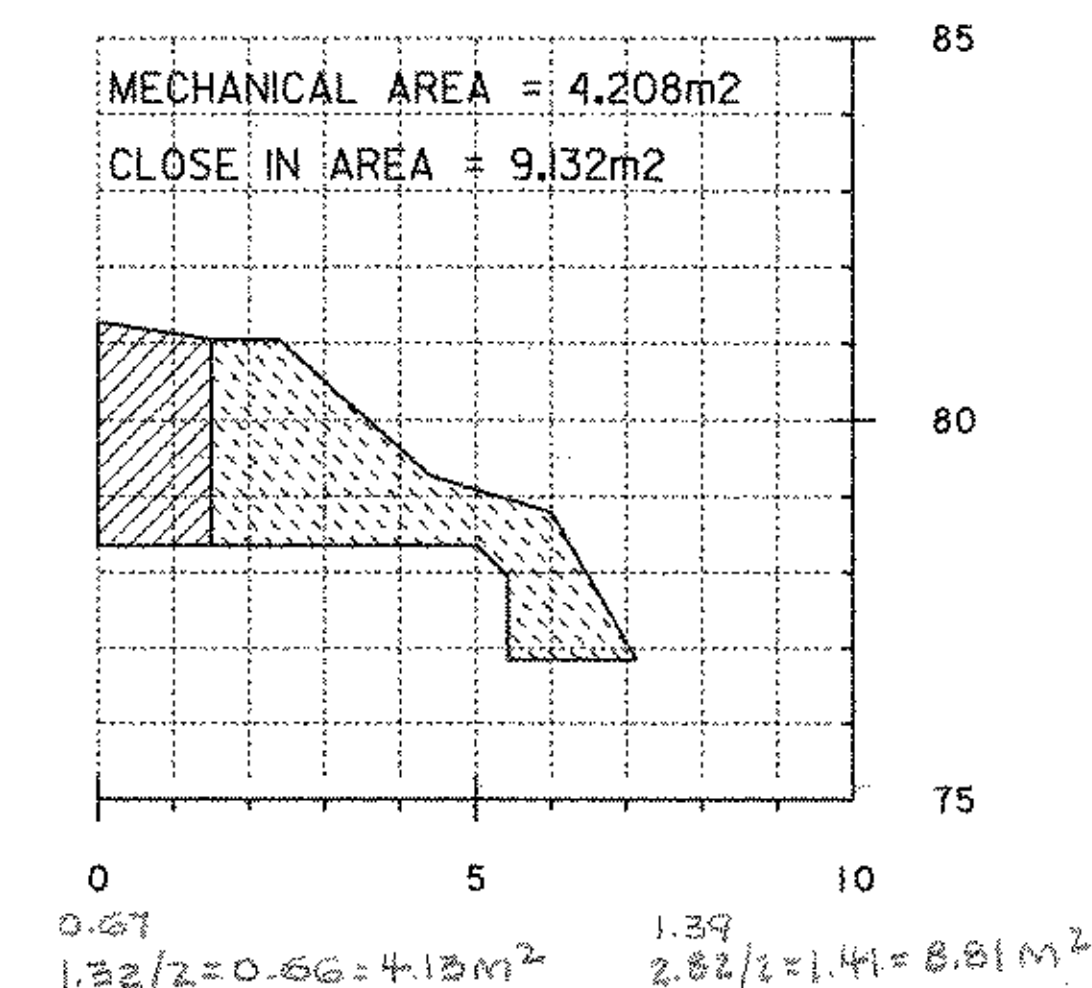

MIDDLE OF ABUTMENT FOOTING

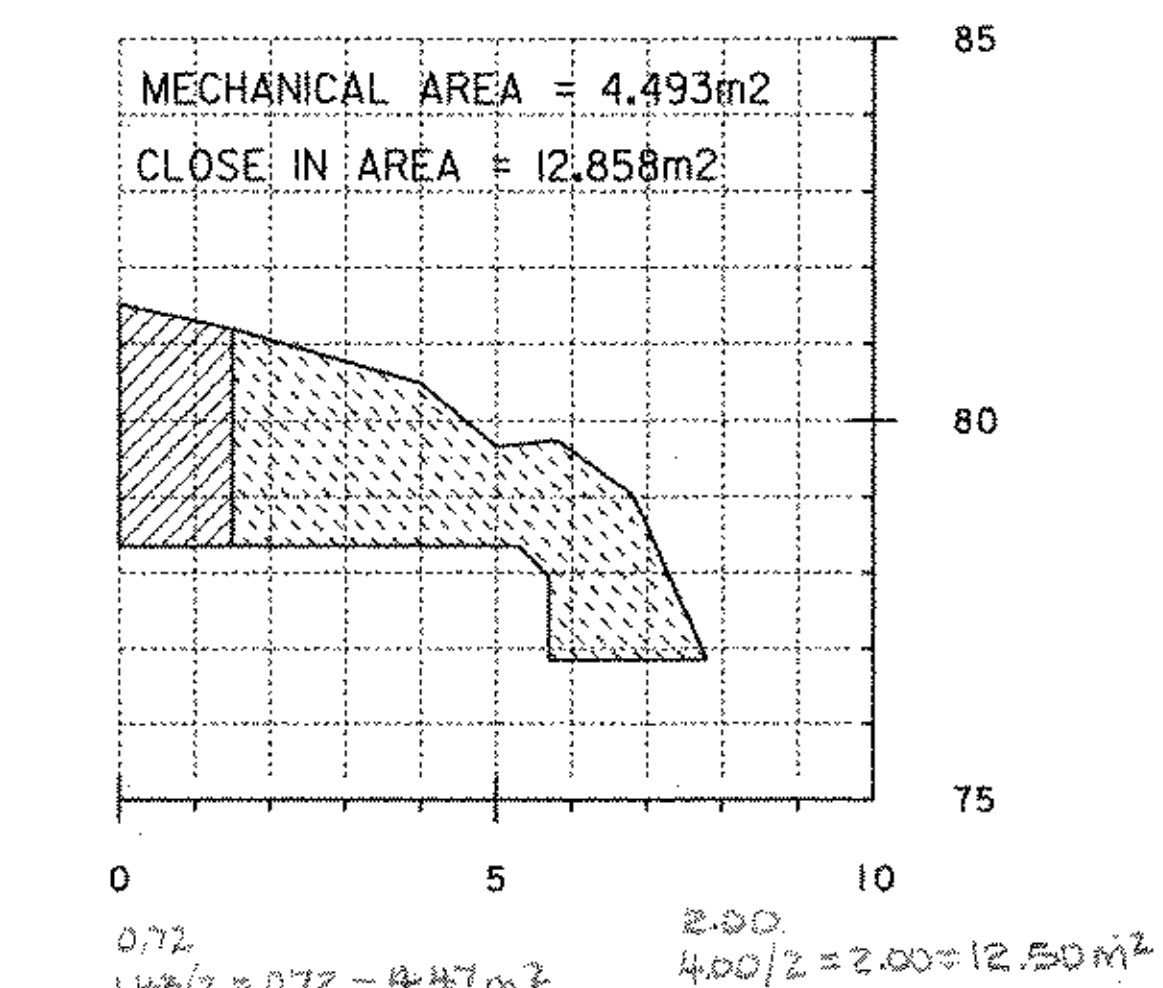

BACK OF ABUTMENT FOOTING

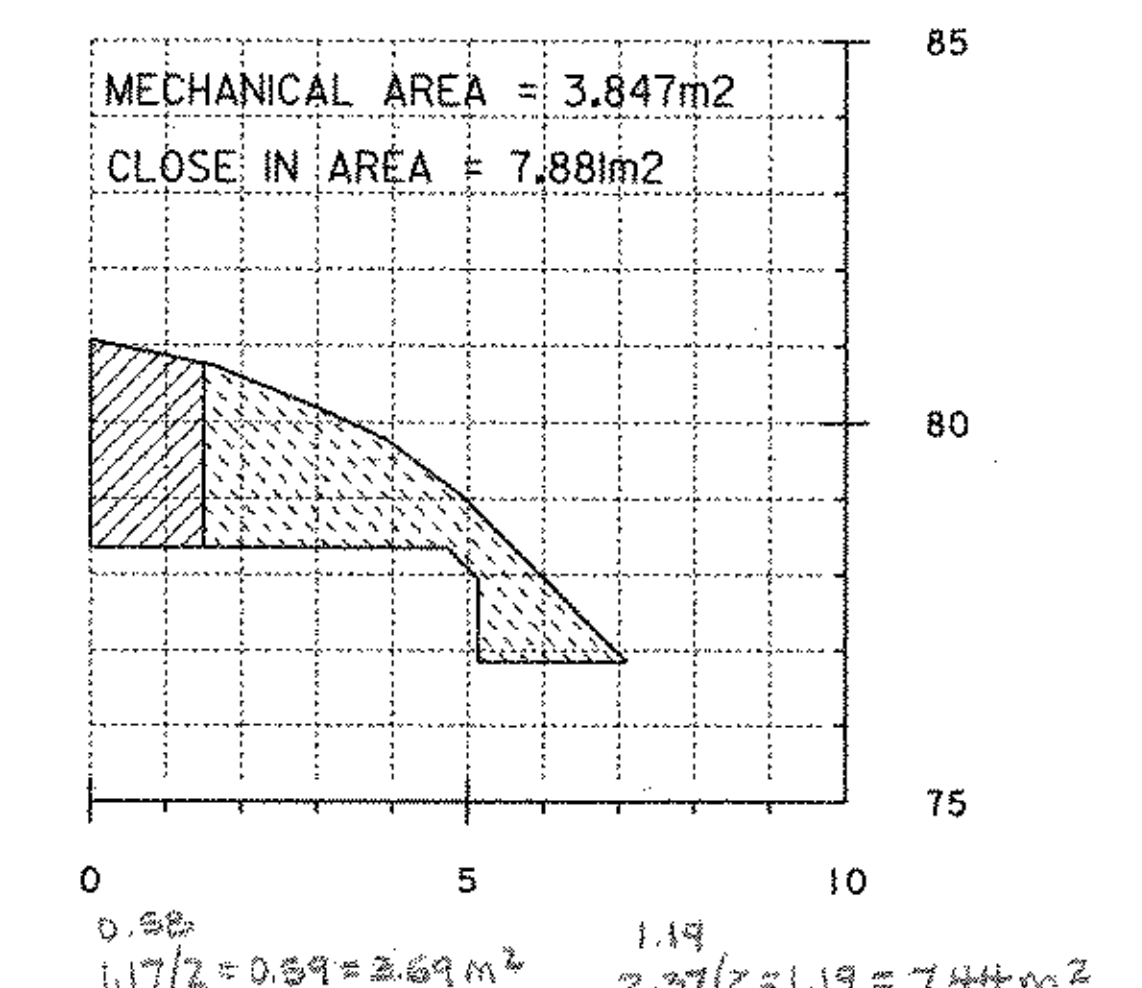


BACK OF ABUTMENT FOOTING

LEGEND


- = MECHANICAL REMOVAL ZONE
- = CLOSE IN REMOVAL ZONE

ROUTE 9 BRIDGE NORTH ABUTMENT
PHASE ONE LEDGE SECTIONS

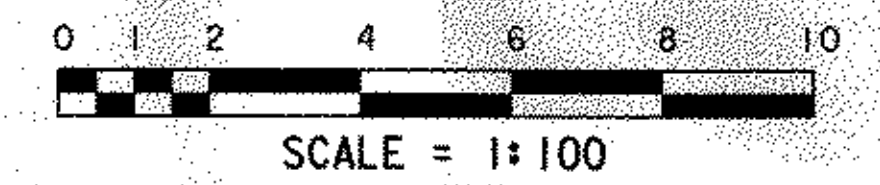


JPD 1/27/05


PROJECT: BRATTLEBORO	PROJECT NO.: NH 010-2(2)
PLOT DATE: 10-MAR-2004	
LEDGE SECTIONS 155 XS	

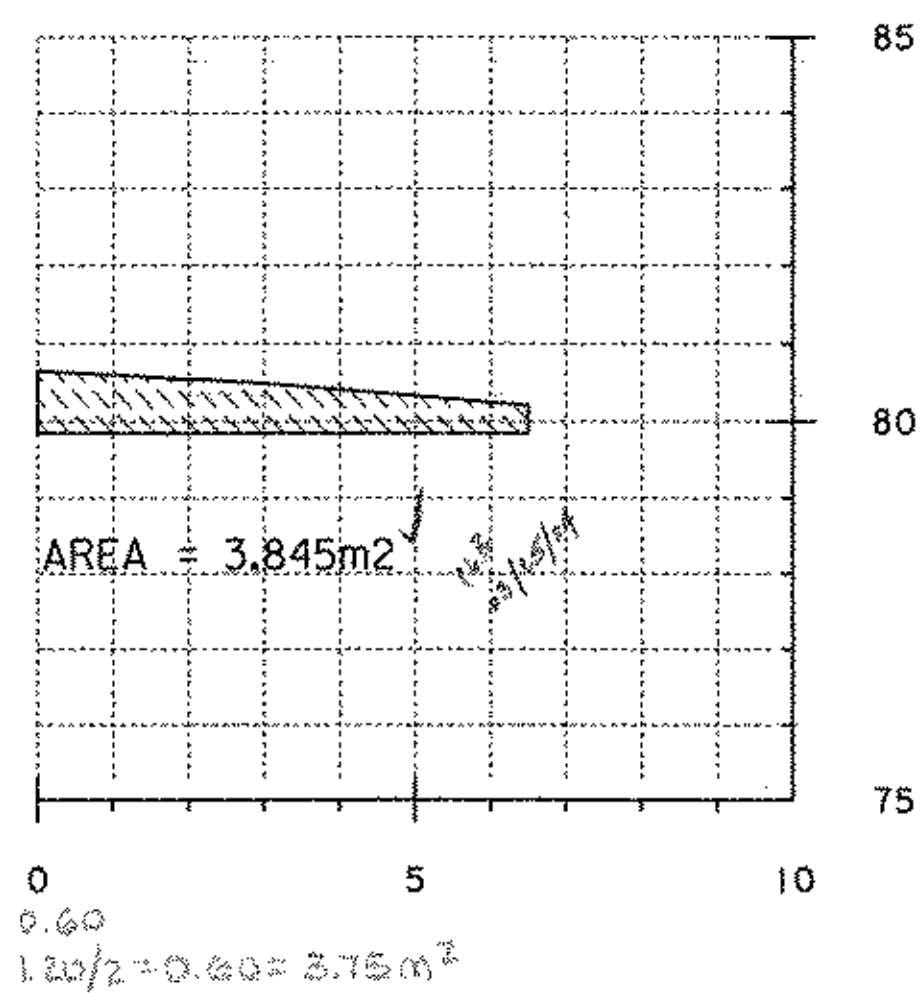


FRONT OF WWIA

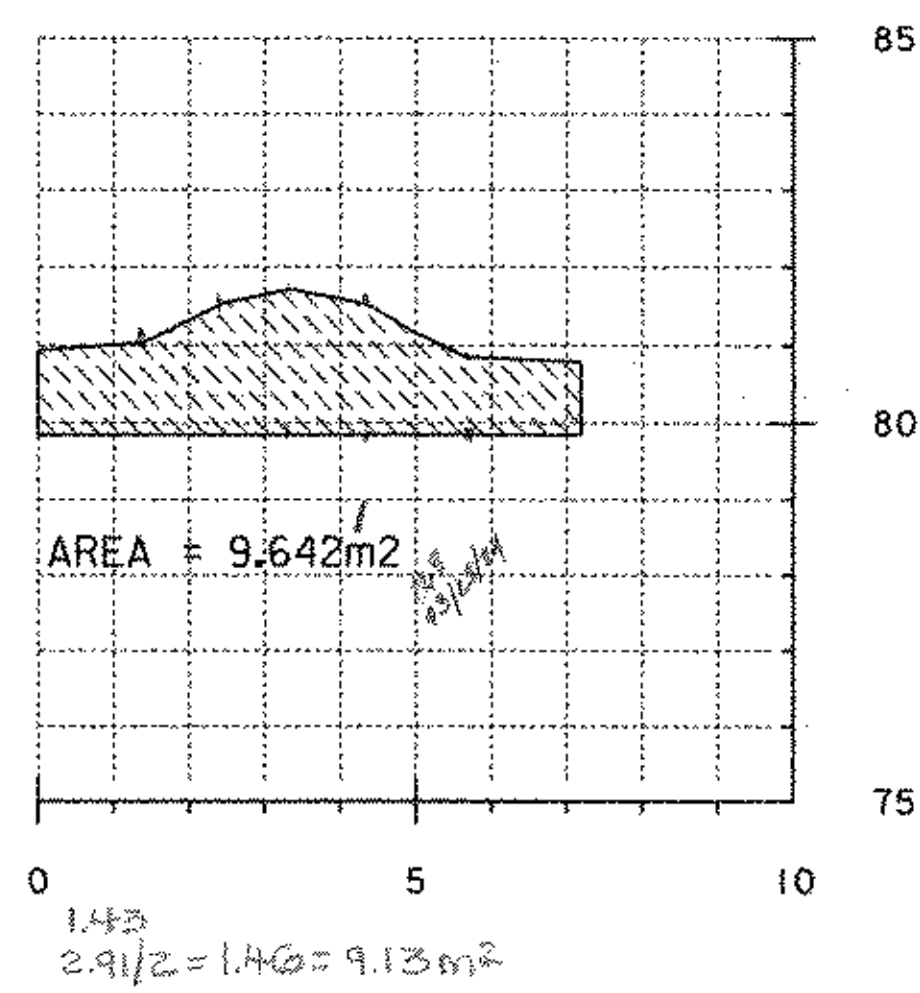


MIDDLE OF WWIA

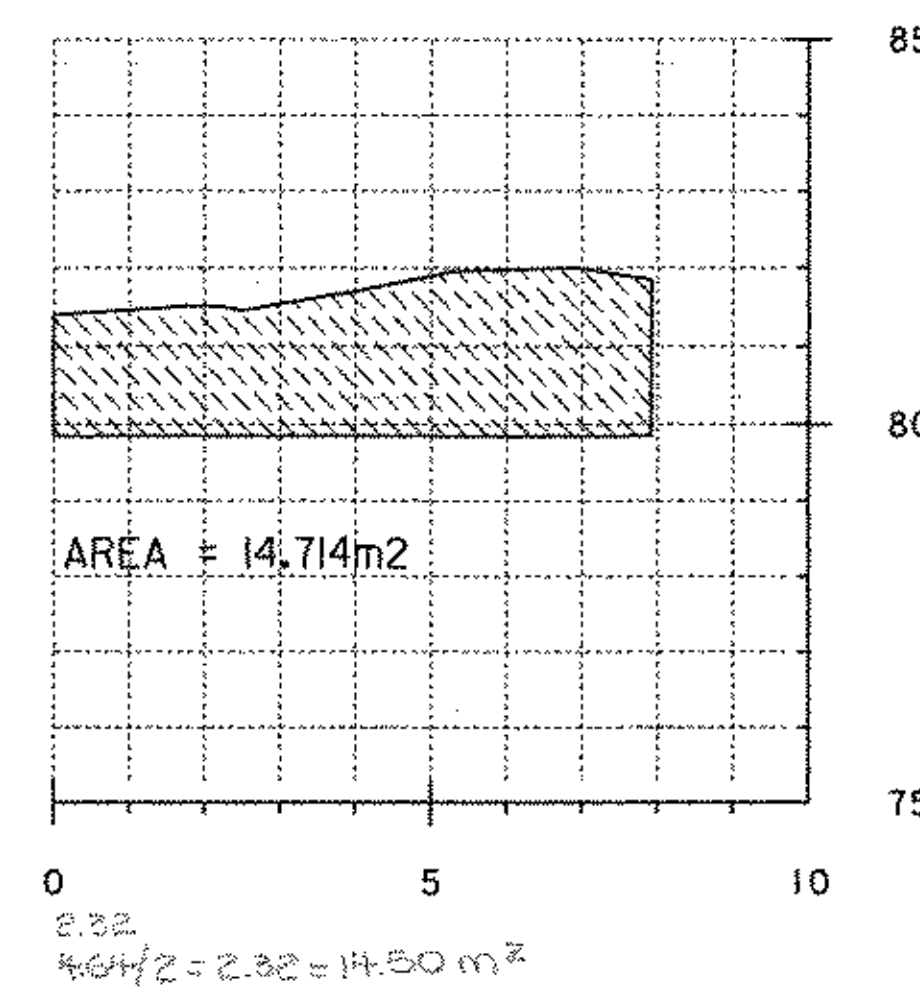


1.5M LINE OF WWIA

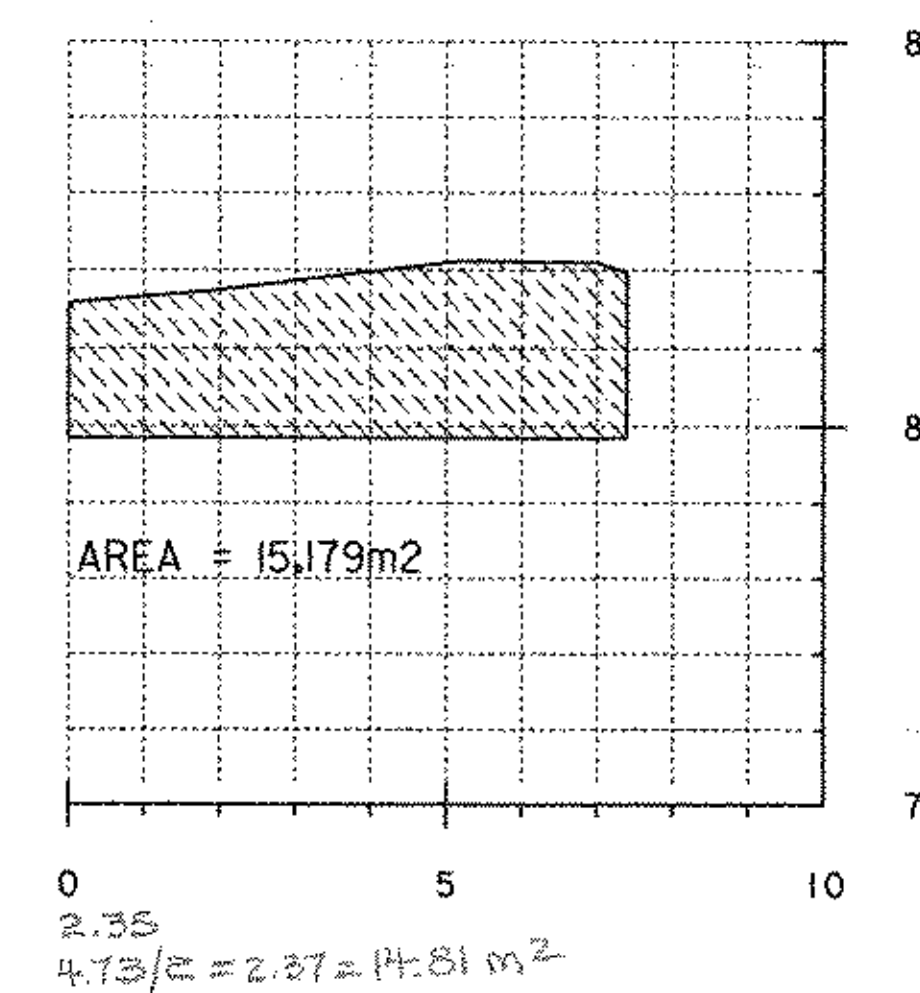


BACK OF WWIA

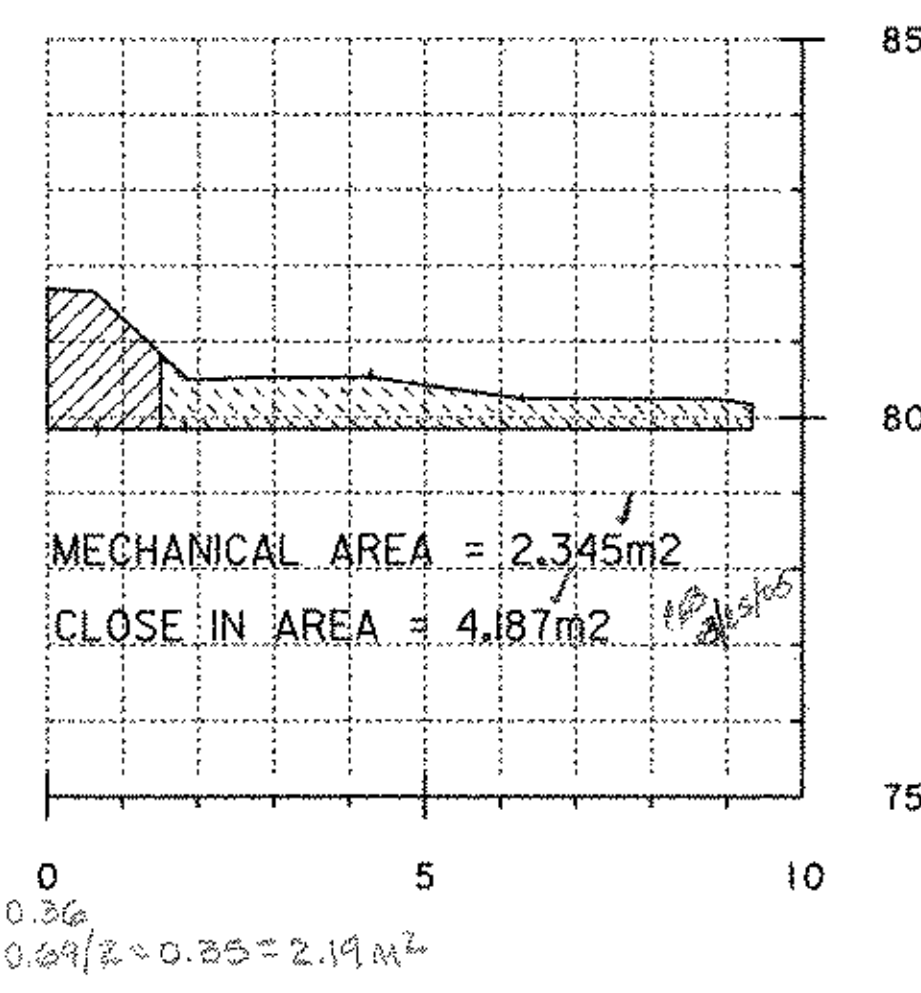


FRONT OF ABUTMENT FOOTING

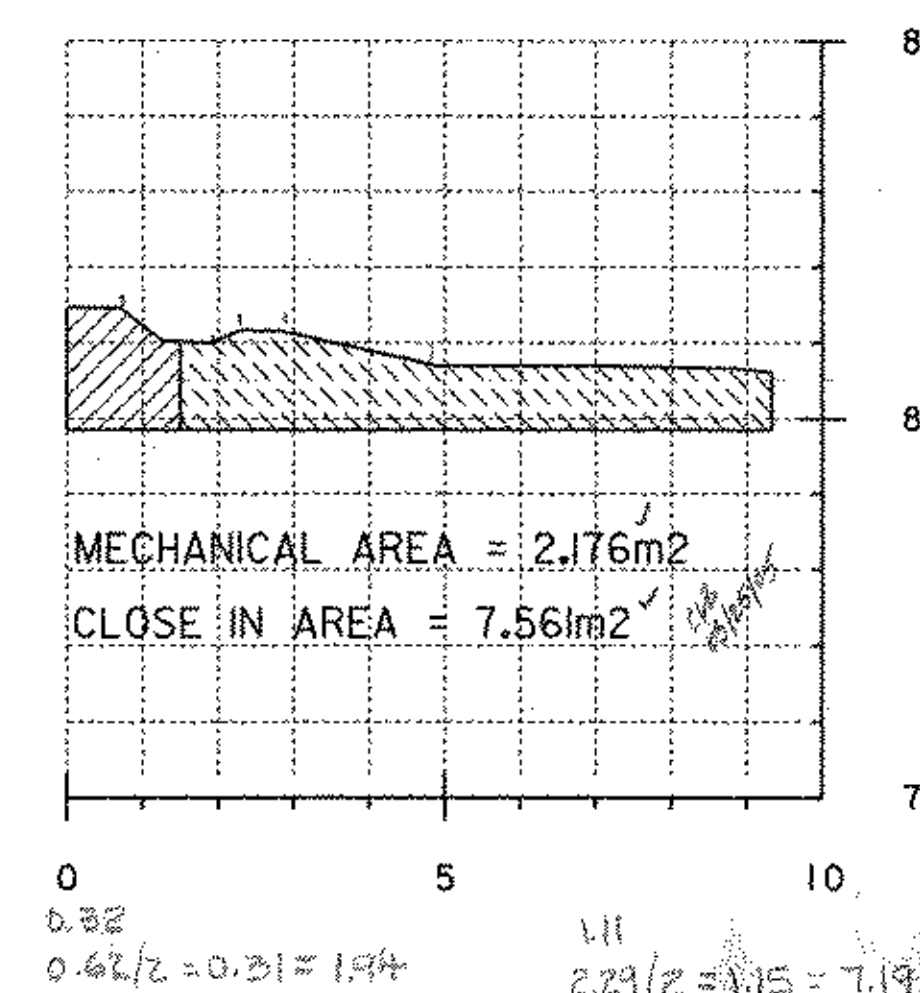

MIDDLE OF ABUTMENT FOOTING

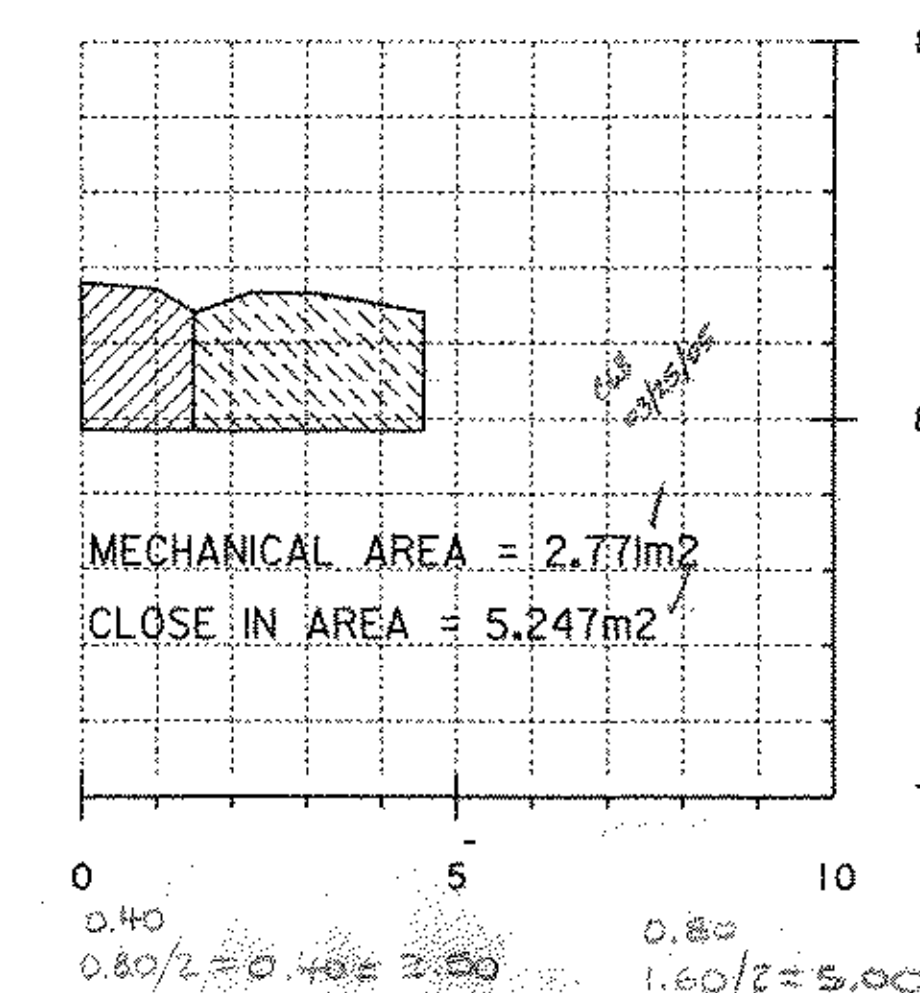

BACK OF ABUTMENT FOOTING

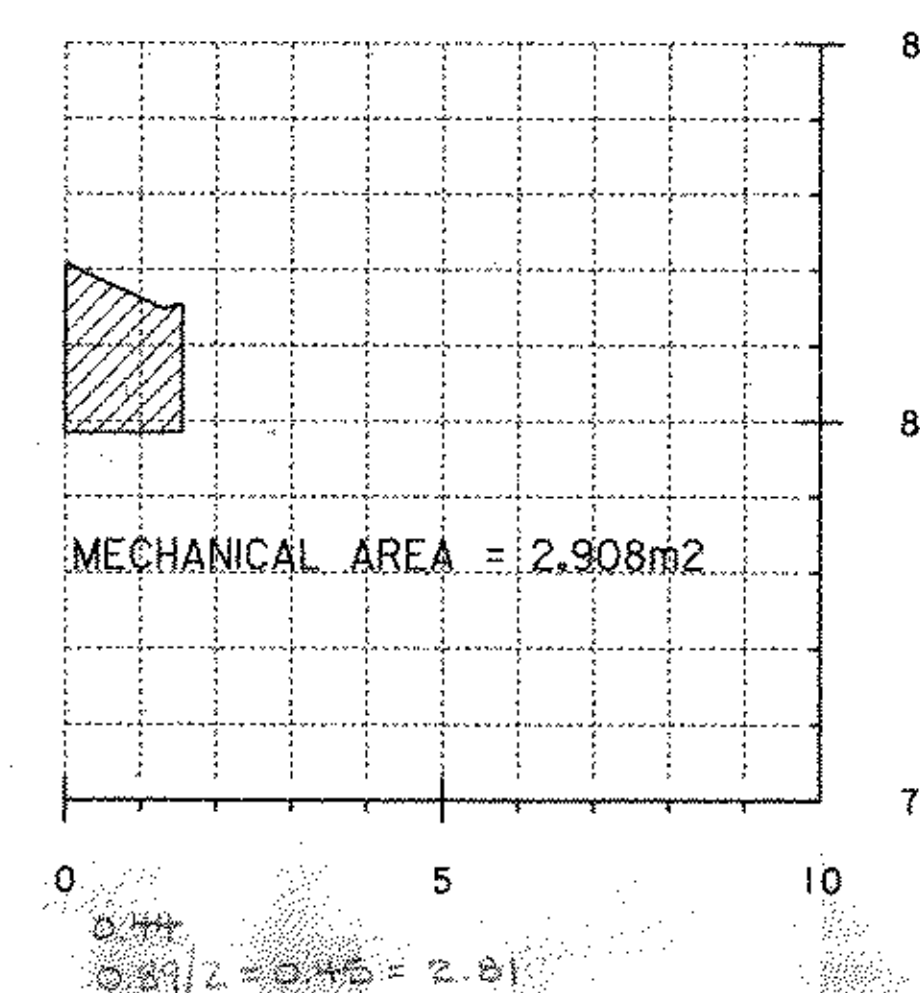

BACK OF ABUTMENT FOOTING

LEGEND

- = MECHANICAL REMOVAL ZONE
- = CLOSE IN REMOVAL ZONE


ROUTE 9 BRIDGE SOUTH ABUTMENT
PHASE ONE LEDGE SECTIONS




SCALE = 1:100

VJD 1/27/03


PROJECT: BRATTLEBORO	PROJECT NO.: NH 010-2(2)
PLOT DATE: 10-MAR-2004	
LEDGE SECTIONS 156 XS	

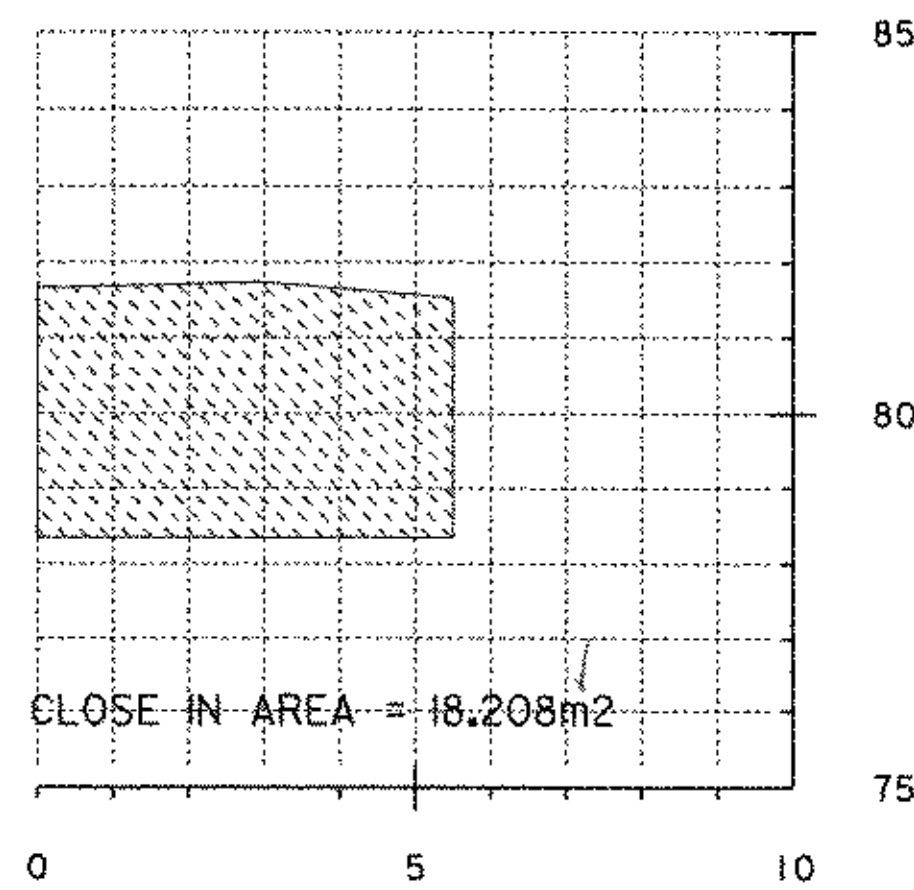

FRONT OF WINGWALL 4 FOOTING

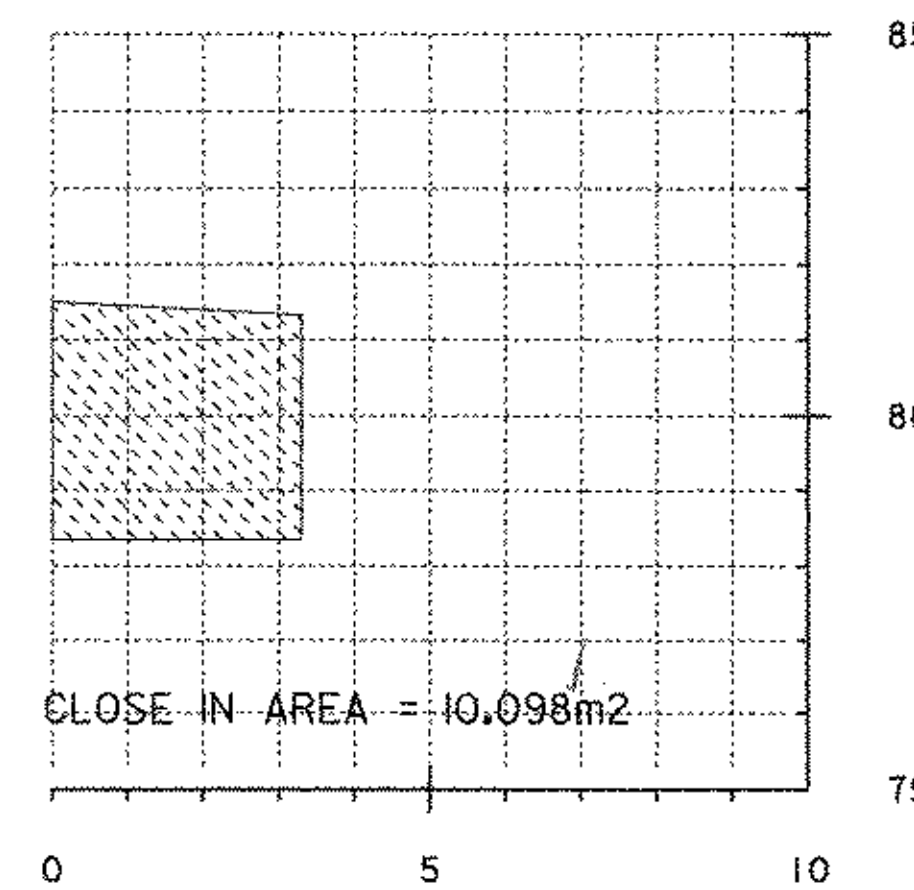


MIDDLE OF WINGWALL 4 FOOTING

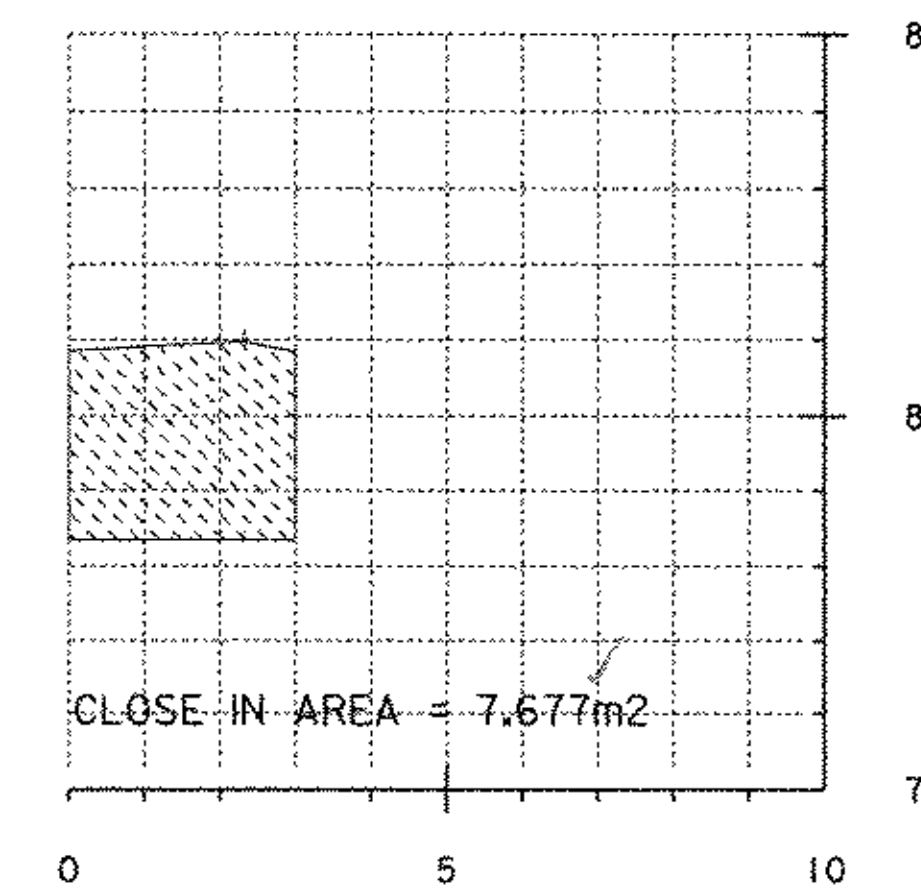


BACK OF WINGWALL 4 FOOTING

Close in areas


ROUTE 9 BRIDGE NORTH ABUTMENT
PHASE TWO LEDGE SECTIONS

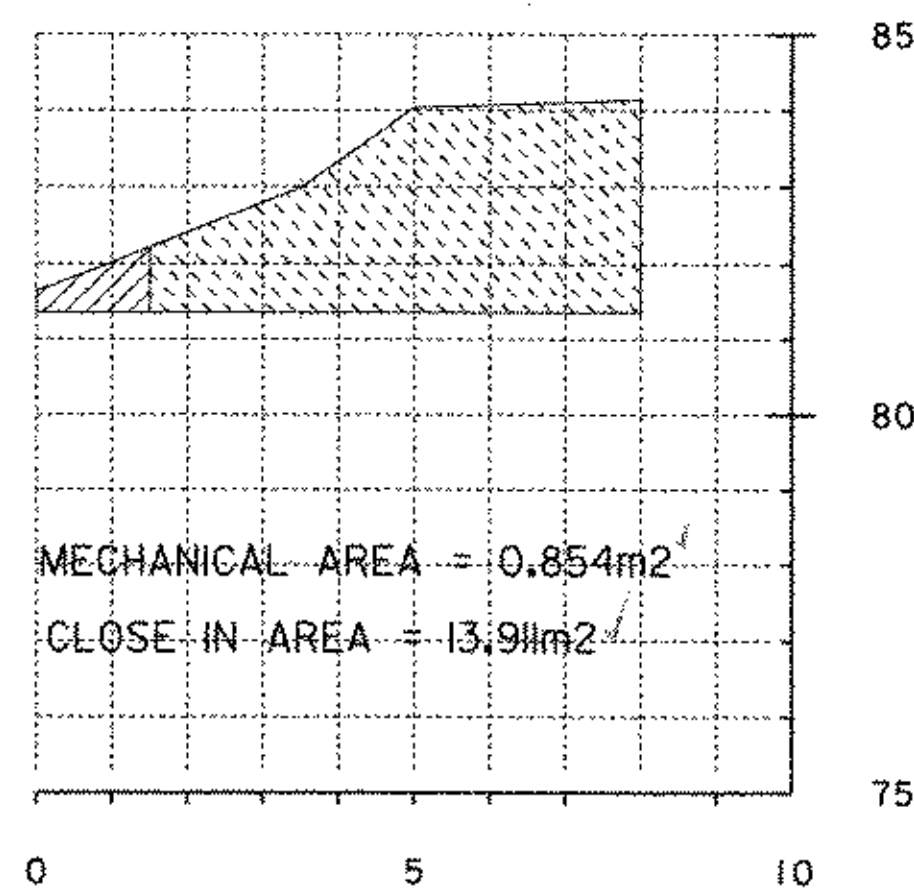

FRONT OF WINGWALL 2A FOOTING

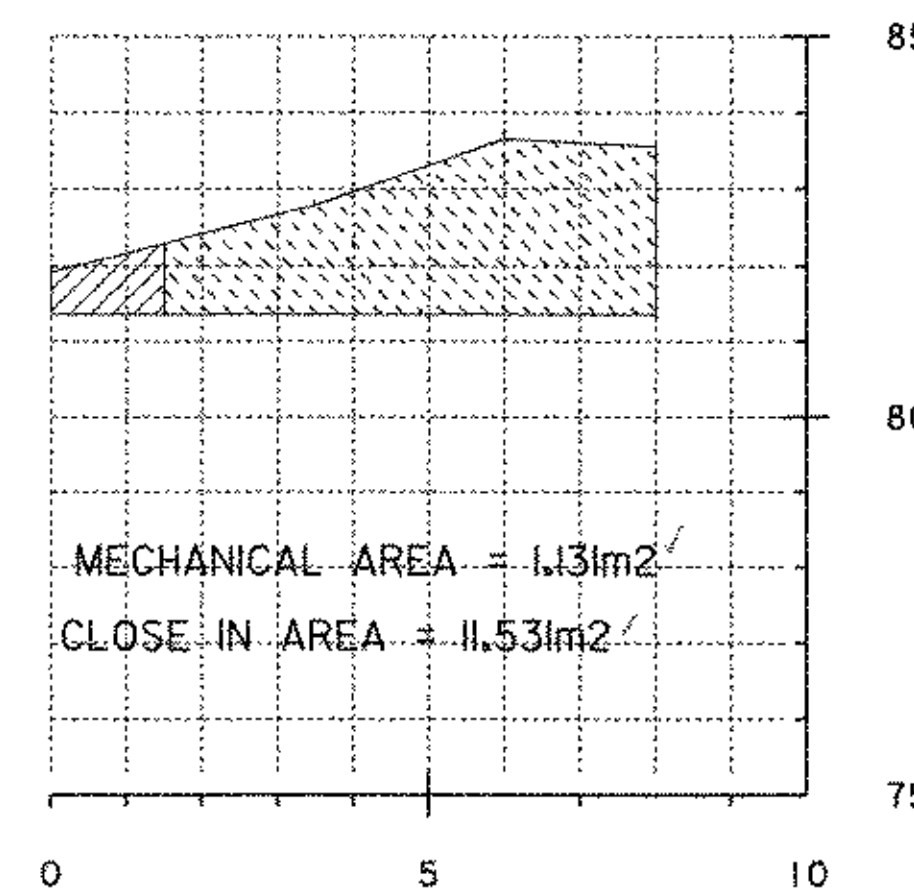



MIDDLE OF WINGWALL 2A FOOTING

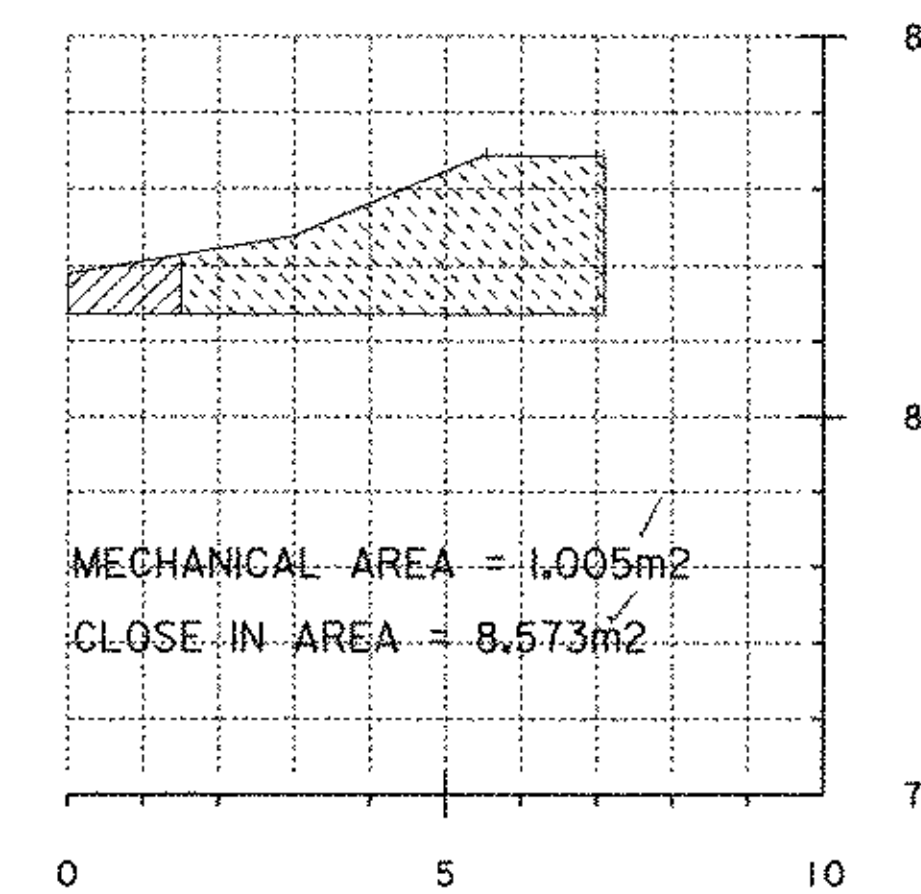


BACK OF WINGWALL 2A FOOTING

Close in areas


LEGEND

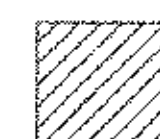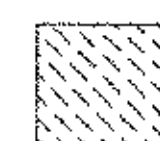-  = MECHANICAL REMOVAL ZONE
-  = CLOSE IN REMOVAL ZONE


ROUTE 9 BRIDGE SOUTH ABUTMENT
PHASE TWO LEDGE SECTIONS

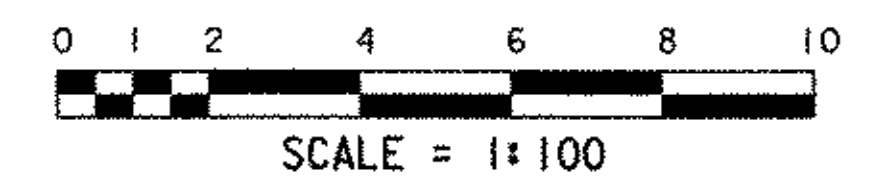


PROJECT: BRATTLEBORO	PROJECT NO.: NH 010-2(2)
PLOT DATE: 25-MAR-2005	
LEDGE SECTIONS 157+5	

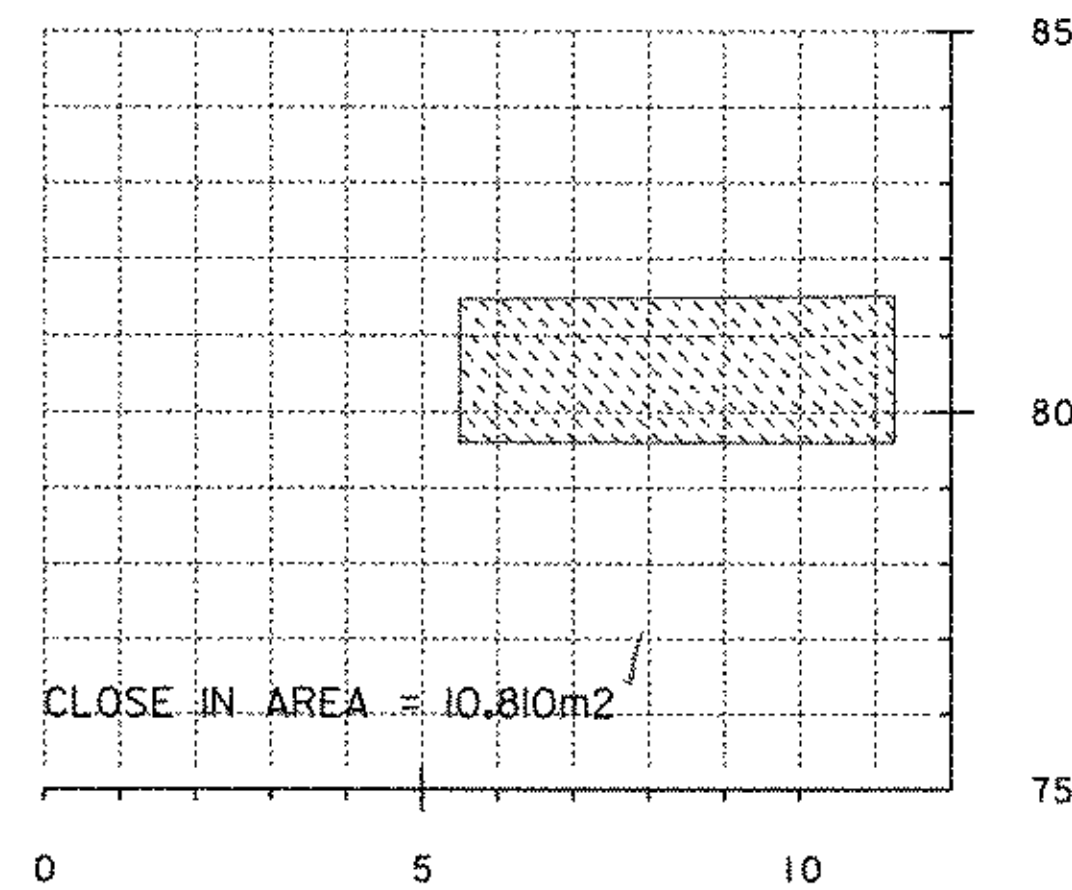

FRONT OF WINGWALL 4A FOOTING

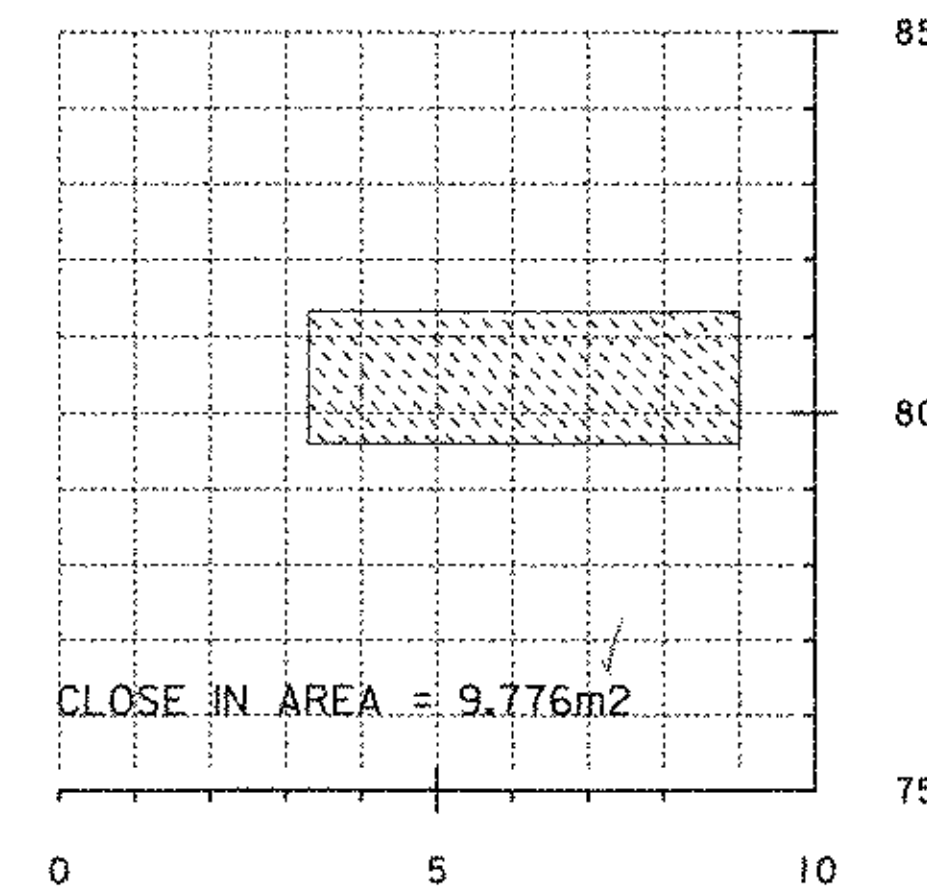

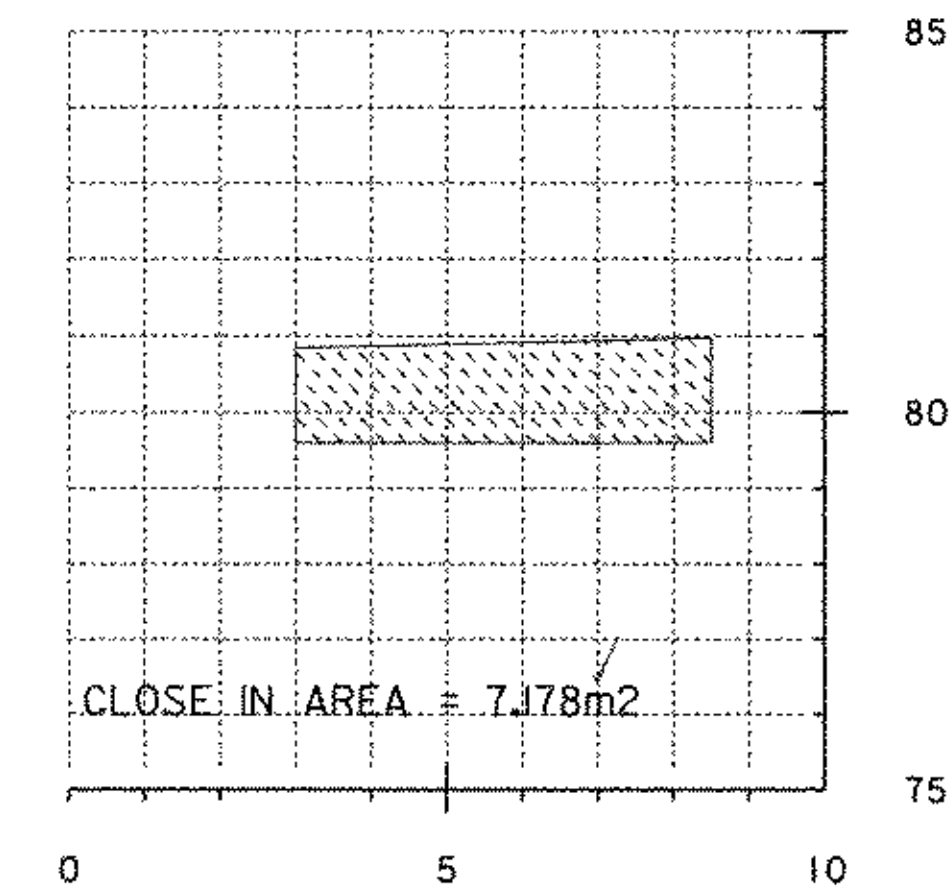

MIDDLE OF WINGWALL 4A FOOTING



BACK OF WINGWALL 4A FOOTING

*CLB
03/25/05*

LEGEND

-  = MECHANICAL REMOVAL ZONE
-  = CLOSE IN REMOVAL ZONE

ROUTE 9 BRIDGE NORTH ABUTMENT
PHASE TWO LEDGE SECTIONS



PROJECT: BRATTLEBORO	PROJECT NO.: NH 010-2(2)
PLOT DATE: 25-MAR-2005	
LEDGE SECTIONS <i>15BAS</i>	

TYPICAL ROADWAY SECTIONS

MATERIAL ITEM	THICKNESS	TOLERANCE
PAVEMENT (TOTAL DEPTH ALL LAYERS)	+/- 5	
SUBBASE	+/- 30	
SAND BORROW	+/- 30	

SEEDING FORMULA URBAN AREAS

% MASS	kg/ha	NAME	PUR %	GERM %
42.5	38.0	CREeping RED FESCUE	98	85
10.0	9.0	PERENNIAL RYE GRASS	95	90
42.5	38.0	KENTUCKY BLUE GRASS	85	85
5.0	5.0	ANNUAL RYE GRASS	95	85
100.0	90.0			

GENERAL NOTES

SEED MIXTURE: SHALL NOT HAVE A WEED CONTENT EXCEEDING 0.40% BY MASS AND SHALL BE FREE OF ALL NOXIOUS SEED.

SEED: TO BE APPLIED PER SEEDING FORMULAS OR AS DIRECTED BY THE ENGINEER.

FERTILIZER: FORMULA 10-20-10, TO BE USED WITH SEED, APPLIED AT THE RATE OF 560 kg/ha. (HYDRO SEEDERS MAY USE 19-19-19 FORMULA).

AGRICULTURAL LIMESTONE: TO BE APPLIED AT THE RATE OF 4500 kg/ha, OR AS DIRECTED BY THE ENGINEER.

HAY MULCH: TO BE PLACED ON EARTH SLOPES AT THE RATE OF 4500 kg/ha, OR AS DIRECTED BY THE ENGINEER.

TOPSOIL: TO BE USED WITH SEED AS INDICATED ON THE PLANS, OR AS DIRECTED BY THE ENGINEER.

MARKER POSTS: TO BE PLACED AS INDICATED OR AS DIRECTED BY THE ENGINEER.

SLOPE ROUNDING: ALL CUT SLOPES TO BE ROUNDED IN ACCORDANCE WITH STD SHEET B-5M. SLOPE LINES SHOWN ON THE PLANS AND CROSS SECTIONS DO NOT SHOW THE SLOPE ROUNDING.


PAY LIMITS OF SAND BORROW: WHEN USED IN CONJUNCTION WITH UNDERDRAIN - SEE STANDARD SHEET D-2M.

TACK COAT: EMULSIFIED ASPHALT IS TO BE APPLIED AT THE RATE OF 0.07 L/m² BETWEEN SUCCESSIVE COURSES OF PAVEMENT AS DIRECTED BY THE ENGINEER.

40 BITUMINOUS CONCRETE PAVEMENT (TYPE III)
50 BITUMINOUS CONCRETE PAVEMENT (TYPE II)
450 SUBBASE OF DENSE GRADED CRUSHED STONE (MINIMUM)

THESE PLANS ARE TO BE USED TOGETHER WITH THE NH 010-2(2) PLANS DATED 10/17/02. SEE THE NH 010-2(2) PLANS FOR ADDITIONAL DETAILS INCLUDING BUT NOT LIMITED TO:
• GENERAL CONSTRUCTION NOTES
• ALIGNMENT DATA
• CONSTRUCTION OF ALL PERMANENT DRAINAGE STRUCTURES, CULVERTS AND UNDERDRAINS.
• UNDERDRAIN DETAILS
• CATCH BASIN DETAILS
• ULTIMATE ROUTE 9 TYPICAL SECTION
• DITCH DETAILS


SEE CROSS SECTIONS FOR GRADES AND ELEVATIONS

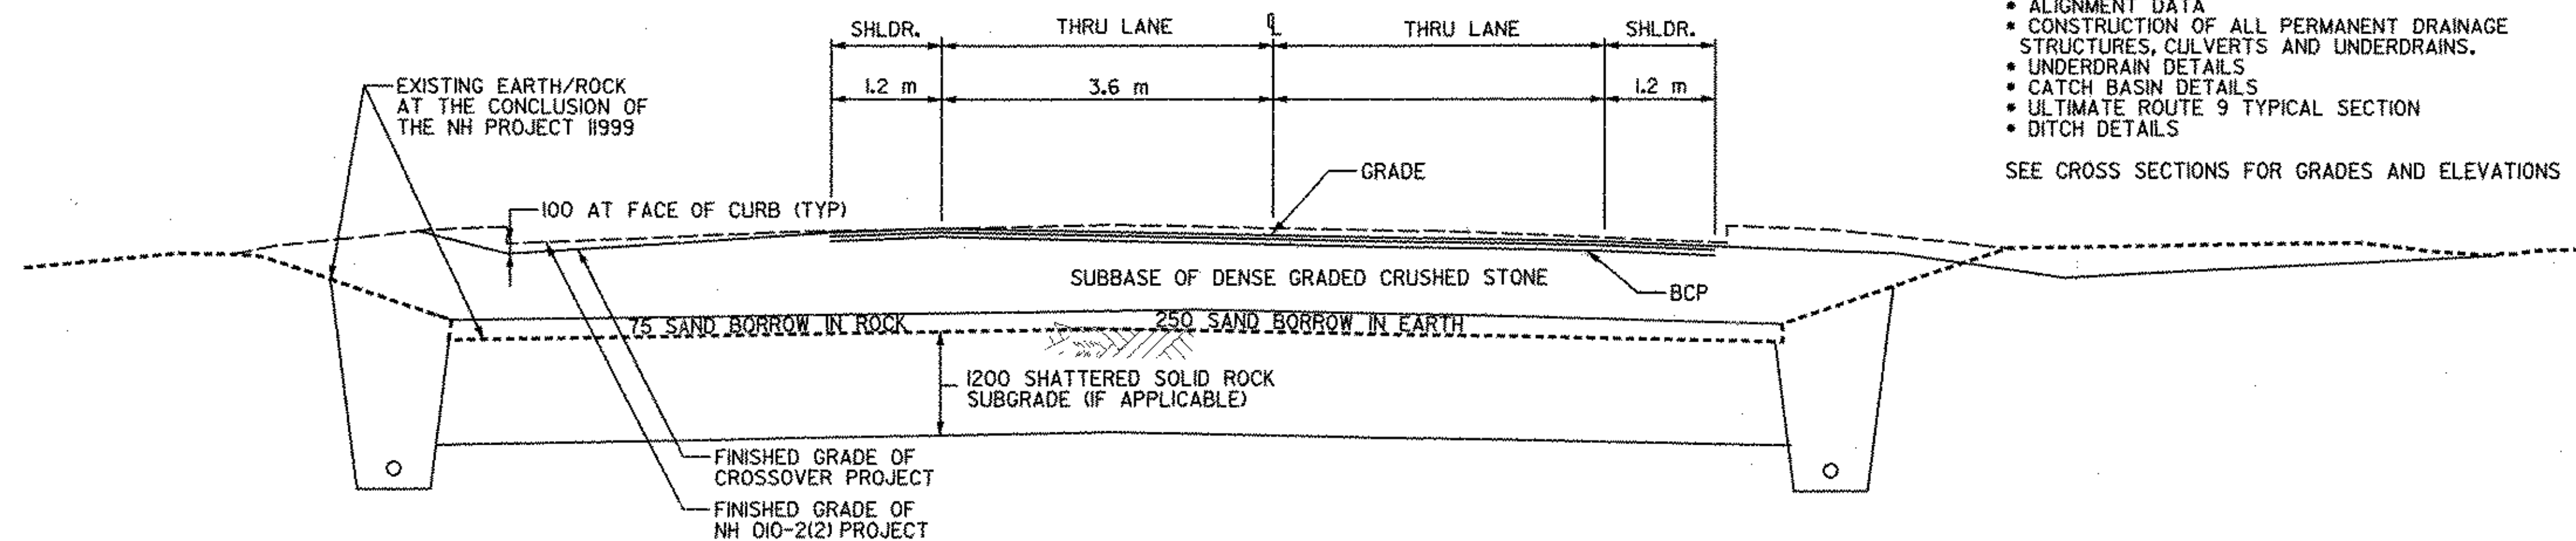

APPROACH TO BRIDGE SECTION STA 1+330 - STA 1+360


(NOT TO SCALE)

Ⓐ AS A MINIMUM, IN CROSSOVER AREAS BEYOND THE LIMIT OF THE EXISTING ROADWAY, THE CONTRACTOR WILL PROVIDE:
40 BITUMINOUS CONCRETE PAVEMENT
60 BITUMINOUS CONCRETE PAVEMENT
450 SUBBASE OF DENSE GRADED CRUSHED STONE

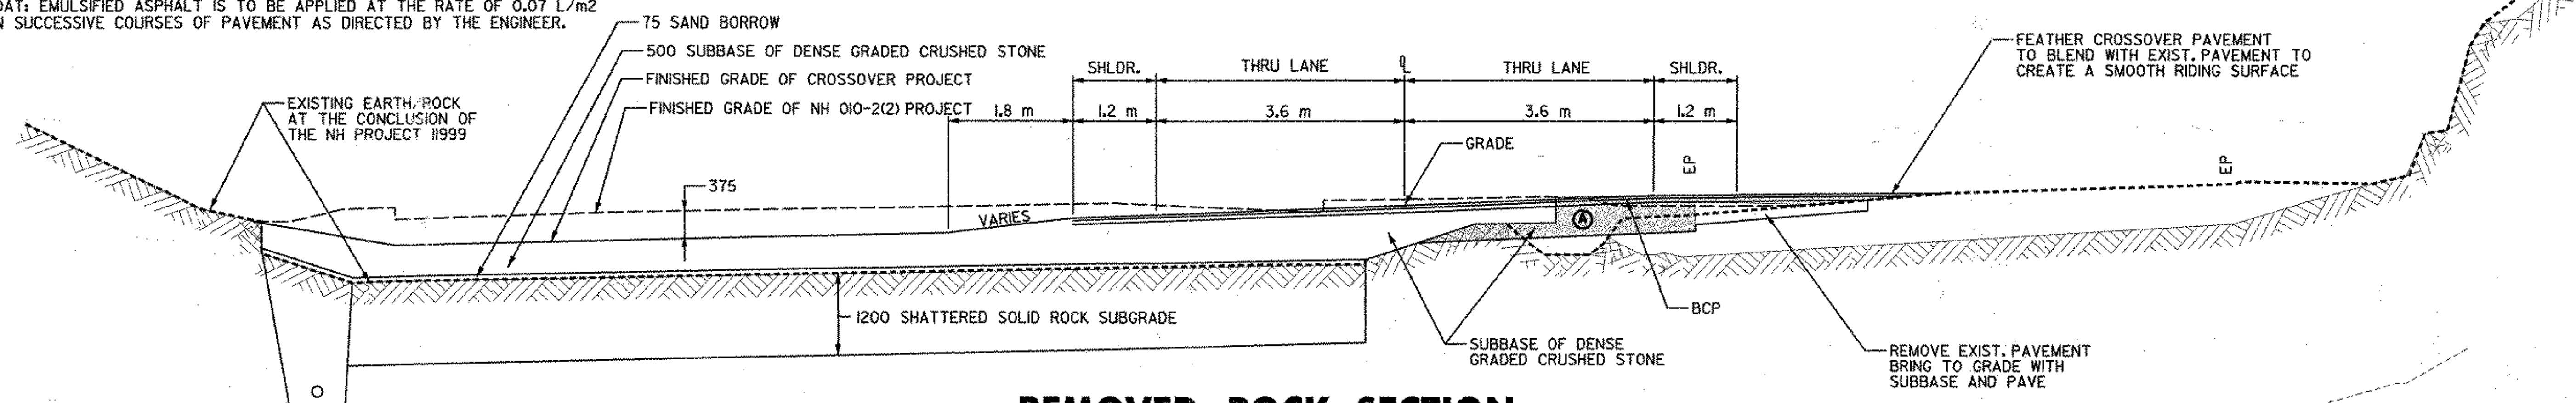

REMOVED ROCK SECTION STA 1+290 - STA 1+330

(NOT TO SCALE)

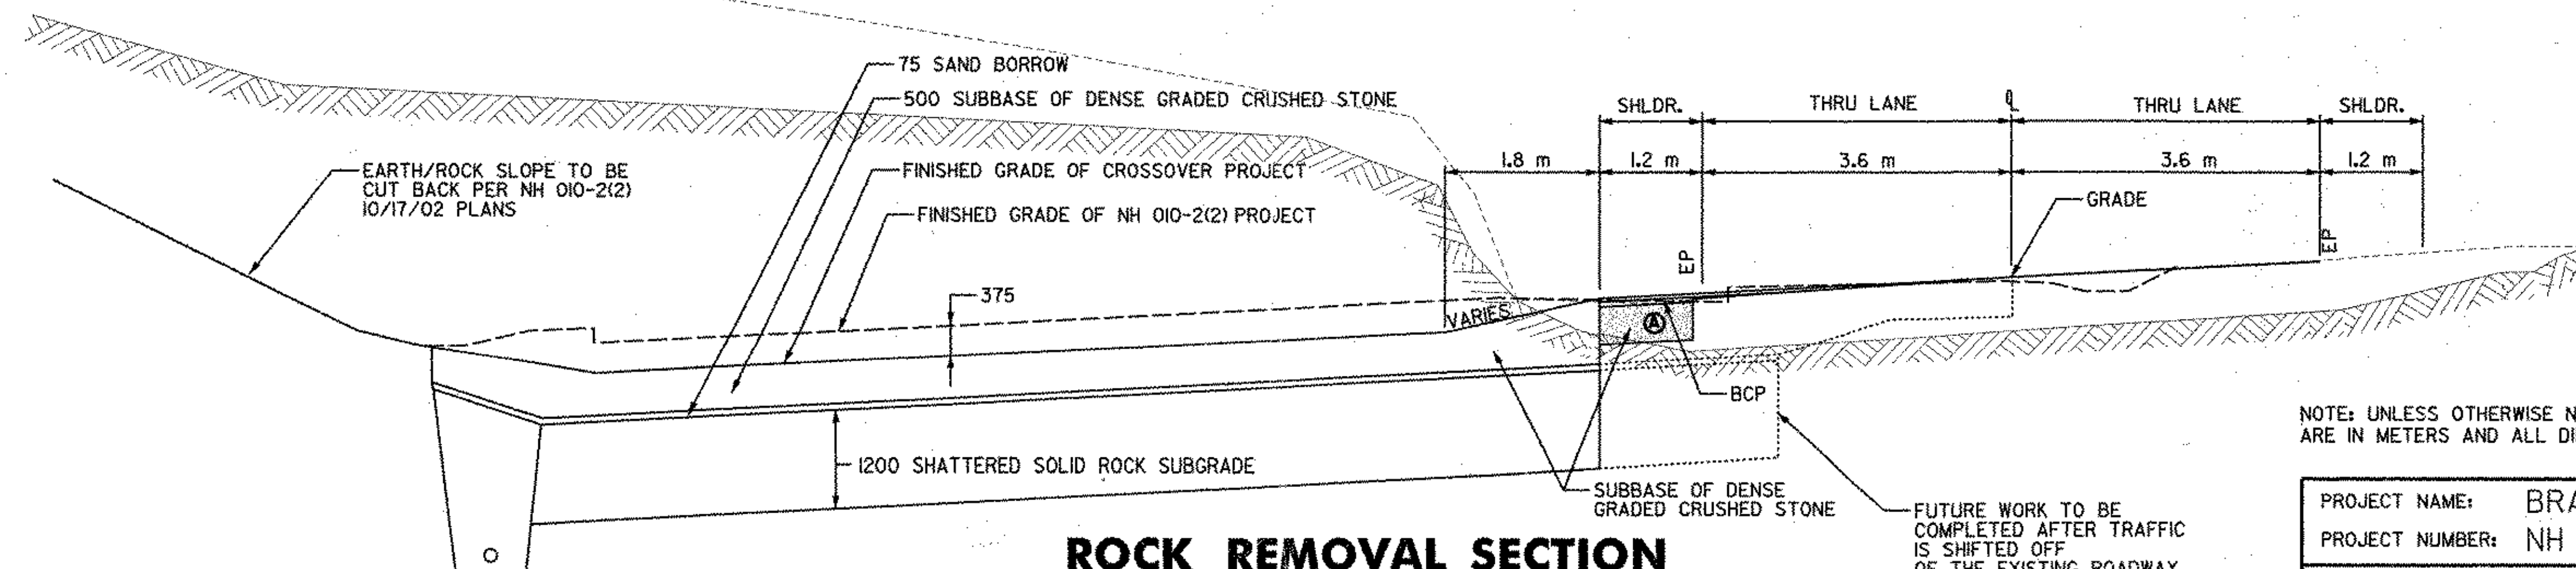


ROCK REMOVAL SECTION STA 1+240 - STA 1+290

(NOT TO SCALE)



NOTE: UNLESS OTHERWISE NOTED IN THESE PLANS, ALL ELEVATIONS ARE IN METERS AND ALL DIMENSIONS ARE IN MILLIMETERS

PROJECT NAME:	BRATTLEBORO
PROJECT NUMBER:	NH 010-2(2)
FILE NAME:	...zb270typ.dgn
PROJECT LEADER:	WRH
DESIGNED BY:	PTS
CLD REF NO.	02-0439
PLOT DATE:	03/28/2003
DRAWN BY:	PTS
CHECKED BY:	JAW
SHEET	1 OF 13

188 Rock

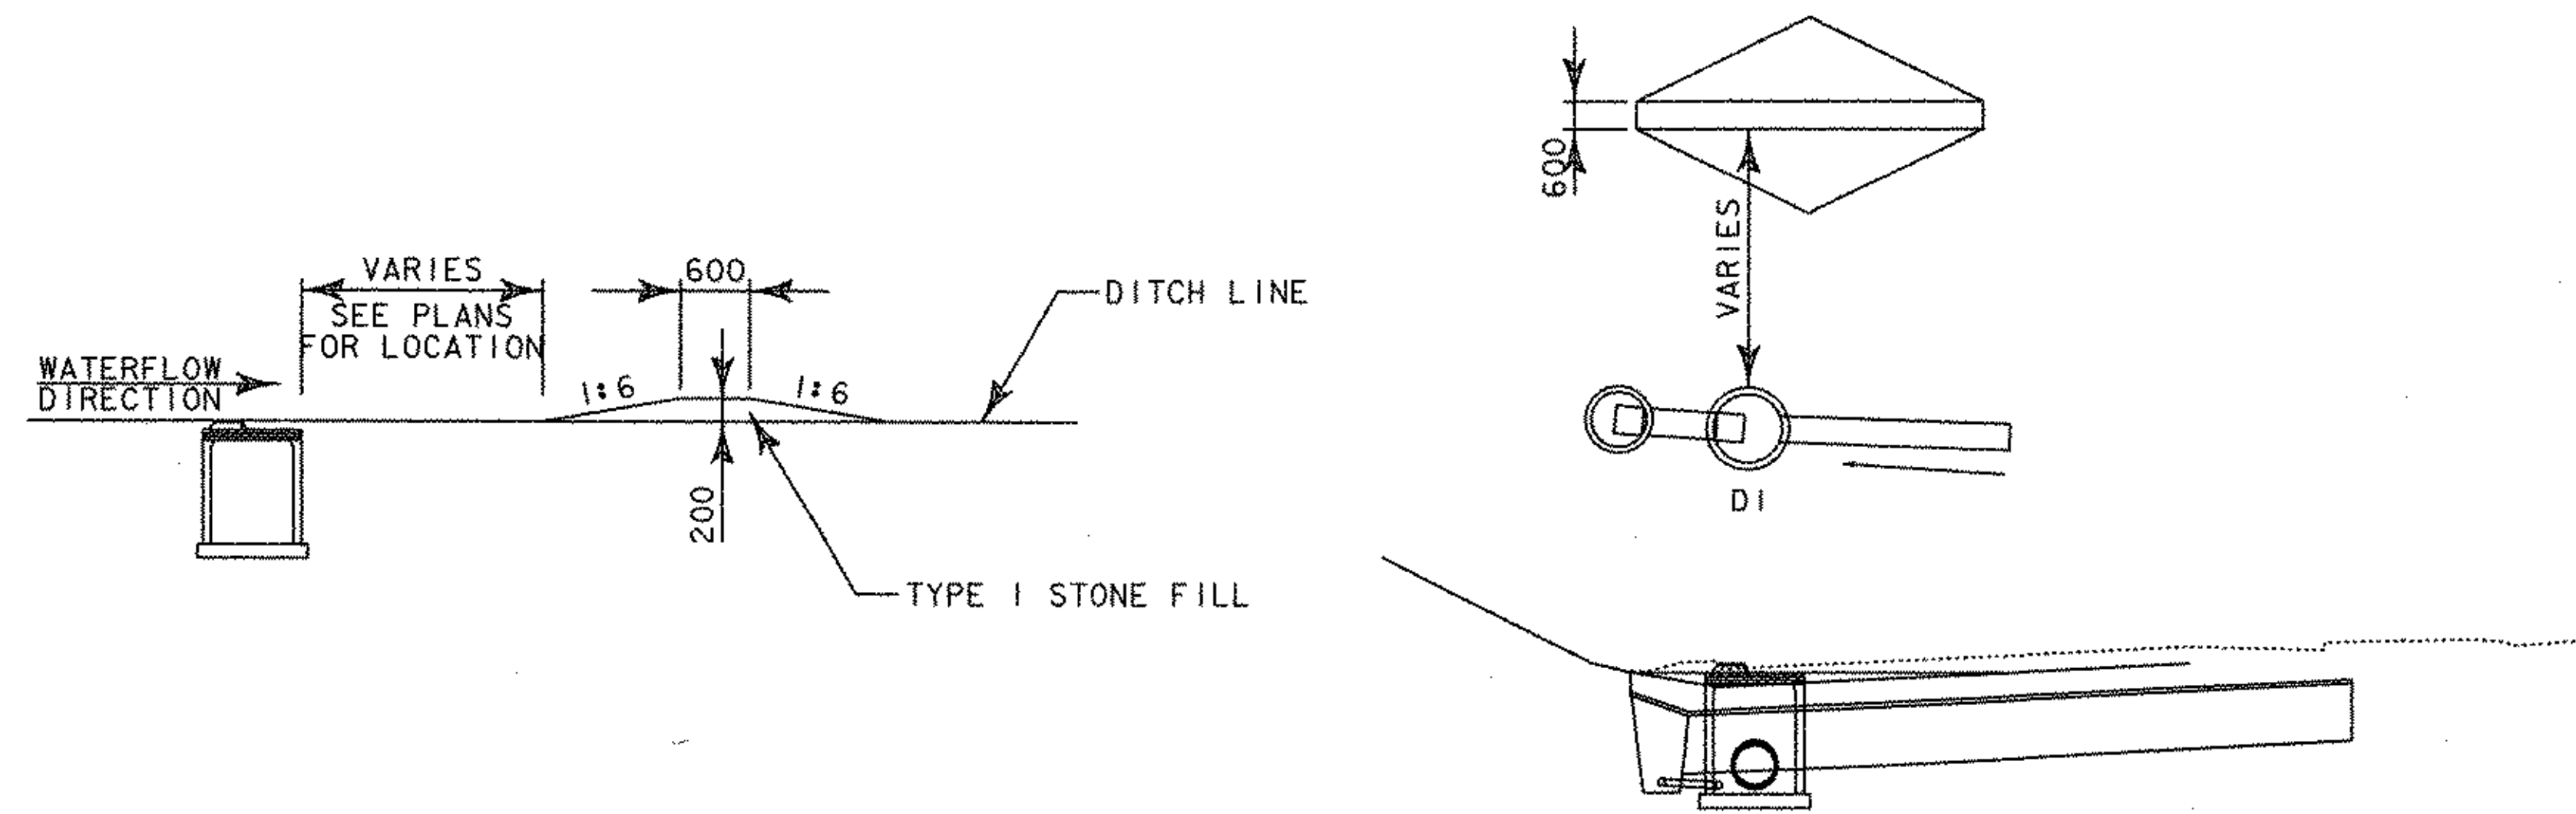

TYPICAL DITCH CHECK DAM DETAIL
(NOT TO SCALE)

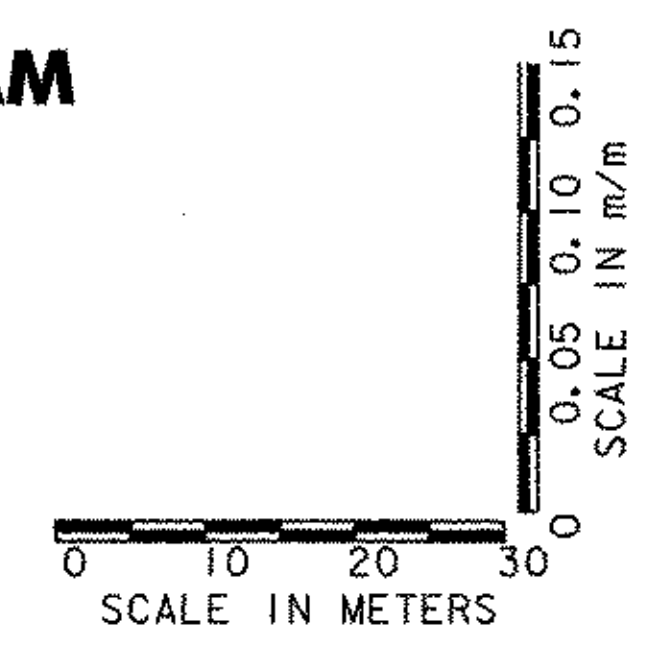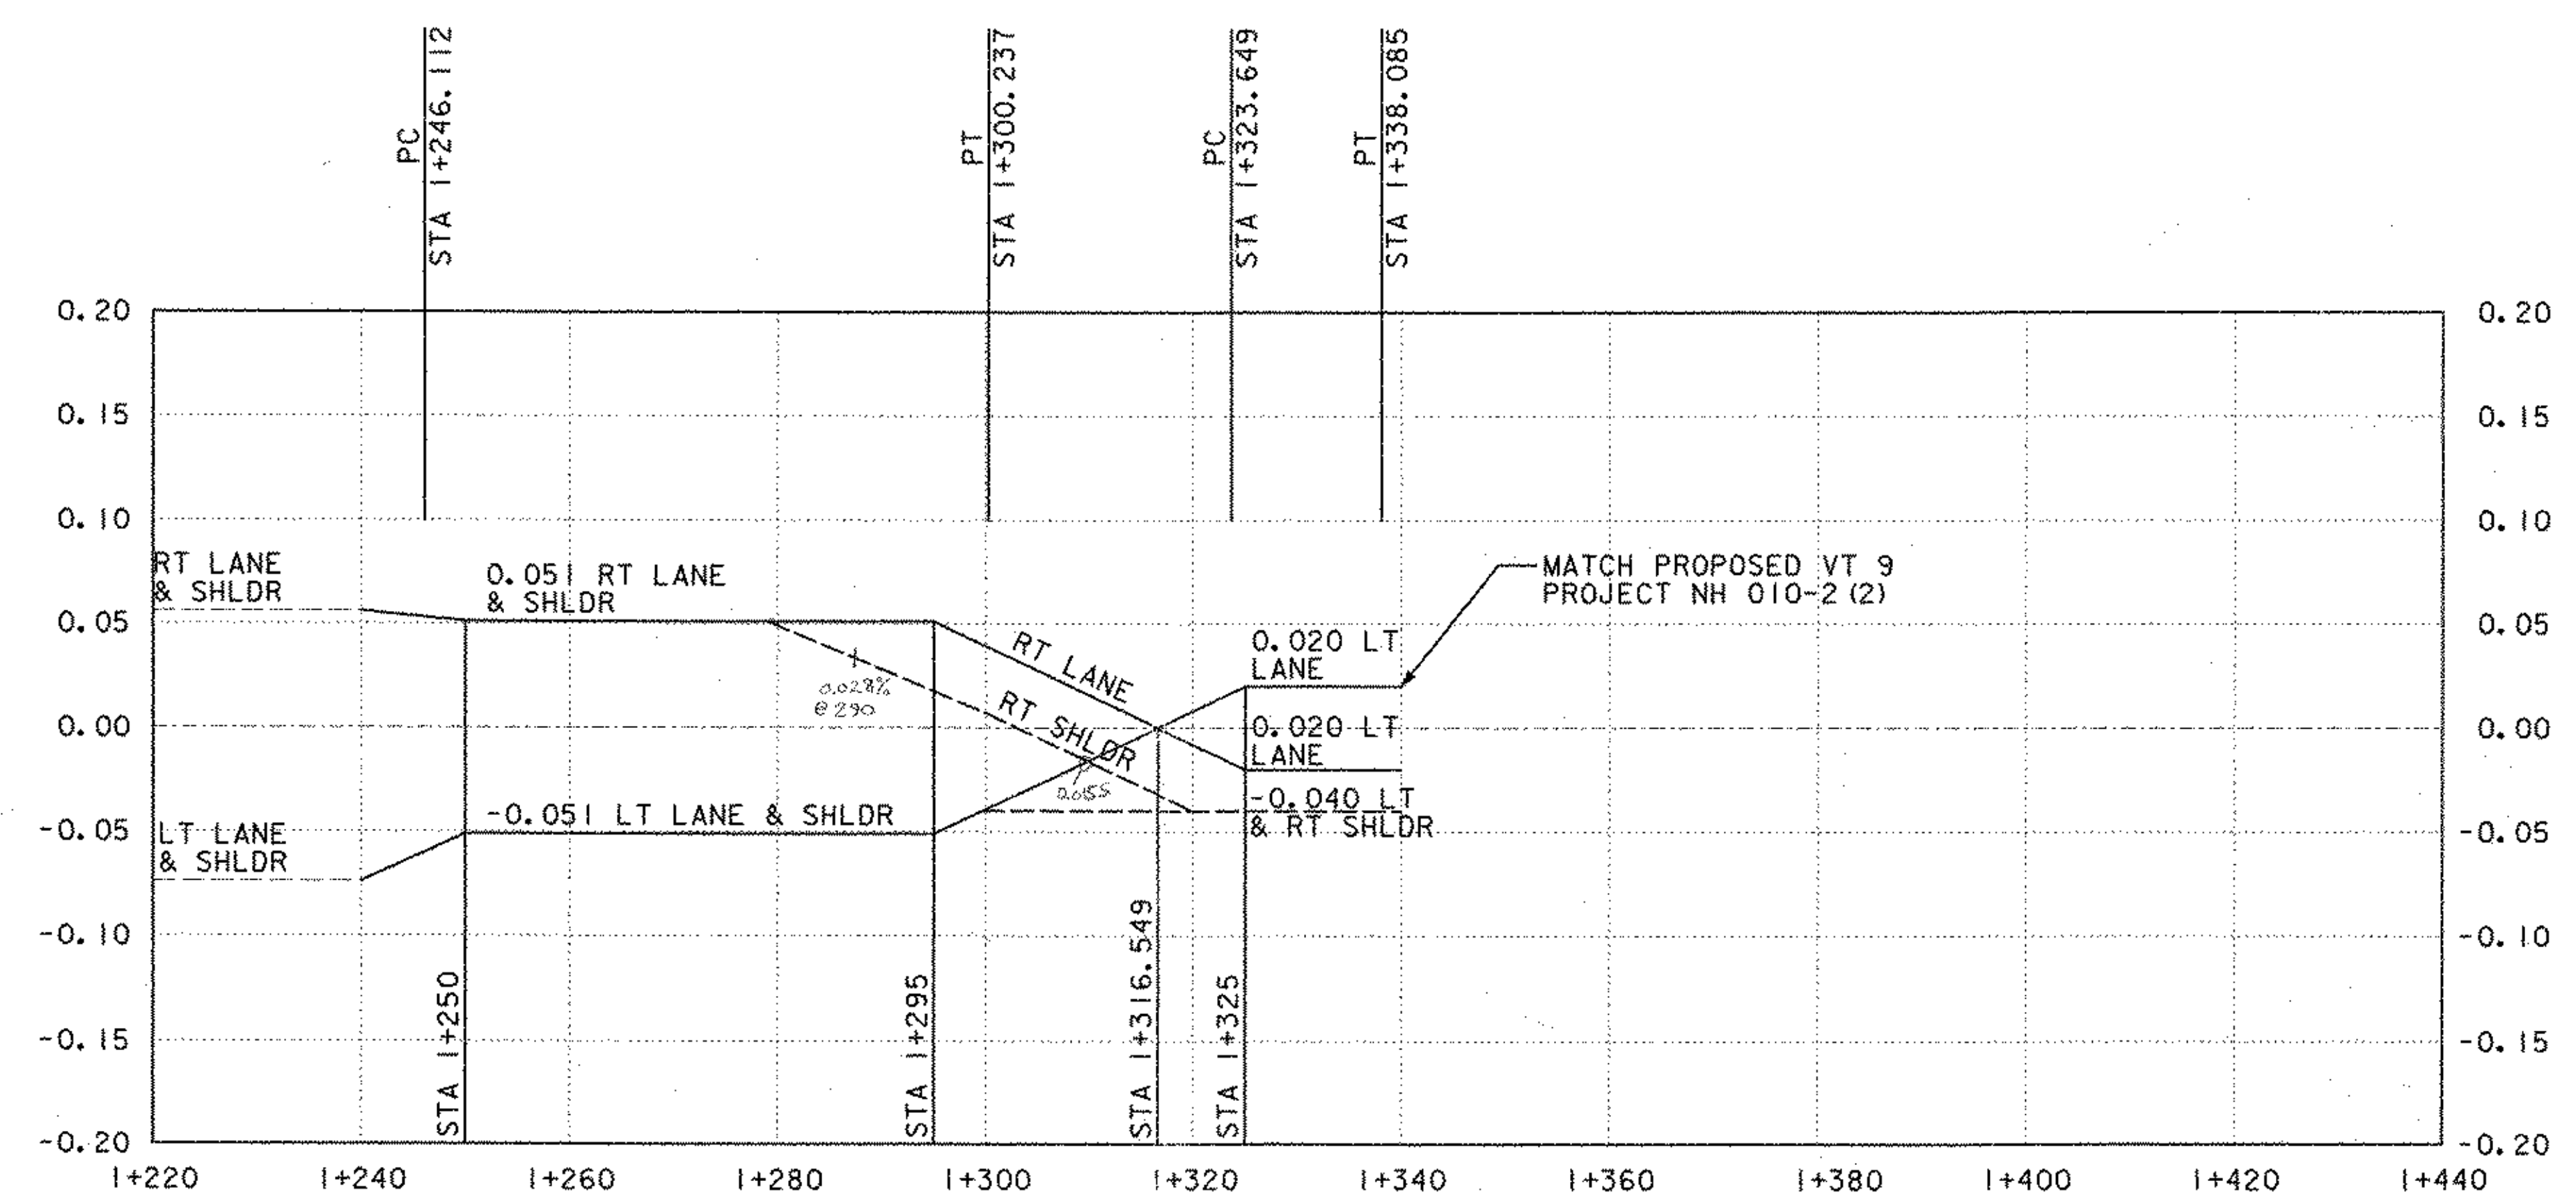

MISCELLANEOUS DETAILS

PROJECT NAME: BRATTLEBORO	PLOT DATE: 03/28/2003
PROJECT NUMBER: NH 010-2(2)	DRAWN BY: PTS
FILE NAME: ...zb270frm.dgn	CHECKED BY: JAW
PROJECT LEADER: WRH	SHEET 2 OF 13
DESIGNED BY: PTS	
CLD REF NO. 02-0439	

161 Percha

DRAINAGE DETAIL SHEET



STATION km + m	STATION km + m	POS.	NOTE NO.	INLET/OUTLET TYPE		DITCH		PIPE ARCH			PIPE					ALLOWABLE OPTIONS							PIPE ELBOW no. deg.	ES ea	P R C B size	P R C M size	DEPTH DI mm	CONC CLASS B	REINF STEEL kg	DI GRATE type	CHAN ELEV ea	CRM m³	TRENCH EXCAVATION		CHAN EXC ROCK m³	CHAN EXC ROCK m³	STRUCT EXCAV m³	GRAN BK FILL STRUCT m³	GRAN BORR m³	EROS MATT m²	STONE FILL		MARKER POSTS		RELAY PIPE m	REMARKS
				INLET	OUTLET	IN	OUT	SPAN mm	RISE mm	L m	D mm	L m	PCCSP mm	CAAP mm	RCP CL mm	CSP mm	CPEP SL mm	PCCSP PI mm	EARTH m³	ROCK m³	m³	m³											m³	m³							m³	m²	m²	LT ea		
30+265	30+285	LT	P11	CAP	1.5m CB							900	18.5	2.01	1.52																										CAP INLET FOR FUTURE USE					
30+290	30+323	RT	P27	CAP	1.5m MH							750	32.8	2.01	1.52																									CAP INLET FOR FUTURE USE						
30+285	30+326	LT	P12	1.5m CB	2.1m CB							900	39.3			III		X																												
30+323	30+328	RT	P26	1.5m MH	CAP							750	5.4			III		X																							CAP OUTLET FOR FUTURE USE					
30+326		LT	P13	1.2m CB	2.1m CB							450	1.5	1.63	1.52	III		X																												
30+326	30+326	LT/RT	P14	2.1m CB	1.8m CB							900	9.2			III		X																												
30+326		RT	P15	1.8m CB	1.8m CB							900	4.8			III		X																												
30+337	5+016	LT	P16	1.2m CB	1.2m CB							450	8.8	1.63	1.52	III		X							23.97																					
30+326	30+337	LT	P17	1.2m CB	2.1m CB							450	9.0	1.63	1.52	III		X																												
30+326	30+337	RT	P18	1.2m CB	1.8m CB							450	9.2	1.63	1.52	III		X																												
30+326	A 203+57	RT	P30	1.8m CB	SF							900	31.5			III		X																							THE INTENT IS TO TEMPORARILY USE THE PRCCB INTENDED FOR STA 30+326 RT AT THIS LOCATION					
				4	1.2m CB							450	28.5	1.63	1.52	III		X																												
				1	1.5m CB							750	32.8	2.01	1.52																															
				2	1.8m CB							750	5.4			III		X																												
				1	2.1m CB							900	18.5	2.01	1.52																															
				1	1.5m MH							900	64.8			III		X								24.0	585.3																			

PROJECT NAME: **BRATTLEBORO**
 PROJECT NUMBER: **NH 010-2(2)**
 FILE NAME: **zb270dds.xls**
 PROJECT LEADER: **W HUSBAND**
 DESIGNED BY: **P SHEDD**
 DRAINAGE DETAIL SHEET #1

PLOT DATE: **3/28/03**
 DRAWN BY: **P SHEDD**
 CHECKED BY: **J WARNER**
 SHEET **4** OF **13**

163 Rock

EARTHWORKS




																														SUMMARY AND BALANCES										
		TOTAL EXCAVATION EARTH AND ROCK		ROCK EXCAVATION		EMBANKMENT						TOTAL EXCAVATION EARTH AND ROCK		ROCK EXCAVATION		EMBANKMENT						TOTAL EXCAVATION EARTH AND ROCK		ROCK EXCAVATION		EMBANKMENT						STATION TO STATION		TOT EXC. EARTH & ROCK	ROCK EXCAV	EMBANK	EXCESSES		ACUMULATIVE EXCESSES	
STATION	DIST	AREA	VOLUME	AREA	VOLUME	AREA	VOLUME	AREA	VOLUME	STATION	DIST	AREA	VOLUME	AREA	VOLUME	AREA	VOLUME	AREA	VOLUME	STATION	DIST	AREA	VOLUME	AREA	VOLUME	AREA	VOLUME	AREA	VOLUME	km + m	km + m	m ³	m ³	m ³	CUT	FILL	CUT	FILL		
km + m	m	m ²	m ³	m ²	m ³	m ²	m ³	m ²	m ³	km + m	m	m ²	m ³	m ²	m ³	m ²	m ³	m ²	m ³	km + m	m	m ²	m ³	m ²	m ³	m ²	m ³	m ²	m ³	m ²	m ³	m ²	m ³	m ²	m ³	m ²	m ³			
Crossover																																								
1+240	20	0	2160	0	1130																																			
1+260	20	216	5090	113	2830																																			
1+280	10	293	1550	170	930																																			
1+290	10	17	90	16	80																																			
1+300	20	1	10	0	0																																			
1+320	20	0	20	0	0																																			
1+340	10	2	10	0	0																																			
1+350		0		0																																				
COLUMN TOTAL			6930		4970																																			

REMARKS	
EARTH AND ROCK EXCAVATION	8930
SOLID ROCK EXCAVATION	4970
EARTH EXCAVATION	3960
PLANIMETERED FILL	0
LESS FACTORED SOLID ROCK	0
LESS DISPLACEMENT OF ANY LARGE STRUCTURES	0
NET PLANIMETERED FILL	0
FACTOR	0
PLANIMETERED FILL INCLUDING FACTOR	0
MATERIALS AVAILABLE FOR FILLS	
EARTH EXCAVATION	3960
CHANNEL EXCAVATION	0
UNDERDRAIN EXCAVATION	260
STRUCTURE EXCAVATION	175
TOTAL MATERIAL AVAILABLE FOR FILL	4395
TOTAL FILL INCLUDING FACTOR	0
TOTAL MATERIAL FOR FILL	4395
BORROW	
EXCESS EXCAVATION (VTRANS CASE II CRITERIA)	10856

PROJECT NAME:	Brattleboro	PLOT DATE:	3/28/2003
PROJECT NUMBER:	NH 010-2(2)	DRAWN BY:	JAW
FILE NAME:	zb270earth.xls	CHECKED BY:	PTS
PROJECT LEADER:	WRH	SHEET	5 OF 13
DESIGNED BY:	JAW		
EARTHWORK SHEET #1			

164 ROCK

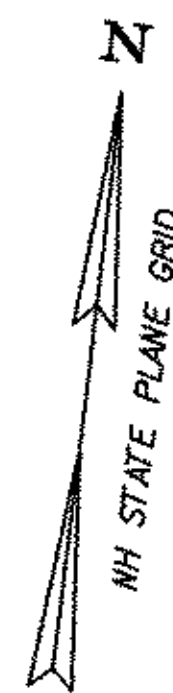

EXCAVATION OF SURFACES AND PAVEMENTS
STA 1+272 TO 1+352 RT

CONSTRUCT DRIVE
STA 30+330.0 RT (4.6 m WIDE GRAVEL)
STA 30+330.0 LT (3.0 m WIDE GRAVEL)

100 mm WHITE LINE
STA 1+240 TO 1+363 LT & RT

100 mm YELLOW LINE
STA 1+240 TO 1+363 LT & RT E

ENERGY ABSORPTION ATTENUATOR
STA 1+338 RT

TEMPORARY TRAFFIC BARRIER
STA 1+338 TO STA 1+350 RT 1/2
STA 1+336 TO STA 1+351 LT 1/5
STA 1+352 RT

TEMPORARY 100 mm WHITE LINE
STA 1+363 TO 1+428 LT & RT

TEMPORARY 100 mm YELLOW LINE
STA 1+363 TO 1+428 LT & RT


CURVE #1 DATA

$\Delta = 3^{\circ}00'39.3''$ LT
R = 100.000
T = 27.743 m
L = 54.124 m
E = 3.777 m
BANK = 0.051 m/m



CURVE #2 DATA

$\Delta = 8^{\circ}16'16.4''$ RT
R = 100.000 m
T = 7.231 m
L = 14.436 m
E = 0.261 m
BANK = 0.020 m/m

**STA 1+428.000
END TEMPORARY
CROSSOVER**

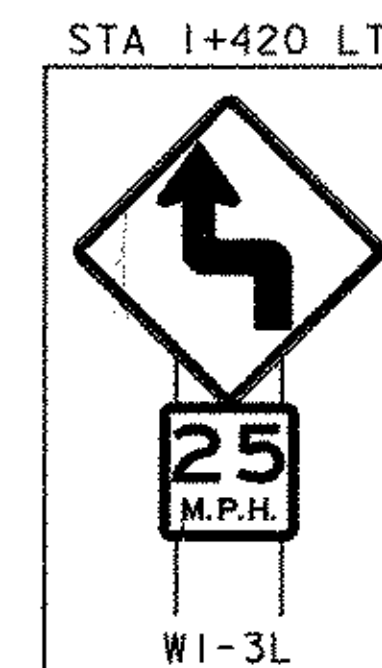

USE FOR ALIGNMENT ROUTE
30-35

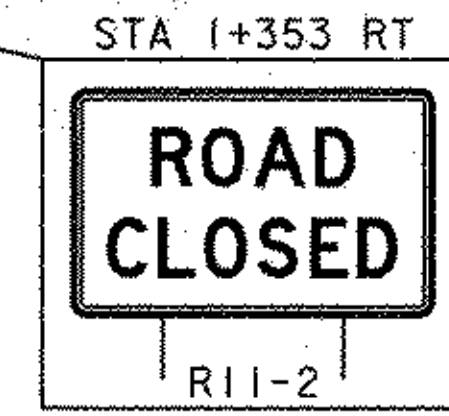
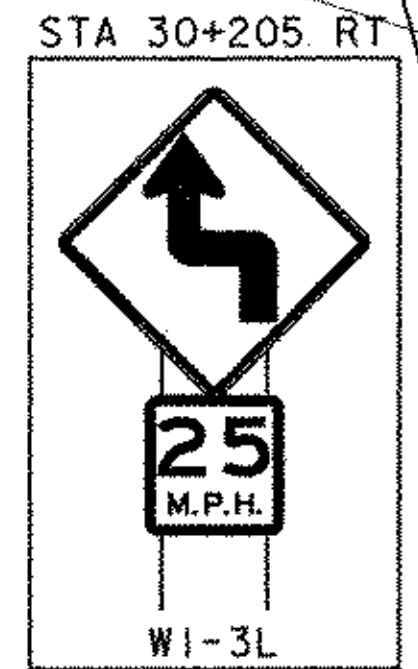


STA 1+383.042 NH 010-2 (2)
STA A203+83.042 NH PROJECT 11999
ANGLE = 177° 42' 34.8"


STA A203+50.000
END PROJECT
NH 010-2(2)
BEGIN NH PROJECT 11999

ROADWAY LAYOUT PLAN

PROJECT NAME: BRATTLEBORO	PROJECT NUMBER: NH 010-2(2)
FILE NAME: ... \zb270ts3.dgn	PLOT DATE: 03/31/2003
PROJECT LEADER: WRH	DRAWN BY: PTS
DESIGNED BY: PTS	CHECKED BY: JAW
CLD REF NO. 02-0439	SHEET 6 OF 13

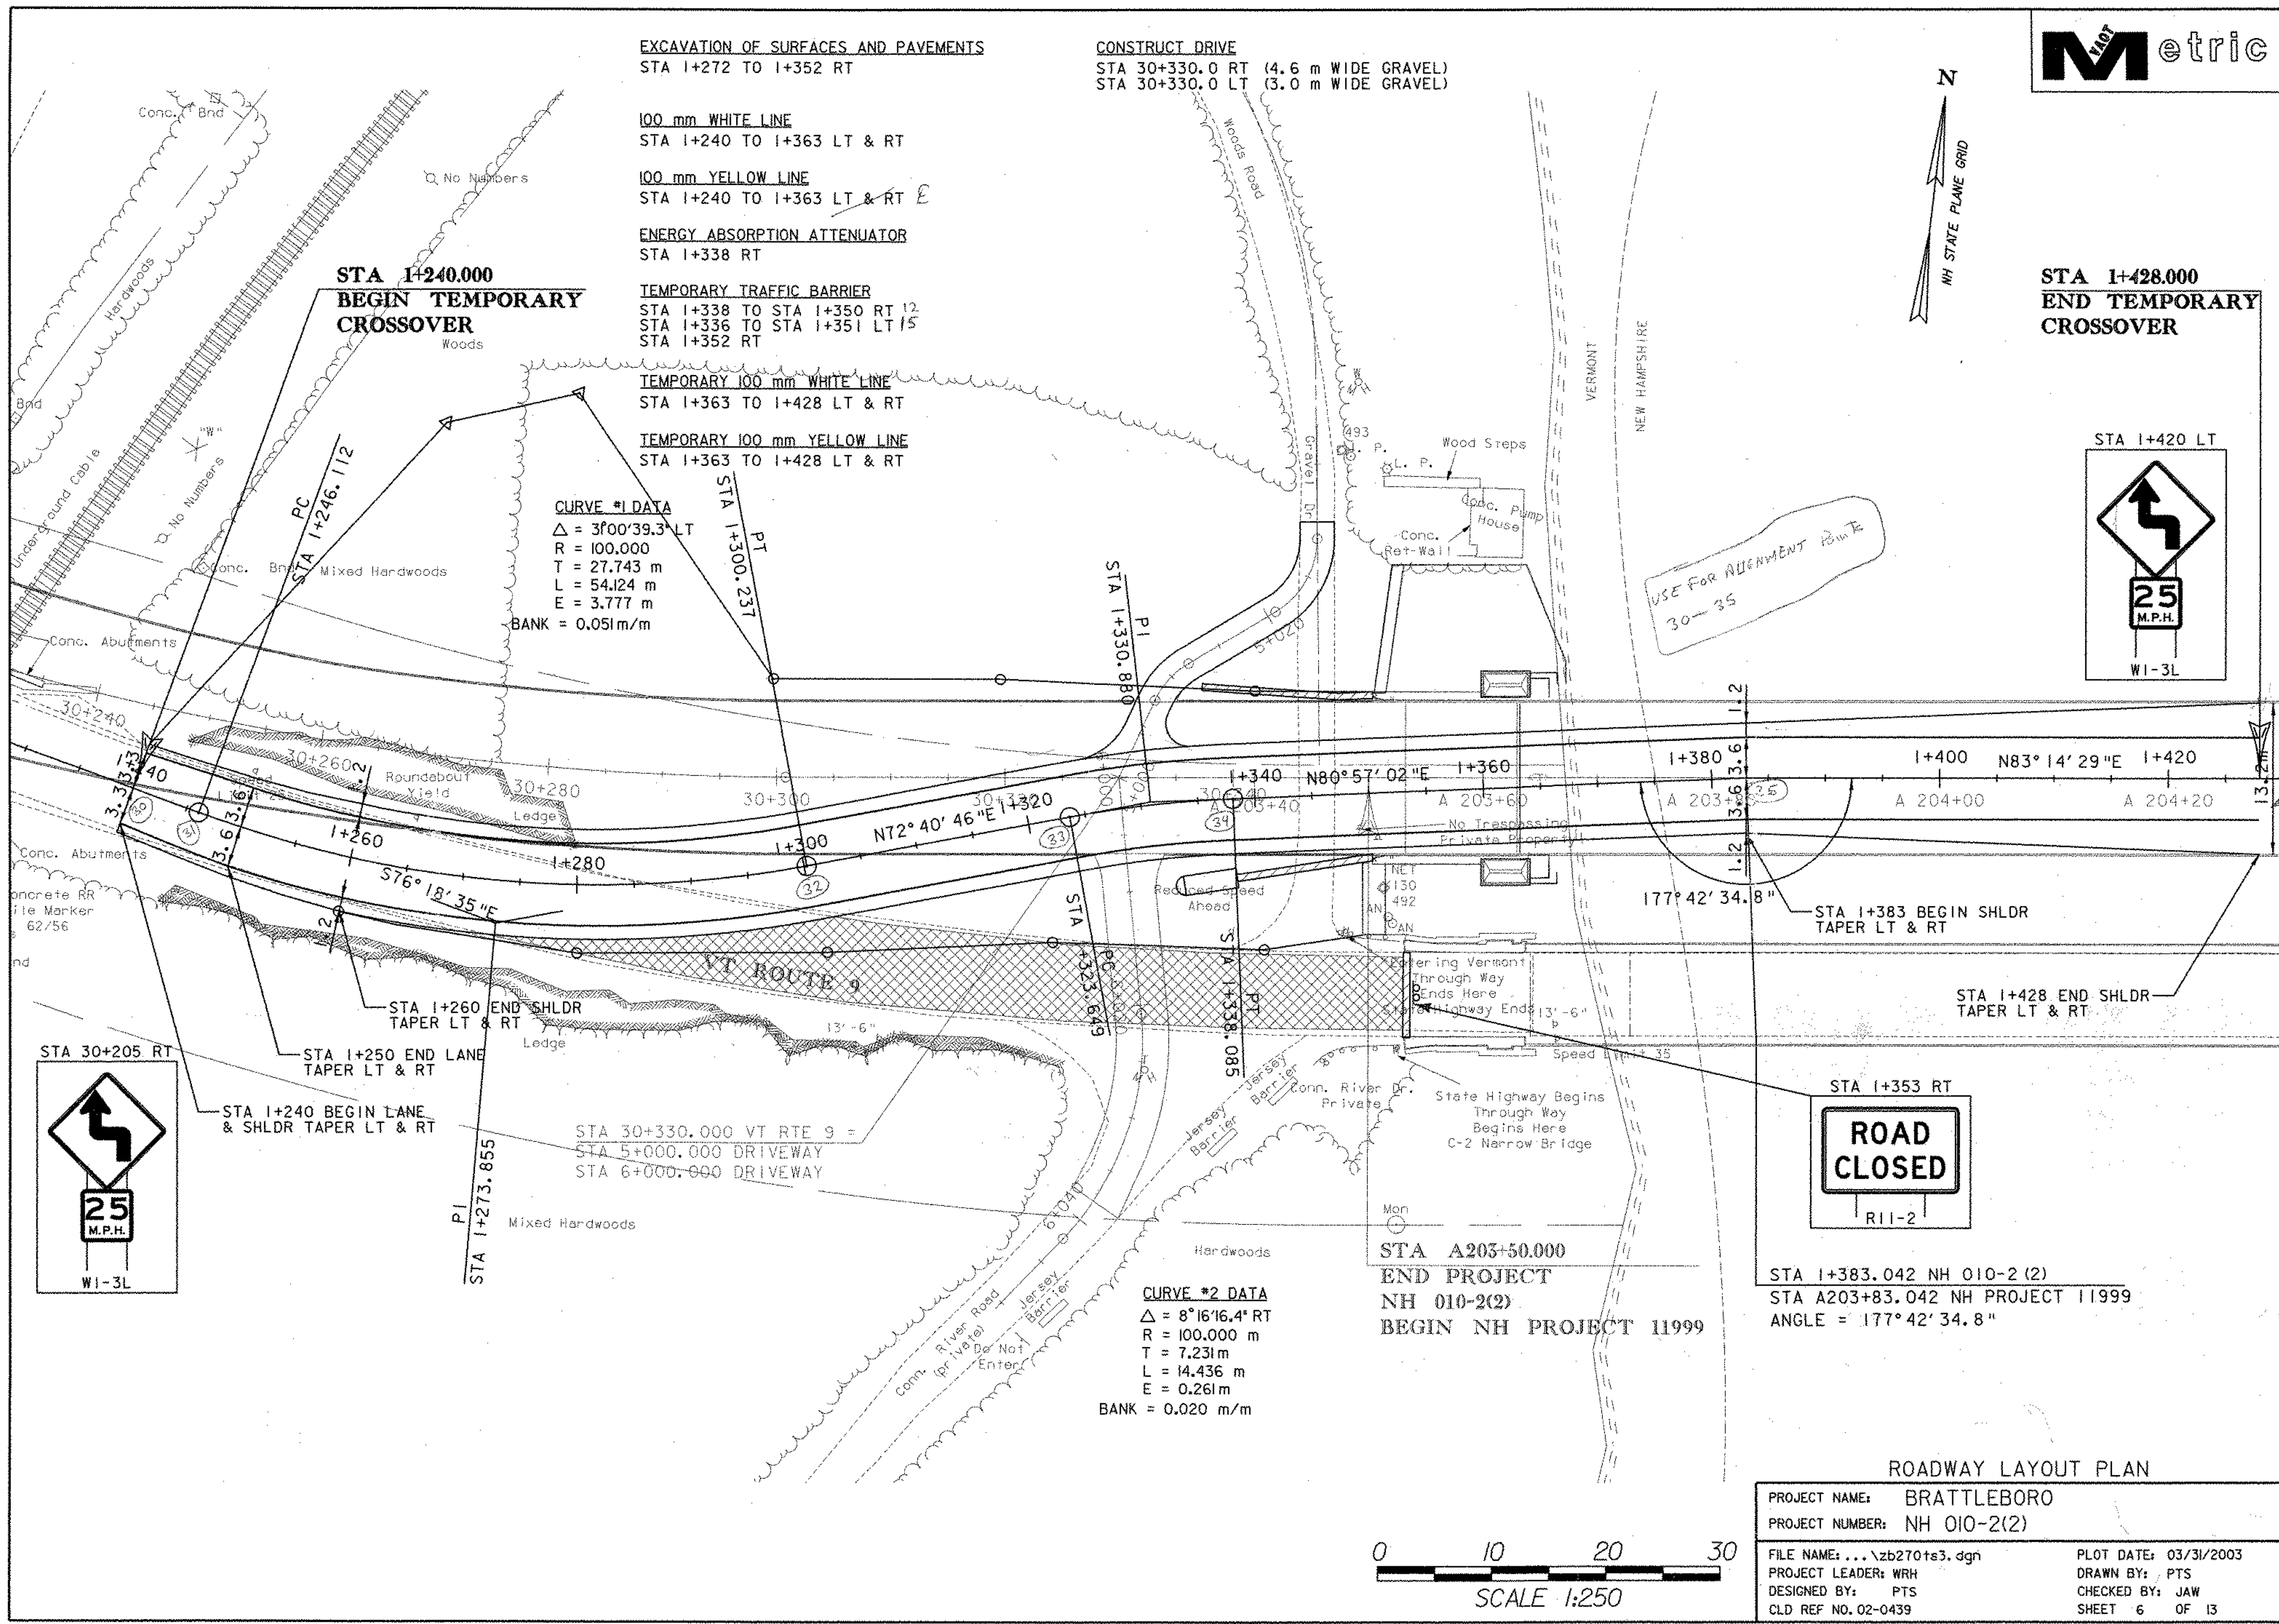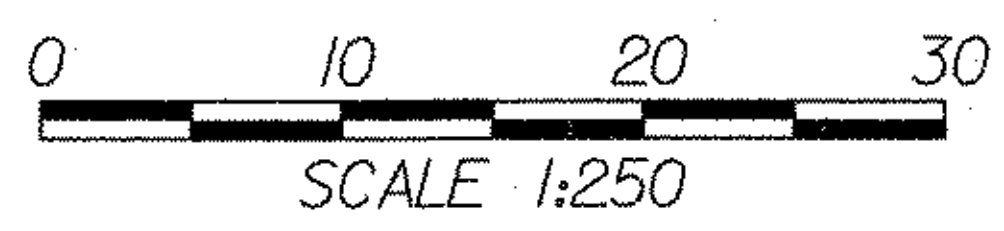





165 POK

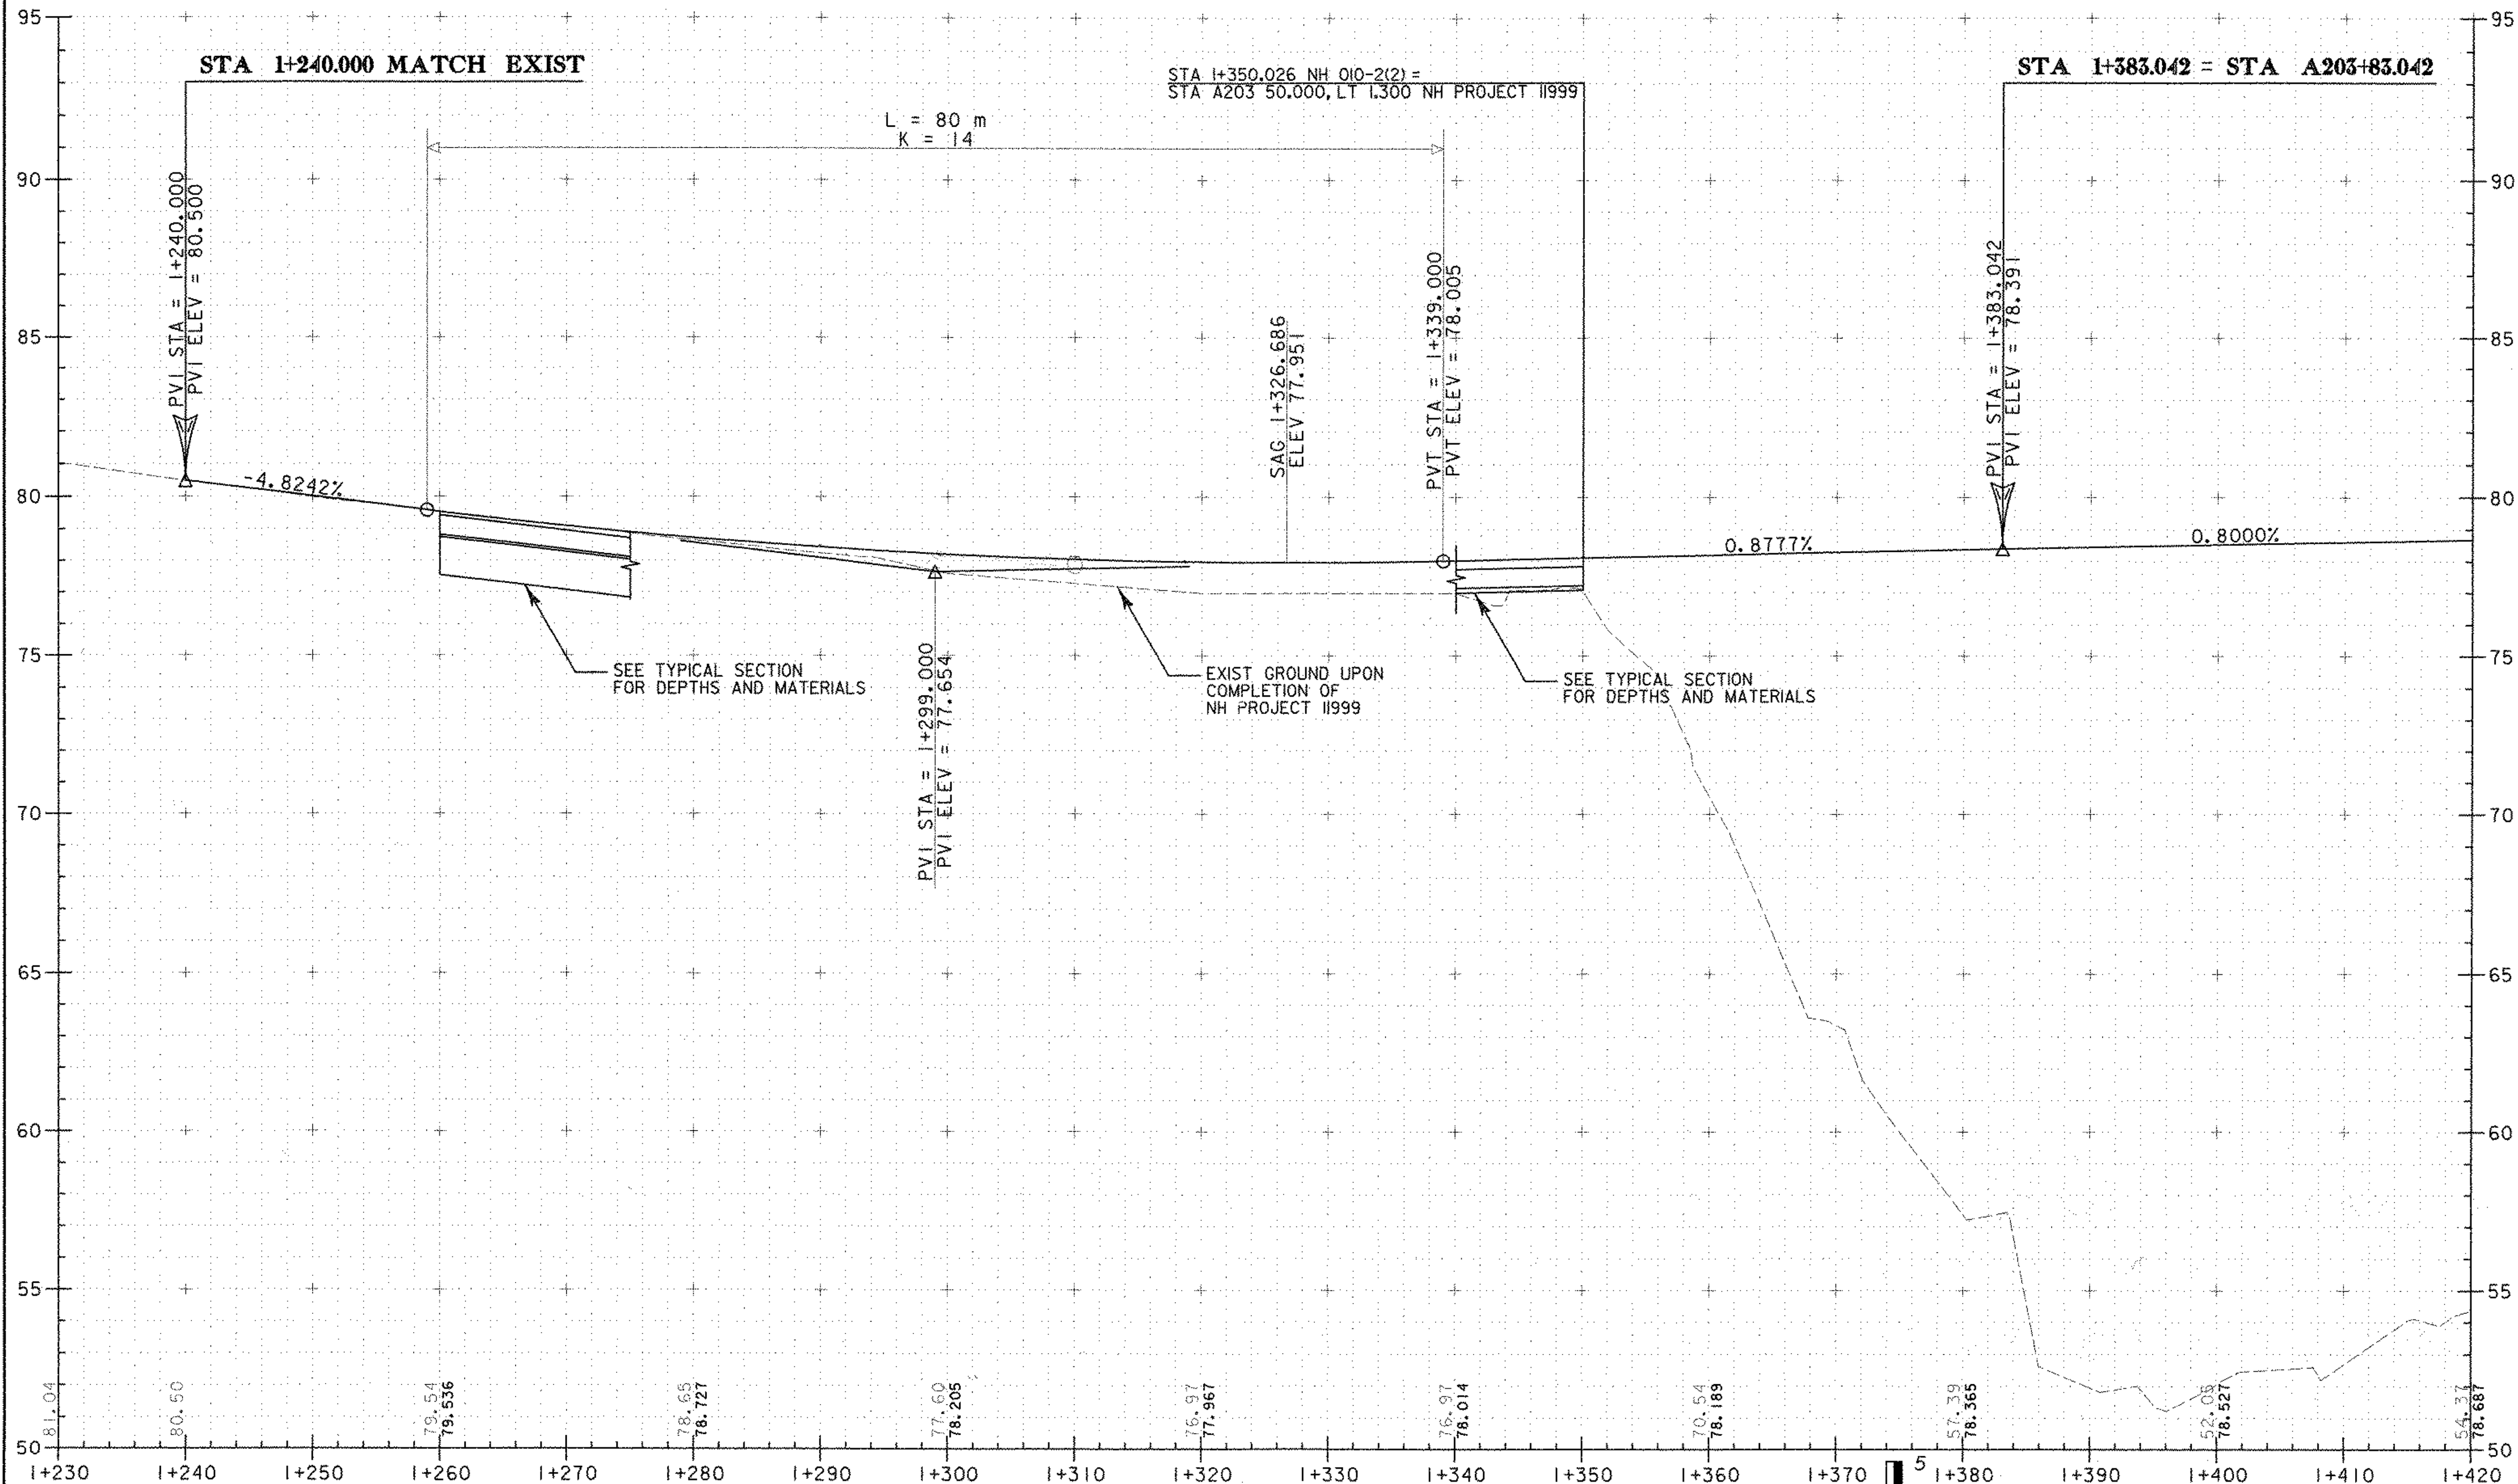


PROFILE - VT ROUTE 9

PROJECT NAME: BRATTLEBORO	PLOT DATE: 03/28/2003
PROJECT NUMBER: NH 010-2(2)	DRAWN BY: PTS
FILE NAME: ...zb270pro.dgn	CHECKED BY: JAW
PROJECT LEADER: WRH	SHEET 7 OF 13
DESIGNED BY: PTS	
CLD REF NO. 02-0439	

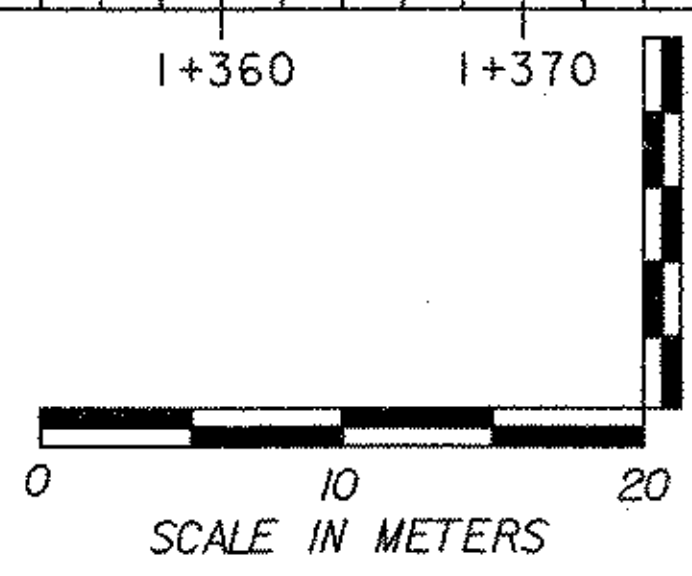

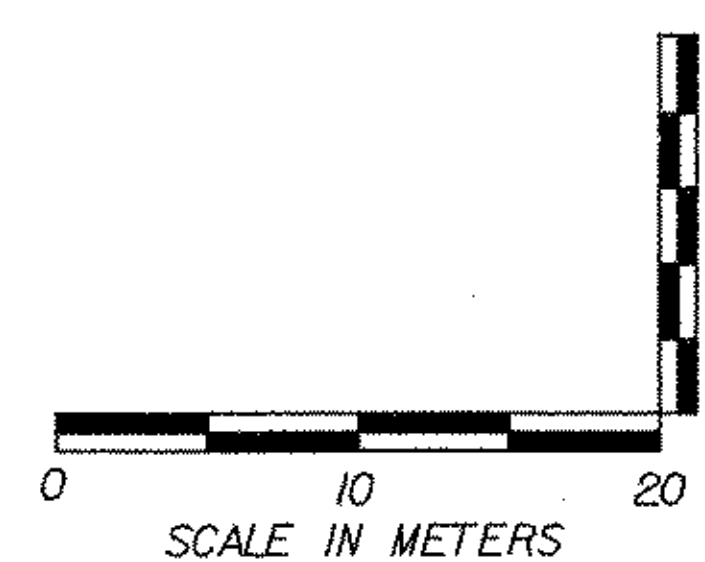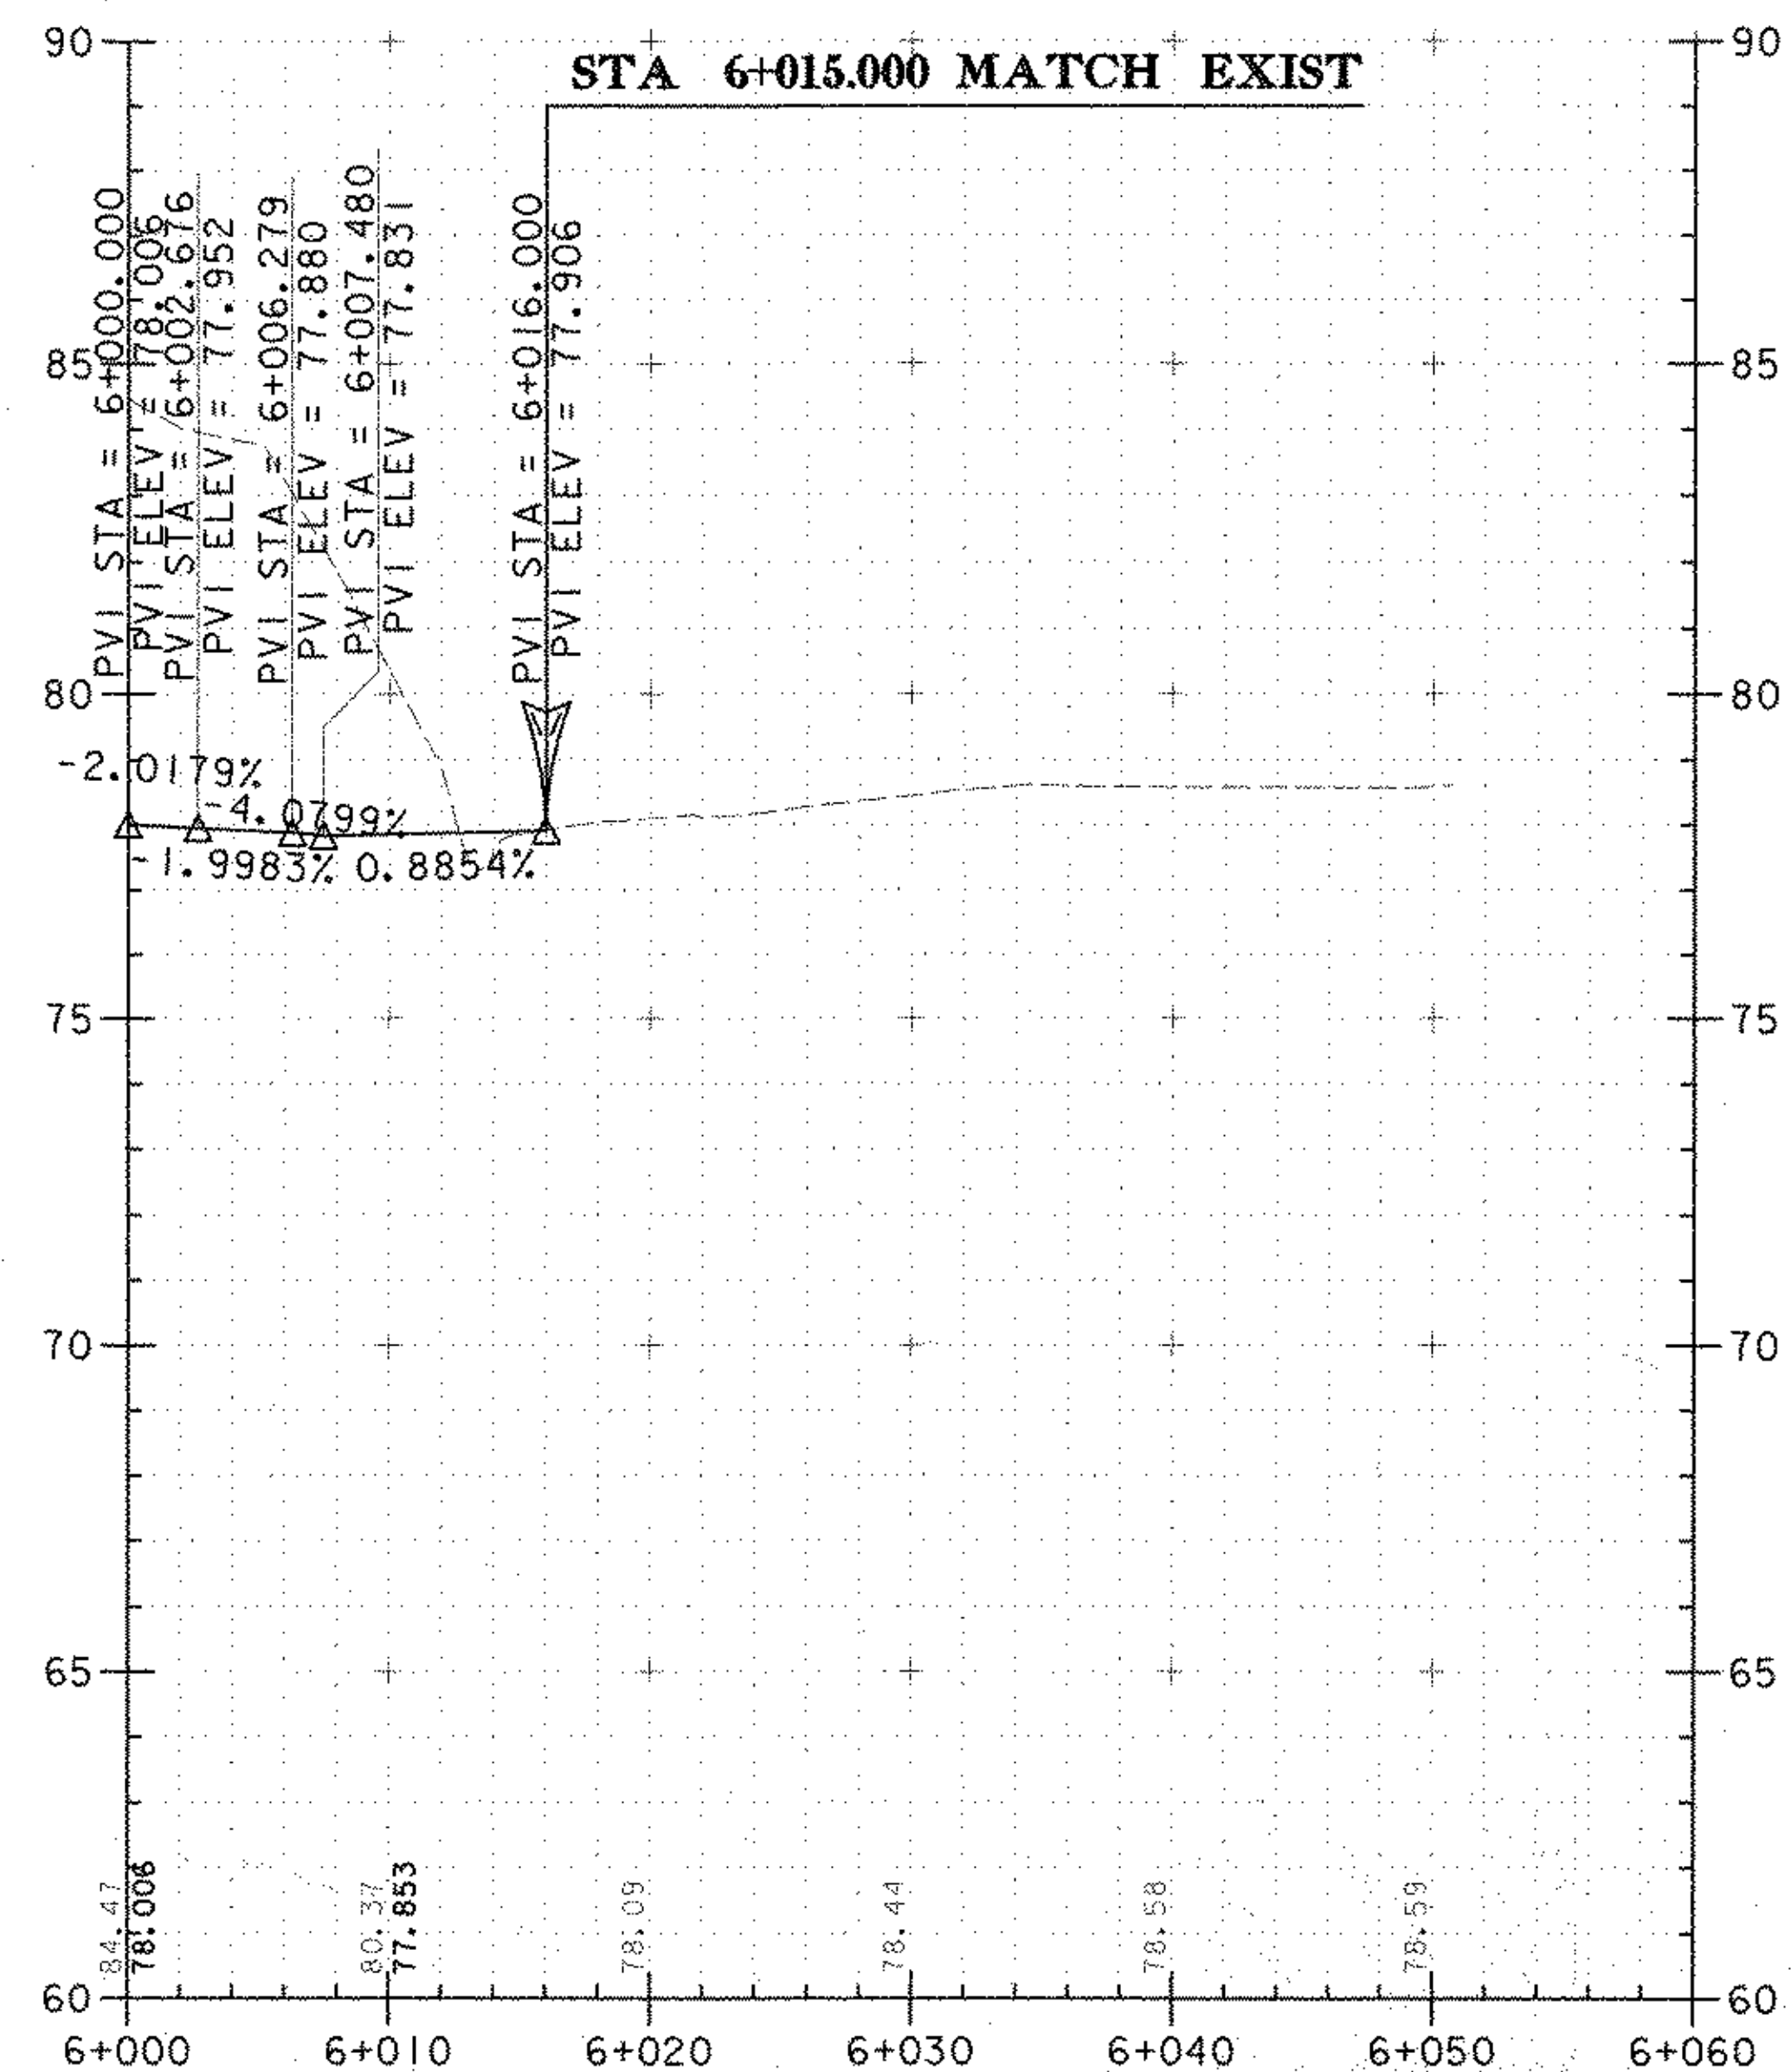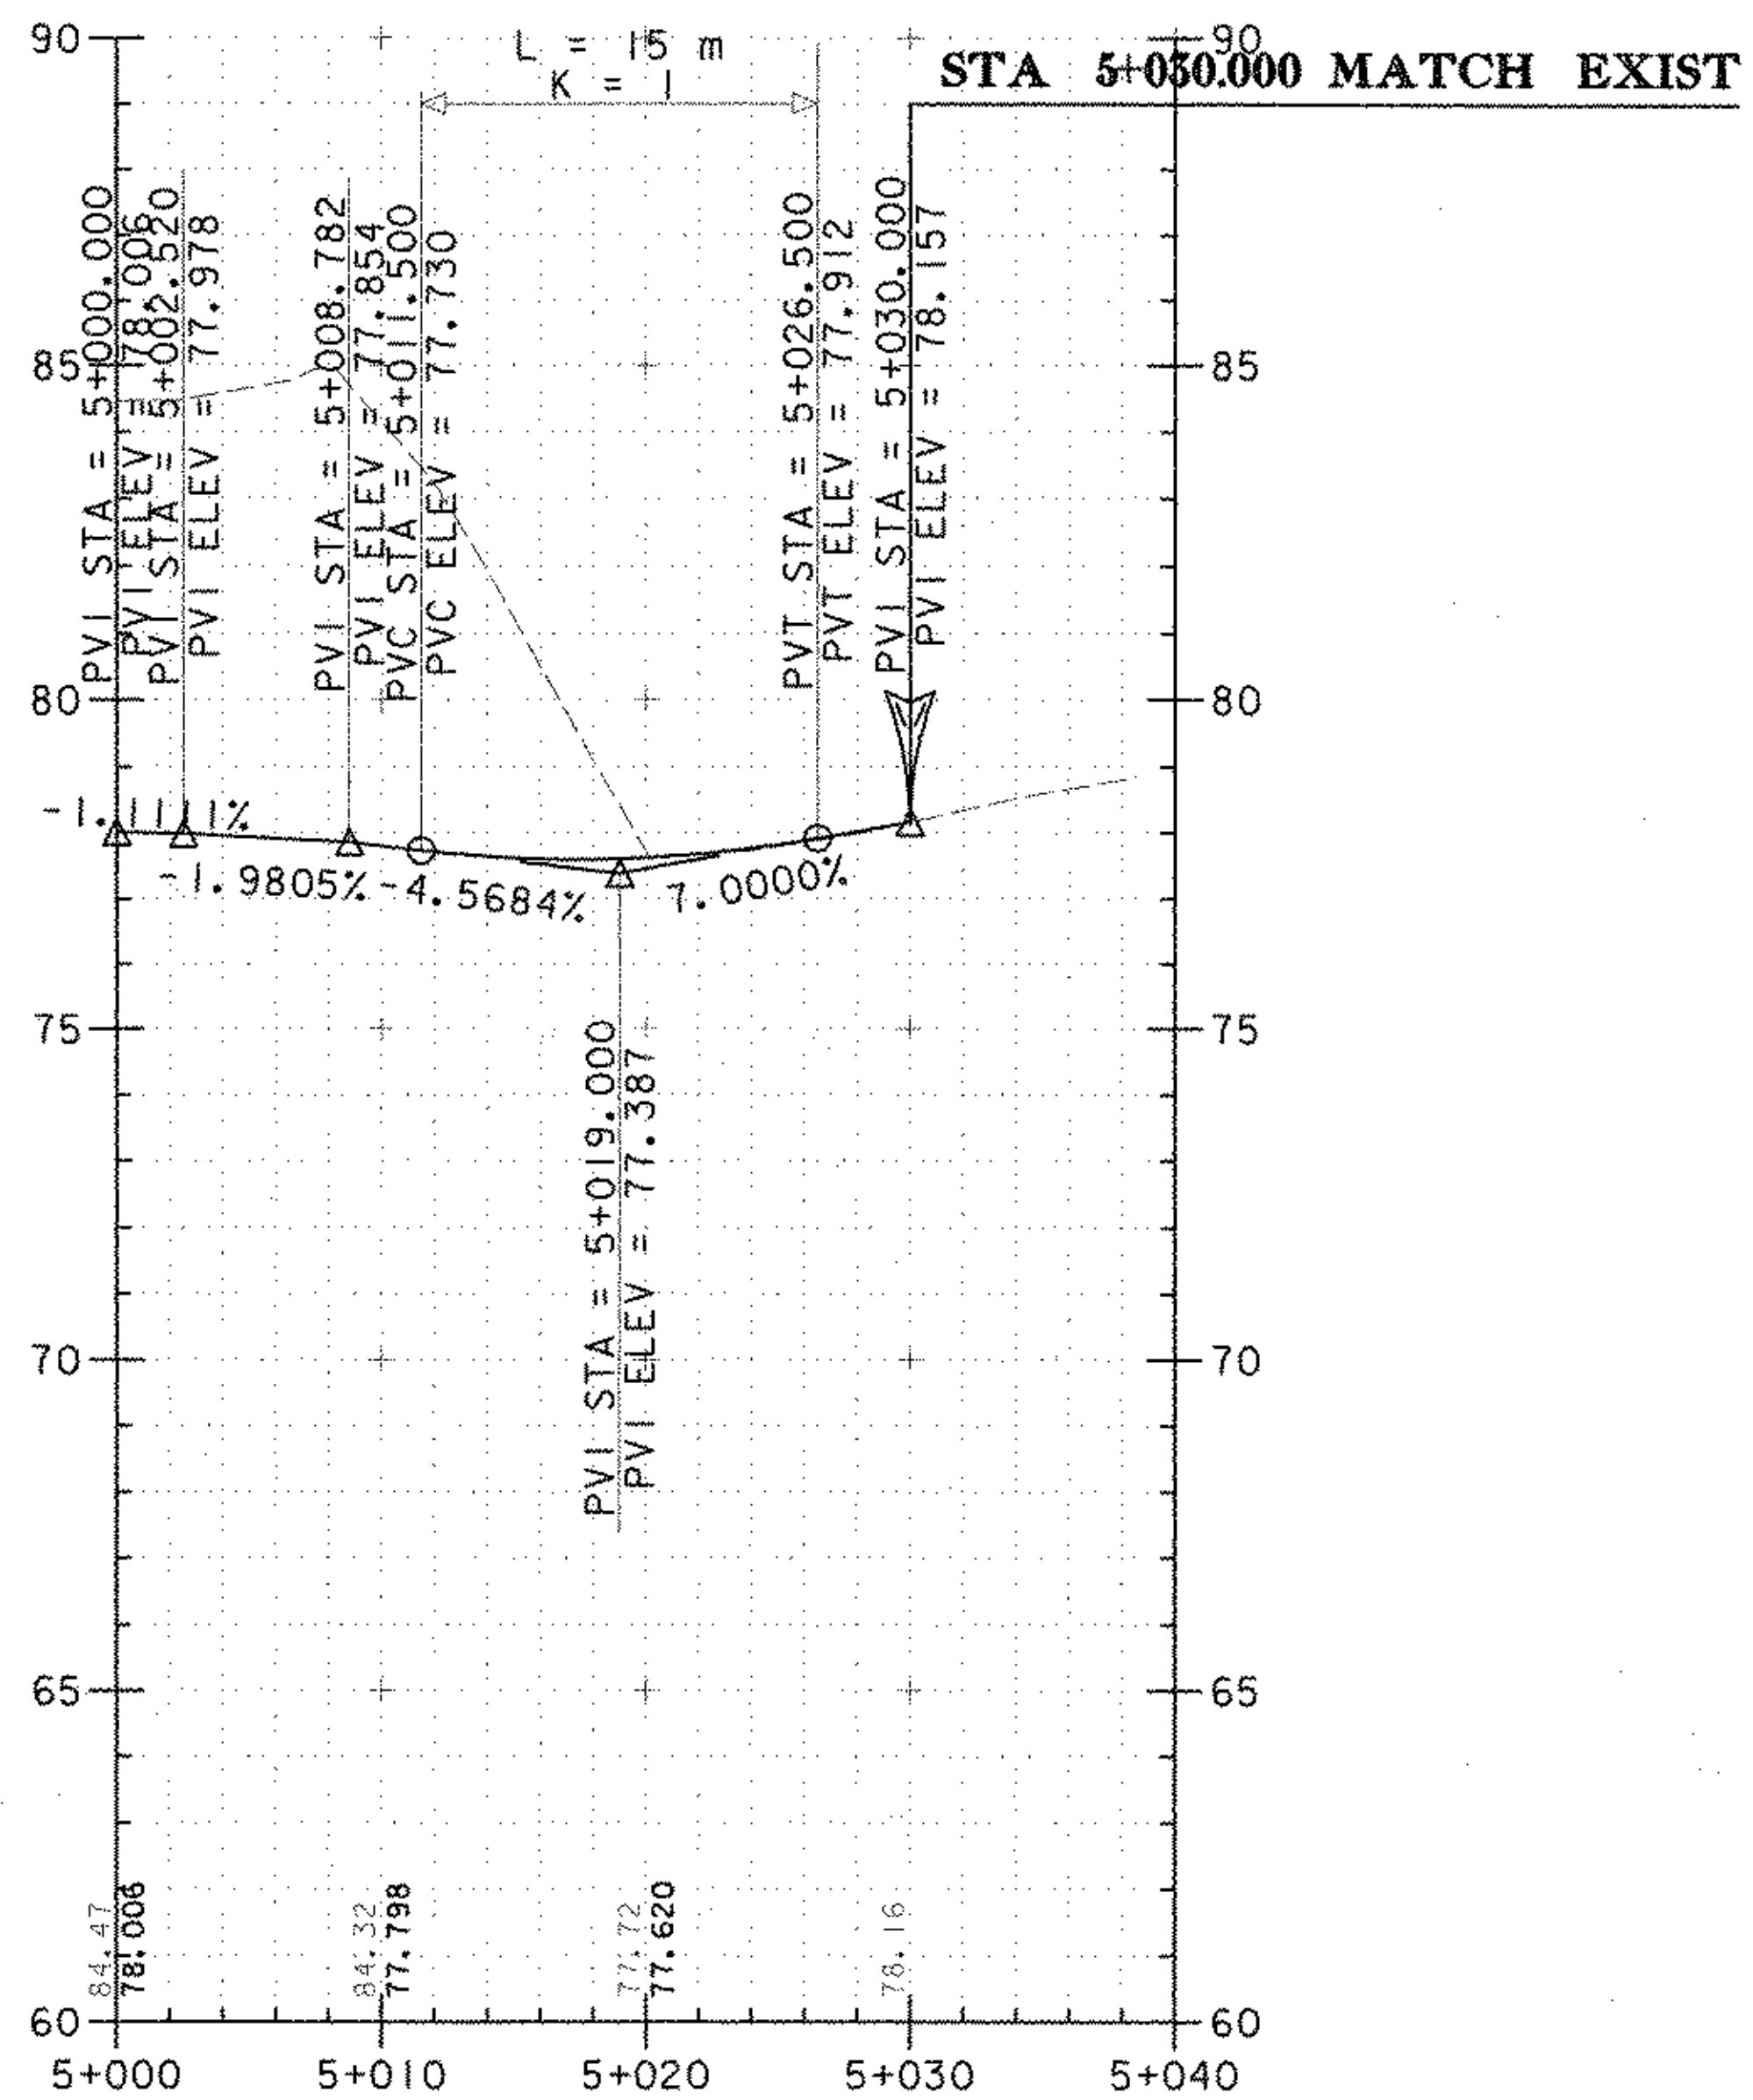

PROFILE - DRIVES	
PROJECT NAME:	BRATTLEBORO
PROJECT NUMBER:	NH 010-2(2)
FILE NAME: ...zb270pro.dgn	PLOT DATE: 03/28/2003
PROJECT LEADER: WRH	DRAWN BY: PTS
DESIGNED BY: PTS	CHECKED BY: JAW
CLD REF NO. 02-0439	SHEET 8 OF 13

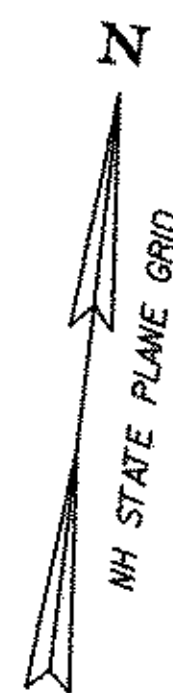


EROSION MATTING
 STA 1+244 - 1+282 LT

STONE FILL, TYPE I
 STA 1+255 LT
 STA 1+270 LT
 STA 1+295 LT
 STA 1+310 LT

**CHANGING ELEV. OF DROP INLETS,
 CATCH BASINS OR MANHOLES**
 STA 30+250 LT
 STA 30+285 LT
 STA 30+323 RT
 STA 30+326 LT & RT
 STA 30+337 LT & RT

**STA 1+240.000
 BEGIN TEMPORARY
 CROSSOVER**

**STA 1+428.000
 END TEMPORARY
 CROSSOVER**

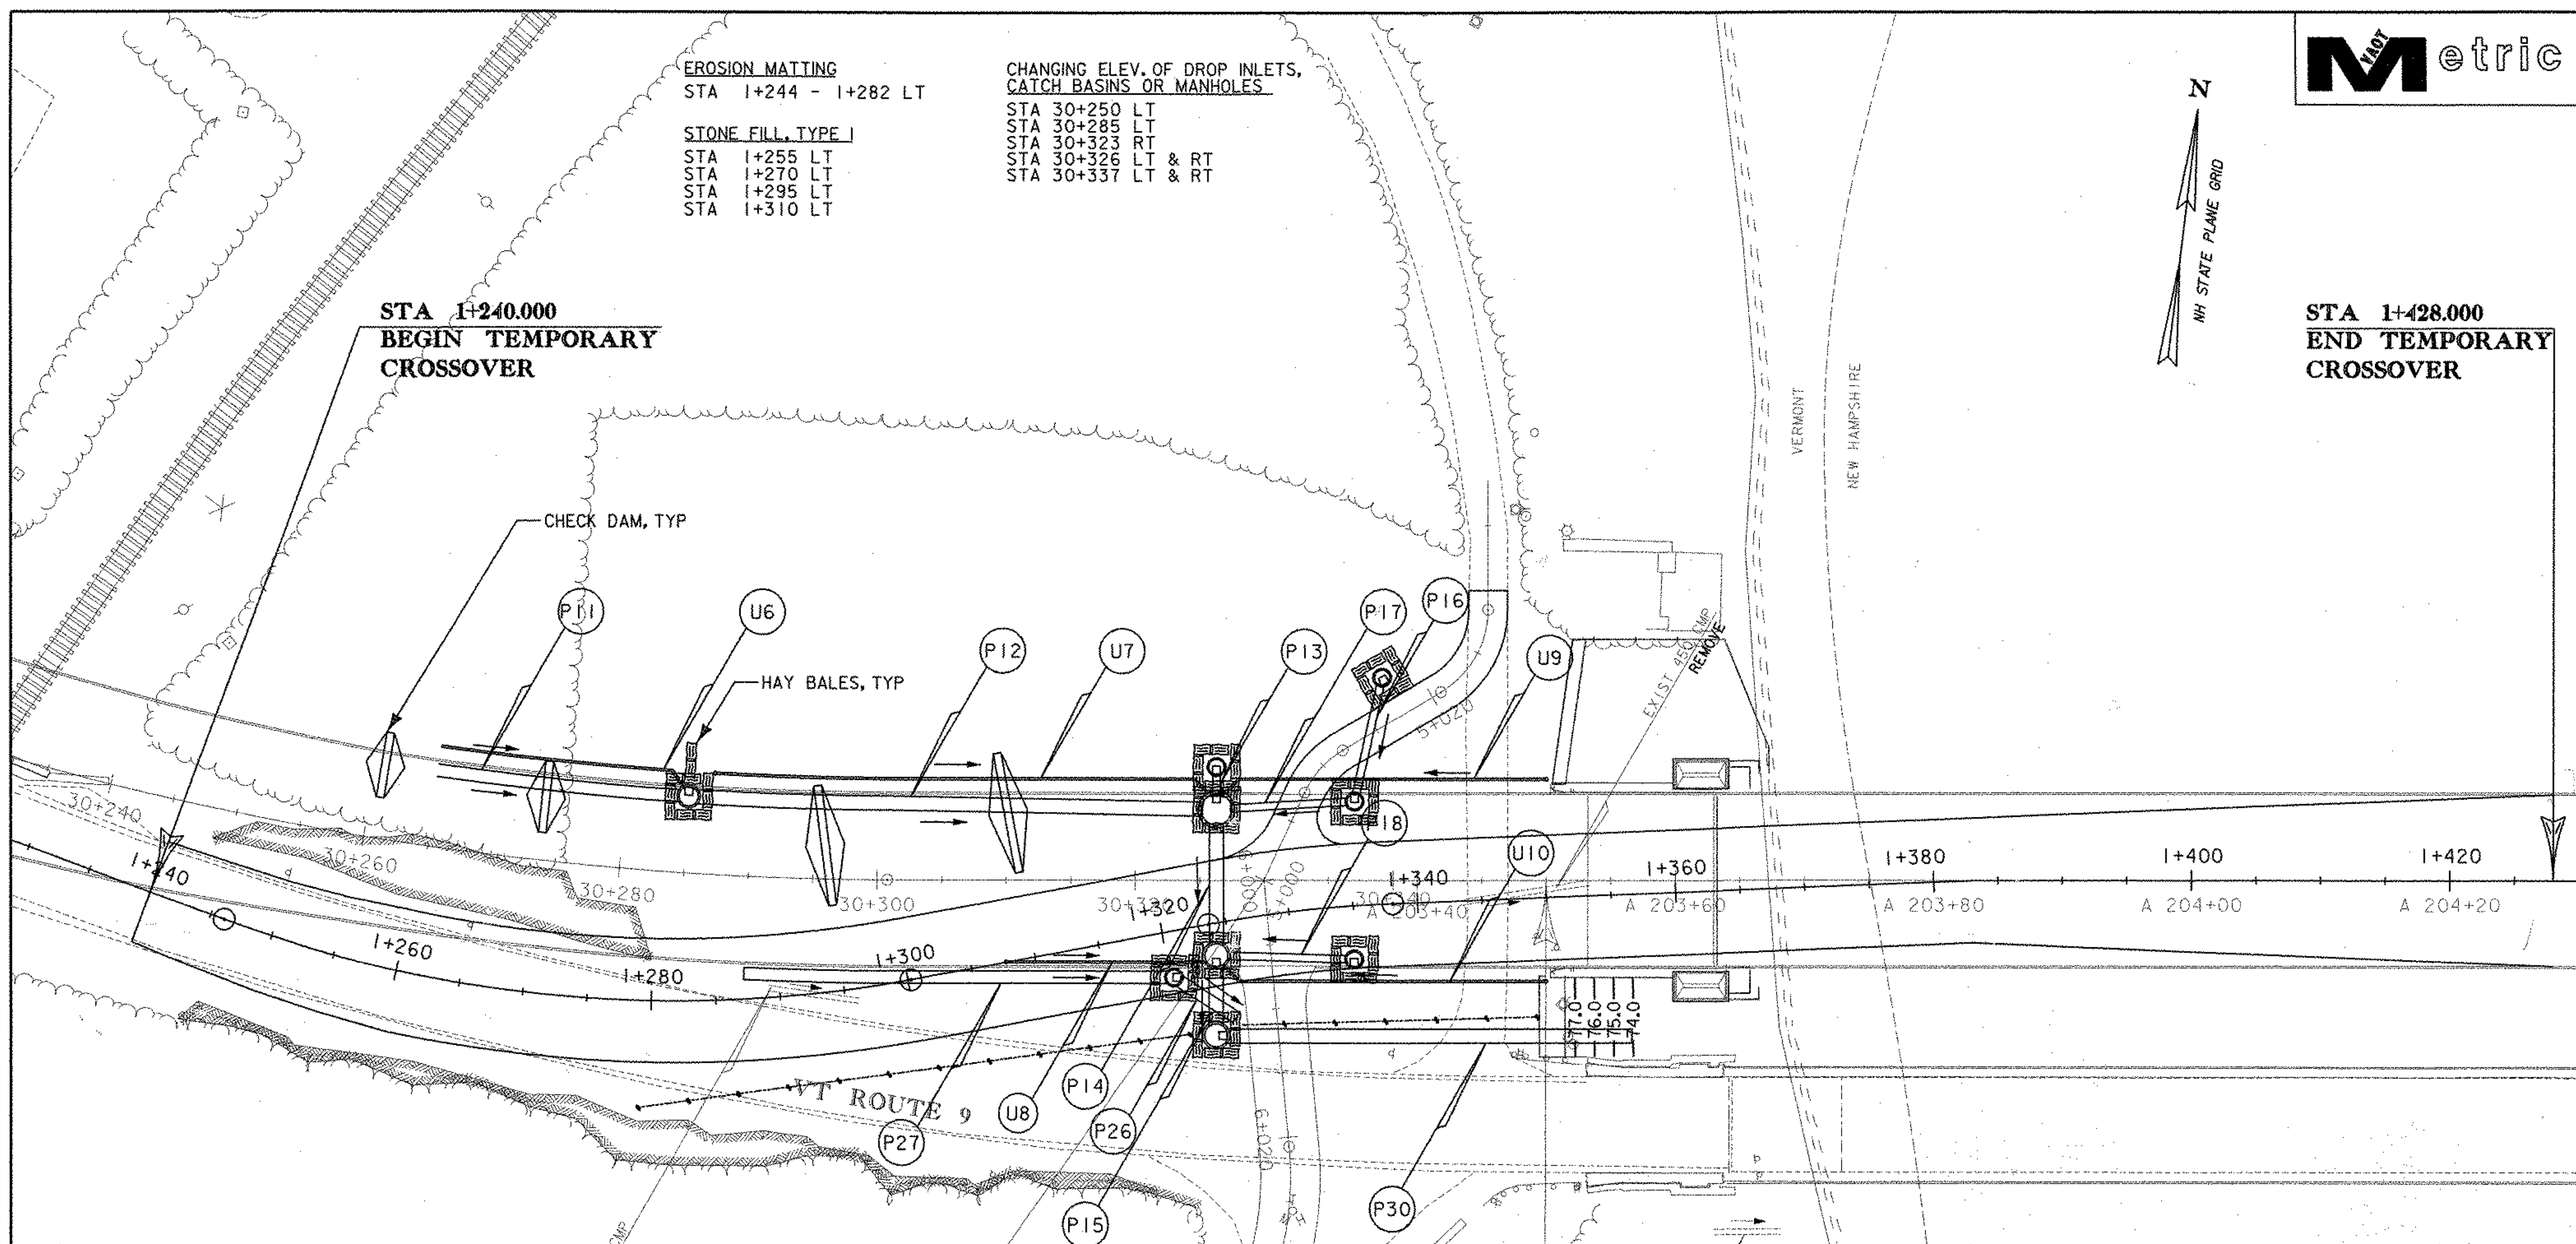

- (P11) STA. 30+265 LT TO STA. 30+285 LT
 NEW 900 mm x 18.5 m PCCSP (2.01) OR CAAP (1.52)
 CAP FOR FUTURE USE
- (P12) STA. 30+285 LT TO STA. 30+326 LT
 NEW 900 mm x 39.3 m RCP (CLASS III) OR CPEP (SL)
 NEW PRCCB AT INLET (1.5 m DIA.)
 W/ CI GRATE TYPE D
- (P13) STA. 30+326 LT
 NEW 450 mm x 1.5 m RCP (CLASS III) OR CPEP (SL)
 OR PCCSP (1.63) OR CAAP (1.52)
 NEW PRCCB AT INLET (1.2 m DIA.)
 W/ CI GRATE TYPE A
- (P14) STA. 30+326 LT TO STA. 30+326 RT
 NEW 900 mm x 9.2 m RCP (CLASS III) OR CPEP (SL)
 NEW PRCCB AT INLET (2.1 m DIA.)
 W/ CI GRATE TYPE D
- (P15) STA. 30+326 RT
 NEW 900 mm x 4.8 m RCP (CLASS III) OR CPEP (SL)
 NEW PRCCB AT INLET (1.8 m DIA.)
 W/ CI GRATE TYPE D
- (P16) STA. 30+337 LT TO STA. 5+016 LT
 NEW 450 mm x 8.8 m RCP (CLASS III) OR CPEP (SL)
 OR PCCSP (1.63) OR CAAP (1.52)
 NEW PRCCB AT INLET (1.2 m DIA.)
 W/ CI GRATE TYPE A
- (P17) STA. 30+326 LT TO STA. 30+337 LT
 NEW 450 mm x 9.0 m RCP (CLASS III) OR CPEP (SL)
 OR PCCSP (1.63) OR CAAP (1.52)
 NEW PRCCB AT INLET (1.2 m DIA.)
 W/ CI GRATE TYPE D

- STA 30+330.000 VT RTE 9 =
 STA 5+000.000 DRIVEWAY
 STA 6+000.000 DRIVEWAY
- (P18) STA. 30+326 RT TO STA. 30+337 RT
 NEW 450 mm x 9.2 m RCP (CLASS III) OR CPEP (SL)
 OR PCCSP (1.63) OR CAAP (1.52)
 NEW PRCCB AT INLET (1.2 m DIA.)
 W/ CI GRATE TYPE D
 - (P26) STA. 30+323 RT TO STA. 30+328 RT
 NEW 750 mm x 5.4 m RCP (CLASS III) OR CPEP (SL)
 CAP FOR FUTURE USE
 NEW PRCMH AT INLET (1.5 m)
 W/ CI COVER
 - (P27) STA. 30+290 RT TO STA. 30+323 RT
 NEW 750 mm x 32.8 m PCCSP (2.01) OR CAAP (1.52)
 CAP FOR FUTURE USE
 - (P30) STA. 30+326 RT TO STA. A203+57 RT
 NEW 900 mm x 31.5 m RCP (CLASS III) OR CPEP (SL)
 OUTLET ONTO STONE FILL BETWEEN ABUTMENTS
 NEW PRCCB AT INLET (1.8 m DIA.)
 W/ CI GRATE TYPE A
 THE INTENT IS TO TEMPORARILY USE THE PRCCB INTENDED
 FOR STA 30+326 RT AT THIS LOCATION


- (U6) STA. 30+265 LT TO STA. 30+285 LT
 NEW 150 mm UD CAP FOR FUTURE USE
- (U7) STA. 30+287 LT TO STA. 30+326 LT
 NEW 150 mm UD w/ FLUSHING BASIN AT STA 30+287
- (U8) STA. 30+310 RT TO STA. 30+326 RT
 NEW 150 mm UD w/ FLUSHING BASIN AT STA 30+310
- (U9) STA. 30+326 LT TO STA. A203+50 LT
 NEW 150 mm UD w/ FLUSHING BASIN AT STA A203+50
- (U10) STA. 30+326 RT TO STA. A203+50 RT
 NEW 150 mm UD w/ FLUSHING BASIN AT STA A203+50

STA A203+50.000
 END PROJECT
 NH 010-2(2)
 BEGIN NH PROJECT 11999


DRAINAGE & EROSION CONTROL PLAN

PROJECT NAME: BRATTLEBORO	PROJECT NUMBER: NH 010-2(2)
FILE NAME: ... \zb270drn.dgn	PLOT DATE: 03/31/2003
PROJECT LEADER: WRH	DRAWN BY: PTS
DESIGNED BY:	CHECKED BY: JAW
CLD REF NO. 02-0439	SHEET 9 OF 13

168 ROK

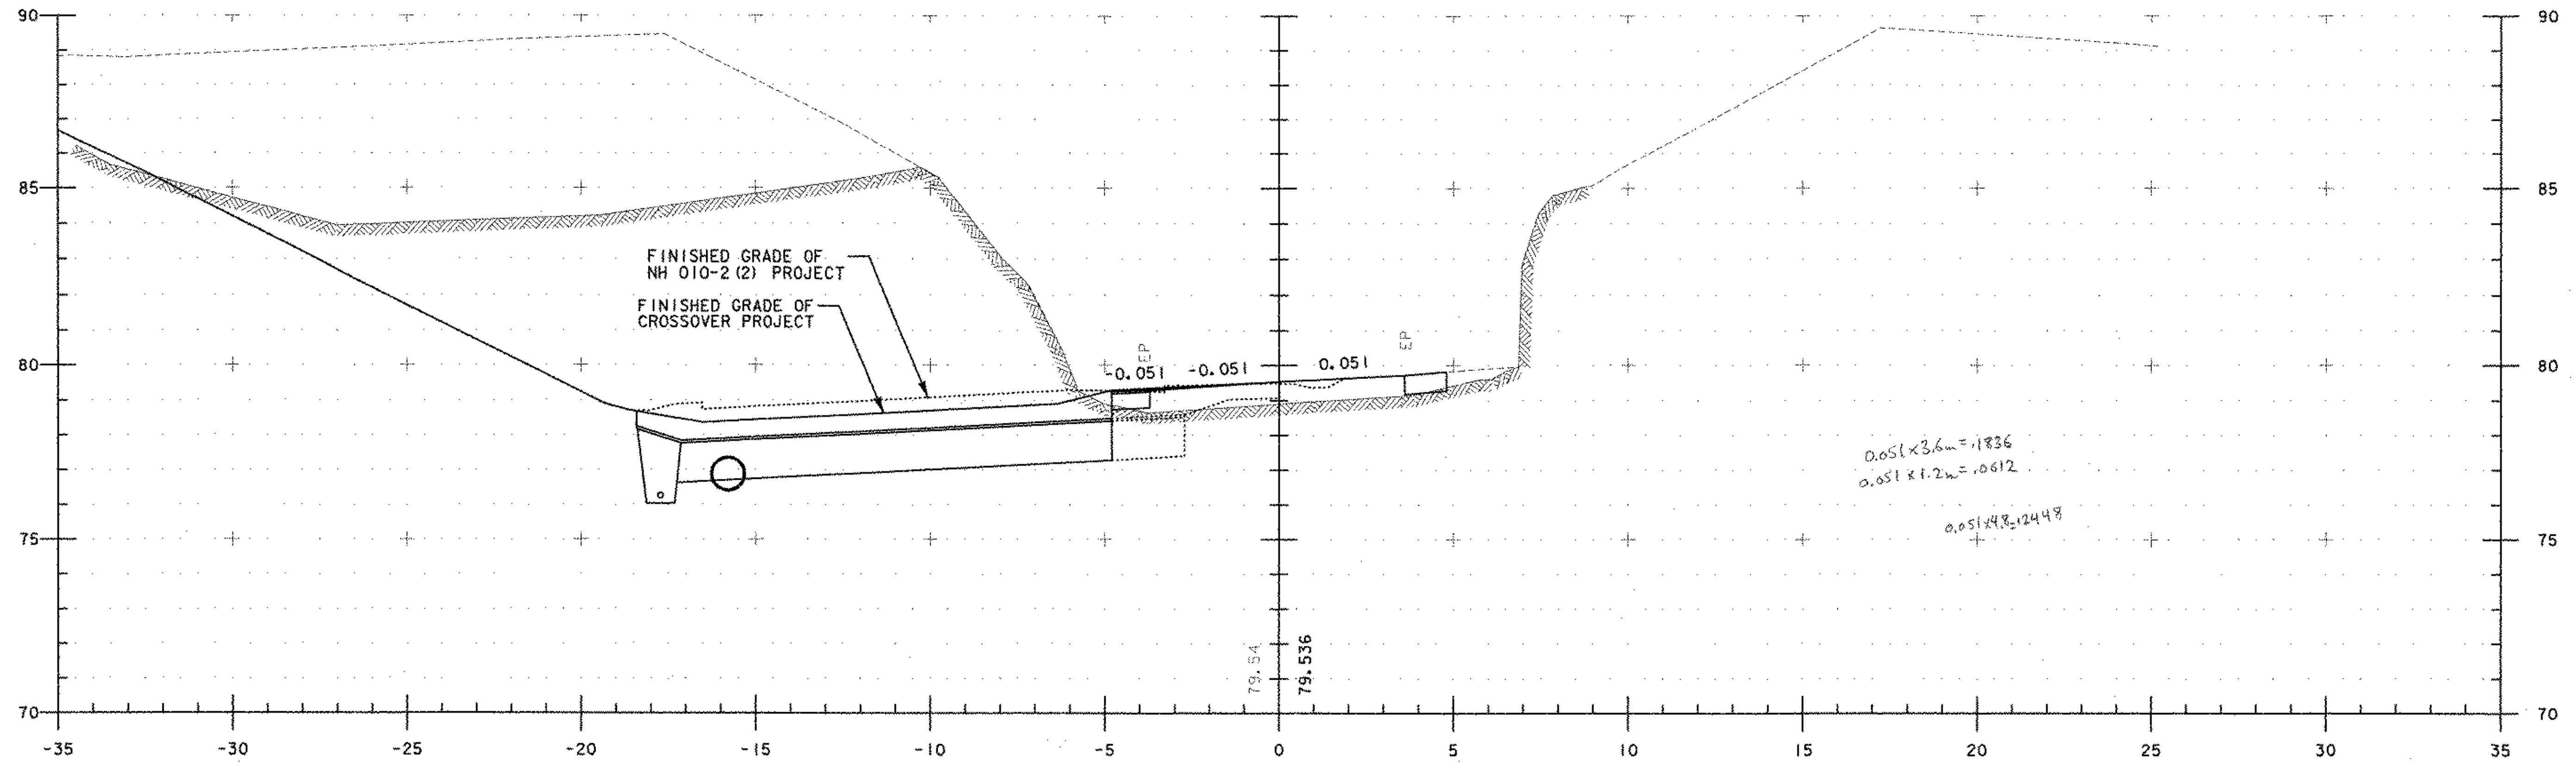


I+260

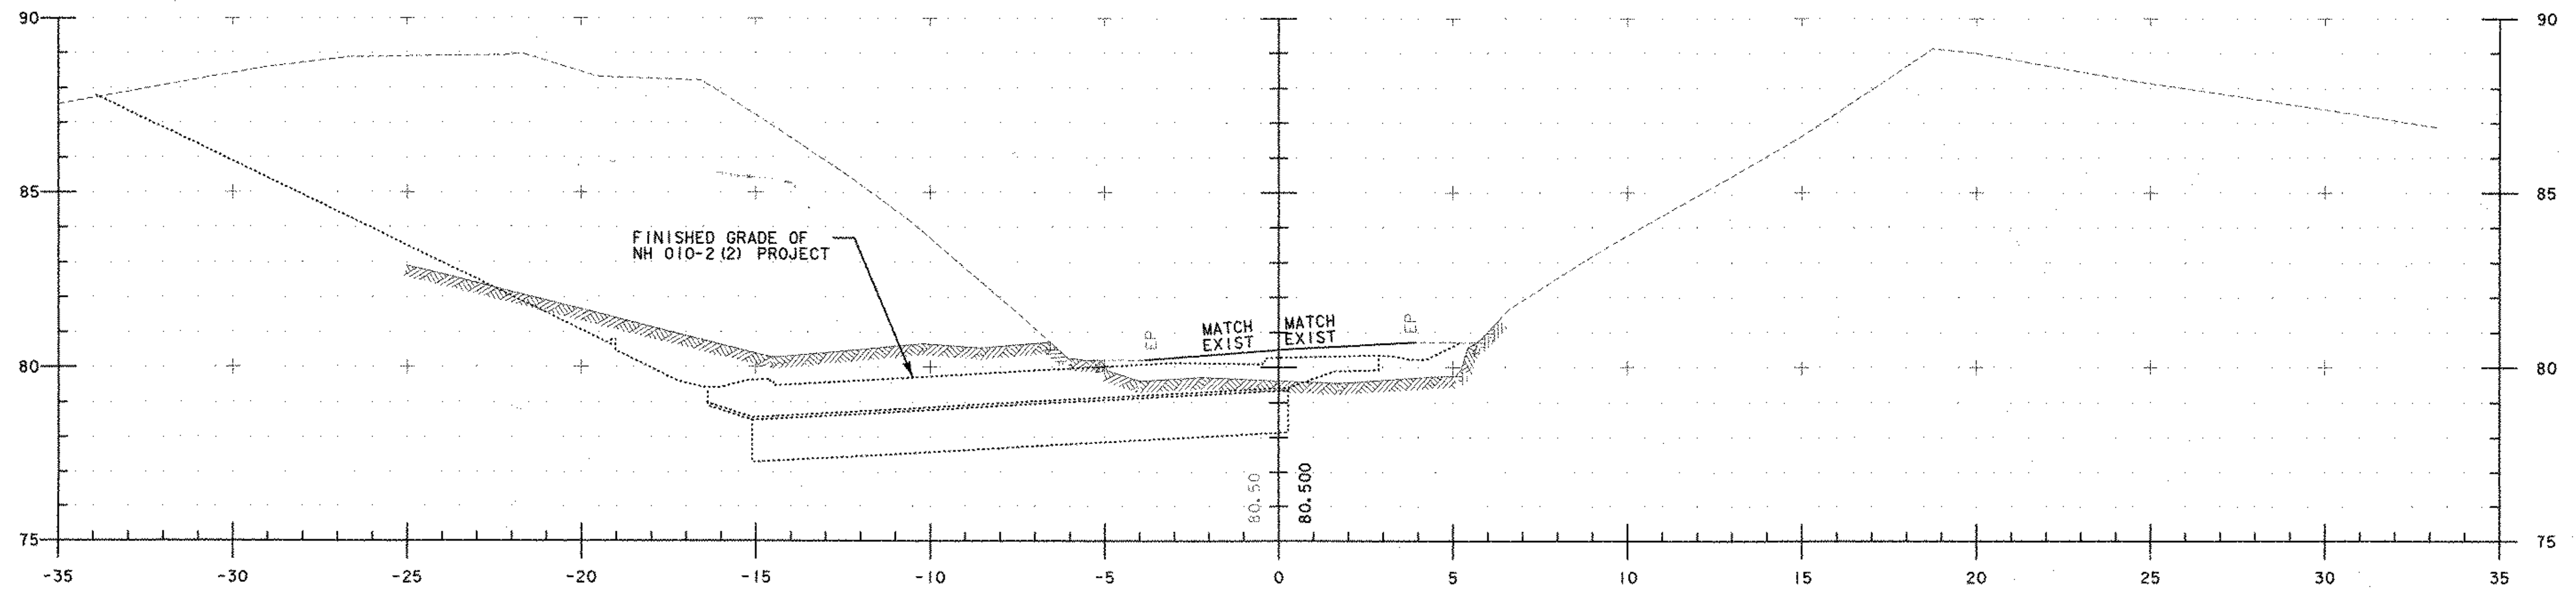

I+240

PROJECT NAME:	BRATTLEBORO	PROJECT NUMBER:	NH 010-2(2)
FILE NAME:	... \zb270xs.dgn	PROJECT LEADER:	WRH
DESIGNED BY:	PTS	CHECKED BY:	JAW
CLD REF NO.	02-0439	PLOT DATE:	03/28/2003
		DRAWN BY:	PTS
		CHECKED BY:	JAW
		SHEET	10 OF 13


169 ROCK

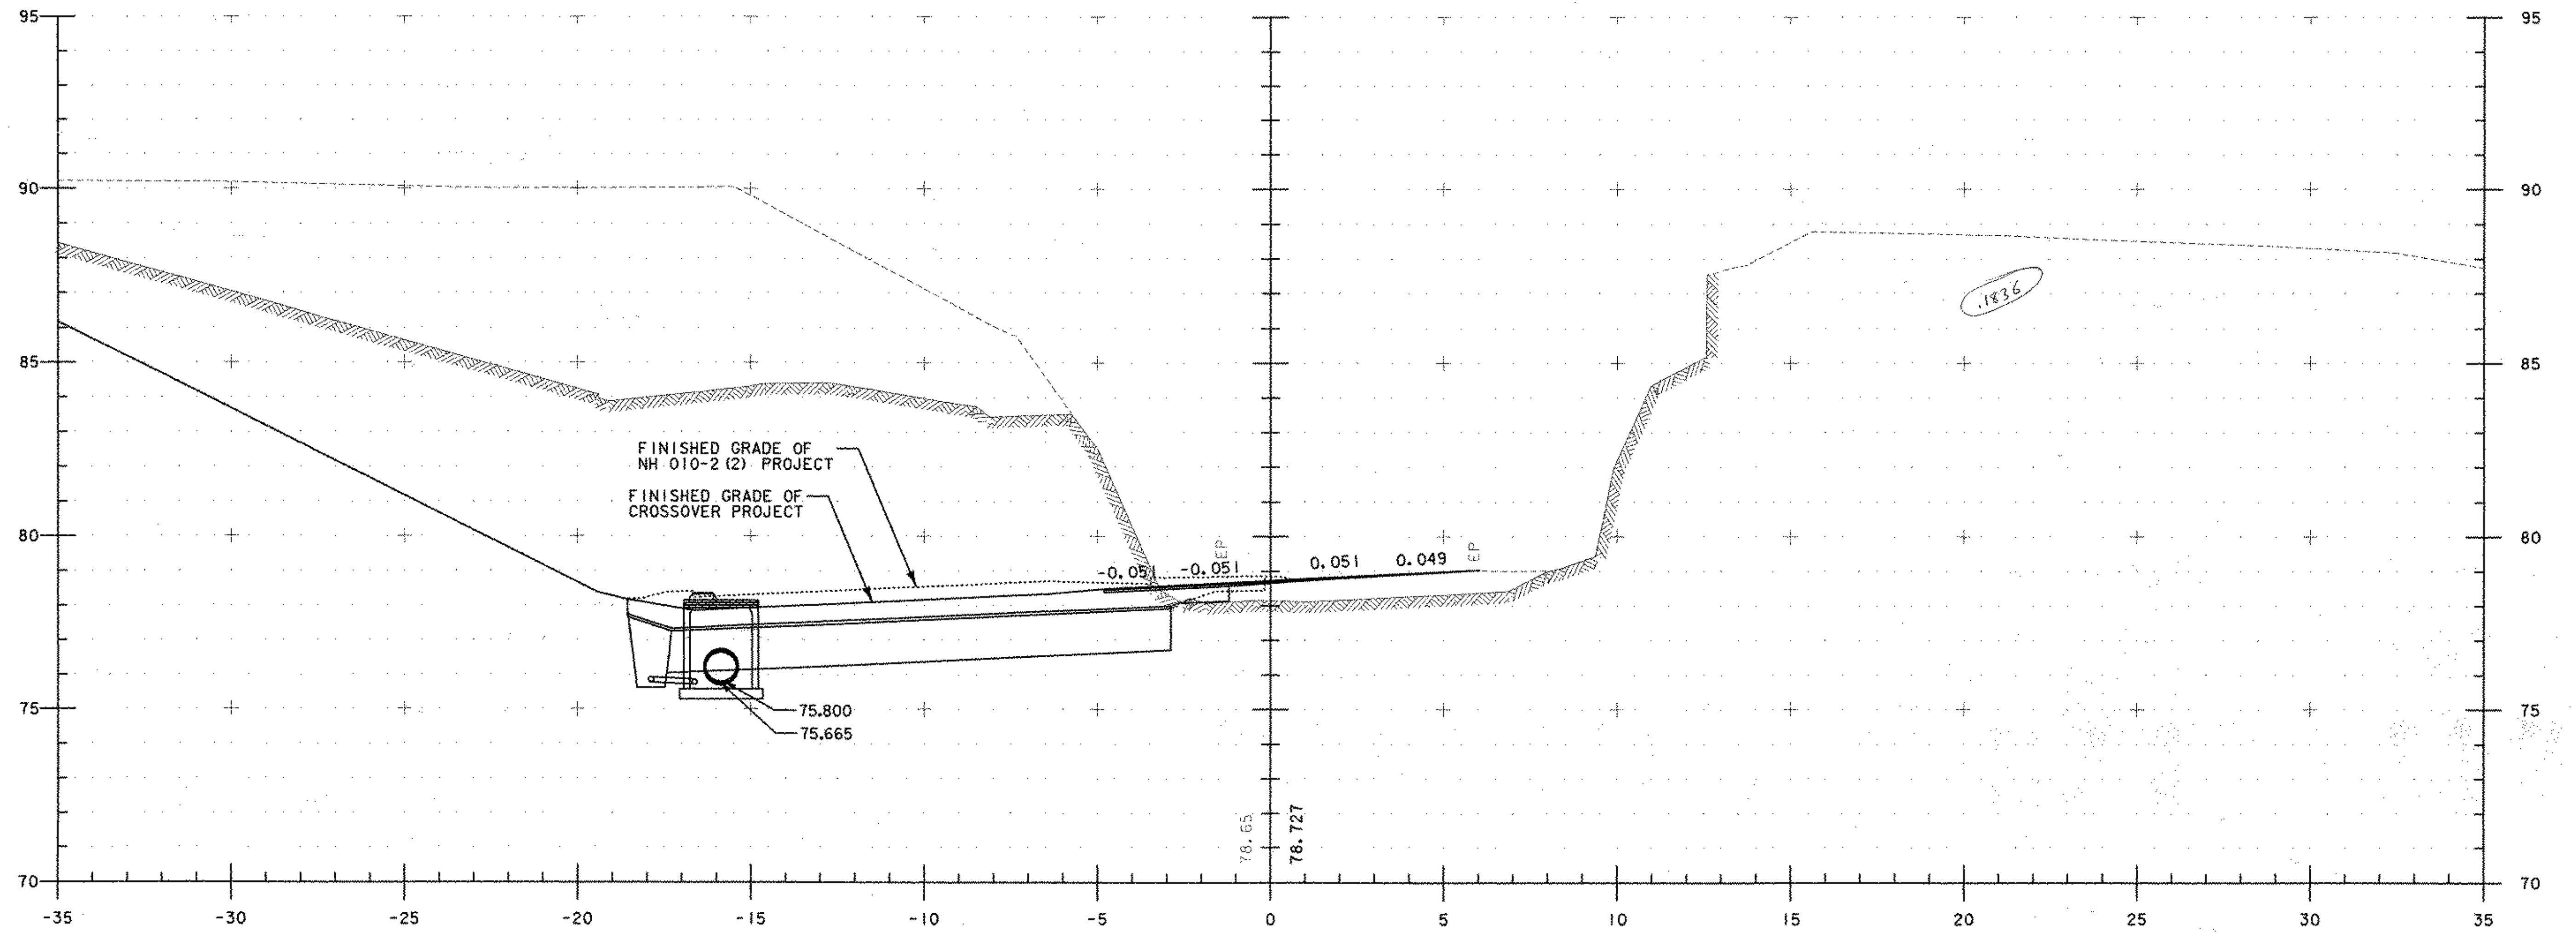

I+280

PROJECT NAME: BRATTLEBORO	PLOT DATE: 03/28/2003
PROJECT NUMBER: NH 010-2(2)	DRAWN BY: PTS
FILE NAME: ... \zb270xs.dgn	CHECKED BY: JAW
PROJECT LEADER: WRH	SHEET 11 OF 13
DESIGNED BY: PTS	
CLD REF NO. 02-0439	


170 Pock

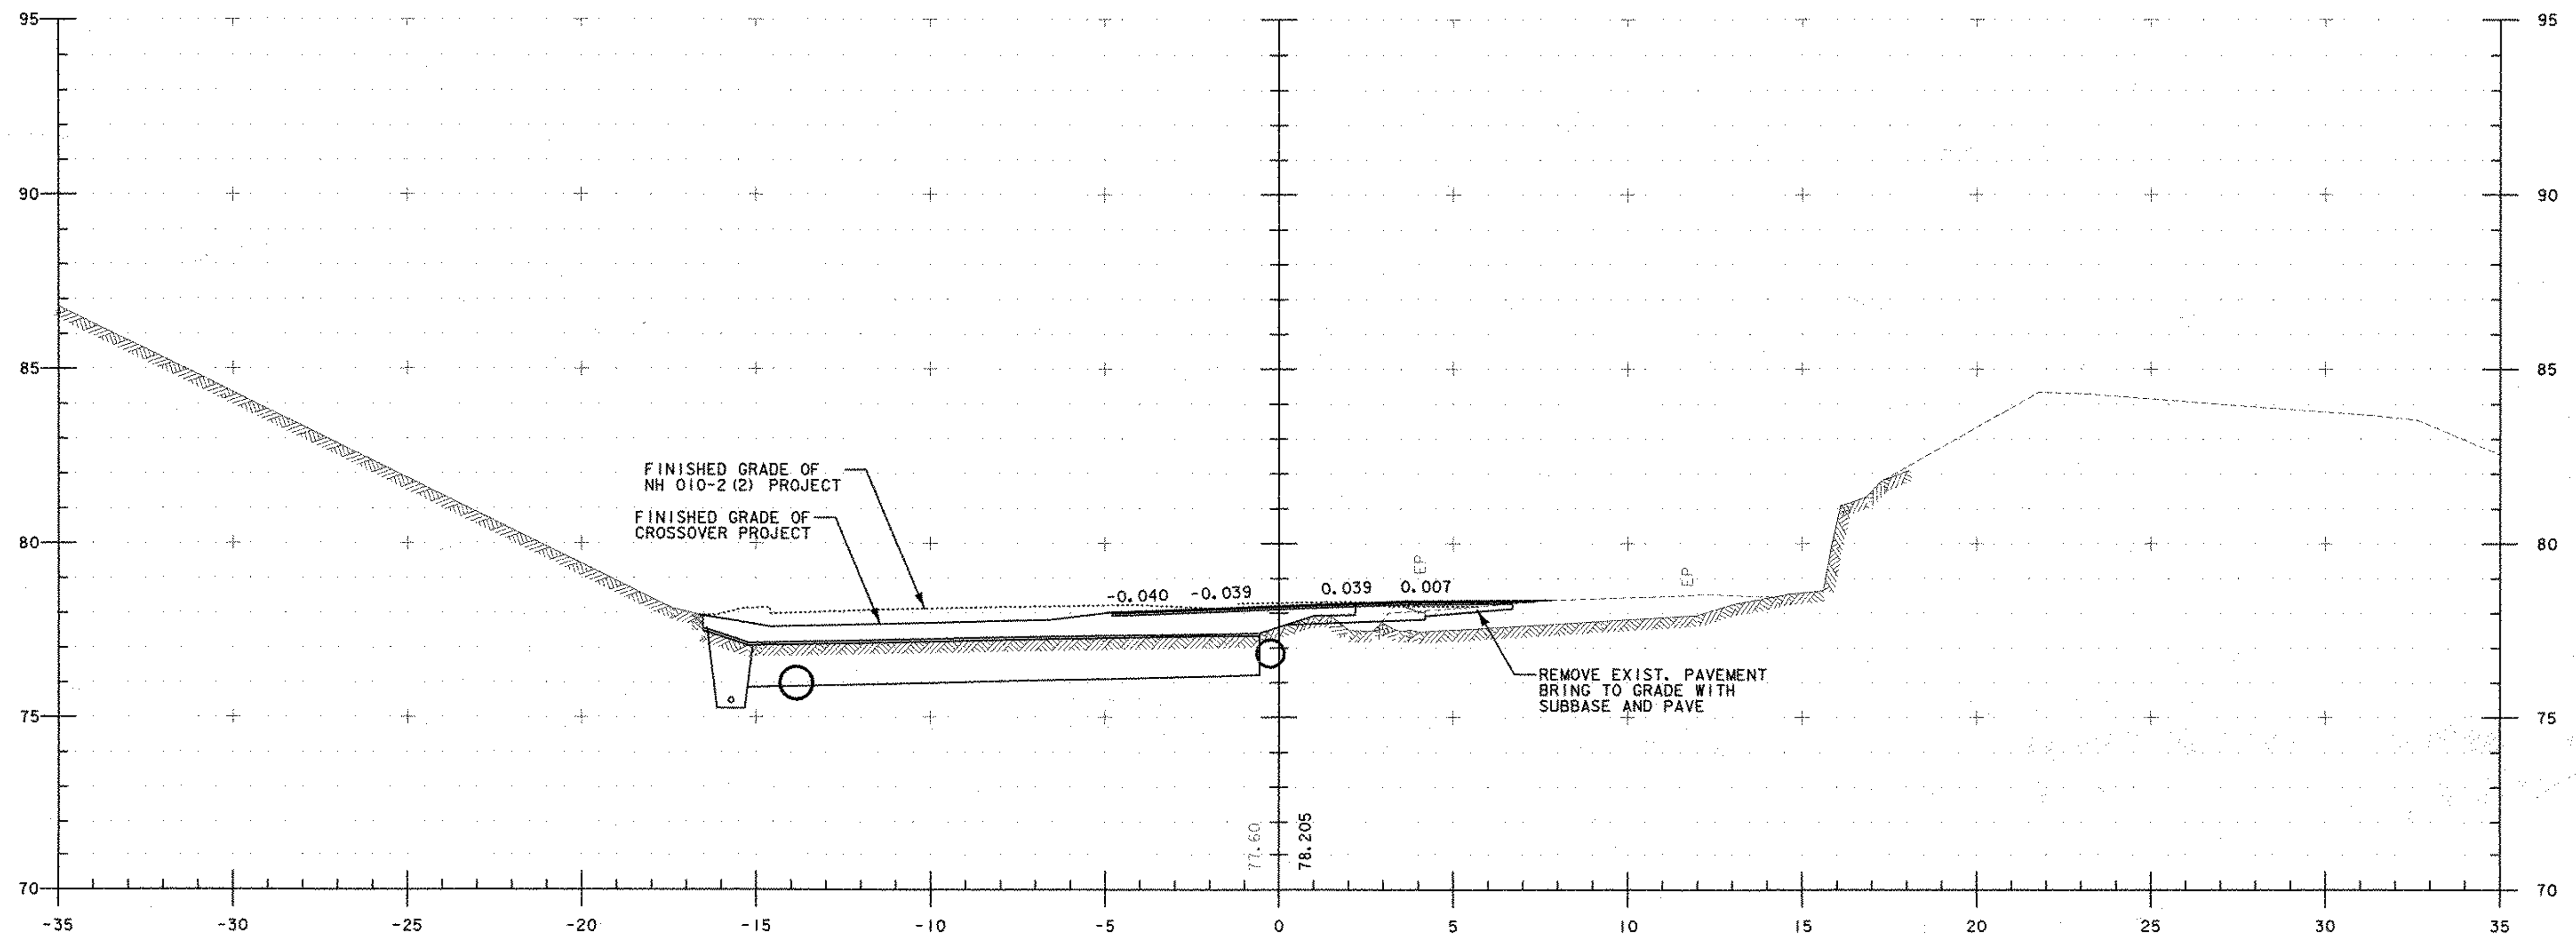


1+300

PROJECT NAME: BRATTLEBORO	
PROJECT NUMBER: NH 010-2(2)	
FILE NAME: ... \zb270xs.dgn	PLOT DATE: 03/28/2003
PROJECT LEADER: WRH	DRAWN BY: PTS
DESIGNED BY: PTS	CHECKED BY: JAW
CLD REF NO. 02-0439	SHEET 12 OF 13

171 Rock

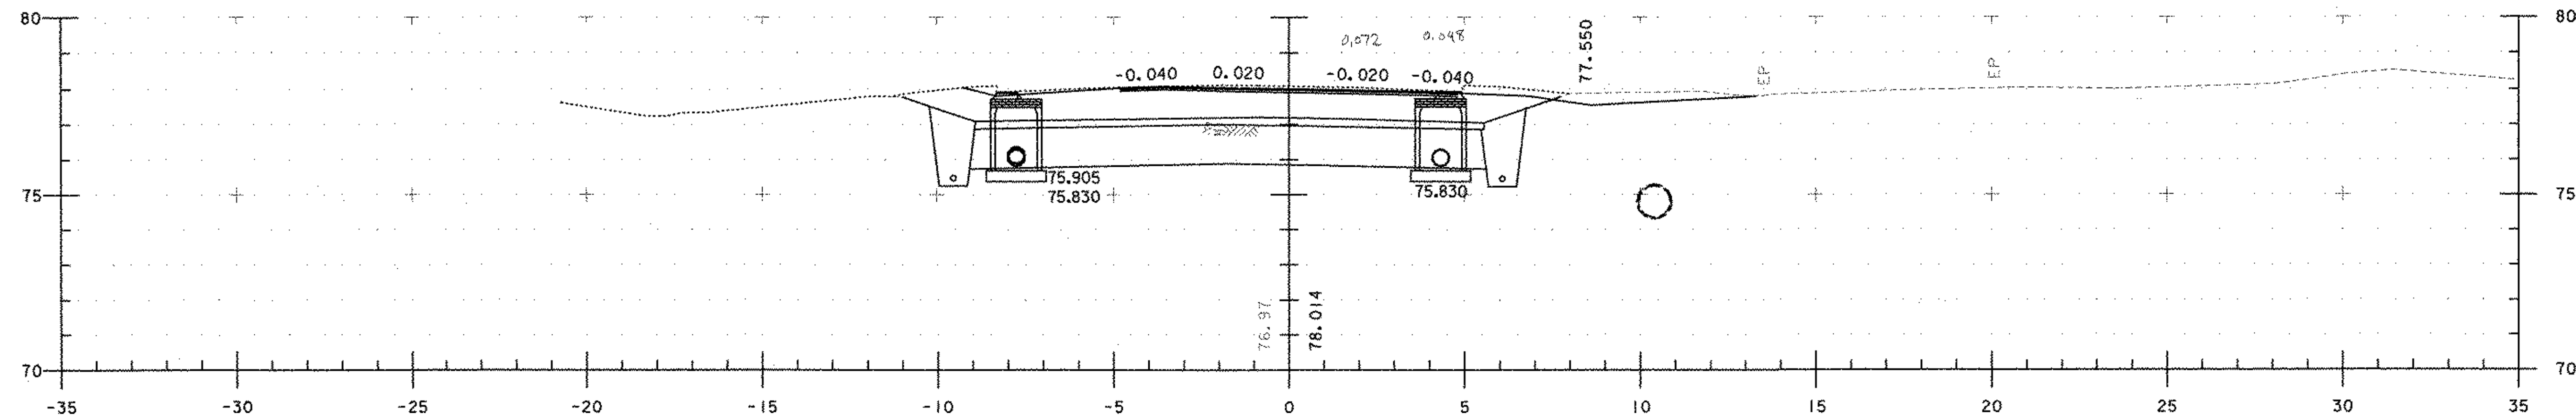

I+340

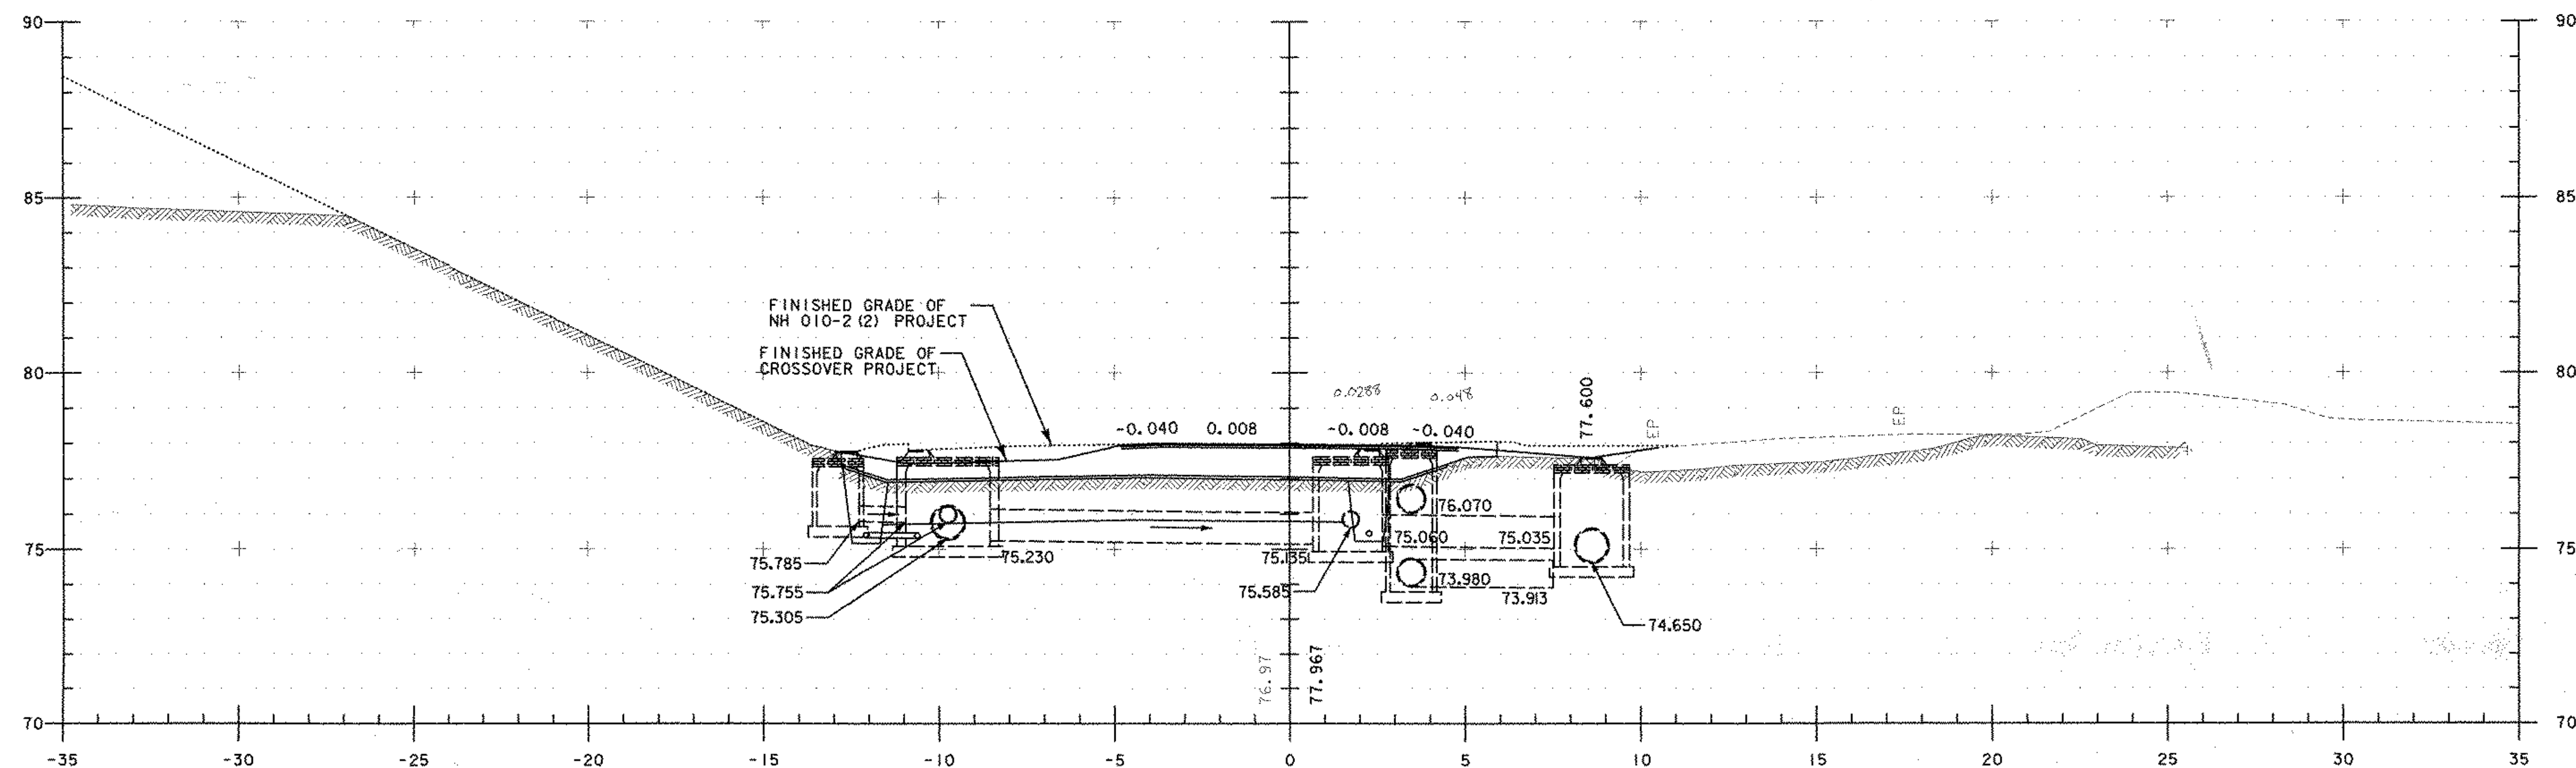

I+320

PROJECT NAME:	BRATTLEBORO	PLOT DATE:	03/28/2003
PROJECT NUMBER:	NH 010-2(2)	DRAWN BY:	PTS
FILE NAME:	... \zb270xs.dgn	CHECKED BY:	JAW
PROJECT LEADER:	WRH	SHEET	13 OF 13
DESIGNED BY:	PTS		
CLD REF NO.	02-0439		

172 Rock

TEMPORARY EXCAVATION SUPPORT ROUTE 9 IMPROVEMENTS BRATTLEBORO, VERMONT

GENERAL NOTES

THIS PLAN SHOWS THE EXCAVATION SHORING SYSTEM FOR THE CONSTRUCTION OF THE RAILROAD BRIDGE ABUTMENTS OVER ROUTE 9 AND SARGENT BROOK IN BRATTLEBORO, VERMONT. THE EXCAVATION SHORING SYSTEM WILL CONSIST OF DRILLED IN OR DRIVEN SOLDIER PILES AND LAGGING OR STEEL SHEET PILES. LATERAL SUPPORT WILL BE PROVIDED BY TIEBACKS, INTERNAL BRACING, OR BY DESIGNING THE SOLDIER PILES TO CANTILEVER.

- DESIGN OF THE EXCAVATION SHORING SYSTEM MAY BE ADJUSTED IN THE FIELD TO ACCOUNT FOR ACTUAL FIELD CONDITIONS. EQUIVALENT MEMBERS MAY BE SUBSTITUTED FOR ANY SHOWN.
- ONLY THOSE PORTIONS OF THE WORK NECESSARY TO CLARIFY THE WORK OF SCHNABEL FOUNDATION COMPANY (SFC) ARE SHOWN. THESE DRAWINGS ARE INTENDED FOR THE EXCLUSIVE USE OF SCHNABEL FOUNDATION COMPANY IN CONSTRUCTING THE EXCAVATION SHORING SYSTEM AND SHOULD NOT BE USED BY THE CONTRACTOR OR ANY OTHER SUBCONTRACTOR(S) FOR ANY OTHER REASON.
- ESTABLISH VERTICAL SURVEY STATIONS AT 15-FOOT ON CENTER ON EACH RAIL OF THE EXISTING (PHASE 1) OR PROPOSED (PHASE 2) RAILS (BY OTHERS). SURVEY STATIONS SHOULD EXTEND AT LEAST 30 FEET BEYOND THE LAST PILE IN THE EXCAVATION SUPPORT SYSTEM. MONITORING SHOULD BE PERFORMED ON A DAILY BASIS DURING EXCAVATION (BY OTHERS). ESTABLISH VERTICAL AND LATERAL MONITORING POINTS ON ALL PILES. MONITORING SHOULD BE PERFORMED ON A WEEKLY BASIS OR WHENEVER EXCAVATION TAKES PLACE IN FRONT OF THE PILES. NOTIFY SCHNABEL FOUNDATION COMPANY IMMEDIATELY OF ANY VERTICAL SETTLEMENT OR LATERAL MOVEMENT. ALL MONITORING RESULTS SHOULD BE SENT TO SFC WITHIN THREE (3) DAYS OF THE READINGS.
- ALL SLOPING SHALL BE IN ACCORDANCE WITH OSHA STANDARDS.
- CALL DIGSAFE (1-888-344-7233 - SFC CONTRACTOR NUMBER 34520) TO MARK THE LOCATION OF ALL EXISTING UTILITIES AT LEAST 72 HOURS PRIOR TO INSTALLATION OF SOLDIER BEAMS AND TIEBACKS AND MONTHLY THEREAFTER. FIELD VERIFY THE LOCATION OF ALL UTILITIES WITH CONTRACTOR PRIOR TO STARTING ANY WORK. VERIFICATION SHALL CONSIST AT A MINIMUM OF EXPOSING ANY UTILITIES WITHIN 5-FEET OF ALL PILES AND PULLING MANHOLES TO MEASURE UTILITY DEPTHS.
- COORDINATE ALL WORK WITH NEW ENGLAND CENTRAL RAILROAD PERSONEL.

EXCAVATION SUPPORT SYSTEM PROCEDURE

- REMOVE AND/OR CAP OFF EXISTING UTILITIES THAT EXTEND INTO THE EXCAVATION (BY OTHERS). UTILITIES SHOULD BE CAPPED OFF AT LEAST 2-FEET BEHIND SHORING LINE TO PREVENT CONTAMINATION OF EXISTING LINES. VERIFY DEPTH AND LOCATION OF UTILITIES THAT REMAIN IN PLACE (BY OTHERS).
- PRE-TRENCH AREA OF PILE INSTALLATION TO REMOVE OBSTRUCTIONS (BY OTHERS). PRE-TRENCHING IS NOT PERMITTED ADJACENT TO THE TRACKS.
- SLOPE GRADE TO TOP OF PILE ELEVATION (BY OTHERS).
- DRILL HOLES TO THE DEPTHS AND AT THE LOCATIONS SHOWN ON THE PLANS AND INSTALL PILES. ALTERNATELY, DRIVE PILES THAT ARE NOT ADJACENT TO TRACKS. INSTALL STEEL SHEET PILES AT THE LOCATIONS SHOWN. IF TOP OF ROCK IS ENCOUNTERED AT A DEPTH MORE THAN 1-FOOT DEEPER OR SHALLOWER THAN SHOWN ON THE PLAN, RECORD TOE ELEVATION AND NOTIFY SFC ENGINEER. SFC WILL DETERMINE IF REDESIGN IS REQUIRED.
- EXCAVATE A MAXIMUM 5-FOOT HIGH LIFT IN THE AREA TO BE SHORED (BY CONTRACTOR). LIFT HEIGHT SHOULD BE REDUCED IF SOIL WILL NOT STAND VERTICAL AS DIRECTED BY SCHNABEL FOUNDATION COMPANY'S FOREMAN. INSTALL TIMBER LAGGING BETWEEN THE SOLDIER BEAMS. LAGGING MAY EITHER BE PLACED ON THE FACE OF THE SOLDIER BEAM OR BEHIND THE FLANGE.
- CONTINUE EXCAVATION AND LAGGING TO AROUND TWO (2) FOOT BELOW TIEBACK ELEVATION AT TIEBACK PILES.
- INSTALL TIEBACKS IN ACCORDANCE WITH THE TIEBACK INSTALLATION PROCEDURE TO THE LENGTHS AND AT THE LOCATIONS SHOWN ON THE PLANS.
- TEST TIEBACKS IN ACCORDANCE WITH THE TIEBACK TESTING PROCEDURE. AT COMPLETION OF TESTING LOCK-OFF THE TIEBACKS.
- REPEAT STEPS 5 TO 8 FOR SECOND ROW OF TIEBACKS IF REQUIRED.
- CONTINUE EXCAVATION AND LAGGING TO WITHIN 4-FOOT OF TOP OF ROCK IN LOCATION OF TOE TIES OR ROCK DOWELS.
- INSTALL TOE TIES AND/OR ROCK DOWELS.
- CONTINUE EXCAVATION TO SUBGRADE, LAGGING TO TOP OF ROCK. TIEBACK INSTALLATION PROCEDURE

- INSTALL TIEBACKS TO THE LENGTH AND AT THE LOCATIONS SHOWN ON THE PLANS. SFC MAY INSTALL TIEBACK TENDONS WITH REGROUT TUBES TO ALLOW ANCHORS TO BE REGROUTED. TIEBACK INSTALLATION PROCEDURE SHALL BE AS FOLLOWS:
 - INSTALL TIEBACKS USING CONCENTRIC ROTARY DUPLEX DRILLING METHODS WITH AIR OR WATER FLUSHING OR DRIVEN CASING WITH A KNOCK-OFF POINT. USE OF A POLYMER OR SLURRY TO FACILITATE REMOVAL OF DRILL CUTTINGS IS ALSO PERMITTED. CASING IS NOT REQUIRED WHEN DRILLING BEDROCK.
 - INSERT TIEBACK TENDON INTO CASING. TENDON MAY BE INSTALLED BEFORE OR AFTER CASING IS FILLED WITH GROUT.
 - FILL CASING WITH GROUT USING TREMIE METHOD.
 - EXTRACT CASING MAKING SURE TO KEEP CASING FILLED WITH GROUT. ALTERNATELY, ANCHORS MAY BE PRESSURE GROUTED.
 - ALLOW ANCHORS TO CURE A MINIMUM OF FIVE (5) DAYS BEFORE TESTING AND LOCKING OFF.

INSTALLATION METHOD MAY BE ALTERED BASED ON ACTUAL CONDITIONS ENCOUNTERED.

- TEST TIEBACKS ACCORDING TO TIEBACK TESTING PROCEDURE. AT COMPLETION OF TESTING, LOCK-OFF THE TIEBACKS.

TIEBACK TESTING

- A TOTAL OF 10% OF THE TIEBACKS WILL BE PERFORMANCE TESTED. PERFORMANCE TESTS WILL BE PERFORMED ON THE FIRST THREE (3) TIEBACKS INSTALLED, WHENEVER THE SOIL /ROCK CONDITIONS CHANGE, AND AT THE ENGINEER'S DISCRETION. ALL REMAINING ANCHORS SHALL BE PROOF TESTED.

THE SEQUENCE OF LOAD APPLICATION FOR THE PERFORMANCE TEST SHALL BE AS FOLLOWS:

- (AL) 0.25P
- (AL) 0.25P 0.50P
- (AL) 0.25P 0.50P 0.75P
- (AL) 0.25P 0.50P 0.75P 1.00P
- (AL) 0.25P 0.50P 0.75P 1.00P 1.20P
- (AL) 0.25P 0.50P 0.75P 1.00P 1.20P 1.33P (Max. Test Load; HOLD FOR 60 MINUTES)
- (AL) ADJUST TO LOCK-OFF LOAD (0.75 P)
- LIFT OFF TO VERIFY LOCK-OFF LOAD.

THE SEQUENCE OF LOAD APPLICATION FOR THE PROOF TEST SHALL BE AS FOLLOWS:

- (AL) 0.25P 0.50P 0.75P 1.00P 1.20P (Max. Test Load, HOLD FOR 10 MINUTES)
- (AL) ADJUST TO LOCK-OFF LOAD (0.75 P)
- LIFT OFF TO VERIFY LOCK-OFF LOAD

AL = ALIGNMENT LOAD
P = DESIGN LOAD

EACH LOAD INCREMENT, EXCEPT THE MAXIMUM TEST LOAD, SHALL BE HELD LONG ENOUGH TO OBTAIN A MOVEMENT READING.

- THE TIEBACKS SHALL BE TESTED USING A CENTER HOLE JACK WITH A CALIBRATED PRESSURE GAUGE CAPABLE OF READING TO AN ACCURACY OF 100 PSI. LOAD CELLS SHOULD BE INSTALLED ON TWO TIEBACKS IN EACH ROW OF TIES TO MONITOR TIEBACK LOADS DURING EXCAVATION. LOAD CELL READINGS SHALL TAKE PLACE ON A DAILY BASIS (MINIMUM), WHENEVER EXCAVATION CHANGES ARE MADE WITHIN VICINITY OF EACH LOAD CELL, OR AS DIRECTED BY THE ENGINEER.
- MOVEMENT MEASUREMENTS SHALL BE TAKEN AT THE ALIGNMENT LOAD (AL), USED TO SEAT THE ANCHOR AND JACKING CHAIR ASSEMBLY (NOT TO EXCEED 5 PERCENT OF THE DESIGN LOAD (P)), AND AT EACH LOAD INCREMENT. MOVEMENT READINGS SHALL BE TAKEN USING AN AMES DIAL GAUGE CAPABLE OF READING TO .001". THE PRESSURE IN THE TEST JACK SHALL BE MAINTAINED DURING ALL LOAD HOLDS.
- THE MAXIMUM TEST LOAD SHALL BE HELD FOR TEN (10) MINUTES. THE MOVEMENT SHALL BE RECORDED AT 1, 2, 3, 4, 5, 6 AND 10 MINUTES. IF THE TOTAL MOVEMENT BETWEEN THE 1 AND 10 MINUTE READING EXCEEDS 0.04", THE TEST LOAD SHALL BE HELD FOR AN ADDITIONAL 50 MINUTES. TOTAL MOVEMENTS SHALL BE RECORDED AT 15, 20, 25, 30, 45 AND 60 MINUTES.
- AN ANCHOR SHALL BE CONSIDERED ACCEPTABLE IF IT MEETS OR EXCEEDS THE FOLLOWING CRITERIA:
 - THE TIEBACK DEVELOPS THE MAXIMUM TEST LOAD WITHOUT CONTINUOUS LOSS OF JACK PRESSURE.
 - THE TOTAL ELASTIC MOVEMENT OBTAINED FROM A PERFORMANCE TEST EXCEEDS 80 PERCENT OF THE THEORETICAL ELASTIC ELONGATION OF THE FREE STRESSING AND UNBONDED ANCHOR LENGTHS.

THE TOTAL MOVEMENT OBTAINED FROM A PROOF TEST, MEASURED BETWEEN 50 PERCENT OF THE DESIGN LOAD AND THE MAXIMUM TEST LOAD EXCEEDS 80 PERCENT OF THE THEORETICAL ELASTIC ELONGATION OF THE FREE STRESSING AND UNBONDED ANCHOR LENGTHS FOR THE RESPECTIVE LOAD RANGE.

LIST OF DRAWINGS

SFC-1	NOTES/TITLE SHEET
SFC-2	PLAN VIEW - PHASE 1
SFC-3	PLAN VIEW - PHASE 2
SFC-4	ELEVATIONS
SFC-5	SUPPORT AT SARGENT BROOK
SFC-6	SECTIONS
SFC-7	DETAILS

MATERIALS

- CENTRALIZERS:** CENTRALIZERS, WHERE REQUIRED, SHALL BE FABRICATED FROM ANY MATERIAL EXCEPT WOOD WHICH IS NON-DETRIMENTAL TO THE PRE-STRESSED STEEL BAR. THE CENTRALIZER SHALL POSITION THE ANCHOR IN THE DRILL HOLE SO A MINIMUM OF 0.5 INCH OF GROUT OR CONCRETE COVER IS PROVIDED. SPACE CENTRALIZERS AT MAXIMUM 10-FOOT INTERVALS.
- GROUT:** GROUT SHALL BE NEAT CEMENT, WITH A MAXIMUM WATER/CEMENT RATIO OF AROUND 0.5 (5 TO 6 GALLONS OF WATER TO ONE 94 LB SACK OF CEMENT) BY WEIGHT. FX-32 ADMIXTURE MAY BE USED TO INCREASE STRENGTH AND REDUCE SHRINKAGE. OTHER ADMIXTURES MAY ALSO BE USED. CEMENT SHALL BE ASTM C-150, TYPE I, II, OR III.
- TIEBACK TENDONS:** TIEBACKS SHALL BE:
 - GRADE 270 7-WIRE STRANDS CONFORMING TO ASTM A-416.
 - GRADE 150 ALL-THREAD BARS CONFORMING TO ASTM A-722.
- TIMBER LAGGING:** TIMBER LAGGING MAY CONSIST OF ANY SPECIES, ROUGH CUT, MIXED HARDWOOD, UNLESS OTHERWISE INDICATED. A GAP SHALL BE PROVIDED BETWEEN LIFTS OF LAGGING TO REDUCE HYDROSTATIC PRESSURES AND ALLOW BOARDS TO BE BACKFILLED. TIMBER LAGGING SHALL BE 3-INCH NOMINAL THICKNESS.
- BEARING PLATE AND WEDGE PLATE OR HEXAGONAL NUT:** STEEL BEARING PLATE AND WEDGE PLATE SHALL CONFORM TO ASTM A-36. HEXAGONAL NUT SHALL CONFORM TO ASTM A-325 OR BAR MANUFACTURER'S SPECIFICATIONS.
- SOLDIER PILES:** SOLDIER PILES SHALL BE GRADE 50 STEEL OR EQUIVALENT GRADE 36 (ASTM A-36). NEW OR USED STEEL MAY BE USED.
- STEEL SHEET PILES:** STEEL SHEET PILES SHALL CONFORM TO ASTM A-36.
- TOE TIES AND ROCK DOWELS:** TOE TIES AND ROCK DOWELS SHALL BE GRADE 75 ALL-THREAD BARS CONFORMING TO ASTM A615.



Harry W. Schnabel, P.E.
Vermont P.E. No. 7291

REVISIONS

NO	DATE	DESCRIPTION
1	4/21/03	REVIEW COMMENTS/GEN. REVISIONS


Schnabel
Foundation Company

Engineers and Contractors
200 Turnpike Road
Southborough, Massachusetts
Atlanta • Denver • Chicago
Houston • Los Angeles • Philadelphia
San Francisco • Washington D.C.


Excavation Support Notes	
Route 9 Improvements	
Brattleboro, Vermont	
Date: 02/27/03	Job Number: 06-3392
Scale: N.T.S.	Drawing No: SFC-1

THESE DRAWINGS ARE THE PROPERTY OF SCHNABEL FOUNDATION COMPANY AND MAY NOT BE USED, COPIED, OR ALTERED, WITHOUT WRITTEN PERMISSION FROM SCHNABEL FOUNDATION COMPANY.

COPYRIGHT 2003 SCHNABEL FOUNDATION COMPANY

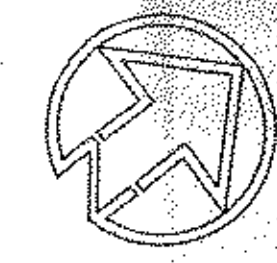

PROPOSED
MSE WALL
B.O.E.EL.262
(BY OTHERS)

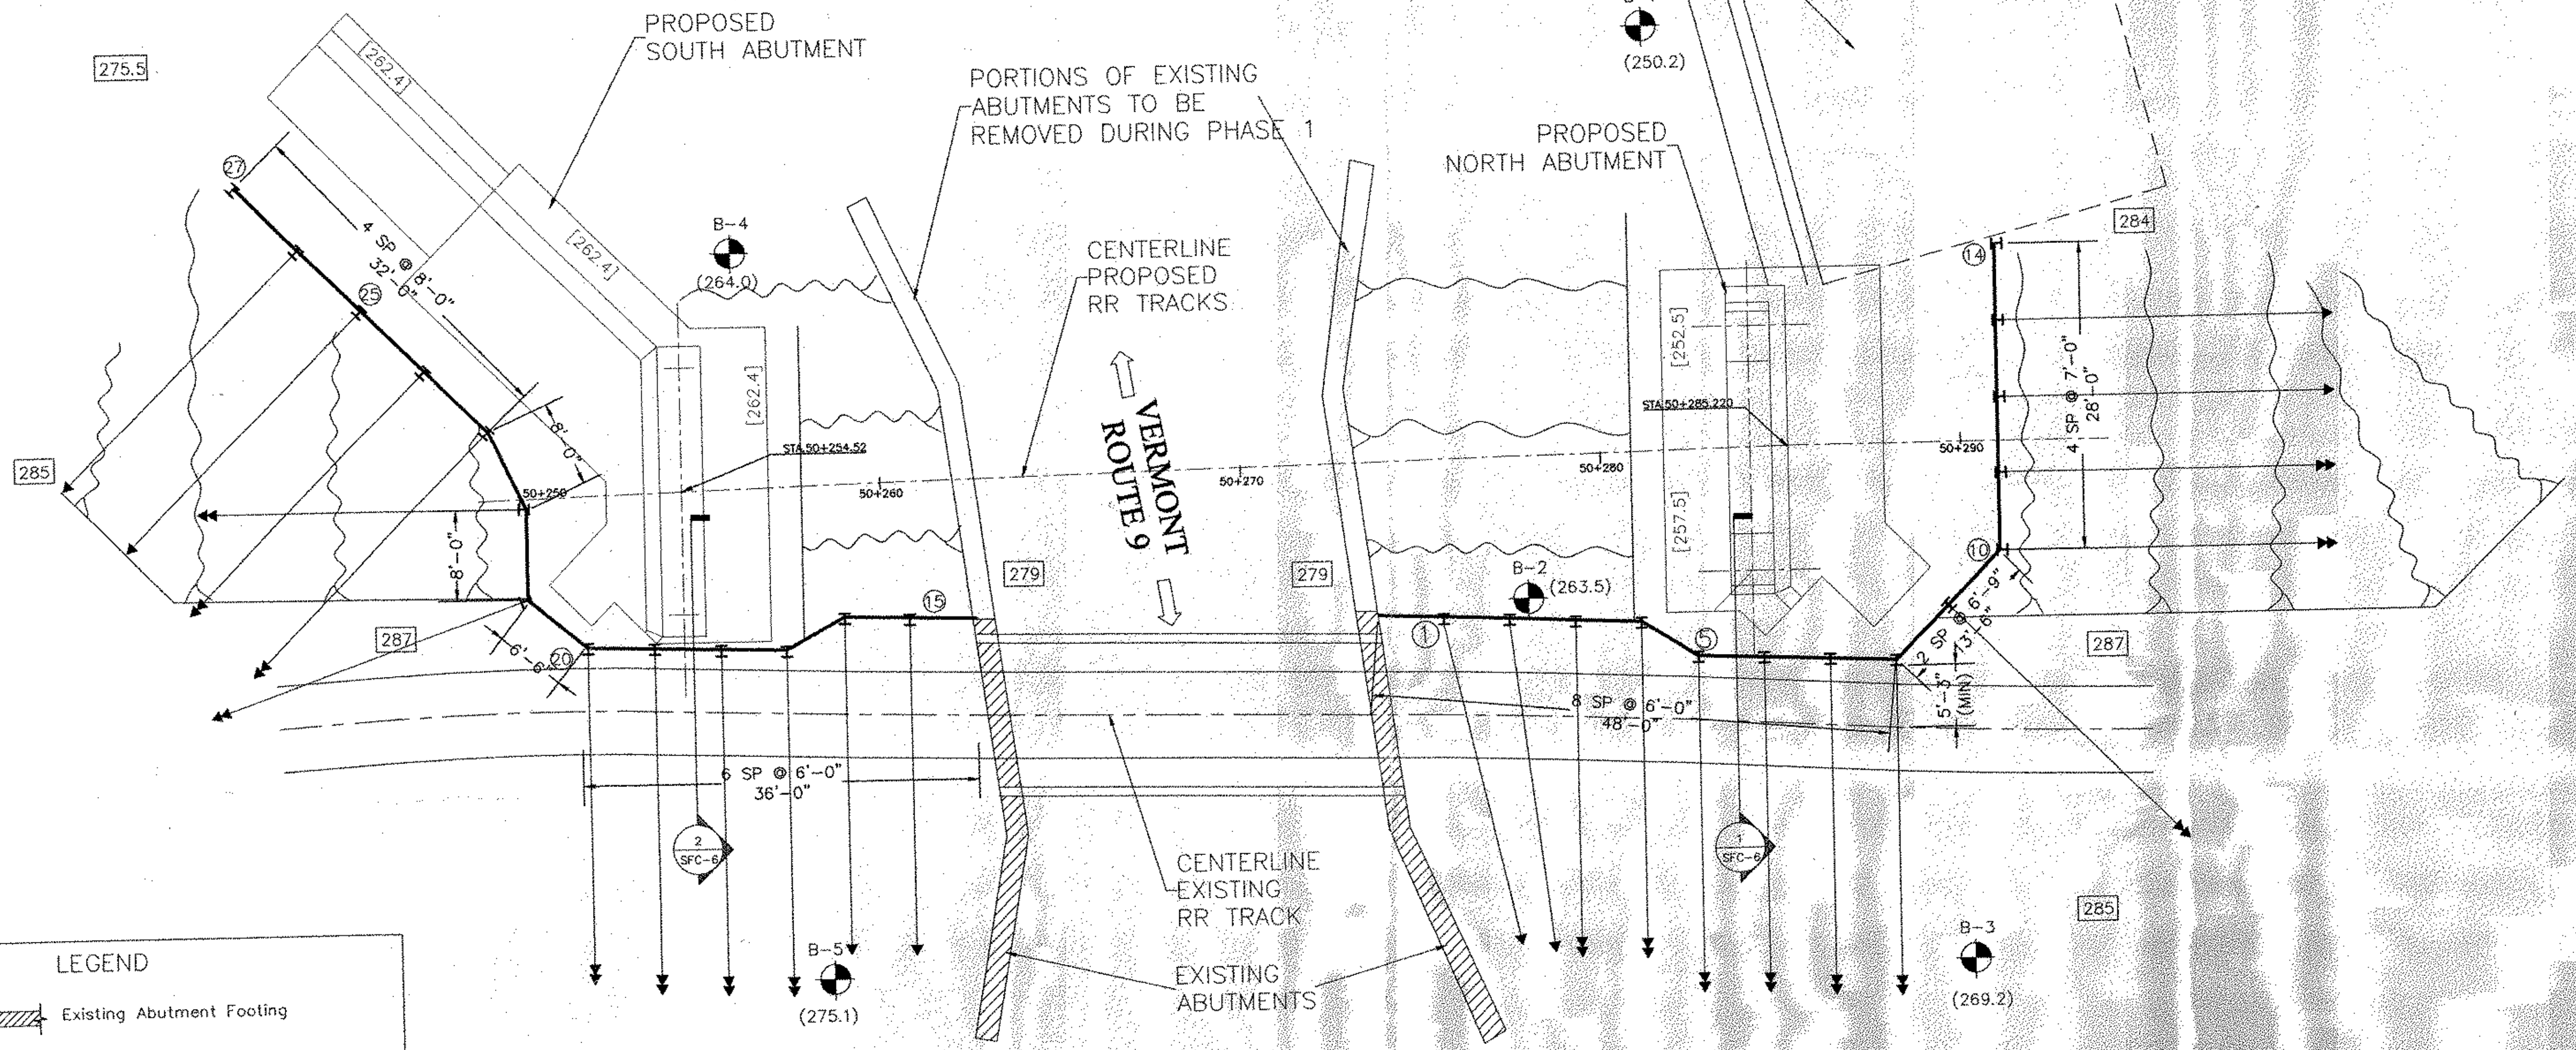

LEGEND

- Existing Abutment Footing
- Proposed Abutment Footing
- [262.4] Bottom of proposed footing elevation
- 289 Existing Grade Elevation
- Soldier Beam
Lagging
15 Soldier Beam Number
Tieback. Number of arrows indicates the number of tiers.
- B-4 Boring Number
Approximate Boring Location
264.0 Approximate Top of Bedrock Elevation

NOTE: FACE OF SOLDIER PILES SHALL NOT BE CLOSER THAN 5'3" FROM THE CENTERLINE OF THE TRACKS.

THESE DRAWINGS ARE THE PROPERTY OF SCHNABEL FOUNDATION COMPANY AND MAY NOT BE USED, COPIED, OR ALTERED, WITHOUT WRITTEN PERMISSION FROM SCHNABEL FOUNDATION COMPANY.
COPYRIGHT 2003 SCHNABEL FOUNDATION COMPANY

REVISIONS		
NO	DATE	DESCRIPTION
1	4/21/03	REVIEW COMMENTS/GEN. REVISIONS



Schnabel
Foundation Company

Engineers and Contractors
200 Turnpike Road
Southborough, Massachusetts
Atlanta • Denver • Chicago
Houston • Los Angeles • Philadelphia
San Francisco • Washington D.C.

Harry W. Schnabel, P.E.
Vermont P.E. No. 7291

Excavation Support Phase 1 - Plan View	
Route 9 Improvements	
Brattleboro, Vermont	
Date: 02/27/03	Job Number: 06-3392
Scale: 1/8"=1'-0"	Drawing No: SFC-2

176 57c

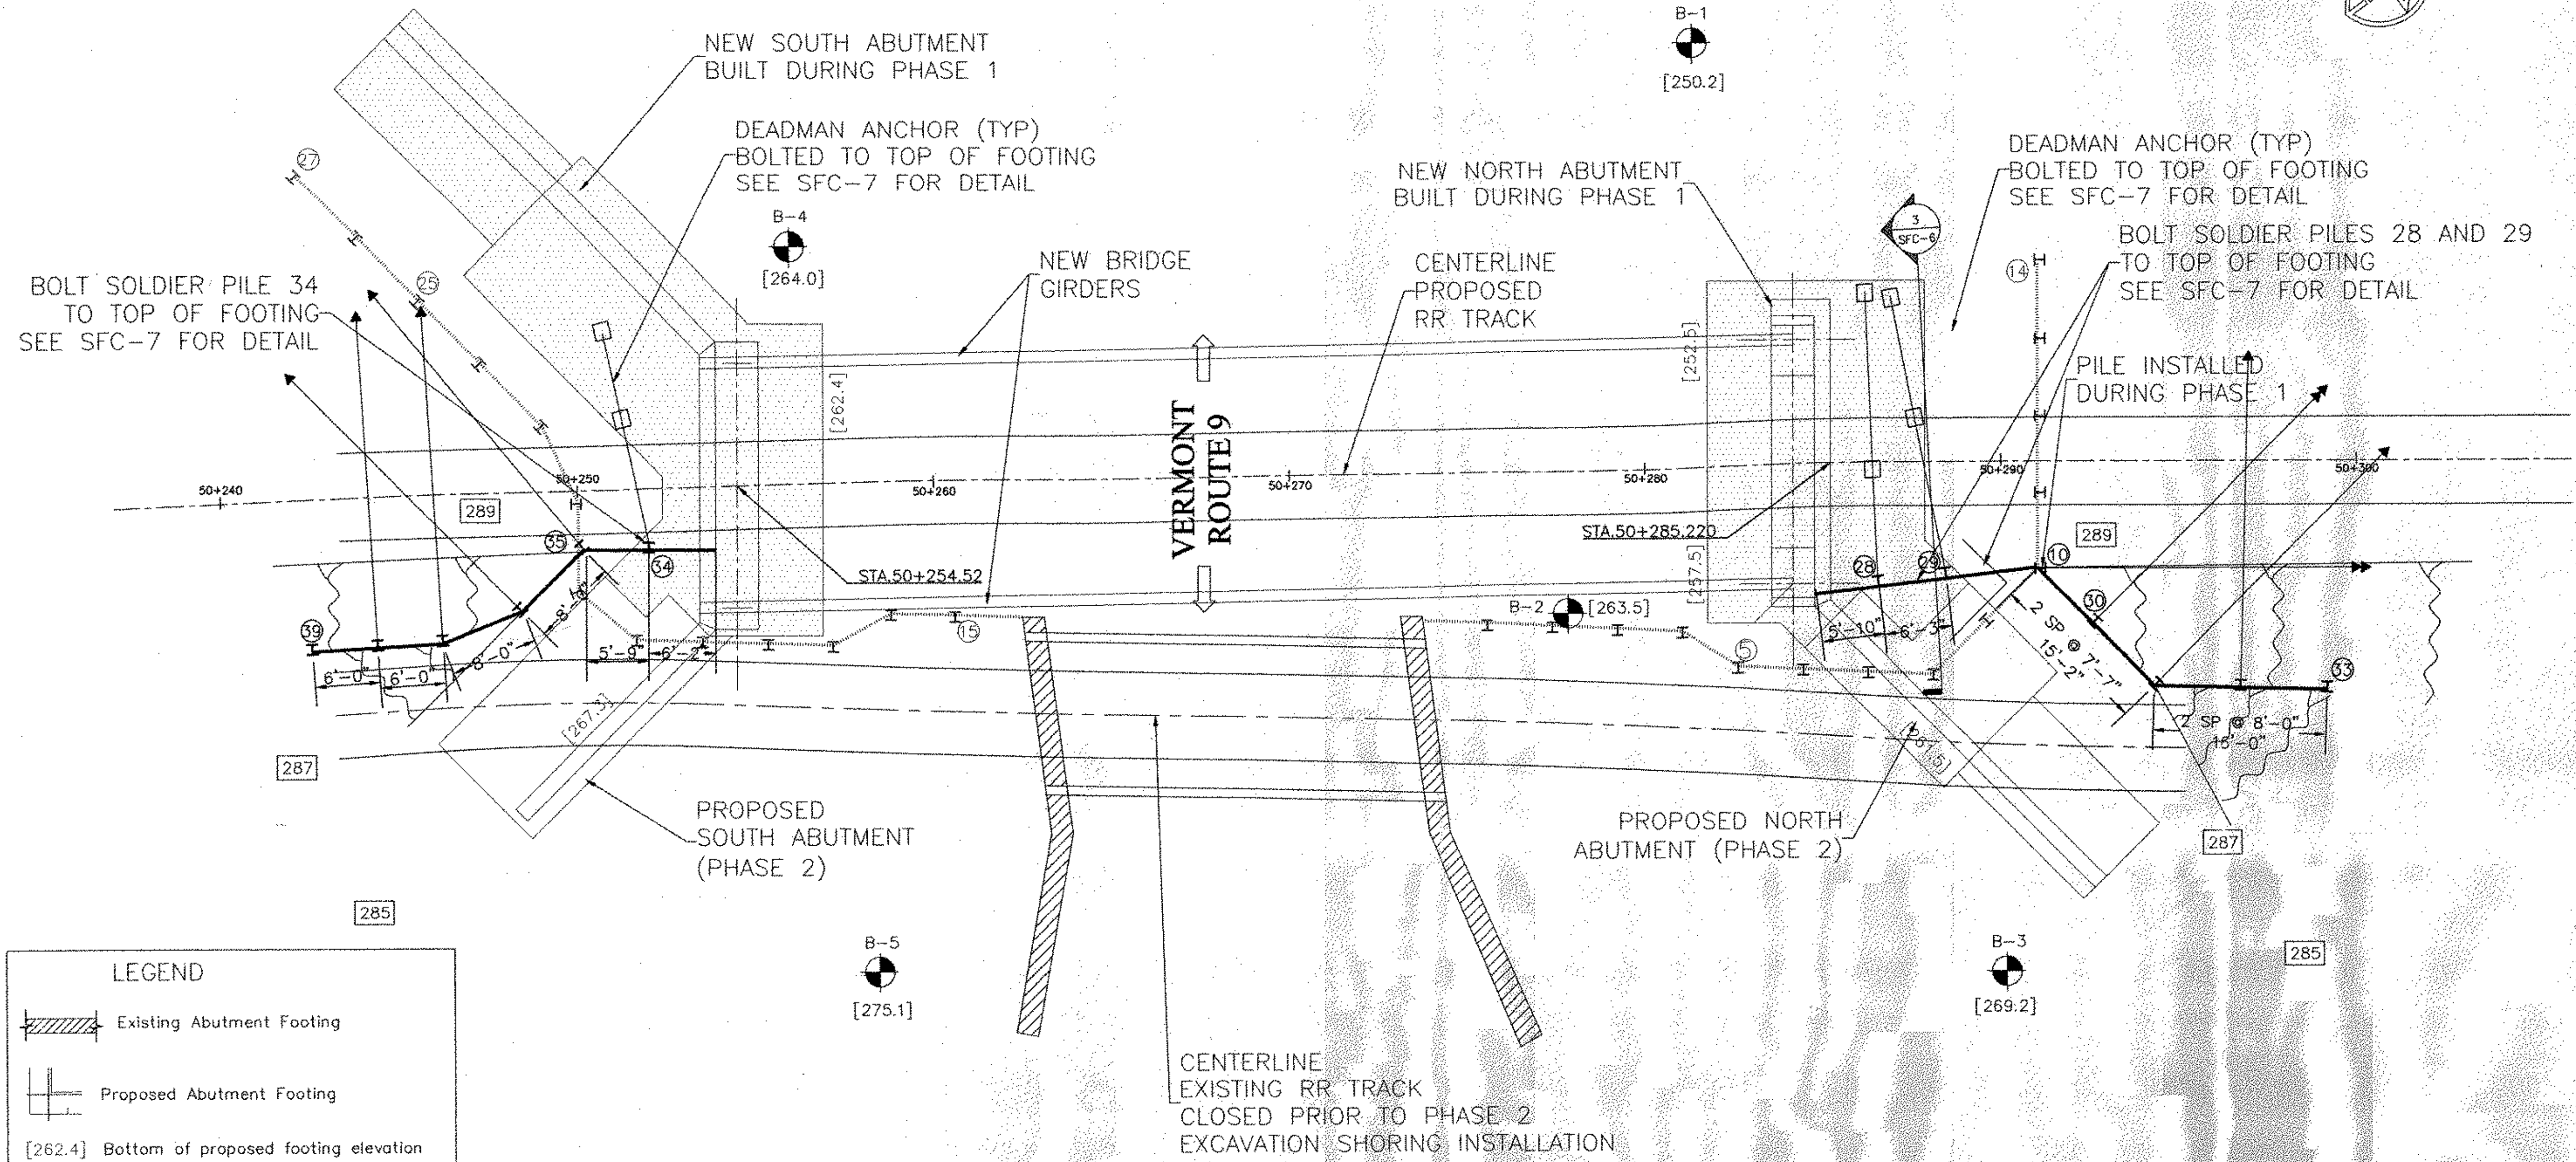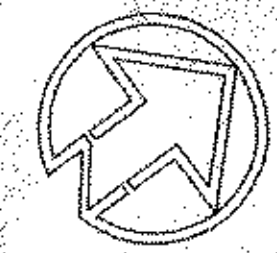

LEGEND

- Existing Abutment Footing
- Proposed Abutment Footing
- [262.4] Bottom of proposed footing elevation
- [289] Existing Grade Elevation
- Soldier Pile Lagging
Soldier Pile Number
Tieback. Number of arrows indicates the number of tiers.
- Phase I Soldier Piles and Lagging
- B-4 Boring Number
- Approximate Boring Location
- [264.0] Approximate Top of Bedrock Elevation

NOTE: PILES 28, 29, 34 WILL BE BOLTED TO TOP OF ABUTMENT FOOTING AFTER PHASE 1 IS COMPLETE.

NOTE: FACE OF SOLDIER PILES SHALL NOT BE CLOSER THAN 5'3" FROM THE CENTERLINE OF THE TRACKS.

THESE DRAWINGS ARE THE PROPERTY OF SCHNABEL FOUNDATION COMPANY AND MAY NOT BE USED, COPIED, OR ALTERED, WITHOUT WRITTEN PERMISSION FROM SCHNABEL FOUNDATION COMPANY.
COPYRIGHT 2003 SCHNABEL FOUNDATION COMPANY

REVISIONS		
NO	DATE	DESCRIPTION
1	03/28/03	ENGINEER'S REVIEW REVISION

Schnabel
Foundation Company


Engineers and Contractors
200 Turnpike Road
Southborough, Massachusetts
Atlanta • Denver • Chicago
Houston • Los Angeles • Philadelphia
San Francisco • Washington D.C.

Harry W. Schnabel, P.E.
Vermont P.E. No. 7291


Excavation Support Phase 2 - Plan View
Route 9 Improvements
Brattleboro, Vermont

Date: 02/27/03 Job Number: 06-3392
Scale: 1/8"=1'-0" Drawing No: SFC-3

177256

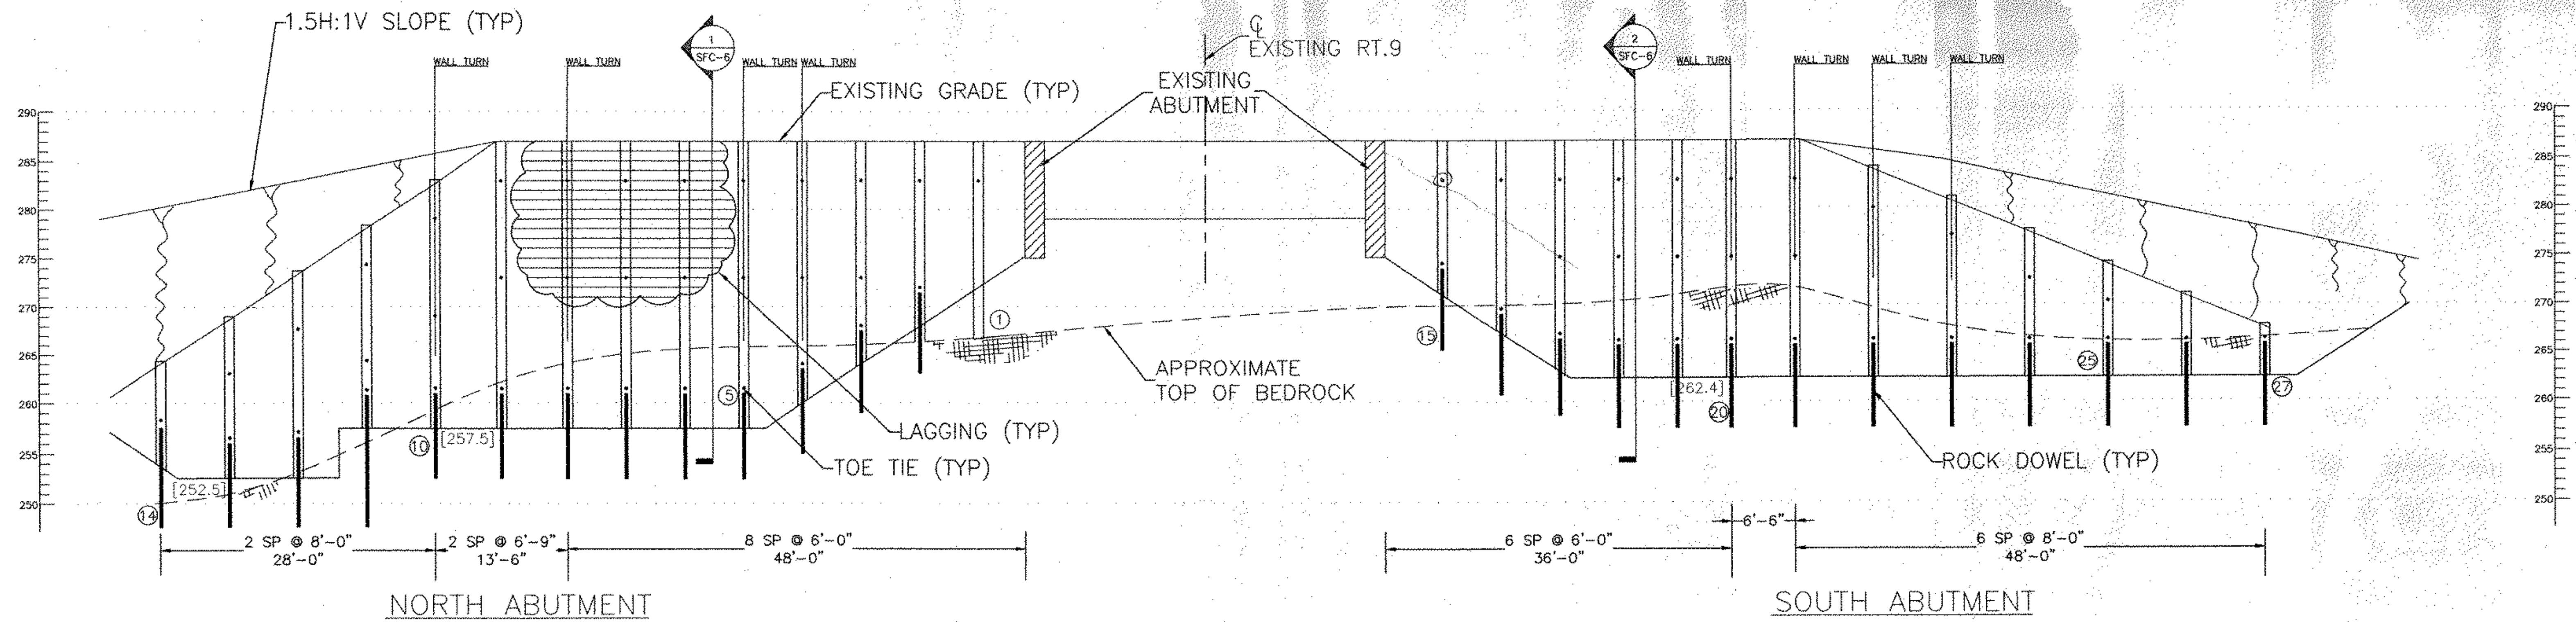


PHASE 1 EXCAVATION SUPPORT ELEVATION

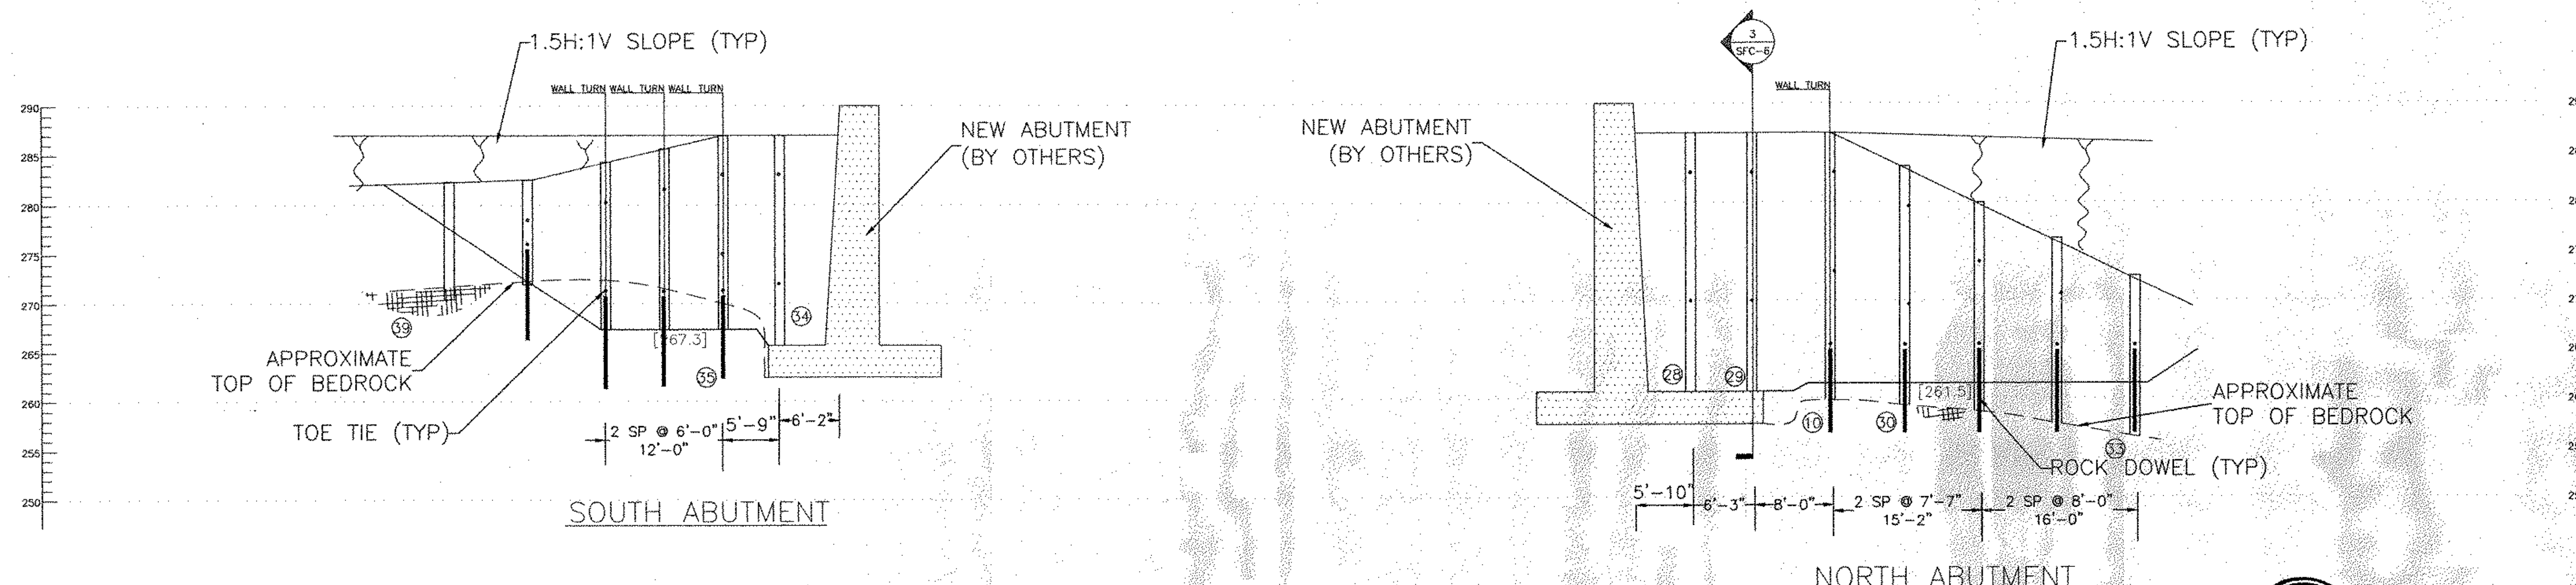

PHASE 2 EXCAVATION SUPPORT ELEVATION

NOTE:
 - ELEVATION VIEW SHOWS PILES IN WORST CASE SITUATION WHERE TOP OF ROCK IS LOCATED AT OR BELOW BOTTOM OF FOOTING. ACTUAL PILE WILL BE DRILLED TO TOP OF COMPETENT ROCK OR 5FT BELOW BOTTOM OF EXCAVATION, WHICHEVER IS HIGHER.
 - ROCK DOWEL AND TOE TIE ARE NOT REQUIRED IF BOTTOM OF PILE IS INSTALLED TO 5FT BELOW BOTTOM OF EXCAVATION.
 - ROCK DOWEL IS NOT REQUIRED IF BOTTOM OF PILE IS INSTALLED WITHIN 2FT OF BOTTOM OF EXCAVATION.
 - COORDINATE INSTALLATION OF LAGGING TO MINIMIZE OPEN CUT FACE AT TIME OF TRAIN PASSING.


 Harry W. Schnabel, P.E.
 Vermont P.E. No. 7291

REVISIONS			Excavation Support Phase 1, 2 - Elevations	
NO	DATE	DESCRIPTION		
1	4/21/03	REVIEW COMMENTS/GEN. REVISIONS	Route 9 Improvements	
			Brattleboro, Vermont	
Schnabel Foundation Company		Engineers and Contractors 200 Turnpike Road Southborough, Massachusetts Atlanta • Denver • Chicago Houston • Los Angeles • Philadelphia San Francisco • Washington D.C.	Date: 02/27/03	Job Number: 06-3392
			Scale: 1/8"=1'-0"	Drawing No: SFC-4



THESE DRAWINGS ARE THE PROPERTY OF SCHNABEL FOUNDATION COMPANY AND MAY NOT BE USED, COPIED, OR ALTERED, WITHOUT WRITTEN PERMISSION FROM SCHNABEL FOUNDATION COMPANY.
 COPYRIGHT 2003 SCHNABEL FOUNDATION COMPANY

178CAC



LEGEND


- 287 Existing Grade Elevation
- B-4 Boring Number
- Approximate Boring Location
- (264.0) Approximate Top of Bedrock Elevation

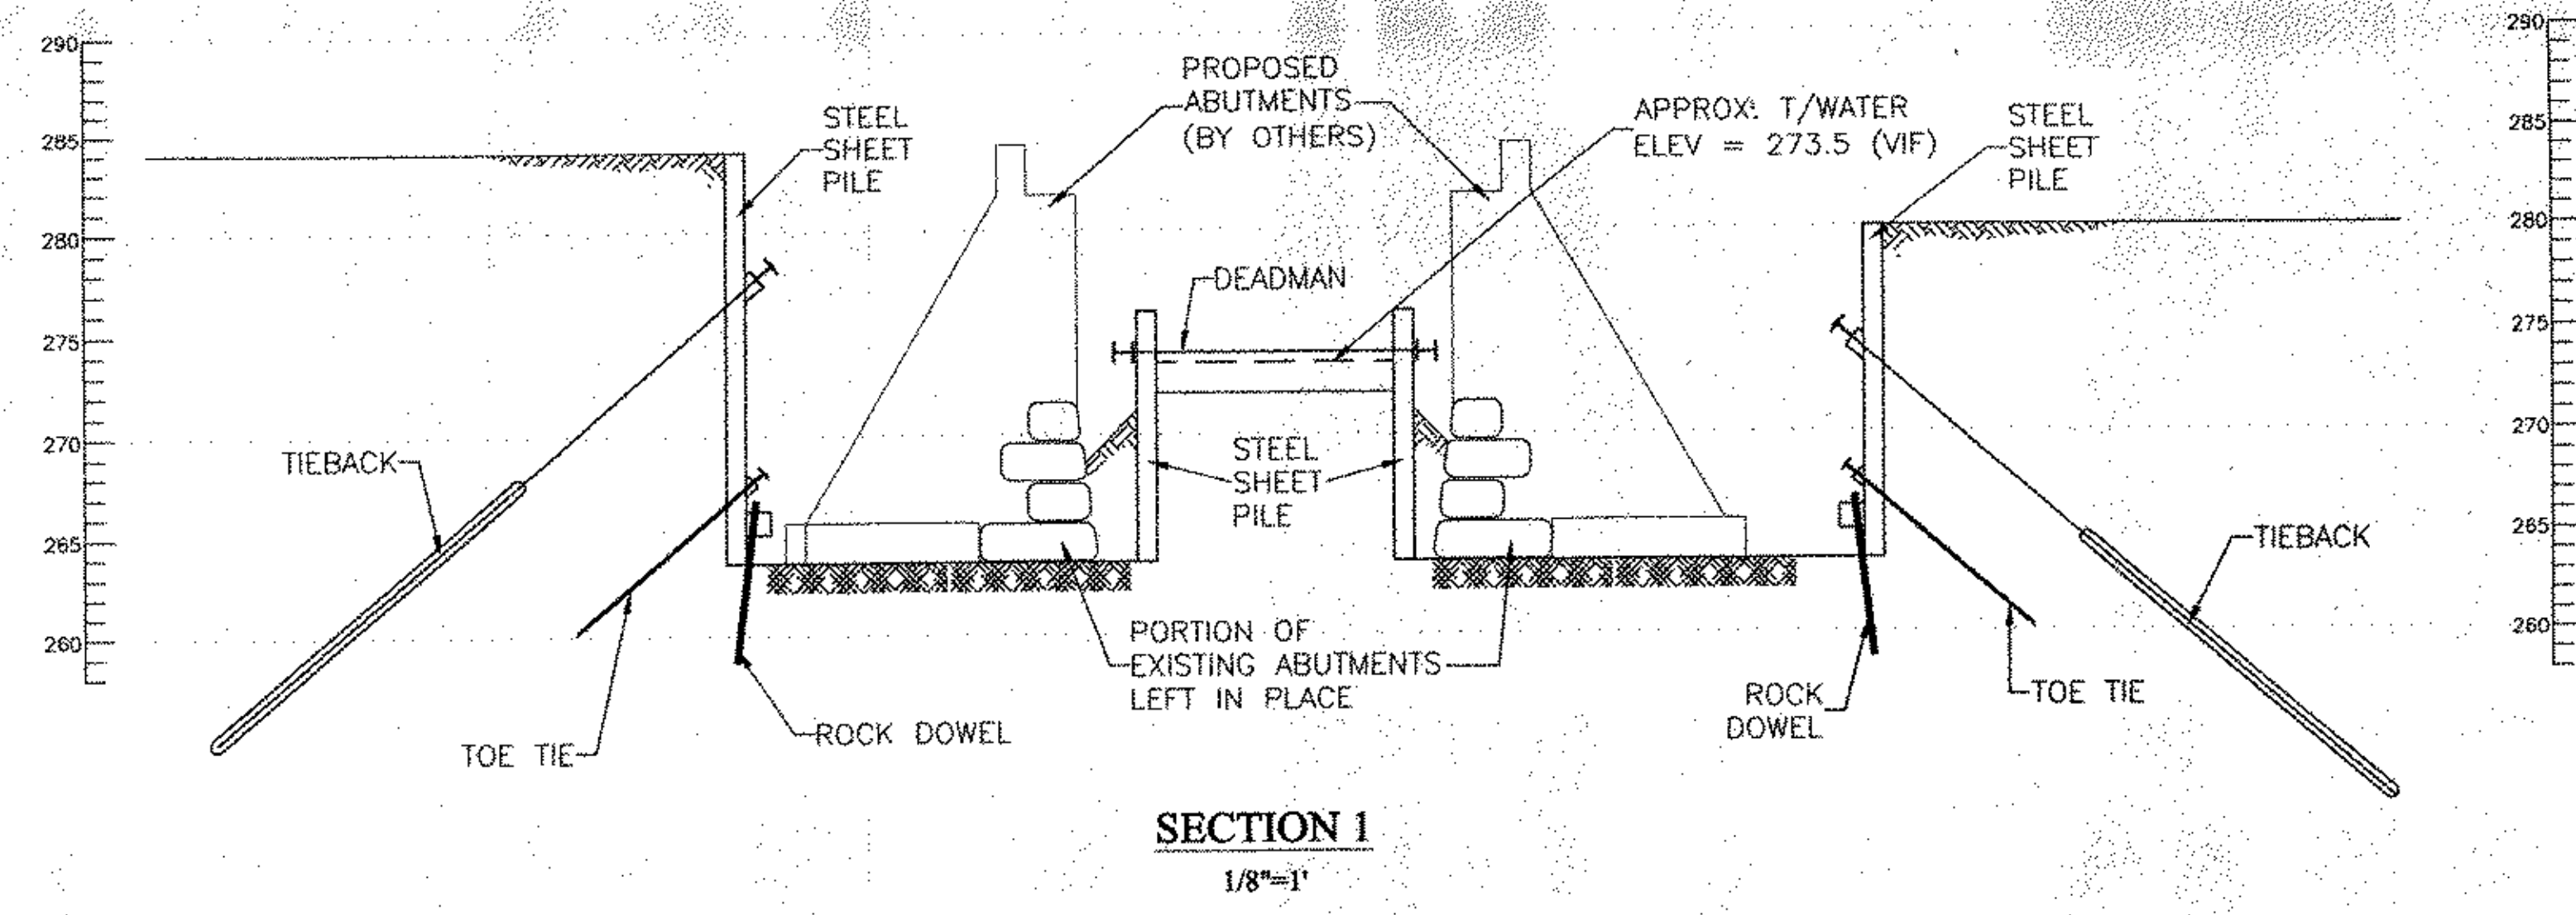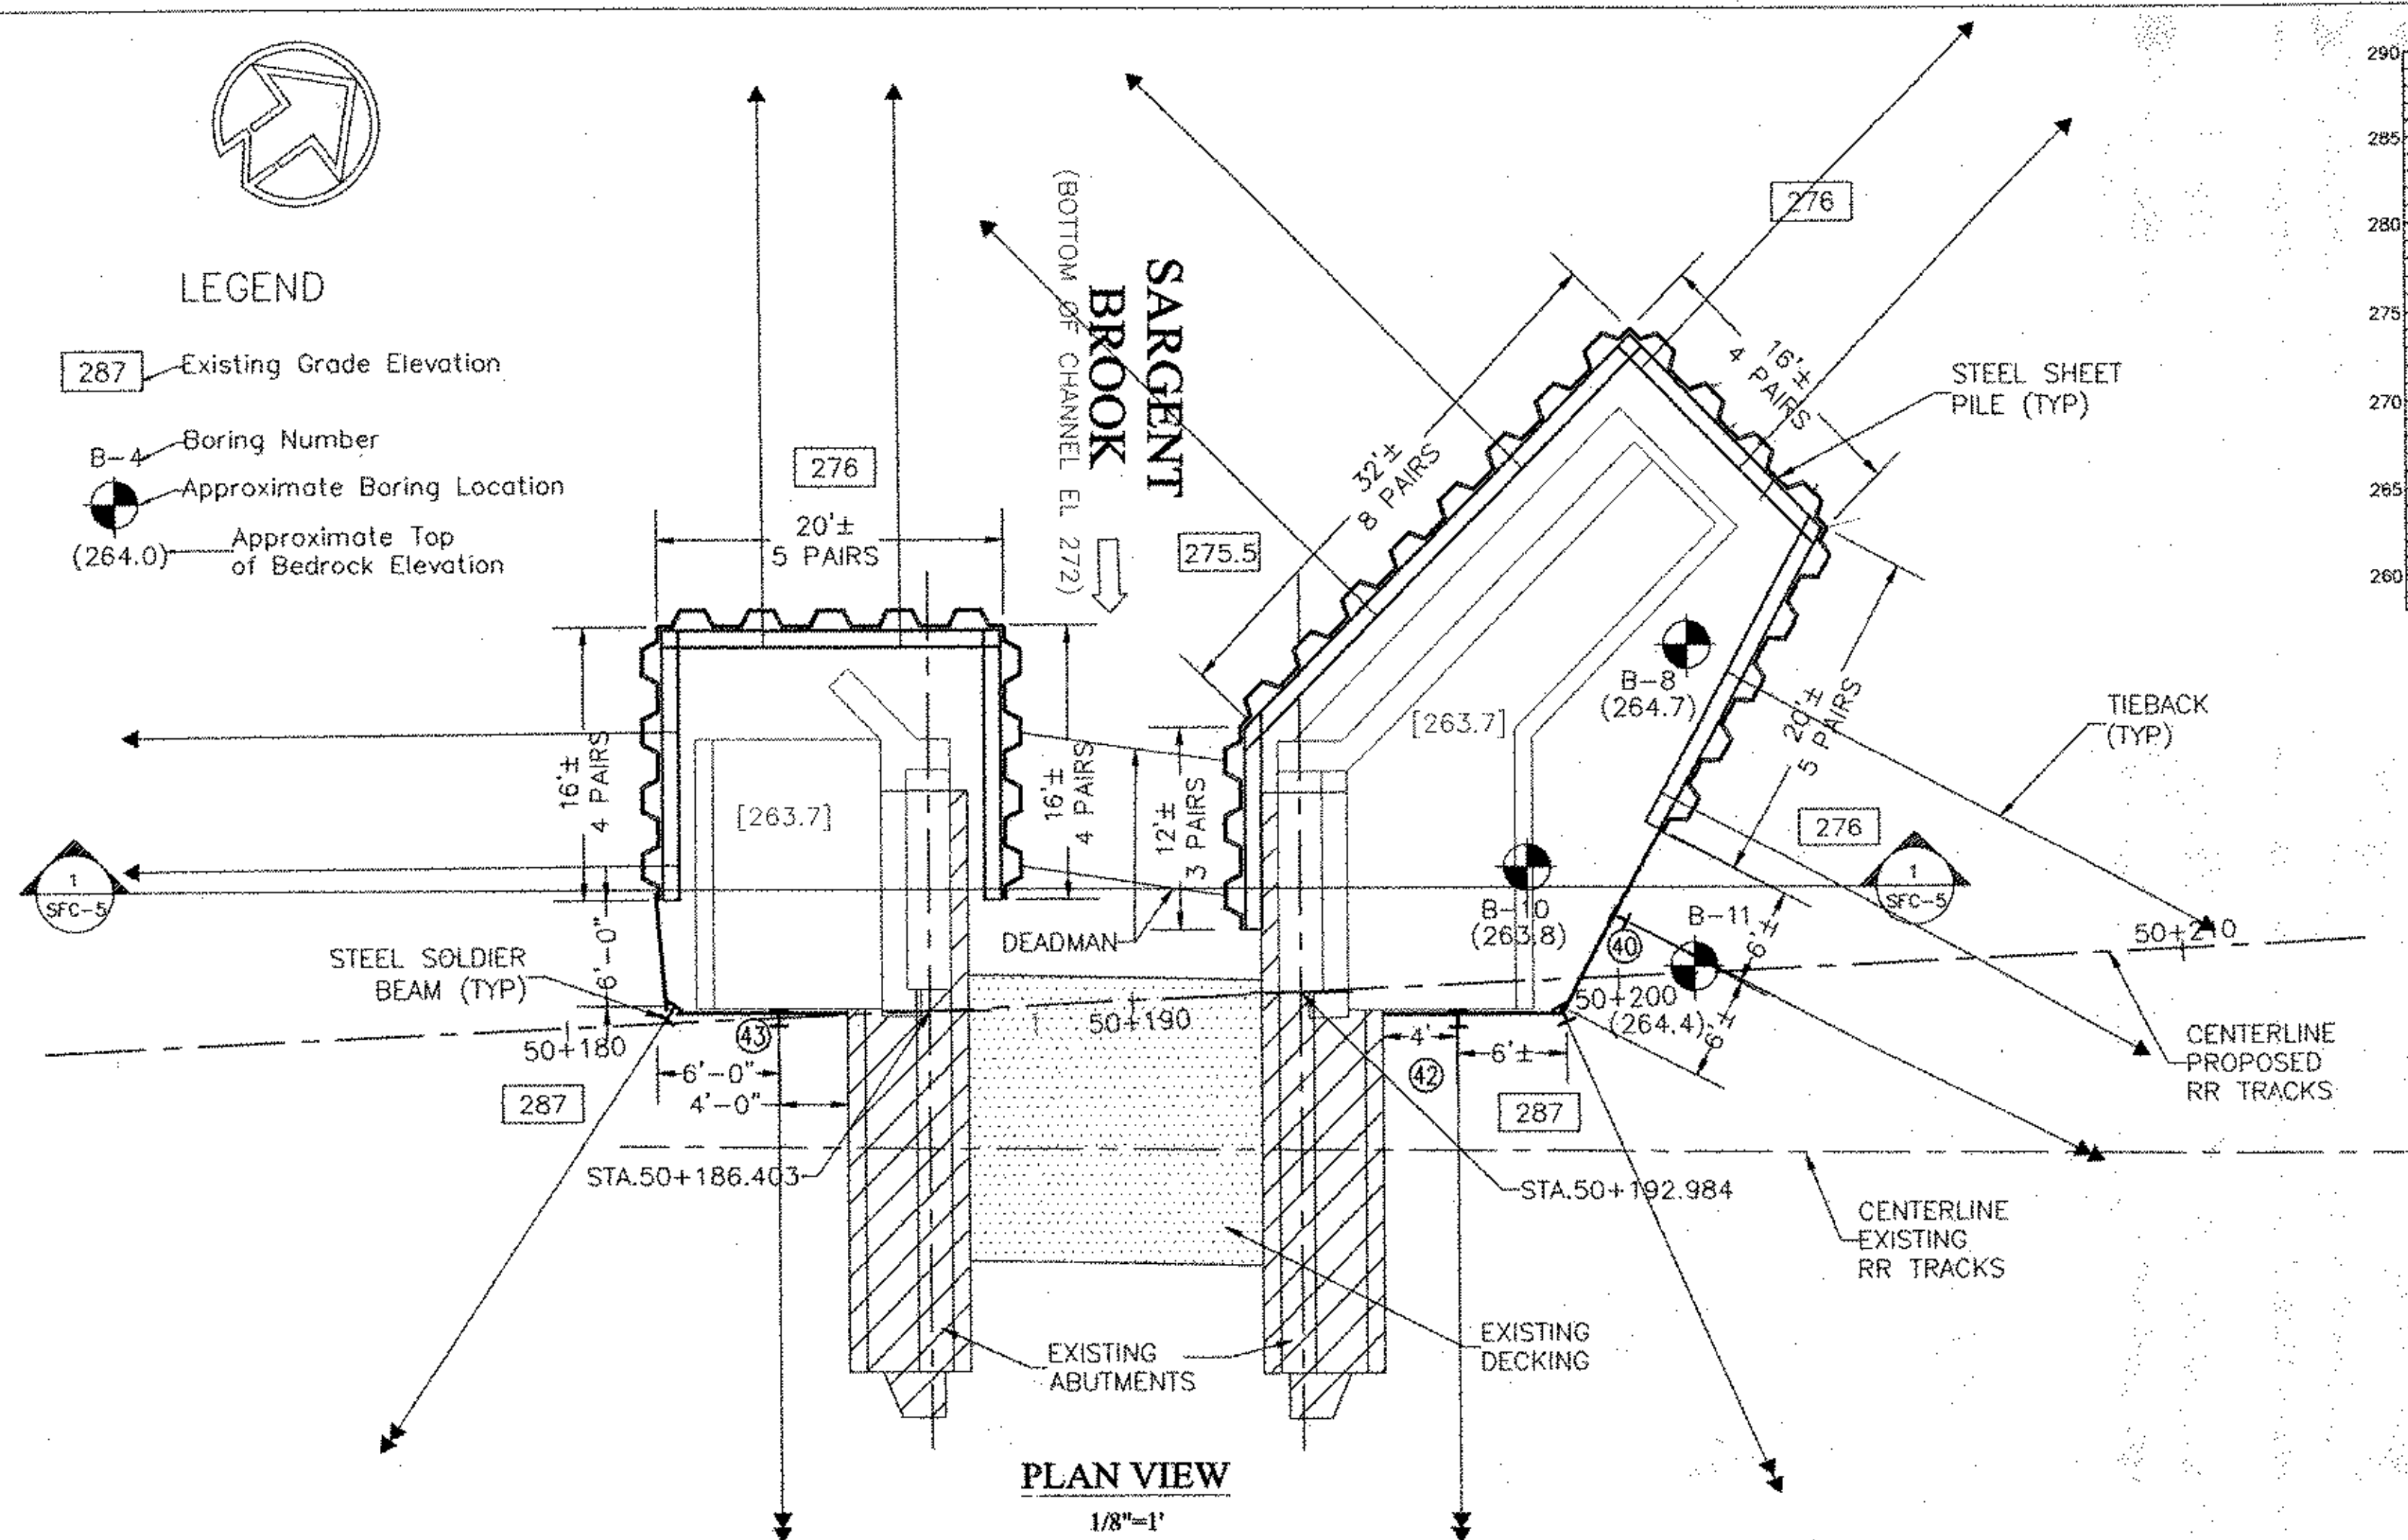

SOLDIER BEAM/SHEET PILES/TIEBACK/TOE TIE SCHEDULE

PILE NUMBER	NUMBER OF PILES	TOP ELEVATION (FT)	SUBGRADE ELEVATION (FT)	PILE ¹ LENGTH (FT)	PILE ² SIZE	H ₁ (FT)	H ₂ (FT)	TIEBACK ANGLE (DEG)	TIEBACK LOAD (KIPS)	UNBONDED LENGTH (FT)	BOND LENGTH ³ (FT)	BAR SIZE	NUMBER OF 0.6\"
40	1	284.8	263.7	21	2C15X33.9	4	7	40	50	15	10	1"	2
41-44	4	287	263.7	23	2C15X33.9	4	9	40	102	15	12	1 1/4"	3
SH 1-4	16 LF	282 - 276	263.7	12 - 19	PZ-22	4		40	73 (2 TIES)	15	10	1"	3
SH 5-9	20 LF	276	263.7	13	PZ-22	4		40	37 (2 TIES)	15	10	1"	2
SH 10-16	28 LF	276	263.7	13	PZ-22	4		DEADMAN	30 (2 TIES)			1"	
SH 17-28	48 LF	276	263.7	13	PZ-22	4		40	45 (4 TIES)	15	10	1"	2
SH 29-33	20 LF	282 - 276	263.7	12 - 19	PZ-22	4		40	91 (2 TIES)	15	10	1 1/4"	3

1. PILE LENGTH SHOWN IS FOR PLANNING PURPOSES ONLY. INSTALL PILES TO TOP OF BEDROCK OR 5FT BELOW BOTTOM OF EXCAVATION, WHICHEVER IS HIGHER.
2. SFC RESERVES THE RIGHT TO SUBSTITUTE ANY BEAM SIZE PROVIDED IT MEETS THE DESIGN REQUIREMENTS.
3. BOND LENGTH SHOWN IS FOR PLANNING PURPOSES ONLY. ACTUAL BOND LENGTH WILL BE DETERMINED IN FIELD BASED ON ACTUAL SOIL/ROCK CONDITIONS. ESTIMATE BOND LENGTH AS FOLLOWS: 2 KIPS/FT BONDED IN SOIL; 10 KIPS/FT BONDED IN ROCK. VERIFY WITH SFC ENGINEER PRIOR TO INSTALLING TENDON.

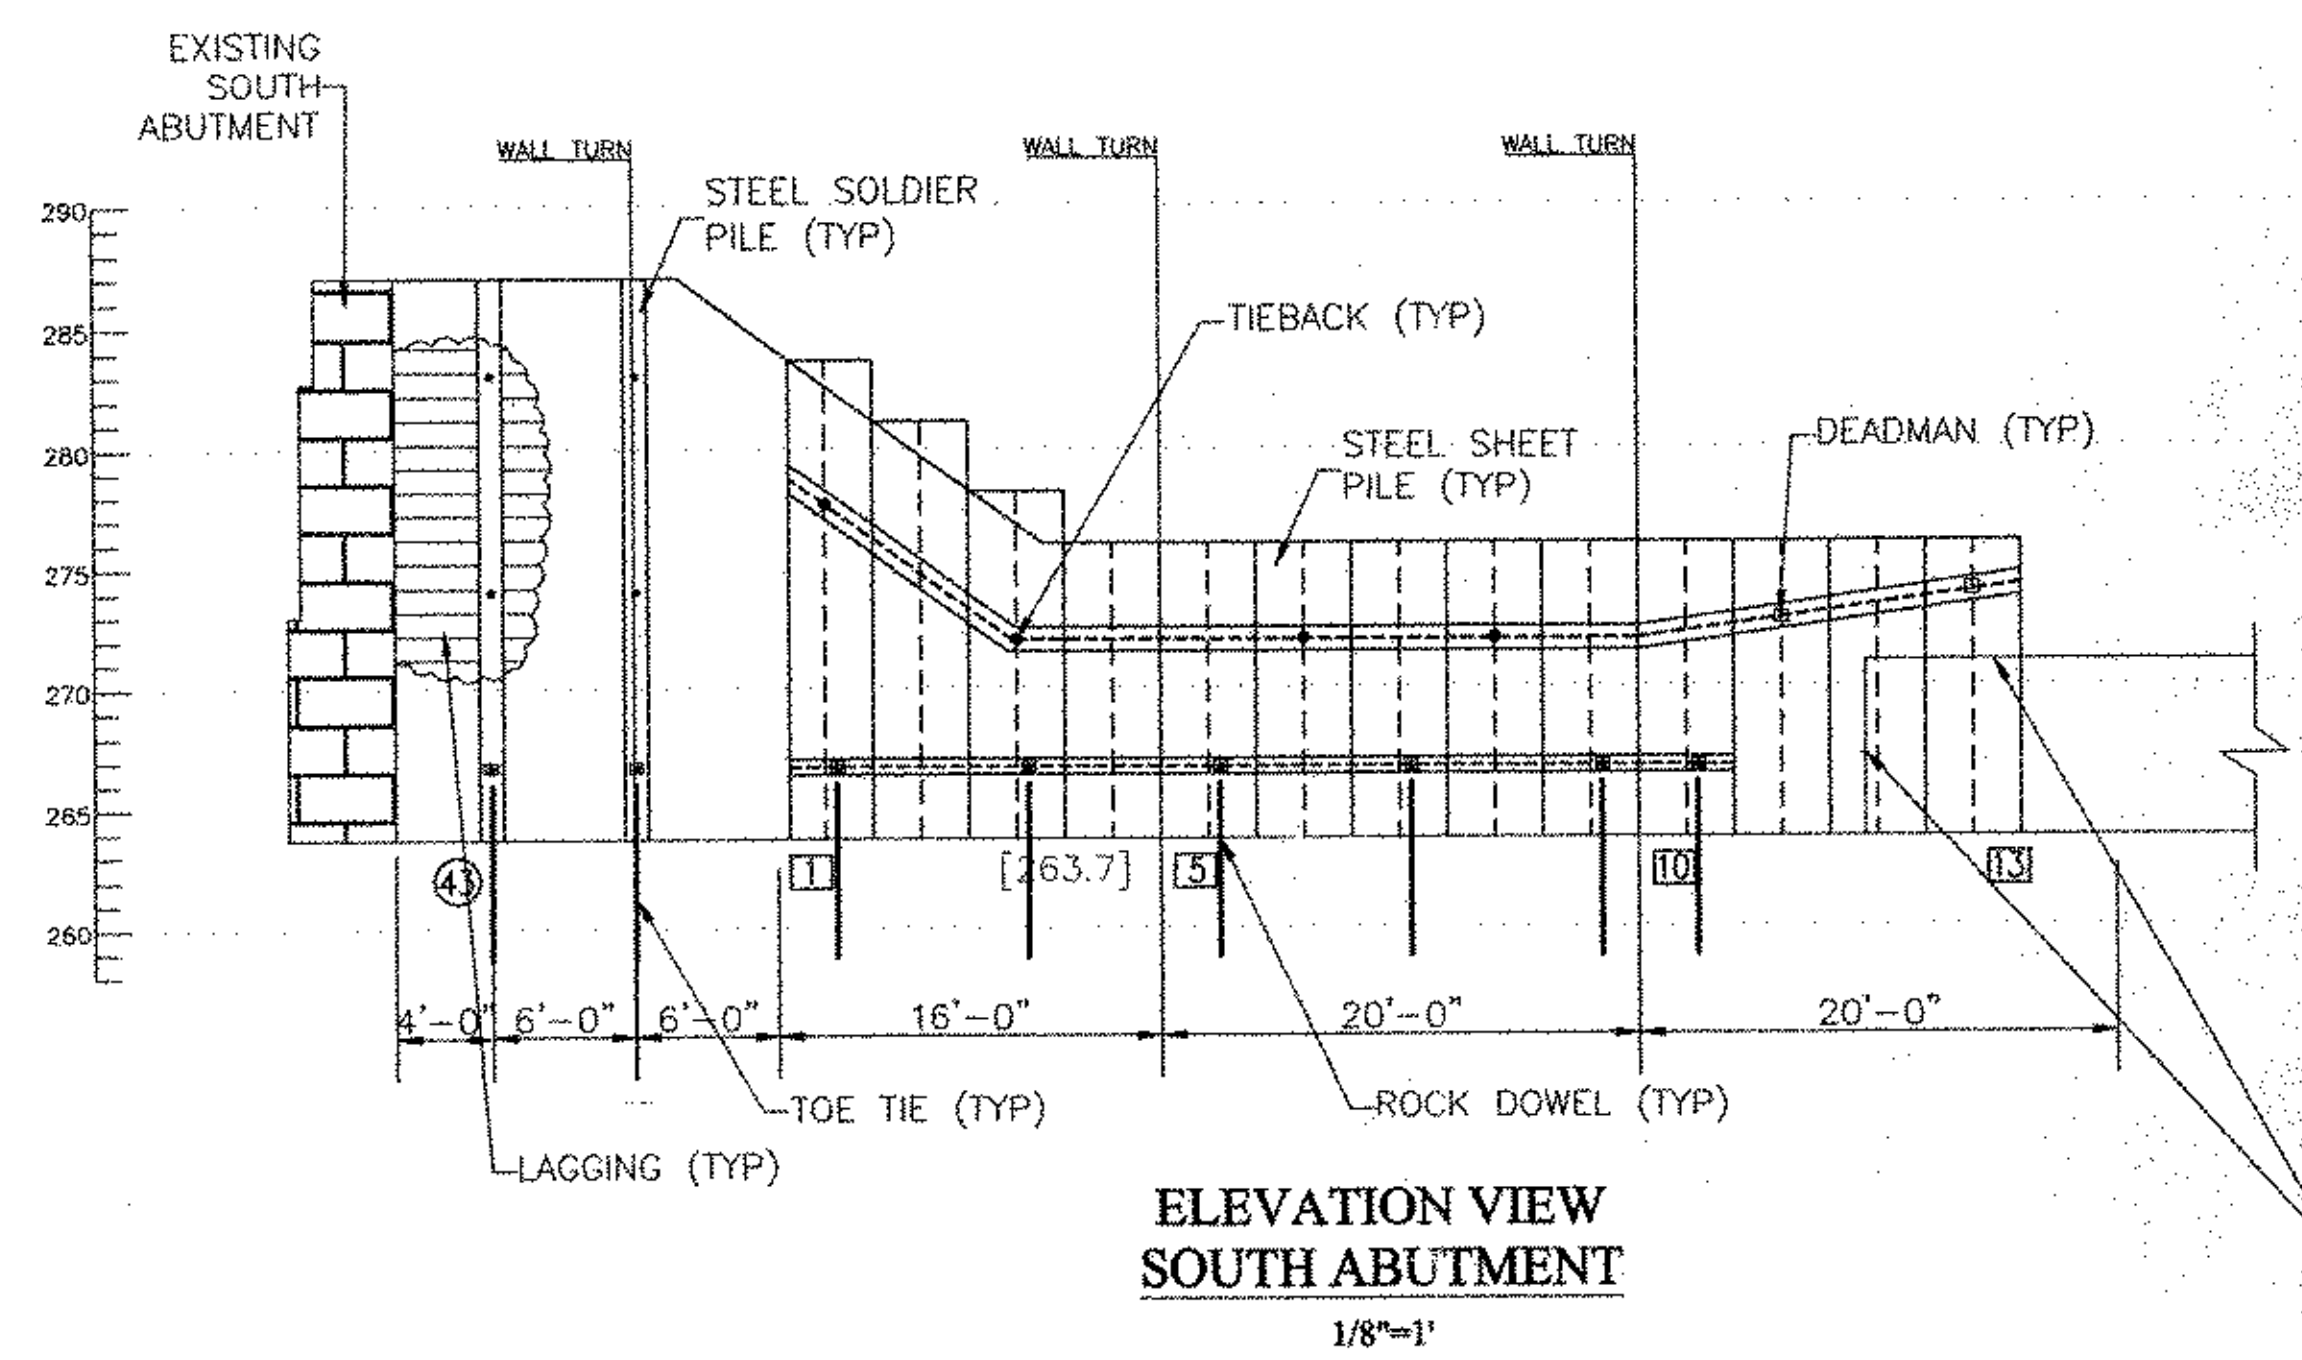

(B1)

Very loose dark brown and yellow brown, c-f Sand, some f-gravel and silt, trace organics


Loose, gray brown and yellow brown, c-f Sand to f-sand, trace to little gravel and silt.

Very loose to loose, gray brown to gray, c-f Sand to f-sand, trace to little gravel and silt. Encountered a 3-4" piece of wood at 13.5'

Loose gray, c-f Sand, little gravel and silt. Trace of wood

Compact gray brown, c-f Sand, trace to little gravel, trace silt

Bedrock - Phyllite

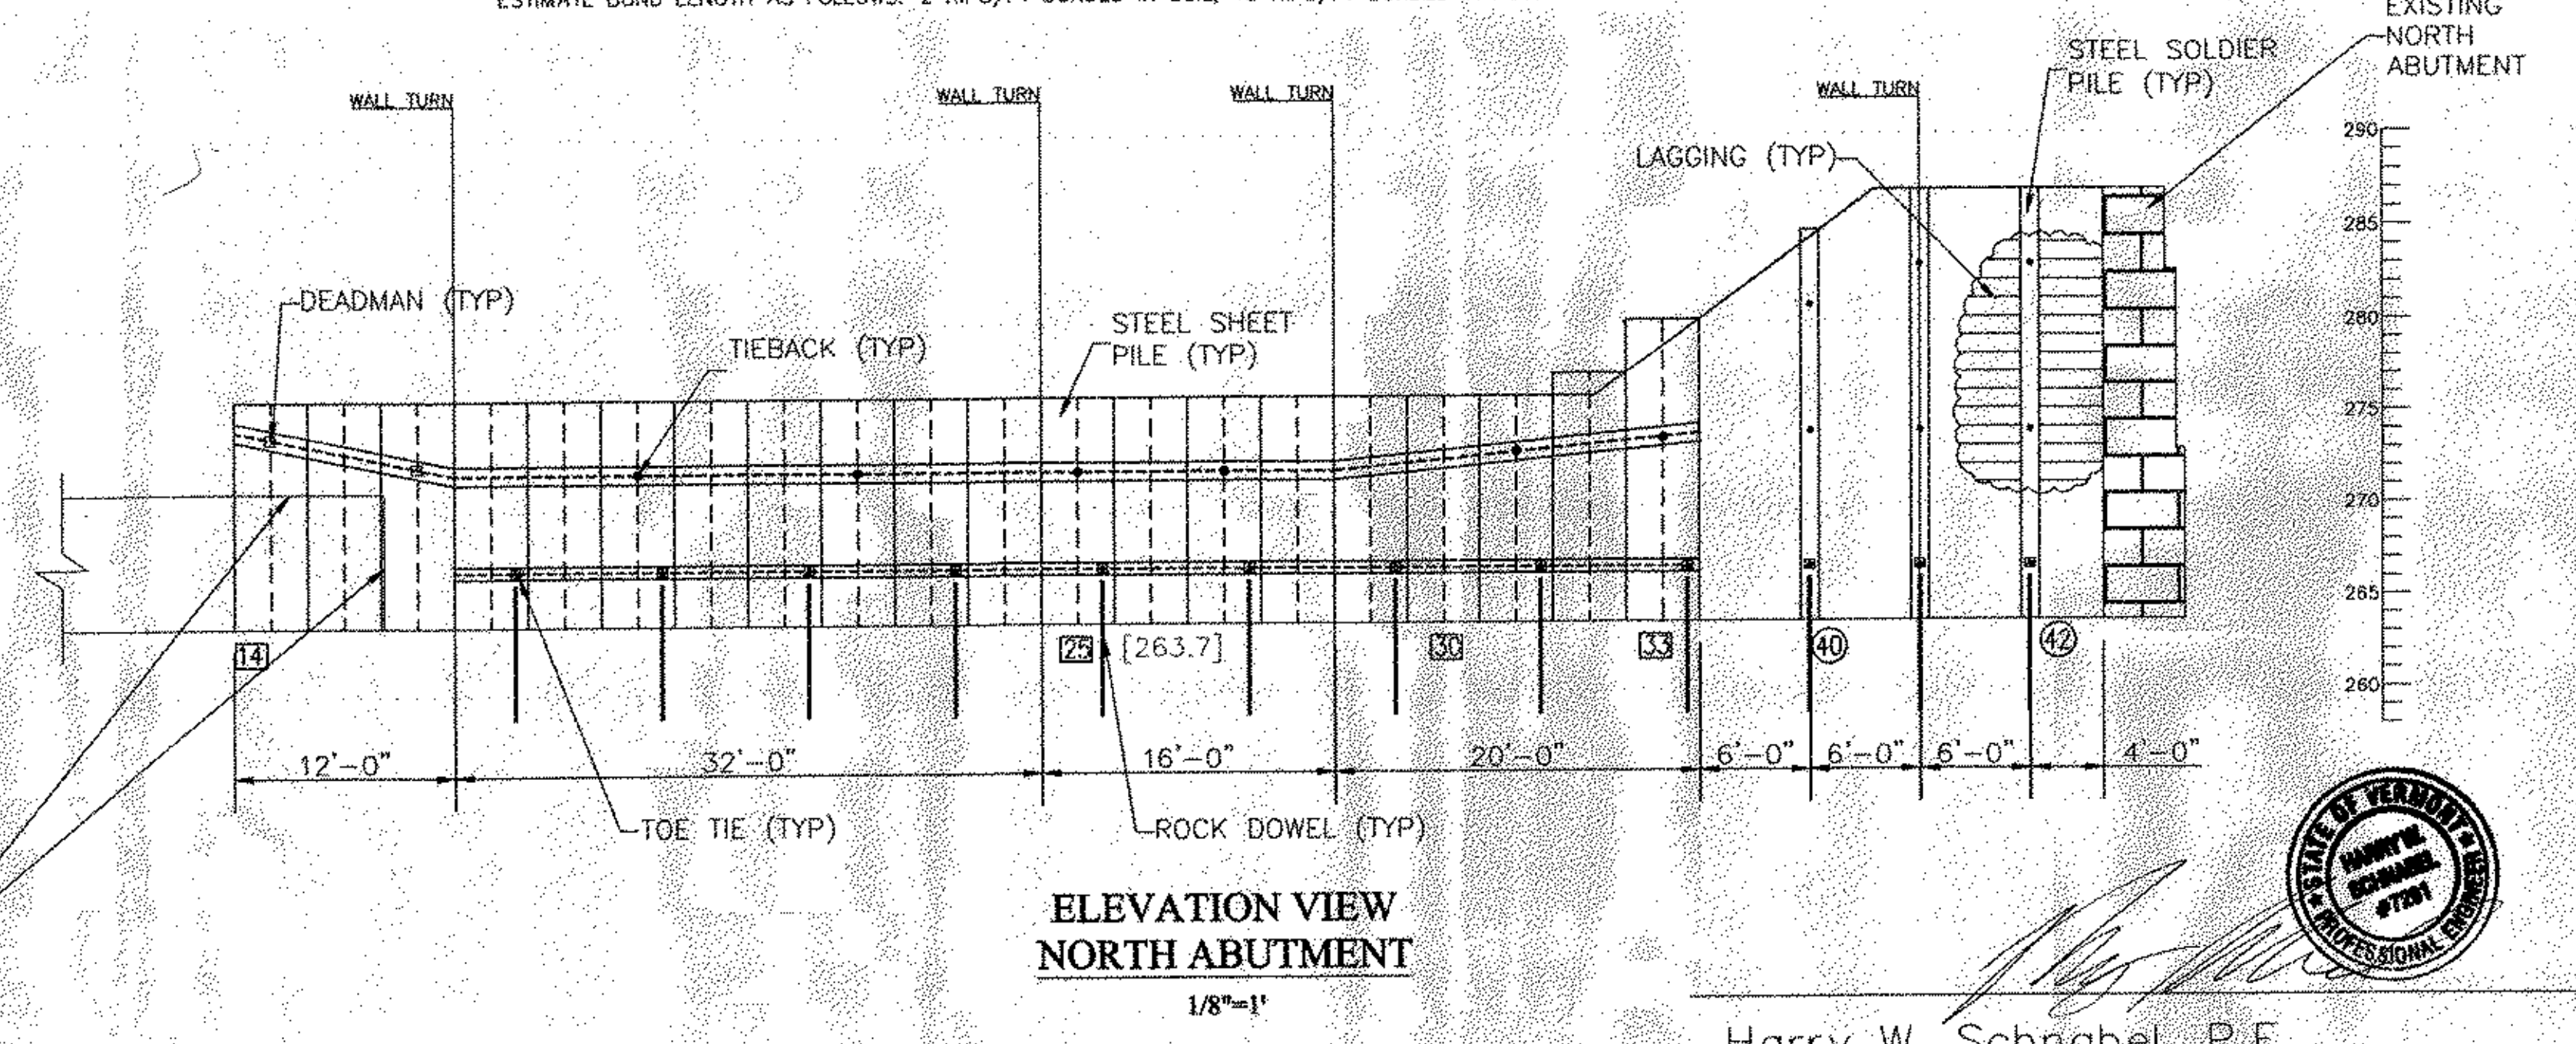

Harry W. Schnabel, P.E.
Vermont P.E. No. 7291

NOTE: FACE OF SOLDIER PILES SHALL NOT BE CLOSER THAN 5'3" FROM THE CENTERLINE OF THE TRACKS.

THESE DRAWINGS ARE THE PROPERTY OF SCHNABEL FOUNDATION COMPANY AND MAY NOT BE USED, COPIED, OR ALTERED, WITHOUT WRITTEN PERMISSION FROM SCHNABEL FOUNDATION COMPANY.
COPYRIGHT 2003 SCHNABEL FOUNDATION COMPANY


REVISIONS

NO	DATE	DESCRIPTION
1	4/21/03	REVIEW COMMENTS/GEN. REVISIONS


Schnabel
Foundation Company

Engineers and Contractors
200 Turnpike Road
Southborough, Massachusetts
Atlanta • Denver • Chicago
Houston • Los Angeles • Philadelphia
San Francisco • Washington D.C.


Excavation Support at Sargent Brook	
Route 9 Improvements	
Brattleboro, Vermont	
Date: 02/27/03	Job Number: 06-3392
Scale: 1/8"=1'-0"	Drawing No: SFC-5

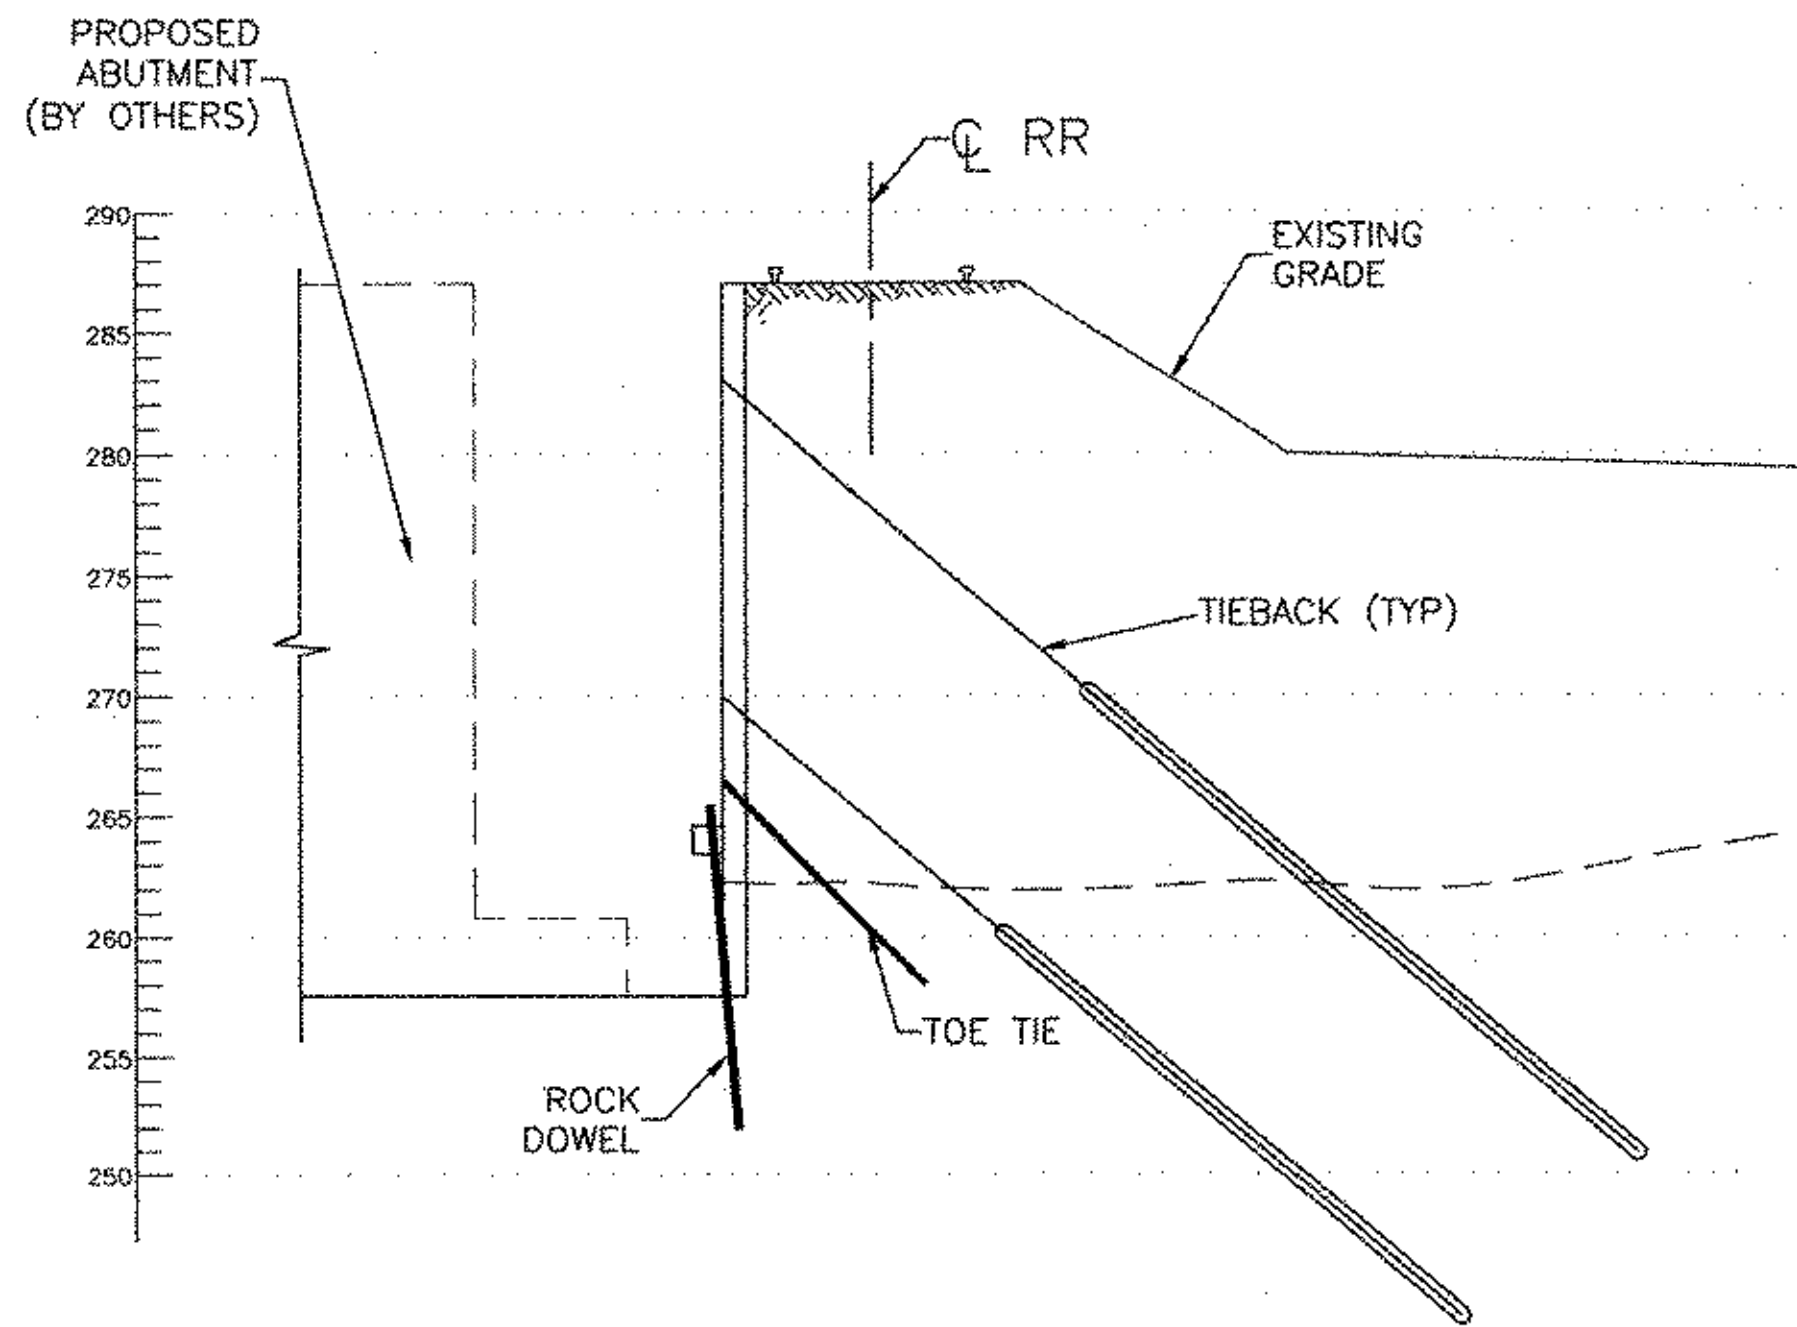

SECTION 1

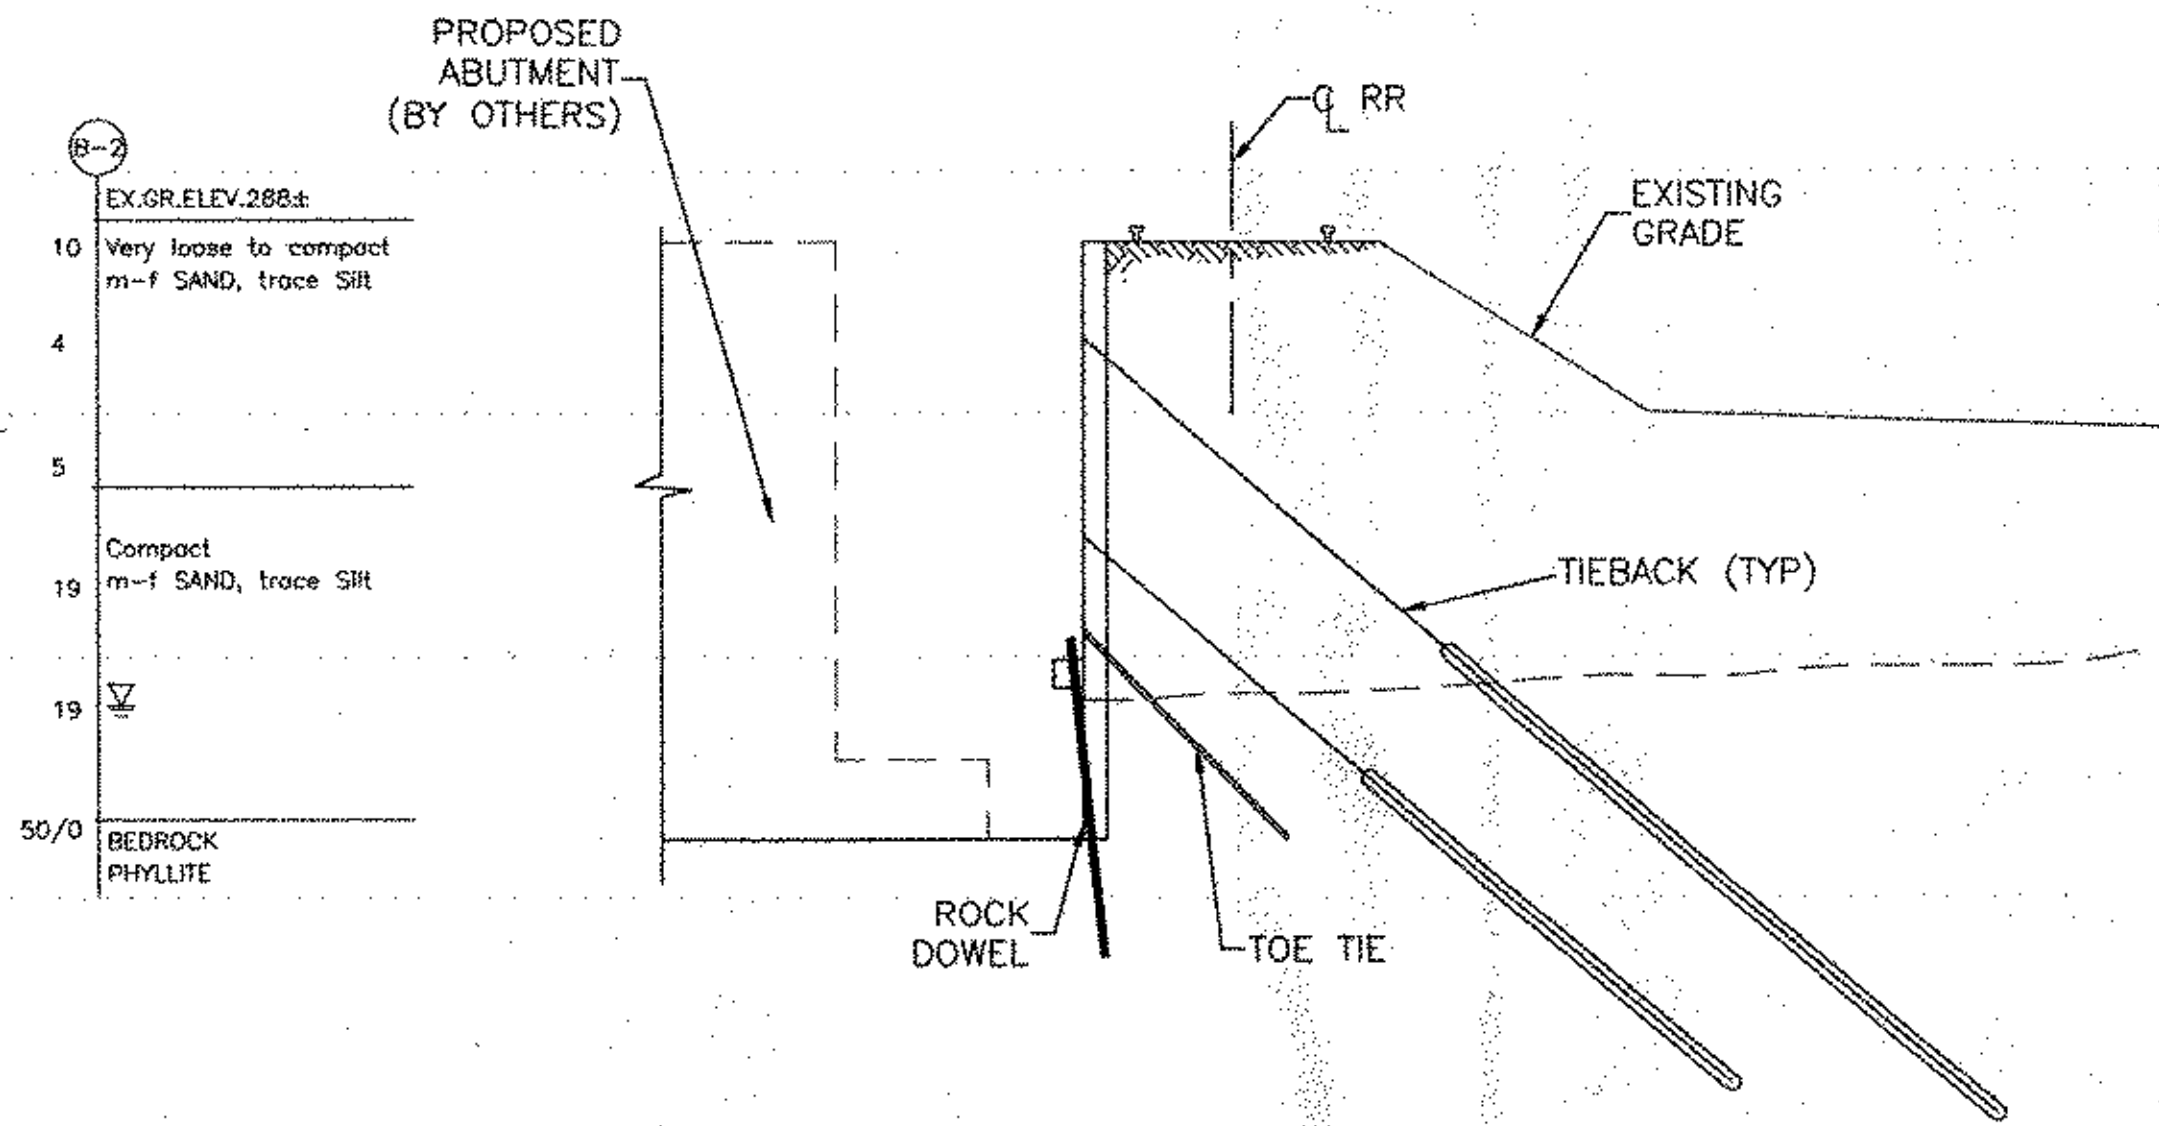

SECTION 2

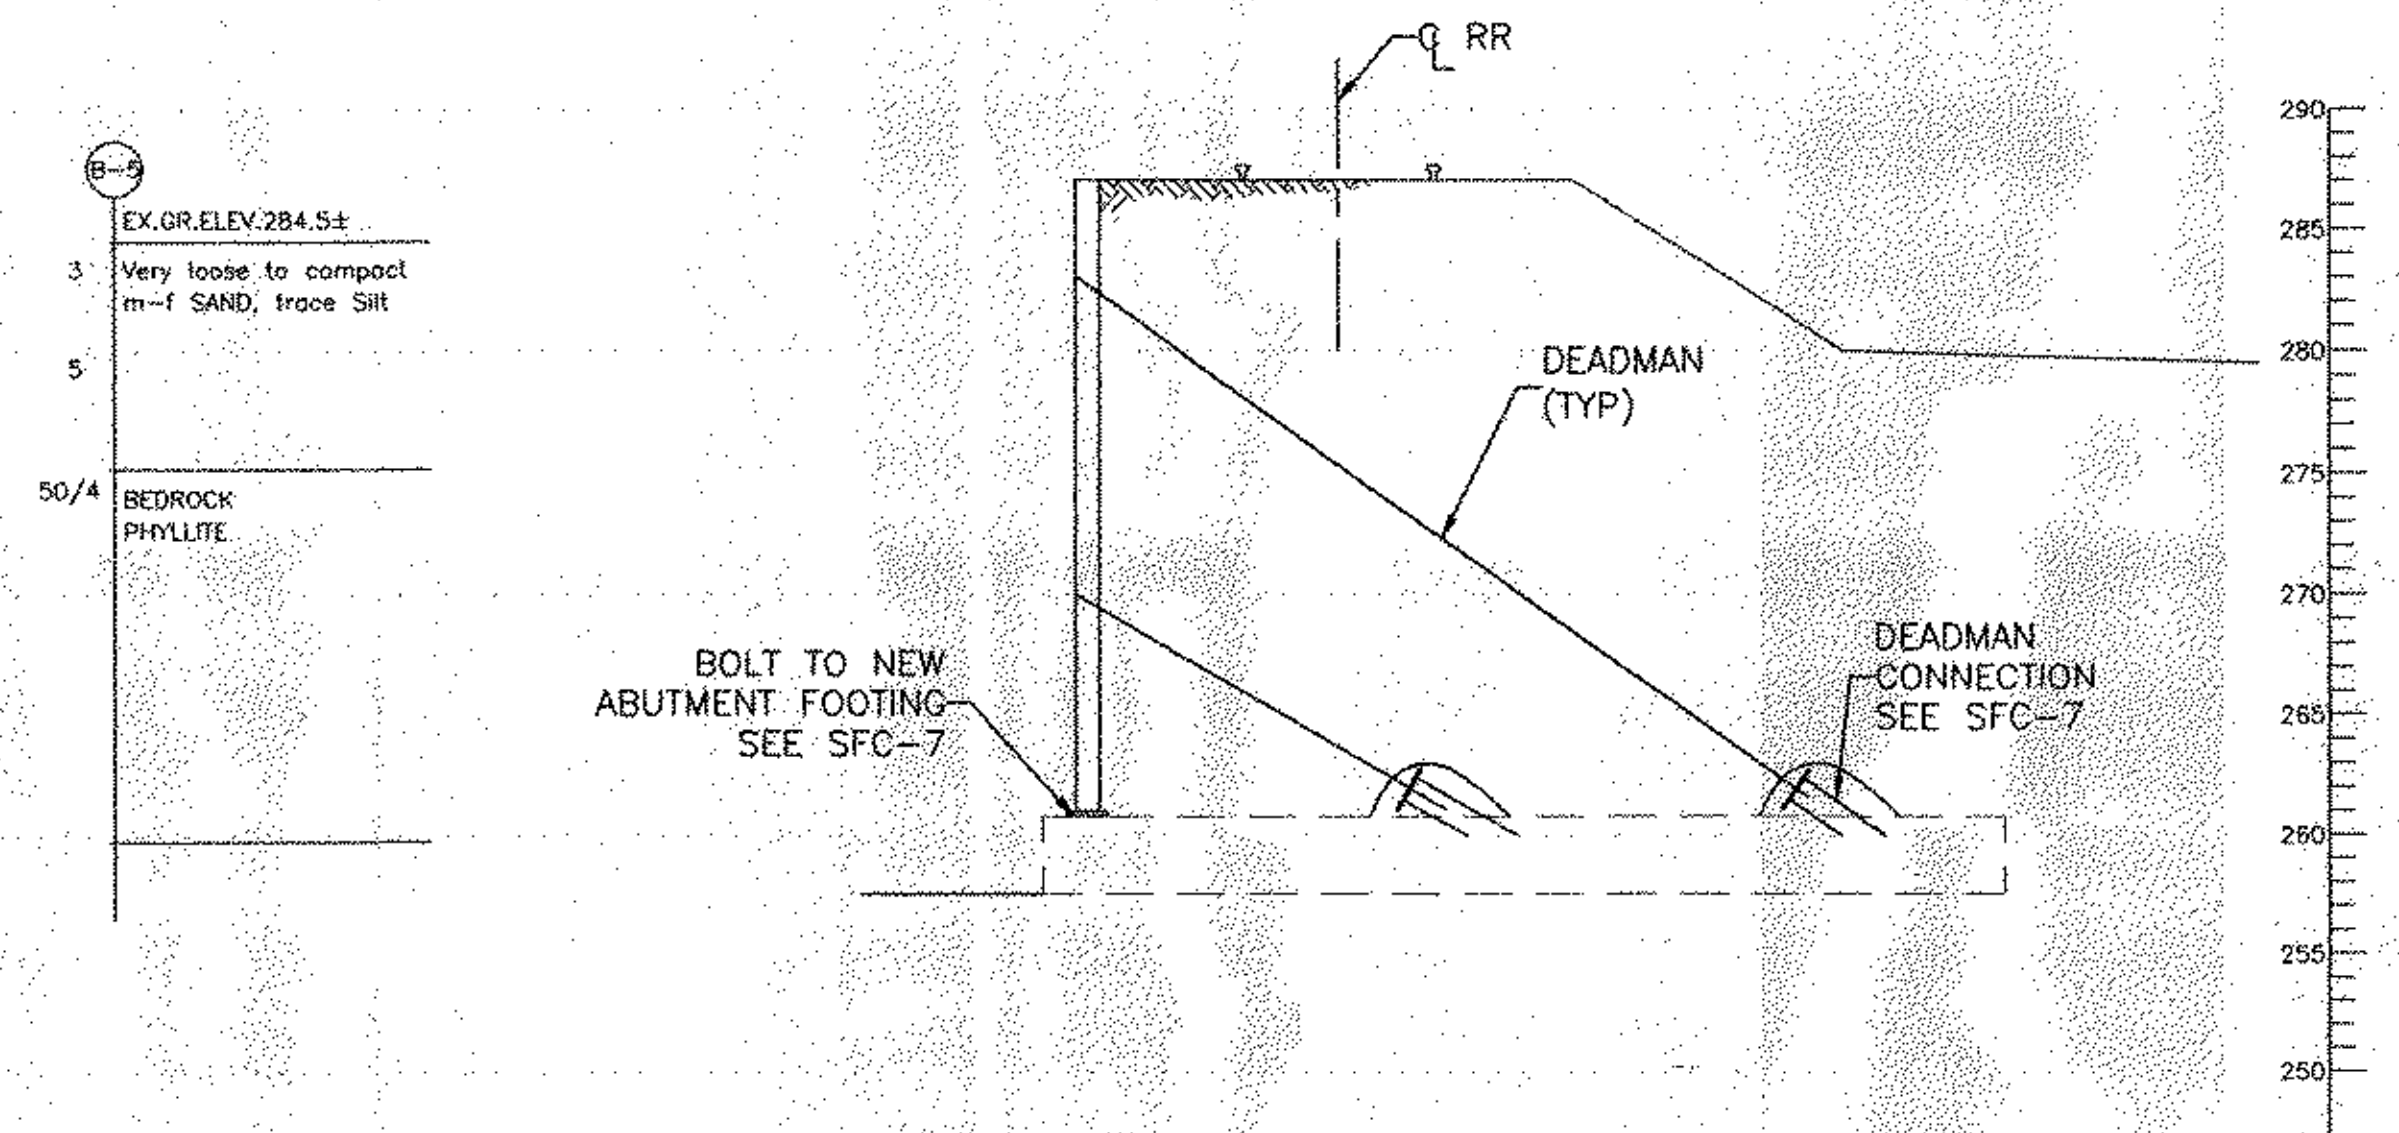

SECTION 3

SOLDIER BEAM/TIEBACK/TOE TIE SCHEDULE

PILE NUMBER	NUMBER OF PILES	TOP ELEVATION (FT)	SUBGRADE ELEVATION (FT)	PILE ¹ LENGTH (FT)	PILE ² SIZE	H ₁ (FT)	H ₂ (FT)	TIEBACK ANGLE (DEG)	TIEBACK LOAD (KIPS)	UNBONDED LENGTH (FT)	BOND ³ LENGTH (FT)	BAR SIZE	NUMBER OF 0.6" Ø STRANDS
1-2	2	287.1	267.4	20	2C15X33.9	4		40	126	15	25	1 3/8"	4
3-4	2	287.1	280.2	27	2C15X33.9	4	10	40	125	15	25	1 3/8"	4
5-8	4	287.1	257.5	30	2C15X33.9	4	10	40	160	15	30	1 1/4"	5
9	1	287.1	257.5	30	2C15X33.9	4	10	40	82	15	10	1 1/4"	3
10-11	2	283.1	257.5	27	2C10X20	4	10	40	47	15	15	1"	2
12-13	2	274.3	252.6	22	2C10X20	6		40	78	15	20	1 1/4"	3
14	1	265.1	253.3	12	2C10X20								
15-16	2	287.1	269.0	19	2C15X33.9	4		40	124	15	25	1 3/8"	4
17-21	5	287.1	262.4	25	2C15X33.9	4	8	40	119	15	25	1 3/8"	4
22	1	286.1	262.4	24	2C10X20	4		40	61	15	15	1"	2
23	1	282.2	262.4	20	2C10X20	4		40	44	15	15	1"	2
24-25	2	282.2	262.4	20	2C10X20	4		40	26	15	15	1"	2
26	1	278.9	262.4	17	2C10X20			40	31	15	15	1"	2
27	1	269.1	262.4	7	2C10X20								
28-29	2	287	260.6	27	HP12x53	4	13	35	143	39	deadman		5
						4		30	64	18	deadman	1"	2
30	1	283.8	261.4	23		4	10	40	40	15	15	1"	2
31-32	2	280.6	261.4	20		4		40	49	15	15	1"	2
33	1	272.4	261.4	11									
34	1	287	260.6	27	HP12x53	4	13	35	143	39	deadman		5
						4		30	64	18	deadman	1"	2
35	1	287.1	267.4	20		4	10	30	133	15	25	1"	4
36-37	2	285.5	267.3	19		4		40	38	15	15	1"	2
38	1	285.5	267.3	19		4		40	28	15	15	1"	2
39	1	281.2	275.5	6					18	15	15	1"	2

1. PILE LENGTH SHOWN IS FOR PLANNING PURPOSES ONLY. INSTALL PILES TO TOP OF BEDROCK OR 5 FT BELOW BOTTOM OF EXCAVATION, WHICHEVER IS HIGHER.
 2. SFC RESERVES THE RIGHT TO SUBSTITUTE ANY BEAM SIZE PROVIDED IT MEETS THE DESIGN REQUIREMENTS.
 3. BOND LENGTH SHOWN IS FOR PLANNING PURPOSES ONLY. ACTUAL BOND LENGTH WILL BE DETERMINED IN FIELD BASED ON ACTUAL SOIL/ROCK CONDITIONS. ESTIMATE BOND LENGTH AS FOLLOWS: 2 KIPS/FT BONDED IN SOIL; 10 KIPS/FT BONDED IN ROCK. VERIFY WITH SFC ENGINEER PRIOR TO INSTALLING TENDON.


THESE DRAWINGS ARE THE PROPERTY OF SCHNABEL FOUNDATION COMPANY AND MAY NOT BE USED, COPIED, OR ALTERED, WITHOUT WRITTEN PERMISSION FROM SCHNABEL FOUNDATION COMPANY.
 COPYRIGHT 2003 SCHNABEL FOUNDATION COMPANY




Harry W. Schnabel, P.E.
 Vermont P.E. No. 7291

REVISIONS			Excavation Support Sections	
NO	DATE	DESCRIPTION	Route 9 Improvements	
1	4/21/03	REVIEW COMMENTS/GEN. REVISIONS	Brattleboro, Vermont	
			Date: 02/27/03	Job Number: 06-3392
			Scale: 1/8"=1'-0"	Drawing No: SFC-6


Schnabel
 Foundation Company
 Engineers and Contractors
 200 Turnpike Road
 Southborough, Massachusetts
 Atlanta • Denver • Chicago
 Houston • Los Angeles • Philadelphia
 San Francisco • Washington D.C.

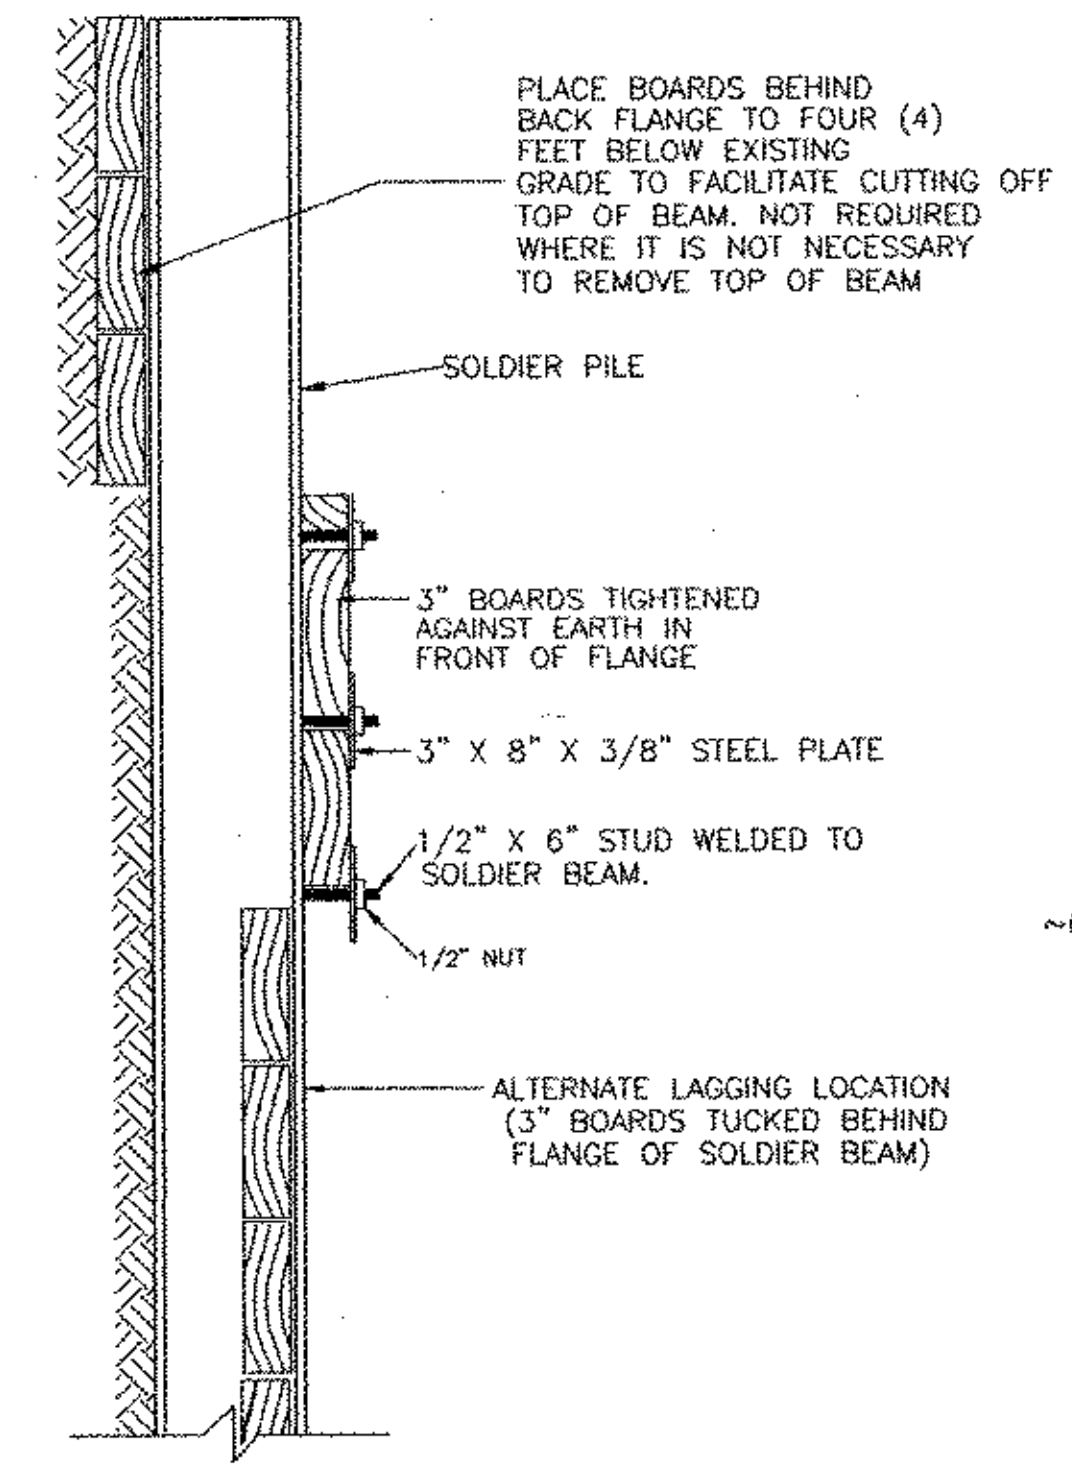

LAGGING DETAIL
N.T.S.

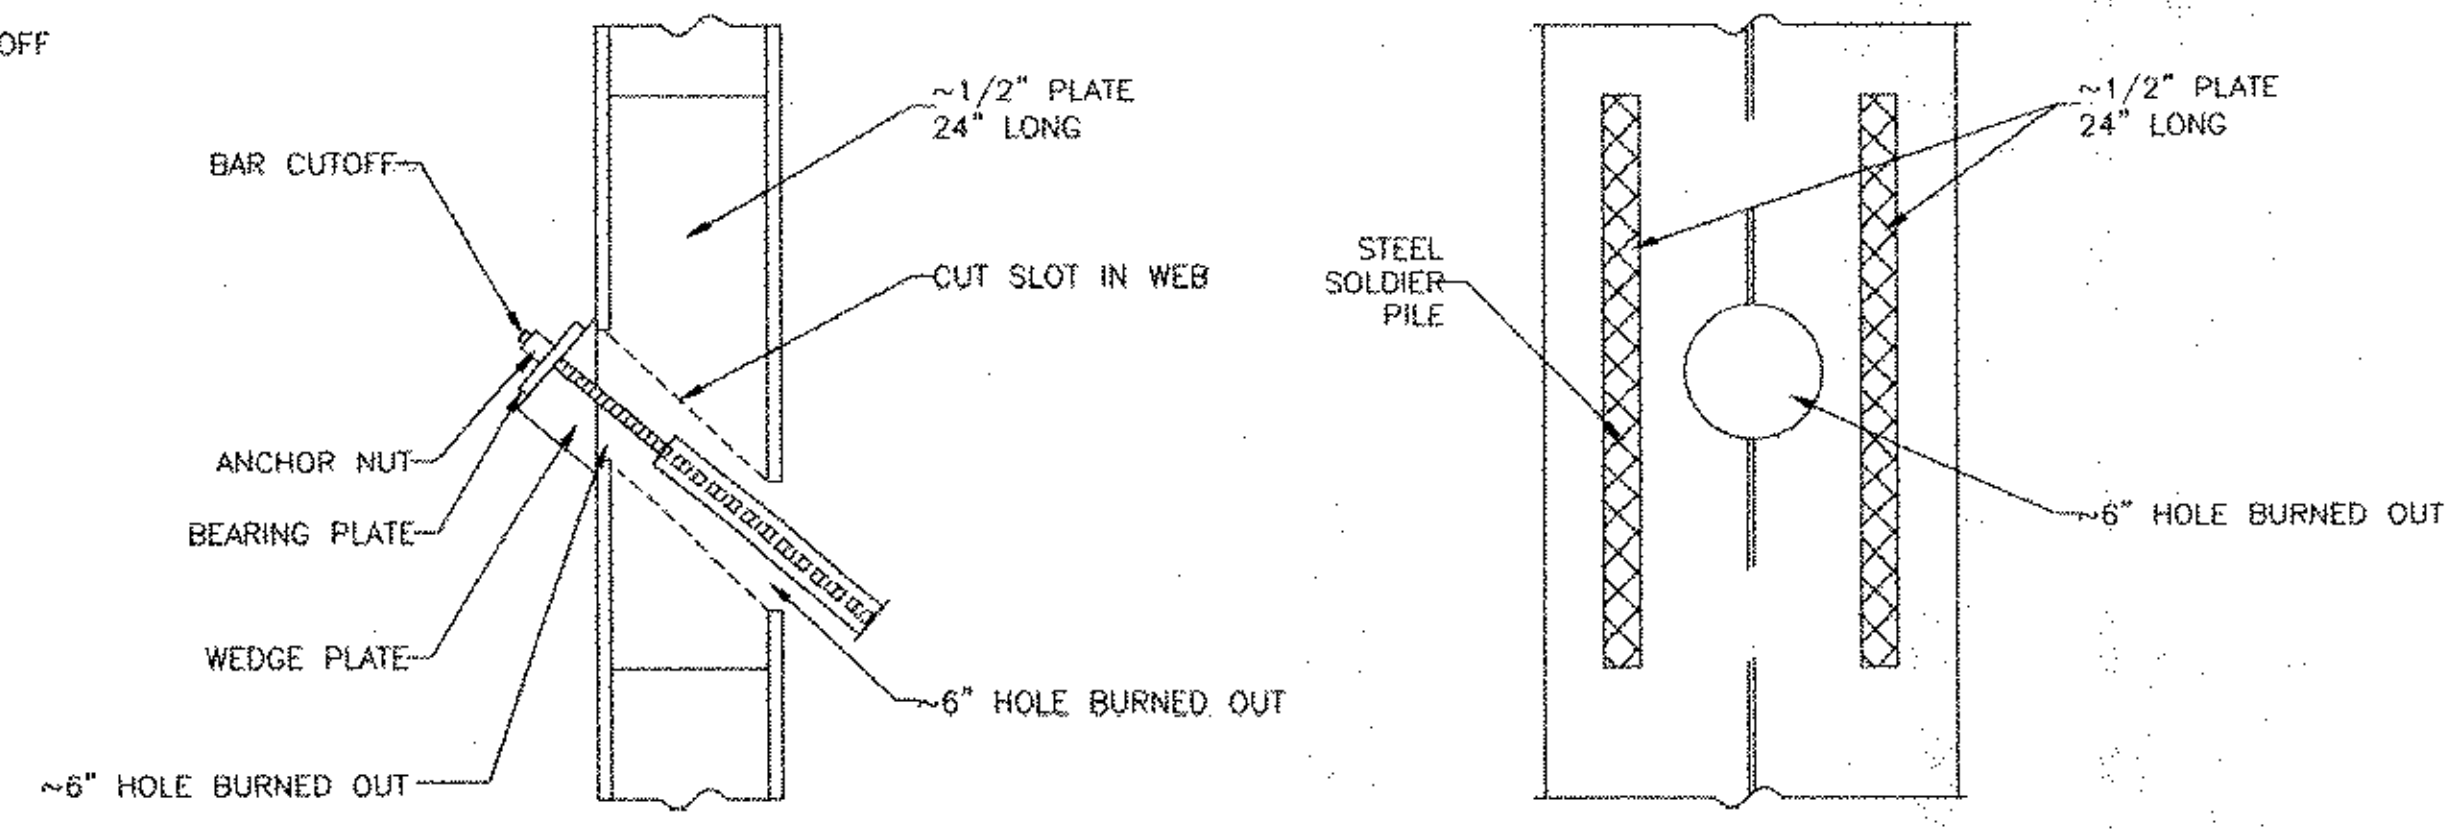


THRU BEAM CONNECTION DETAIL FOR HP PILE
N.T.S.

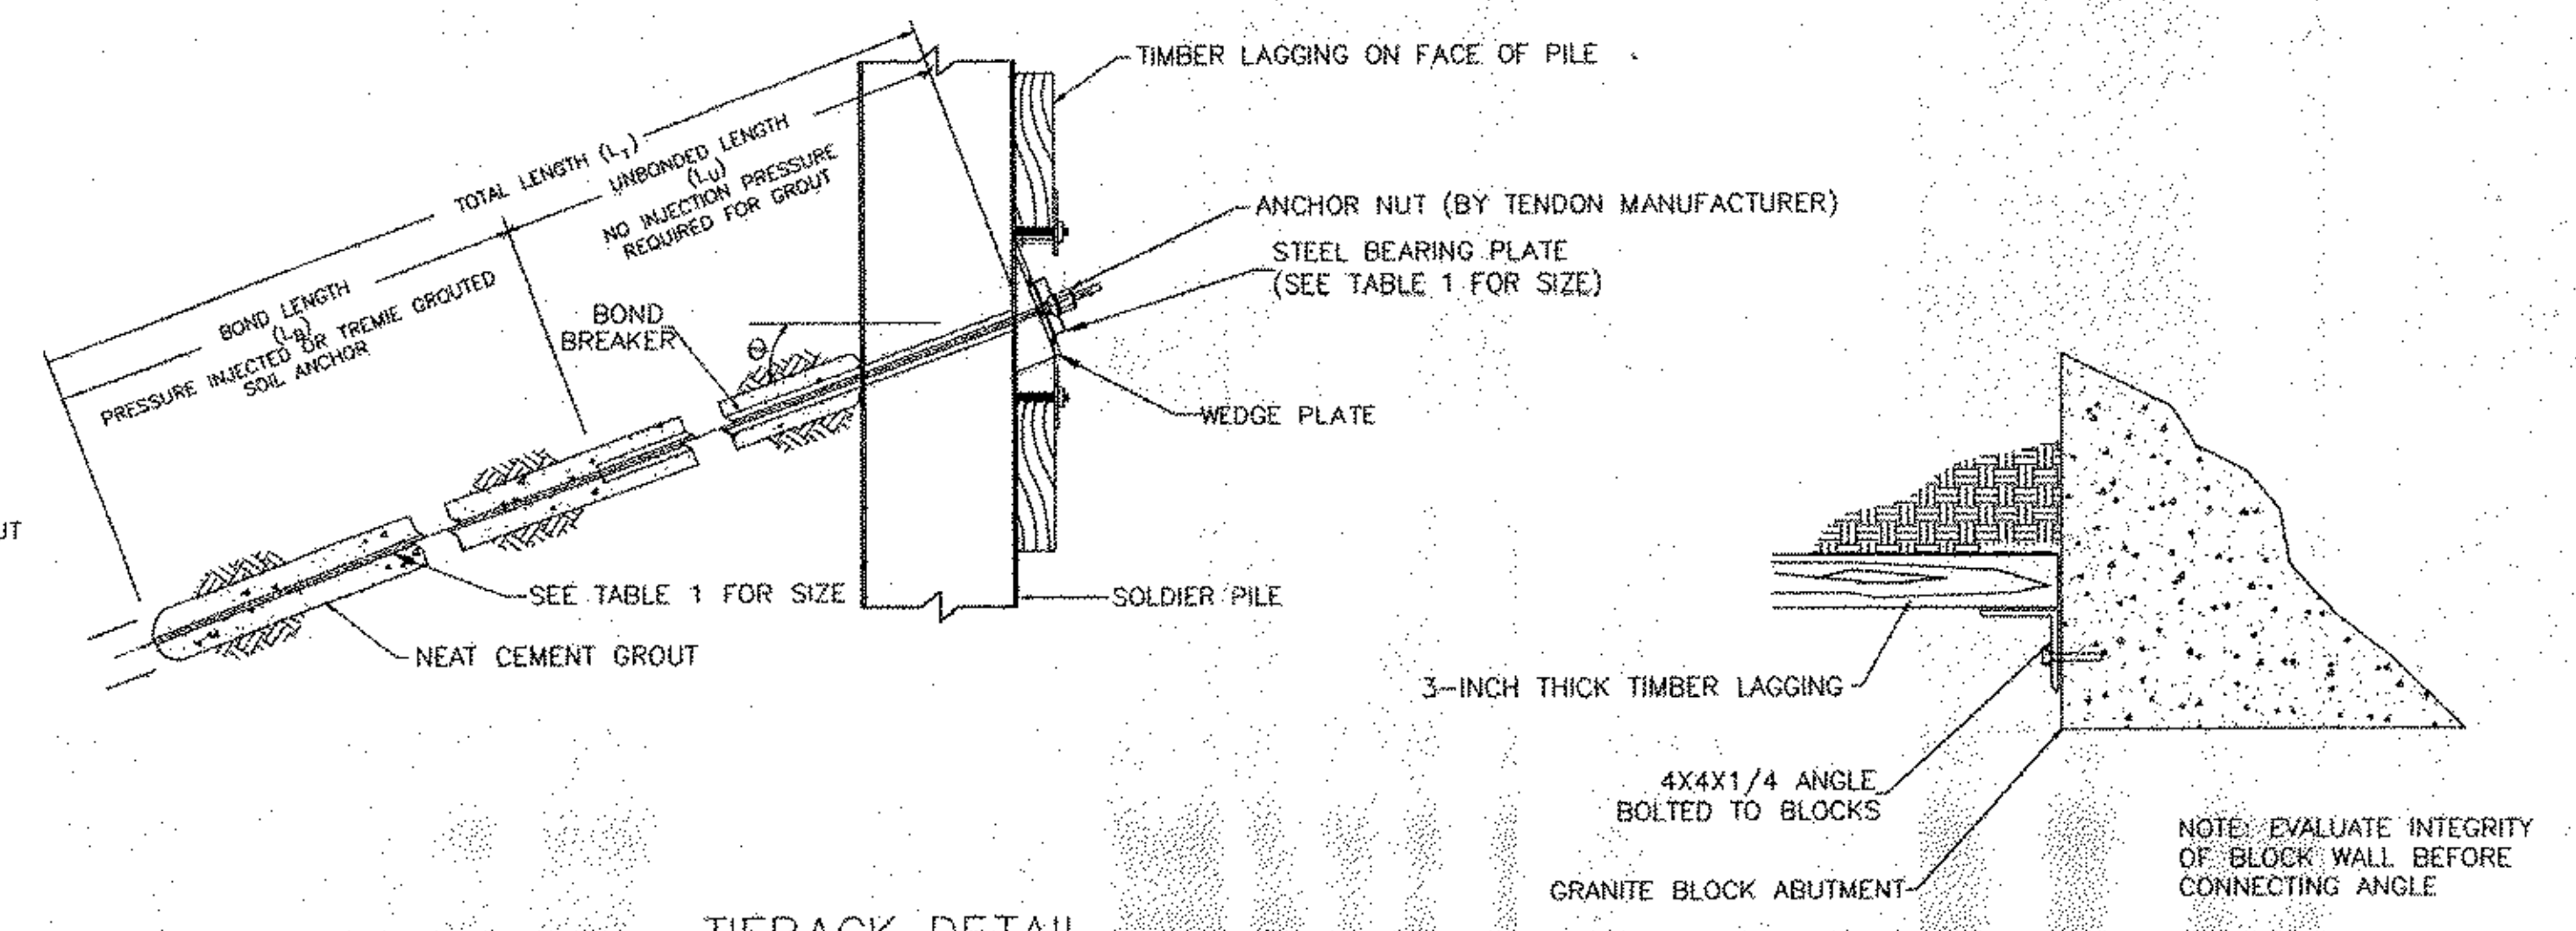

TIEBACK DETAIL
N.T.S.

LAGGING CONNECTION TO ABUTMENT DETAIL
N.T.S.

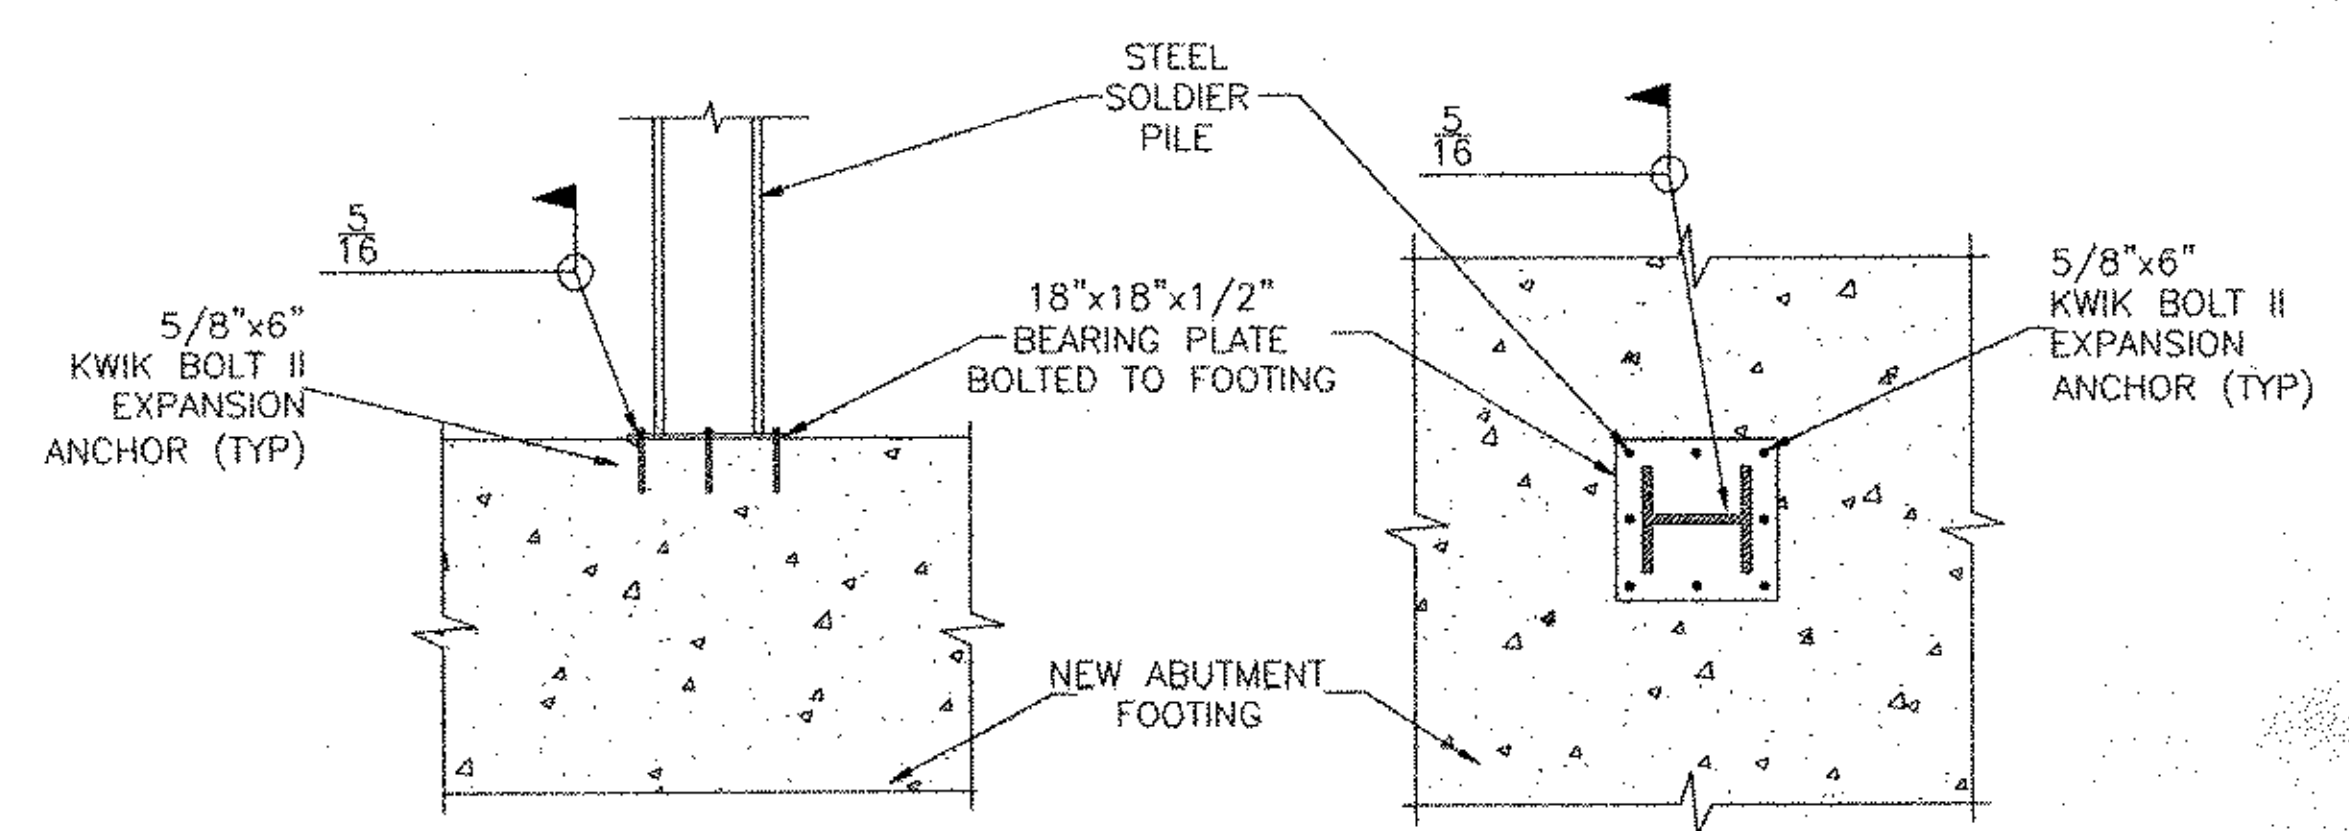


SOLDIER BEAM TO FOOTING CONNECTION DETAIL
N.T.S.

GRADE 150 BARS (ASTM A722)


SIZE	MAXIMUM LOAD (KIP)	PLATE SIZE
1"	76	5x5x1.25 4x6.5x1.25
1-1/4"	112	6x7x1.5 5x8x1.5
1-3/8"	142	7x7.5x1.75 5x9.5x1.75

SEVEN WIRE STRANDS (ASTM A416)


SIZE	MAXIMUM LOAD (KIP)	PLATE SIZE
3	105	6x6x1.5 5x8x1.5
4	140	7x7x1.75 5x9x1.75
5	175	8x8x2.0 6x10x2.0

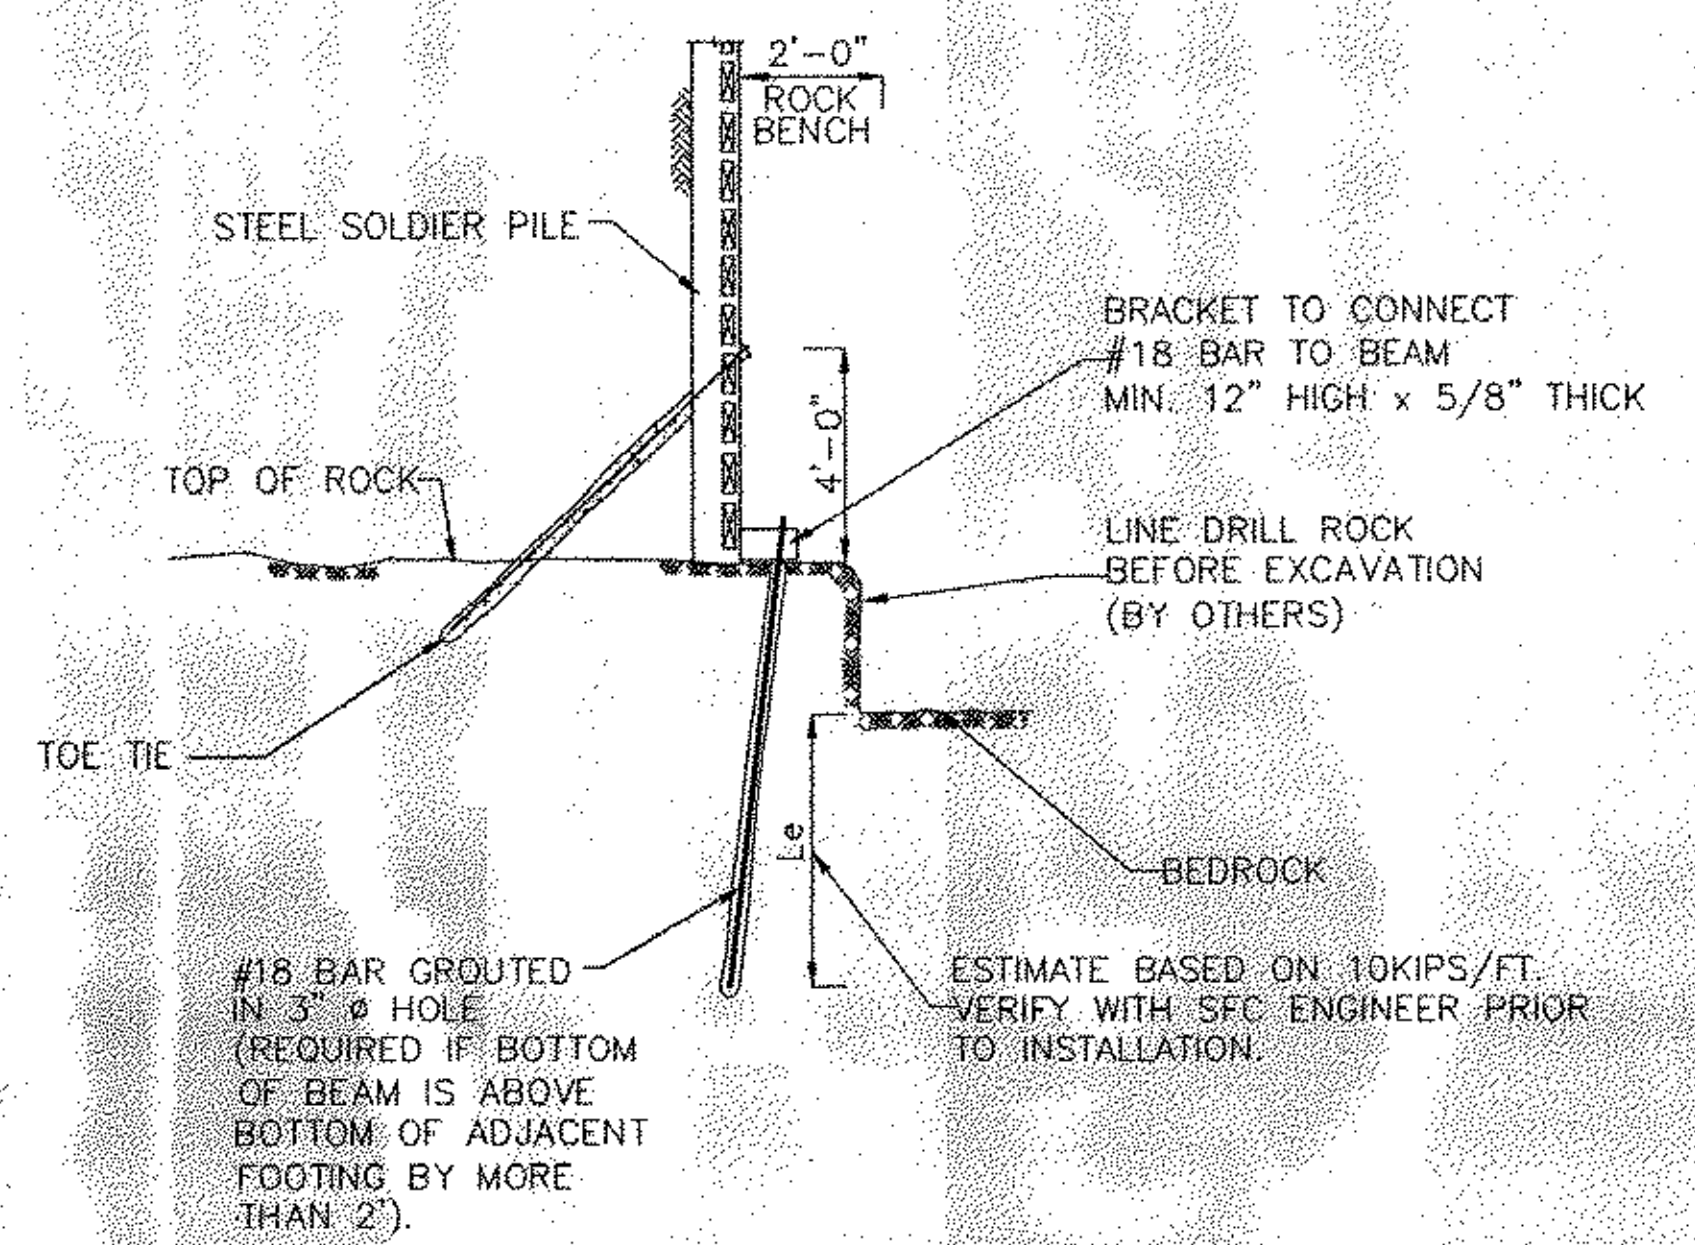


TOE TIE AND ROCK DOWEL DETAIL
N.T.S.

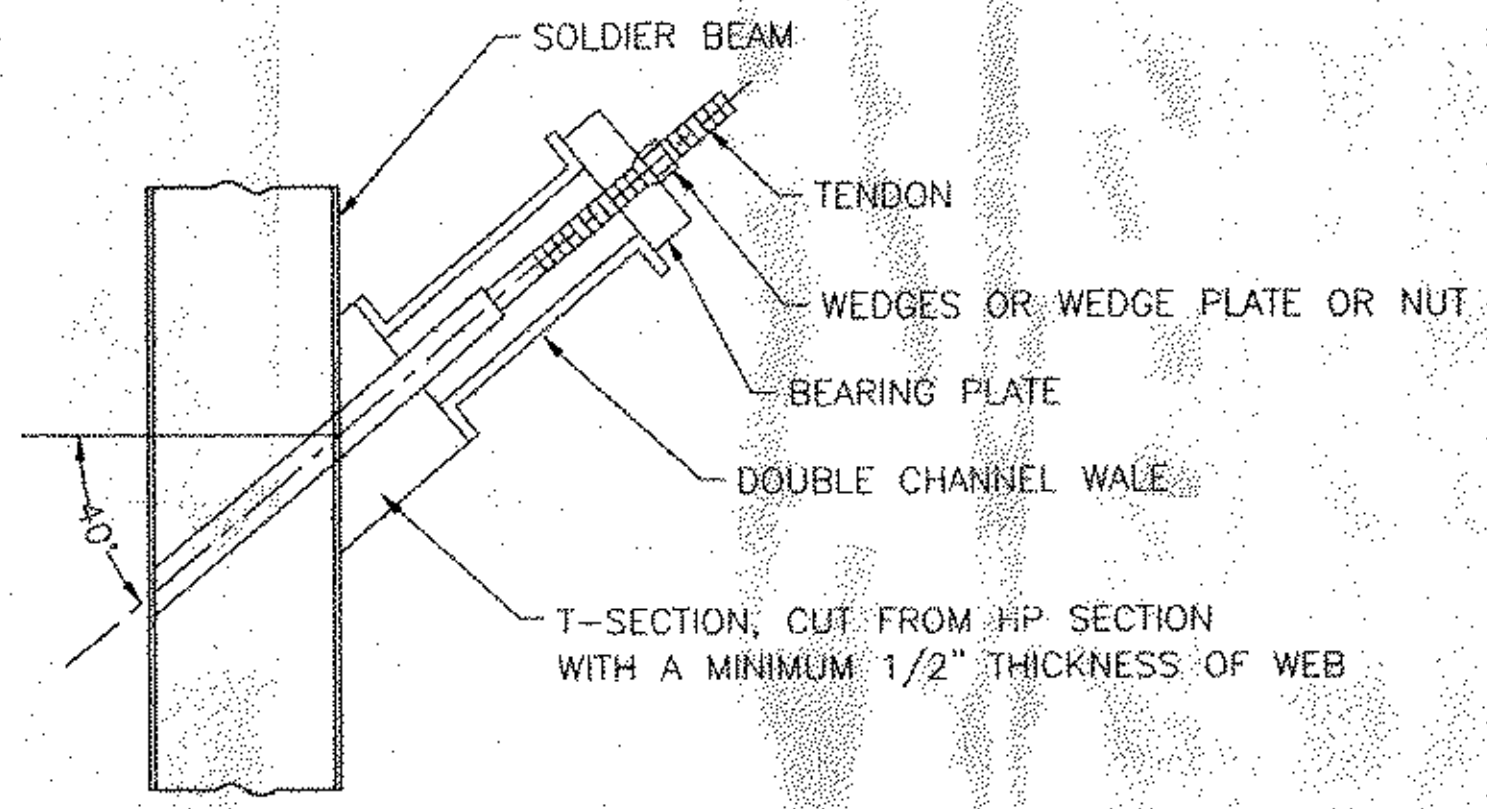

DOUBLE CHANNEL WALE DETAIL
N.T.S.

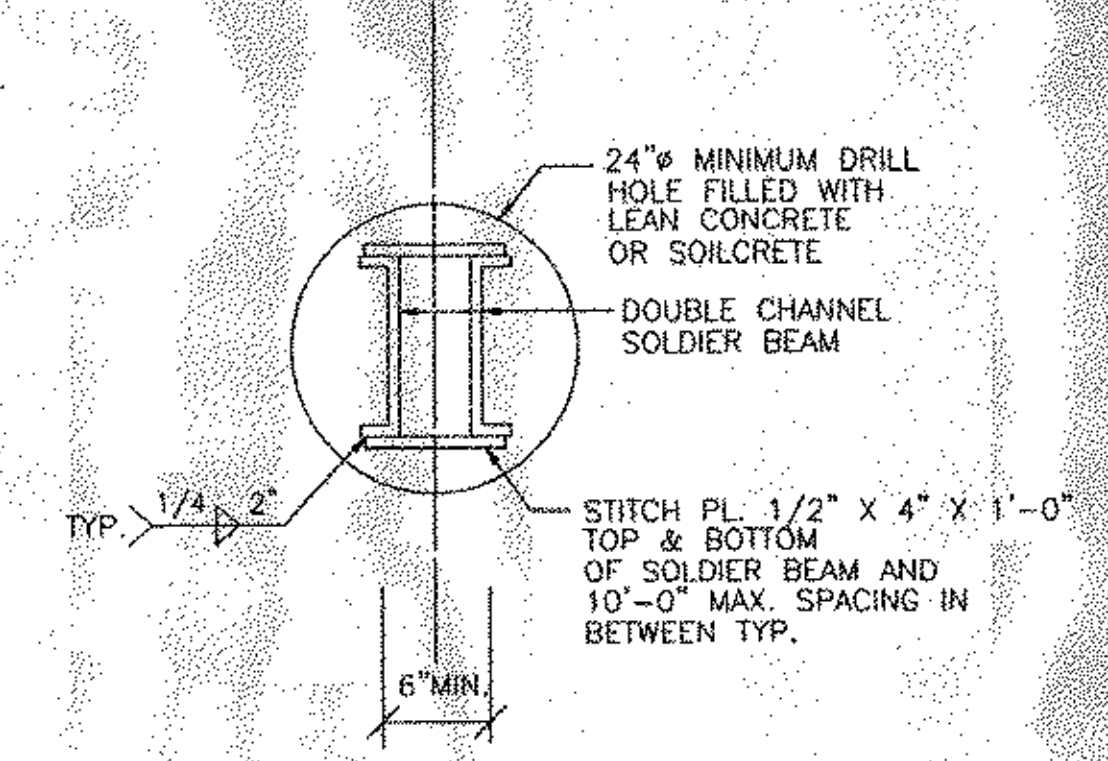

DOUBLE CHANNEL BEAM DETAIL
N.T.S.

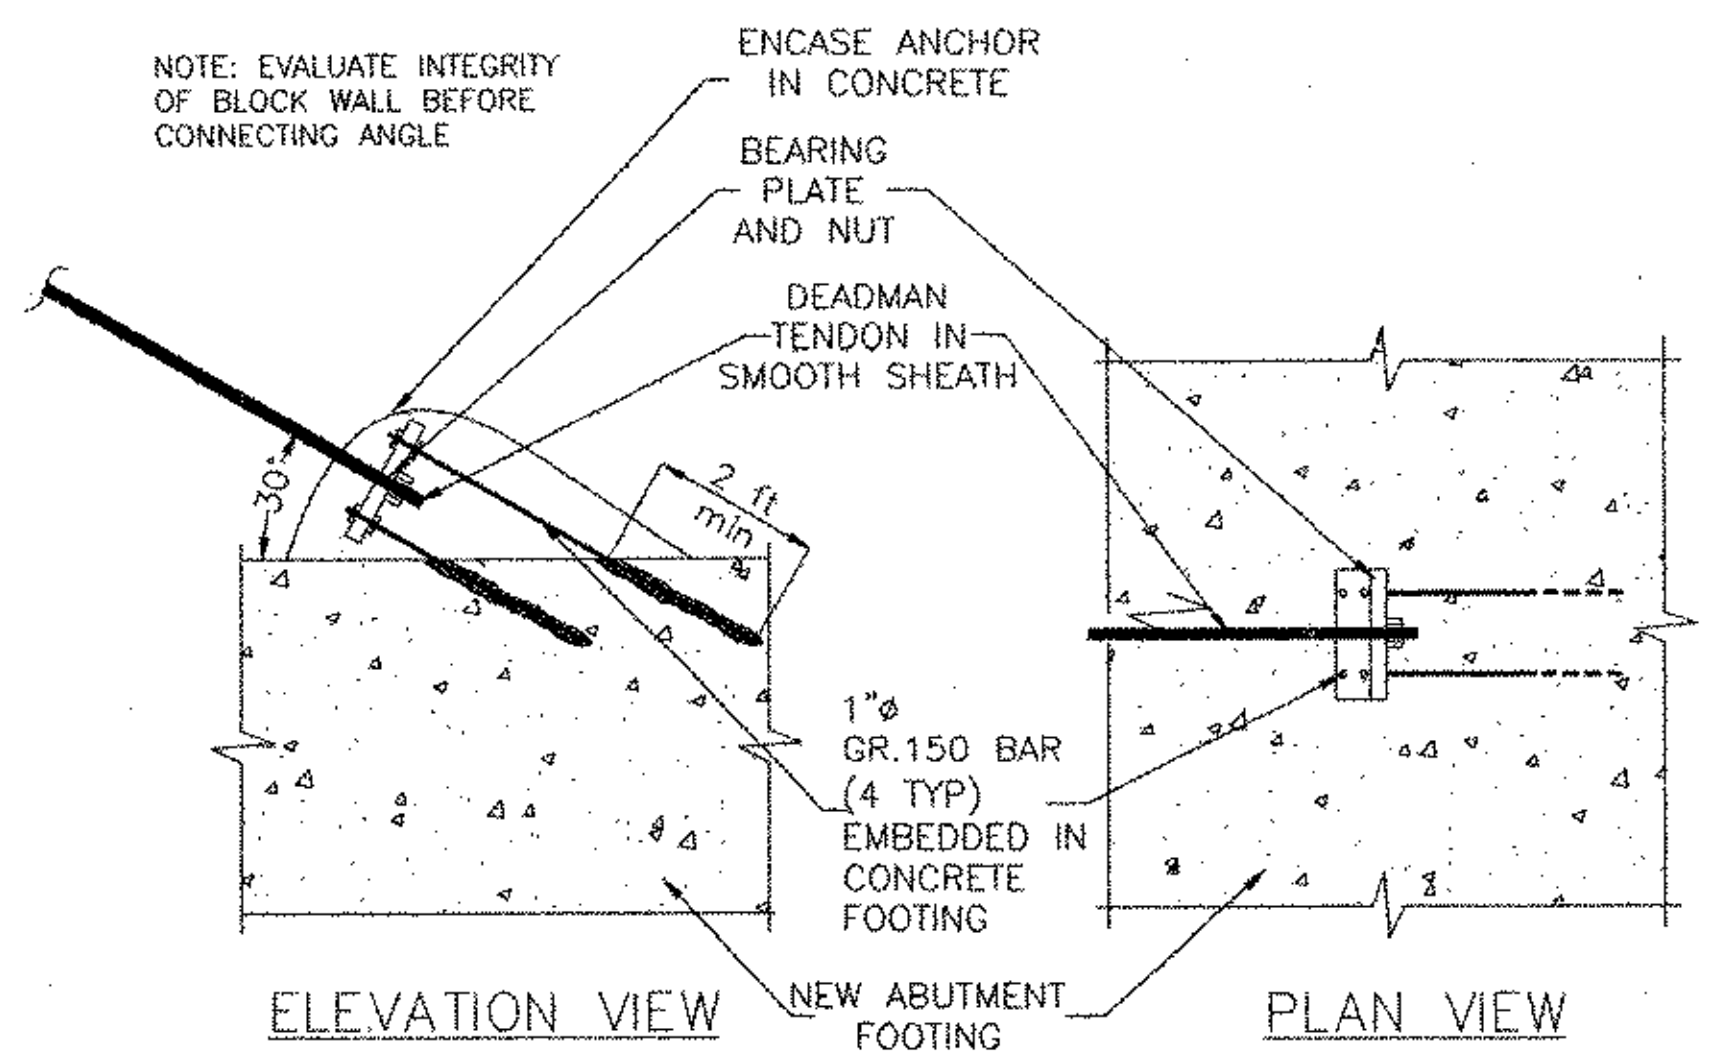

DEADMAN DETAIL
N.T.S.

THESE DRAWINGS ARE THE PROPERTY OF SCHNABEL FOUNDATION COMPANY AND MAY NOT BE USED, COPIED, OR ALTERED, WITHOUT WRITTEN PERMISSION FROM SCHNABEL FOUNDATION COMPANY.
COPYRIGHT 2003 SCHNABEL FOUNDATION COMPANY

REVISIONS

NO	DATE	DESCRIPTION
1	4/21/03	REVIEW COMMENTS/GEN. REVISIONS

Schnabel
Foundation Company

Engineers and Contractors
200 Turnpike Road
Southborough, Massachusetts
Atlanta • Denver • Chicago
Houston • Los Angeles • Philadelphia
San Francisco • Washington D.C.

Harry W. Schnabel, P.E.
Vermont P.E. No. 7291

Excavation Support Details
Route 9 Improvements
Brattleboro, Vermont

Date: 02/25/03 Job Number: 06-3392
Scale: N.T.S. Drawing No: SFC-7

181 etc


GENERAL NOTES:

1. ALL MATERIALS AND CONSTRUCTION SHALL CONFORM TO STATE OF VERMONT AGENCY OF TRANSPORTATION STANDARD SPECIFICATIONS FOR CONSTRUCTION DATED 2001, AND ITS LATEST REVISIONS; AREMA'S "MANUAL FOR RAILWAY ENGINEERING", LATEST EDITION , AND ITS LATEST REVISIONS.
2. THESE SHOP DRAWINGS WERE PREPARED IN ACCORDANCE WITH THE CONTRACT PLANS AND SPECIFICATIONS. THE D.S. BROWN COMPANY DOES NOT ACCEPT LIABILITY FOR THE DESIGN OF THE PRODUCTS DETAILED IN THESE SHOP DRAWINGS.
3. THE D.S. BROWN COMPANY IS TO ONLY SUPPLY THE PARTS SHOWN ON THESE DRAWINGS.
4. MATCH MARKS SHALL BE PLACED AT CENTER LINE ON PLATE EDGES TO INSURE CORRECT ASSEMBLY AT THE JOB SITE. THE MARKS SHALL BE MADE IN INDELIBLE INK AND SHALL BE BE VISIBLE AFTER BEARING INSTALLATION.


Δ 5. BEARING SHALL BE GALVANIZED IN ACCORDANCE WITH VADOT 2001 STANDARD SPECIFICATIONS.


PROJECT	NH010-2(2)
DATE	4/30/03
DESIGNED BY	
CHECKED BY	
DATE	5/18/03

REV.	DESCRIPTION	DATE	DET.	CKD.			
Δ	ADDED GENERAL NOTE 5	4/23/03	BC	EK			
	LOCATION — VT ROUTE 9						
	BRIDGE — 62.56						
	PROJECT — NH 010-2(2)						
	DESIGNER — CONSULTING ENGINEERS						
	CUSTOMER — JA MCDONALD						
	DESCRIPTION	SCALE	DRAWN BY	CHECKED BY	DATE	ITEM	QUANTITY
	GENERAL NOTES	N.T.S.	B. COPPUS	E. KELLEY	3/20/03		
	WINDHAM COUNTY, VERMONT	PROJECT NUMBER	7657	PROJECT CODE	1121	RELEASE	1
						SHEET	GN



D.S. BROWN
 300 E. CHERRY STREET
 NORTH BALTIMORE, OHIO 45872
 419.257.3561
 FAX: 419.257.0332
 4201 NOREX DRIVE
 CHASKA, MINNESOTA 55318
 952.368.3000
 FAX: 952.448.7000
 DSBROWN.COM




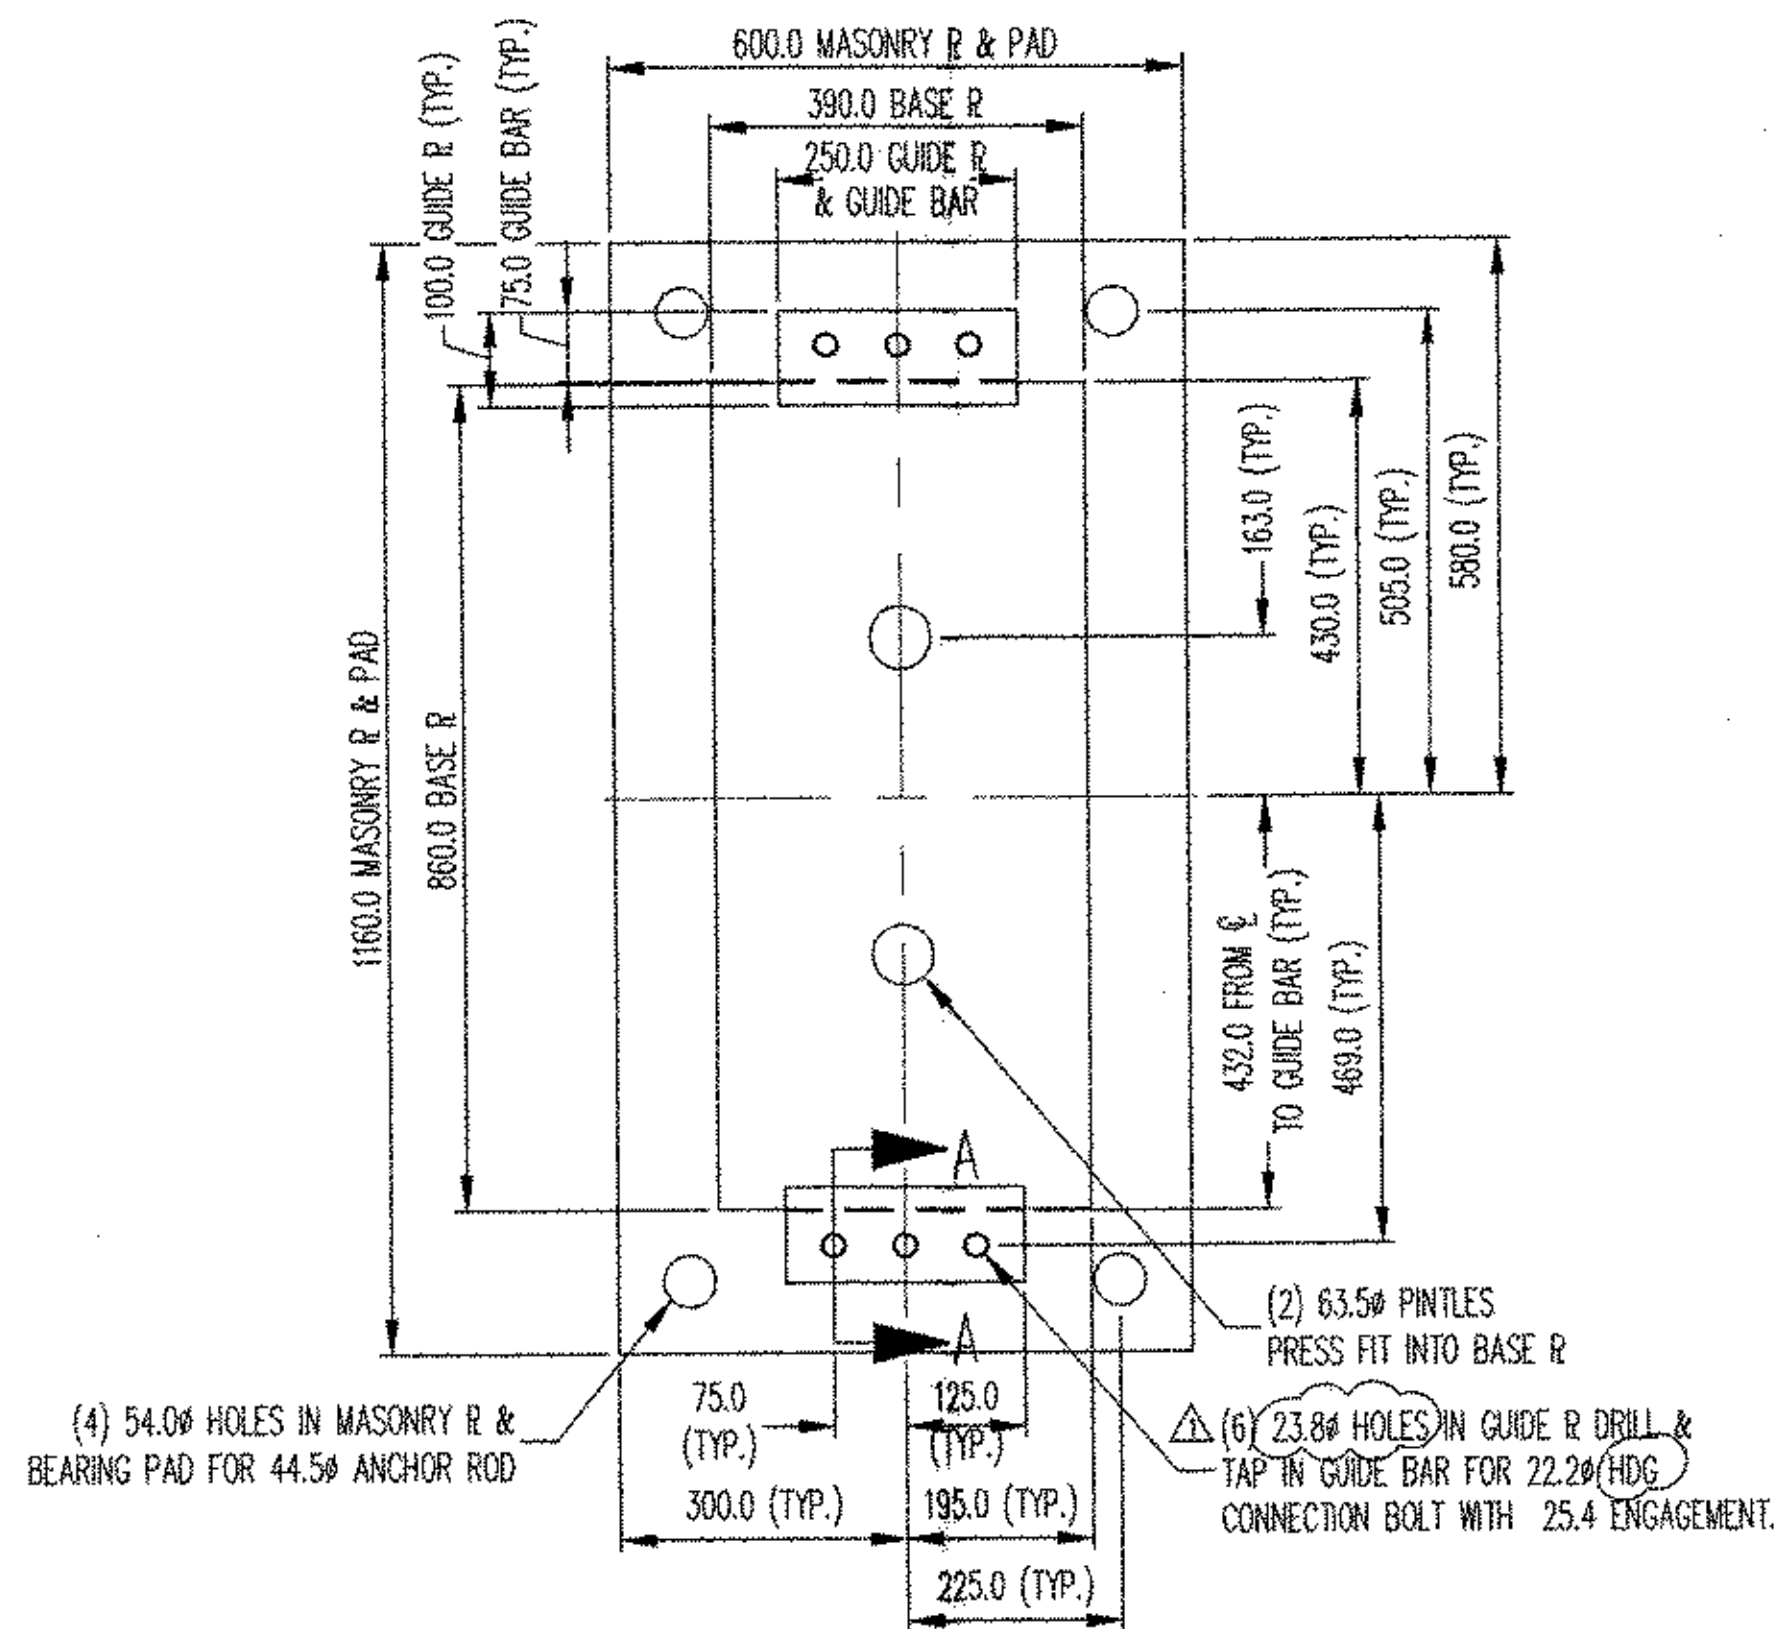


2-MASONRY PLATE ASSEMBLY

LOAD TABLE


LOAD DATA	7657-1121-1
VERTICAL LOAD (kN)	2970
HORIZONTAL LOAD TRANSVERSE (kN)	182
HORIZONTAL LOAD LONGITUDINAL (kN)	676

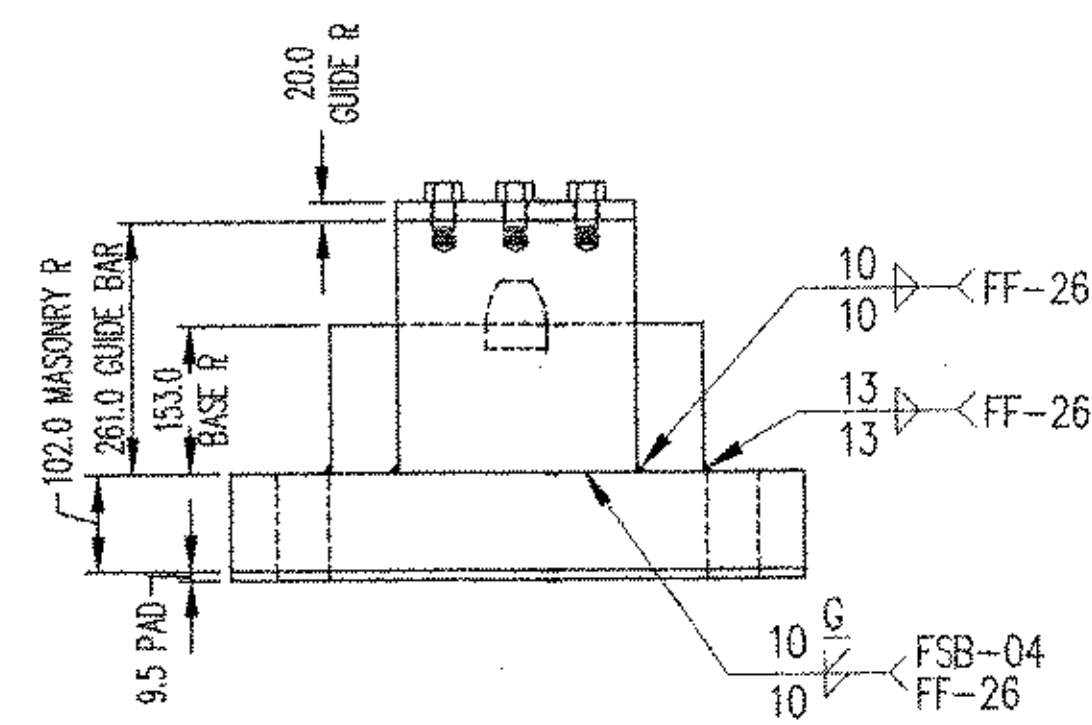


SIDE VIEW

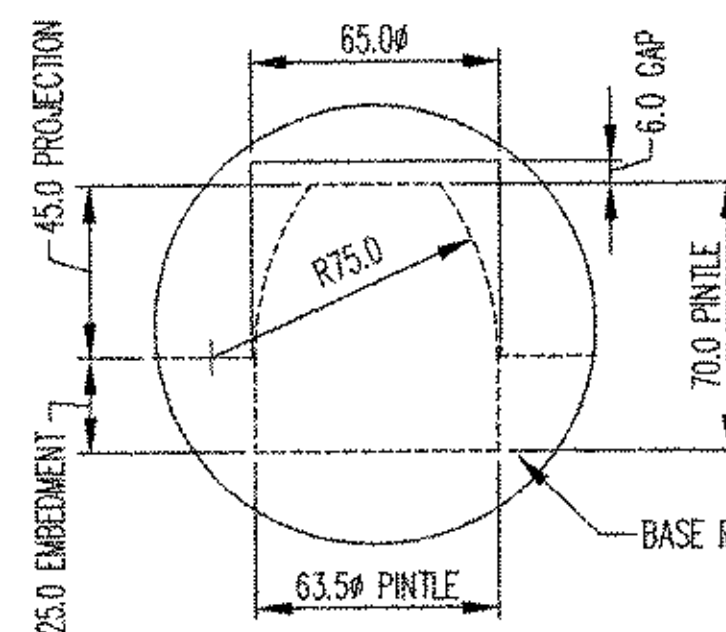


PINTLE DETAIL

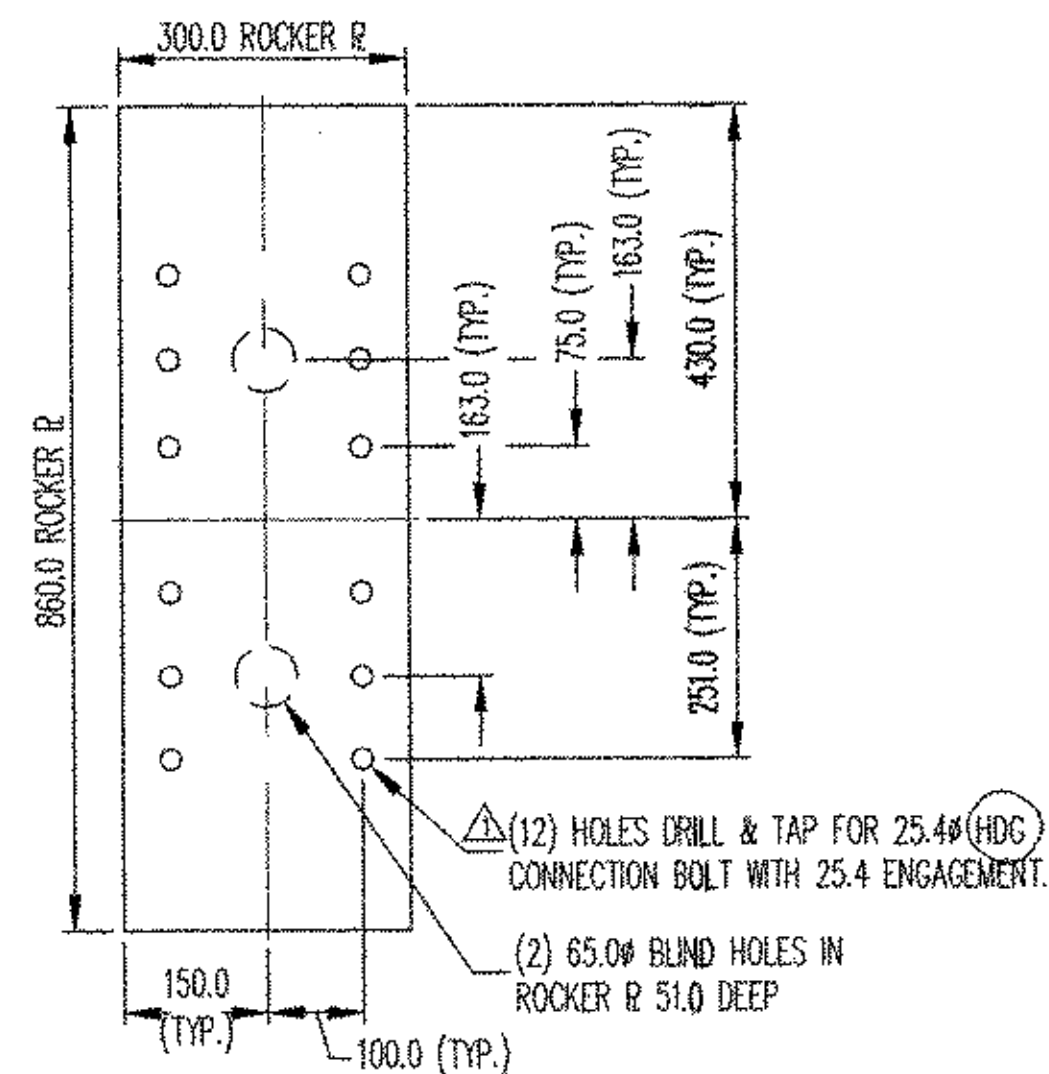


2-ROCKER PLATE

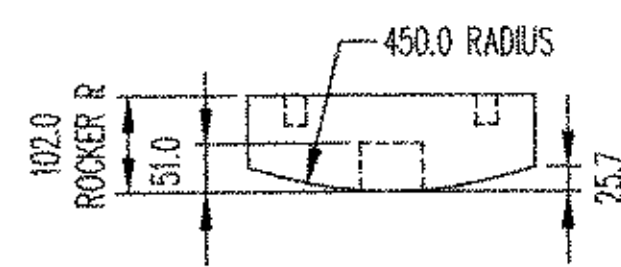


SIDE VIEW

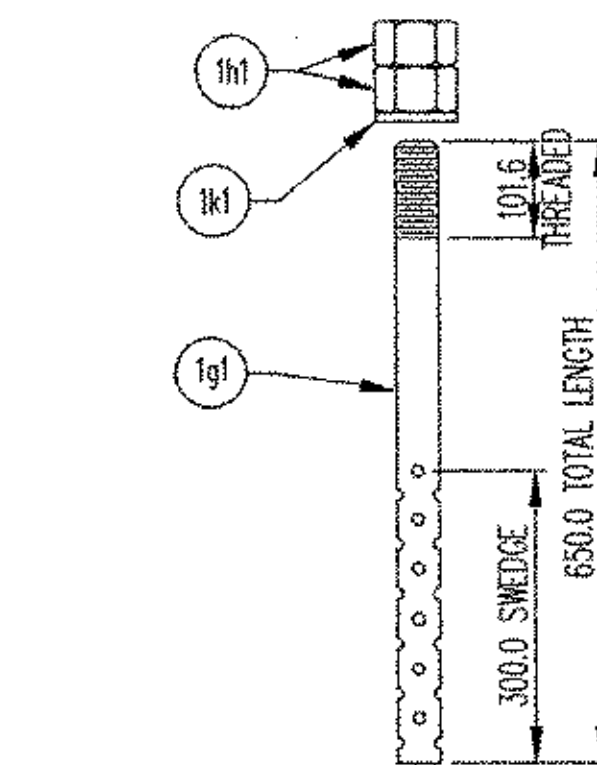

SWEDGE ANCHOR ROD DETAIL

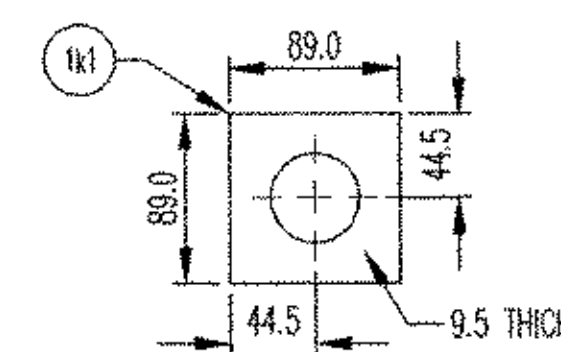


WASHER PLATE DETAIL

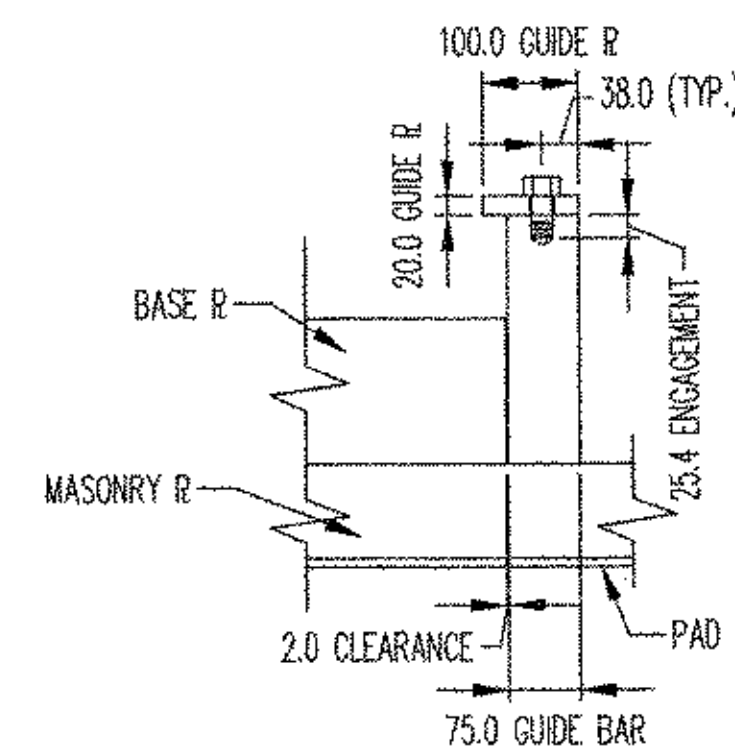

SECTION 'A-A'

MK	QTY	DESCRIPTION	MATERIAL	LENGTH	REMARKS	PART NO.
1A	2	ROCKER PLATE				
1p1	2	102.0 X 860.0	A709 GR 50W	300.0	450.0 RADIUS, GALV. A123	
1B	2	MASONRY PLATE ASSEMBLY				
1b1	4	63.5 ϕ	A709 GR 50W	70.0	PRESS FIT, GALV. A123	
1b2	4	20.0 X 100.0	A709 GR 50W	250.0	HOLES, GALV. A123	
1b3	4	261.0 X 75.0	A709 GR 50W	250.0	HOLES, GALV. A123	
1bp1	2	153.0 X 860.0	A709 GR 50W	390.0	HOLES, GALV. A123	
1mp1	2	102.0 X 1160.0	A709 GR 50W	600.0	HOLES, GALV. A123	
1C	2	BEARING PAD				
1c1	2	9.5 X 1160.0	NEOPRENE	600.0	HOLES, SHIPPED LOOSE, 5045 DURO	
1D	12	CONNECTION BOLT				
1d1	12	22.2 ϕ	A325	44.5	GALV. A153	
1F	24	CONNECTION BOLT				
1f1	24	25.4 ϕ	A325	127.0	GALV. A153	
1G	8	SWEDGE ANCHOR ROD				
1g1	8	44.5 ϕ	A449	650.0	N/D.G THREADED, 300.0 SWEDGE, GALV. A153	
1H	16	HEAVY HEX NUT				
1h1	16	44.5 ϕ	A563-DH	-	GALV. A153	
1K	8	WASHER PLATE				
1k1	8	9.5 X 89.0	A36	89.0	GALV. A123	

NOTE: ALL MATERIALS SPECIFICATION DESCRIPTIONS ARE ASTM, UNLESS OTHERWISE NOTED.

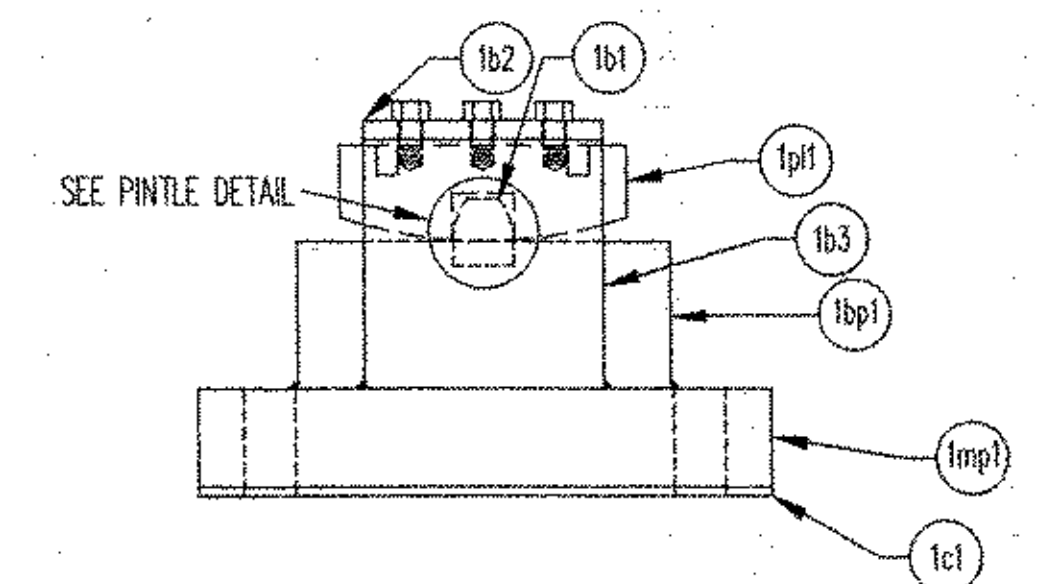

ASSEMBLY VIEW
STEEL FIXED BEARING
(2) REQ'D @ SOUTH ABUTMENT
(2) REQ'D TOTAL

PROJECT	NH 010-2(2)
DATE	4/23/03
DESIGNER	CONSULTING ENGINEERS
CHECKED BY	N.T.S. B. COPPUSSE, KELLEY
DATE	3/20/03
PROJECT NUMBER	7657
PROJECT CODE	1121
RELEASE	1
SHEET	1


FOR GENERAL NOTES SEE SHEET GN

REV.	DESCRIPTION	DATE	DET.	CHKD.
A	ADDED GALVANIZING TO HARDWARE AND PLATES	4/23/03	BC	EK


LOCATION	BRIDGE	PROJECT	DESIGNER	CUSTOMER
VT ROUTE 9	62.56	NH 010-2(2)	CONSULTING ENGINEERS	JA McDONALD

ITEM	QUANTITY
7652-1121-1	2 OF 2


D.S. BROWN
300 E. CHERRY STREET
NORTH BALTIMORE, OHIO 45872
419.257.3561
FAX: 419.257.0332
4201 NOREX DRIVE
CHASKA, MINNESOTA 55318
952.368.3000
FAX: 952.448.7000
DSBROWN.COM

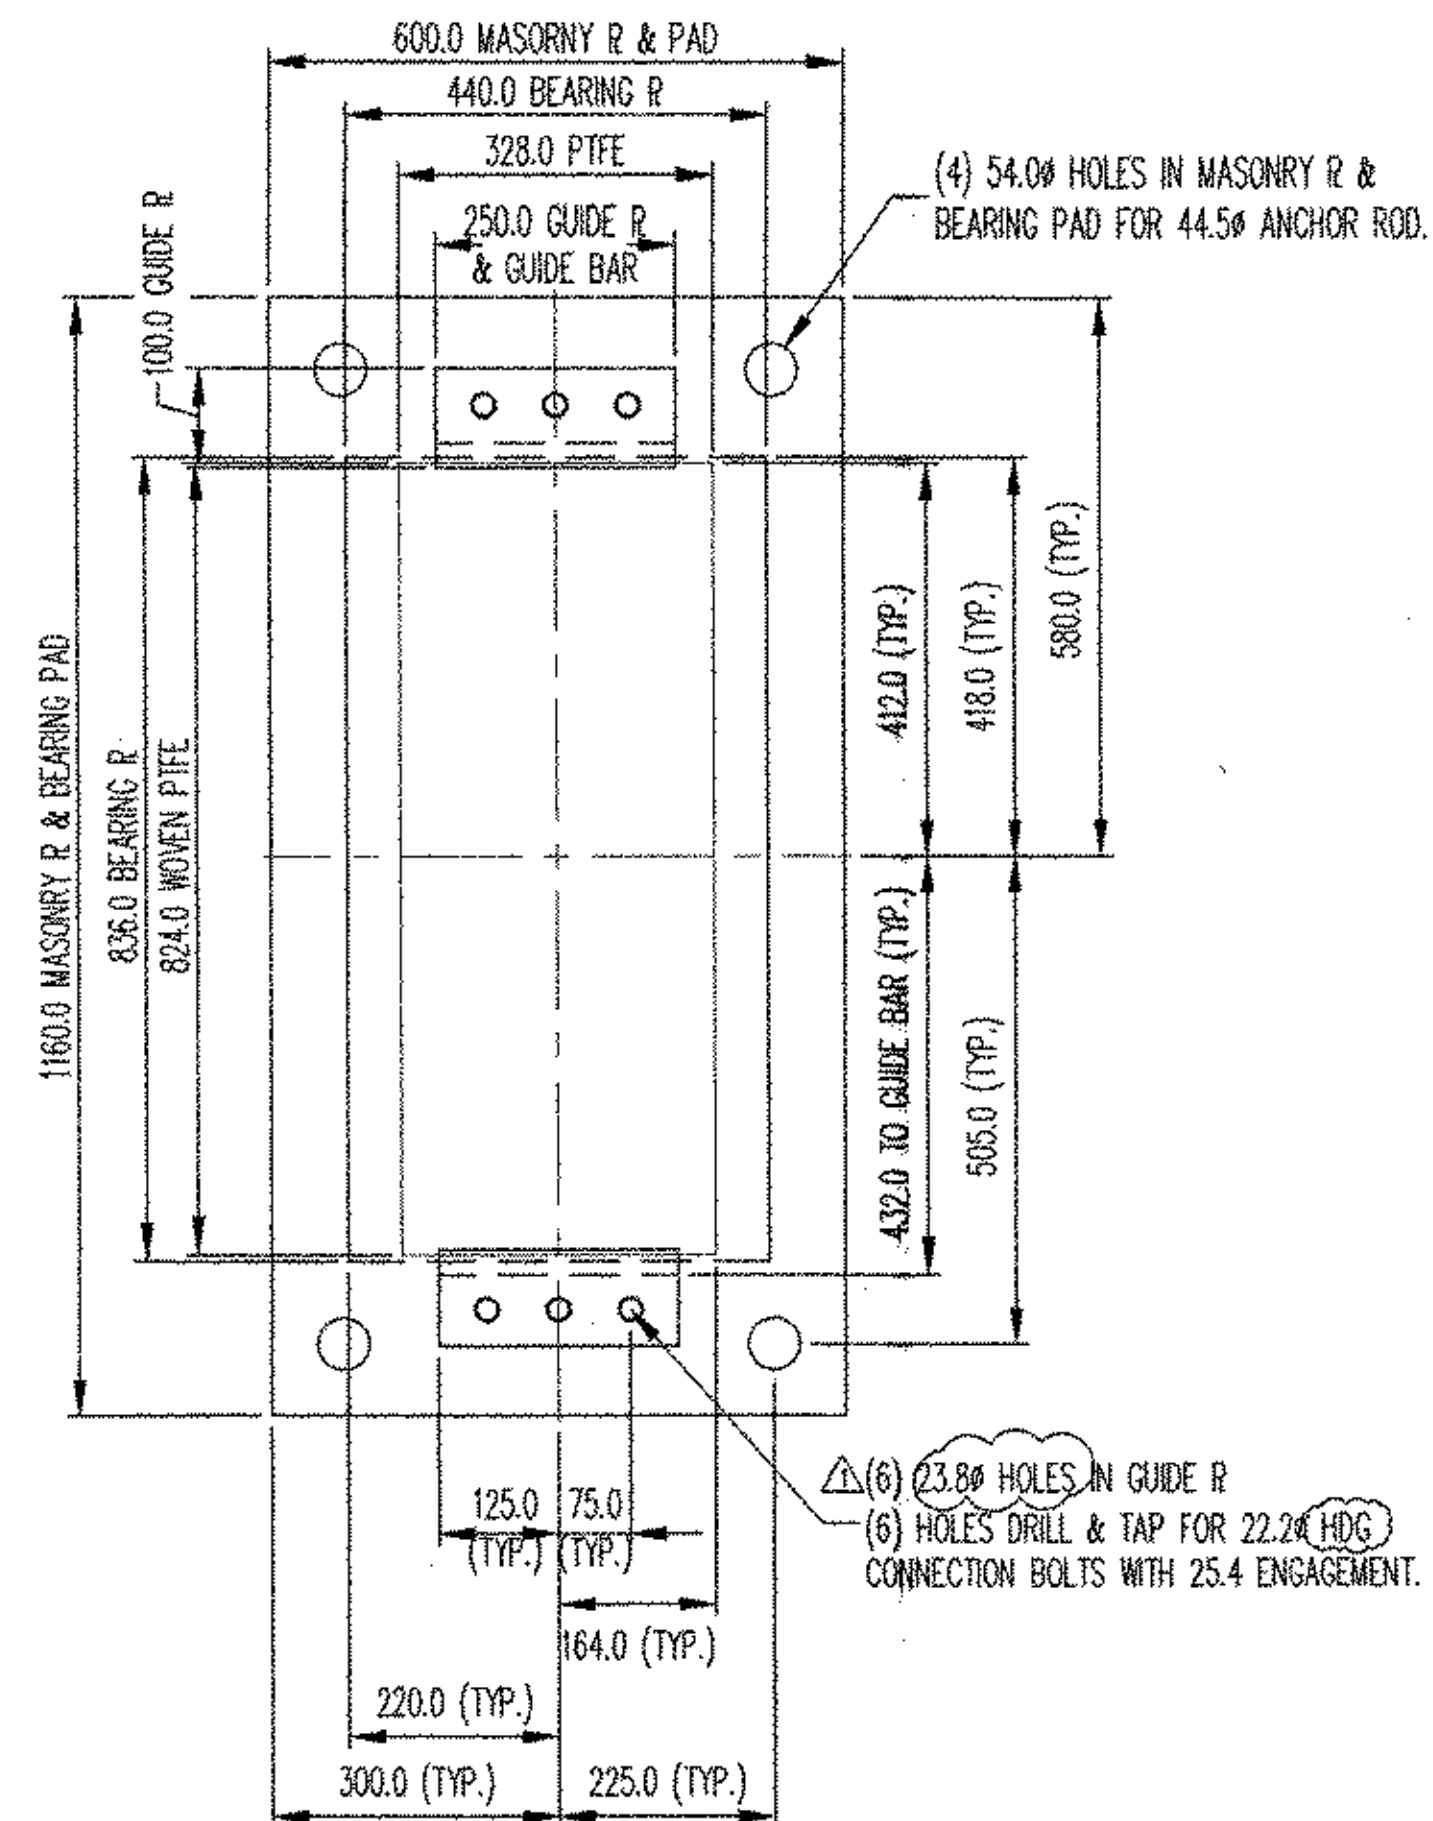


2-MASONRY PLATE ASSEMBLY

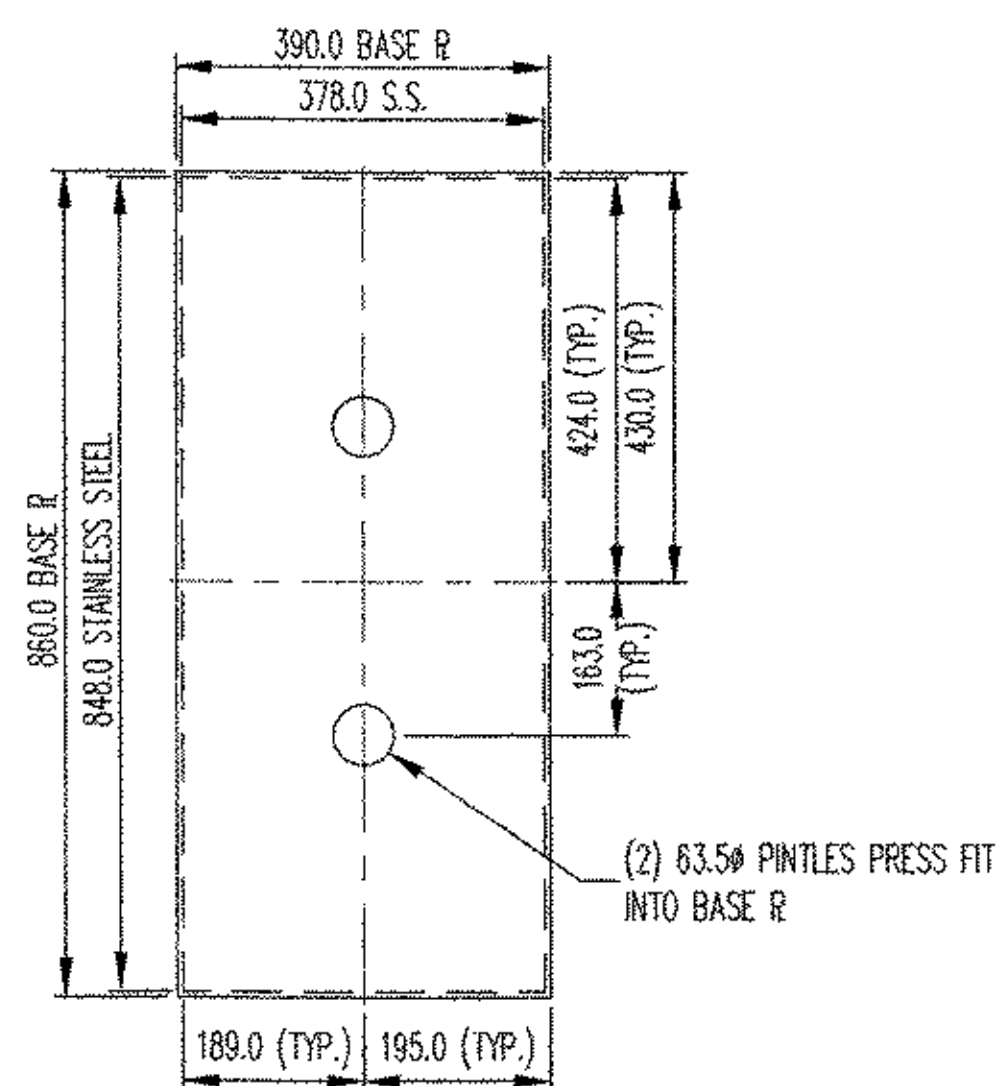


2-BASE PLATE ASSEMBLY

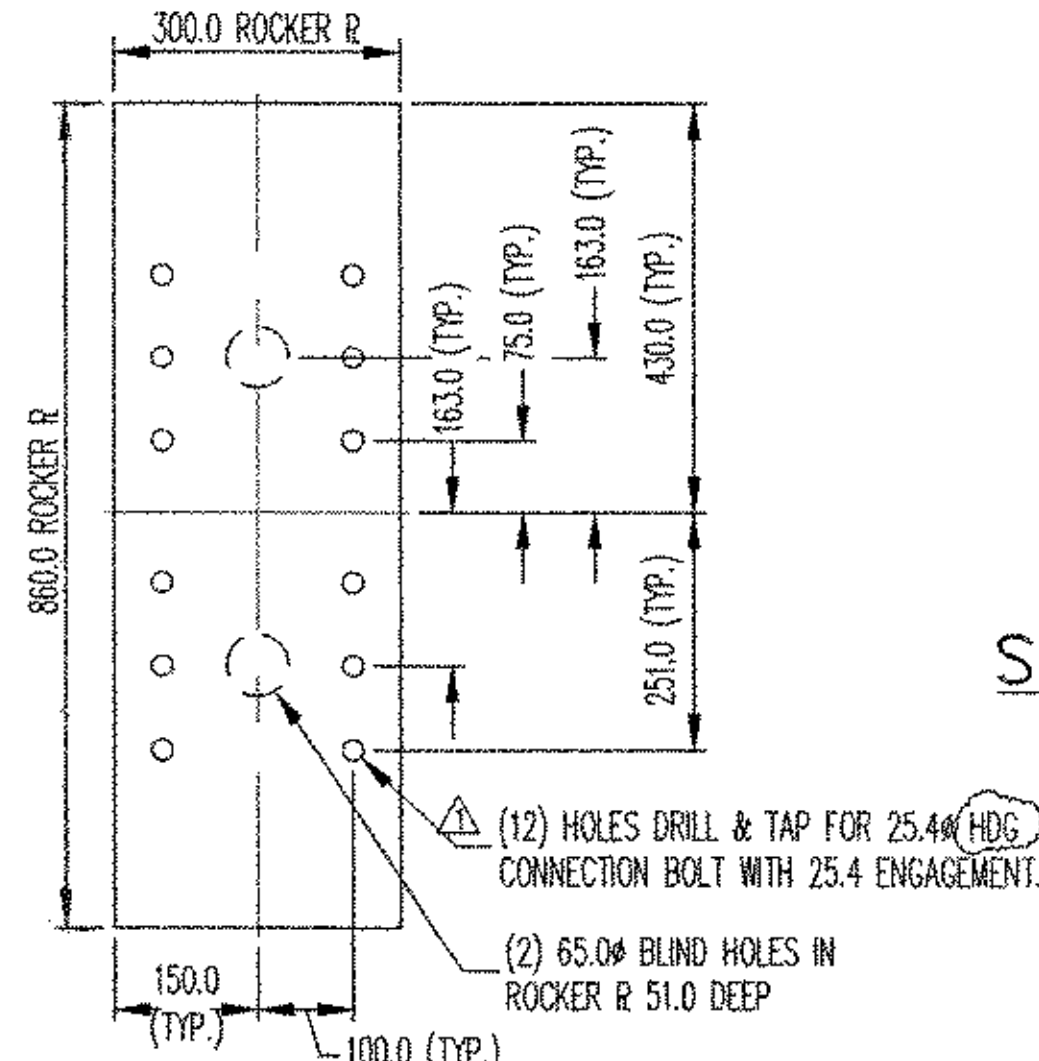


2-ROCKER PLATE

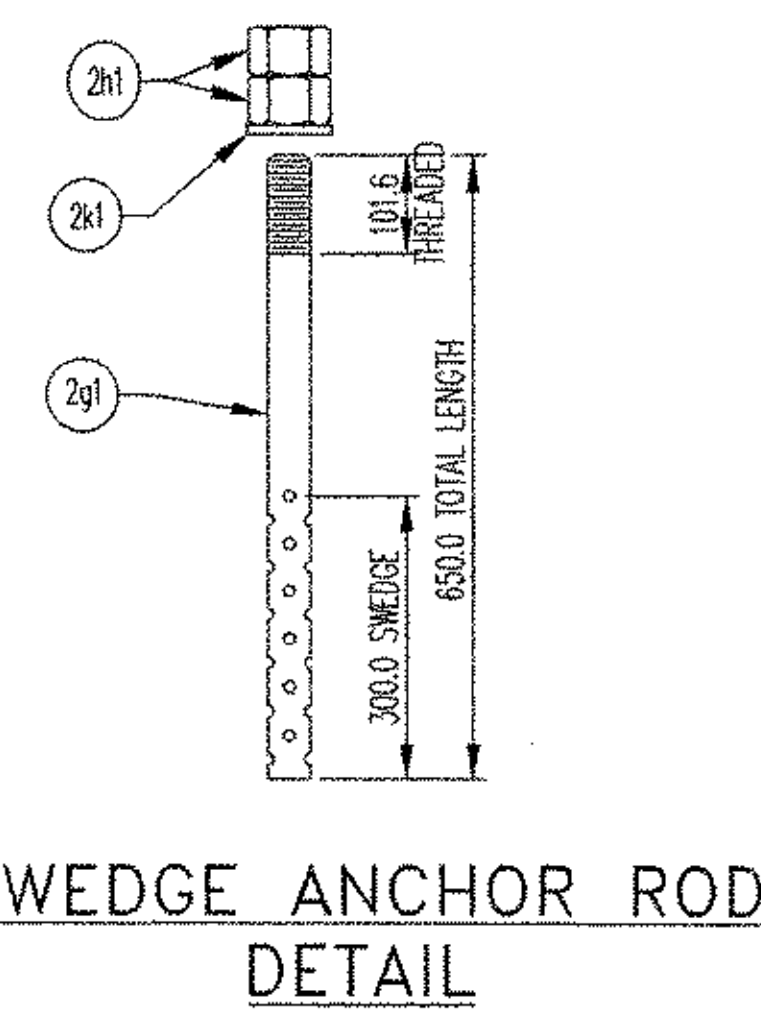


SWEDGE ANCHOR ROD DETAIL

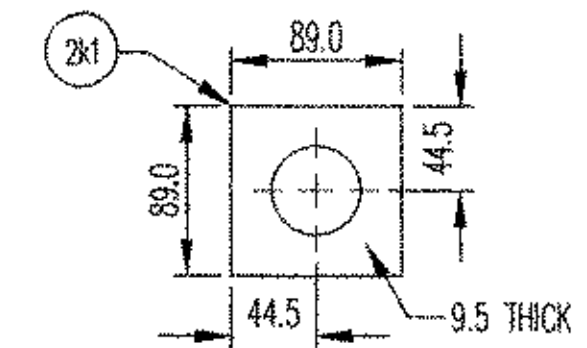

WASHER PLATE DETAIL

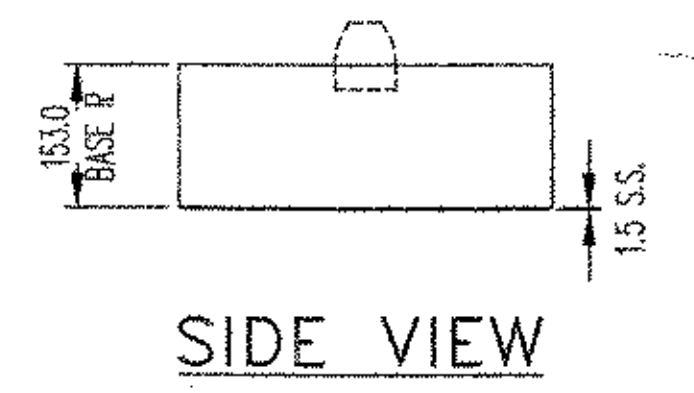


SIDE VIEW

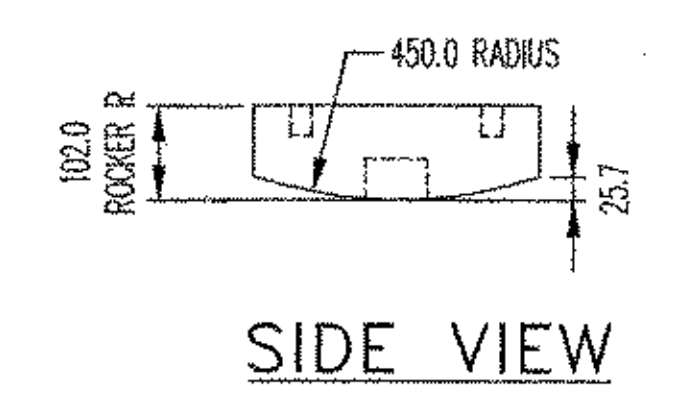


SIDE VIEW

LOAD TABLE


LOAD DATA	7657-1121-2
VERTICAL LOAD (kN)	2970
HORIZONTAL LOAD TRANSVERSE (kN)	209
HORIZONTAL LOAD LONGITUDINAL (kN)	--

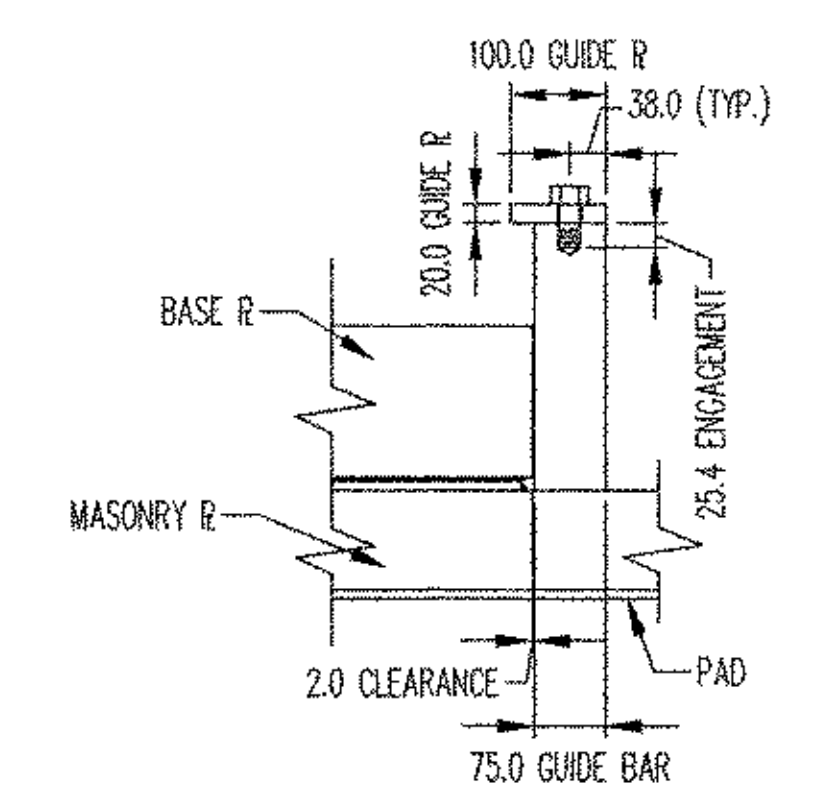


SECTION 'A-A'

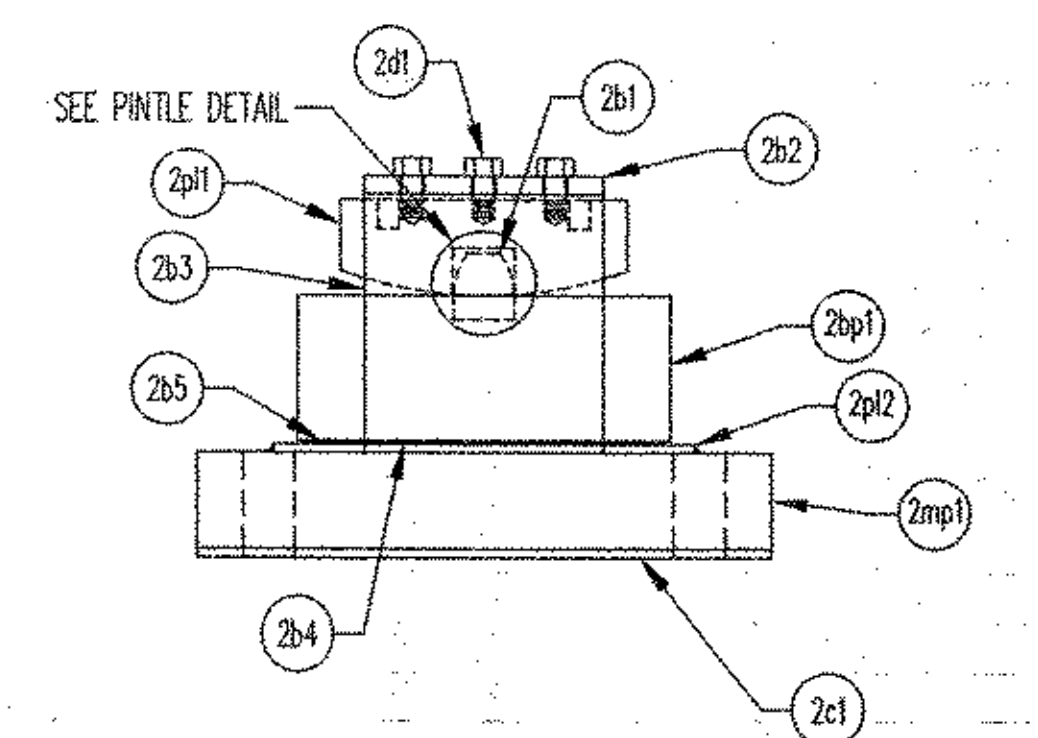


ASSEMBLY VIEW
STEEL EXPANSION BEARING
(2) REQ'D @ SOUTH ABUTMENT
(2) REQ'D TOTAL

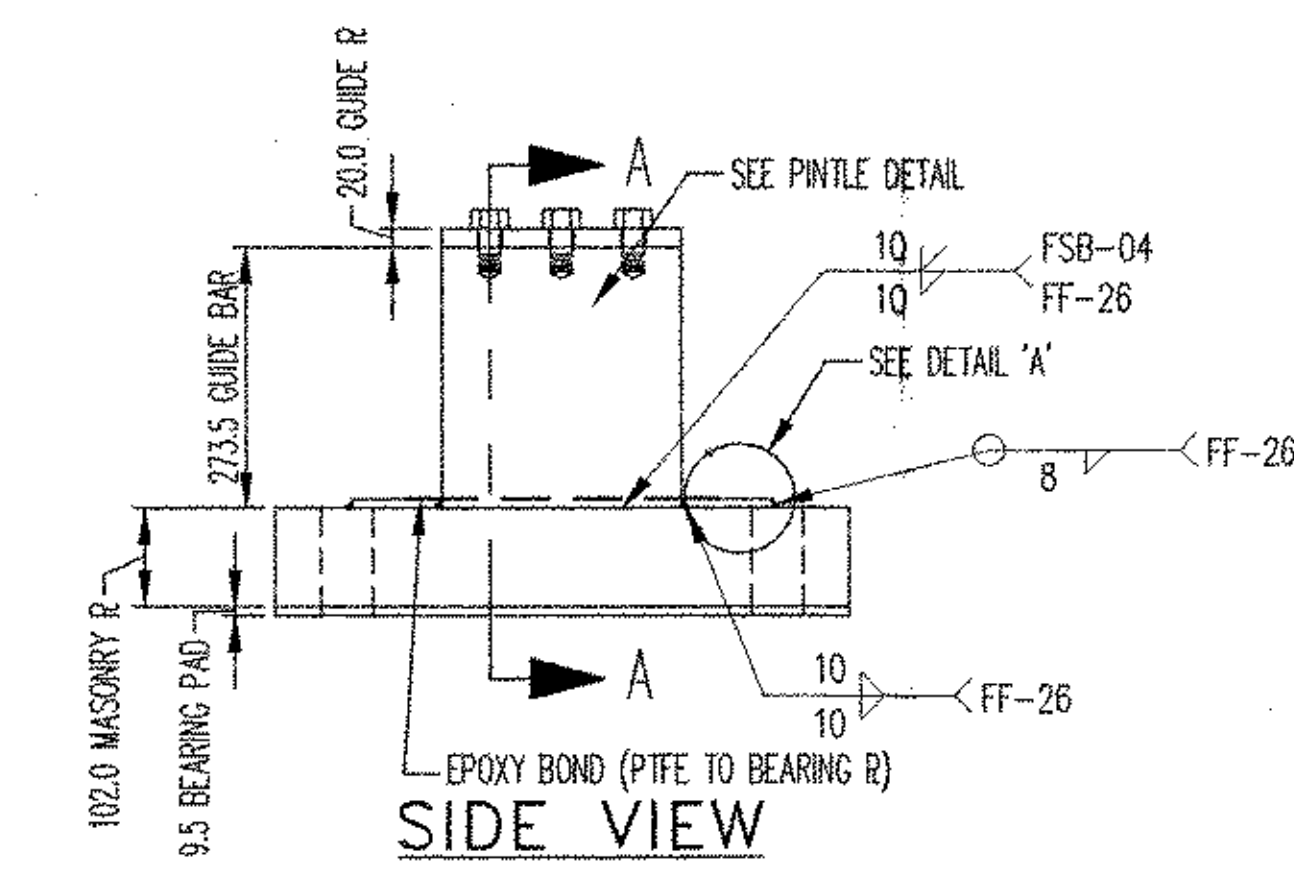

STAINLESS STEEL WELD DETAIL

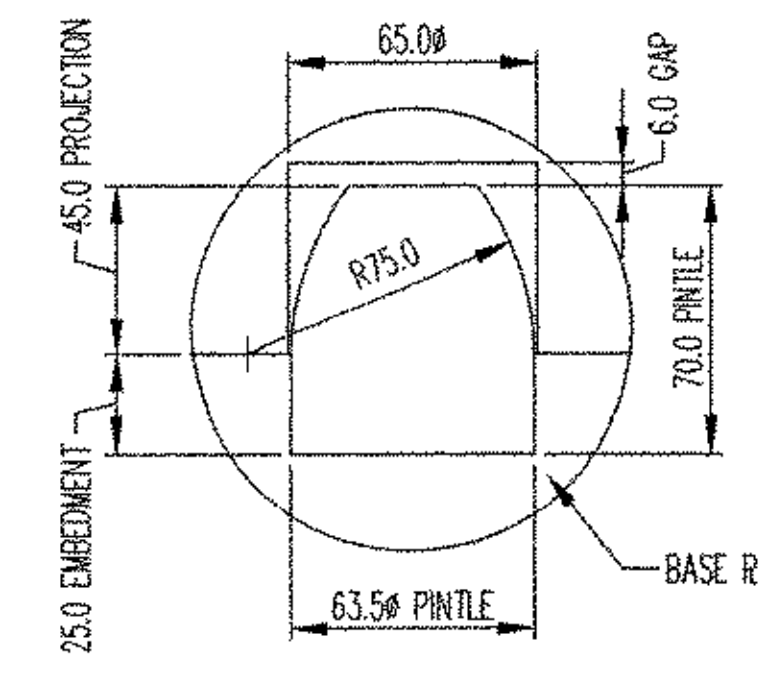

PINTLE DETAIL

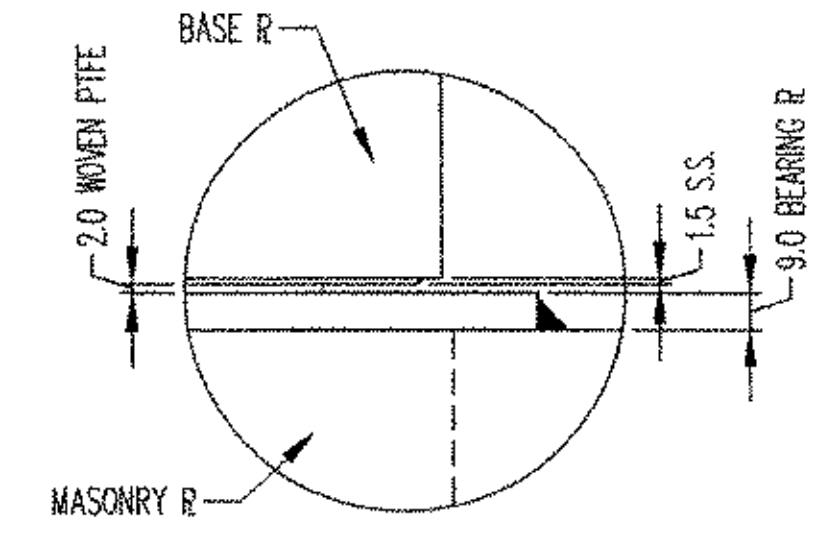

DETAIL 'A'

MK	QTY	DESCRIPTION	MATERIAL	LENGTH	REMARKS	PART NO.
2A	2	ROCKER PLATE				
2pl1	2	102.0 X 860.0	A709 GR 50W	300.0	450.0 RADIUS, GALV. A123	
2B	2	MASONRY PLATE ASSEMBLY				
2b1	4	63.5#	A709 GR 50W	70.0	PRESS FIT, GALV. A123	
2b2	4	20.0 X 100.0	A709 GR 50W	250.0	HOLES, GALV. A123	
2b3	4	273.5 X 75.0	A709 GR 50W	250.0	HOLES, GALV. A123	
2b4	2	2.0 X 824.0	D4441	328.0	IRON PIPE MULTIFLAME & OTHER FIBERS	
2b5	2	16 GA X 848.0	A240 TYPE 304	378.0	#8 MIRROR FINISH	
2bp1	2	153.0 X 860.0	A709 GR 50W	390.0	HOLES, GALV. A123	
2mp1	2	102.0 X 1160.0	A709 GR 50W	600.0	HOLES, GALV. A123	
2pl2	2	9.0 X 836.0	A709 GR 50W	440.0	(GALV. A123)	
2C	2	BEARING PAD				
2c1	2	9.5 X 1160.0	NEOPRENE	600.0	HOLES, SHIPPED LOOSE, 5015 DURD	
2D	12	CONNECTION BOLT				
2d1	12	22.2#	A325	44.5	(GALV. A153)	
2F	24	CONNECTION BOLT				
2f1	24	25.4#	A325	127.0	(GALV. A153)	
2G	8	SWEDGE ANCHOR ROD				
2g1	8	44.5#	A449	650.0	101.6 THREADED, 300.0 SWEDGE, GALV. A153	
2H	16	HEAVY HEX NUT				
2h1	16	44.5#	A563-DH	--	GALV. A153	
2K	8	WASHER PLATE				
2k1	8	9.5 X 89.0	A36	89.0	GALV. A123	

NOTE: ALL MATERIALS SPECIFICATION DESCRIPTIONS ARE ASTM, UNLESS OTHERWISE NOTED.
ALL DIMENSIONS ARE IN MILLIMETERS, UNLESS OTHERWISE NOTED.

FOR GENERAL NOTES SEE SHEET GN

D.S. BROWN
300 E. CHERRY STREET
NORTH BALTIMORE, OHIO 48872
419.257.3561
FAX: 419.257.0332
4201 NOREX DRIVE
CHASKA, MINNESOTA 55318
952.368.3000
FAX: 952.448.7000
DSBROWN.COM

REV.	DESCRIPTION	DATE	DET.	CKD.
	LOCATION - VT ROUTE 9 BRIDGE - 62.56 PROJECT - NH 010-2(2)			
	DESIGNER - CONSULTING ENGINEERS CUSTOMER - JA MCDONALD			

ITEM	QUANTITY
7652-1121-2	2 OF 2

SCALE:	DRWN BY:	CHCKD BY:	DATE:
N.T.S.	R.COPPUS, KELLEY		3/20/03
PRODUCT NUMBER:	RELEASE:	1	DIST:
7657	1121	1	2

GENERAL SHOP NOTES

PROPOSED IMPROVEMENT TO RR BRIDGE #62.56
OVER VT ROUTE 9 (PRINCIPAL ARTERIAL)
IN THE TOWN OF BRATTLEBORO
WINDHAM COUNTY, VT

1 SPECIFICATIONS

ALL MATERIALS AND CONSTRUCTION SHALL CONFORM TO THE STATE OF VERMONT AGENCY OF TRANSPORTATION'S STANDARD SPECIFICATIONS FOR CONSTRUCTION, DATED 2001, AND ITS LATEST REVISIONS; AREMA'S "MANUAL FOR RAILWAY ENGINEERING", LATEST EDITION; THE AASHTO STANDARD SPECIFICATIONS FOR HIGHWAY BRIDGES, SIXTEENTH EDITION, AND ITS LATEST REVISION.

2 MATERIAL

ALL STRUCTURAL STEEL SHALL BE AASHTO M270M/M270M-93 GRADE 345W
ALL BOLTS SHALL BE 22MM DIAMETER AASHTO M164M-93 TYPE 3
NUTS SHALL BE AASHTO M291M-93, GRADE 1053 HVY. HEX NUTS
WASHERS SHALL BE AASHTO M293M (WEATHERING)

MEMBERS MARKED GR345WT2 SHALL CONFORM TO CHARPY V-NOTCH TESTING IN ACCORDANCE WITH AASHTO T243 FREQUENCY "H", ZONE 2
20 J. @ 4°C UP TO 2" (INCL.)
27 J. @ 4°C UP TO 2" TO 4"

MEMBERS MARKED GR345WF2 ARE FRACTURE CRITICAL AND SHALL CONFORM TO CHARPY V-NOTCH TESTING IN ACCORDANCE WITH AASHTO T243, FREQUENCY "PP", ZONE 2.
25 J. @ 4°C UP TO 2" (INCL.)
30 J. @ 4°C UP TO 2" TO 4"

3 FABRICATION AND WORKMANSHIP

ALL REENTRANT CUTS TO HAVE A MINIMUM 50MM RADIUS U.N.O.
FLOOR BEAMS SHALL BE FABRICATED WITH THEIR NATURAL CAMBER UP

ALL GIRDERS ARE FRACTURE CRITICAL MEMBERS AND REQUIRE THE FRACTURE CRITICAL CONTROL PLAN PER AREMA CHAPTER 15. TEST REPORTS AND SPECIMENS SHALL BE DELIVERED TO THE ENGINEER FOR EXAMINATION. ALL CERTIFICATION AND REQUIREMENTS OF AREMA SHALL BE FOLLOWED AND REPORTS AND DOCUMENTATION SHALL BE PROVIDED TO THE ENGINEER.

ALL STRUCTURAL STEEL SHALL BE DETAILED AND FABRICATED USING PROCEDURES AND TOLERANCES IN ACCORDANCE WITH APPLICABLE PUBLICATIONS OF THE AMERICAN RAILWAY ENGINEERING AND MAINTENANCE-OF-WAY ASSOCIATION (AREMA).

4 SHOP WELDING AND TESTING NOTES

ALL WELDING AND INSPECTION OF WELDS SHALL CONFORM TO ANSI/AASHTO/AWS D1.5


5 SHOP CLEANING AND PAINTING

THE STRUCTURAL STEEL OF THIS BRIDGE SHALL NOT BE PAINTED

IN THE FABRICATION SHOP THE OUTSIDE SURFACE OF THE FASCIA GIRDER SHALL BE CLEANED OF ALL DIRT, GREASE, PAINT, MILL SCALE OR OTHER FOREIGN MATERIAL PRIOR TO SHIPPING. THE PURPOSE OF THE CLEANING IS TO PRODUCE FASCIA SURFACES WHICH WILL WEATHER UNIFORMLY


6 MISC.

A NAMEPLATE BEARING THE NAME OF THE MANUFACTURER AND THE DATE OF MANUFACTURE SHALL BE ATTACHED IN A VISIBLE LOCATION AT THE SOUTH END OF 2G2A.

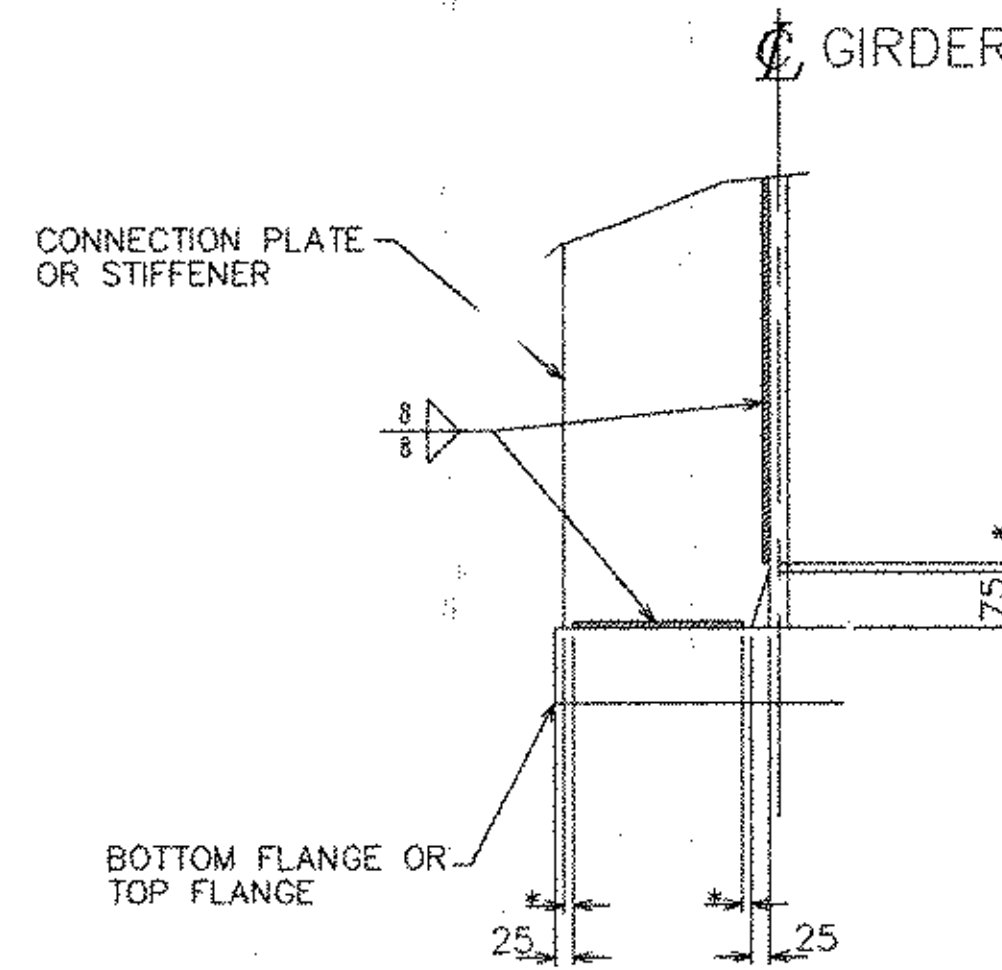

TYPICAL WELD DETAIL (EXCEPT INTERMEDIATE STIFFENERS)** Δ

* = NO WELD FOR 6 MIN. 12 MAX.
(EXCEPT MUST MAINTAIN 25 MIN. FROM EDGE OF FLANGE)
** EXCEPT AT INTERMEDIATE STIFFENER AT BOTTOM FLANGE (TENSION FLANGE)

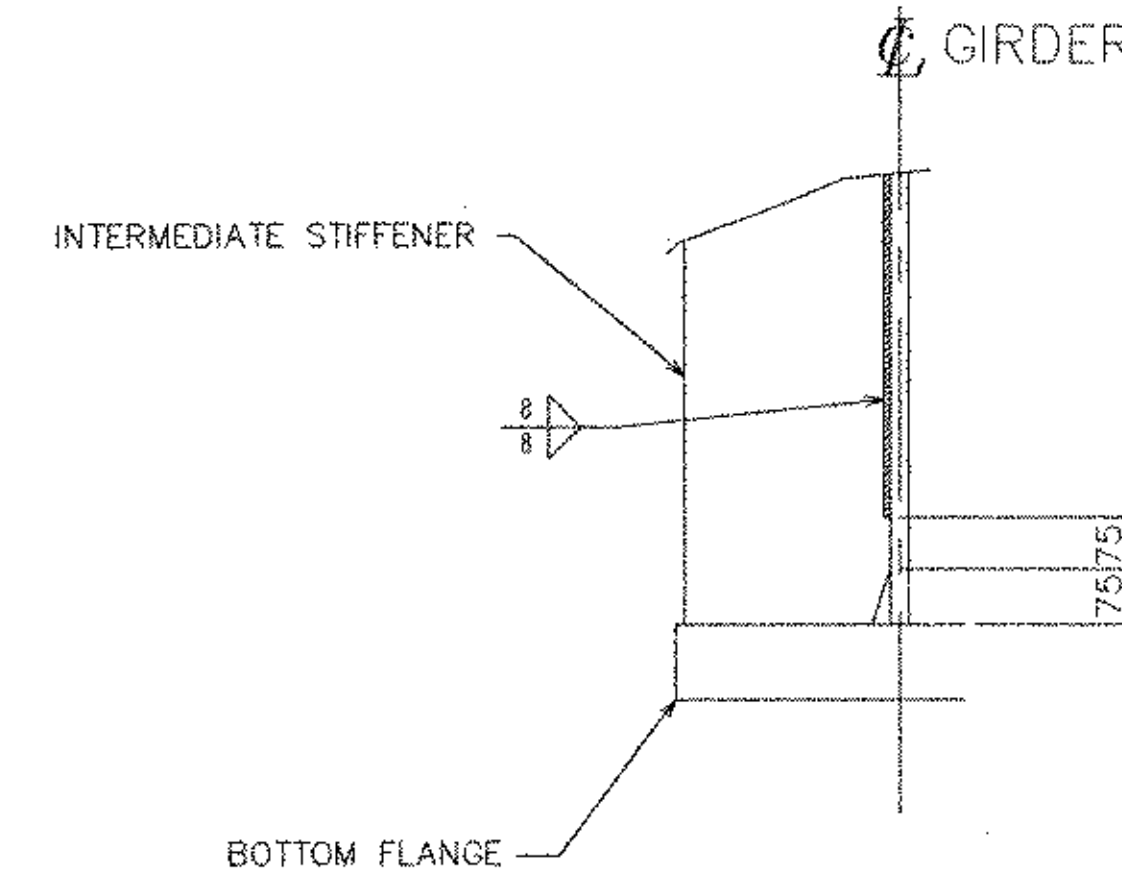

TYPICAL WELD DETAIL FOR INTERMEDIATE STIFFENERS Δ


AT BOTTOM FLANGE (TENSION FLANGE) ONLY

STEEL-ART, INCORPORATED
40 WEST MAIN STREET
GALETON, PA 16922
(814) 435-6997




EASTERN BRIDGE LLC
RURAL RTE 2, BOX 302
CLAREMONT, NH 03743
608-542-5202

REVISIONS			STATE OF VERMONT AGENCY OF TRANSPORTATION	
NO.	DATE	DESCRIPTION	CONTRACT	PIN
1	5/14/03	PER APPROVAL	PROPOSED IMPROVEMENT TO RR BRIDGE #62.56	
Δ	6/24/03	PER APPROVAL	OVER VT ROUTE 9 (PRINCIPAL ARTERIAL)	
	8/4/03	Approval	WINDHAM COUNTY, TOWN OF BRATTLEBORO	
			TITLE:	
			GENERAL NOTES	
			DRAWN BY TJS	SHOP ORDER
			3/24/03	4015
			CKD BY RGY	BLOCK NO.
			4/14/03	
			DWG. NO.	GNI
			SHEET NO.	1 / 20

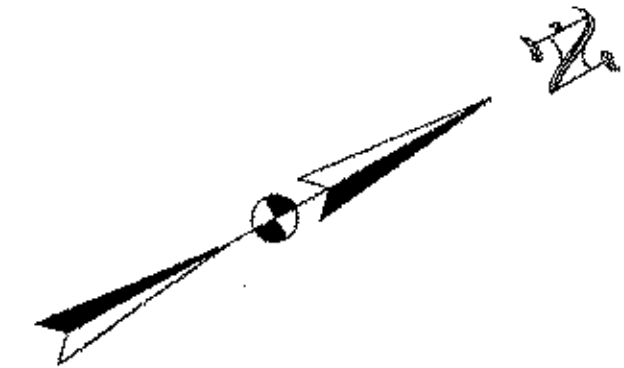

CONCRETE PAD ELEVATIONS		
GIRDER	Q SOUTH ABUT. FIXED	Q NORTH ABUT. EXP.
1G1A	86.473	86.681
2G2A	86.473	86.681

No.	Mark	Mark	Material	Quantity	Notes
1904	H.S. BOLTS	7/8"	A325 TYPE 3	70	
1904	H. HEX NUTS	7/8"	A563 GR. C3		
1904	STD. WASH.	7/8"	F436		
512	H.S. BOLTS	7/8"	A325 TYPE 3	76	
512	H. HEX NUTS	7/8"	A563 GR. C3		
512	STD. WASH.	7/8"	F436		
56	H.S. BOLTS	7/8"	A325 TYPE 3	95	
56	H. HEX NUTS	7/8"	A563 GR. C3		
56	STD. WASH.	7/8"	F436		
40	H.S. BOLTS	5/8"	A325 TYPE 3	40	
40	H. HEX NUTS	5/8"	A563 GR. C3		
40	STD. WASH.	5/8"	F436		

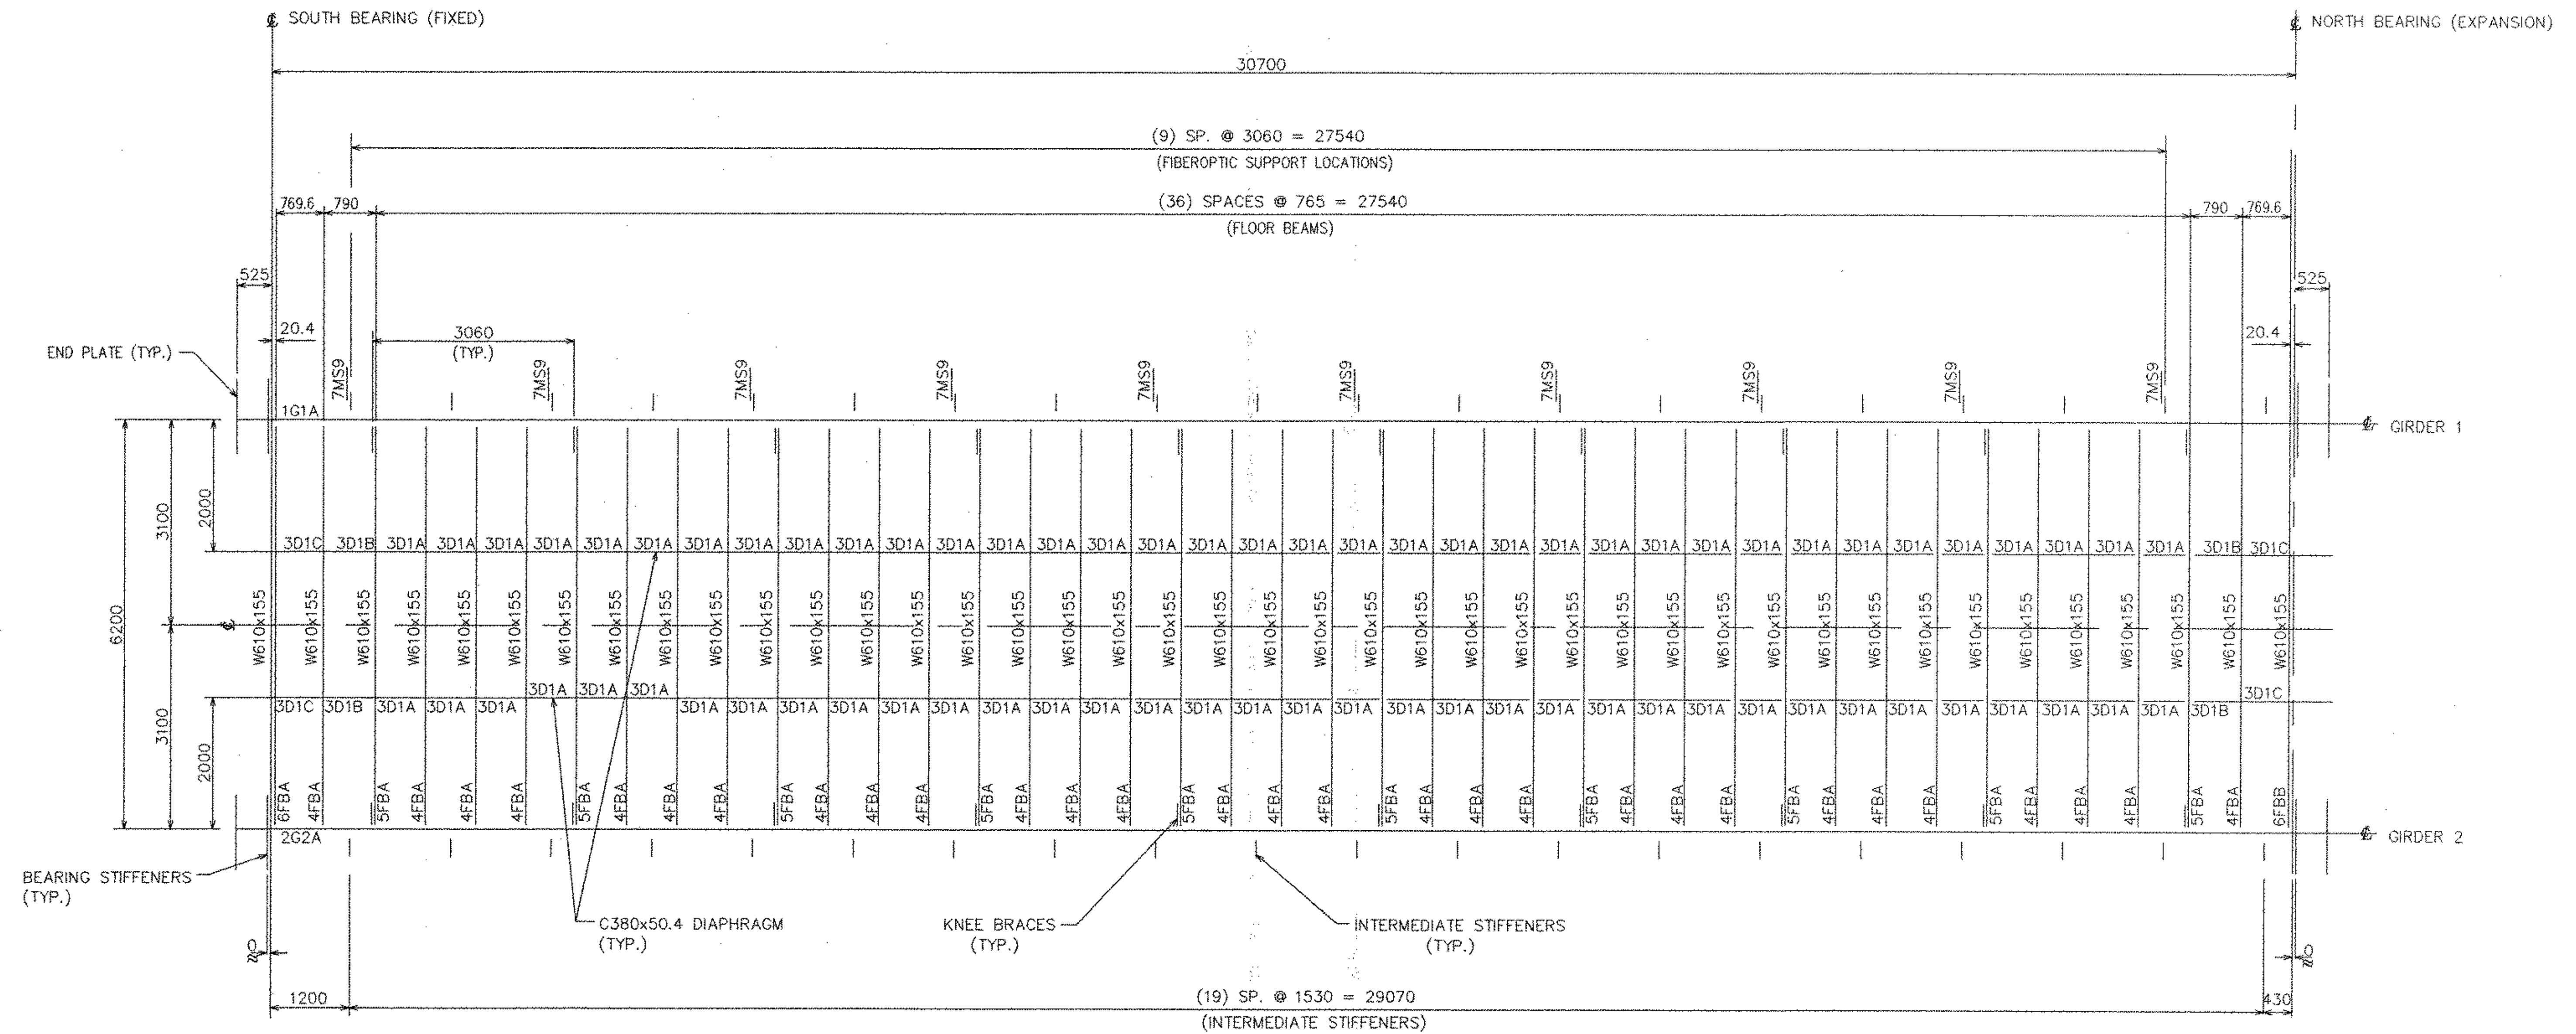


FRAMING PLAN
 NOTE:
 LIFTING WEIGHT OF GIRDERS
 IS 112,000 POUNDS.

STEEL-ART, INCORPORATED
 40 WEST MAIN STREET
 GALETON, PA 16922
 (814) 435-6997


EASTERN BRIDGE LLC
 RURAL RTE 2, BOX 322
 CLAREMONT, NH 03743
 608-542-5202

REVISIONS			STATE OF VERMONT AGENCY OF TRANSPORTATION	
NO.	DATE	DESCRIPTION	CONTRACT	PIN
	2/14/03	APPROVAL	PROPOSED IMPROVEMENT TO RR BRIDGE #62.56 OVER VT ROUTE 9 (PRINCIPAL ARTERIAL) WINDHAM COUNTY, TOWN OF BRATTLEBORO	
FRAMING PLAN				
DRAWN BY	DAN	SHOP ORDER		DWG. NO.
		3/17/03	4015	E1
CHKD BY	RJS	BLOCK NO.		SHEET NO.
		4/14/03		2 / 20


18655

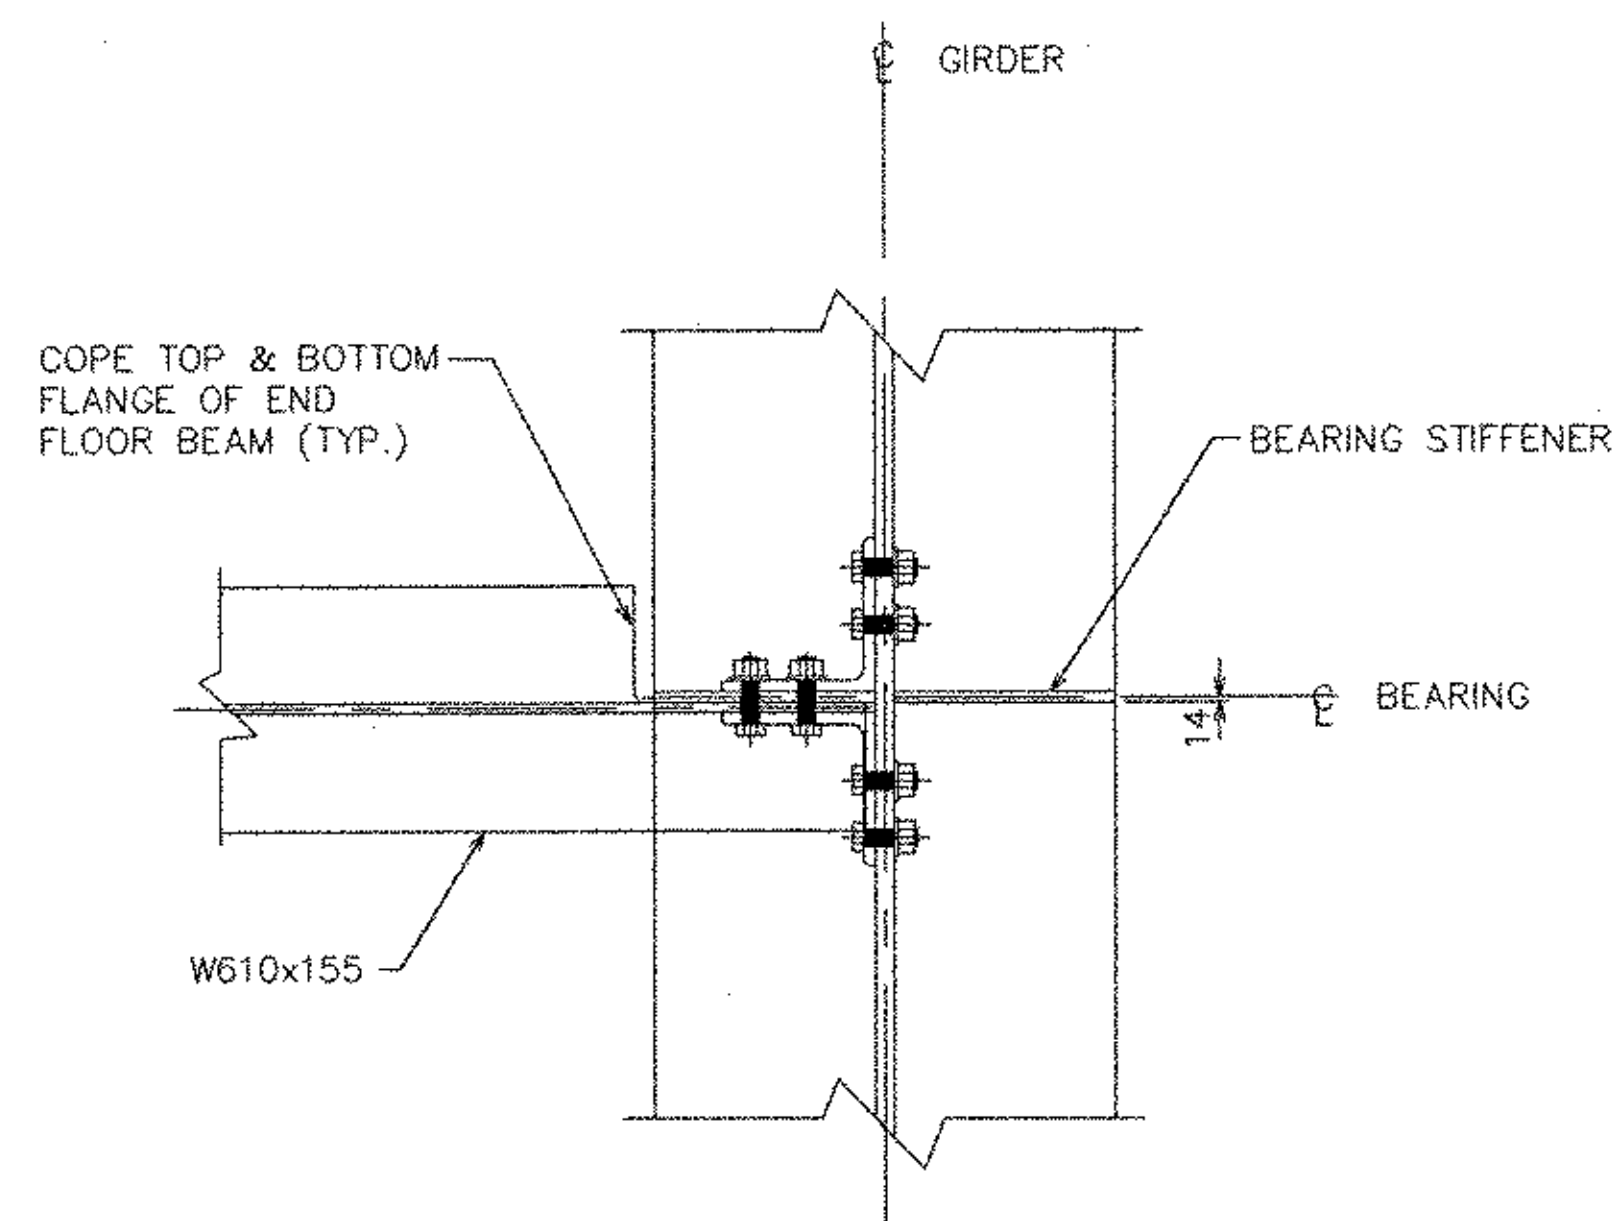


SECTION 2-2

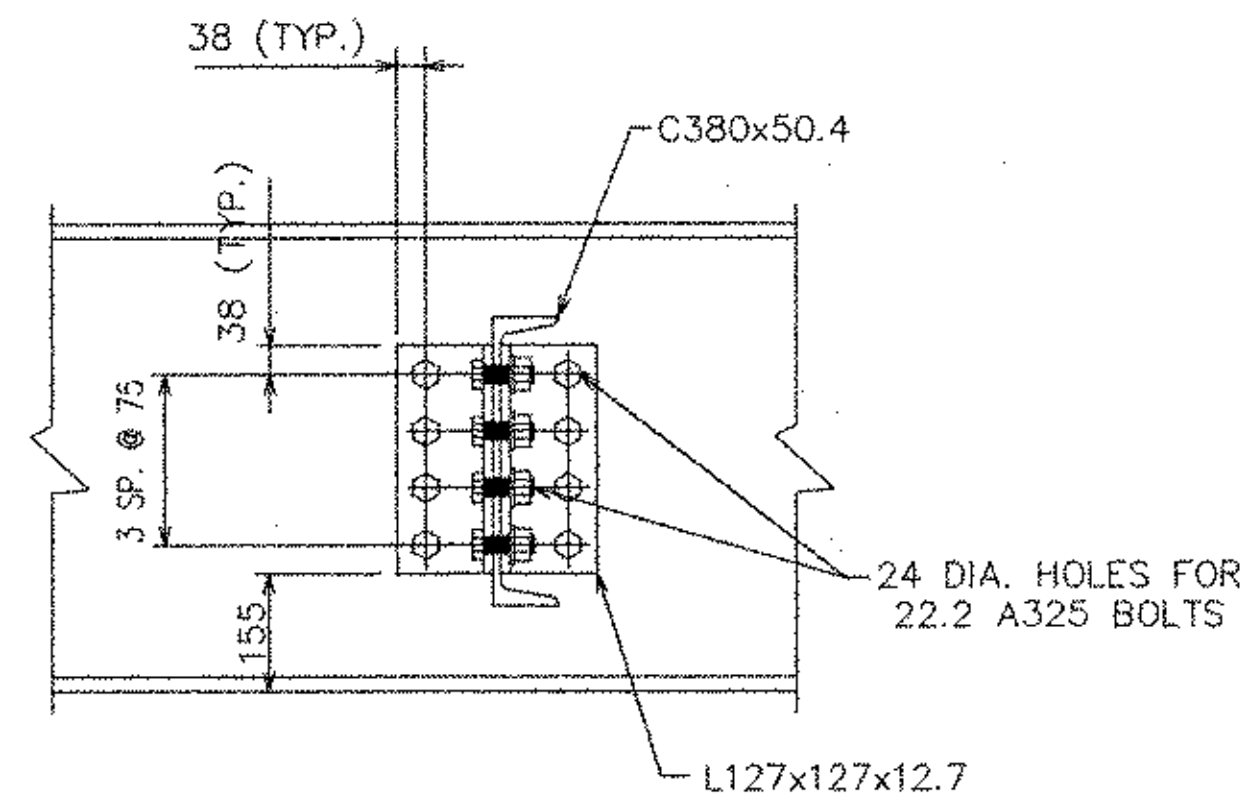

DIAPHRAGM CONNECTION DETAIL

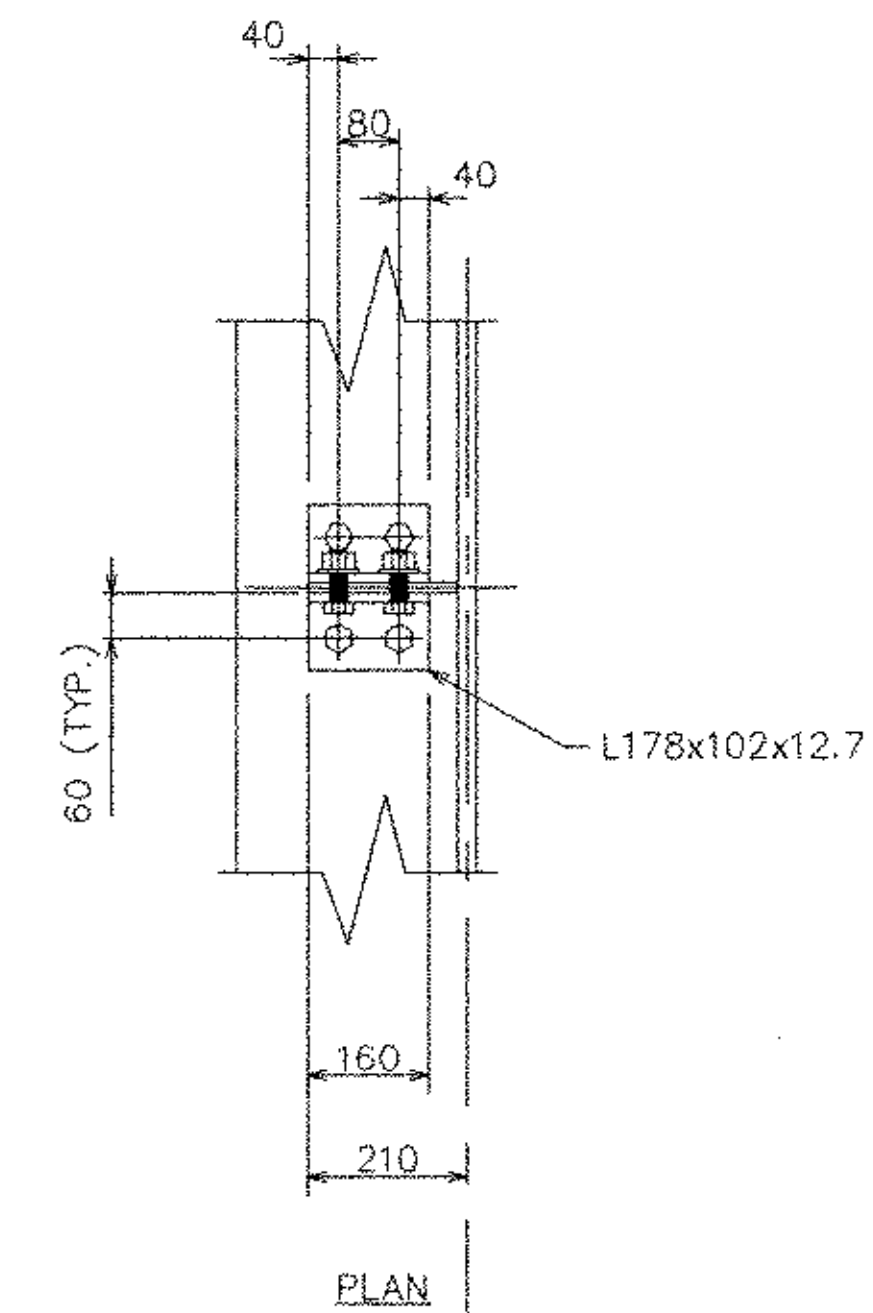


PLAN

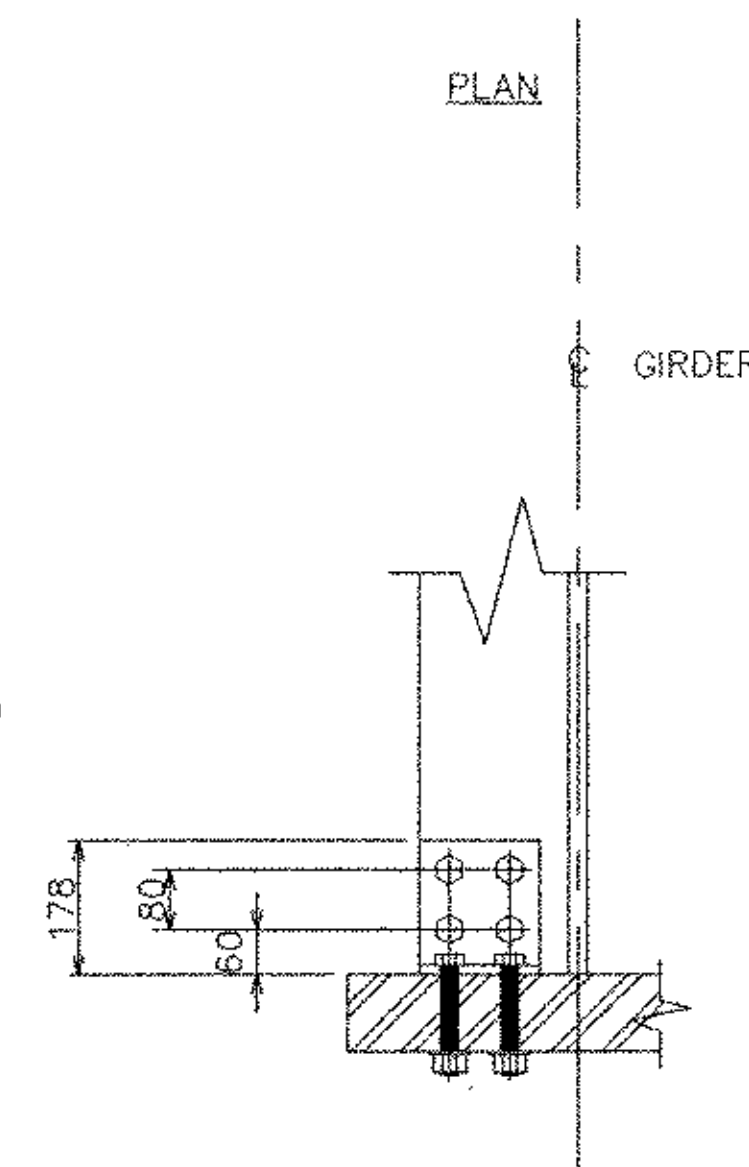


ELEVATION


DETAIL A
BOLTING OF INTERMEDIATE STIFFENER
NEAR BEARING

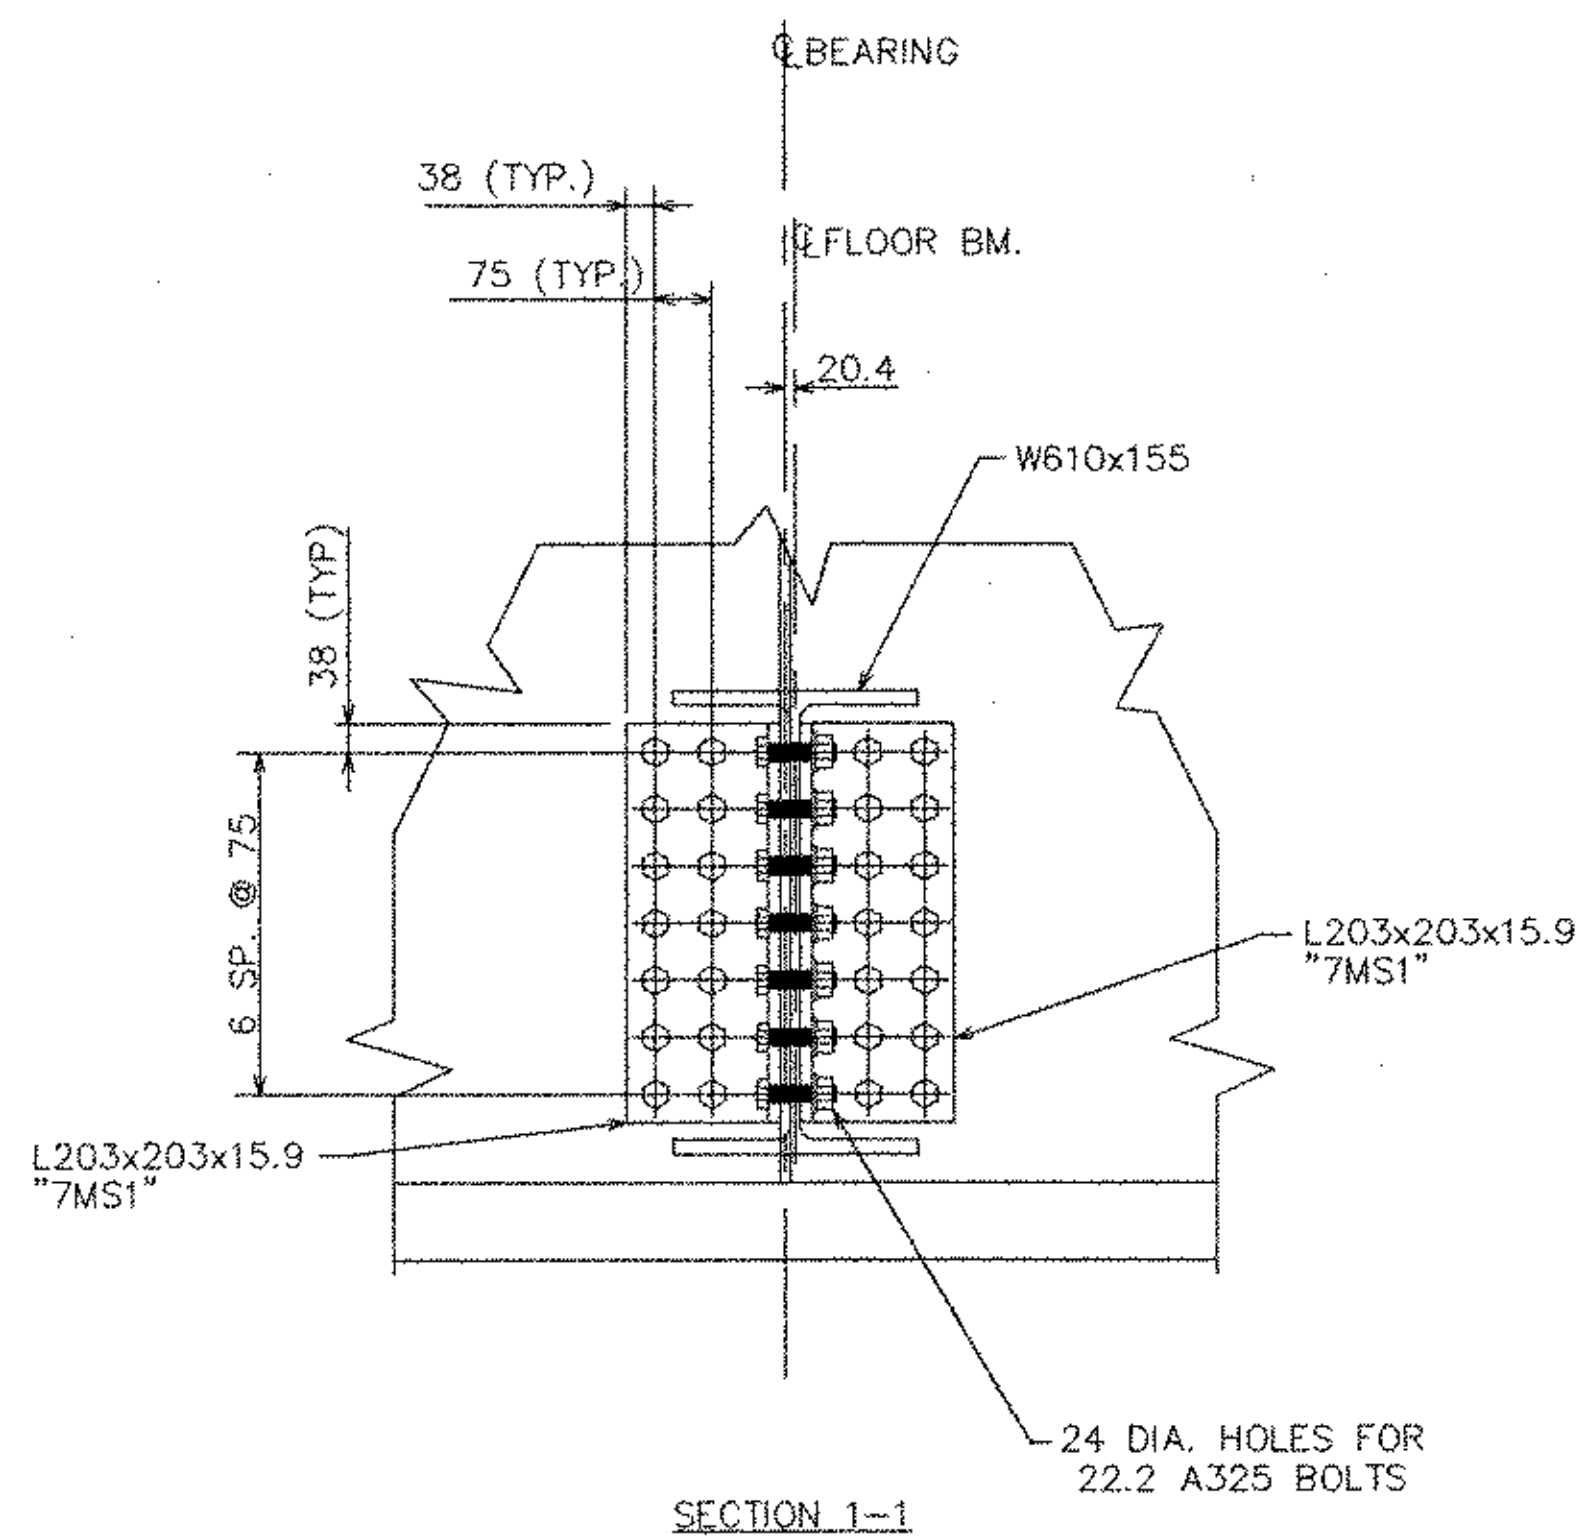

SECTION 1-1

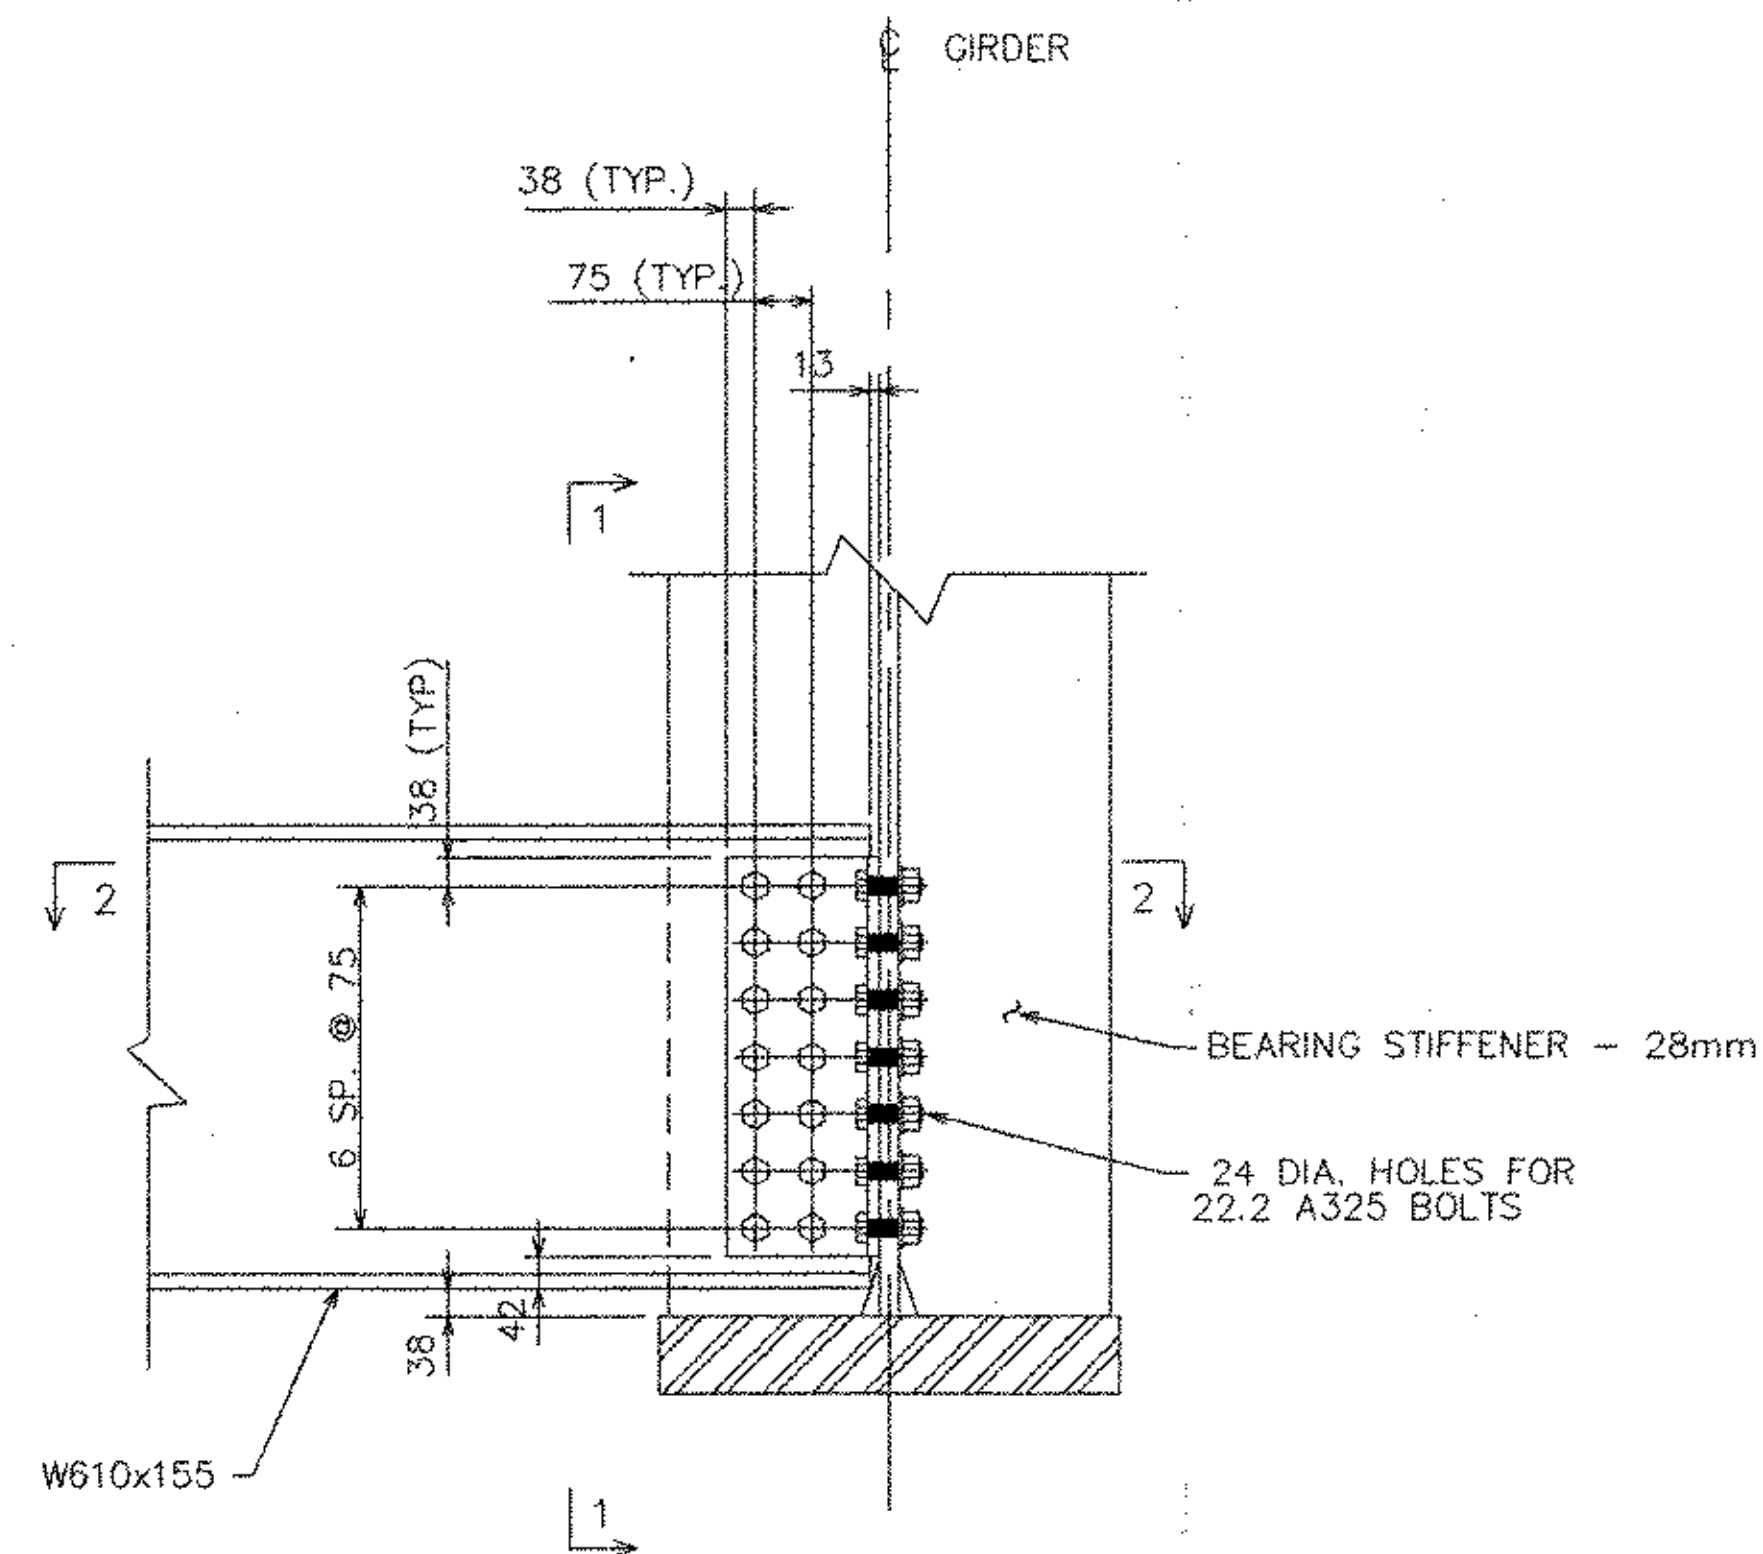

END FLOOR BEAM CONNECTION DETAIL

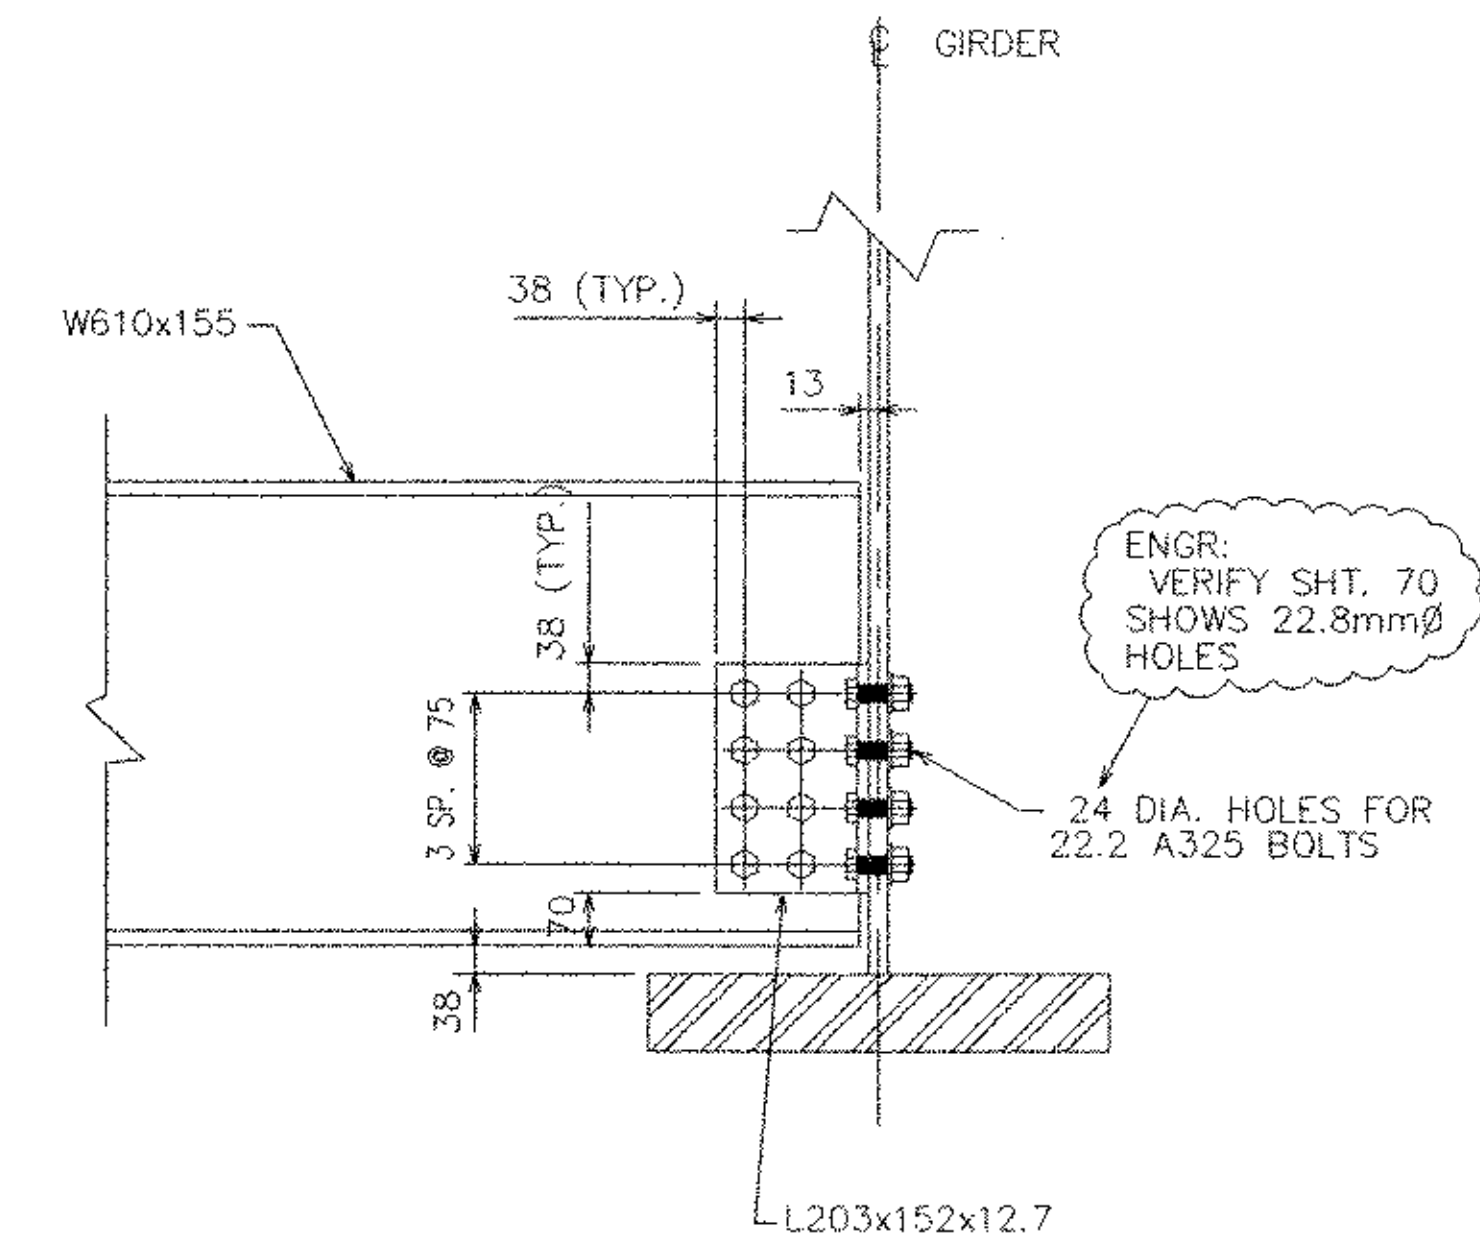

FLOOR BEAM CONNECTION DETAIL


REVISIONS			STATE OF VERMONT AGENCY OF TRANSPORTATION	
NO.	DATE	DESCRIPTION	CONTRACT :	PIN :
	9/14/03	APPROVAL	PROPOSED IMPROVEMENT TO RR BRIDGE #62.56 OVER VT ROUTE 9 (PRINCIPAL ARTERIAL) WINDHAM COUNTY, TOWN OF BRATTLEBORO	
			TITLE : SECTIONS & DETAILS	
			DRAWN BY DAN	SHOP ORDER
			3/19/03	4015
			CRD BY RJS	BLOCK NO.
			4/14/03	SHEET NO.
				3 / 20

STEEL-ART, INCORPORATED
40 WEST MAIN STREET
GALETON, PA 16922
(814) 435-6997



EASTERN BRIDGE LLC
RURAL RTE 2, BOX 302
CLAREMONT, NH 03743
608-542-5202

18755

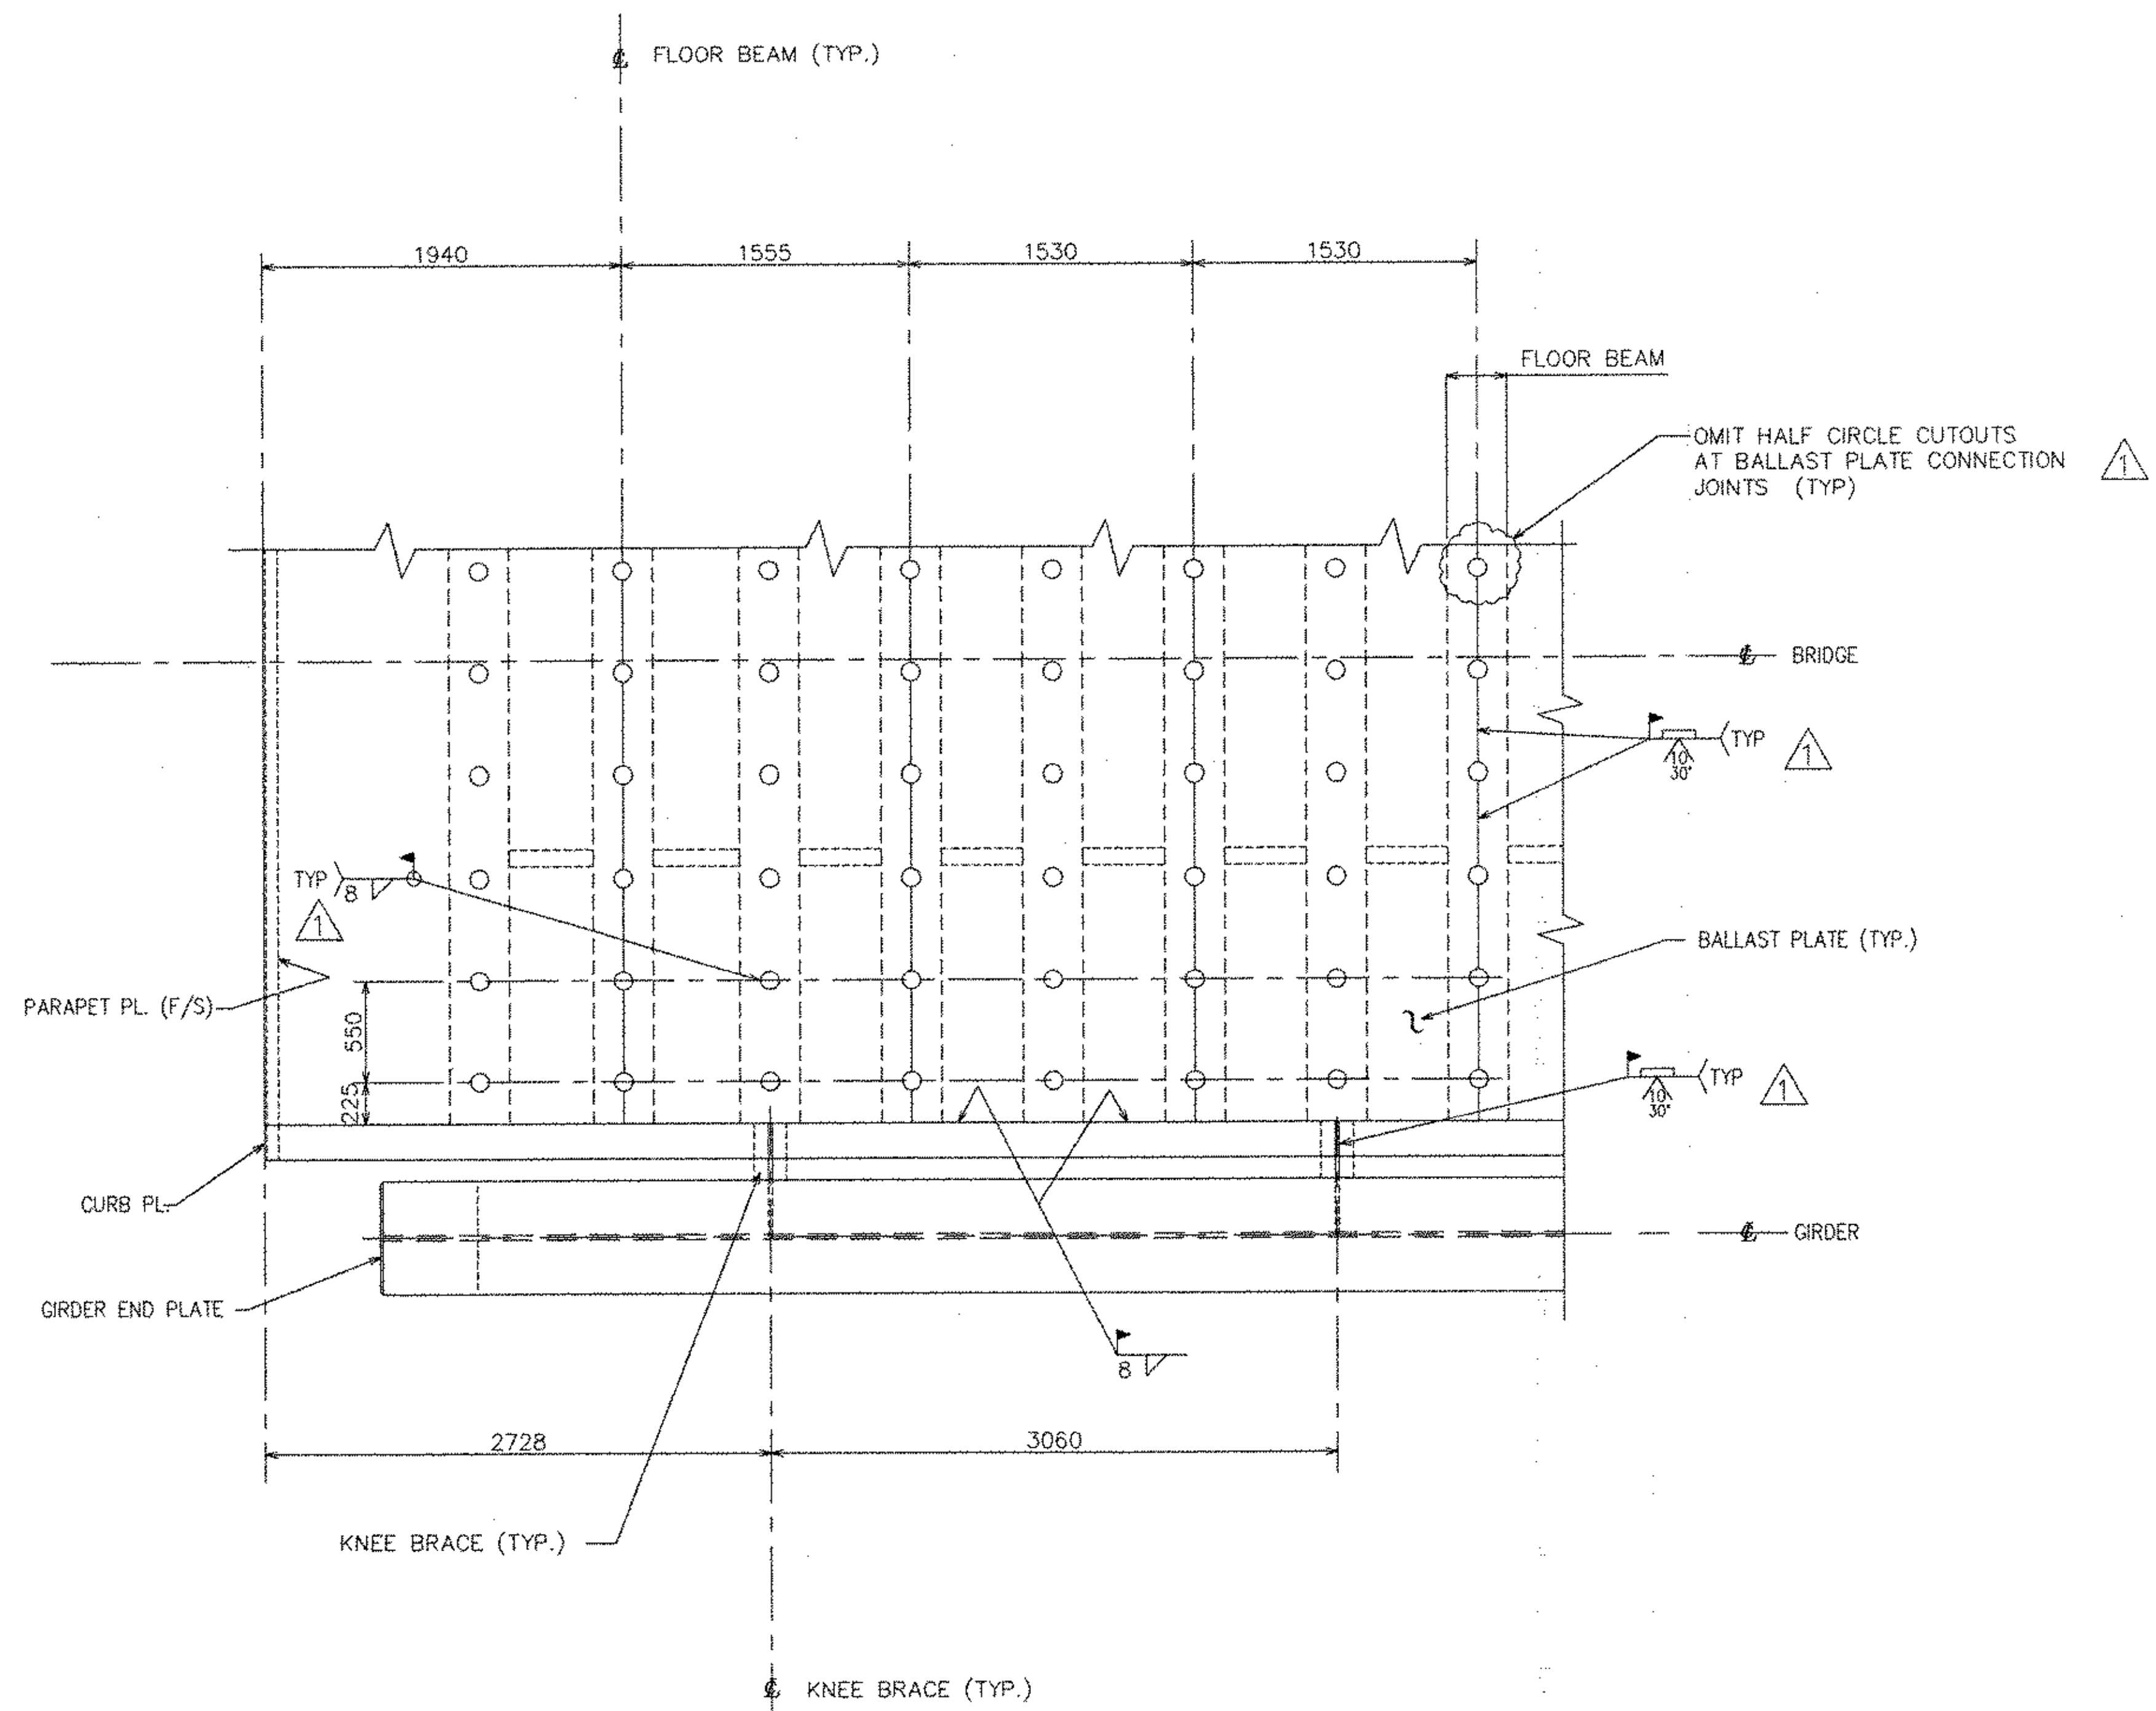




BALLAST PLATE LAYOUT

STEEL-ART, INCORPORATED
 40 WEST MAIN STREET
 GALETON, PA 16922
 (814) 435-6997

REVISIONS		
NO.	DATE	DESCRIPTION
1	6/24/03	PER APPROVAL
2	7/1/03	Approval


STATE OF VERMONT AGENCY OF TRANSPORTATION	
CONTRACT :	PIN :
PROPOSED IMPROVEMENT TO RR BRIDGE #62.56 OVER VT ROUTE 9 (PRINCIPAL ARTERIAL) WINDHAM COUNTY, TOWN OF BRATTLEBORO	
TITLE :	
BALLAST PLATE	
DRAWN BY DAN	SHOP ORDER
3/20/03	4015
4/14/03	E4
4/14/03	5 / 20

18955

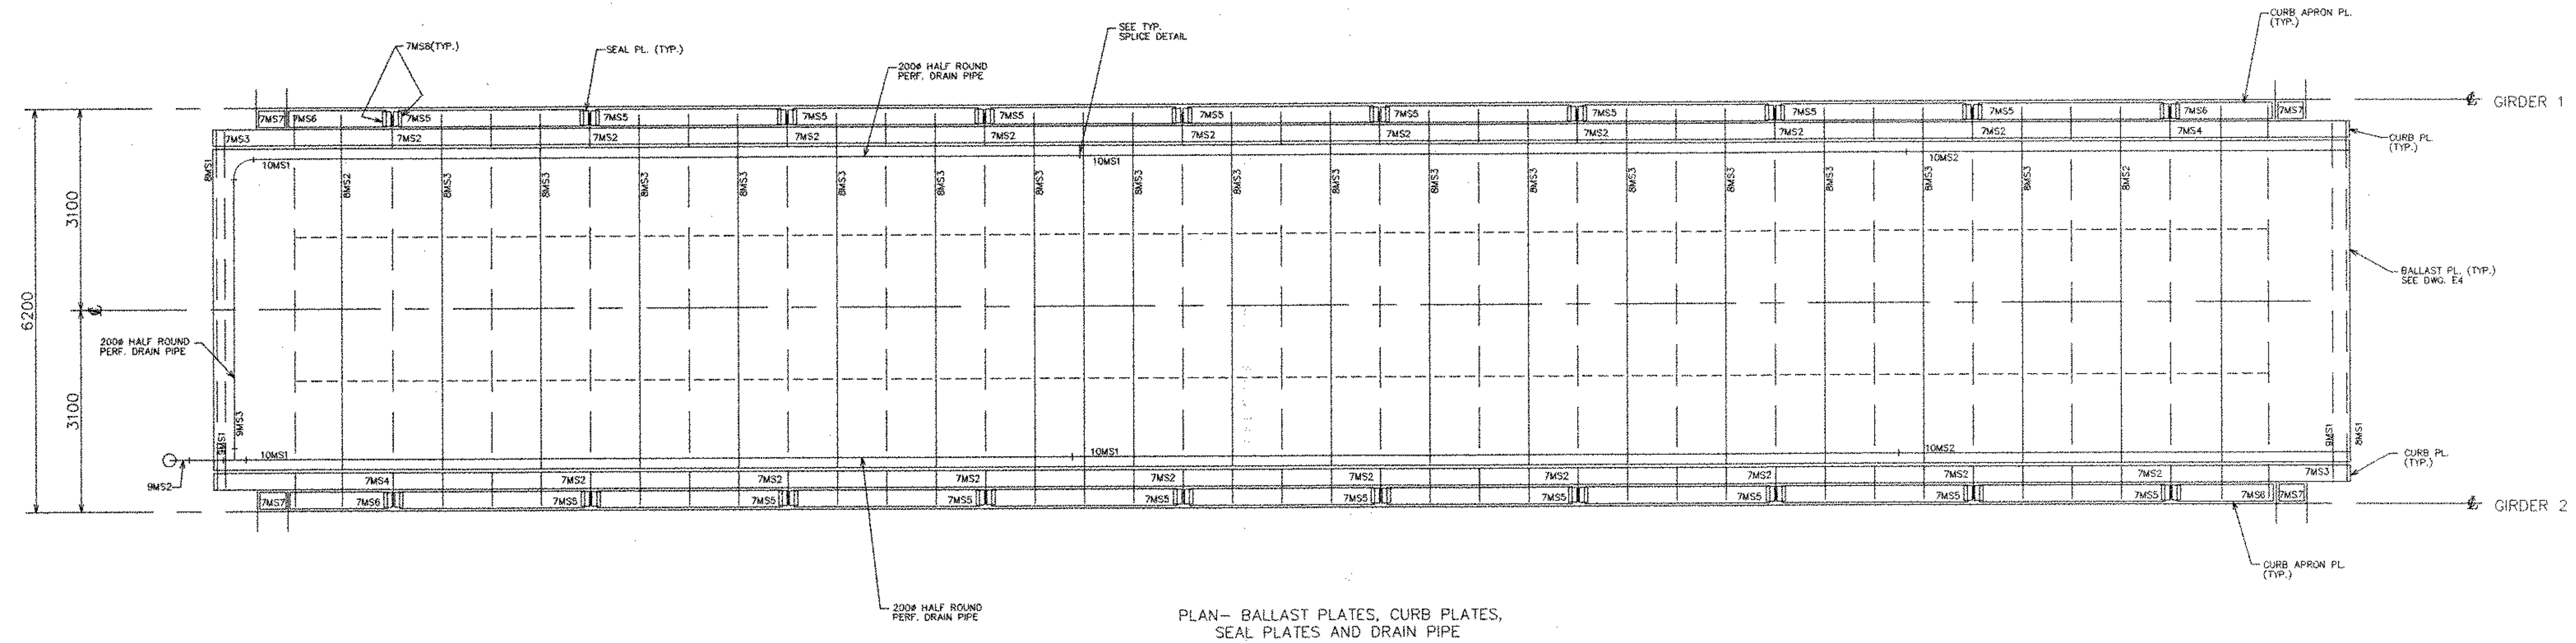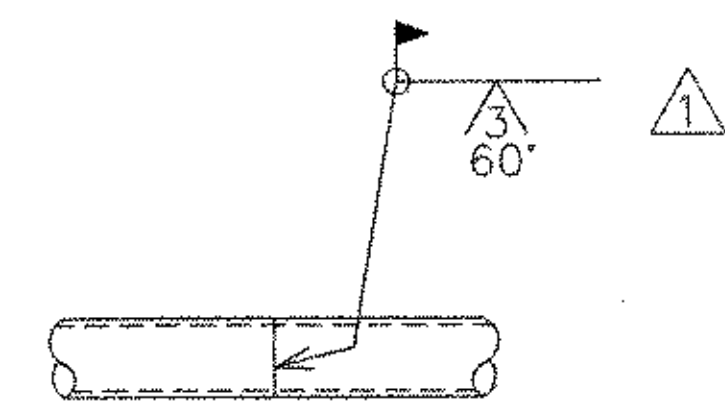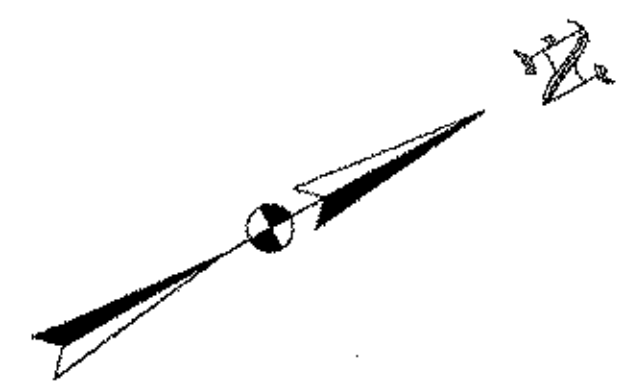

PLAN- BALLAST PLATES, CURB PLATES, SEAL PLATES AND DRAIN PIPE



α = PRODUCTION GROOVE ANGLE
(60° RECOMMENDED)

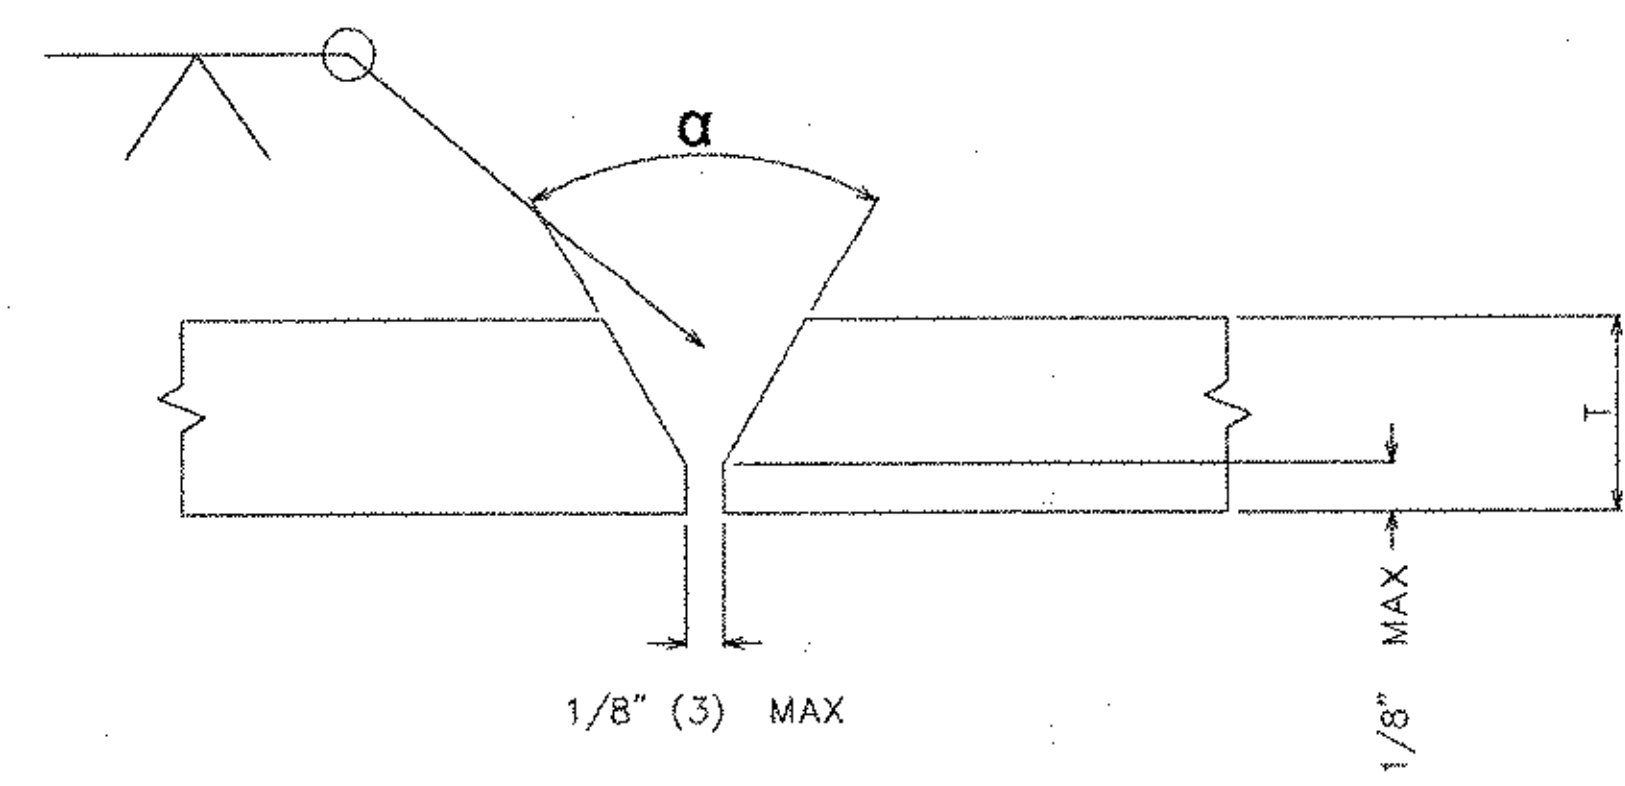

STEEL-ART, INCORPORATED
40 WEST MAIN STREET
GALETON, PA 16922
(814) 435-6997

EASTERN BRIDGE LLC
RURAL RTE 2, BOX 302
CLAREMONT, NH 03743
606-542-5202



REVISIONS			STATE OF VERMONT AGENCY OF TRANSPORTATION		
NO.	DATE	DESCRIPTION	CONTRACT :	PIN :	
1	5/24/03	PER APPROVAL	PROPOSED IMPROVEMENT TO RR BRIDGE #62.56		
2	8/10/03	Approval	OVER VT ROUTE 9 (PRINCIPAL ARTERIAL)		
			WINDHAM COUNTY, TOWN OF BRATTLEBORO		
			TITLE :		
			PLAN - MISCELLANEOUS		
DRAWN BY : DAN		SHOP ORDER	DWG. NO.		
3/17/03		4015	E5		
CHK BY : RJS		BLOCK NO.	SHEET NO.		
4/14/03			6 / 20		

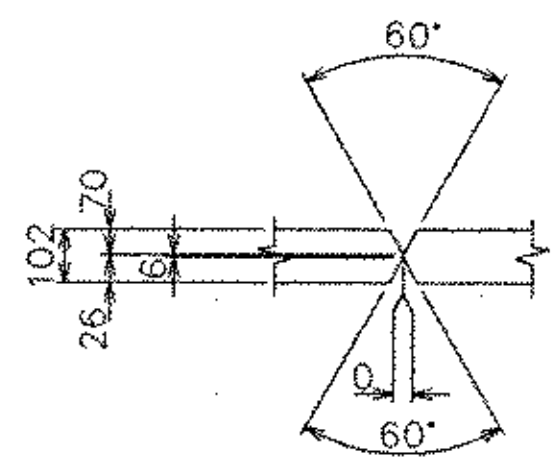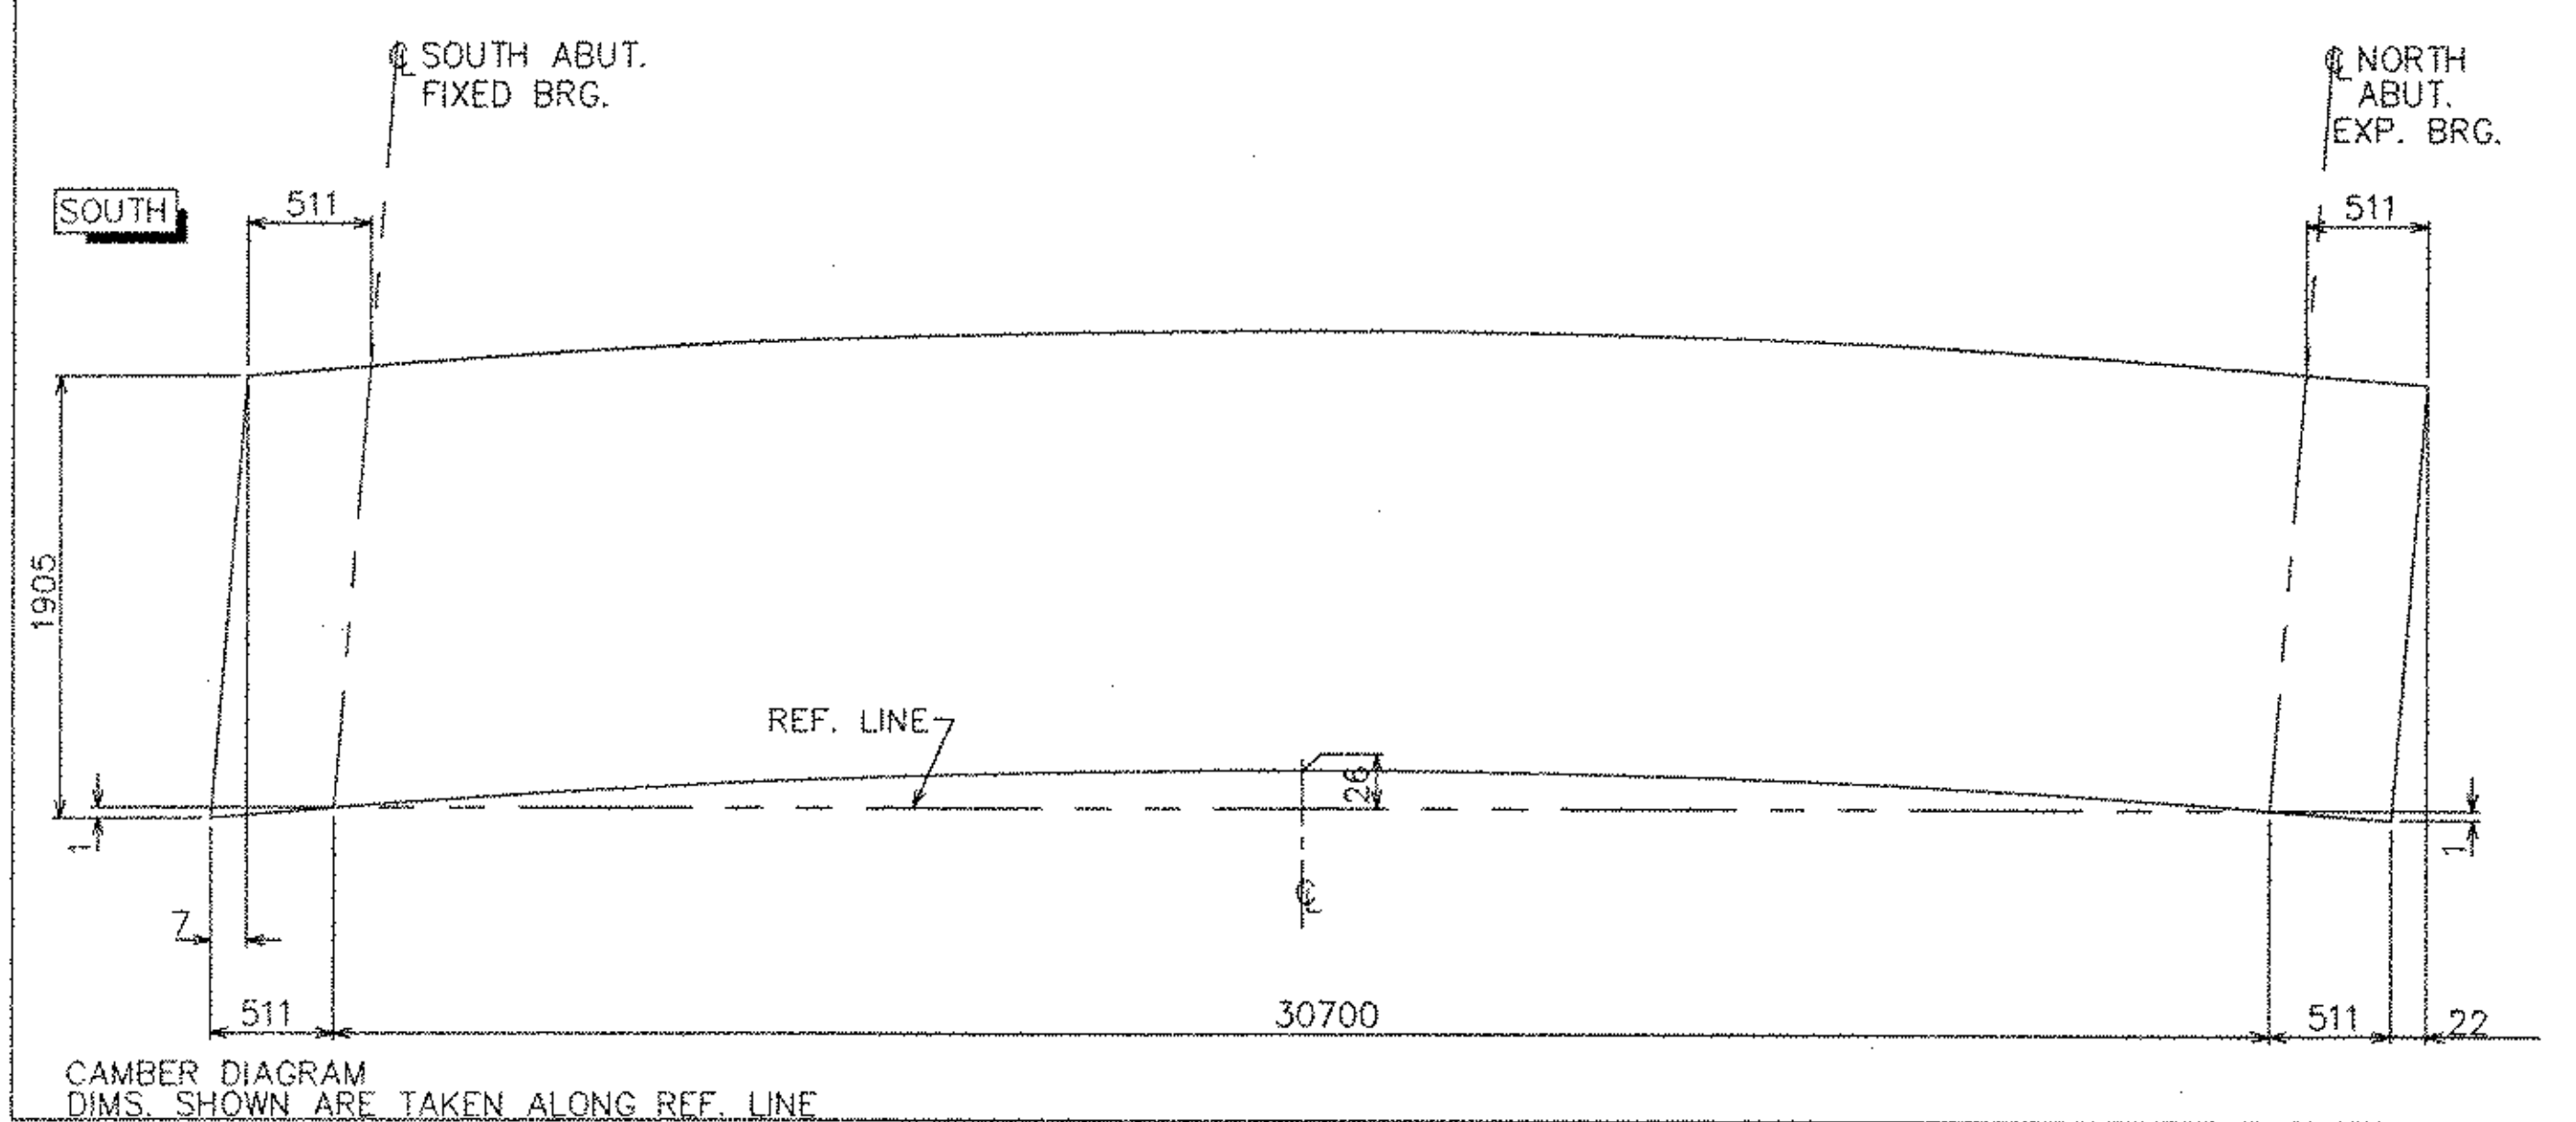

TOP & BOTTOM FLANGE SPLICE
B-U3c-S
WPS #8-2
BOTTOM FLANGE SPLICE (FCW)

No.	Mark	Qty	Type	Material	Grade	Length	Finish	Wgt./Lbs.	Notes	ABN
1	1G1A	1	GIRDER					111563		
		1	PL	102x610	M270M-345WF2	10124				1-A
		1	PL	102x610	M270M-345WF2	10710				1-AA
		1	PL	102x610	M270M-345WF2	10903				
		1	PL	102x610	M270M-345WF2	10124				FCM 1-B
		1	PL	102x610	M270M-345WF2	10710				FCM 1-AB
		1	PL	102x610	M270M-345WF2	10888				FCM
		1	PL	25x1905	M270M-345WF2	31744		26554		FCM 1-C
		2	PL	28x280	M270M-345W	1905		528		1-D
		2	PL	28x280	M270M-345W	1905		528		1-D
		2	PL	14x200	M270M-345W	1905		264		1-E
		9	PL	14x200	M270M-345W	1905		1186		1-E
		10	PL	20x175	M270M-345W	1260		786		1-F
		10	PL	20x584	M270M-345W	1236		2584		1-G
		10	PL	20x322	M270M-345W	620		8612		1-H
		8	PL	14x200	M270M-345W	1905		752		1-E
		1	PL	14x200	M270M-345W	1905		94		1-E
		2	PL	14x610	M270M-345W	2083		629		1-I
		6	L	178x102x12.7	M270M-345W	160		56		1-J
		2	L	102x76x12.7	M270M-345W	2985		978		1-K
		2	L	102x76x12.7	M270M-345W	1491		109		1-L
		2	L	102x76x12.7	M270M-345W	436		32		1-M
		80	PL	14x150	M270M-345W	150		440		1-N
		12	H.S. BOLTS	3/8"	A325 TYPE 3	146		10		1-O
		4	H.S. BOLTS	3/8"	A325 TYPE 3	76				1-O
		16	H. HEX NUTS	3/8"	A563GR C3					1-P
		16	STD. WASHERS	3/8"	F346					1-Q

NOTE:
GENERAL NOTES SEE DWG. G1
HOLES : 24mm U.N.O.
FOR WEB CUTTING DIAGRAM SEE WC-1

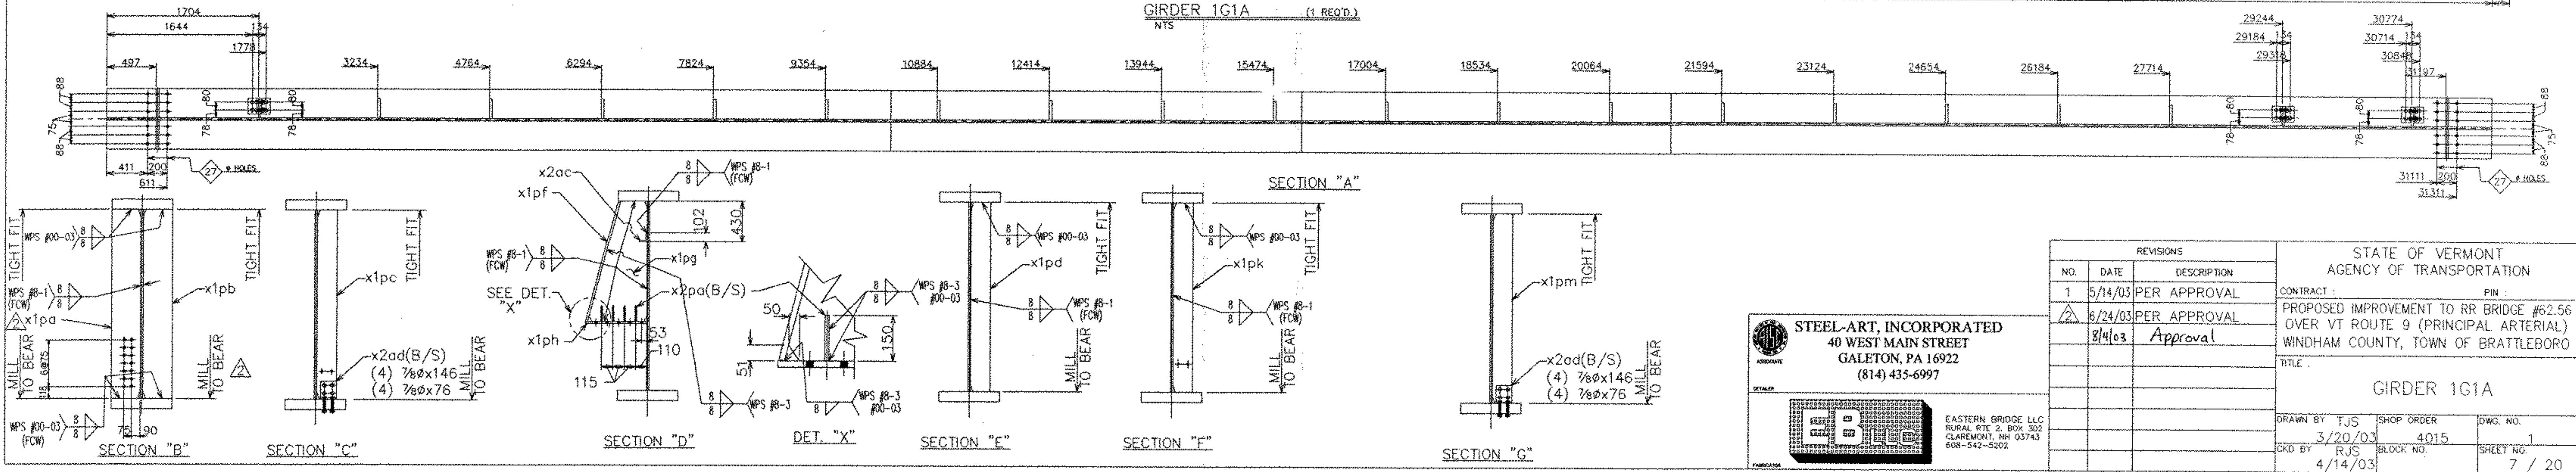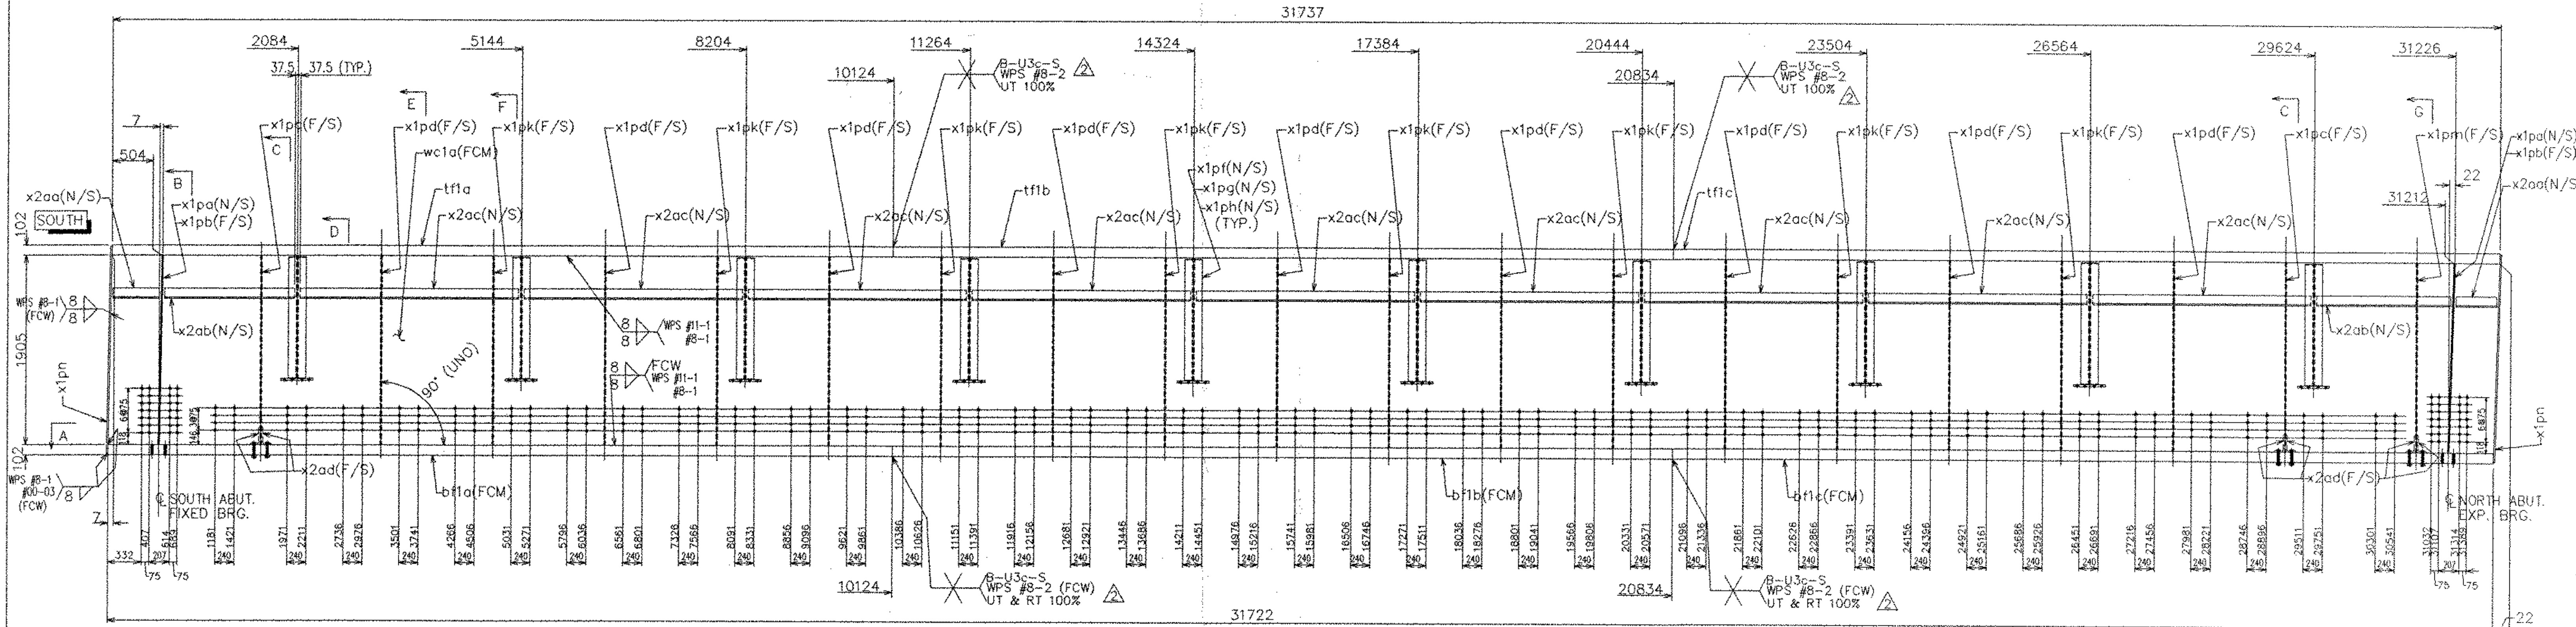


STEEL-ART, INCORPORATED
40 WEST MAIN STREET
GALETON, PA 16922
(814) 435-6997

REVISIONS			STATE OF VERMONT AGENCY OF TRANSPORTATION	
NO.	DATE	DESCRIPTION	CONTRACT	PIN
1	5/14/03	PER APPROVAL		
2	6/24/03	PER APPROVAL		
		Approval		


PROPOSED IMPROVEMENT TO RR BRIDGE #62.56
OVER VT ROUTE 9 (PRINCIPAL ARTERIAL)
WINDHAM COUNTY, TOWN OF BRATTLEBORO

TITLE: GIRDER 1G1A


DRAWN BY: TJS SHOP ORDER: 4015 DWG. NO.: 1
CRD BY: RJS BLOCK NO.: SHEET NO.: 7 / 20
DATE: 4/14/03

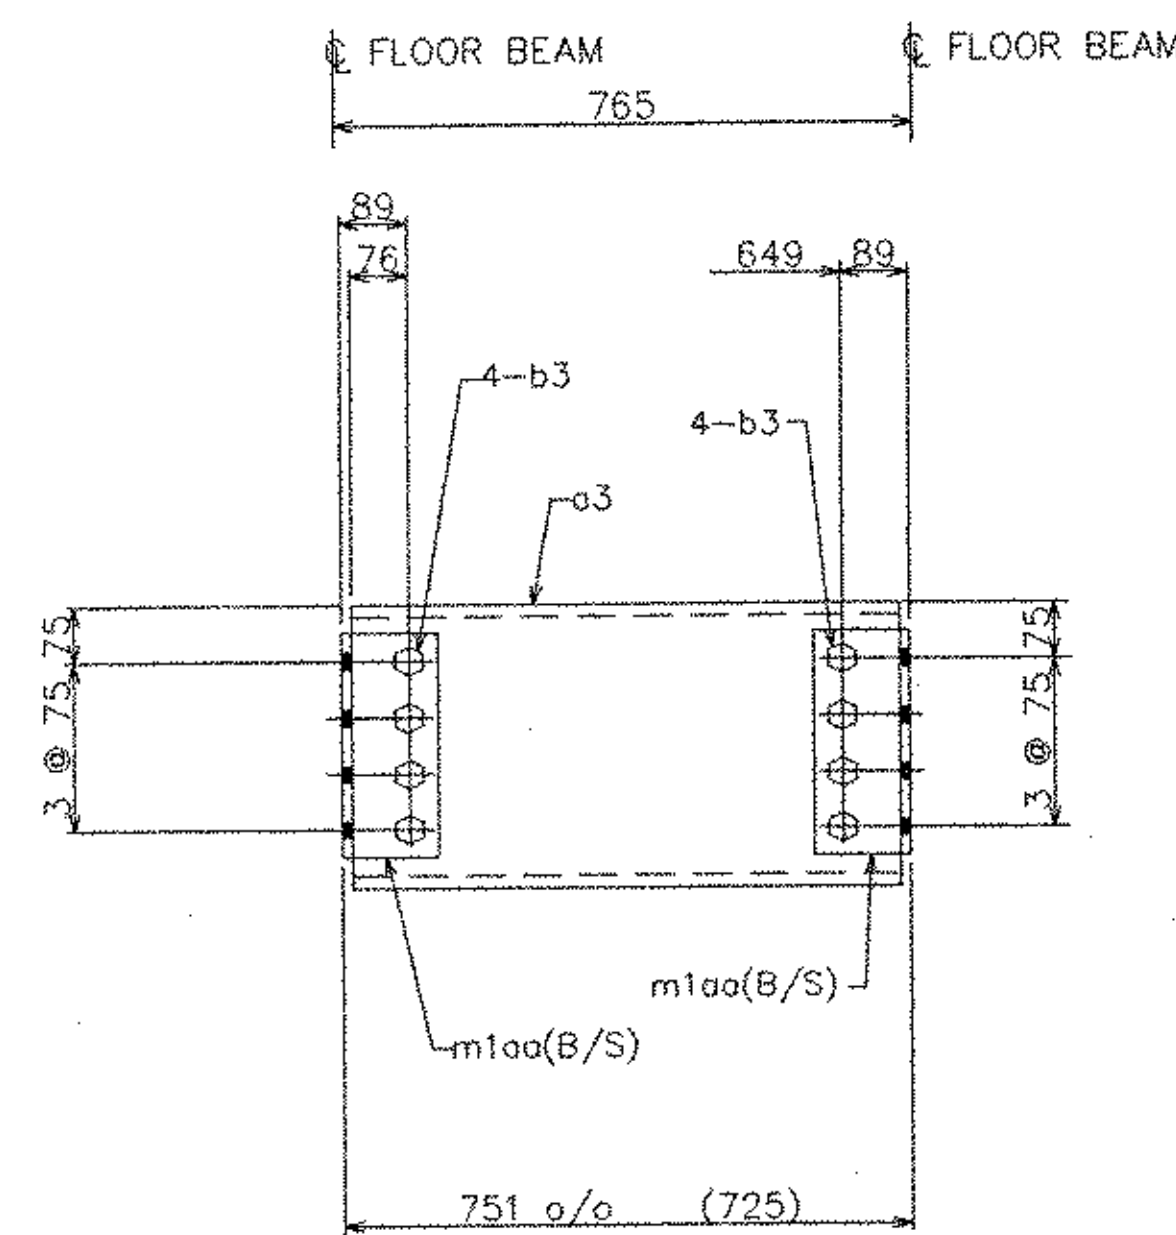

ITEM 3D1A (72 REQ'D)
SCALE 1:10

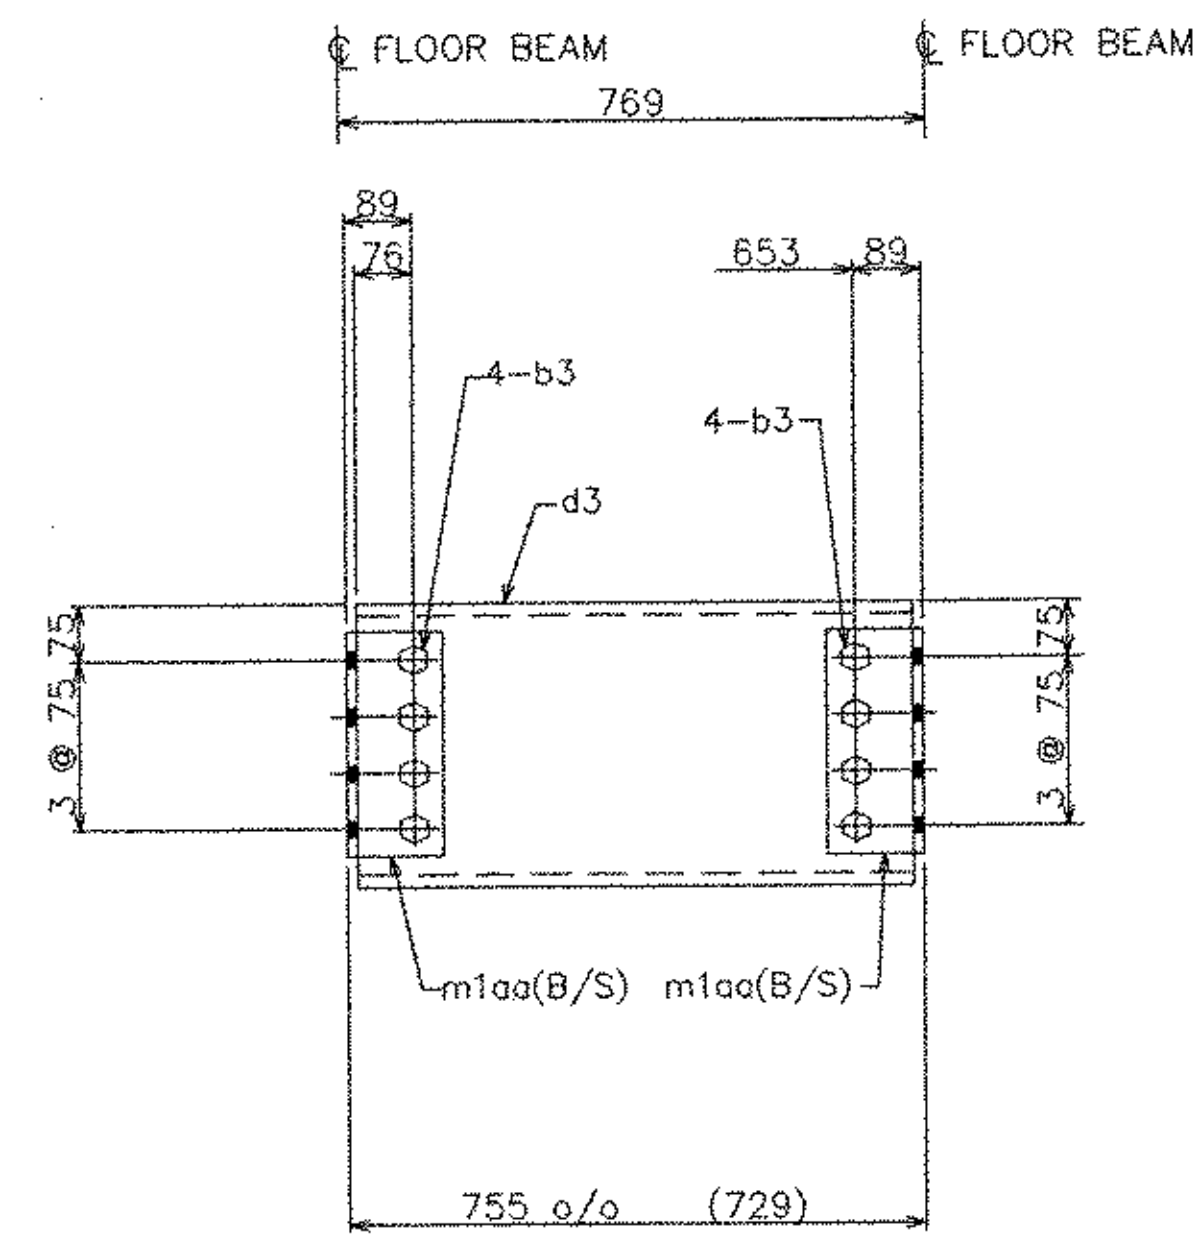

ITEM 3D1C (4 REQ'D)
SCALE 1:10

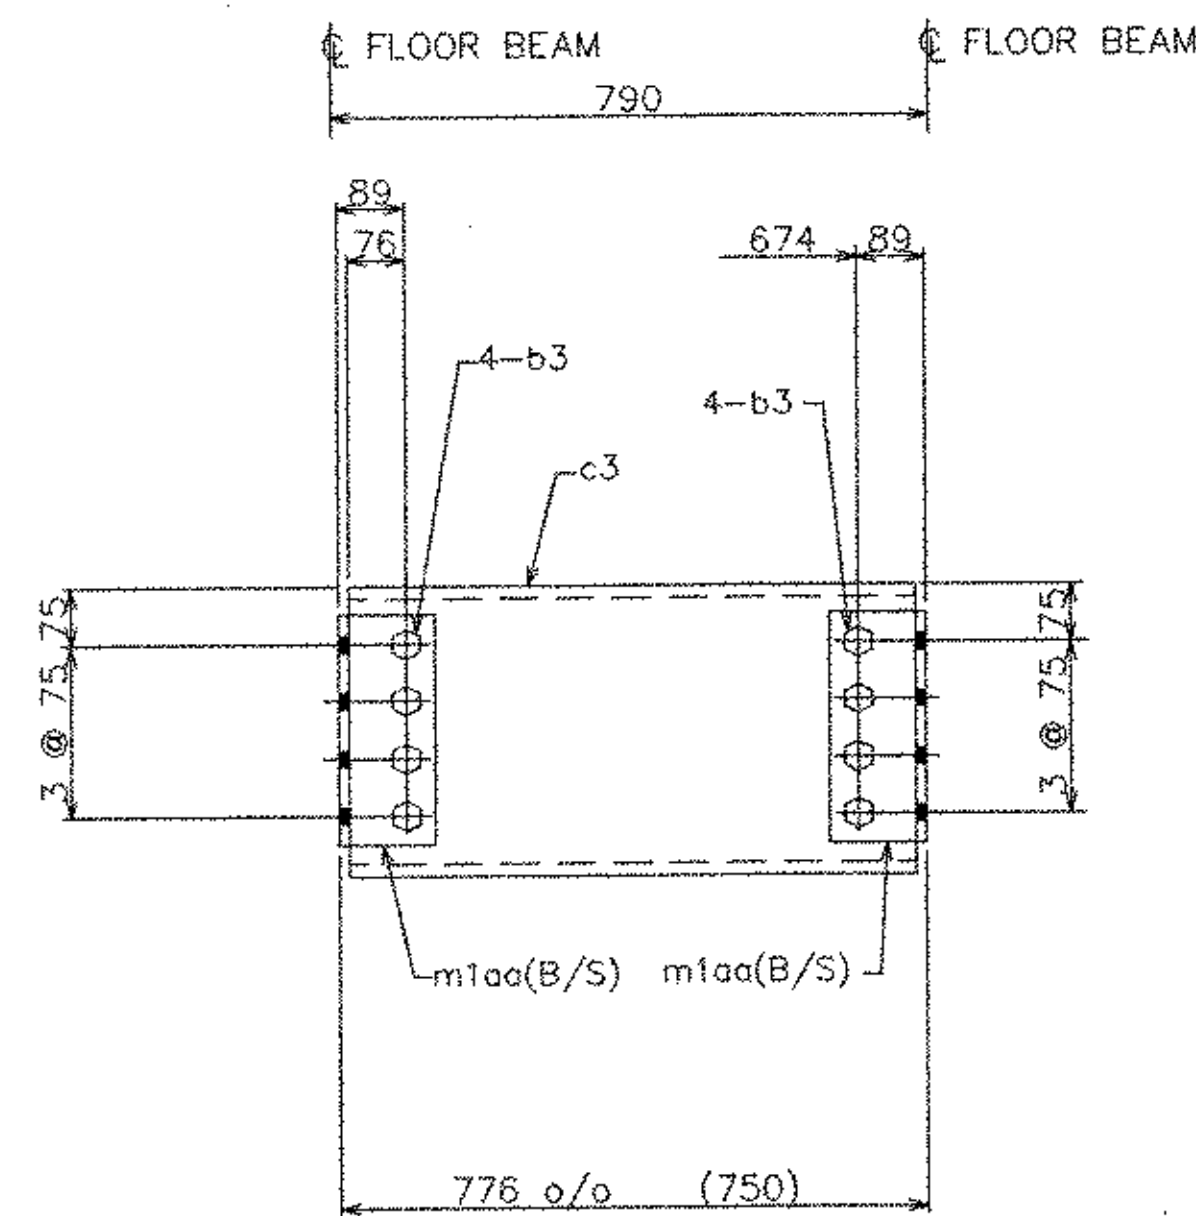

ITEM 3D1B (4 REQ'D)
SCALE 1:10

Dwg No.	Rev.	Ship Mark	Piece Mark	Qty	Type	Size of Material	Grade	Length	Finish	Wgt./Lbs	Notes	ABM
3		3D1A		72	DIAPHRAM					10790		
			a3	72	C	380x50.4	M270M-345W	725		5793		1-R
			m1aa	288	L	27x127x127	M270M-345W	301		4617		1-S
			b3	576	H.S. BOLTS	22.2	A325 TYPE 3	70		380		1-T
				576	HEX NUT	22.2						1-P
				576	STD. WASH	22.2						1-Q
3		3D1B		4	DIAPHRAM					610		
			c3	4	C	380x50.4	M270M-345W	750		333		1-U
			m1aa	16	L	27x127x127	M270M-345W	301		256		1-S
			b3	32	H.S. BOLTS	22.2	A325 TYPE 3	70		21		1-T
				32	HEX NUT	22.2						1-P
				32	STD. WASH	22.2						1-Q
3		3D1C		4	DIAPHRAM					604		
			d3	4	C	380x50.4	M270M-345W	729		327		1-V
			m1aa	16	L	27x127x127	M270M-345W	301		256		1-S
			b3	32	H.S. BOLTS	22.2	A325 TYPE 3	70		21		1-T
				32	HEX NUT	22.2						1-P
				32	STD. WASH	22.2						1-Q


NOTES:
1 - GENERAL NOTES: SEE DRAWING GN1
2 - HOLES: 24Ø (U.N.O.)
3 - SHOP BOLT - BOLT TO SHIP ONLY

STEEL-ART, INCORPORATED
40 WEST MAIN STREET
GALETON, PA 16922
(814) 435-6997

REVISIONS			STATE OF VERMONT AGENCY OF TRANSPORTATION		
NO.	DATE	DESCRIPTION	CONTRACT :	PIN :	
	8/14/03	APPROVAL	PROPOSED IMPROVEMENT TO RR BRIDGE #62.56 OVER VT ROUTE 9 (PRINCIPAL ARTERIAL) WINDHAM COUNTY, TOWN OF BRATTLEBORO		
			TITLE : DIAPHRAGM D1		
DRAWN BY : TJS		SHOP ORDER	DWG. NO. : 4015		SHEET NO. : 3
CHKD BY : RGY		BLOCK NO.	SHEET NO. : 9 / 20		
DATE : 4/7/03					

No.	Mark	Mark	QTY	DESCRIPTION	UNIT	AMOUNT	AMOUNT	AMOUNT	AMOUNT
4	4FBA		29	FLOOR BEAM			63788		
		o4	29	W	610x155	M270M-345W	6149	60844	1-W
		m1ab	116	L	20x15x127	M270M-345W	301	2635	1-X
		b4	464	H.S. BOLTS	22.2	A325 TYPE 3	76	309	1-Y
			464	HEX NUT	22.2				1-P
			464	STD. WASH.	22.2				1-Q

NOTES:
 1 - GENERAL NOTES: SEE DRAWING GN1
 2 - HOLES: 24# (U.N.O.)
 3 - SHOP BOLT - BOLT TO SHIP ONLY

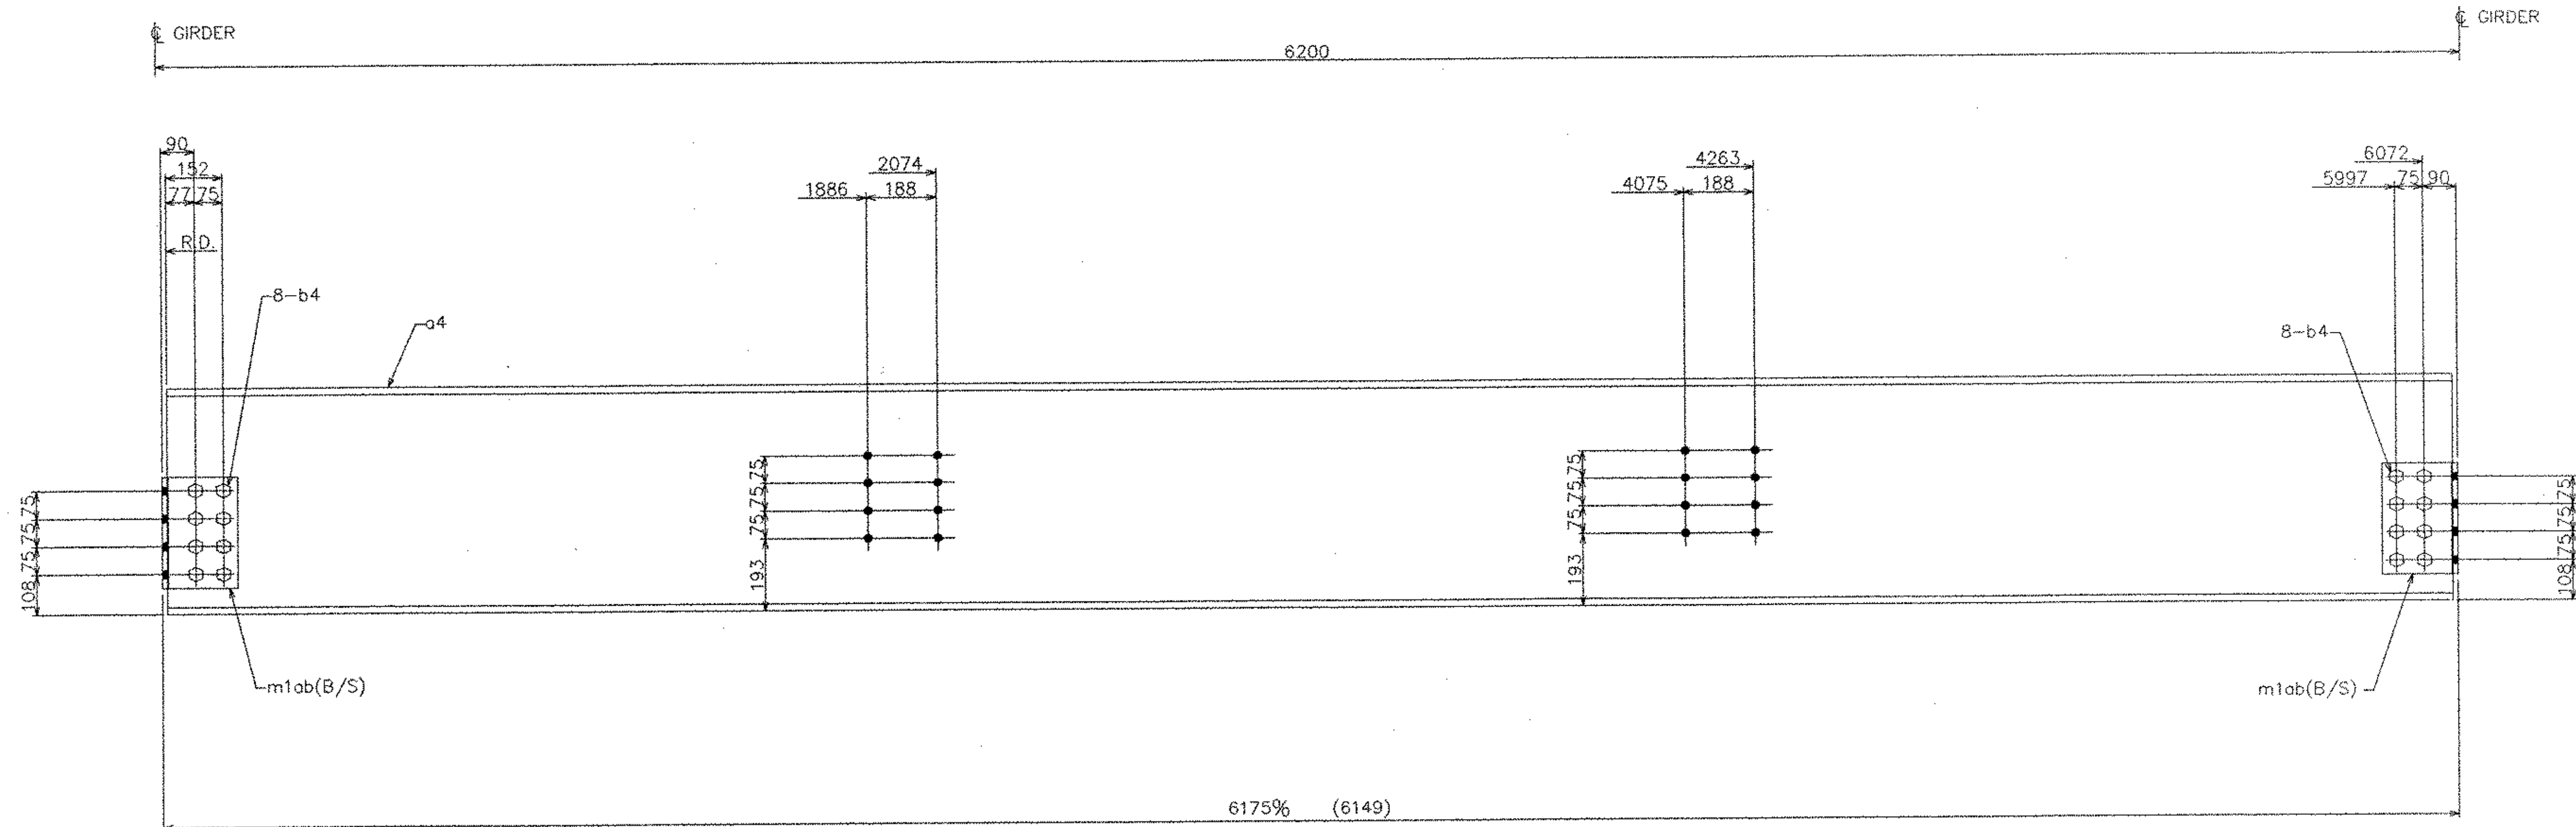

ITEM 4FBA (29 REQ'D)
 SCALE 1:10

STEEL-ART, INCORPORATED
 40 WEST MAIN STREET
 GALETON, PA 16922
 (814) 435-6997


EASTERN BRIDGE LLC
 RURAL RTE 2, BOX 303
 CLAREMONT, NH 03743
 608-542-5202

REVISIONS			STATE OF VERMONT AGENCY OF TRANSPORTATION	
NO.	DATE	DESCRIPTION	CONTRACT :	PIN :
1	8/1/03	APPROVAL	PROPOSED IMPROVEMENT TO RR BRIDGE #62.56 OVER VT ROUTE 9 (PRINCIPAL ARTERIAL) WINDHAM COUNTY, TOWN OF BRATTLEBORO	
			TITLE : FLOOR BEAM	
DRAWN BY TJS		SHOP ORDER	DWS NO.	
3/17/03		4015	4	
CHK BY RGY		BLOCK NO.	SHEET NO.	
4/7/03			10 / 20	


19355

Dwg. No.	Rev.	Ship Mark	Piece Mark	Qty	Type	Size of Material	Grade	Length	Finish	Wgt./Lbs.	Notes	ABM
5		SFBA		10	FLOOR BEAM							
			a5	10	W	610x155	M270M-345W	6149		20981		1-W
			m1pa	160	PL	14x150	M270M-345W	150		885		1-Z
			m1ab	40	L	203x152x12.7	M270M-345W	301		908		1-X
			b4	160	H.S. BOLTS	22.2	A325 TYPE 3	76		107		1-Y
				160	HEX NUTS	22.2						1-P
				160	STD. WASH	22.2						1-Q

NOTES:
 1 - GENERAL NOTES: SEE DRAWING GN1
 2 - HOLES: 24Ø (U.N.O.)
 3 - SHOP BOLT - BOLT TO SHIP ONLY

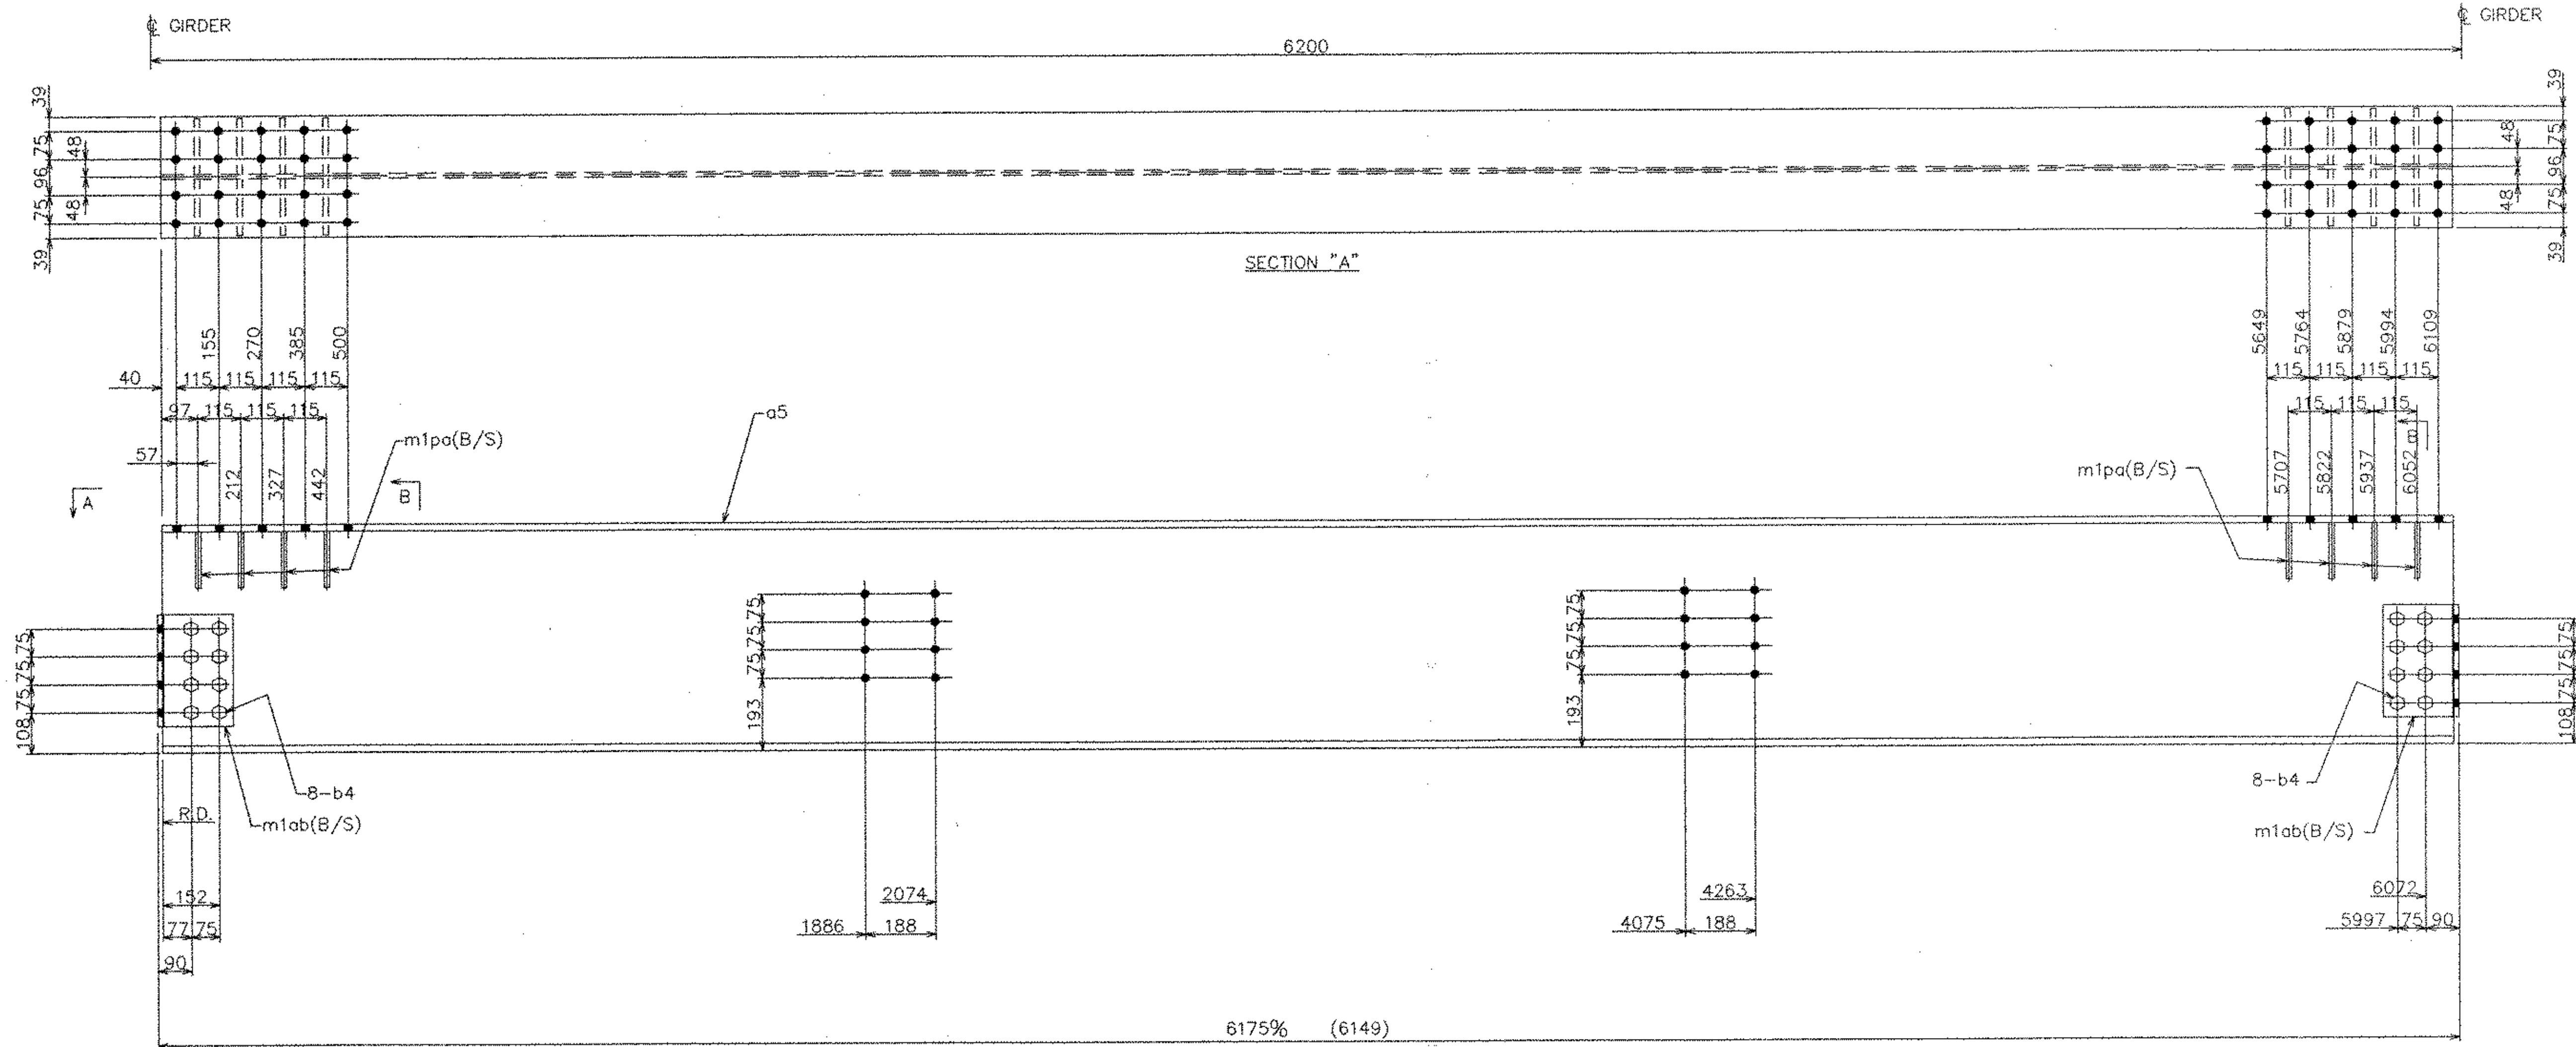

ITEM 5FBA (10 REQ'D)
 SCALE 1:10

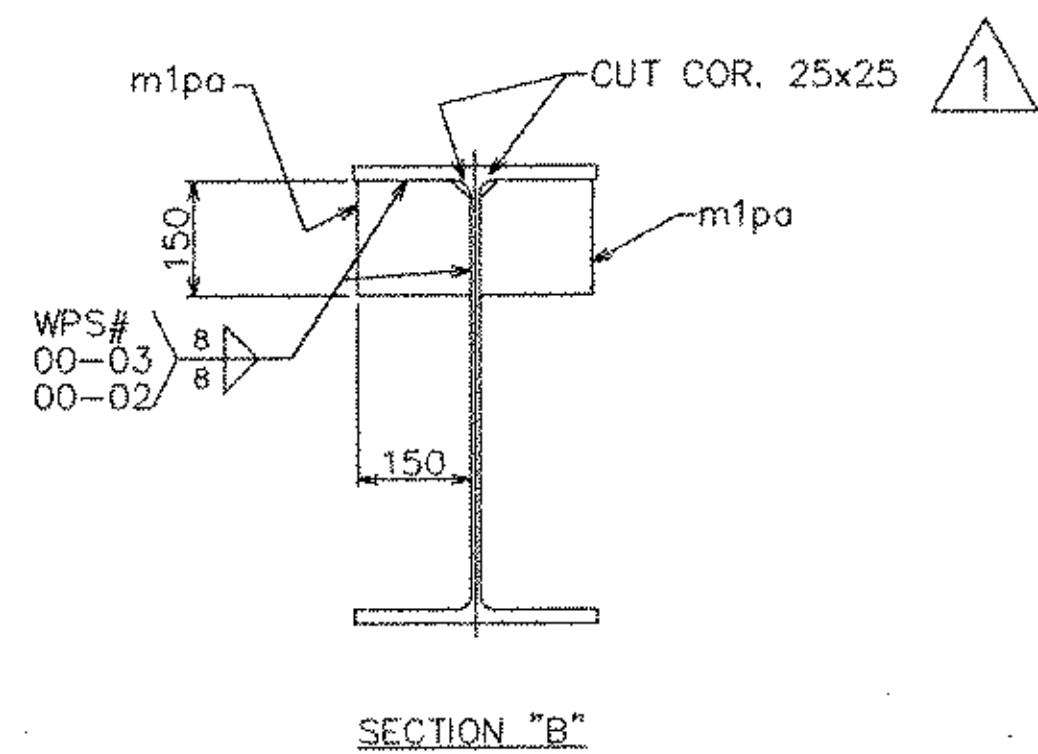

SECTION "B"

STEEL-ART, INCORPORATED
 40 WEST MAIN STREET
 GALETON, PA 16922
 (814) 435-6997




REVISIONS			STATE OF VERMONT AGENCY OF TRANSPORTATION	
NO.	DATE	DESCRIPTION	CONTRACT	PIN
1	6/24/03	PER APPROVAL		
		Approval		

PROPOSED IMPROVEMENT TO RR BRIDGE #62.56
 OVER VT ROUTE 9 (PRINCIPAL ARTERIAL)
 WINDHAM COUNTY, TOWN OF BRATTLEBORO


TITLE: FLOOR BEAM

DRAWN BY TJS	SHOP ORDER 4015	DWG. NO. 5
CHK BY RCY	BLOCK NO.	SHEET NO. 11 / 20
4/8/03		


19455

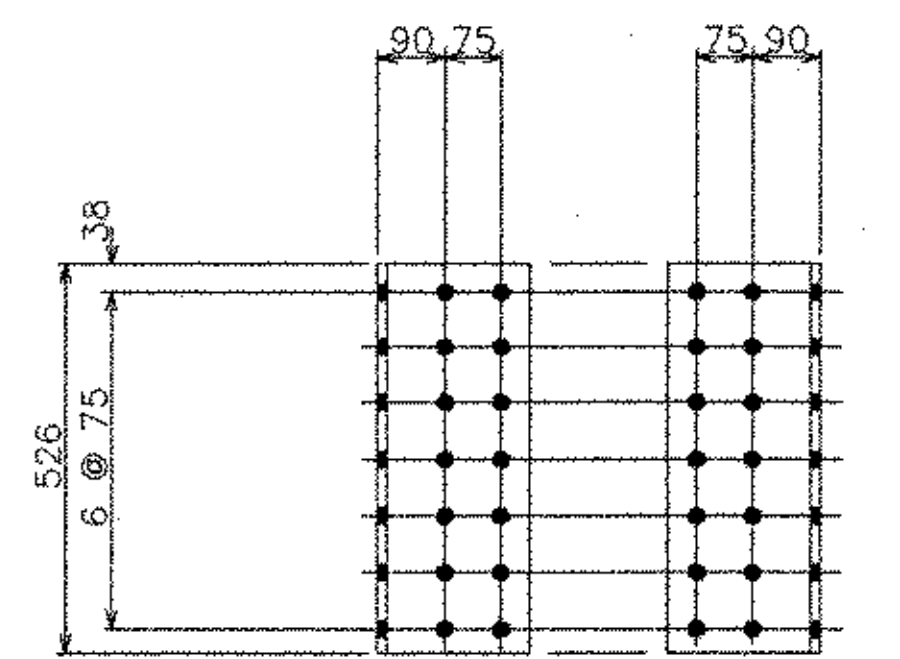


ITEM 7MS1 (8 REQ'D)
SCALE 1:10

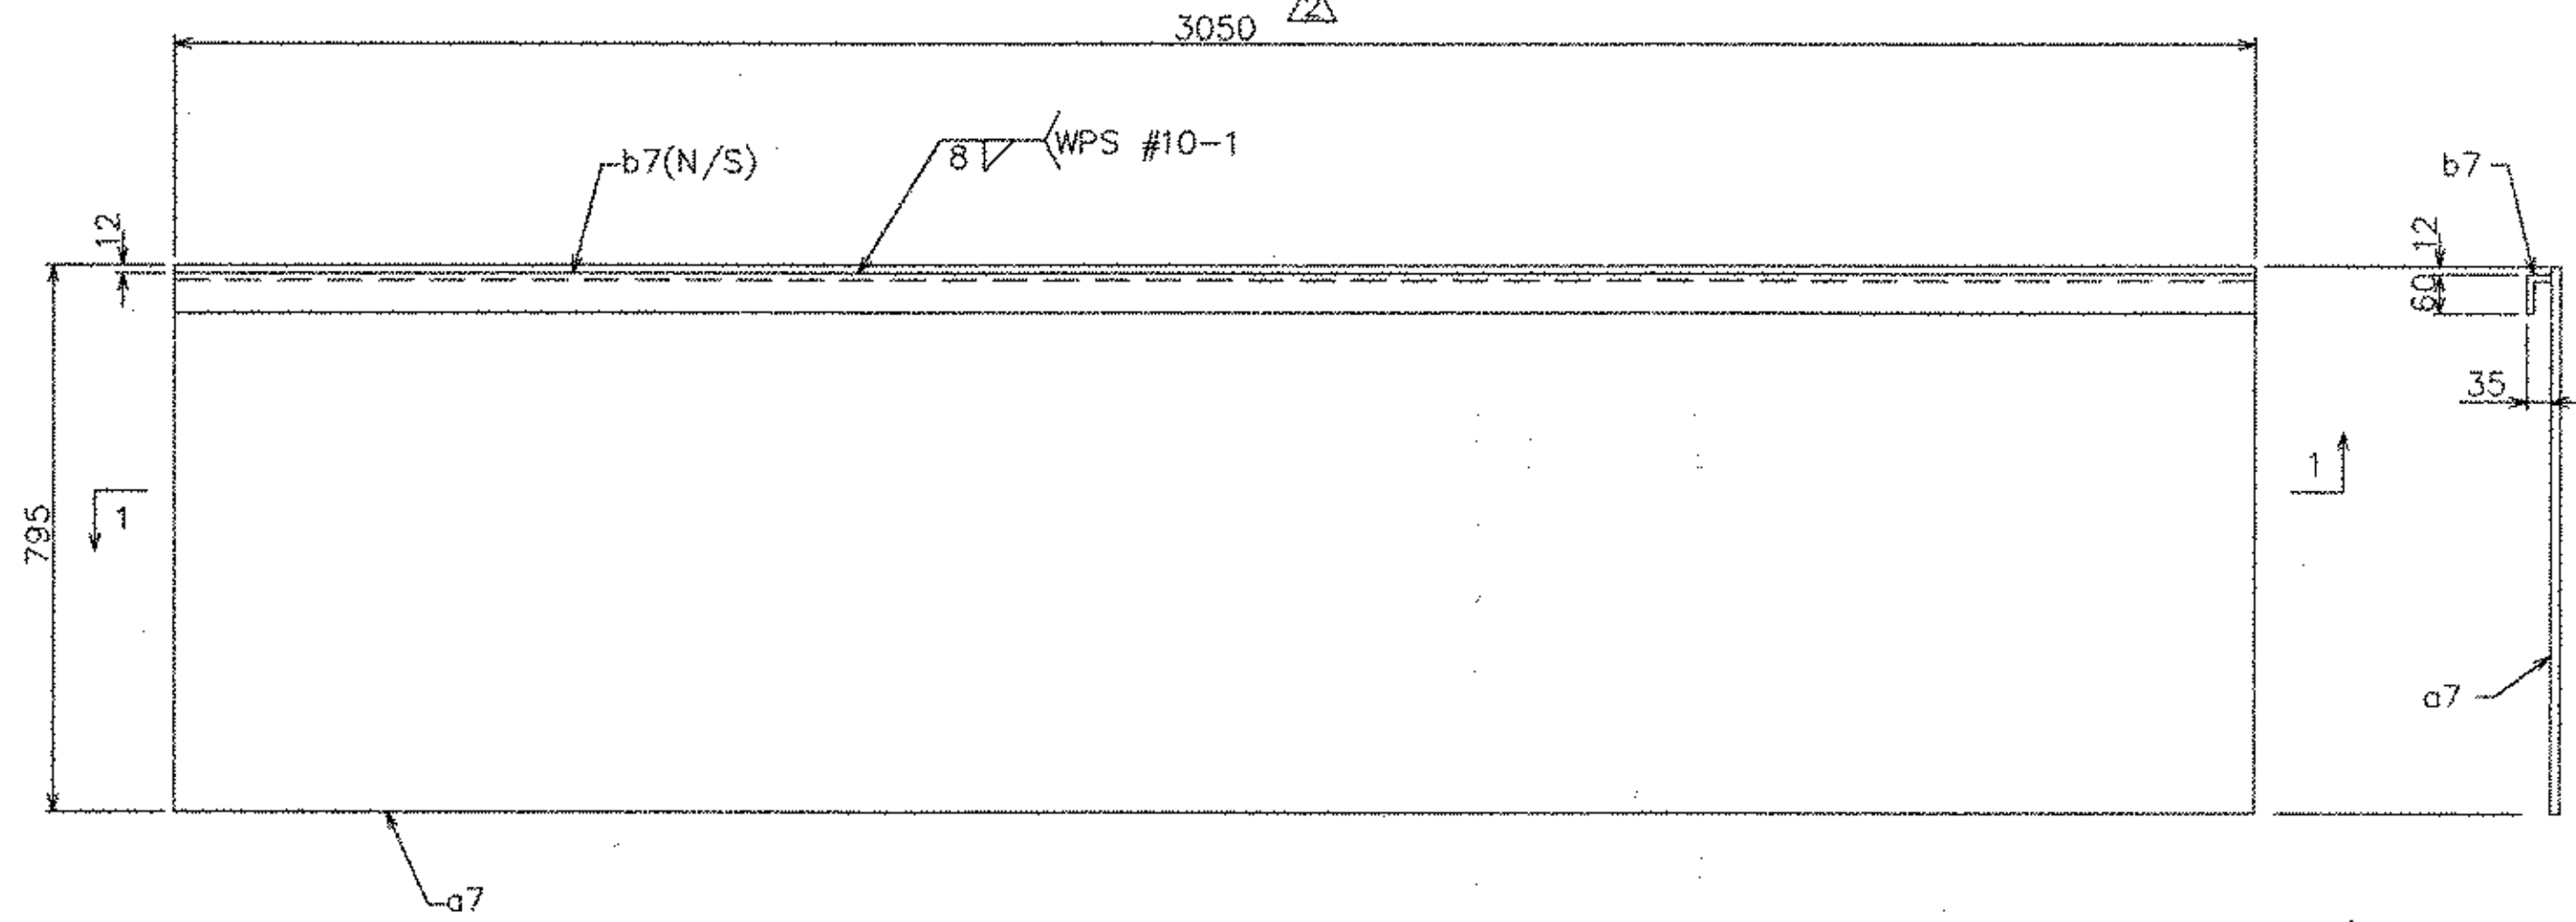


ITEM 7MS2 (18 REQ'D)
SCALE 1:10

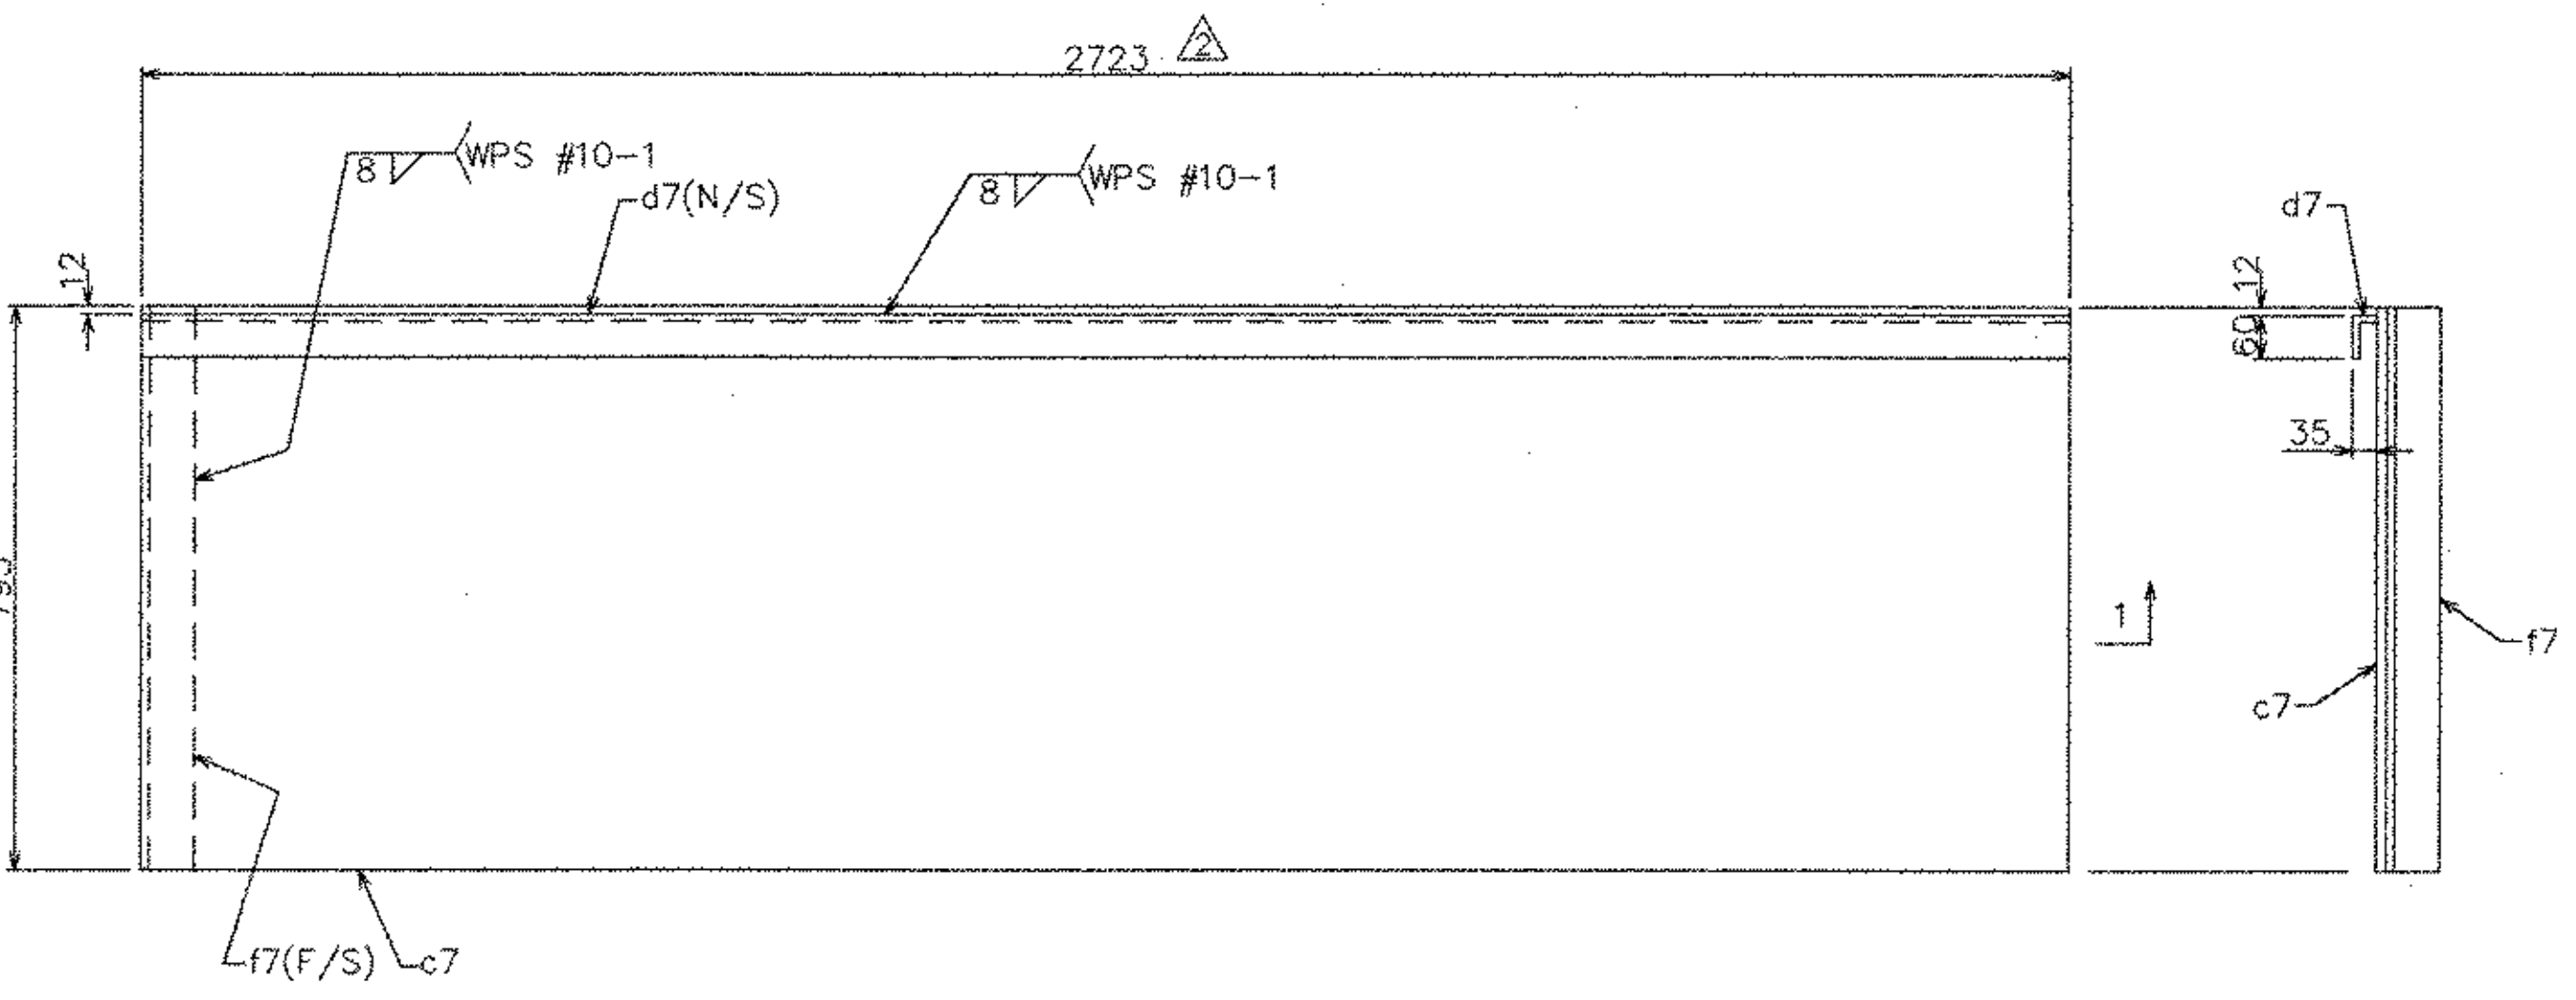


ITEM 7MS3 (2 REQ'D)
SCALE 1:10

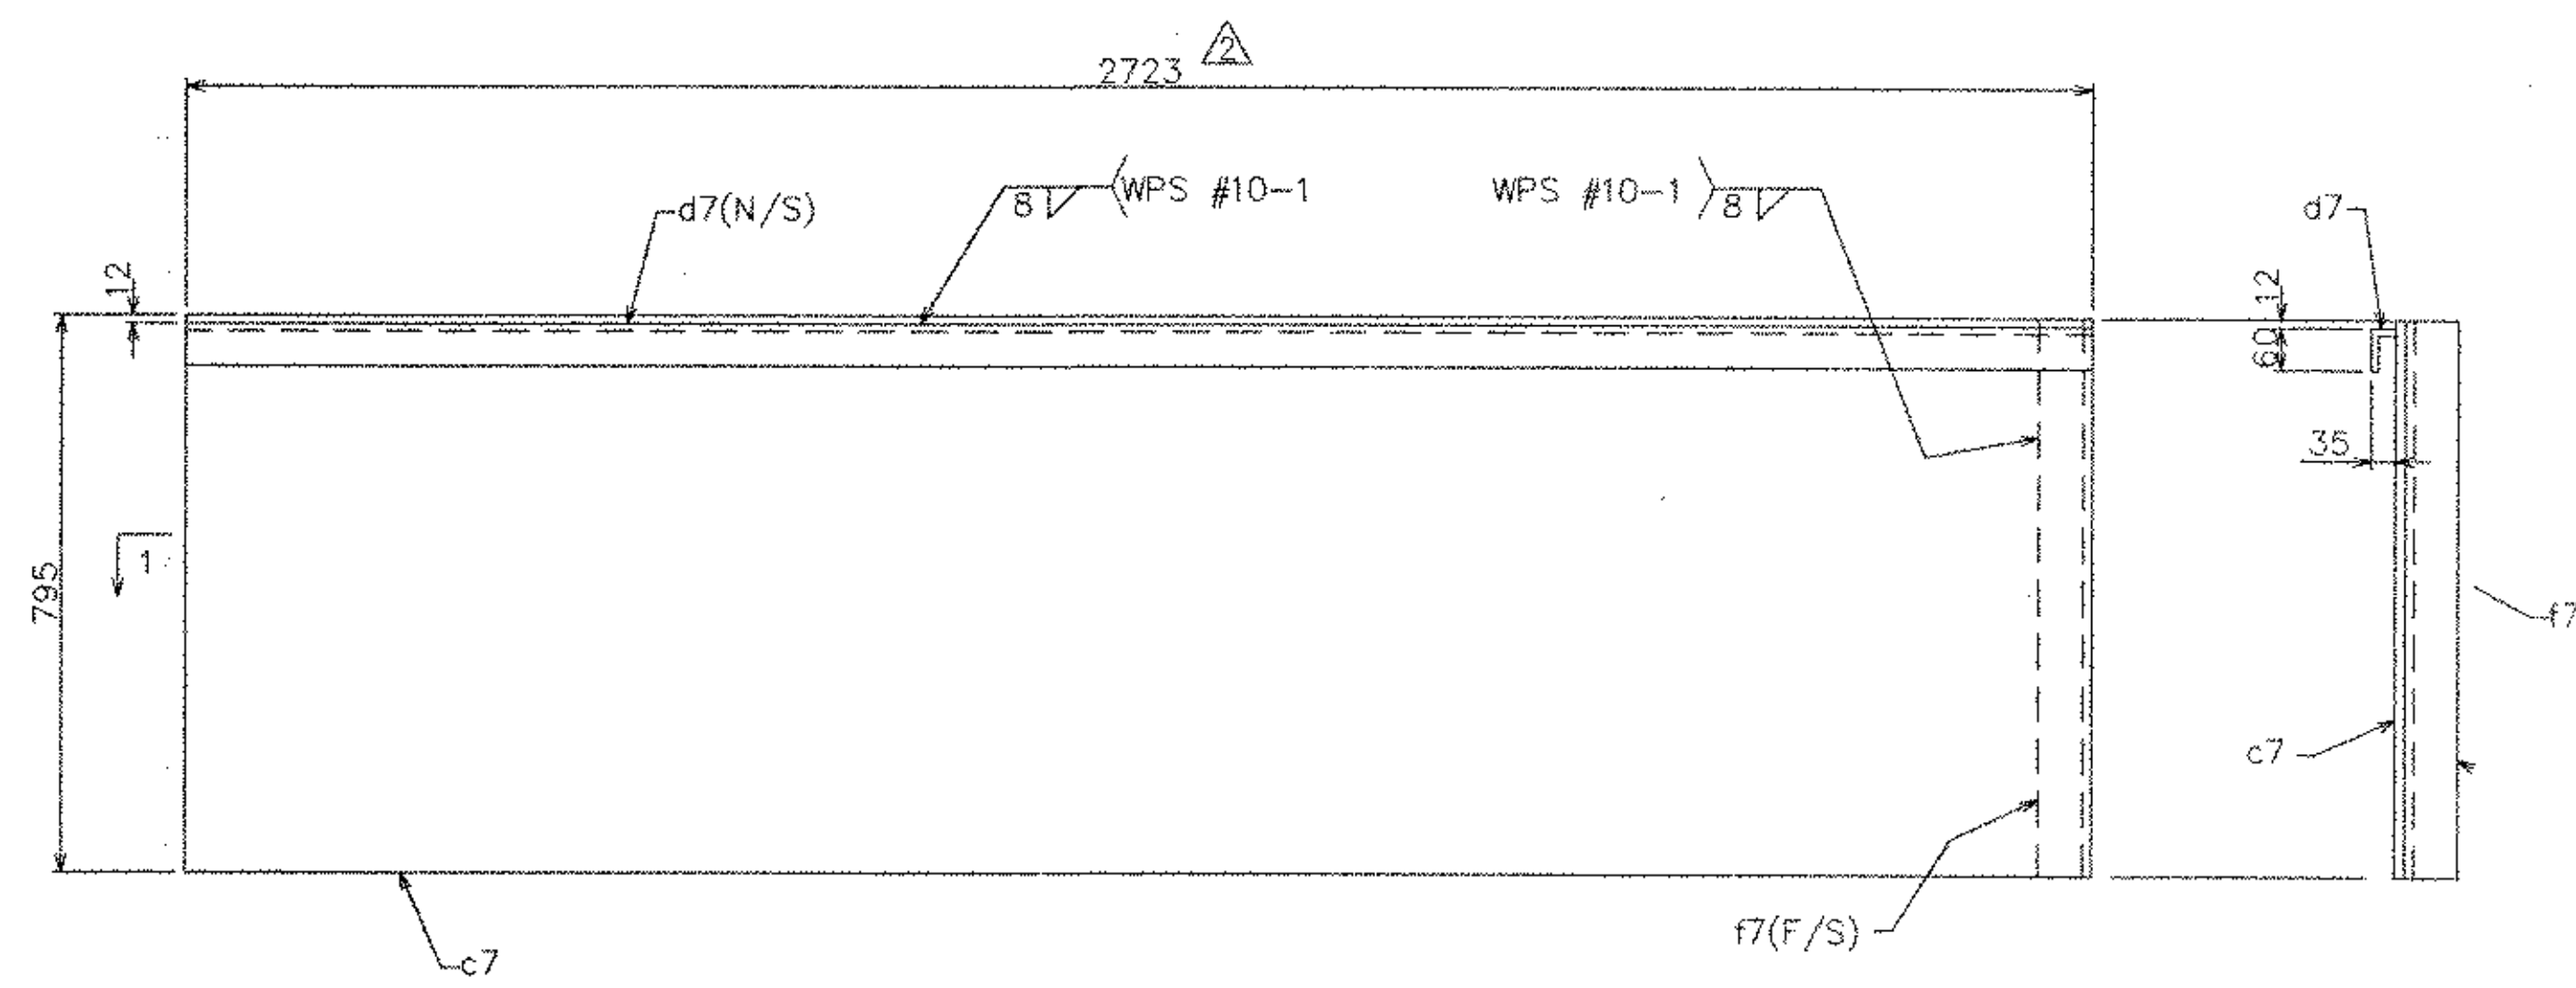


ITEM 7MS4 (2 REQ'D)
SCALE 1:10

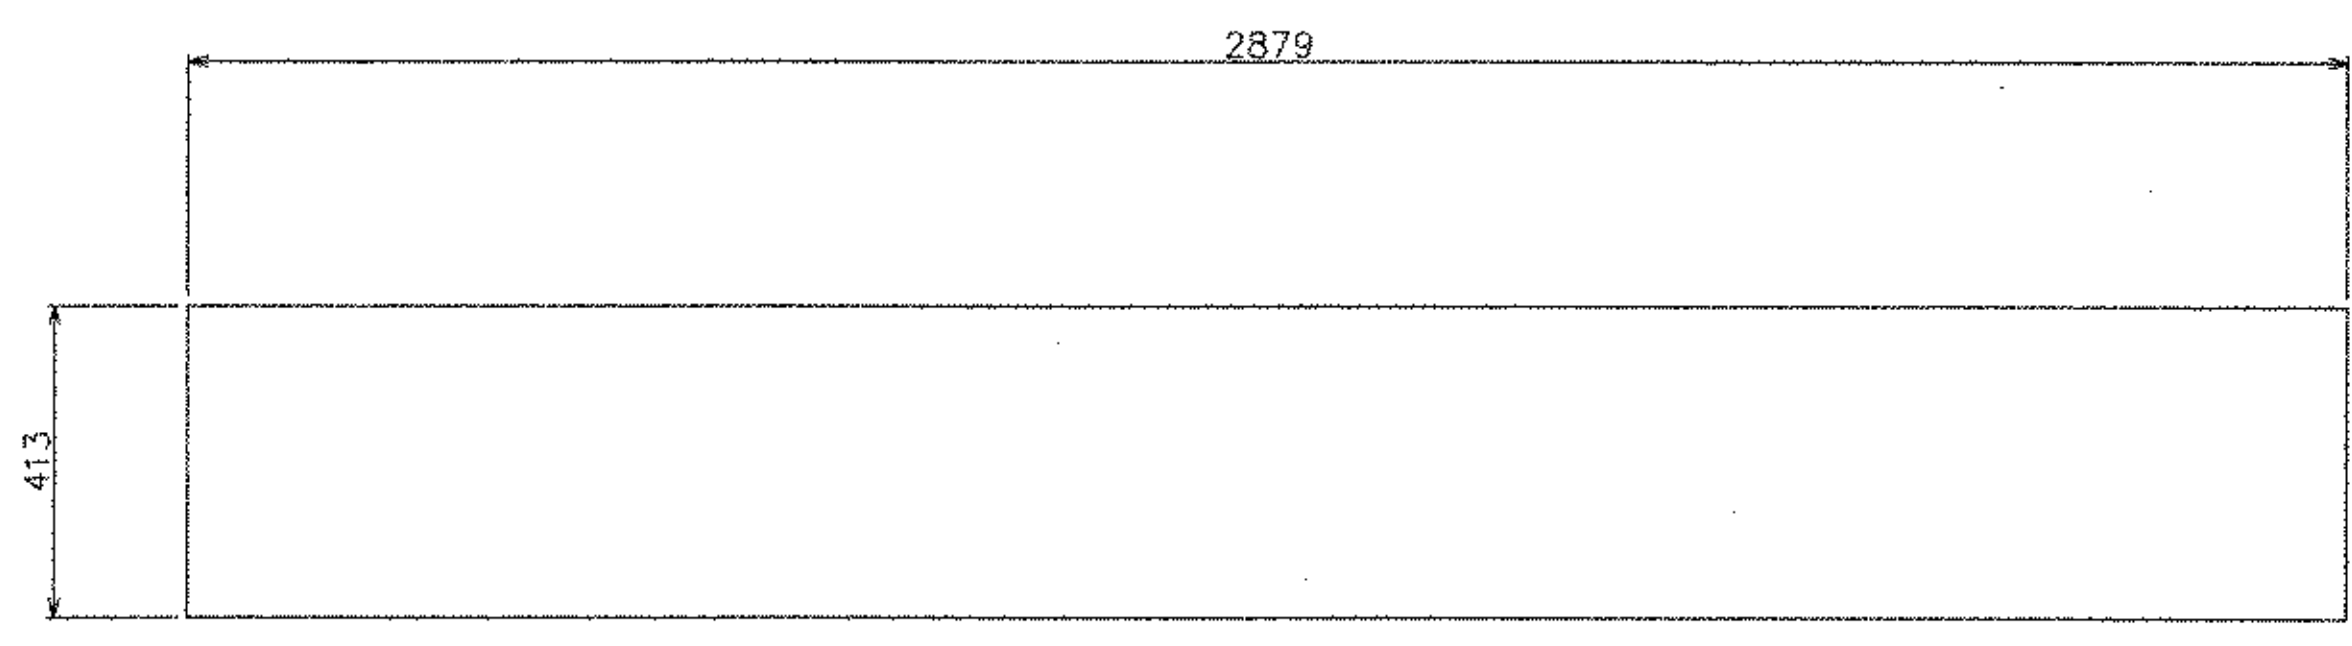


ITEM 7MS5 (18 REQ'D)
SCALE 1:10

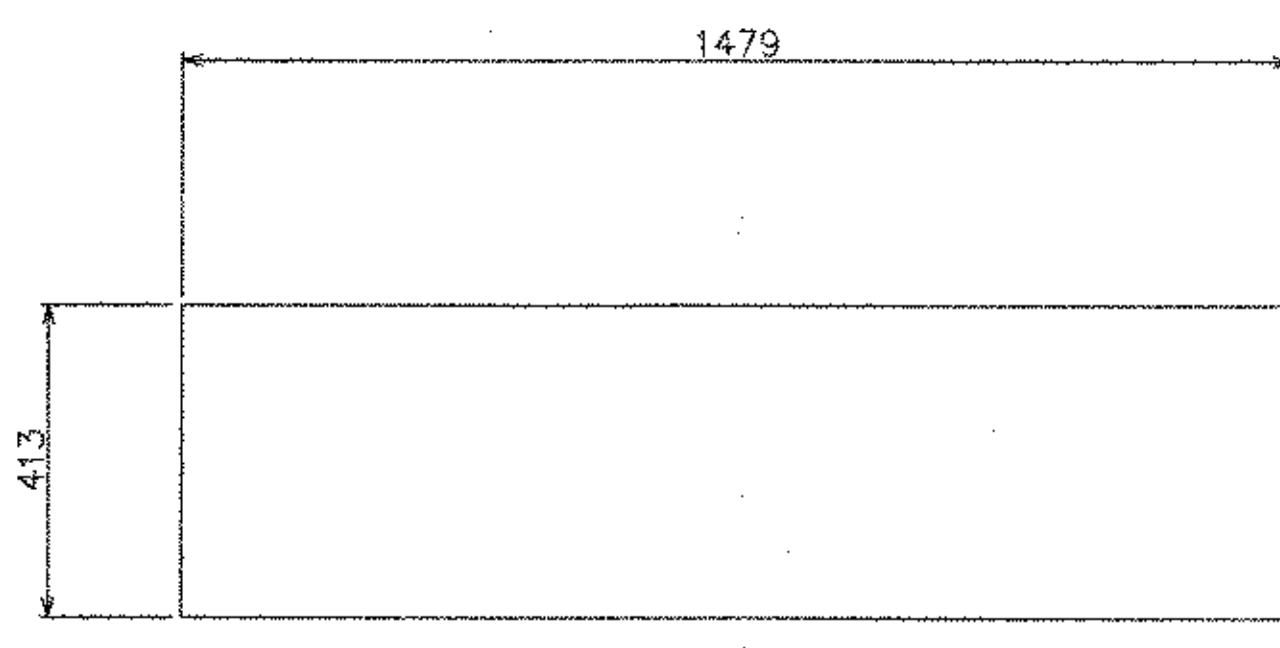


ITEM 7MS6 (4 REQ'D)
SCALE 1:10

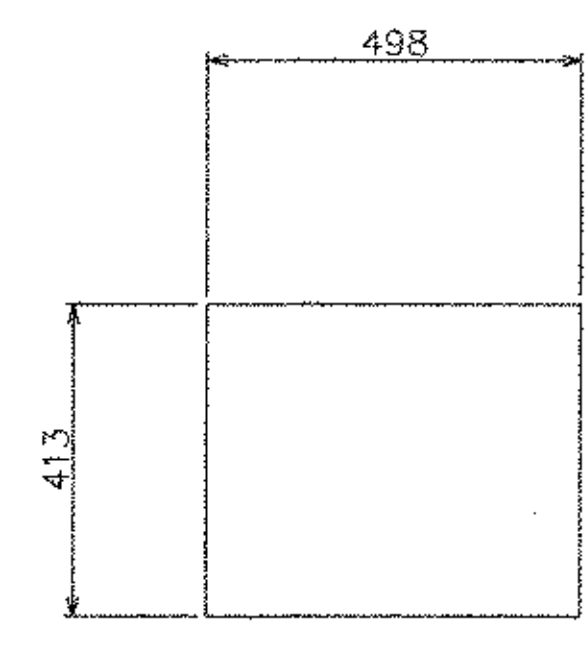

ITEM 7MS7 (4 REQ'D)
SCALE 1:10

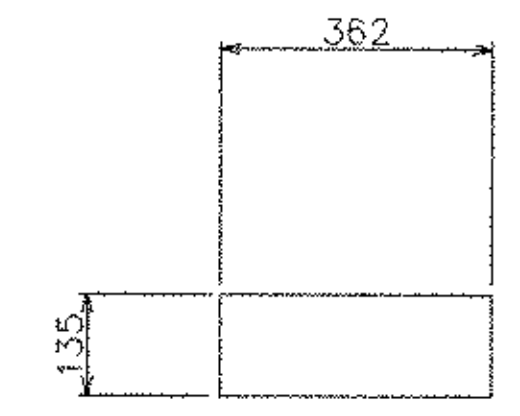


ITEM 7MS8 (40 REQ'D)
SCALE 1:10

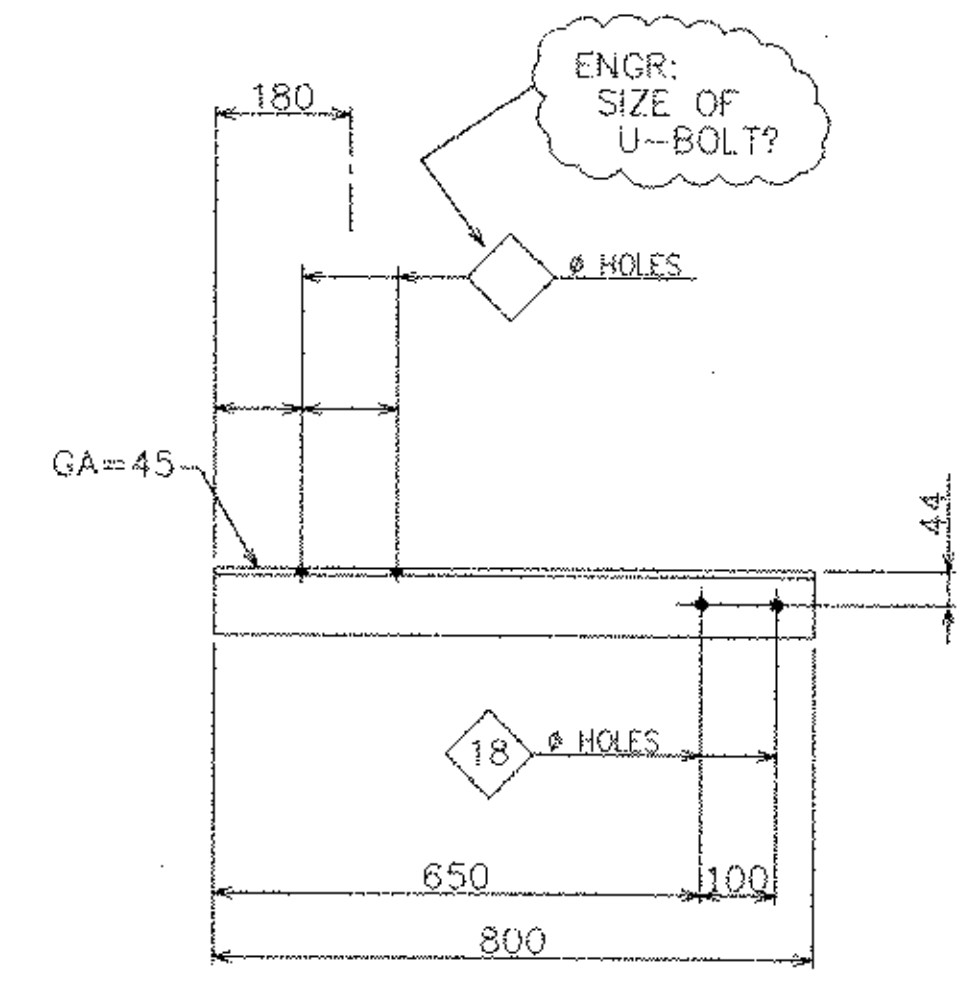

ITEM 7MS9 (10 REQ'D)
SCALE 1:10

Dwg No.	Rev.	Ship Mark	Piece Mark	Qty	Type	Size of Material	Grade	Length	Finish	Wgt./Lbs	Notes	ABM
7		7MS1		8	L	203x203x15.9	M270M-345W	526		451		2-A
7		7MS2		18	ASSY.					11255		
			a7	18	PL	14x795	M270M-345W	3050		10821		2-B
			b7	18	PL	10x85	M270M-345W	3050		434	BENT	2-C
7		7MS3		2	ASSY.					1200		
			c7	2	PL	14x795	M270M-345W	2723		1074		2-D
			d7	2	PL	10x85	M270M-345W	2723		77	BENT	2-E
			f7	2	L	76x76x12.5	M270M-345W	795		49		2-F
7		7MS4		2	ASSY.					1200		
			c7	2	PL	14x795	M270M-345W	2723		1074		2-D
			d7	2	PL	10x85	M270M-345W	2723		77	BENT	2-E
			f7	2	L	76x76x12.5	M270M-345W	795		49		2-F
7		7MS5		18	PL	14x413	M270M-345W	2879		5296		2-G
7		7MS6		4	PL	14x413	M270M-345W	1479		604		2-H
7		7MS7		4	PL	14x413	M270M-345W	498		203		2-I
7		7MS8		40	PL	10x135	M270M-345W	362		322		2-J
7		7MS9		10	L	89x89x9.5	M270M-345W	800		223		2-K

NOTES:
1 - GENERAL NOTES: SEE DRAWING GN1
2 - HOLES: 24ø (U.N.O.)

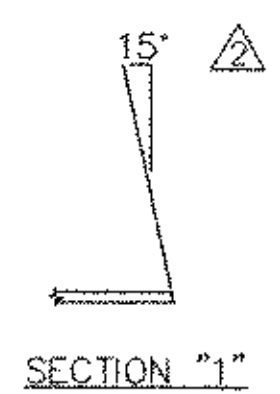

STEEL-ART, INCORPORATED
40 WEST MAIN STREET
GALETON, PA 16922
(814) 435-6997


EASTERN BRIDGE LLC
RURAL RTE 2, BOX 302
CLAREMONT, NH 03743
608-542-5202

REVISIONS			STATE OF VERMONT AGENCY OF TRANSPORTATION	
NO.	DATE	DESCRIPTION	CONTRACT :	PIN :
1	5/14/03	PER APPROVAL		
2	6/24/03	PER APPROVAL		
3	8/14/03	Approval		


PROPOSED IMPROVEMENT TO RR BRIDGE #62.56
OVER VT ROUTE 9 (PRINCIPAL ARTERIAL)
WINDHAM COUNTY, TOWN OF BRATTLEBORO

TITLE : MISC. DETAILS


DRAWN BY : TJS SHOP ORDER : 4015 DWG. NO. : 7
CRD BY : RGY BLOCK NO. : SHEET NO. : 13 / 20
DATE : 4/8/03

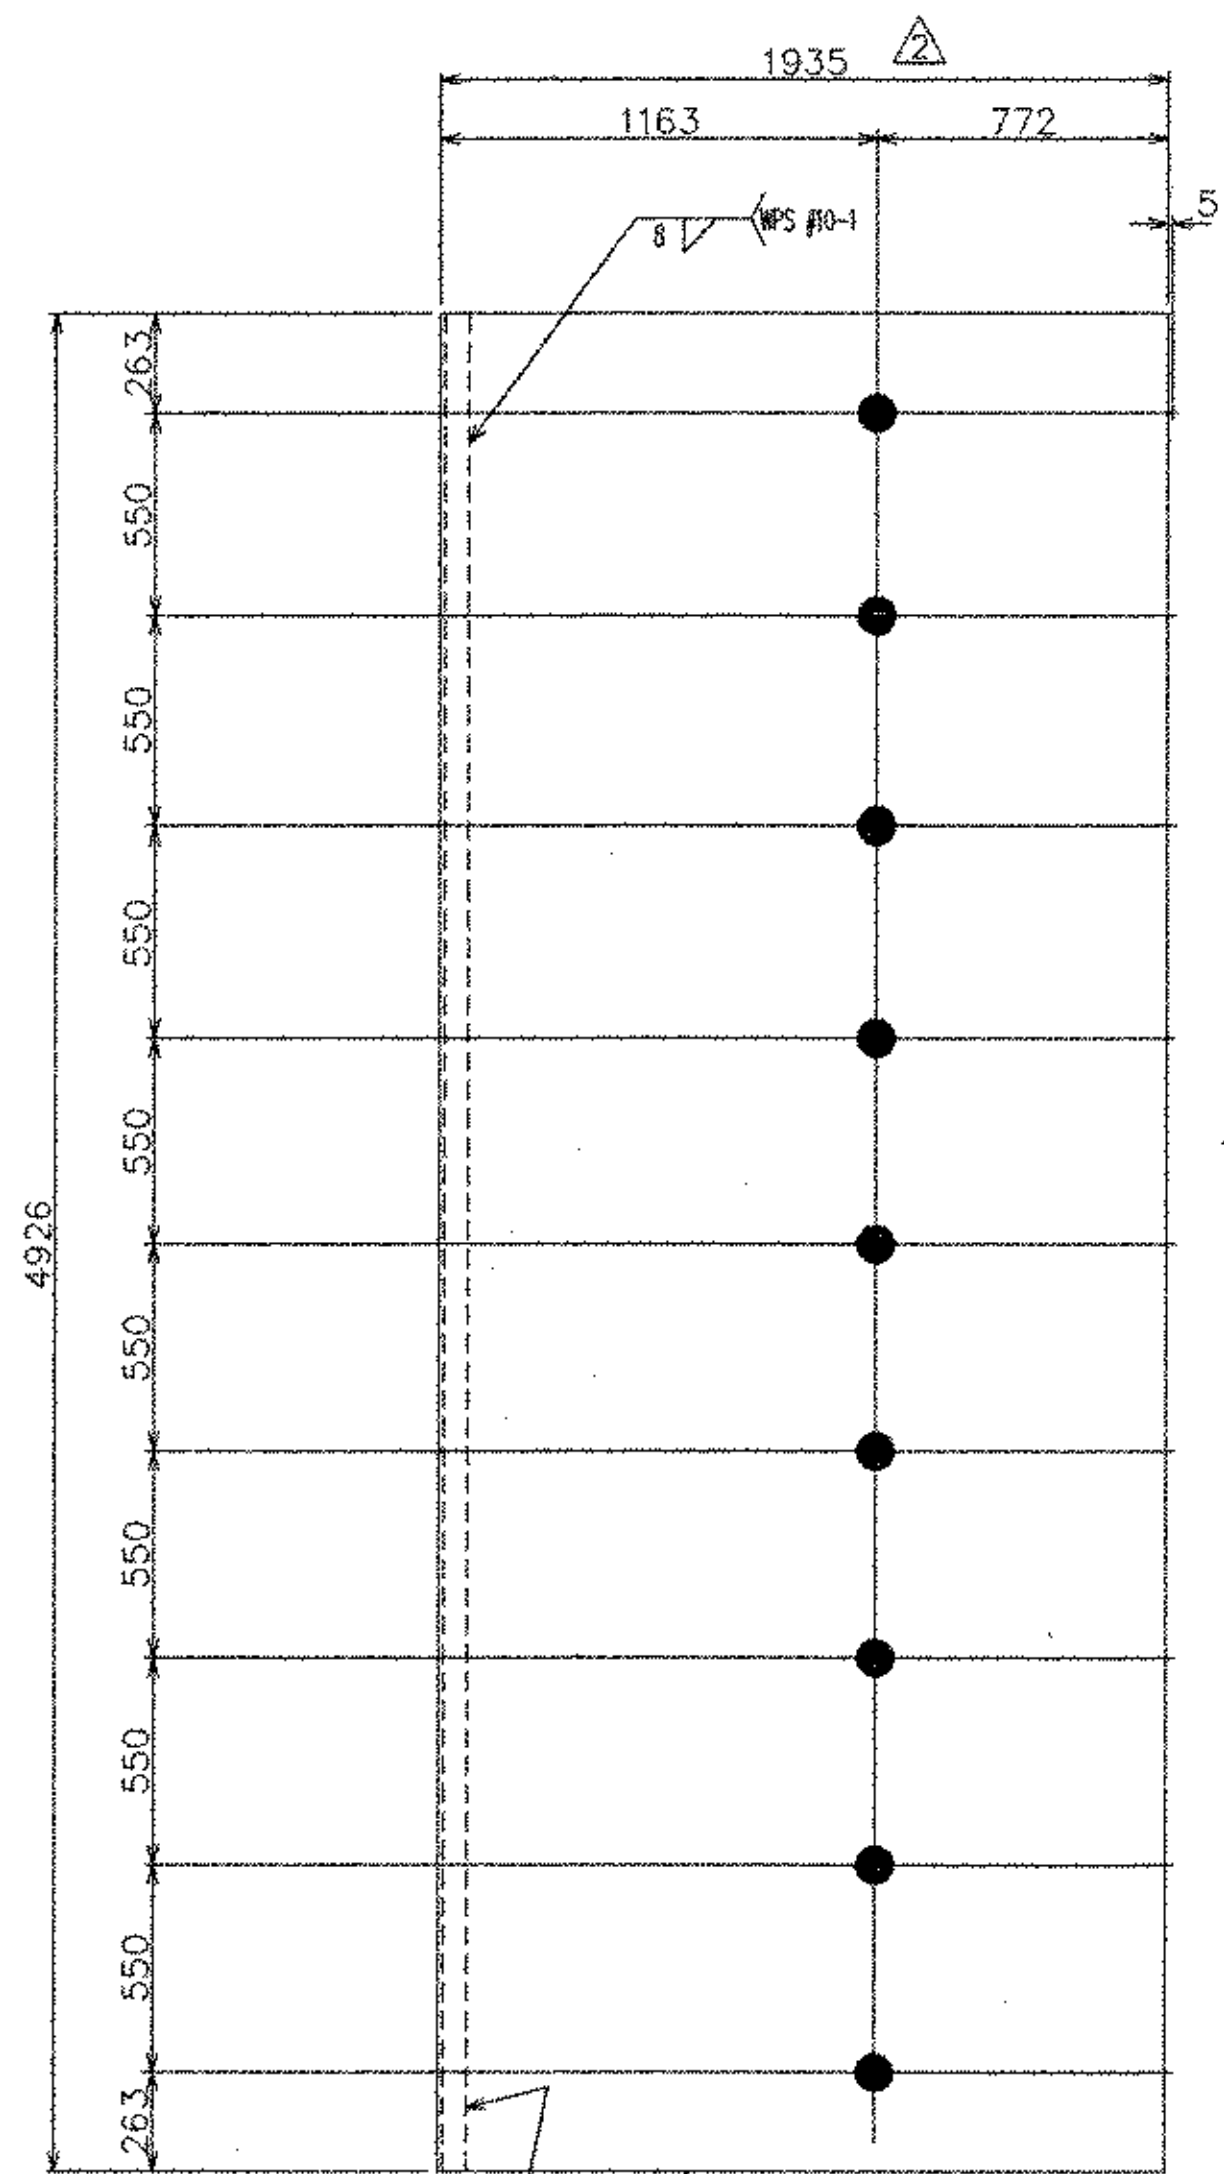


ITEM 8MS1 (2 REQ'D)
SCALE 1:20

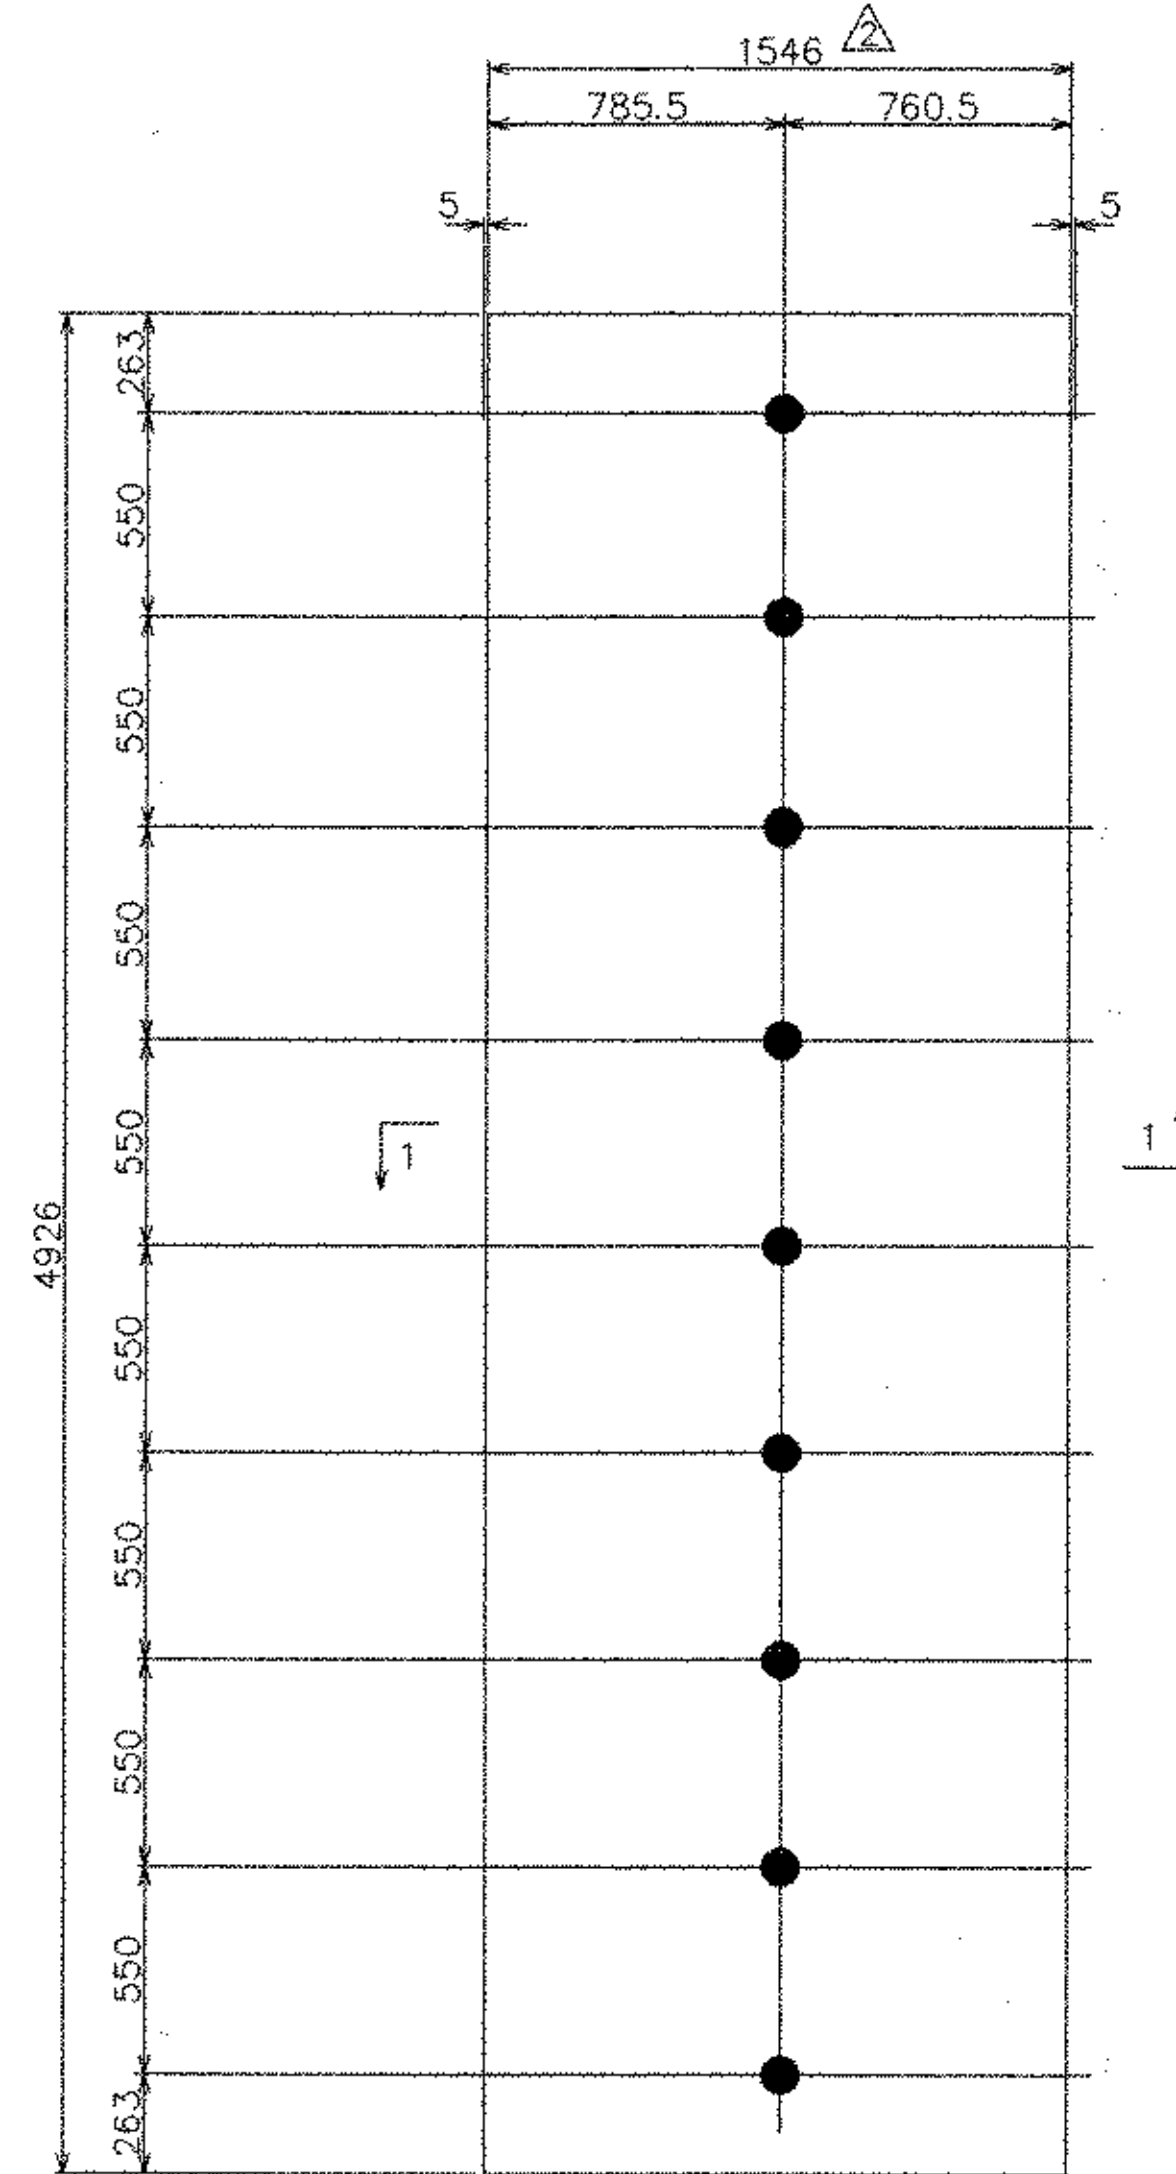

ITEM 8MS2 (2 REQ'D)
SCALE 1:20

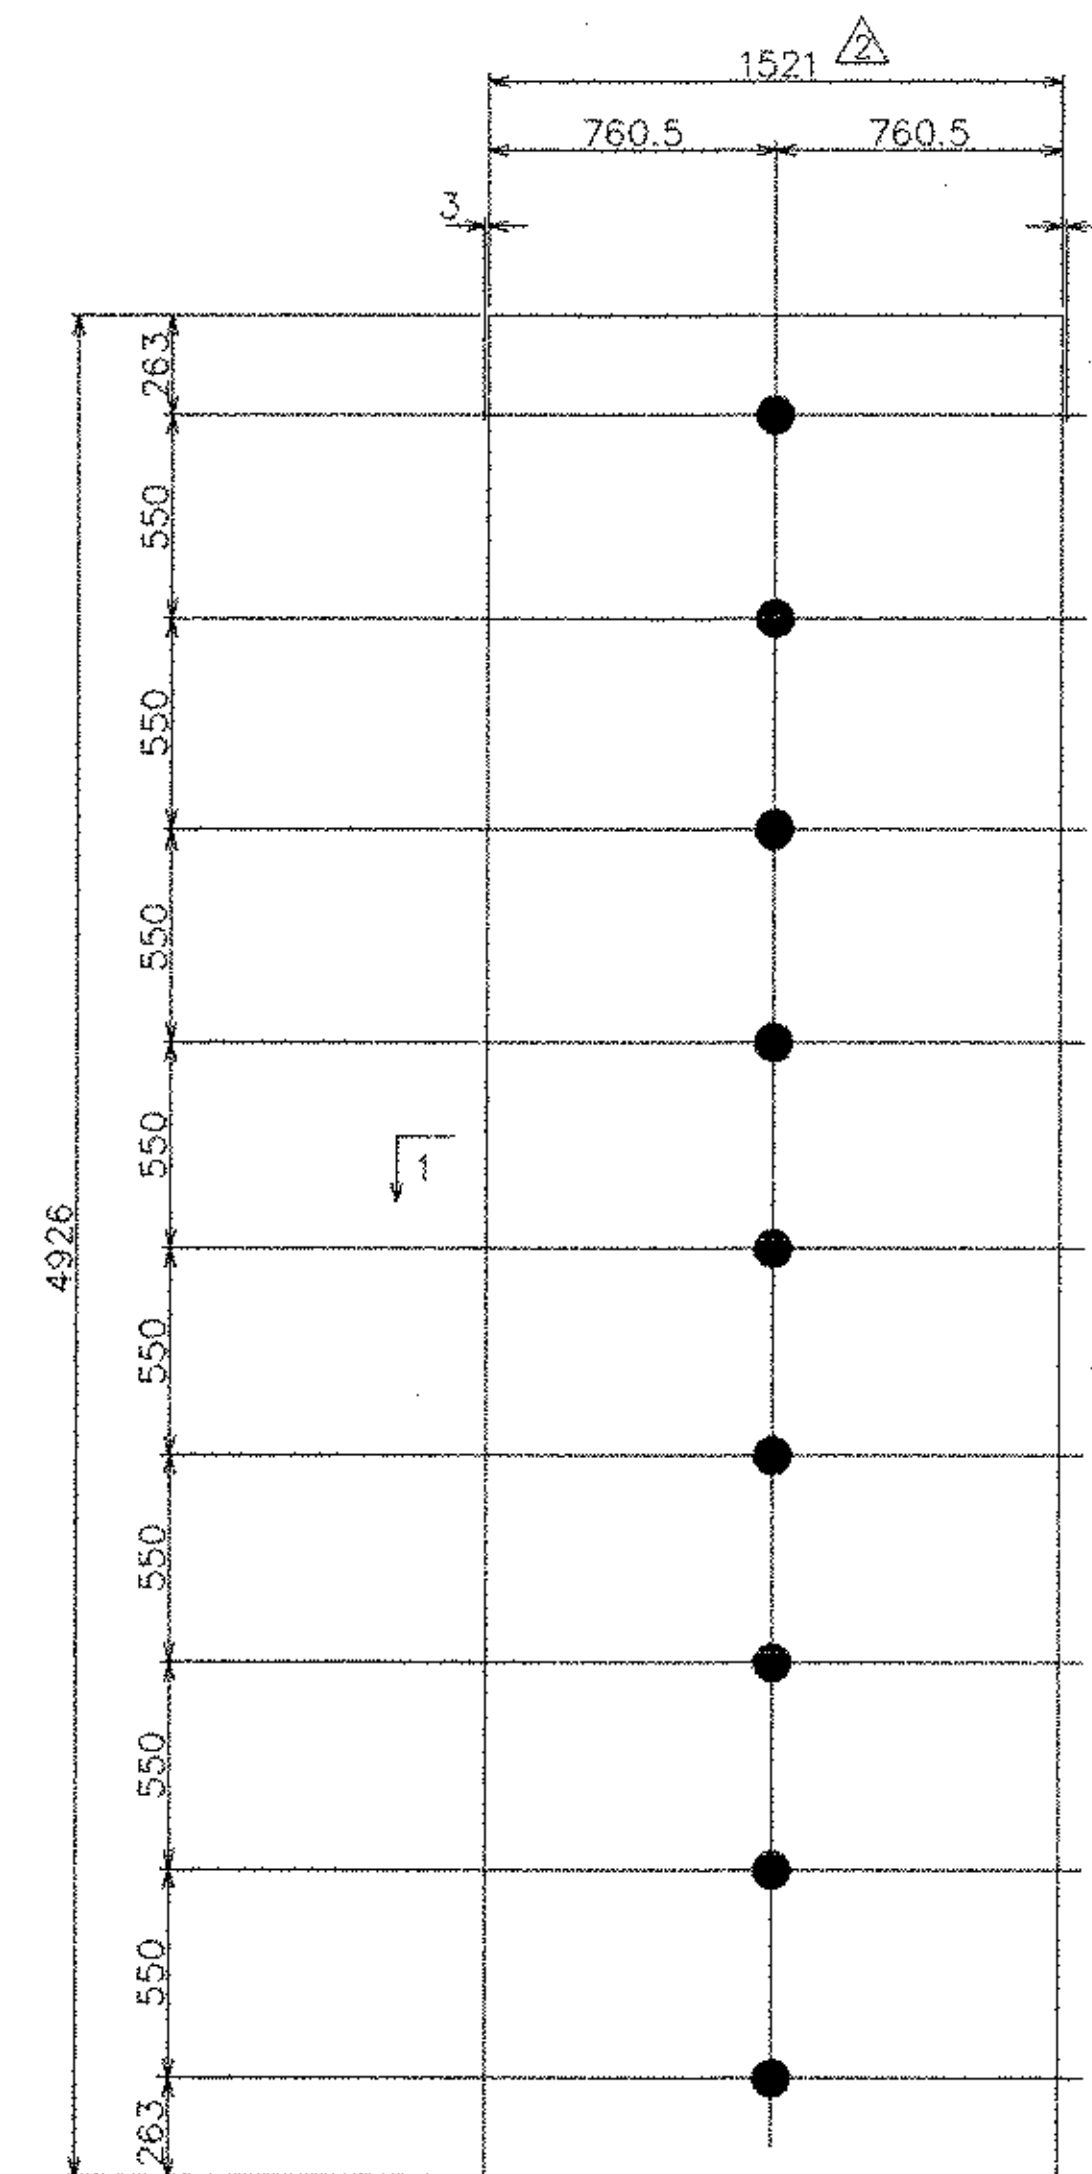


ITEM 8MS3 (17 REQ'D)
SCALE 1:20

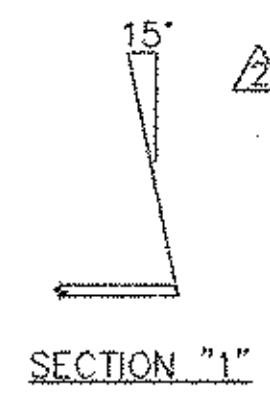

Dwg No.	Rev.	Ship Mark	Piece Mark	Qty	Type	Size of Material	Grade	Length	Finish	Wgt./Lbs.	Notes	ABM
8		8MS1		2	ASSY.					7126		
			a8	2	PL	20x1935	M270M-345W	4926		6822		2-L
			b8	2	L	76x76x12.5	M270M-345W	4926		304		2-M
8		8MS2		2	PL	20x1546	M270M-345W	4926		5463		2-N
8		8MS3		17	PL	20x1521	M270M-345W	4926		45679		2-O

NOTES:
1 - GENERAL NOTES: SEE DRAWING GN1
2 - HOLES: 100mm

STEEL-ART, INCORPORATED
40 WEST MAIN STREET
GALETON, PA 16922
(814) 433-6997

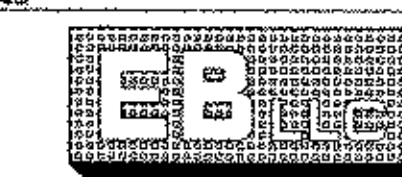

EASTERN BRIDGE LLC
RURAL RTE 2, BOX 302
CLAREMONT, NH 03743
608-542-5502

REVISIONS			STATE OF VERMONT AGENCY OF TRANSPORTATION		
NO.	DATE	DESCRIPTION	CONTRACT	PIN	
1	5/14/03	PER APPROVAL			
2	5/24/03	PER APPROVAL			
	8/4/03	Approval			


PROPOSED IMPROVEMENT TO RR BRIDGE #62.56
OVER VT ROUTE 9 (PRINCIPAL ARTERIAL)
WINDHAM COUNTY, TOWN OF BRATTLEBORO

TITLE: BALLAST PLATES


DRAWN BY TJS	SHOP ORDER	DWG. NO.
3/25/03	4015	8
OK'D BY RGY	BLOCK NO.	SHEET NO.
4/8/03		14 / 20

Dwg No.	Rev.	Ship Mark	Piece Mark	Qty	Type	Size of Material	Grade	Length	Finish	Wgt./Lbs.	Notes	ASM		
9			9MS1	2	ASSY.					765				
				m1pb	2	PL	20x150	M270M-345W	4953		540		2-P	
				m1pc	4	PL	20x150	M270M-345W	820		180		2-Q	
				a9	30	HEADED ANCH	20ø			150		45		2-R
9			9MS2	1	ASSY.					78				
				b9	1	PIPE	200ø SCH. 40	A53 GR B	90° ELBOW	GALV.	46		2-S	
				c9	1	PIPE	200ø SCH. 40	A53 GR B	300	GALV.	28		2-T	
				d9	1	PL	14x86	M270M-345W	198	GALV.	4		2-U	
9			9MS3	1	ASSY.					375				
				f9	1	1/2 PIPE	200ø SCH. 80	A53 GR B	347	GALV.	10		2-V	
				g9	1	PLATE	14x200	M270M-345W	200	GALV.	37		2-W	
				k9	1	1/2 PIPE	200ø SCH. 80	A53 GR B	STRAIGHT REE	GALV.	294		2-X	
				m9	1	1/2 PIPE	200ø SCH. 80	A53 GR B	4128	GALV.	34	PERF.	2-Y	
				n9	1	1/2 PIPE	200ø SCH. 80	A53 GR B	90° ELBOW	GALV.		2-Z		


NOTES:
 1 - GENERAL NOTES: SEE DRAWING GN1
 2 - HOLES: 50mm (U.N.O.)

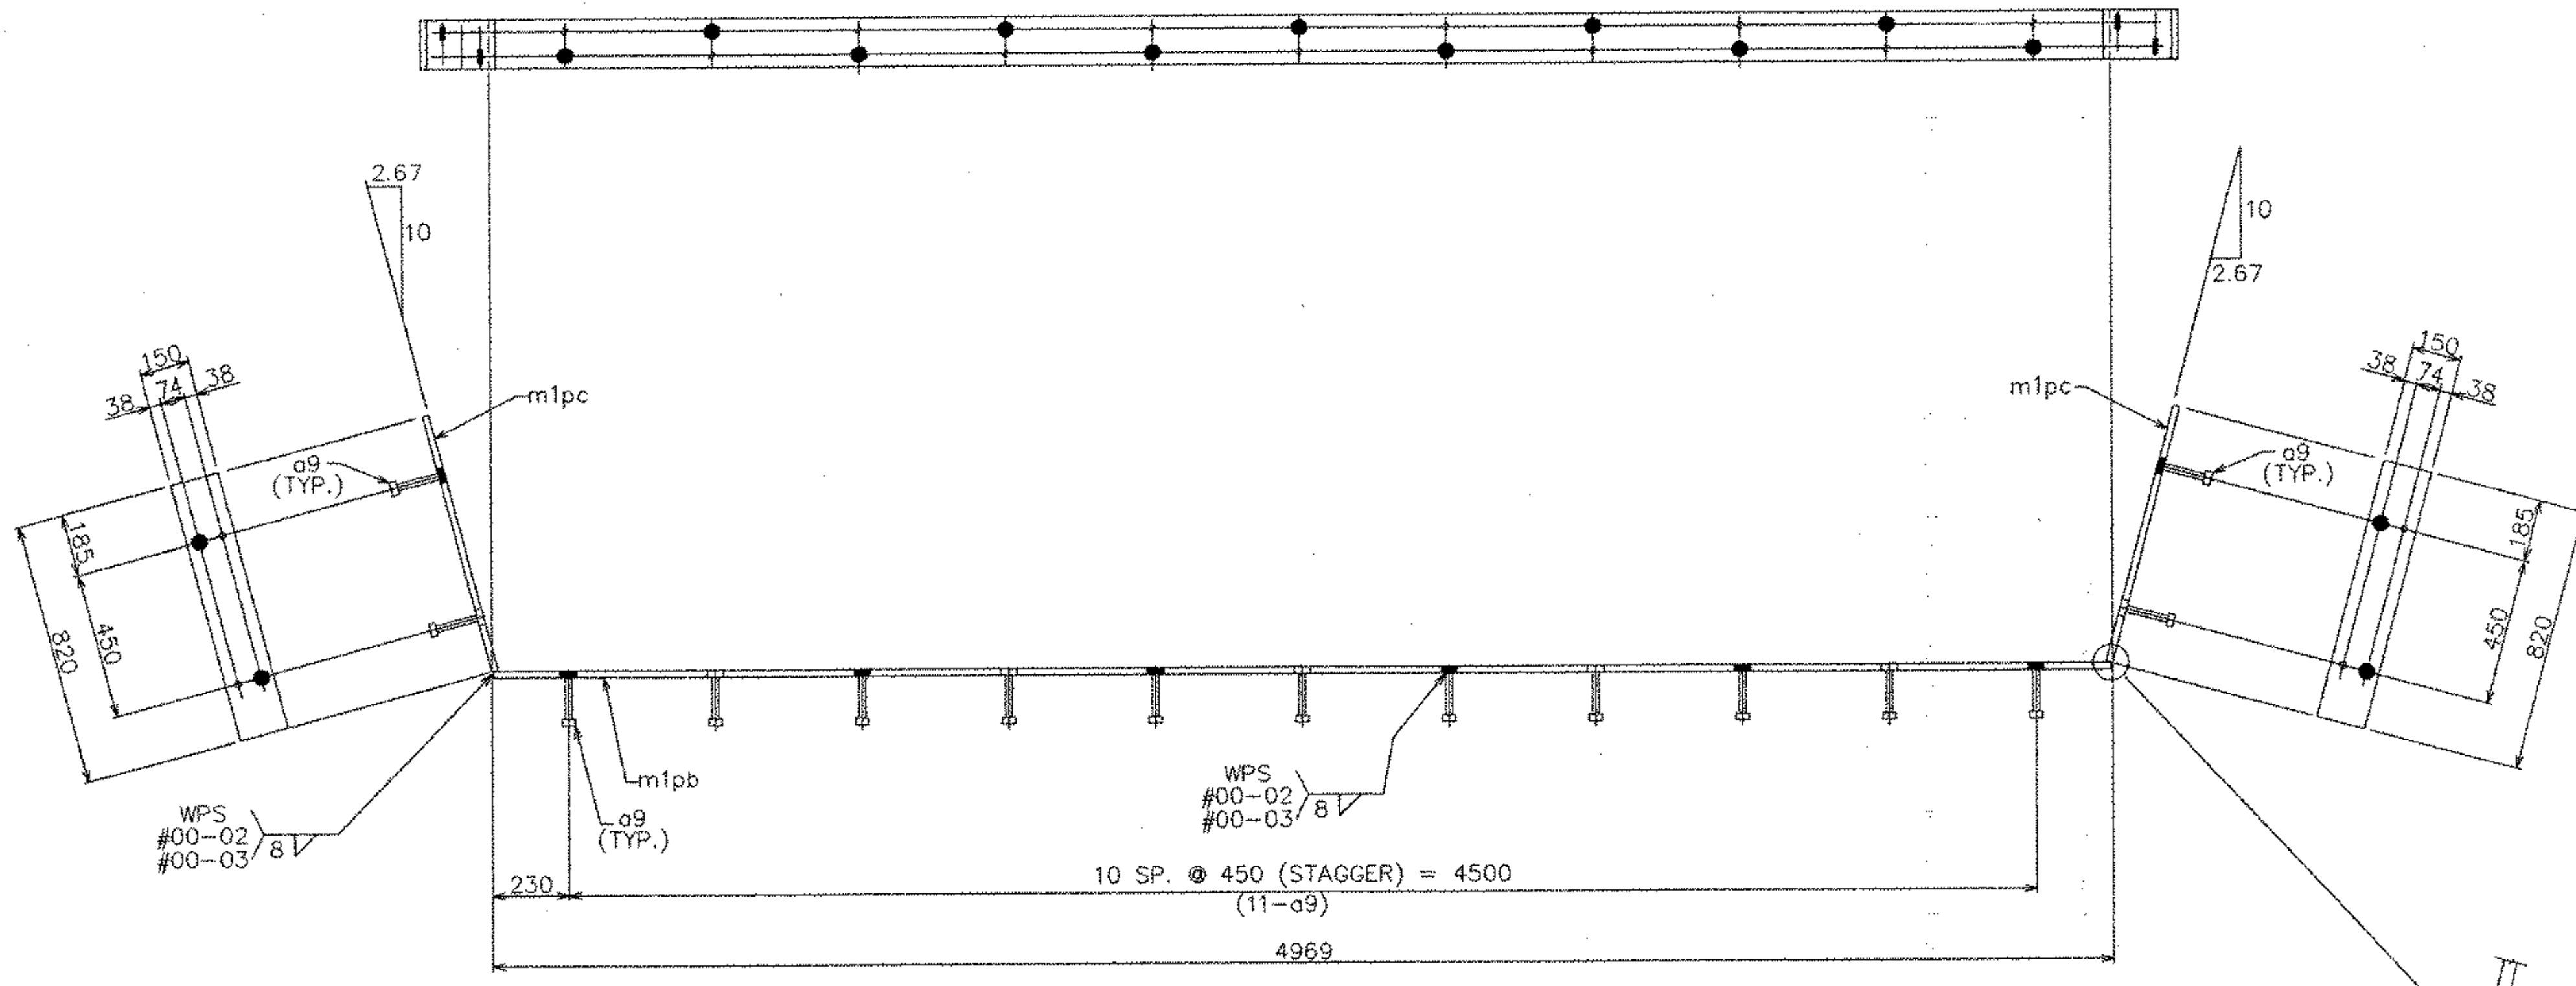


ITEM 9MS1 (2 REQ'D)
SCALE 1:15

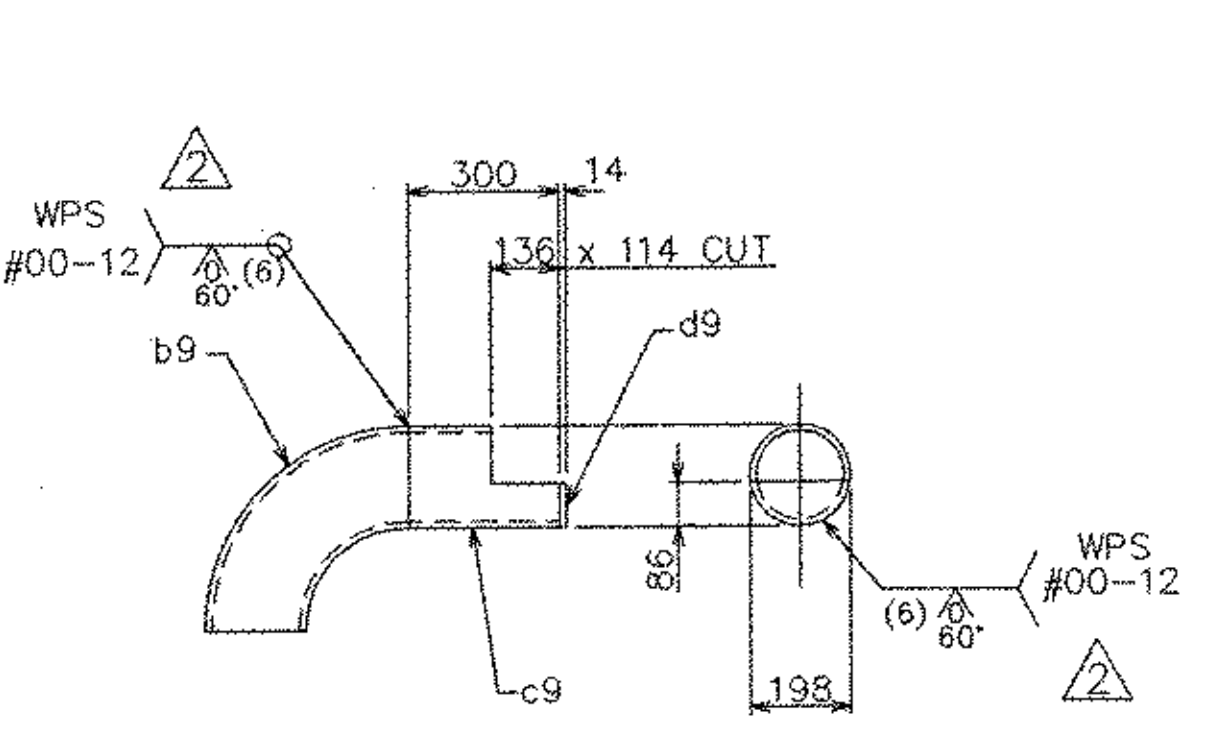

ITEM 9MS2 (1 REQ'D)
SCALE 1:15

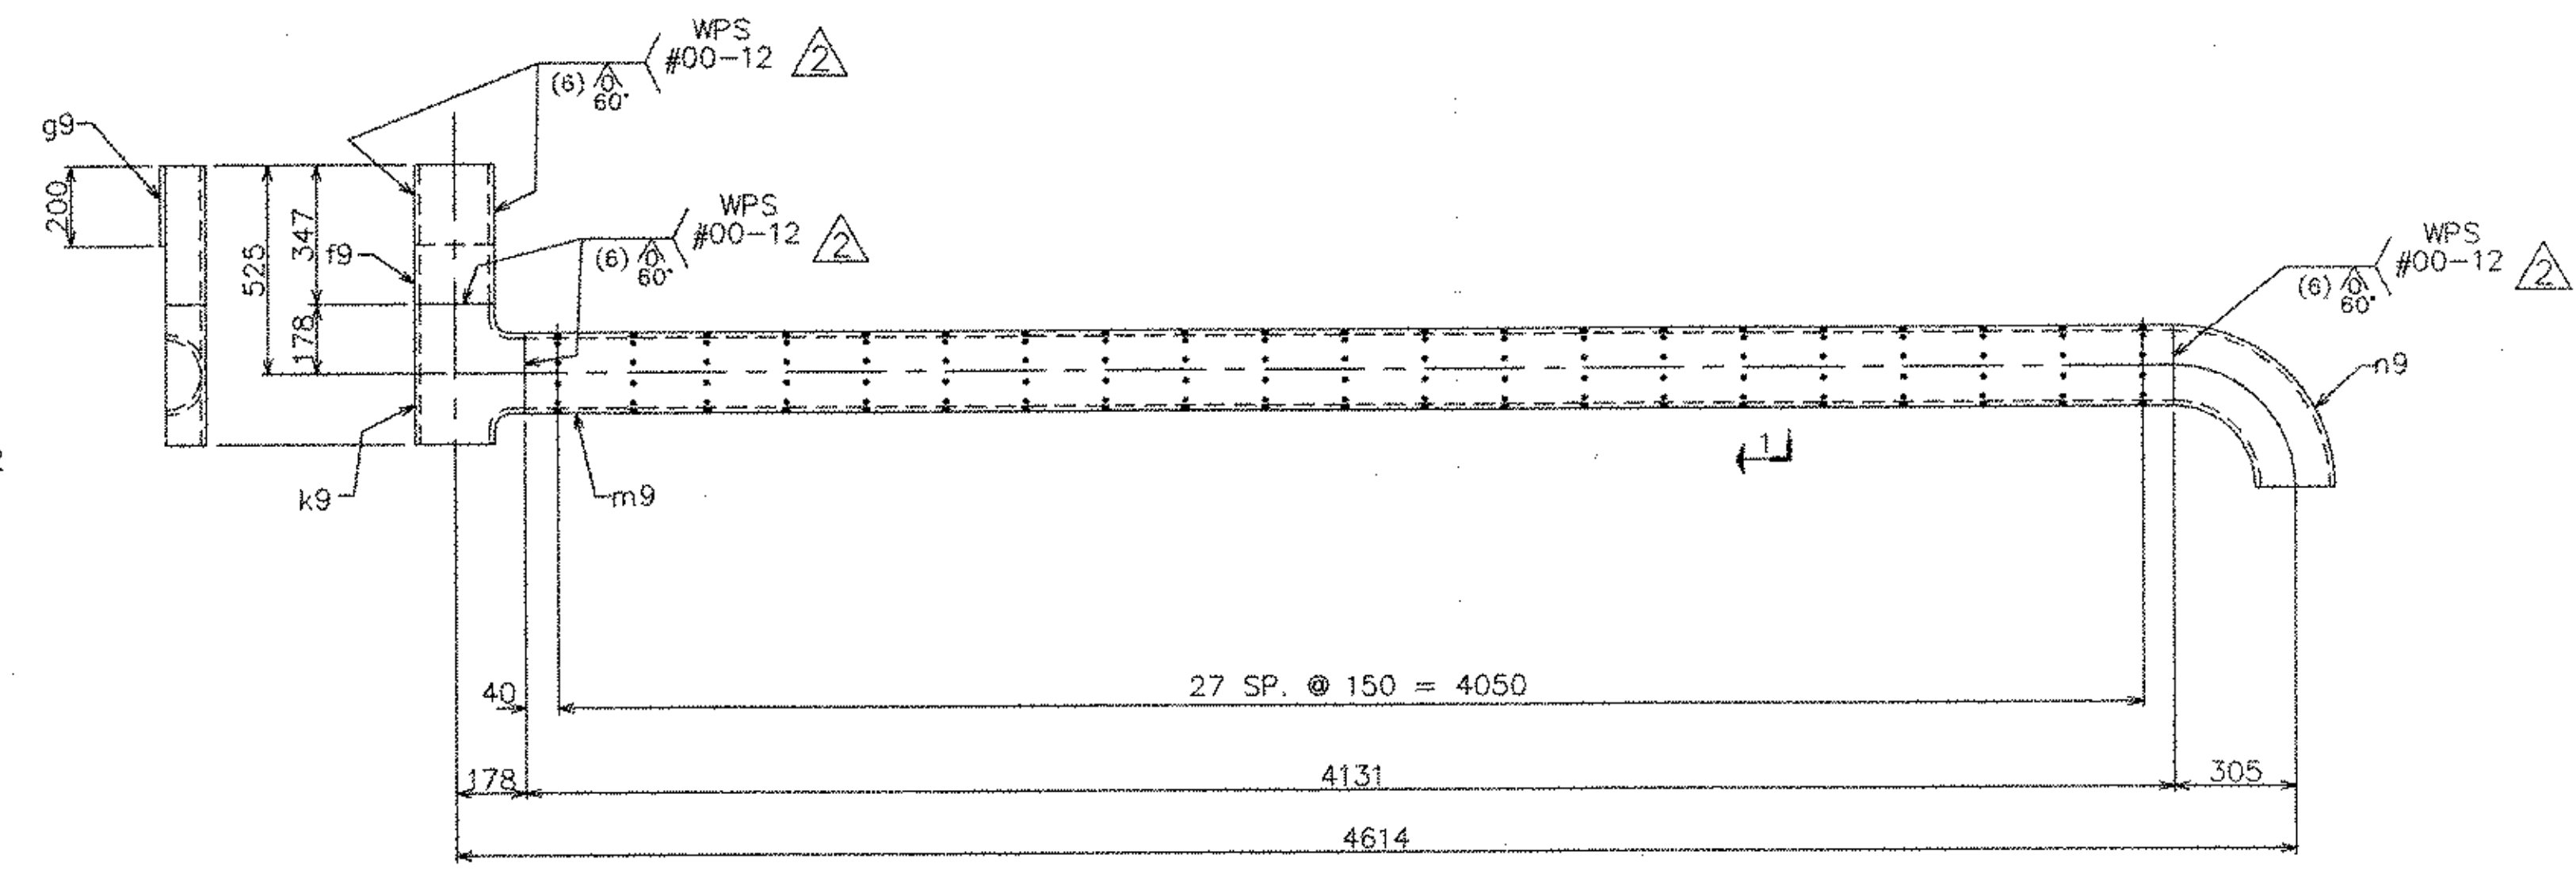

ITEM 9MS3 (1 REQ'D)
SCALE 1:15

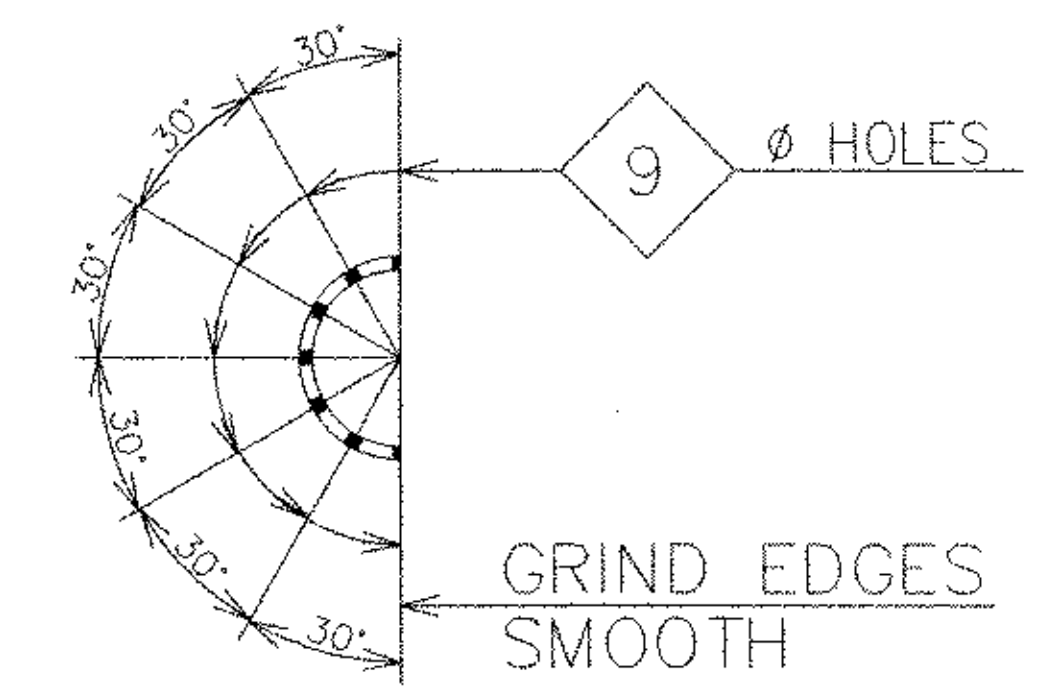

SECTION "1"


STEEL-ART, INCORPORATED
 40 WEST MAIN STREET
 GALETON, PA 16922
 (814) 435-6997




REVISIONS			STATE OF VERMONT AGENCY OF TRANSPORTATION		
NO.	DATE	DESCRIPTION	CONTRACT	PIN:	
1	5/14/03	PER APPROVAL	PROPOSED IMPROVEMENT TO RR BRIDGE #62.56 OVER VT ROUTE 9 (PRINCIPAL ARTERIAL) WINDHAM COUNTY, TOWN OF BRATTLEBORO		
2	6/24/03	PER APPROVAL			
3	8/14/03	Approval			
TITLE: MISC. DETAILS			DRAWN BY: TJS SHOP ORDER: 4015 DWG. NO.: 9		
			CRD BY: RJS BLOCK NO.: SHEET NO.: 15 / 20		
			4/16/03		

Dwg. No.	Rev.	Ship Mark	Piece Mark	Qty	Type	Size of Material	Grade	Length	Finish	Wgt./Lbs.	Notes	ABM
10				4	1/2 PIPE	200# SCH. 80	A53 GR. B	12798	GALV.	3645	PERF.	3-A
10				2	ASSY.					984		
			a10	2	1/2 PIPE	200# SCH. 80	A53 GR. B	6881	GALV.	979	PERF.	3-B
			b10	2	PL	14x100	M270M-345W	200	GALV.	5		3-C
10				ONE	U-BOLT							
			c10	1	ROD	φ	A36		GALV.			
				2			HEX NUT		GALV.			
				2			WASHER		GALV.			
			d10	1	PL		A36		GALV.			


NOTES:
 1 - GENERAL NOTES: SEE DRAWING GNT
 2 - HOLES: 24φ (U.N.O.)

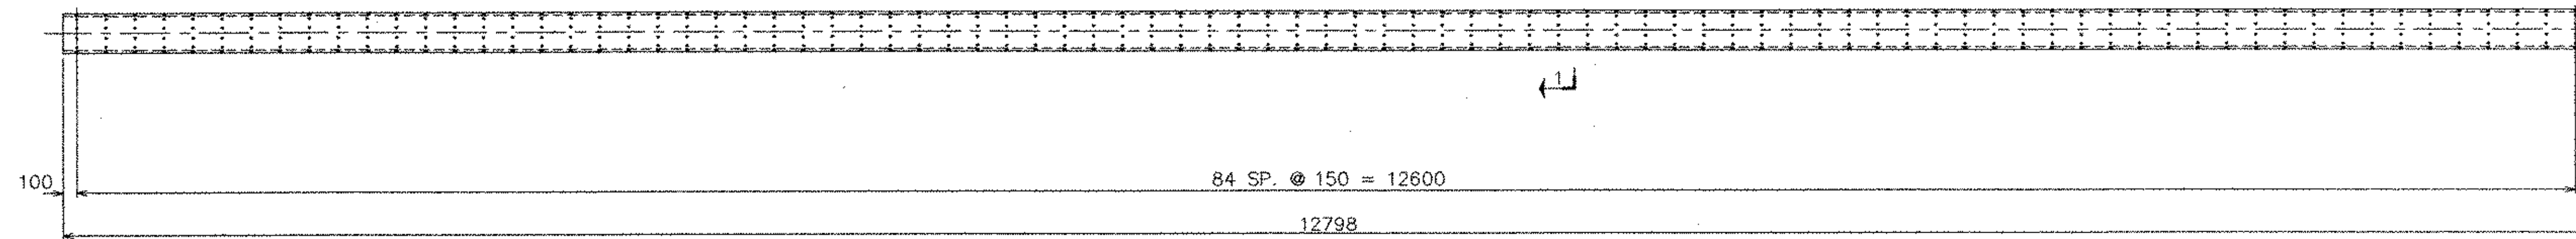


ITEM 10MS1 (4 REQ'D)
 SCALE 1:20

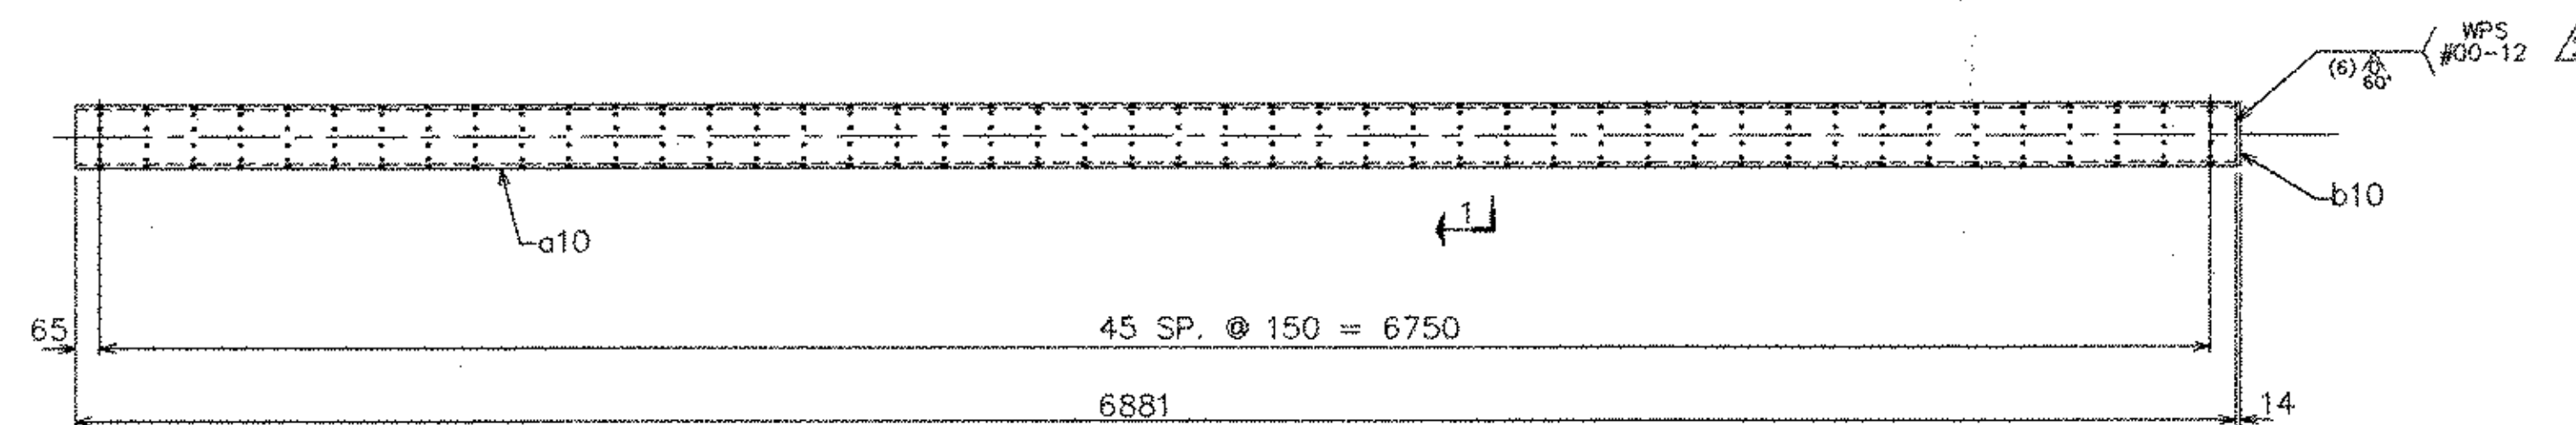

ITEM 10MS2 (2 REQ'D)
 SCALE 1:20

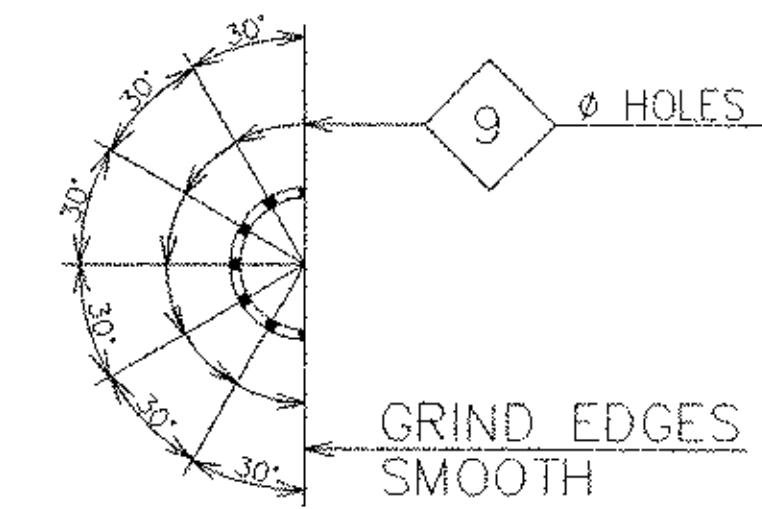


SECTION "1"

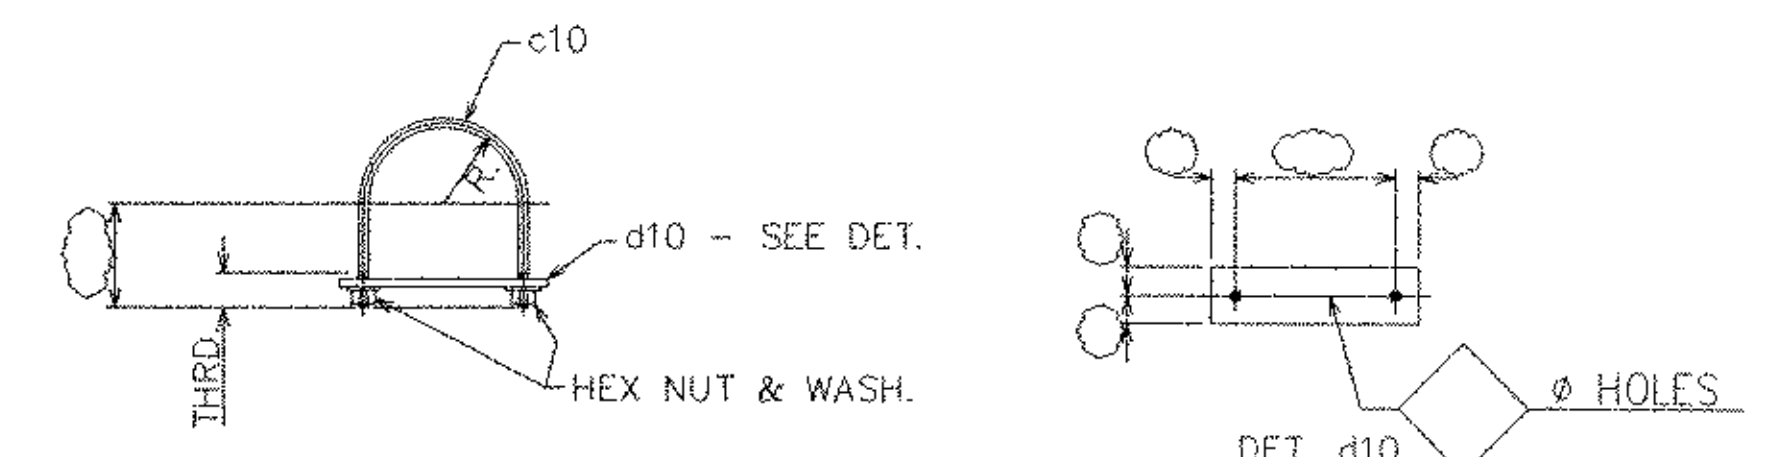

ITEM 10MS3 (1 REQ'D)
 NTS


STEEL-ART, INCORPORATED
 40 WEST MAIN STREET
 GALETON, PA 16922
 (814) 435-6997

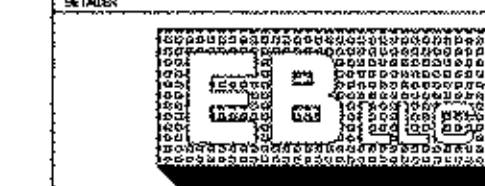

EASTERN BRIDGE LLC
 RURAL RTE. 2, BOX 302
 CLAREMONT, NH 03743
 603-642-5202


REVISIONS			STATE OF VERMONT AGENCY OF TRANSPORTATION	
NO.	DATE	DESCRIPTION	CONTRACT :	PN :
1	5/14/03	PER APPROVAL	PROPOSED IMPROVEMENT TO RR BRIDGE #62.56	
2	6/24/03	PER APPROVAL	OVER VT ROUTE 9 (PRINCIPAL ARTERIAL)	
3	8/4/03	Approval	WINDHAM COUNTY, TOWN OF BRATTLEBORO	
			TITLE :	
			MISC. DETAILS	
DRAWN BY TJS		SHOP ORDER	DWC NO.	
3/26/03		4015	10	
CHKD BY RSY		BLOCK NO.	SHEET NO.	
4/9/03			16 / 20	

19955

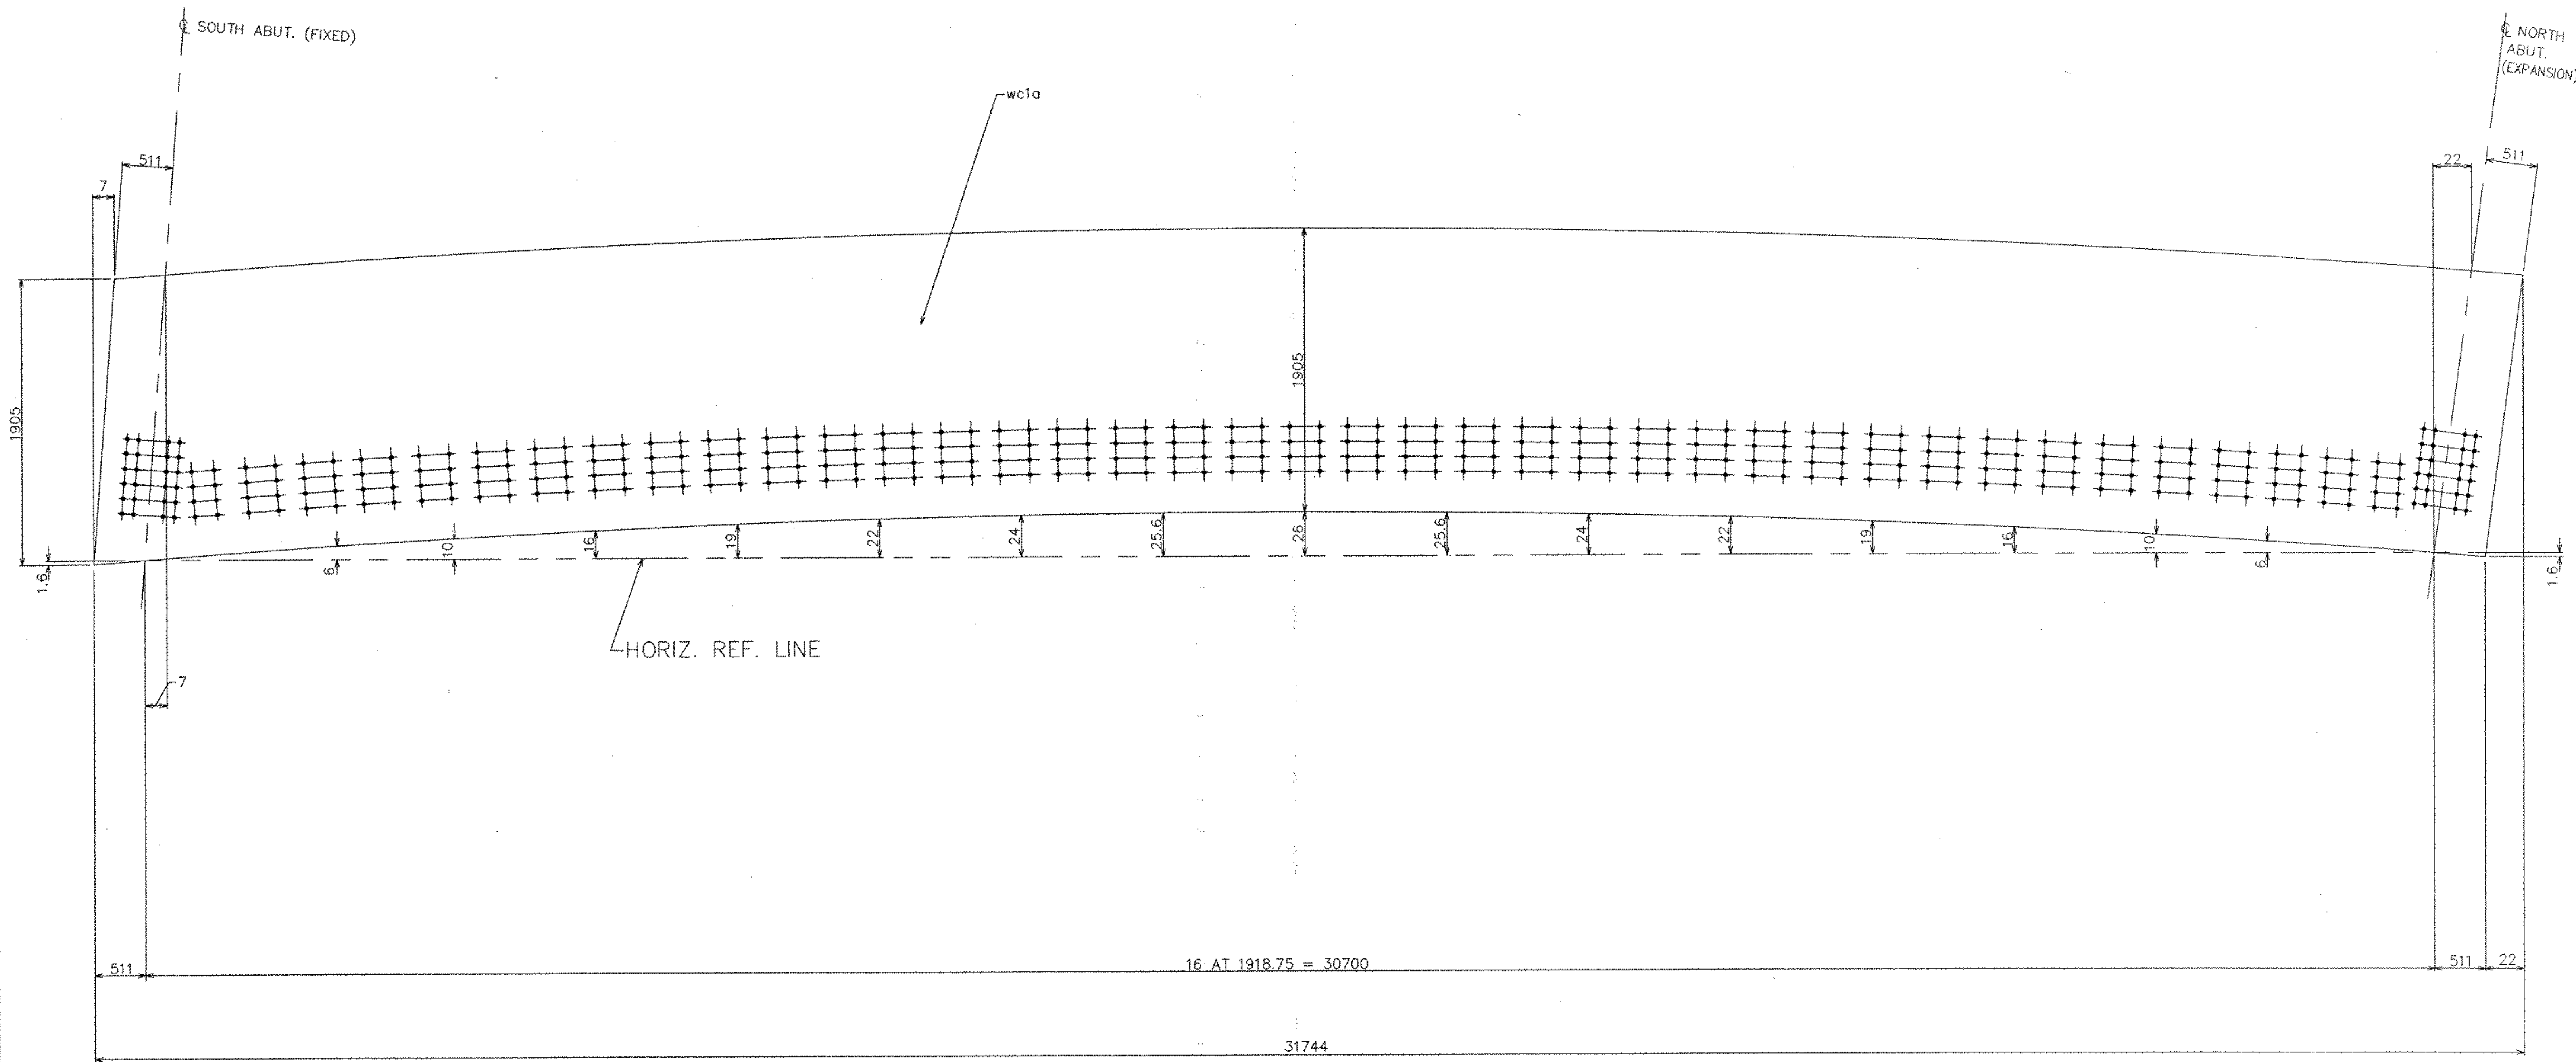

WEB CUTTING FOR 1G1A, 2G2A (FCM)
 NTS (wc1a, PL25x1905 x 31744)


STEEL-ART, INCORPORATED
 40 WEST MAIN STREET
 GALETON, PA 16922
 (814) 435-6997

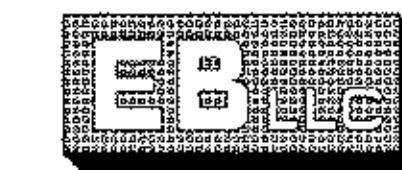


EASTERN BRIDGE LLC
 RURAL RTE 2, BOX 302
 CLAREMONT, NH 03743
 608-542-5202

REVISIONS			STATE OF VERMONT AGENCY OF TRANSPORTATION	
NO.	DATE	DESCRIPTION	CONTRACT :	PIN :
1	5/14/03	PER APPROVAL	PROPOSED IMPROVEMENT TO RR BRIDGE #62.56 OVER VT ROUTE 9 (PRINCIPAL ARTERIAL) WINDHAM COUNTY, TOWN OF BRATTLEBORO	
	8/14/03	APPROVAL		
			TITLE :	
			WEB CUTTING DIAGRAM	
DRAWN BY TJS		SHOP ORDER	DWC NO.	
3/26/03		4015	WC1	
CHKD BY RJS		BLOCK NO.	SHEET NO.	
4/14/03			17 / 20	


20055

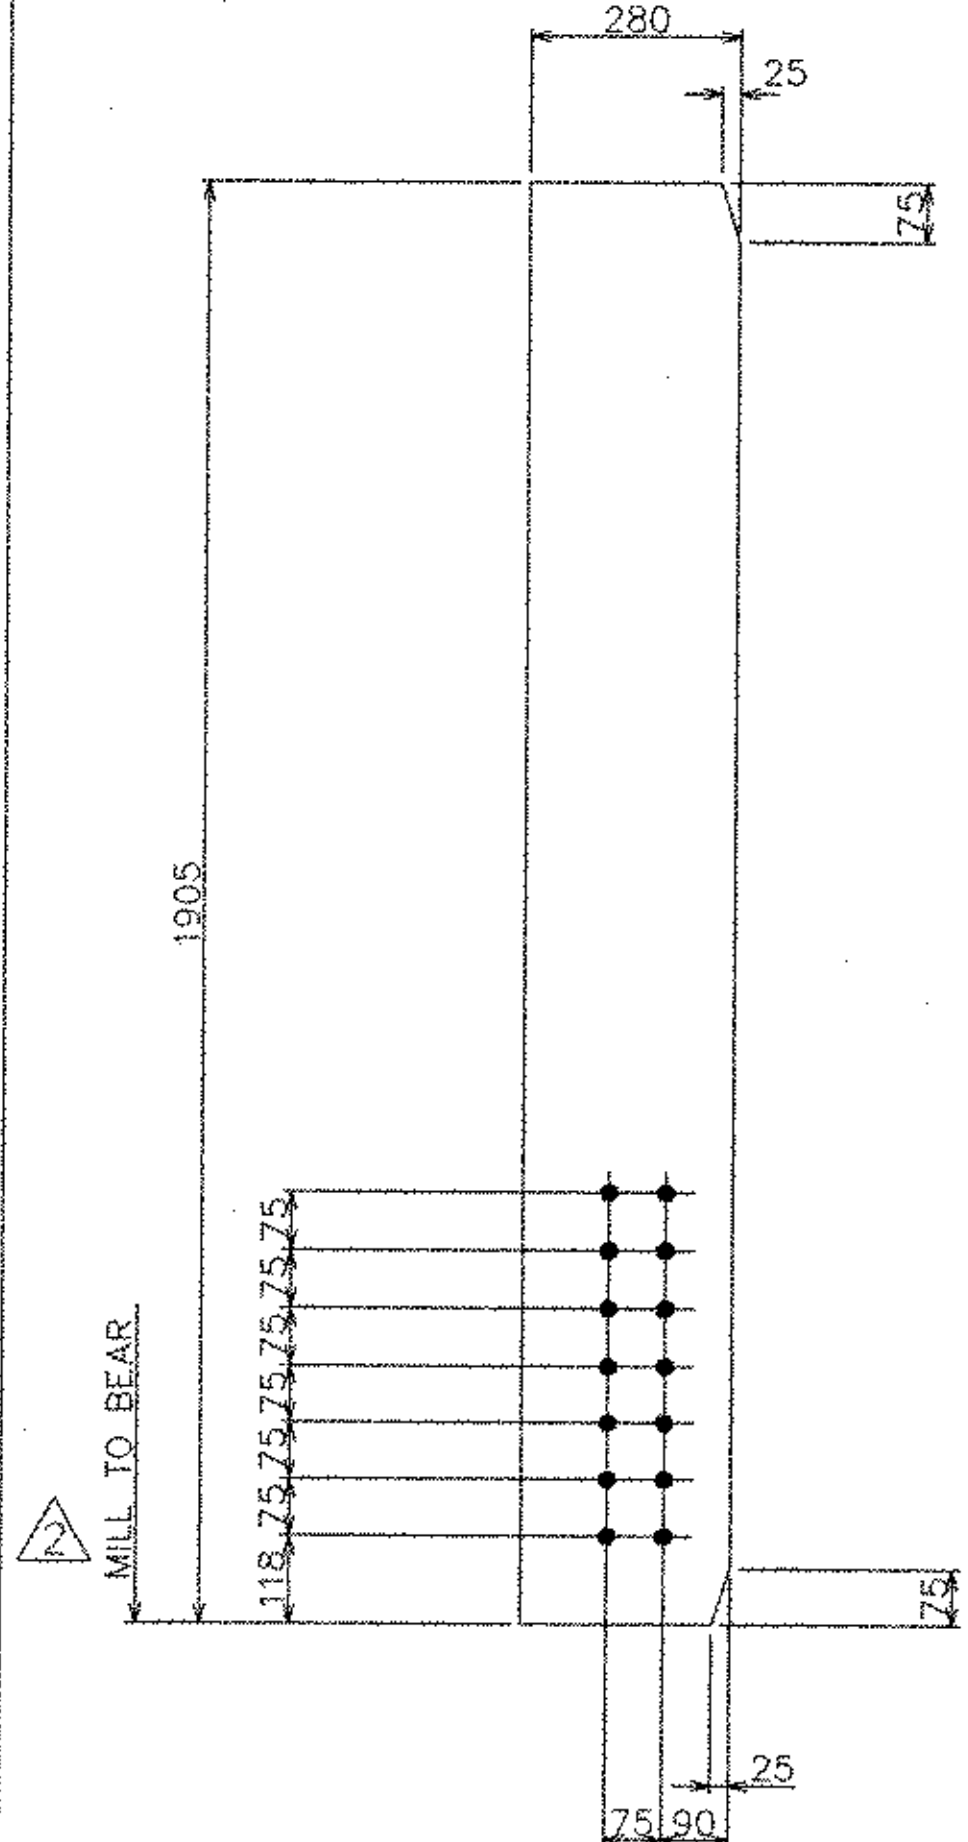


ITEM x1pg (4 REQ'D)
SCALE 1:10 (PL28x280 x 1905)

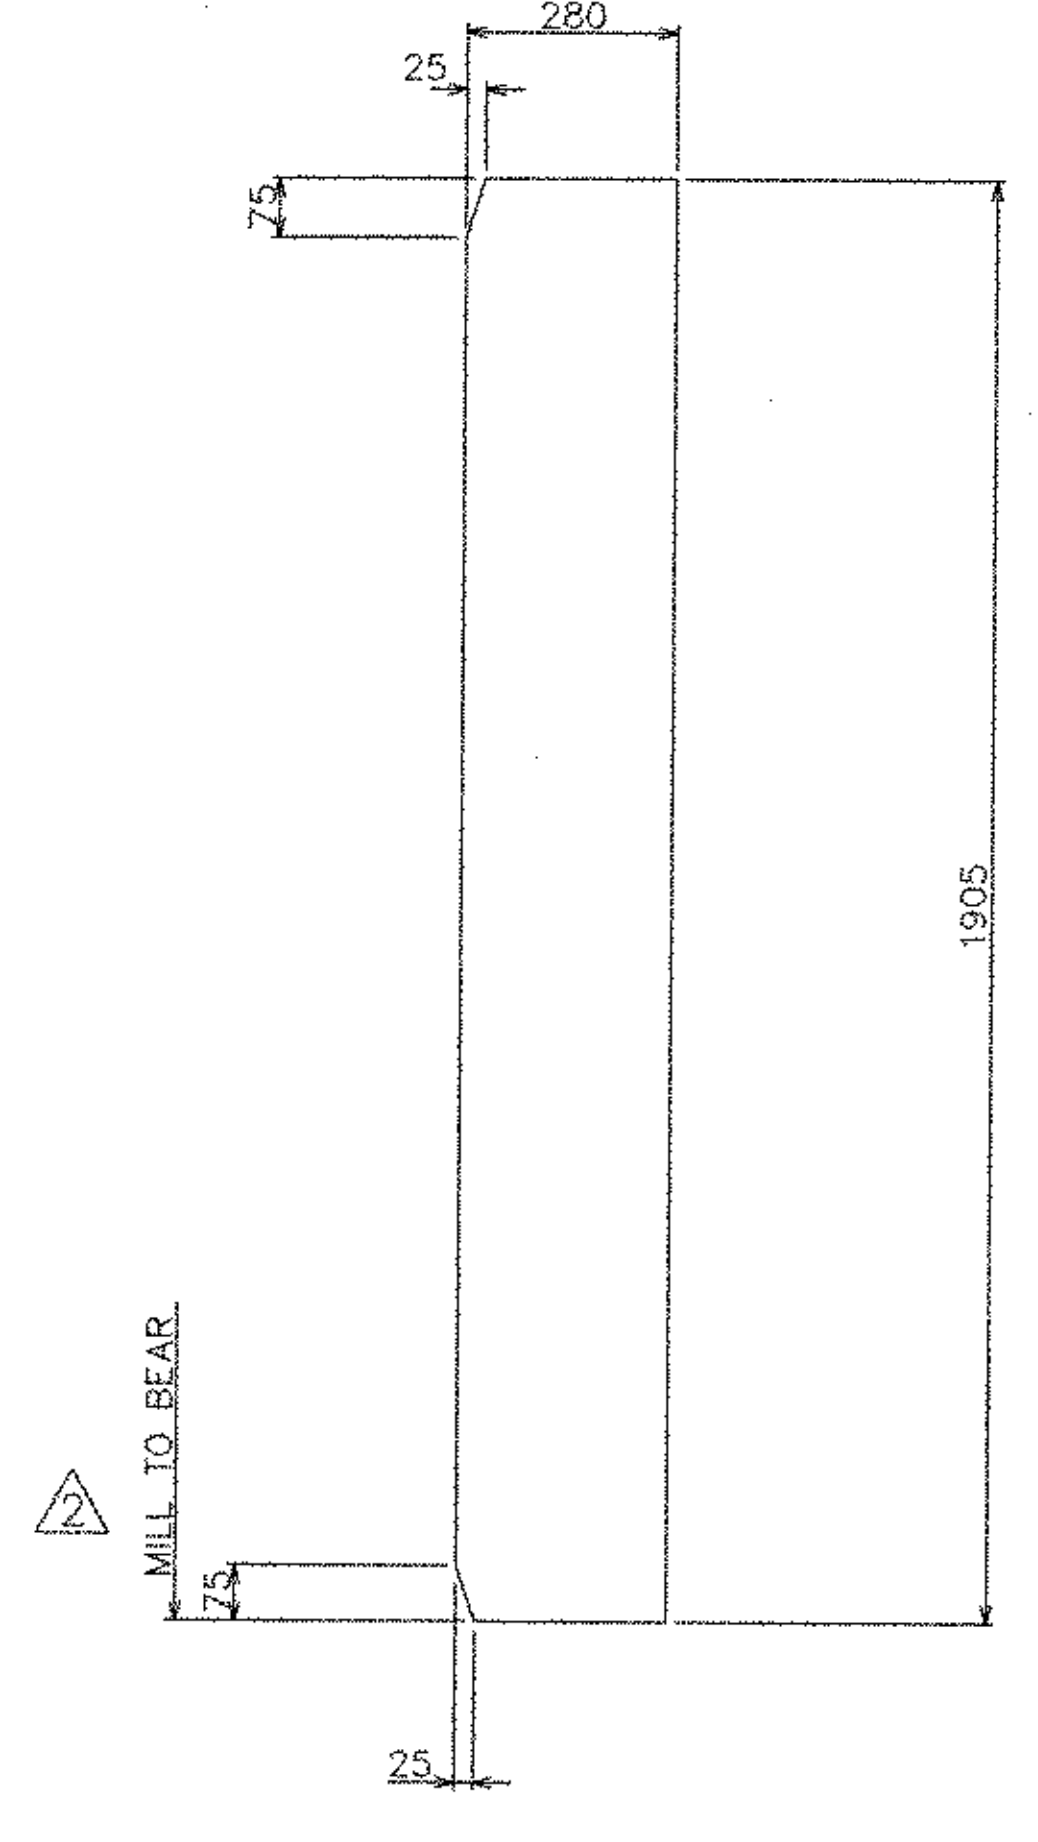


ITEM x1pb (4 REQ'D)
SCALE 1:10 (PL28x280 x 1905)

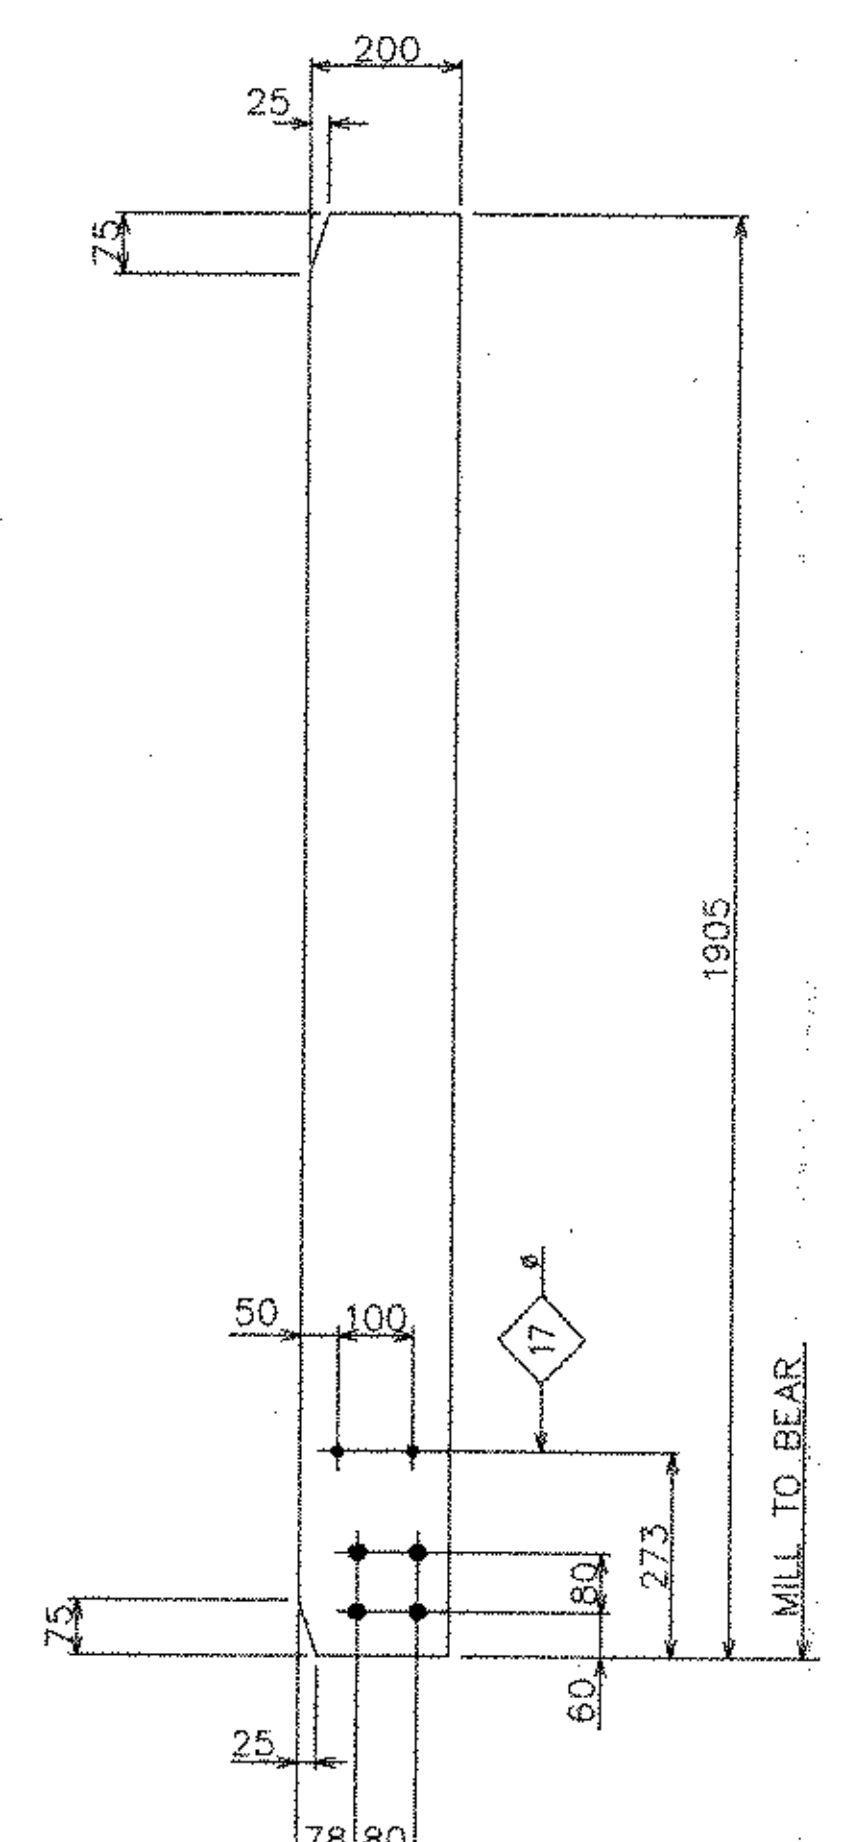


ITEM x1pc (4 REQ'D)
SCALE 1:10 (PL14x200 x 1905)

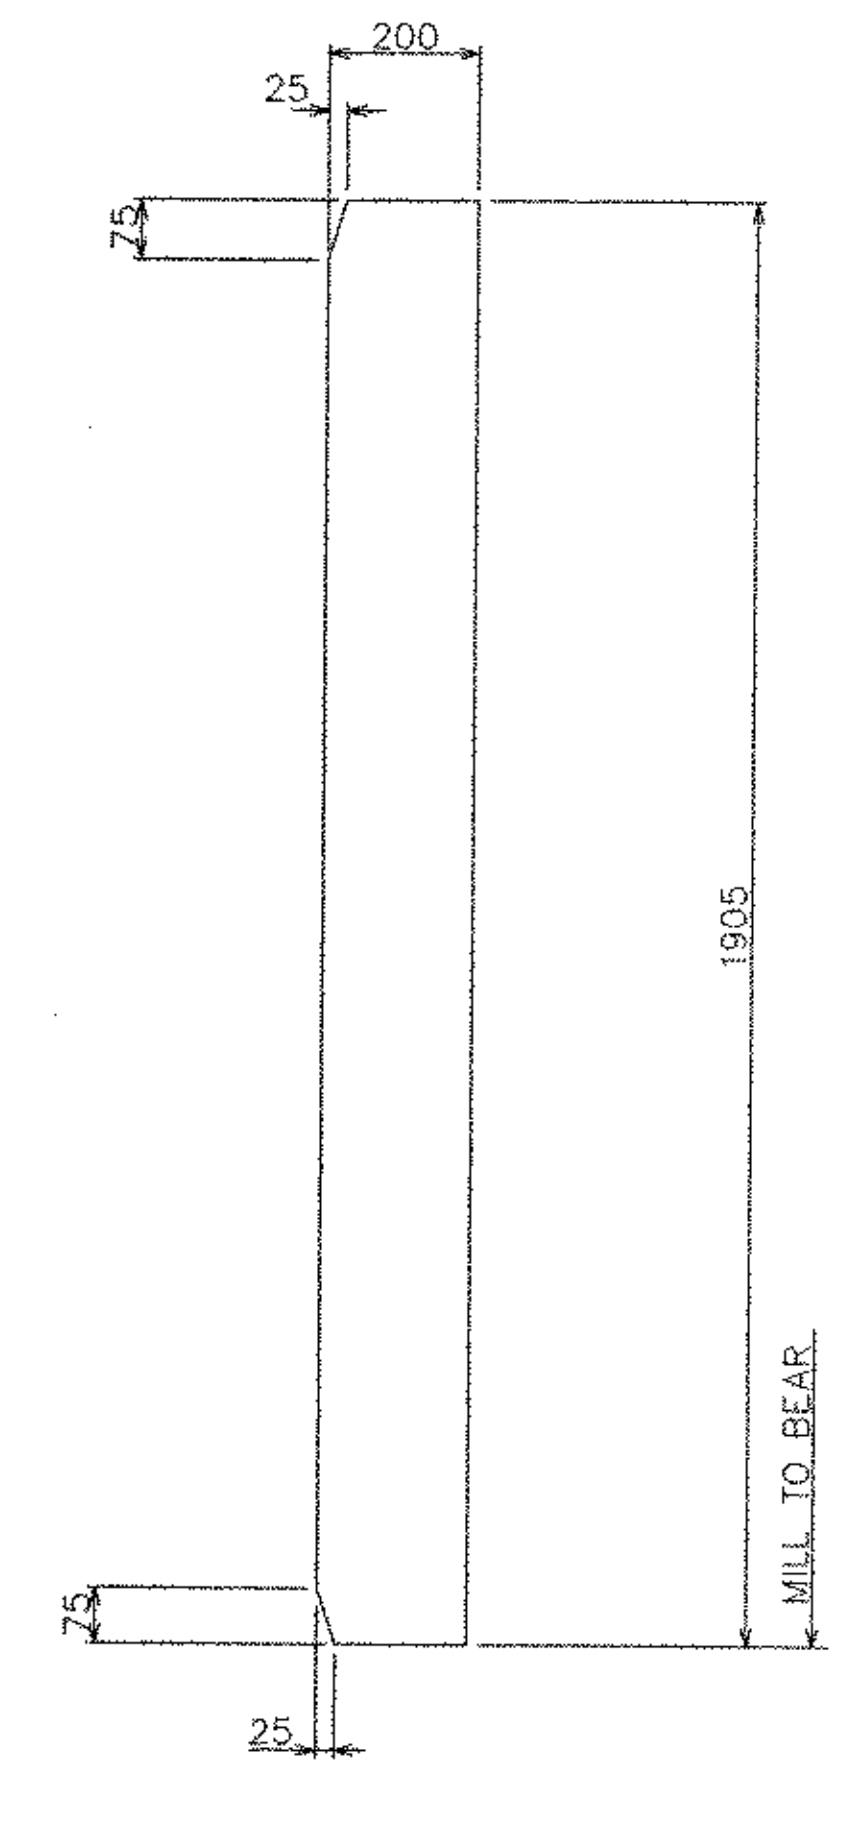


ITEM x1pd (18 REQ'D)
SCALE 1:10 (PL14x200 x 1905)

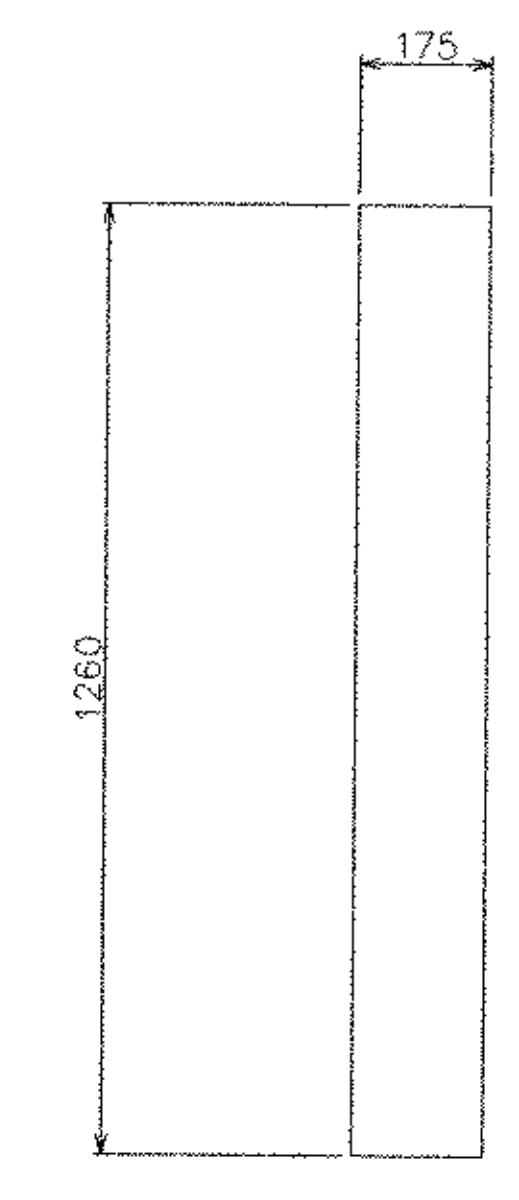


ITEM x1pf (20 REQ'D)
SCALE 1:10 (PL20x175 x 1260)

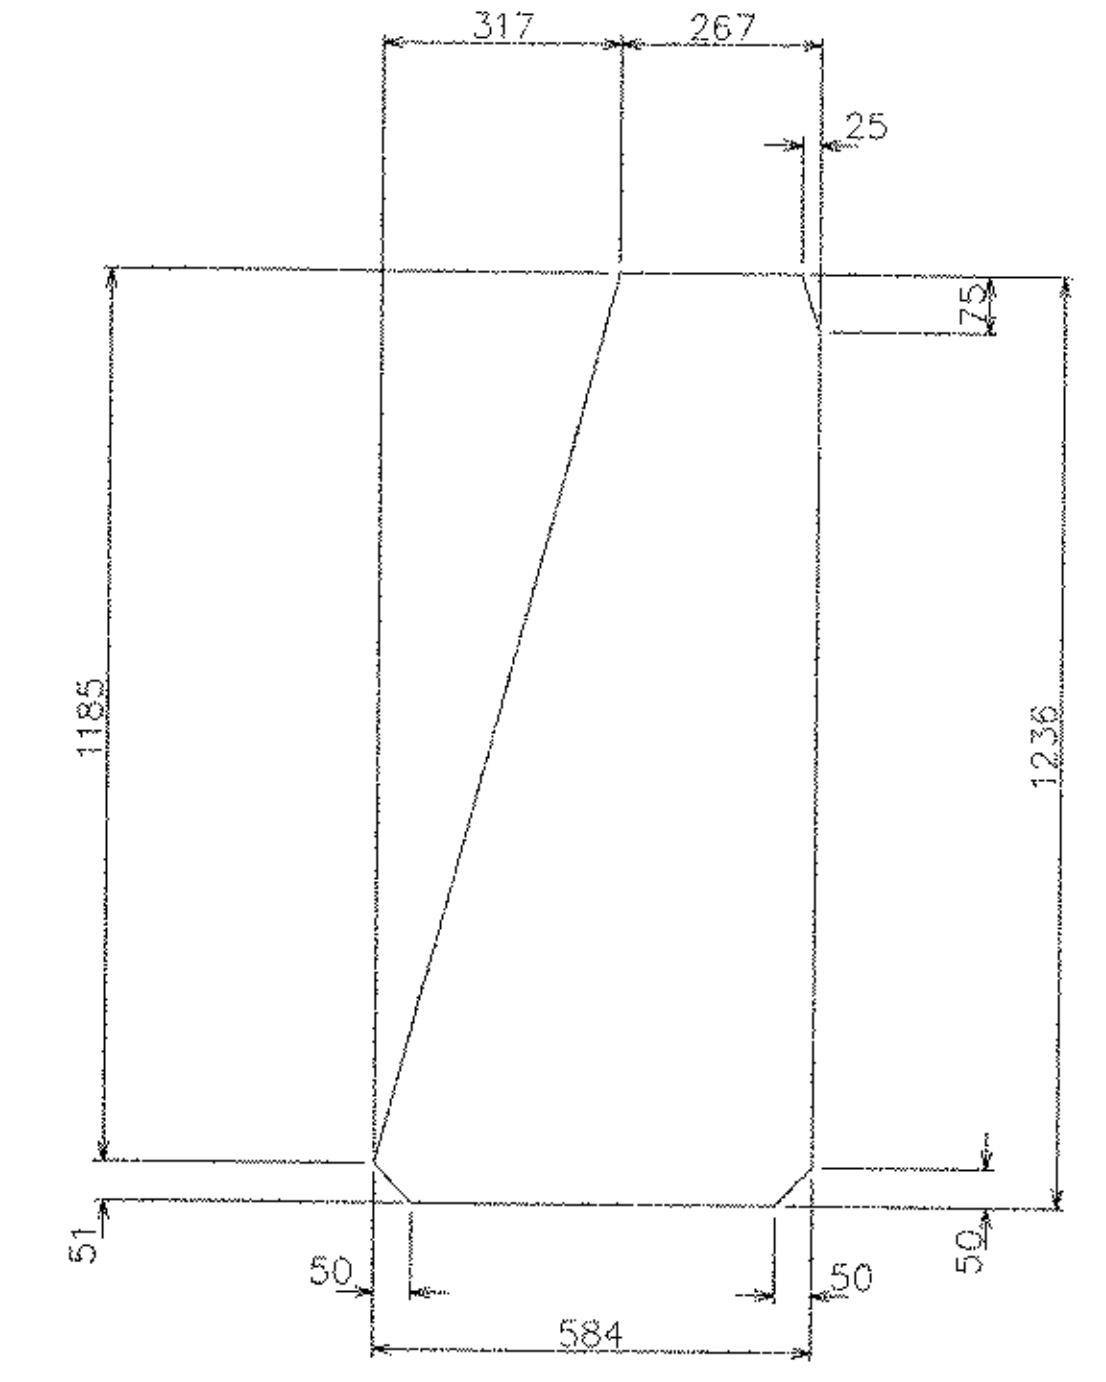


ITEM x1pg (20 REQ'D)
SCALE 1:10 (PL20x584 x 1236)

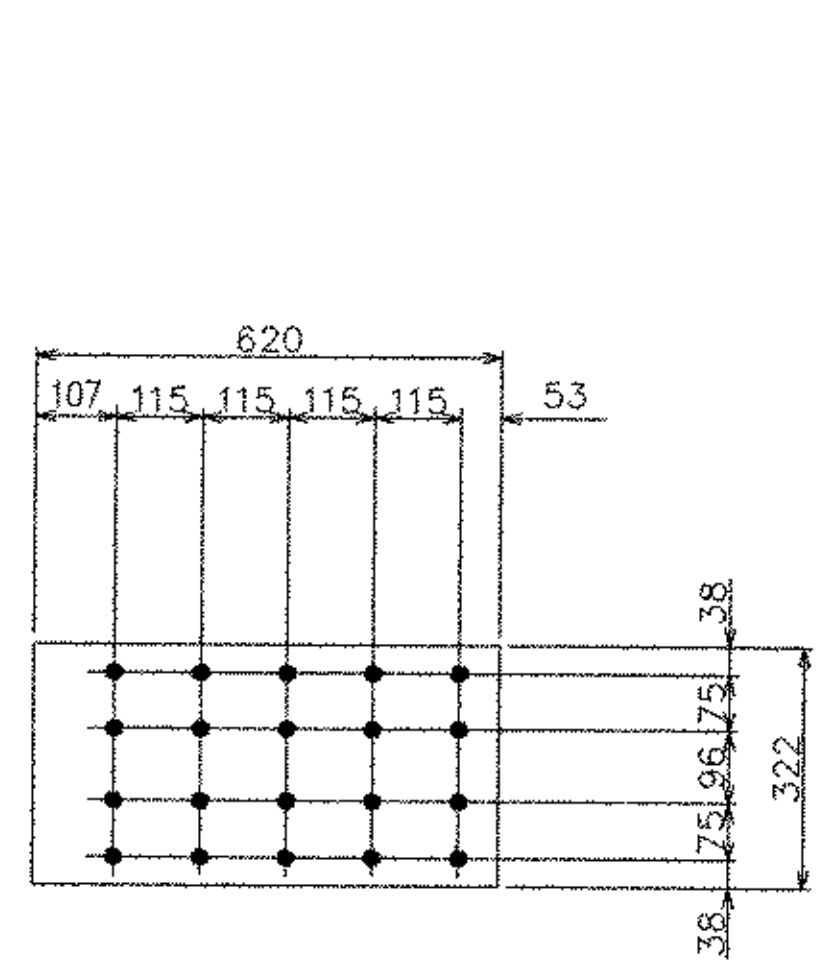


ITEM x1ph (20 REQ'D)
SCALE 1:10 (PL20x322 x 620)

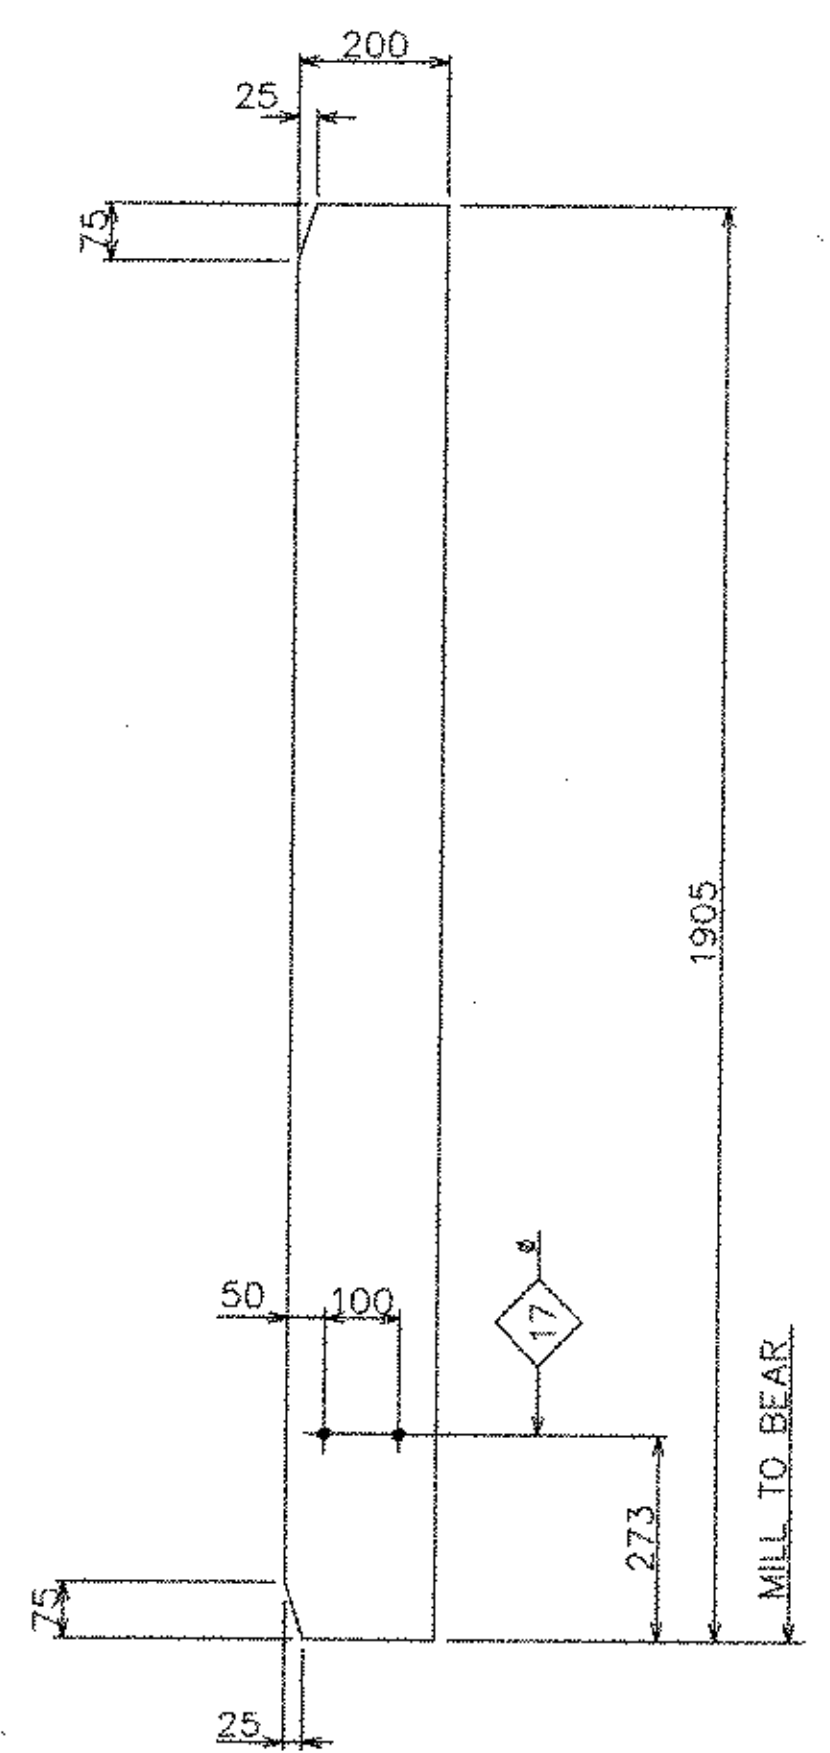

ITEM x1pk (16 REQ'D)
SCALE 1:10 (PL14x200 x 1905)

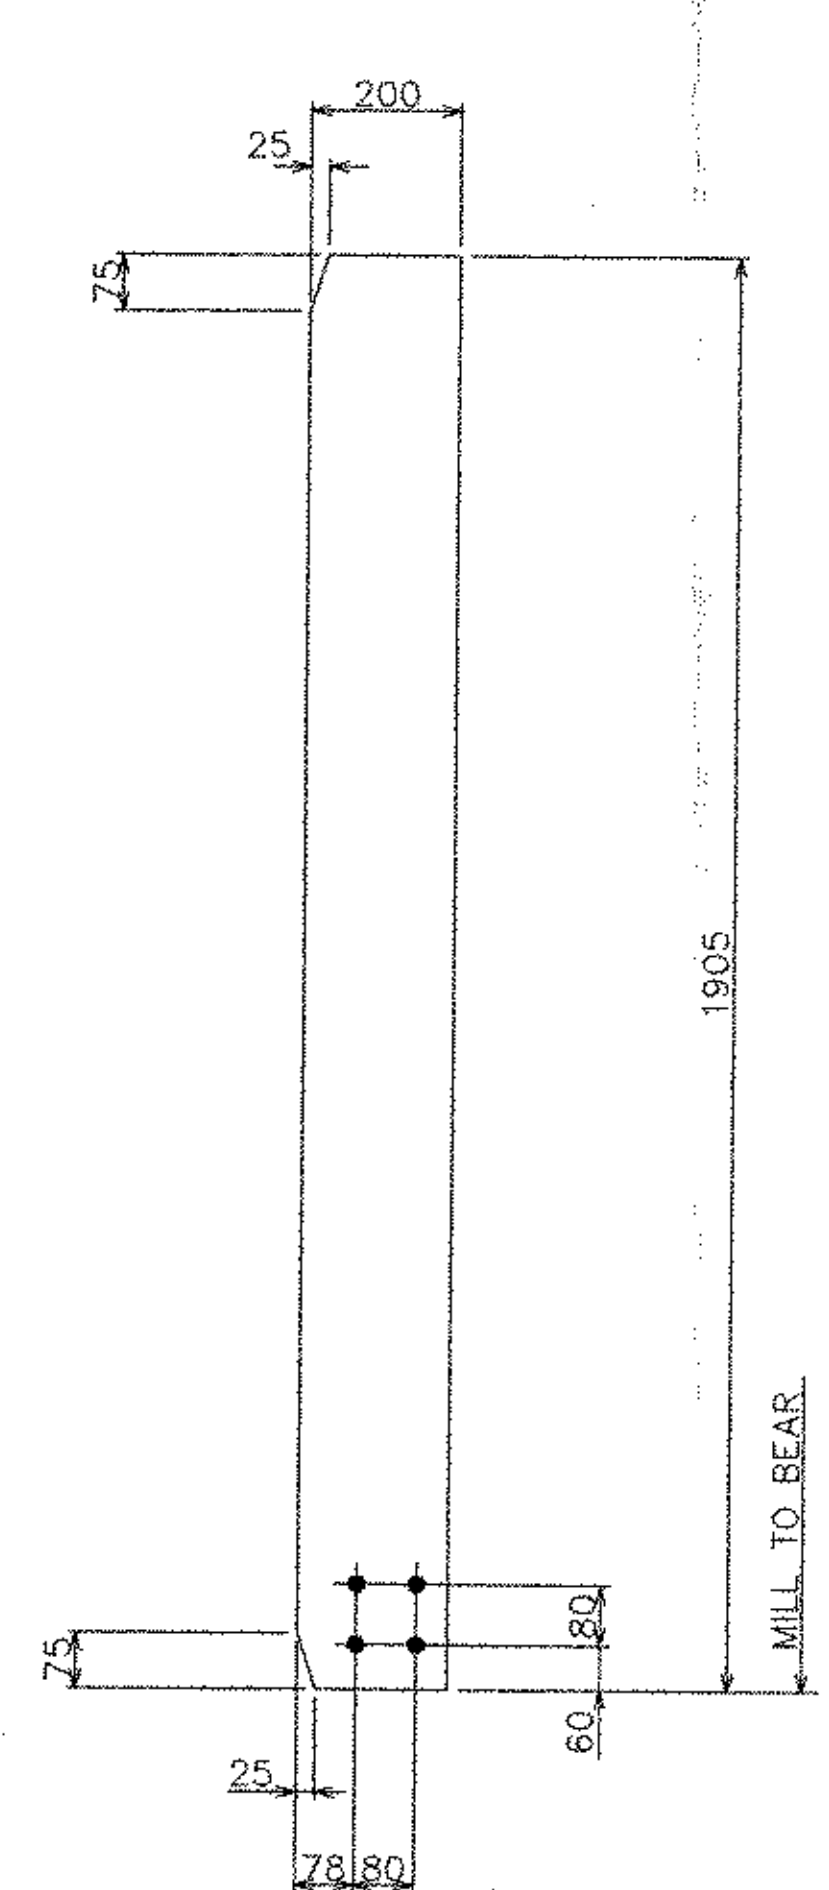


ITEM x1pm (2 REQ'D)
SCALE 1:10 (PL14x200 x 1905)

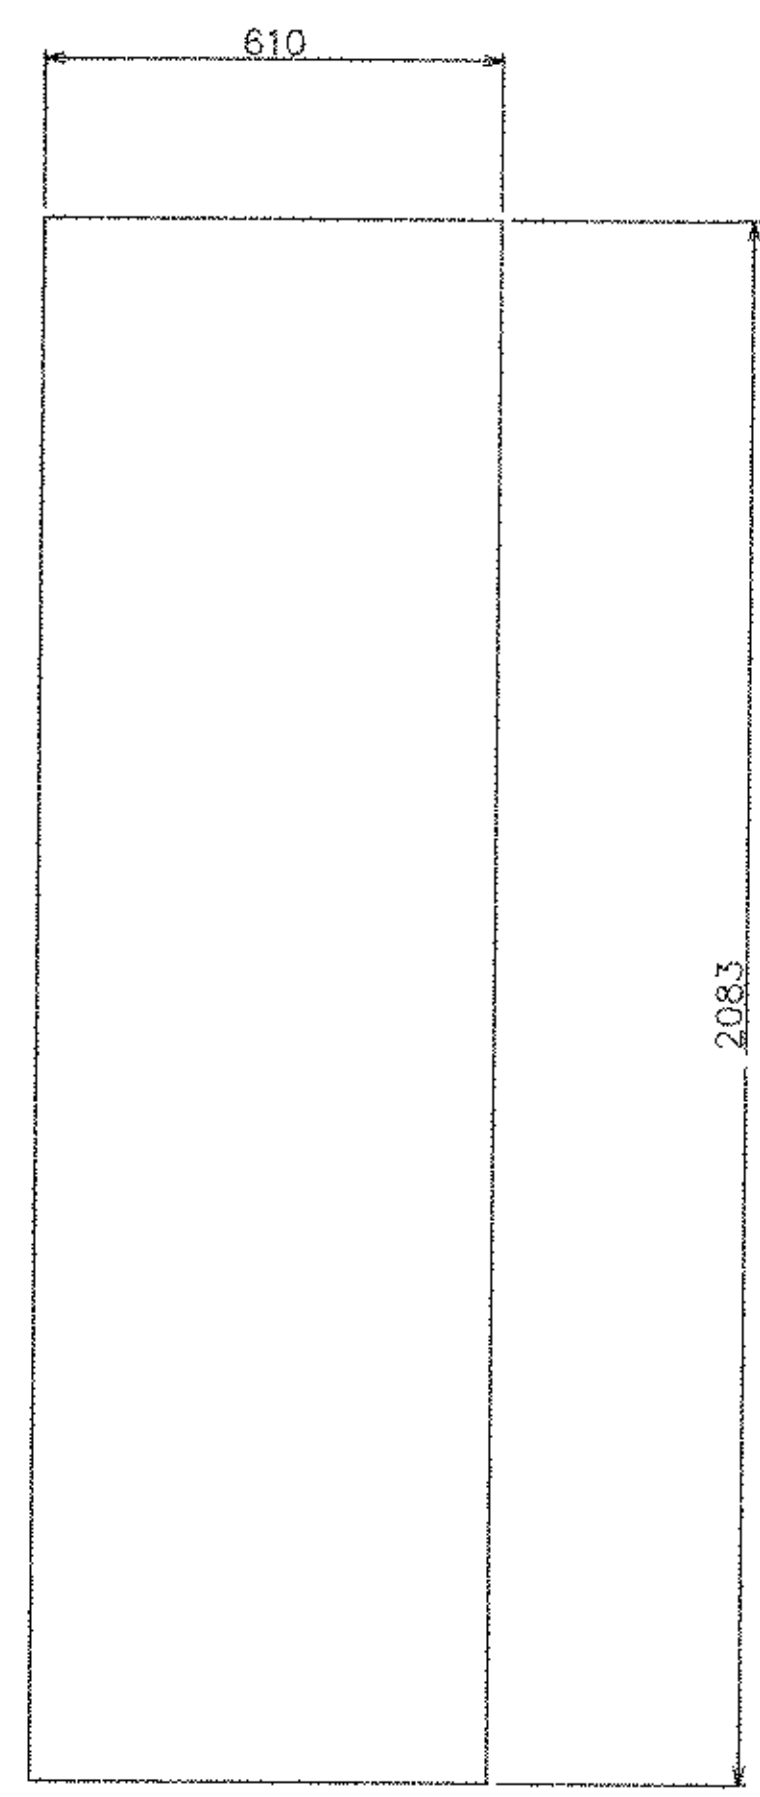

ITEM x1pn (4 REQ'D)
SCALE 1:10 (PL14x610 x 2083)


NOTES:
ALL HOLES 24mm (U.N.O)

STEEL-ART, INCORPORATED
40 WEST MAIN STREET
GALETON, PA 16922
(814) 435-6997

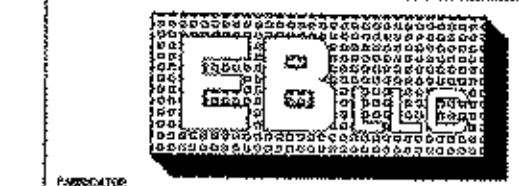


EASTERN BRIDGE LLC
RURAL RTE 2, BOX 302
CLAREMONT, NH 03743
608-542-9202


REVISIONS			STATE OF VERMONT AGENCY OF TRANSPORTATION	
NO.	DATE	DESCRIPTION	CONTRACT	PIN
1	5/14/03	PER APPROVAL	PROPOSED IMPROVEMENT TO RR BRIDGE #62.56	
	6/24/03	PER APPROVAL	OVER VT ROUTE 9 (PRINCIPAL ARTERIAL)	
			WINDHAM COUNTY, TOWN OF BRATTLEBORO	
			TITLE: GIRDER PLATES	
			DRAWN BY: TJS	SHOP ORDER
			3/19/03	4015
			CHKD BY: RGY	BLOCK NO.
			4/9/03	
				DWG. NO. X1
				SHEET NO. 18 / 20

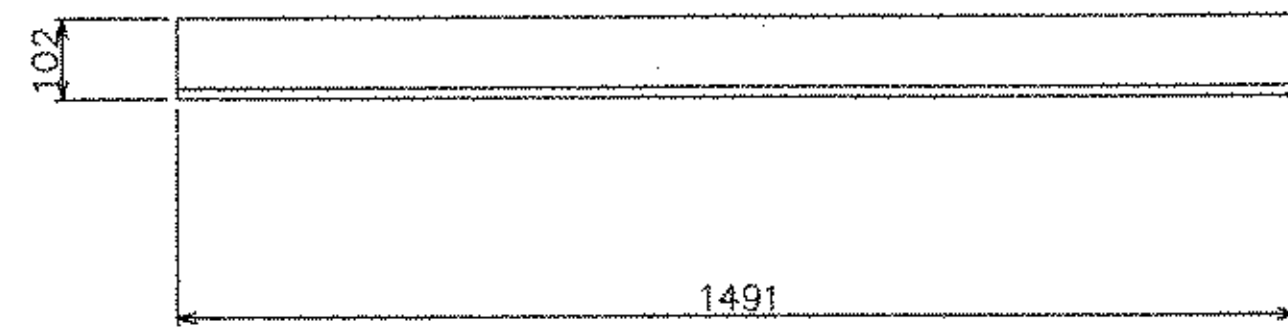


ITEM x2ab (4 REQ'D)
SCALE 1:10 (L102x76x12.7 x 1491)

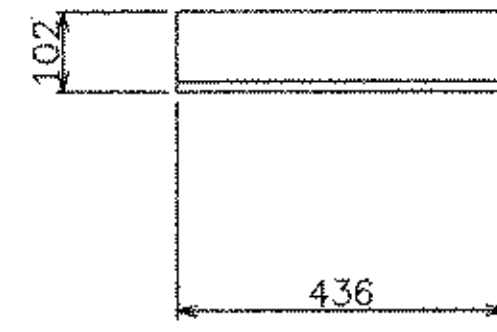


ITEM x2aa (4 REQ'D)
SCALE 1:10 (L102x76x12.7 x 436)

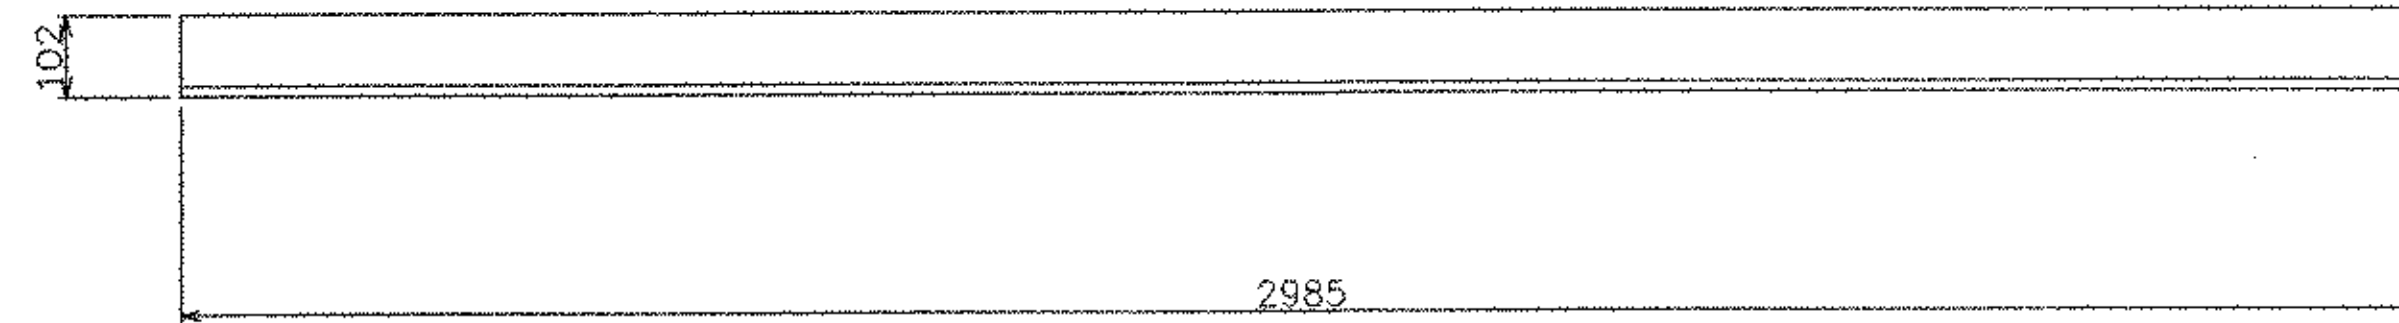

ITEM x2ac (18 REQ'D)
SCALE 1:10 (L102x76x12.7 x 2985)

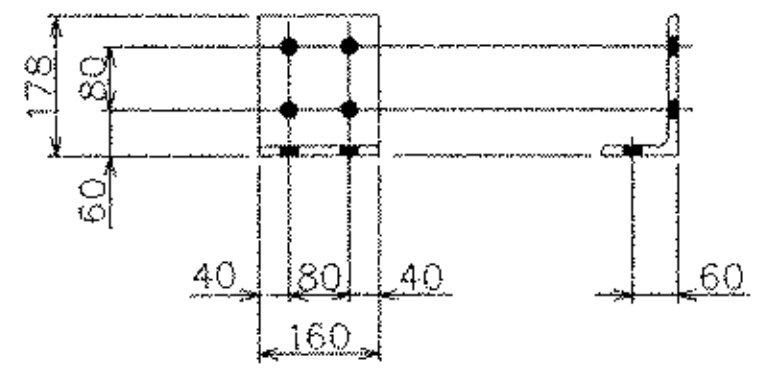


ITEM x2ad (12 REQ'D)
SCALE 1:10 (L178x102 x 12.7)

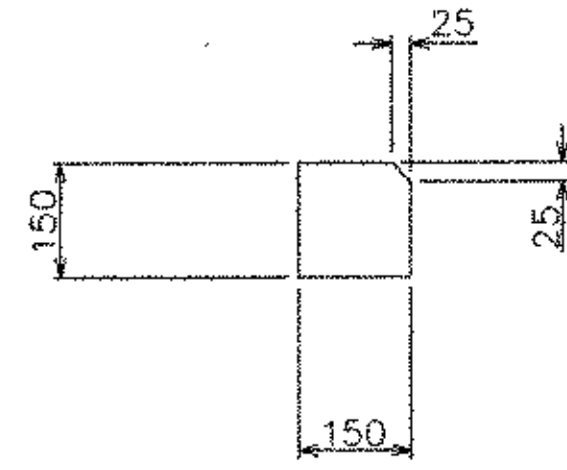


ITEM x2pa (160 REQ'D)
SCALE 1:10 (PL14x150 x 150)

NOTES:
ALL HOLES 24mm (U.N.O)


STEEL-ART, INCORPORATED
40 WEST MAIN STREET
GALETON, PA 16922
(814) 435-6997

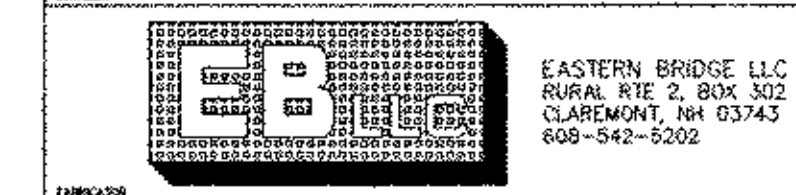


REVISIONS			STATE OF VERMONT AGENCY OF TRANSPORTATION		
NO.	DATE	DESCRIPTION	CONTRACT :	PIN :	
1	8/9/03	APPROVAL	PROPOSED IMPROVEMENT TO RR BRIDGE #62.56 OVER VT ROUTE 9 (PRINCIPAL ARTERIAL) WINDHAM COUNTY, TOWN OF BRATTLEBORO		
			TITLE : GIRDER FITTINGS		
DRAWN BY TJS		SHOP ORDER	DWG. NO.		
3/19/03		4015	X2		
CHK BY RGY		BLOCK NO.	SHEET NO.		
4/9/03			19 / 20		

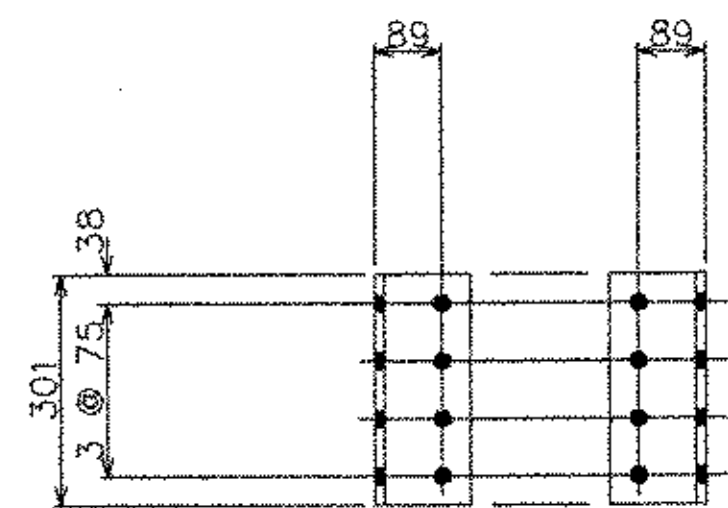


ITEM m1aa (320 REQ'D)
SCALE 1:10 (L127x127x12.7 x 301)

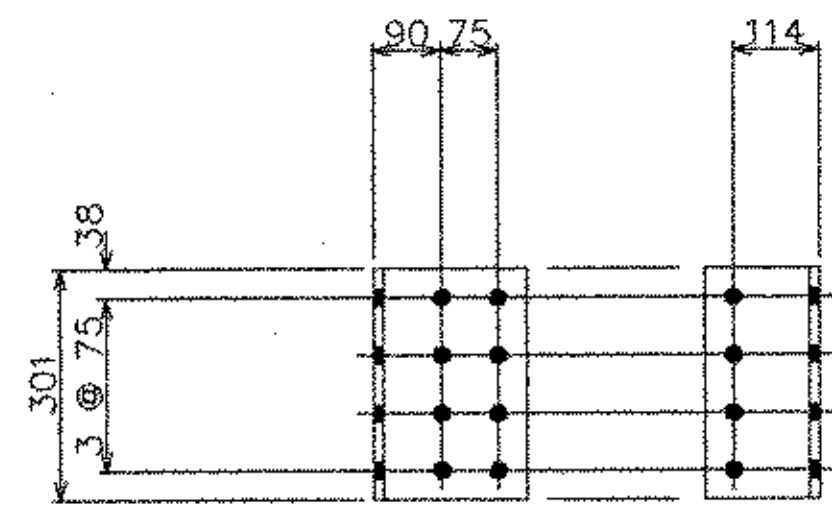


ITEM m1ab (156 REQ'D)
SCALE 1:10 (L203x152x12.7 x 301)

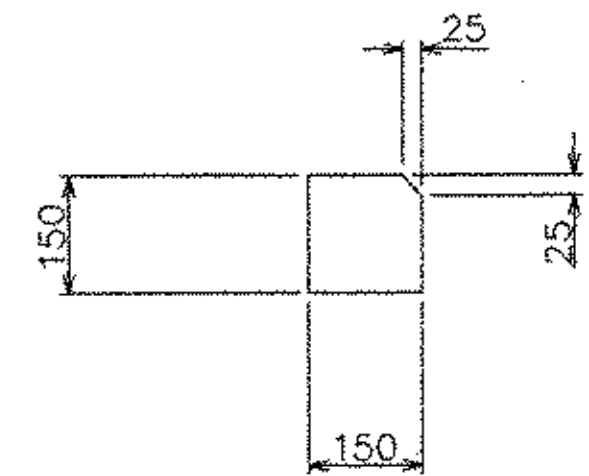

ITEM m1pg (160 REQ'D)
SCALE 1:10 (PL14x150 x 150)

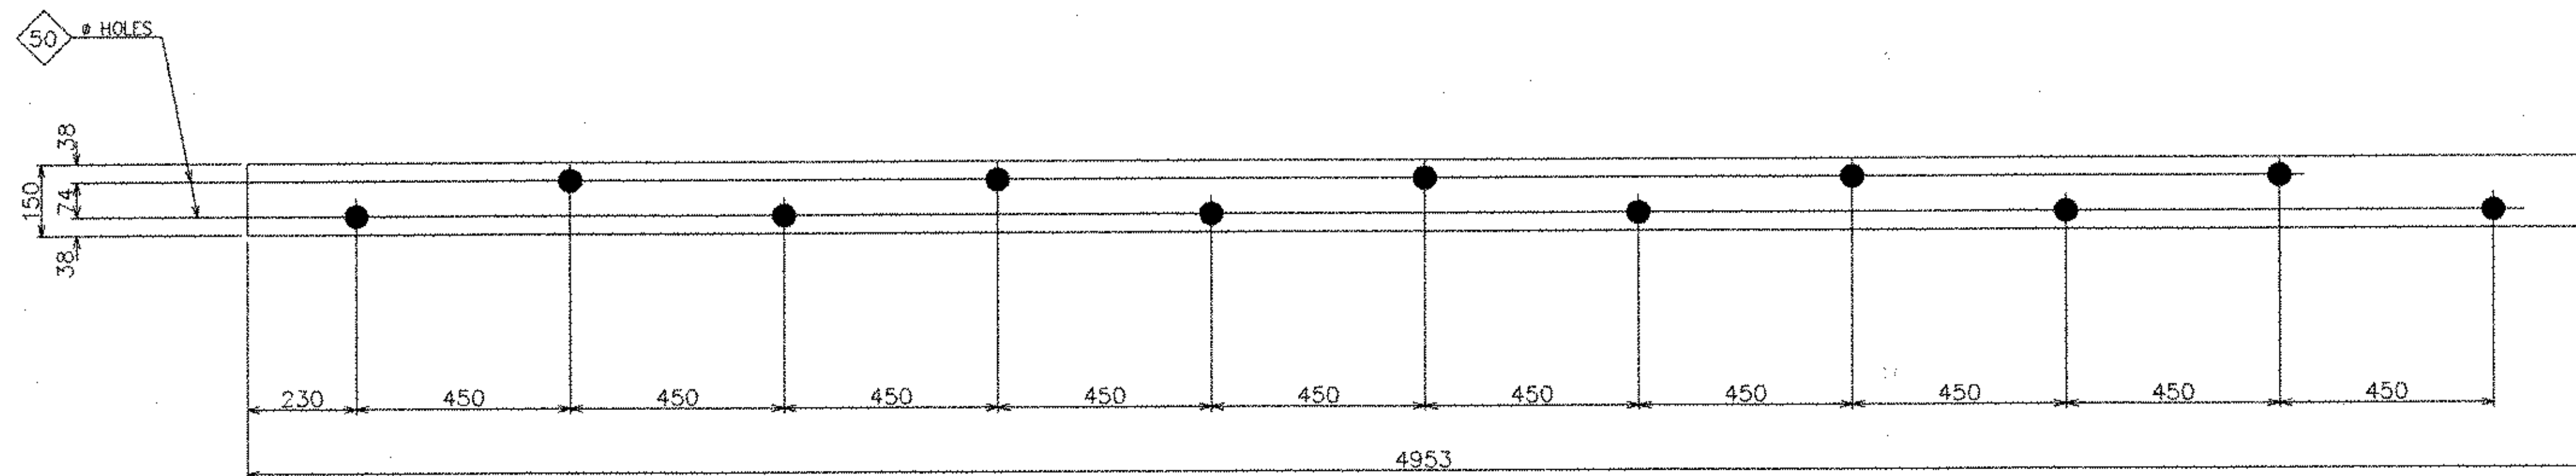

ITEM m1pb (2 REQ'D)
SCALE 1:10 (PL20x150 x 4953)

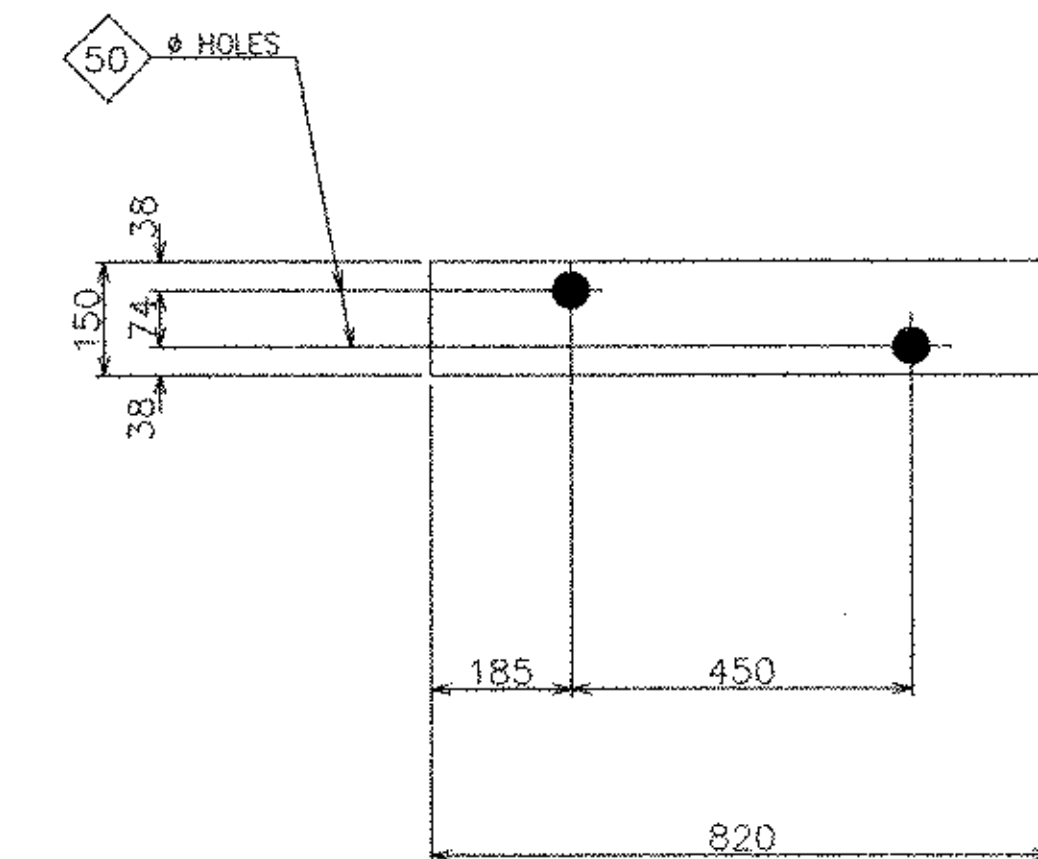

ITEM m1pc (4 REQ'D)
SCALE 1:10 (PL20x150 x 820)


NOTES:
ALL HOLES 24mm (U.N.O.)


STEEL-ART, INCORPORATED
40 WEST MAIN STREET
GALETON, PA 16922
(814) 435-6997





EASTERN BRIDGE LLC
RURAL FIE 2, BOX 302
CLAREMONT, NH 03743
808-242-5202

REVISIONS		STATE OF VERMONT AGENCY OF TRANSPORTATION	
NO.	DATE	DESCRIPTION	
	8/4/03	APPROVAL	
		CONTRACT :	PIN :
		PROPOSED IMPROVEMENT TO RR BRIDGE #62.56 OVER VT ROUTE 9 (PRINCIPAL ARTERIAL) WINDHAM COUNTY, TOWN OF BRATTLEBORO	
		TITLE :	
		MISC. PLATES	
		DRAWN BY TJS	SHOP ORDER
		3/17/03	4015
		CRD BY RGY	BLGCK NO.
		4/09/03	
		DWG. NO.	M1
		SHEET NO.	20 / 20

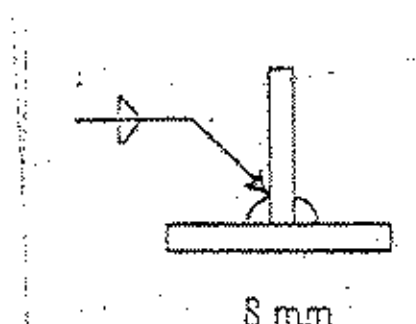
WPS NUMBER:SAW PL#8-1				ISSUE DATE:5/9/03	
PROJECT:VT AOT NO.NH-010-2 (2)				EB JOB NO.:4015	
BASE METAL:ASTM A709 GR36,50,50W					
WELDING PROCESS:SUBMERGED ARC WELDING					
FILLER METAL SPEC.:AWS A5.13 LINCOLN LA75					
FLUX / SHIELDING GAS:LINCOLN 960					
CURRENT AND POLARITY:DCEP				ELEC STICKOUT:1" +/- 1/4"	
WELDING POSITION:2F					
PREHEAT AND INTERPASS TEMP.: AWS D1.5 TABLE 12.4				WPS QUALIFICATION:AWS D1.5 5.13	
HEAT INPUT:50.88 - 73.92 KILOJOULES				SUPPORTING PQR#:SAW A332-3 PL#8	
ELECTRODE SIZE	WELDING AMPS	CURRENT VOLTS	TRAVEL SPEED	JOINT DETAIL AND AWS NUMBER FILLET	
3/32"	398-440	28.8-31.5	11.25-13.5		
NOTES:					
MINIMUM PREHEAT AND INTERPASS TEMPERATURES SHALL BE AS FOLLOWS:					
MAXIMUM INTERPASS TEMPERATURE SHALL BE 450F					
THICKNESS OF THICKEST PART AT POINT OF WELDING		TEMPERATURE, F ASTM A709 STEEL			
UP TO 3/4"		125F			
3/4" TO 1 1/2"		200F			
1 1/2" TO 2 1/2"		300F			
OVER 2 1/2"		350F			
THIS PROCEDURE MAY VARY DUE TO FABRICATION SEQUENCE, FIT UP, PASS SIZE, ETC. WITHIN THE LIMITS PROVIDED IN APPLICABLE AWS CODES AND CONTRACT SPECIFICATIONS.					

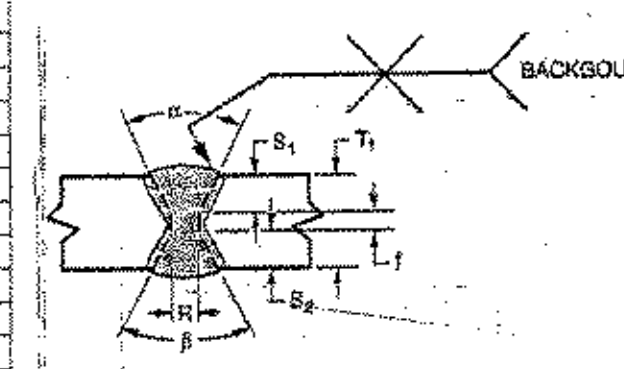WPS NUMBER:SAW PL#8-2				ISSUE DATE:5/9/03	
PROJECT:VT AOT NO.NH-010-2 (2)				EB JOB NO.:4015	
BASE METAL:ASTM A709 GR36,50,50W					
WELDING PROCESS:SUBMERGED ARC WELDING					
FILLER METAL SPEC.:AWS A5.13 LINCOLN LA75					
FLUX / SHIELDING GAS:LINCOLN 960					
CURRENT AND POLARITY:DCEP				ELEC STICKOUT:1" +/- 1/4"	
WELDING POSITION:1G					
PREHEAT AND INTERPASS TEMP.: AWS D1.5 TABLE 12.4				WPS QUALIFICATION:AWS D1.5 5.13	
HEAT INPUT:50.88 - 73.92 KILOJOULES				SUPPORTING PQR#:SAW A332-3 PL#8	
ELECTRODE SIZE	WELDING AMPS	CURRENT VOLTS	TRAVEL SPEED	JOINT DETAIL AND AWS NUMBER: B-U3c-S	
3/32"	398-440	28.8-31.5	11.25-13.5		
NOTES:					
T1 = 102 MM					
R = 0 BACKGOUGE ROOT TO SOUND METAL BEFORE WELDING SECOND SIDE					
F = 6 MM - 12MM					
a-b = 60 degrees					
S1 = 70 MM					
S2 = 28MM					
MINIMUM PREHEAT AND INTERPASS TEMPERATURES SHALL BE AS FOLLOWS:					
MAXIMUM INTERPASS TEMPERATURE SHALL BE 450F					
THICKNESS OF THICKEST PART AT POINT OF WELDING		TEMPERATURE, F ASTM A709 STEEL			
UP TO 3/4"		125F			
3/4" TO 1 1/2"		200F			
1 1/2" TO 2 1/2"		300F			
OVER 2 1/2"		350F			
THIS PROCEDURE MAY VARY DUE TO FABRICATION SEQUENCE, FIT UP, PASS SIZE, ETC. WITHIN THE LIMITS PROVIDED IN APPLICABLE AWS CODES AND CONTRACT SPECIFICATIONS.					

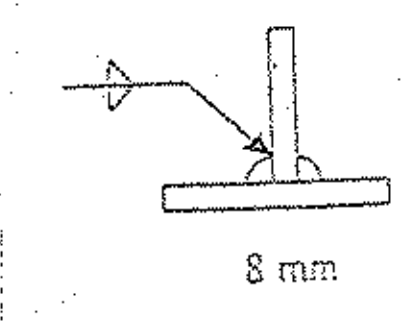
WPS NUMBER:SAW PL#8-3				ISSUE DATE:5/9/03	
PROJECT:VT AOT NO.NH-010-2 (2)				EB JOB NO.:4015	
BASE METAL:ASTM A709 GR36,50,50W					
WELDING PROCESS:SUBMERGED ARC WELDING					
FILLER METAL SPEC.:AWS A5.13 LINCOLN LA75					
FLUX / SHIELDING GAS:LINCOLN 960					
CURRENT AND POLARITY:DCEP				ELEC STICKOUT:1" +/- 1/4"	
WELDING POSITION:2F					
PREHEAT AND INTERPASS TEMP.: AWS D1.5 TABLE 4.4				WPS QUALIFICATION:AWS D1.5 5.13	
HEAT INPUT:50.88 - 73.92 KILOJOULES				SUPPORTING PQR#:SAW A332-3 PL#8	
ELECTRODE SIZE	WELDING AMPS	CURRENT VOLTS	TRAVEL SPEED	JOINT DETAIL AND AWS NUMBER FILLET	
3/32"	398-440	28.8-31.5	11.25-13.5		
NOTES:					
MINIMUM PREHEAT AND INTERPASS TEMPERATURES SHALL BE AS FOLLOWS:					
MAXIMUM INTERPASS TEMPERATURE SHALL BE 450F					
THICKNESS OF THICKEST PART AT POINT OF WELDING		TEMPERATURE, F ASTM A709 STEEL			
UP TO 3/4"		50F			
3/4" TO 1 1/2"		70F			
1 1/2" TO 2 1/2"		150F			
OVER 2 1/2"		225F			
THIS PROCEDURE MAY VARY DUE TO FABRICATION SEQUENCE, FIT UP, PASS SIZE, ETC. WITHIN THE LIMITS PROVIDED IN APPLICABLE AWS CODES AND CONTRACT SPECIFICATIONS.					

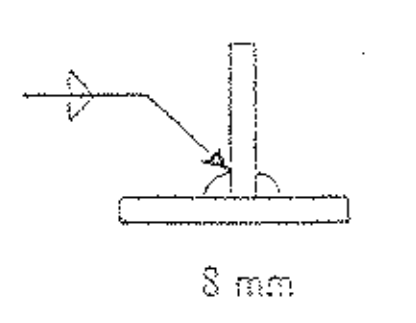WPS NUMBER:FCAW PL#10-1				ISSUE DATE:5-9-03	
PROJECT:VT AOT NO.NH-010-2 (2)				EB JOB NO.:4015	
BASE METAL:ASTM A709 GR36,50,50W					
WELDING PROCESS:FCAW					
FILLER METAL SPEC.:A5.29 ESAB 80-N1 DUAL SHIELD					
FLUX / SHIELDING GAS:75% ARGON / 25% CO2					
CURRENT AND POLARITY:DCEP				ELEC STICKOUT:1" +/- 1/4"	
WELDING POSITION:2F					
PREHEAT AND INTERPASS TEMP.: AWS D1.5 TABLE 4.4				WPS QUALIFICATION:AWS D1.5 5.13	
HEAT INPUT:35 - 44.2 KILOJOULES				SUPPORTING PQR#:FCAW-SA116-1 PL#10	
ELECTRODE SIZE	WELDING AMPS	CURRENT VOLTS	TRAVEL SPEED	JOINT DETAIL AND AWS NUMBER: FILLET	
1/16"	290-320	24-26	11.3-12.0		
NOTES:					
MINIMUM PREHEAT AND INTERPASS TEMPERATURES SHALL BE AS FOLLOWS:					
MAXIMUM INTERPASS TEMPERATURE SHALL BE 450F					
THICKNESS OF THICKEST PART AT POINT OF WELDING		TEMPERATURE, F ASTM A709 STEEL			
UP TO 3/4"		50F			
3/4" TO 1 1/2"		70F			
1 1/2" TO 2 1/2"		150F			
OVER 2 1/2"		225F			
THIS PROCEDURE MAY VARY DUE TO FABRICATION SEQUENCE, FIT UP, PASS SIZE, ETC. WITHIN THE LIMITS PROVIDED IN APPLICABLE AWS CODES AND CONTRACT DOCUMENTS.					


EASTERN BRIDGE, LLC
WELDING PROCEDURE SPECIFICATION
FCM WELDS

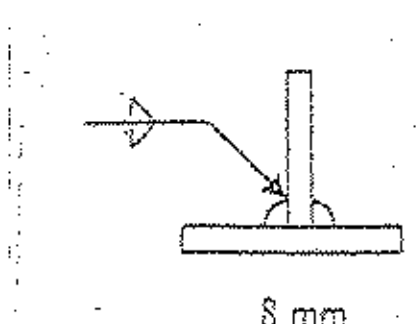WPS NUMBER:SAW PL#11-1				ISSUE DATE: 5-9-03	
PROJECT: VT AOT NO. NH-010-2 (2)				EB JOB NO.: 4015	
BASE METAL:ASTM A709 GR36,50,50W					
WELDING PROCESS:SUBMERGED ARC WELDING					
FILLER METAL SPEC.:AWS A5.23 LINCOLN LA75					
FLUX / SHIELDING GAS:LINCOLN 960					
CURRENT AND POLARITY:DCEP				ELEC STICKOUT:1" +/- 1/4"	
WELDING POSITION:2F					
PREHEAT AND INTERPASS TEMP.:AWS D1.5 TABLE 12.4				WPS QUALIFICATION:AWS D1.5 5.13	
HEAT INPUT:50.5 - 73.2 KILOJOULES				SUPPORTING PQR#:SAW LA75H-3 PL#11	
ELECTRODE SIZE	WELDING AMPS	CURRENT VOLTS	TRAVEL SPEED	JOINT DETAIL AND AWS NUMBER FILLET	
3/32"	550-610	37-40	20-24.2		
NOTES:					
MINIMUM PREHEAT AND INTERPASS TEMPERATURES SHALL BE AS FOLLOWS:					
MAXIMUM INTERPASS TEMPERATURE SHALL BE 450F					
THICKNESS OF THICKEST PART AT POINT OF WELDING		TEMPERATURE, F ASTM A709 STEEL			
UP TO 3/4"		125F			
3/4" TO 1 1/2"		200F			
1 1/2" TO 2 1/2"		300F			
OVER 2 1/2"		350F			
THIS PROCEDURE MAY VARY DUE TO FABRICATION SEQUENCE, FIT UP, PASS SIZE, ETC. WITHIN THE LIMITS PROVIDED IN APPLICABLE AWS CODES AND CONTRACT SPECIFICATIONS.					


EASTERN BRIDGE, LLC
WELDING PROCEDURE SPECIFICATION

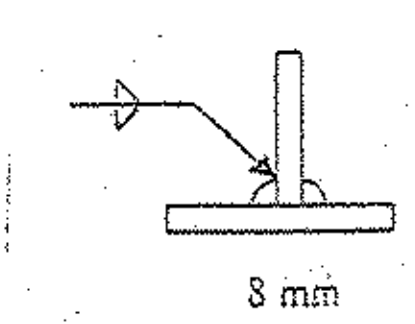WPS NUMBER:SAW PL#00-02				ISSUE DATE:5/9/03	
PROJECT:VT AOT NO.NH-010-2 (2)				EB JOB NO.:4015	
BASE METAL:A709 GR36,50,50W					
WELDING PROCESS:SAW					
FILLER METAL SPEC.:A5.1 E7018					
FLUX / SHIELDING GAS:N/A					
CURRENT AND POLARITY:DCEP				ELEC STICKOUT:N/A	
WELDING POSITION:2F					
PREHEAT AND INTERPASS TEMP.:AWS D1.5 TABLE 4.4				WPS QUALIFICATION:PREQUALIFIED	
HEAT INPUT:38 - 130 KILOJOULES				SUPPORTING PQR#:N/A	
ELECTRODE SIZE	WELDING AMPS	CURRENT VOLTS	TRAVEL SPEED	JOINT DETAIL AND AWS NUMBER:FILLET 2F	
1/8"	125-150	23-26	3-4.5 IPM		
5/32"	140-190	23-26	3-4.5 IPM		
3/16"	180-250	23-26	3-4.5 IPM		
NOTES:					
SINGLE PASS FILLET WELDS					
MINIMUM PREHEAT AND INTERPASS TEMPERATURES SHALL BE AS FOLLOWS:					
MAXIMUM INTERPASS TEMPERATURE SHALL BE 450F					
THICKNESS OF THICKEST PART AT POINT OF WELDING		TEMPERATURE, F ASTM A709 STEEL			
UP TO 3/4"		50F			
3/4" TO 1 1/2"		70F			
1 1/2" TO 2 1/2"		150F			
OVER 2 1/2"		225F			
THIS PROCEDURE MAY VARY DUE TO FABRICATION SEQUENCE, FIT UP, PASS SIZE, ETC. WITHIN THE LIMITS PROVIDED IN APPLICABLE AWS CODES AND CONTRACT DOCUMENTS.					

EASTERN BRIDGE, LLC
WELDING PROCEDURE SPECIFICATION
FCM WELDS

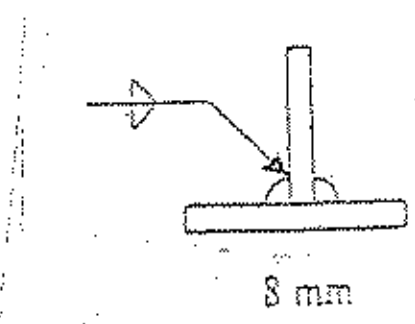WPS NUMBER:SAW PL#00-03				ISSUE DATE:5/9/03	
PROJECT:VT AOT NO.NH-010-2 (2)				EB JOB NO.:4015	
BASE METAL:A709 GR36,50,50W					
WELDING PROCESS:SAW					
FILLER METAL SPEC.:A5.5 E8018 C3					
FLUX / SHIELDING GAS:N/A					
CURRENT AND POLARITY:DCEP				ELEC STICKOUT:N/A	
WELDING POSITION:2F					
PREHEAT AND INTERPASS TEMP.:AWS D1.5 TABLE 12.4				WPS QUALIFICATION:PREQUALIFIED	
HEAT INPUT:38 - 130 KILOJOULES				SUPPORTING PQR#:N/A	
ELECTRODE SIZE	WELDING AMPS	CURRENT VOLTS	TRAVEL SPEED	JOINT DETAIL AND AWS NUMBER:FILLET 2F	
1/8"	125-150	23-26	3-4.5 IPM		
5/32"	140-190	23-26	3-4.5 IPM		
3/16"	180-250	23-26	3-4.5 IPM		
NOTES:					
MINIMUM PREHEAT AND INTERPASS TEMPERATURES SHALL BE AS FOLLOWS:					
MAXIMUM INTERPASS TEMPERATURE SHALL BE 450F					
THICKNESS OF THICKEST PART AT POINT OF WELDING		TEMPERATURE, F ASTM A709 STEEL			
UP TO 3/4"		125F			
3/4" TO 1 1/2"		200F			
1 1/2" TO 2 1/2"		300F			
OVER 2 1/2"		350F			
THIS PROCEDURE MAY VARY DUE TO FABRICATION SEQUENCE, FIT UP, PASS SIZE, ETC. WITHIN THE LIMITS PROVIDED IN APPLICABLE AWS CODES AND CONTRACT DOCUMENTS.					

EASTERN BRIDGE, LLC
WELDING PROCEDURE SPECIFICATION

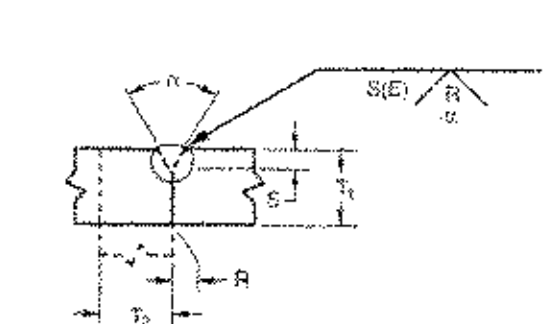WPS NUMBER:SAW PL#00-12				ISSUE DATE:6/29/03	
PROJECT:VT AOT NO.NH-010-2 (2)				EB JOB NO.:4015	
BASE METAL:A709 GR36,50,50W					
WELDING PROCESS:SAW					
FILLER METAL SPEC.:A5.1 E7018					
FLUX / SHIELDING GAS:N/A					
CURRENT AND POLARITY:DCEP				ELEC STICKOUT:N/A	
WELDING POSITION:1G					
PREHEAT AND INTERPASS TEMP.:AWS D1.5 TABLE 4.4				WPS QUALIFICATION:PREQUALIFIED	
HEAT INPUT:38 - 130 KILOJOULES				SUPPORTING PQR#:N/A	
ELECTRODE SIZE	WELDING AMPS	CURRENT VOLTS	TRAVEL SPEED	JOINT DETAIL AND AWS NUMBER:C-P2	
1/8"	125-150	23-26	3-4.5 IPM		
5/32"	140-190	23-26	3-4.5 IPM		
3/16"	180-250	23-26	3-4.5 IPM		
NOTES:					
T1=1/2"					
T2=1/2"					
R=0					
a-b=1/4"					
a=60 Degrees					
MINIMUM PREHEAT AND INTERPASS TEMPERATURES SHALL BE AS FOLLOWS:					
MAXIMUM INTERPASS TEMPERATURE SHALL BE 450F					
THICKNESS OF THICKEST PART AT POINT OF WELDING		TEMPERATURE, F ASTM A709 STEEL			
UP TO 3/4"		50F			
3/4" TO 1 1/2"		70F			
1 1/2" TO 2 1/2"		150F			
OVER 2 1/2"		225F			
THIS PROCEDURE MAY VARY DUE TO FABRICATION SEQUENCE, FIT UP, PASS SIZE, ETC. WITHIN THE LIMITS PROVIDED IN APPLICABLE AWS CODES AND CONTRACT DOCUMENTS.					


STEEL-ART, INCORPORATED
40 WEST MAIN STREET
GALETON, PA 16922
(814) 435-6997



EASTERN BRIDGE LLC
RURAL RTE 2, BOX 302
CLAREMONT, NH 03743
608-542-5202

REVISIONS			STATE OF VERMONT AGENCY OF TRANSPORTATION	
NO.	DATE	DESCRIPTION	CONTRACT	PH
1	6-24-03	PER APPROVAL	PROPOSED IMPROVEMENT TO RR BRIDGE #6 OVER VT ROUTE 9 (PRINCIPAL ARTERIAL) WINDHAM COUNTY, TOWN OF BRATTLEBORO	
2	8/4/03	Approval		
DRAWN BY: RX			SHOP ORDER: 4015	DWG. NO.: WPS
CHKD BY: JH			BLOCK NO.:	SHEET NO.: WPS1

STATE OF VERMONT AGENCY OF TRANSPORTATION

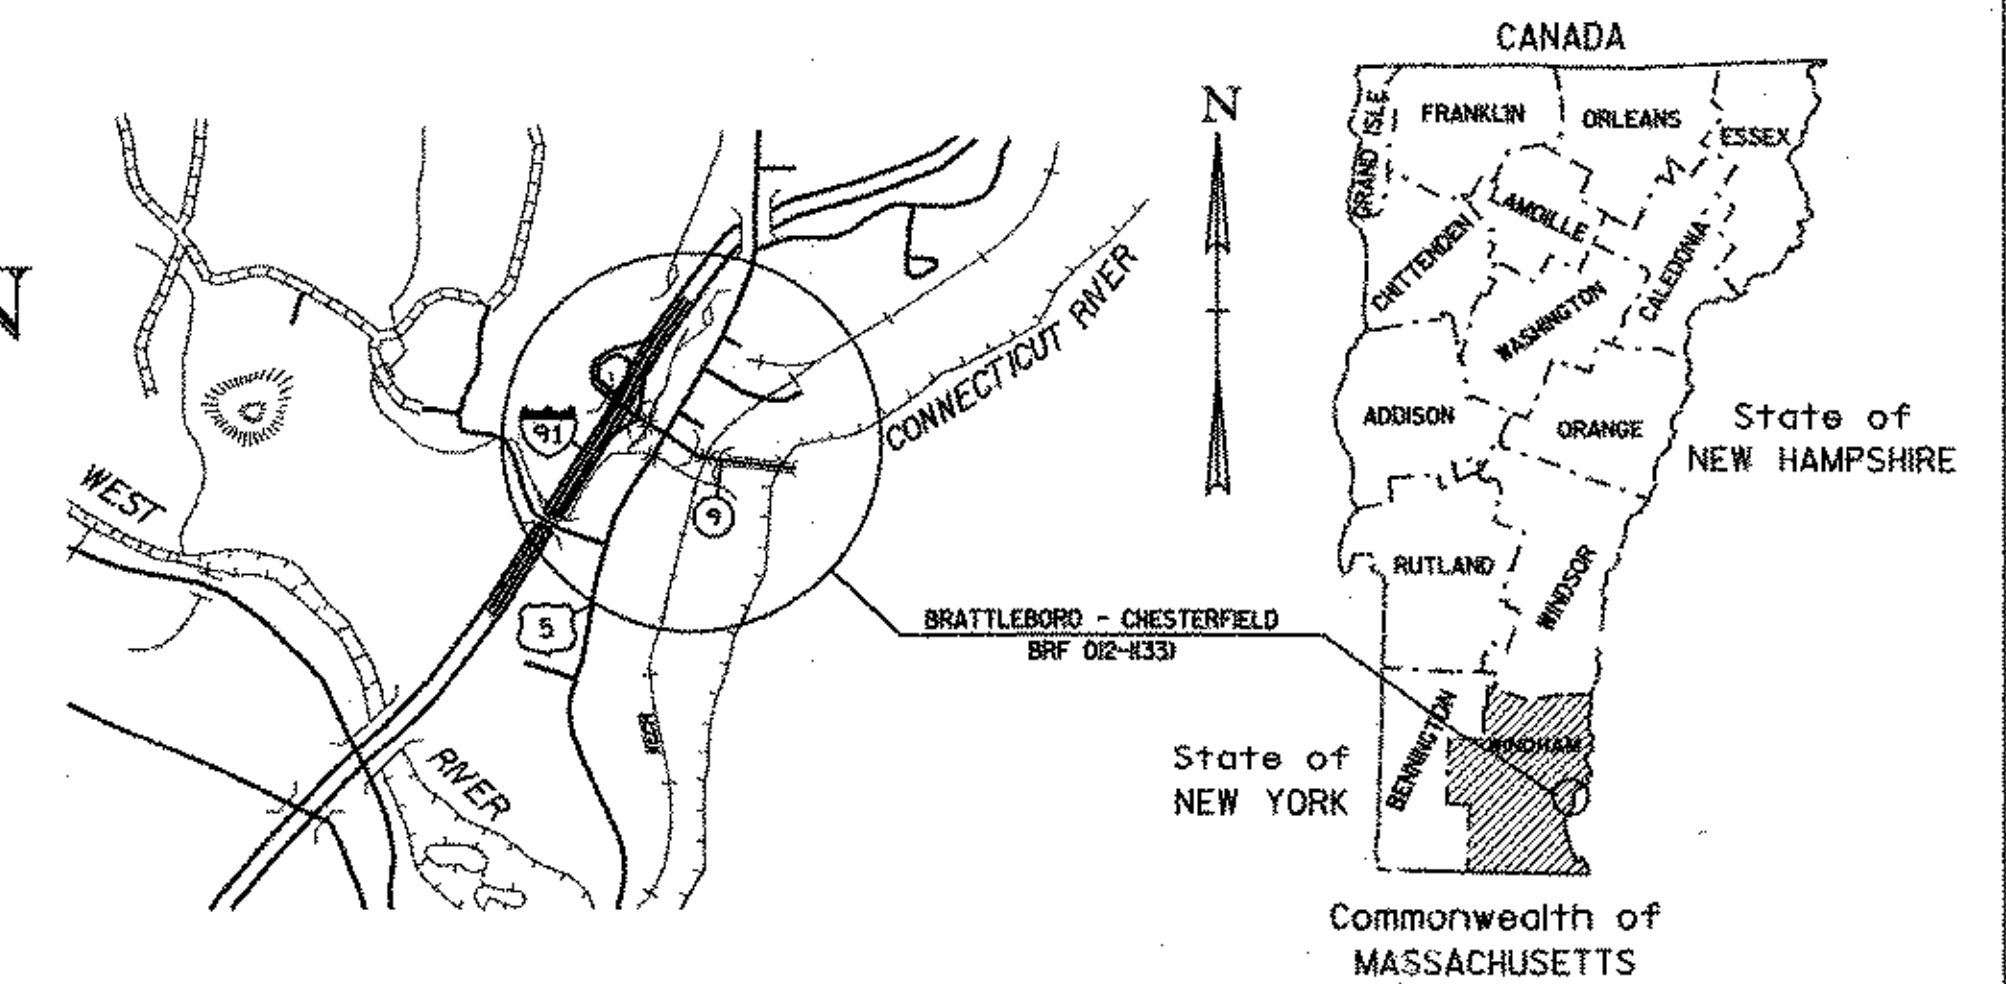

R.O.W. PLANS

PROPOSED IMPROVEMENT TOWN OF BRATTLEBORO COUNTY OF WINDHAM VT ROUTE 9, RR BRIDGE #62.56

BEGINNING AT A POINT IN THE TOWN OF BRATTLEBORO APPROXIMATELY 90 METERS FROM THE INTERSECTION OF VT ROUTES 5 AND 9, EXTENDING EASTERLY ALONG ROUTE 9 TO THE CONNECTICUT RIVER A DISTANCE OF 270 METERS.

- LENGTH OF ROADWAY = 270m
- LENGTH OF RAILWAY = 678.6m
- LENGTH OF VT ROUTE 9 BRIDGE = 32m
- LENGTH OF SARGENT BROOK BRIDGE = 8m
- LENGTH OF R.O.W. PROJECT = 284.3m (932.0 ft)

WORK TO BE PERFORMED UNDER THIS PROJECT CONSISTS OF REALIGNING AND WIDENING ROUTE 9, THE REPLACEMENT OF EXISTING RAILROAD BRIDGE #62.56 OVER VT ROUTE 9, THE WIDENING OF EXISTING RAILROAD BRIDGE # 62.51 OVER SARGENT BROOK, AND THE ASSOCIATED RAILWAY APPROACH WORK.

BEGIN R.O.W. PROJECT
STA. 30+090.0 12.6M (41.5') LT.

BEGIN RAILROAD CONSTRUCTION
RR STA. 50+020.00

END RAILROAD CONSTRUCTION
RR STA. 50+698.603

END R.O.W. PROJECT
NH 203+72.3 39.3M (128.5') RT.

CONVENTIONAL SYMBOLS	
COUNTY LINE	-----
TOWN LINE	-----
LIMITS OF ACCESS	---o---o---o---
POINT OF ACCESS	X
FENCE LINE	X---X---X---X---
STONE WALL	o---o---o---o---
TRAVELED WAY	-----
GUARD RAIL	o---o---o---o---
RAILROAD	=====
SURVEY LINE	-----
CULVERT	-----
POWER POLE	⊕
TELEPHONE POLE	⊕
TREES	* * *
CONTROL OF ACCESS	--- --- --- ---
PROPERTY LINE	-----
R.O.W. LINE	-----
R.O.W. TAKING LINE	-----
SLOPE RIGHTS	o---SR---o---SR---o---SR---
TOP OF CUT	---△---△---△---
TOE OF SLOPE	---o---o---o---

SURVEYED BY :
SURVEYED DATE :
DATUM
VERTICAL
HORIZONTAL

SURVEY INFORMATION OBTAINED BY NHDOT, ELECTRONICALLY TRANSLATED FROM MOSS TO MICROSTATION, AND SUPPLEMENTED BY VTRANS ADDITIONAL SURVEY.

ALL DRIVES AS INDICATED ON PLANS ARE SUBJECT TO PERMITS PURSUANT TO TITLE 19 SECTION III, V.S.A.

LINES SHOWN ON THESE PLANS AS EXISTING PROPERTY LINES (P/L) ARE BELIEVED TO BE ACCURATE BUT SHOULD NOT BE RELIED UPON FOR PURPOSES UNRELATED TO THE STATE OF VERMONT'S ACQUISITION OF LAND AND RIGHTS FOR THIS PROJECT.

THESE PLANS ARE SUBJECT TO SUCH ENGINEERING CHANGES AS MAY BE REQUIRED BY THE FEDERAL HIGHWAY ADMINISTRATION OR THE DIRECTOR OF PROJECT DEVELOPMENT.
CONSTRUCTION IS TO BE CARRIED ON IN ACCORDANCE WITH THESE PLANS AND THE STANDARD SPECIFICATIONS FOR CONSTRUCTION DATED 1995, AS APPROVED BY THE FEDERAL HIGHWAY ADMINISTRATION ON AUGUST 21, 1995 FOR USE ON THIS PROJECT, INCLUDING ALL SUBSEQUENT REVISIONS AND SUCH REVISED SPECIFICATIONS AND SPECIAL PROVISIONS AS ARE INCORPORATED IN THESE PLANS.

GORDON, BUA & READ, INC.
CIVIL, STRUCTURAL & TRANSPORTATION ENGINEERS
34 SALEM STREET
READING, MASSACHUSETTS 01867

FEB 05 2001

Metric

APPROVED *David P. [Signature]* DATE 2/2/01
Director of Project Development

APPROVED *Alan B. [Signature]* DATE 2/2/01
Chief, Right of Way



**BRATTLEBORO
NH BRF 012-1(33)**

R.O.W. SHEET 1 OF 27 SHEETS

TYPICAL ROADWAY SECTIONS

MATERIAL ITEM	THICKNESS TOLERANCE
PAVEMENT (TOTAL DEPTH ALL LAYERS)	+/- 5
SUBBASE	+/- 30
SAND BORROW	+/- 30

50 BITUMINOUS CONCRETE PAVEMENT (TYPE IIS) (PG 58-28)
 75 BITUMINOUS CONCRETE PAVEMENT (TYPE IIS) (PG 58-28)
 150 BITUMINOUS CONCRETE PAVEMENT (TYPE IS) (PG 58-28)
 600 SUBBASE OF DENSE GRADED CRUSHED STONE
 250 SAND BORROW

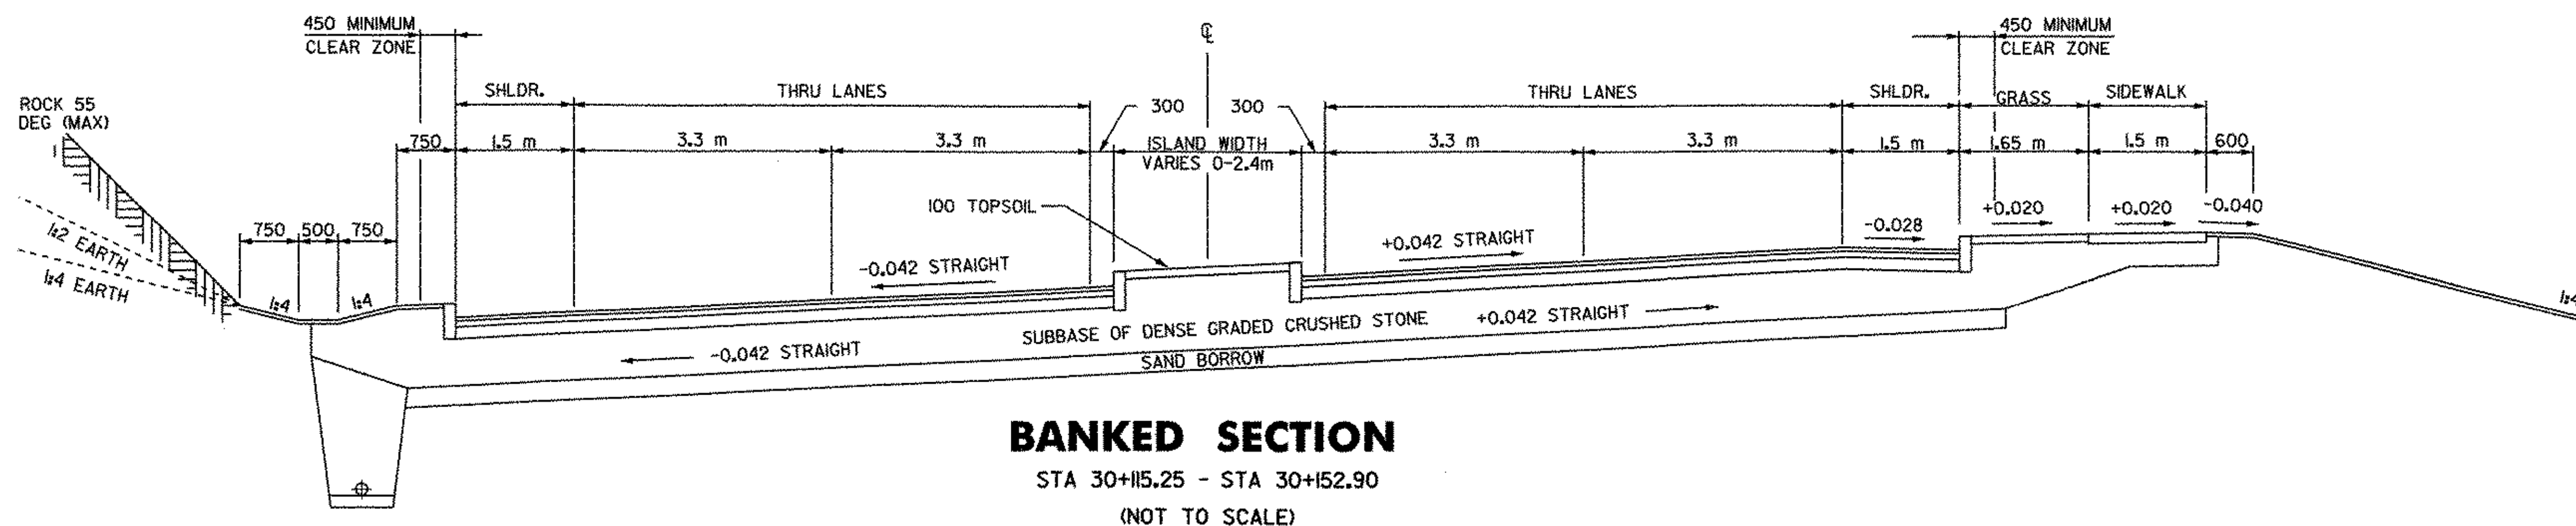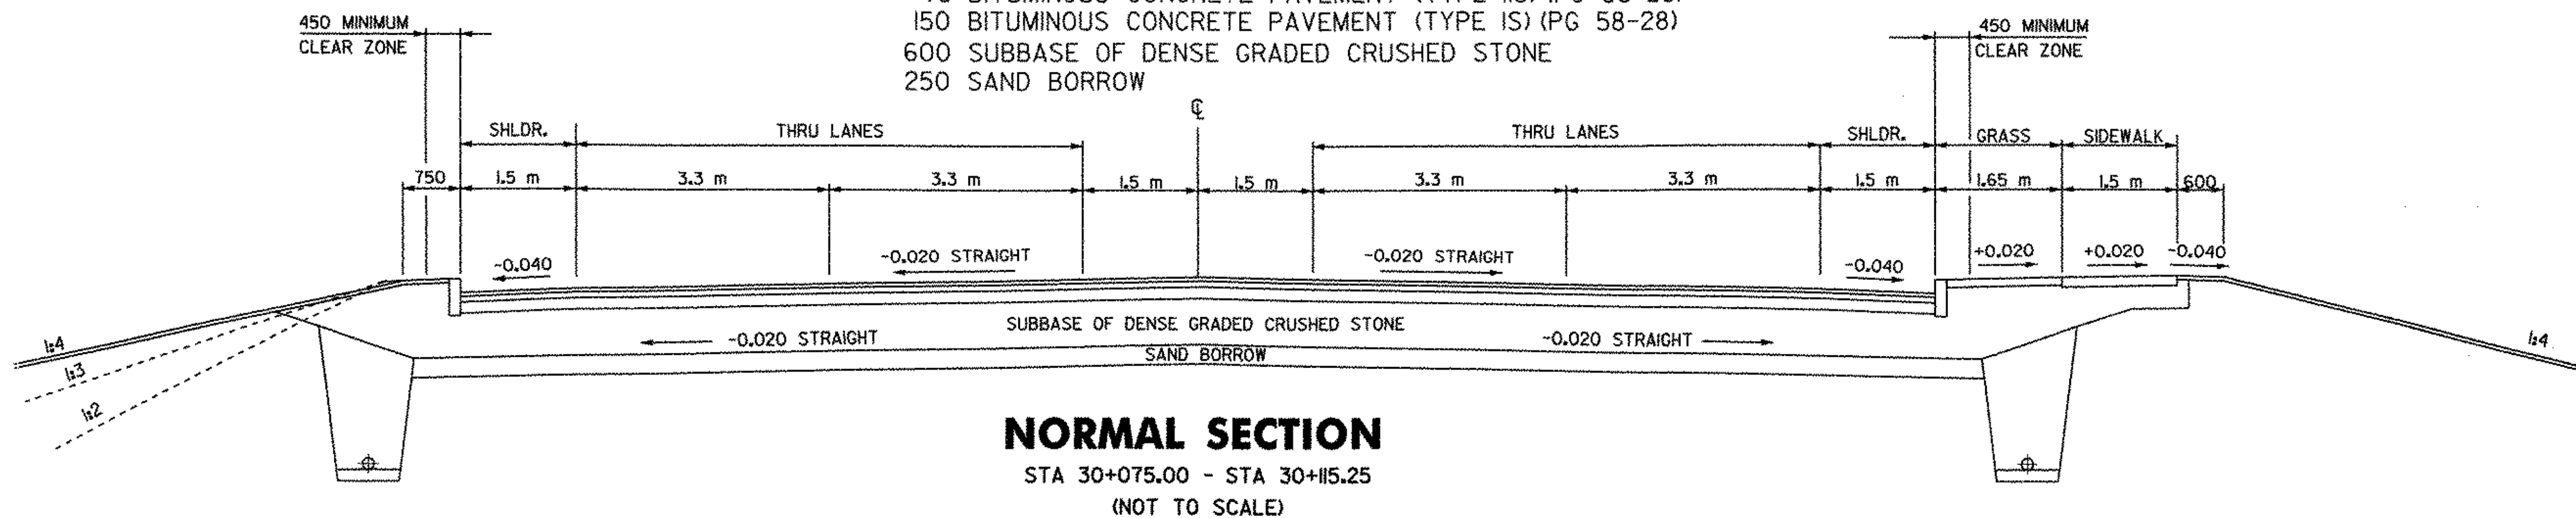


SEEDING FORMULA URBAN AREAS


% MASS	kg/ha	NAME	PUR %	GERM %
42.5	38.0	CREeping RED FESCUE	98	85
10.0	9.0	PERENNIAL RYE GRASS	95	90
42.5	38.0	KENTUCKY BLUE GRASS	85	85
5.0	5.0	ANNUAL RYE GRASS	95	85
100.0	90.0			

GENERAL NOTES

- SEED MIXTURE: SHALL NOT HAVE A WEED CONTENT EXCEEDING 0.40% BY MASS AND SHALL BE FREE OF ALL NOXIOUS SEED.
- SEED: TO BE APPLIED PER SEEDING FORMULAS OR AS DIRECTED BY THE ENGINEER.
- FERTILIZER: FORMULA 10-20-10, TO BE USED WITH SEED, APPLIED AT THE RATE OF 560 kg/ha. (HYDRO SEEDERS MAY USE 19-19-19 FORMULA).
- AGRICULTURAL LIMESTONE: TO BE APPLIED AT THE RATE OF 4500 kg/ha, OR AS DIRECTED BY THE ENGINEER.
- HAY MULCH: TO BE PLACED ON EARTH SLOPES AT THE RATE OF 4500 kg/ha, OR AS DIRECTED BY THE ENGINEER.
- TOPSOIL: TO BE USED WITH SEED AS INDICATED ON THE PLANS, OR AS DIRECTED BY THE ENGINEER.
- MARKER POSTS: TO BE PLACED AS INDICATED OR AS DIRECTED BY THE ENGINEER.
- SLOPE ROUNDING: ALL CUT SLOPES TO BE ROUNDED IN ACCORDANCE WITH STD SHEET B-5M. SLOPE LINES SHOWN ON THE PLANS AND CROSS SECTIONS DO NOT SHOW THE SLOPE ROUNDING.
- PAY LIMITS OF SAND BORROW: WHEN USED IN CONJUNCTION WITH UNDERDRAIN - SEE STANDARD SHEET D-2M.
- TACK COAT: EMULSIFIED ASPHALT IS TO BE APPLIED AT THE RATE OF 0.07 L/m² BETWEEN SUCCESSIVE COURSES OF PAVEMENT AS DIRECTED BY THE ENGINEER.

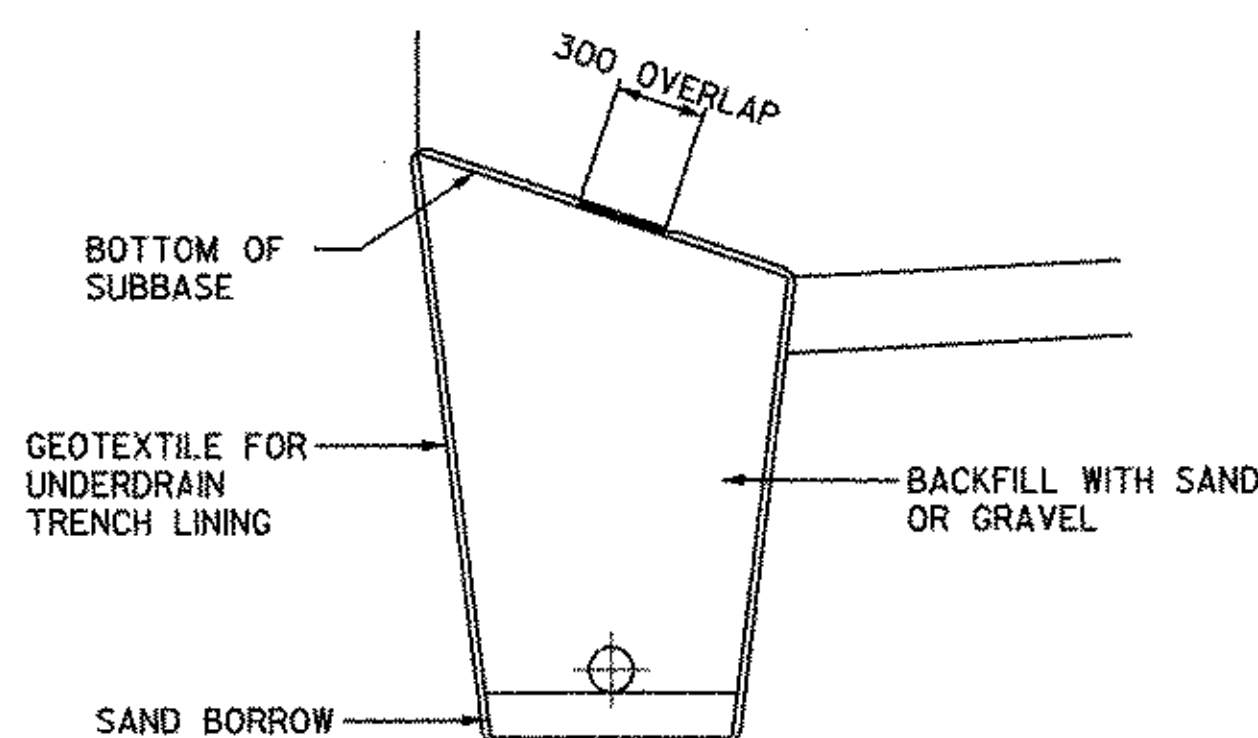

UNDERDRAIN DETAIL
 (NOT TO SCALE)

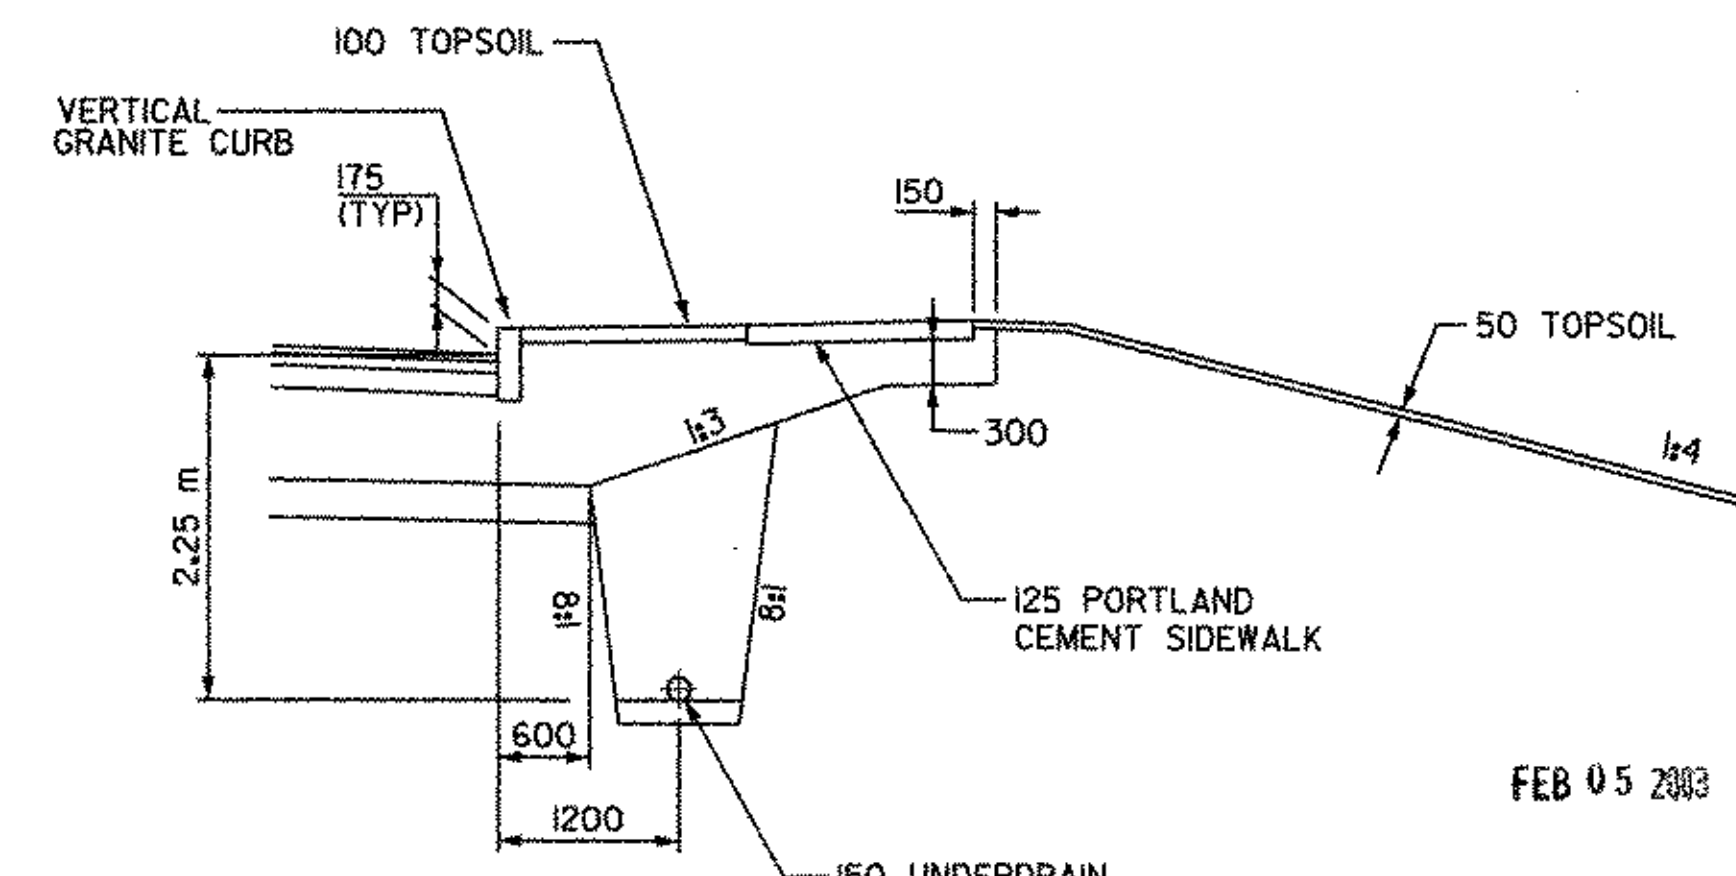

SIDEWALK CONSTRUCTION UNDERDRAIN PLACEMENT DETAIL
 (NOT TO SCALE)

NOTE: UNLESS OTHERWISE NOTED IN THESE PLANS, ALL ELEVATIONS ARE IN METERS AND ALL DIMENSIONS ARE IN MILLIMETERS

DATUM	
VERTICAL	NGVD 1929
HORIZONTAL	NAD 1983


PROJECT:	BRATTLEBORO	PROJECT NO.:	NH BRF 012-1(33)
DESIGN FILE NAME:	95b270\structures\sb270typ.dgn	PLOT DATE:	09-MAR-2001
IPARM FILE NAME:	sb270typ.l	SURVEY DATE:	
SURVEYED BY:		SQUAD LEADER:	W HUSBAND
		DRAWN BY:	P SHEDD
R.O.W. SHEET 2 OF 27 SHEETS			

TYPICAL ROADWAY SECTIONS




MATERIAL ITEM	THICKNESS	TOLERANCE
PAVEMENT (TOTAL DEPTH ALL LAYERS)	+/- 5	
SUBBASE	+/- 30	
SAND BORROW	+/- 30	

- 50 BITUMINOUS CONCRETE PAVEMENT (TYPE IIIS) (PG 58-28)
- 75 BITUMINOUS CONCRETE PAVEMENT (TYPE IIS) (PG 58-28)
- 150 BITUMINOUS CONCRETE PAVEMENT (TYPE IS) (PG 58-28)
- 600 SUBBASE OF DENSE GRADED CRUSHED STONE
- 250 SAND BORROW

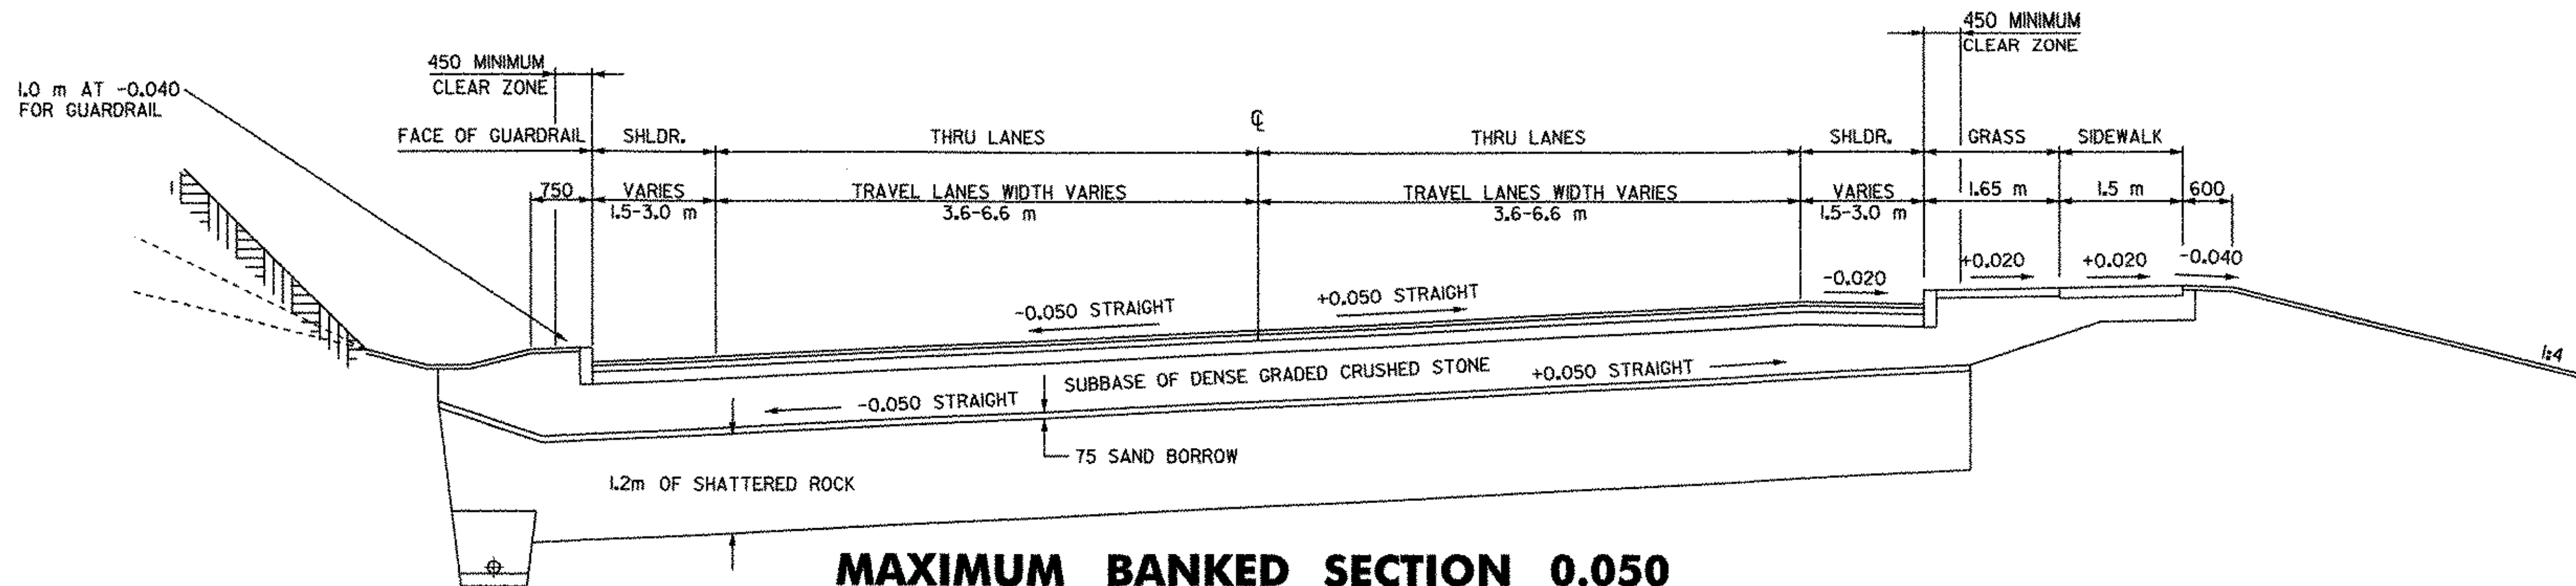


MAXIMUM BANKED SECTION 0.050

STA 30+152.90 - STA 30+325.00
(NOT TO SCALE)

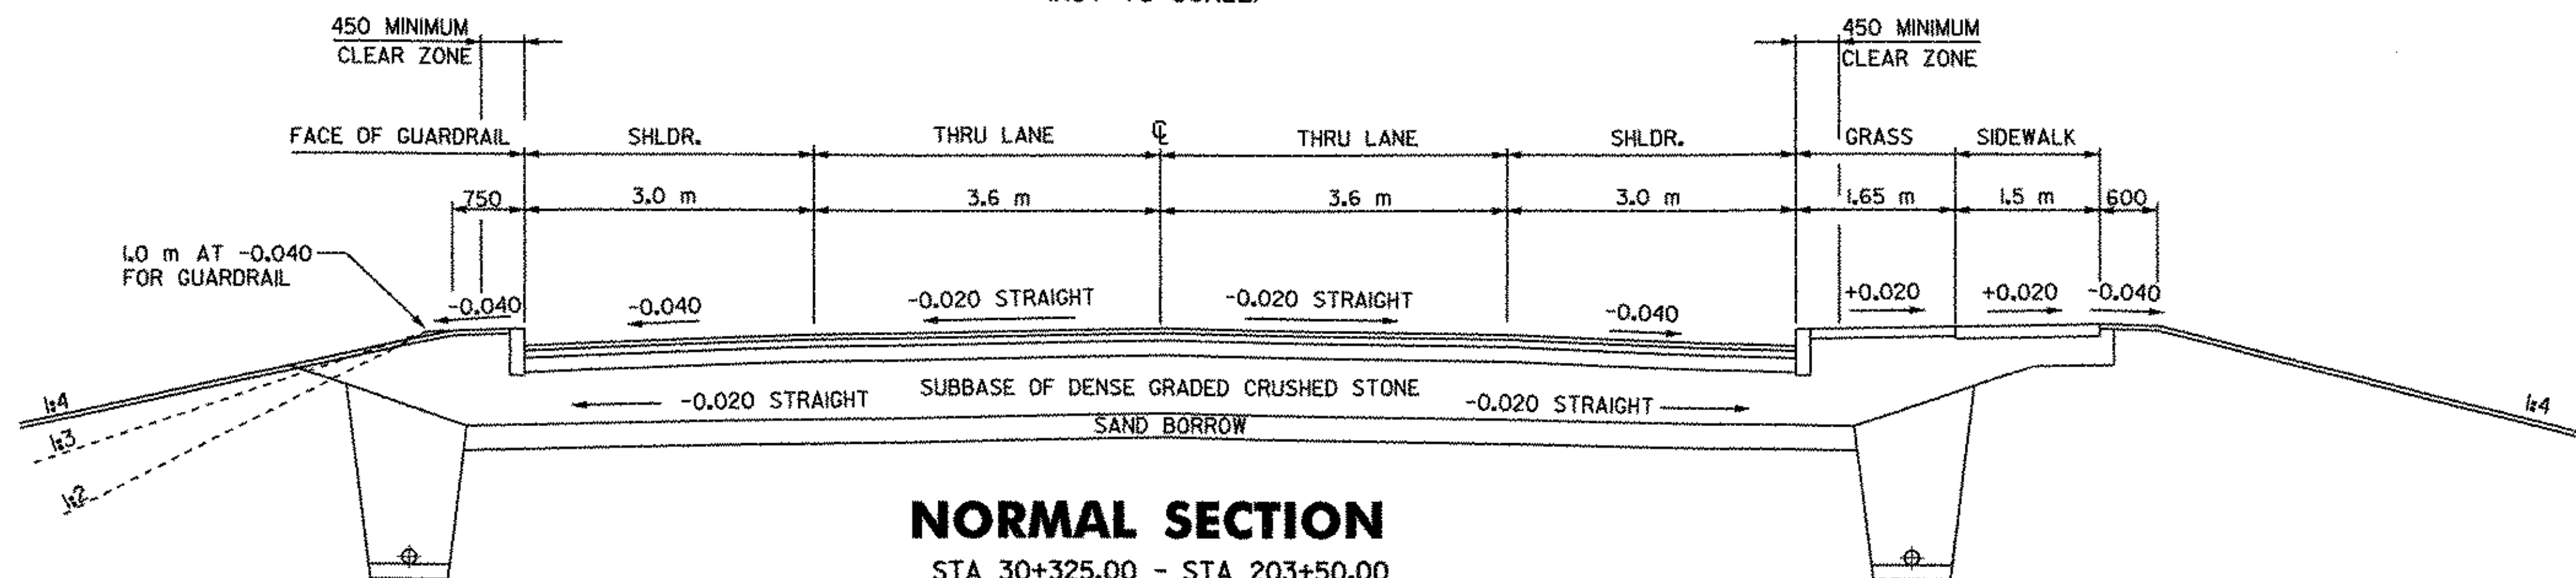


NORMAL SECTION

STA 30+325.00 - STA 203+50.00
(NOT TO SCALE)

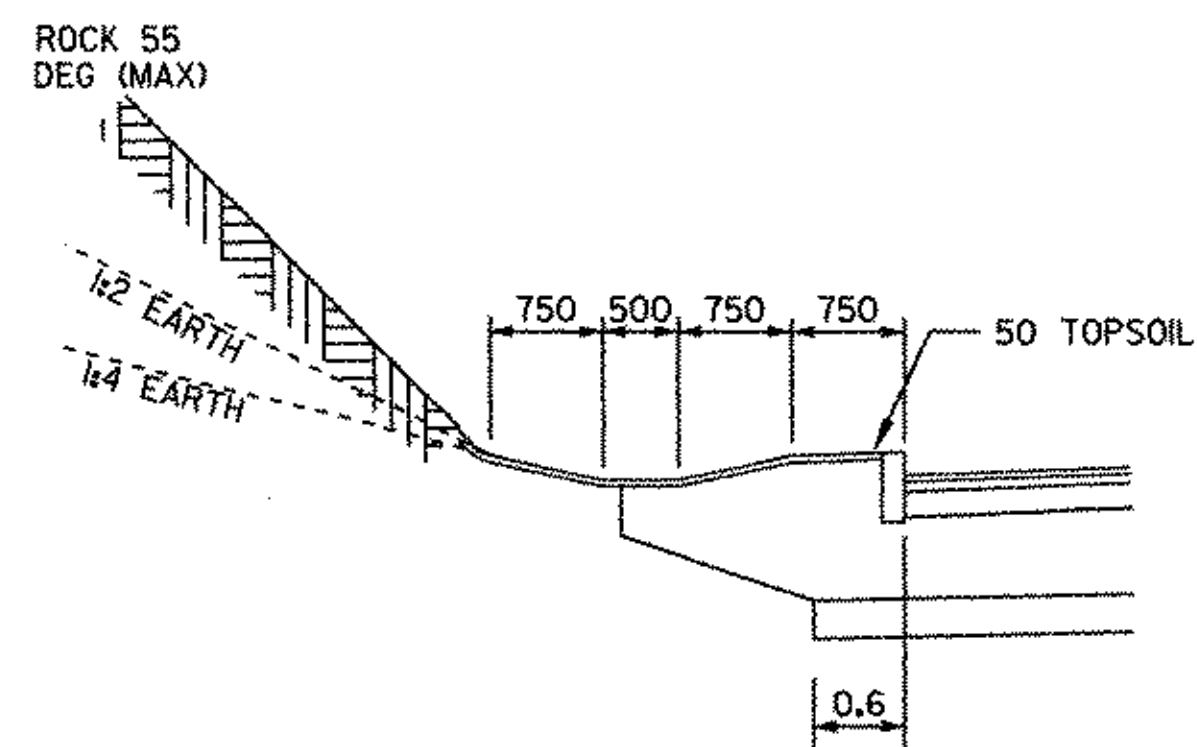


DITCH & BACKSLOPE DETAIL

(NOT TO SCALE)

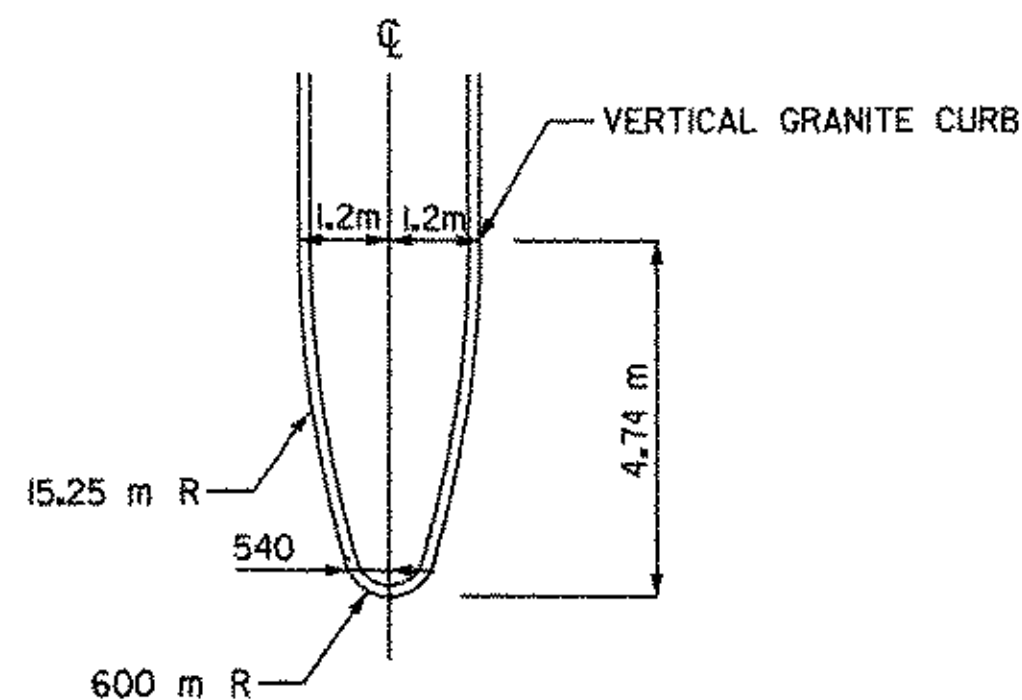

MEDIAN TERMINI DETAIL

(NOT TO SCALE)

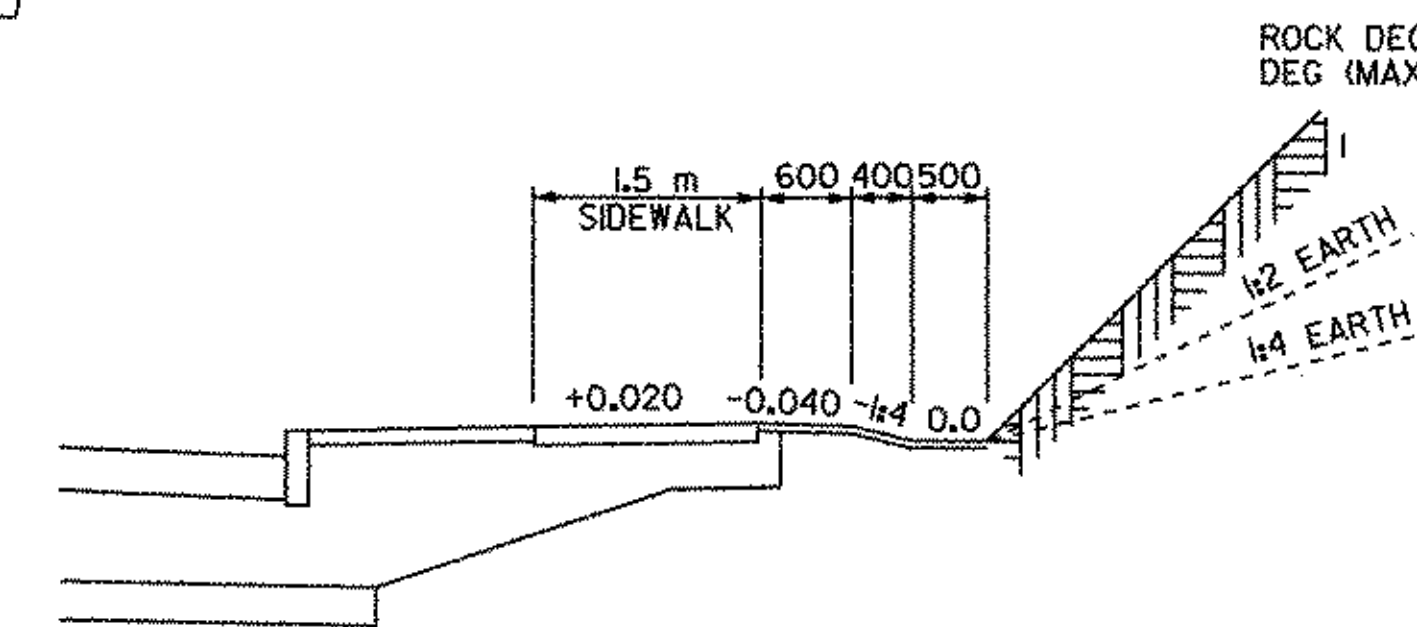

DITCH AND BACKSLOPE DETAIL FOR SIDEWALK

(NOT TO SCALE)


NOTE: UNLESS OTHERWISE NOTED IN THESE PLANS, ALL ELEVATIONS ARE IN METERS AND ALL DIMENSIONS ARE IN MILLIMETERS

DATUM	
VERTICAL	NGVD 1929
HORIZONTAL	NAD 1983

PROJECT:	BRATTLEBORO	PROJECT NO.:	NH BRF 012-(133)
DESIGN FILE NAME:	95b270\structures\sb270typ.dgn	PLOT DATE:	09-MAR-2001
IPARM FILE NAME:	sb270yp2.1	SURVEY DATE:	
SQUAD LEADER:	W HUSBAND	DRAWN BY:	P SHEDD
R.O.W. SHEET 3 OF 27 SHEETS			


212 R.O.W.

FEB 05 2003

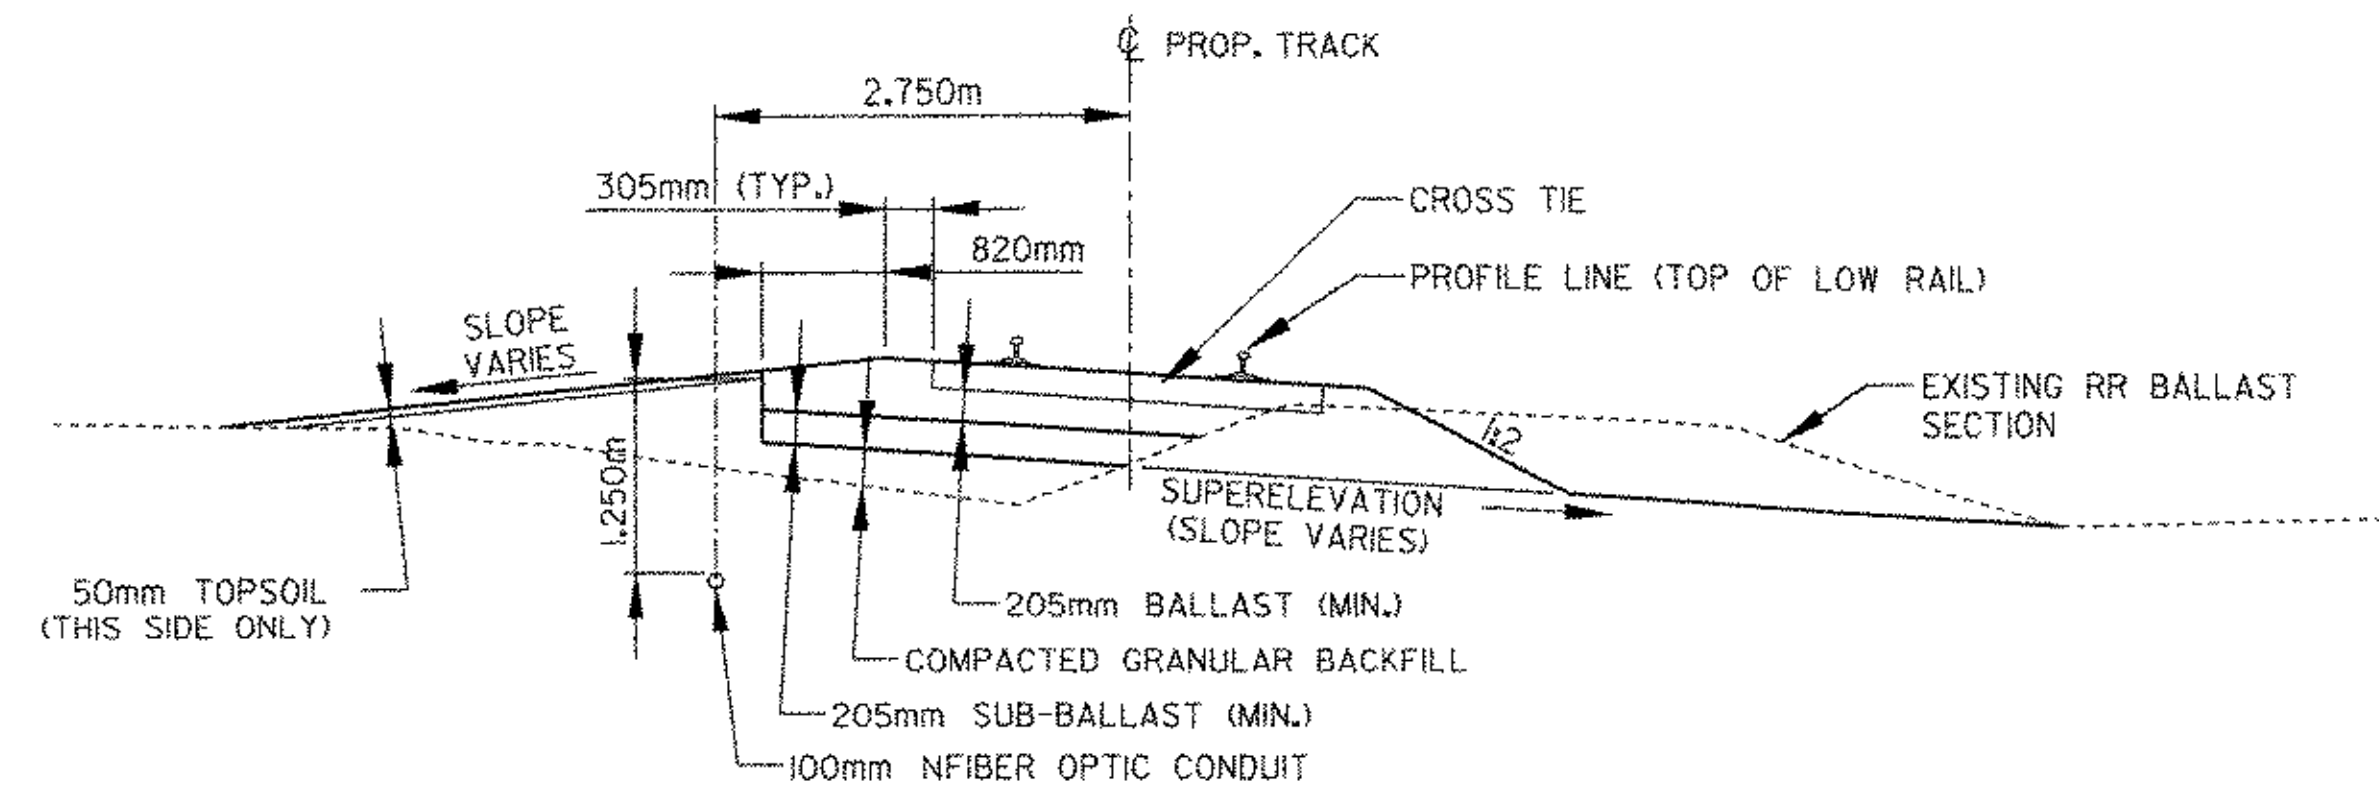


TYPICAL TRACK TRANSITION SECTION
STA. 50+500 TO STA. 50+580

SCALE 1:50

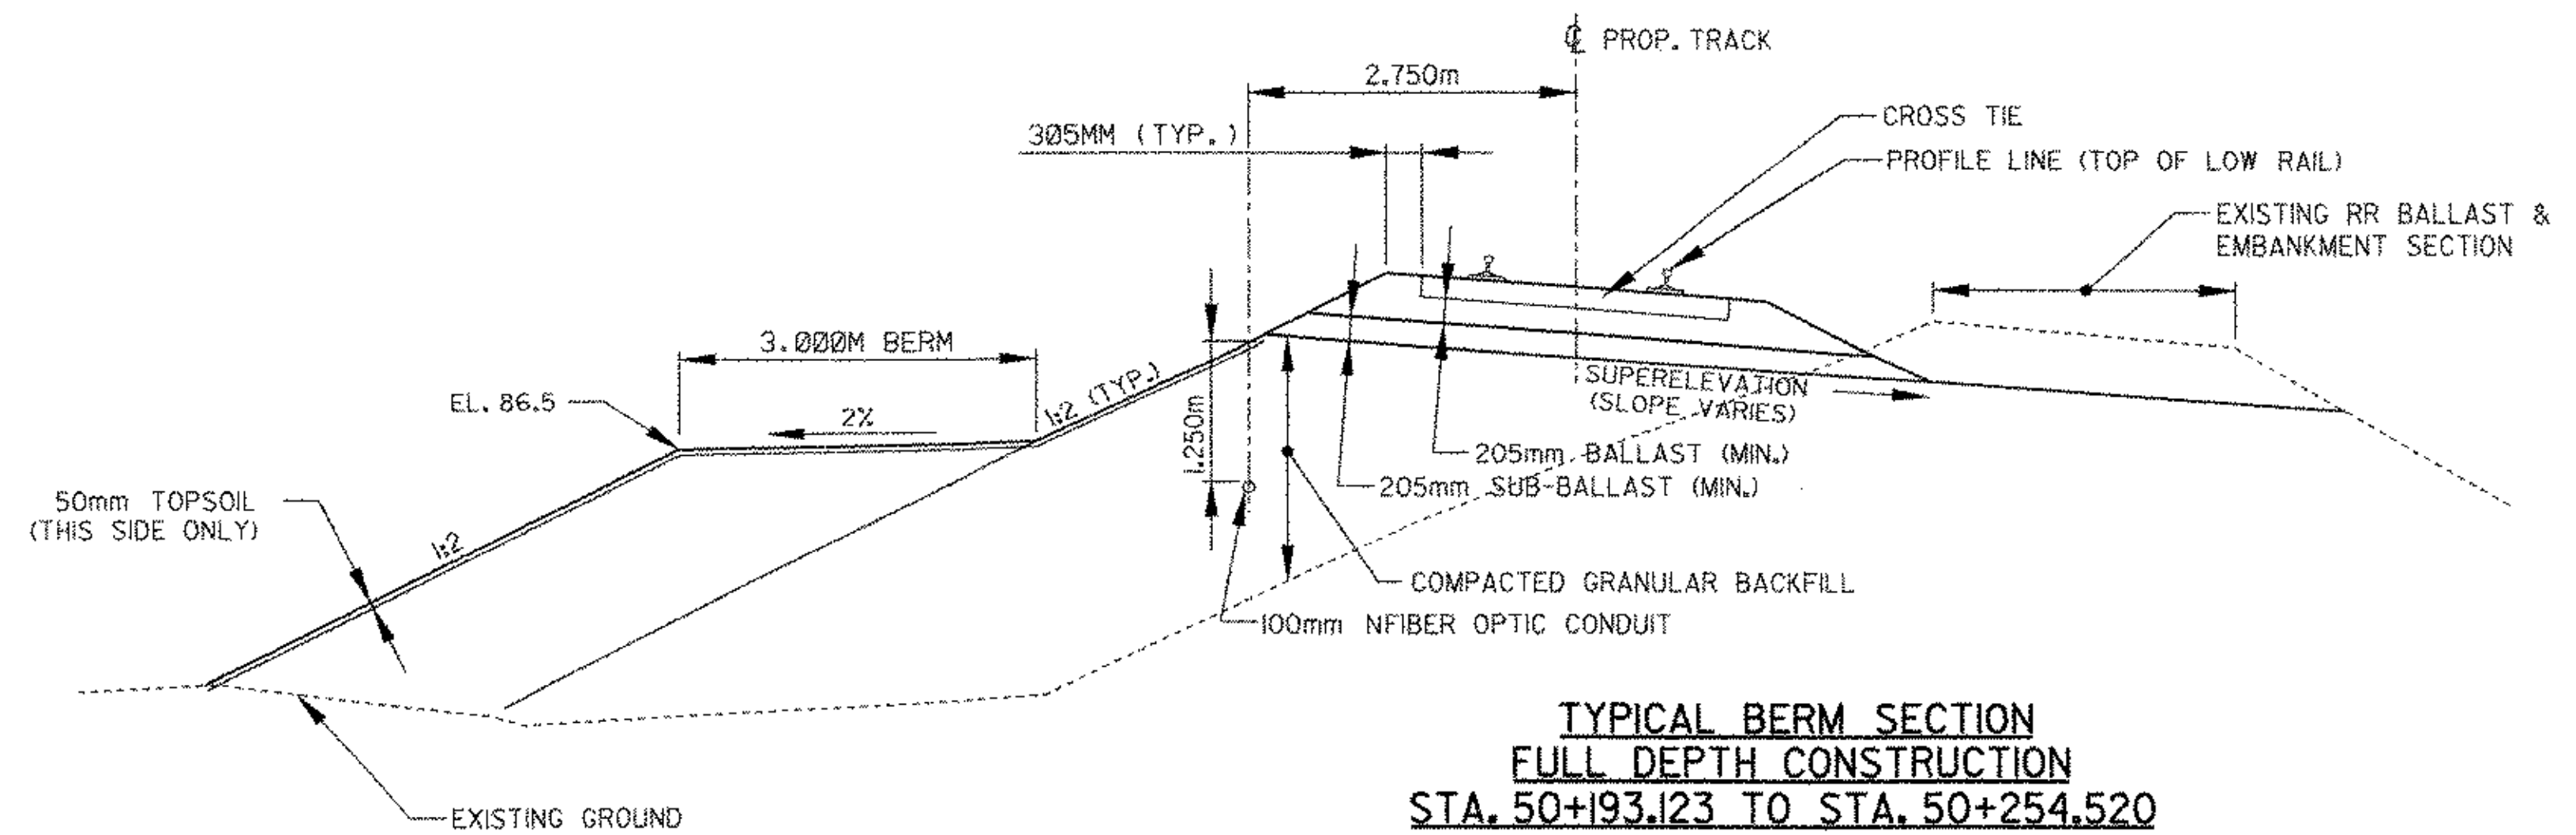

TYPICAL BERM SECTION
FULL DEPTH CONSTRUCTION
STA. 50+193.123 TO STA. 50+254.520
(SARGENT BROOK TO VT ROUTE 9)

SCALE 1:50

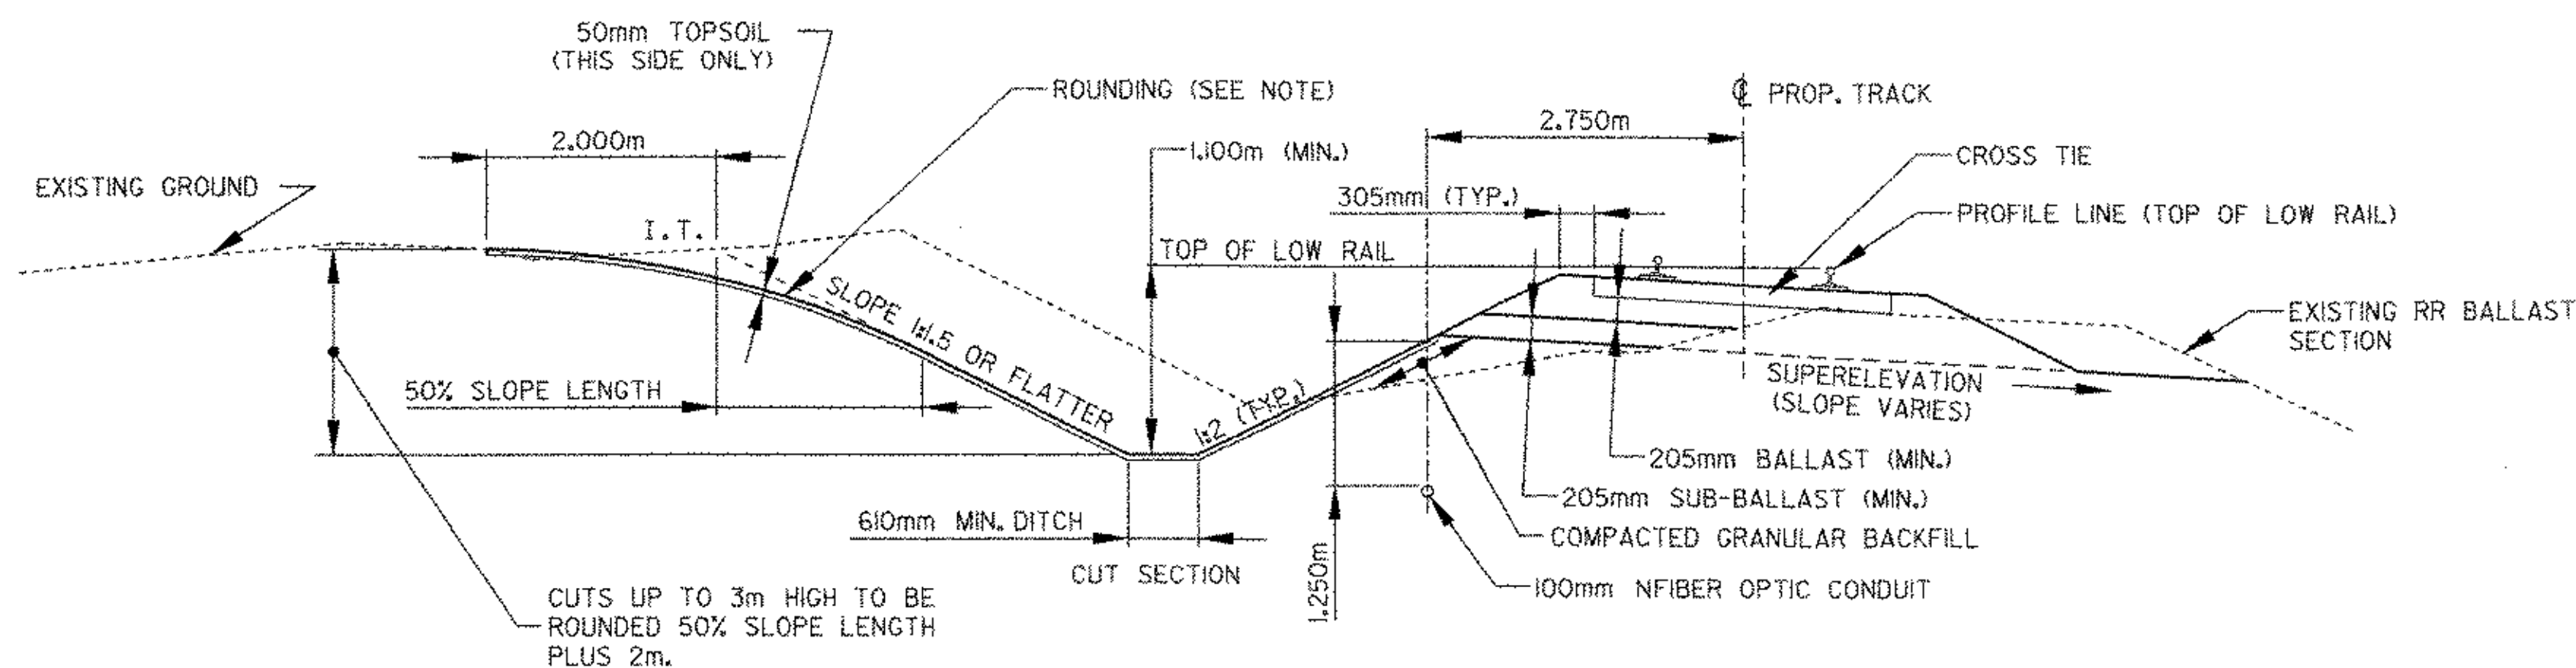


TYPICAL TRACK TRANSITION SECTION
STA. 50+120 TO STA. 50+186.417

SCALE 1:50


NOTE:

WHEN STEEPNESS OF EXISTING GROUND, SHALLOWSNESS OF CUT OR PRESENCE OF EXISTING VEGETATION OR BUILDINGS IS CONSIDERED A FACTOR PREVENTING NORMAL ROUNDING, THE EXTENT OF THE ROUNDING SHOULD BE MODIFIED TO MEET CONDITIONS. SEE NOTE 3.

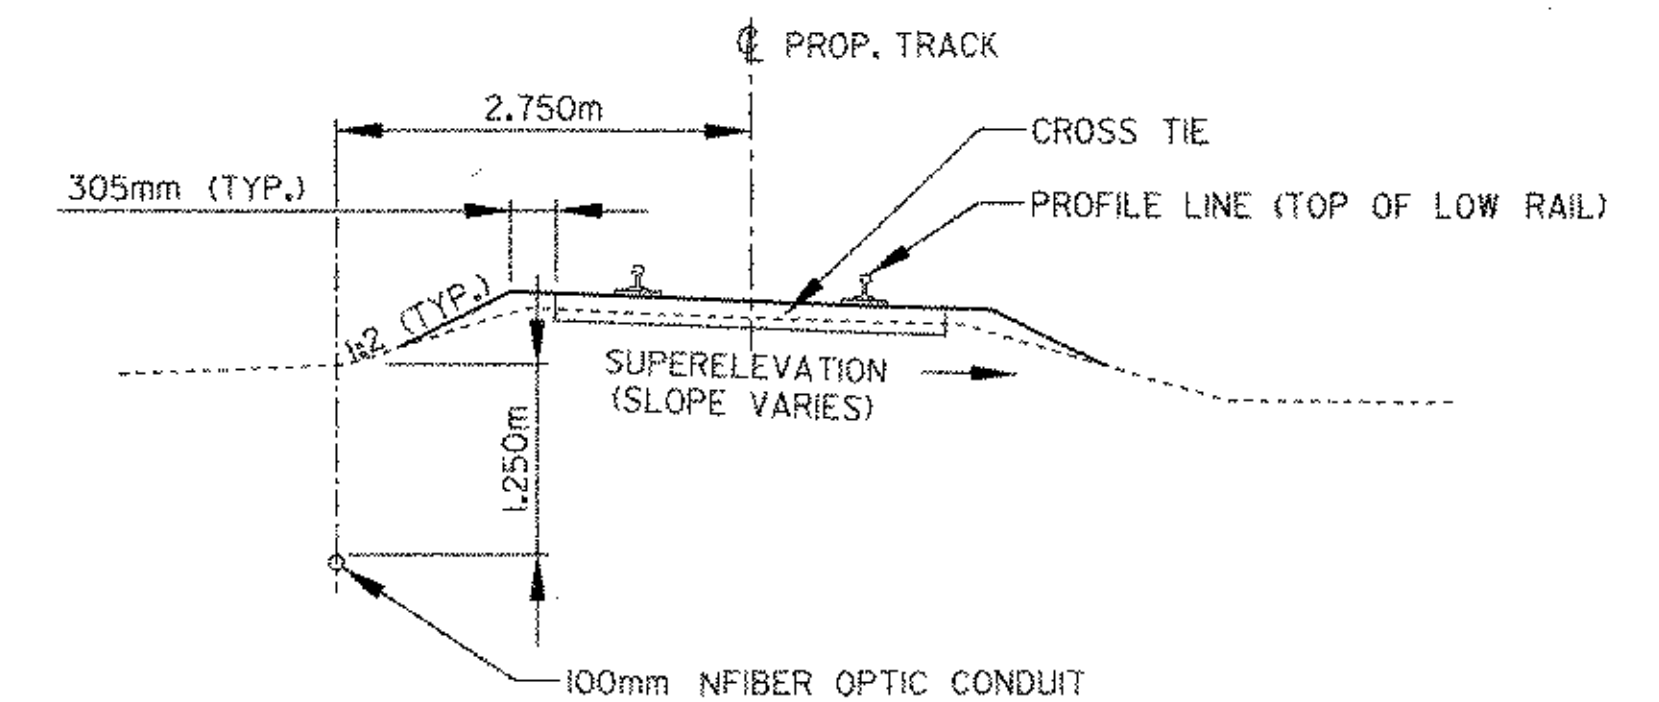

TYPICAL TRACK REHABILITATION SECTION
STA. 50+020 TO STA. 50+120
STA. 50+580 TO STA. 50+698.603

SCALE 1:50

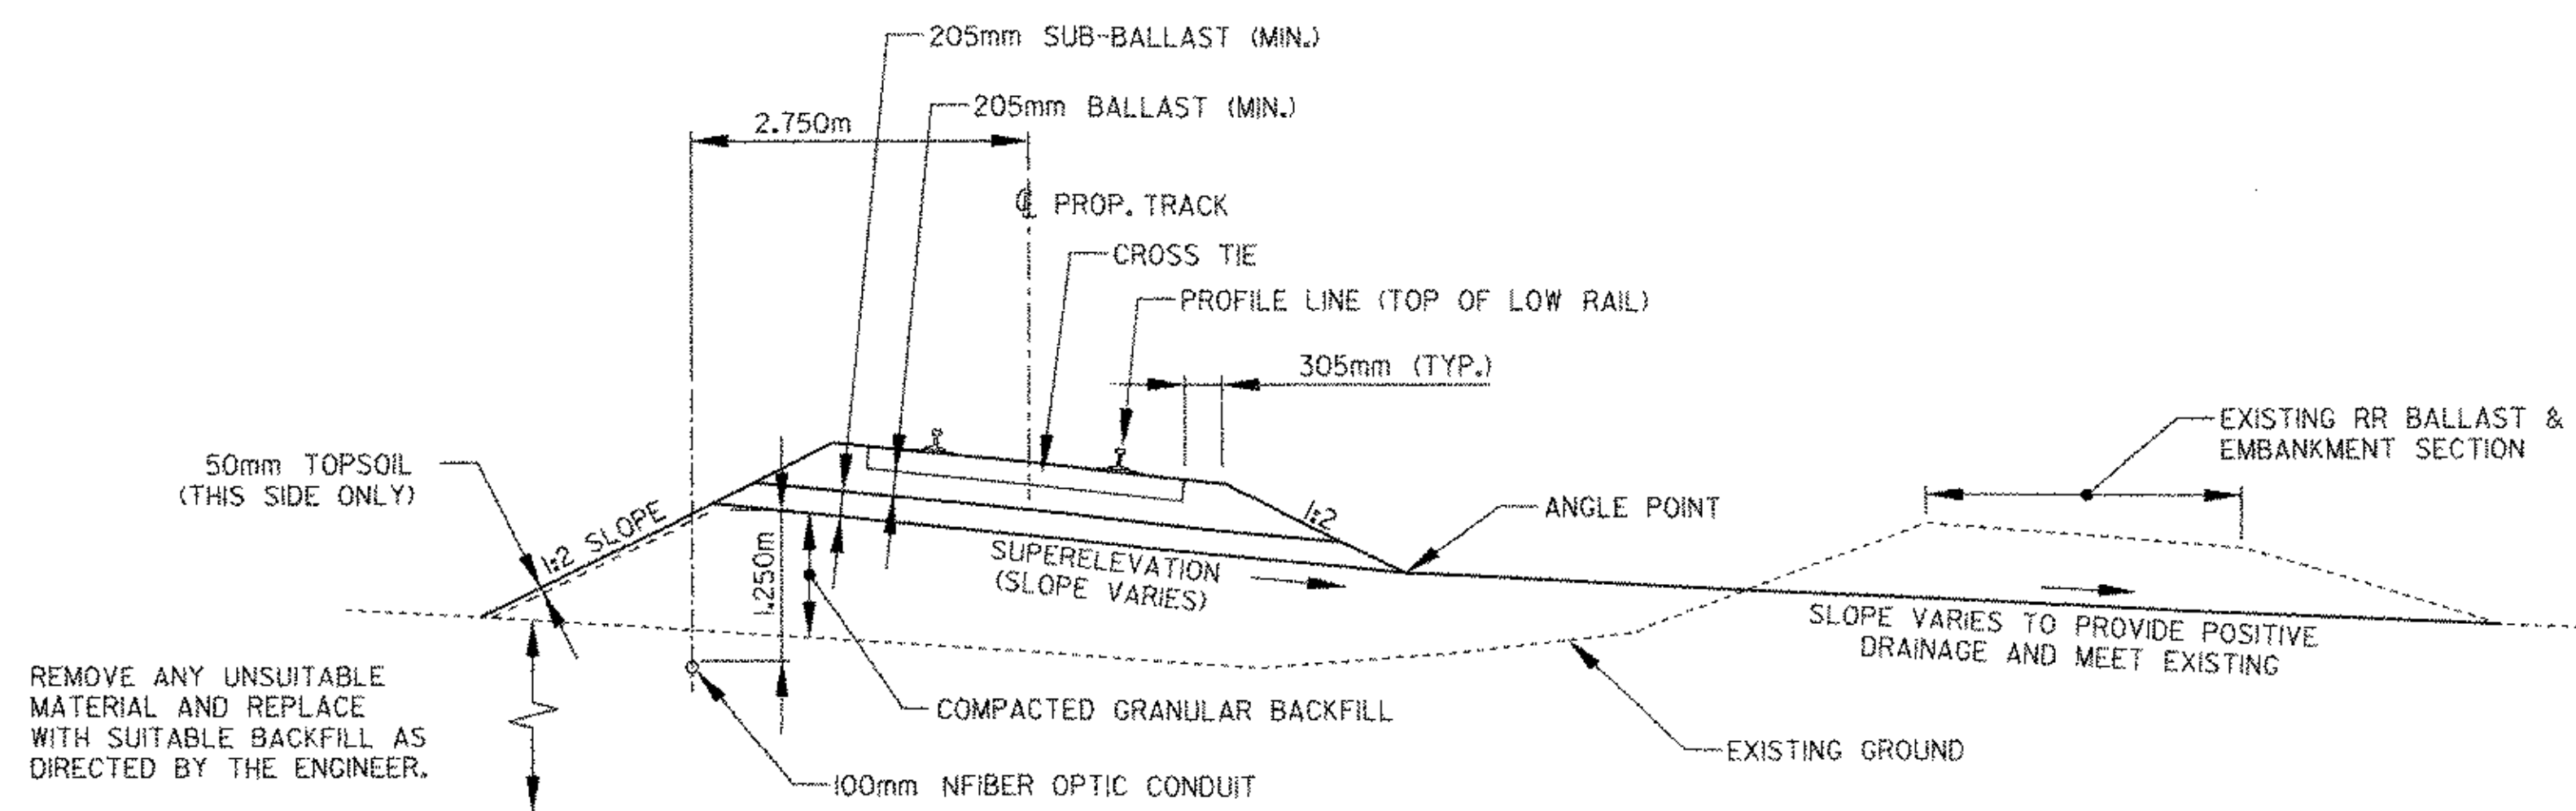

TYPICAL SUPERELEVATED TRACK SECTION - (ON CURVE)
FULL DEPTH CONSTRUCTION
STA. 50+285.220 TO STA. 50+500

SCALE 1:50

DATUM	
VERTICAL	_____
HORIZONTAL	_____

FEB 05 2003

NOTES:

- REFER TO ROADWAY TYPICAL SECTIONS FOR 'GENERAL NOTES FOR ROADWAY TYPICALS', AND UTILIZE AS APPLICABLE TO RAILROAD TYPICAL SECTIONS. NOTE THAT TOPSOIL AND/OR SEED IS NEVER TO BE APPLIED ABOVE RAILROAD SUBGRADE ELEVATION.
- RAIL TO BE #5 POUND CONTINUOUS WELDED RAIL. CROSS TIES TO BE 7"X9"X8'-6" TIMBER. BALLAST TO BE STONE BALLAST, SIZE #4. SUB-BALLAST TO BE SCREENED GRAVEL. ALL ABOVE MATERIALS MUST MEET THE REQUIREMENTS OF AREMA.
- ALLOWANCE FOR ROUNDING HAS NOT BEEN INDICATED ON RAILROAD PLANS AND CROSS SECTIONS. DUE TO UNTYPICAL CONDITIONS IN CUT, ROUNDINGS WILL BE AS DIRECTED BY THE ENGINEER.


RAILROAD TYPICAL SECTIONS

SURVEYED BY	N/A	DATE	N/A
DRAWN BY	DHL	DATE	
SQUAD LEADER	JHR		
DESIGN FILE No.	95b270\structures\track_sect.dgn		
#PARM FILE	sb270trxs.l	DATE PLOTTED	09-MAR-2001

BRATTLEBORO
NH BR F 012-K33)


R.O.W. SHEET 4 OF 27 SHEETS

PROFILE - VT ROUTE 9

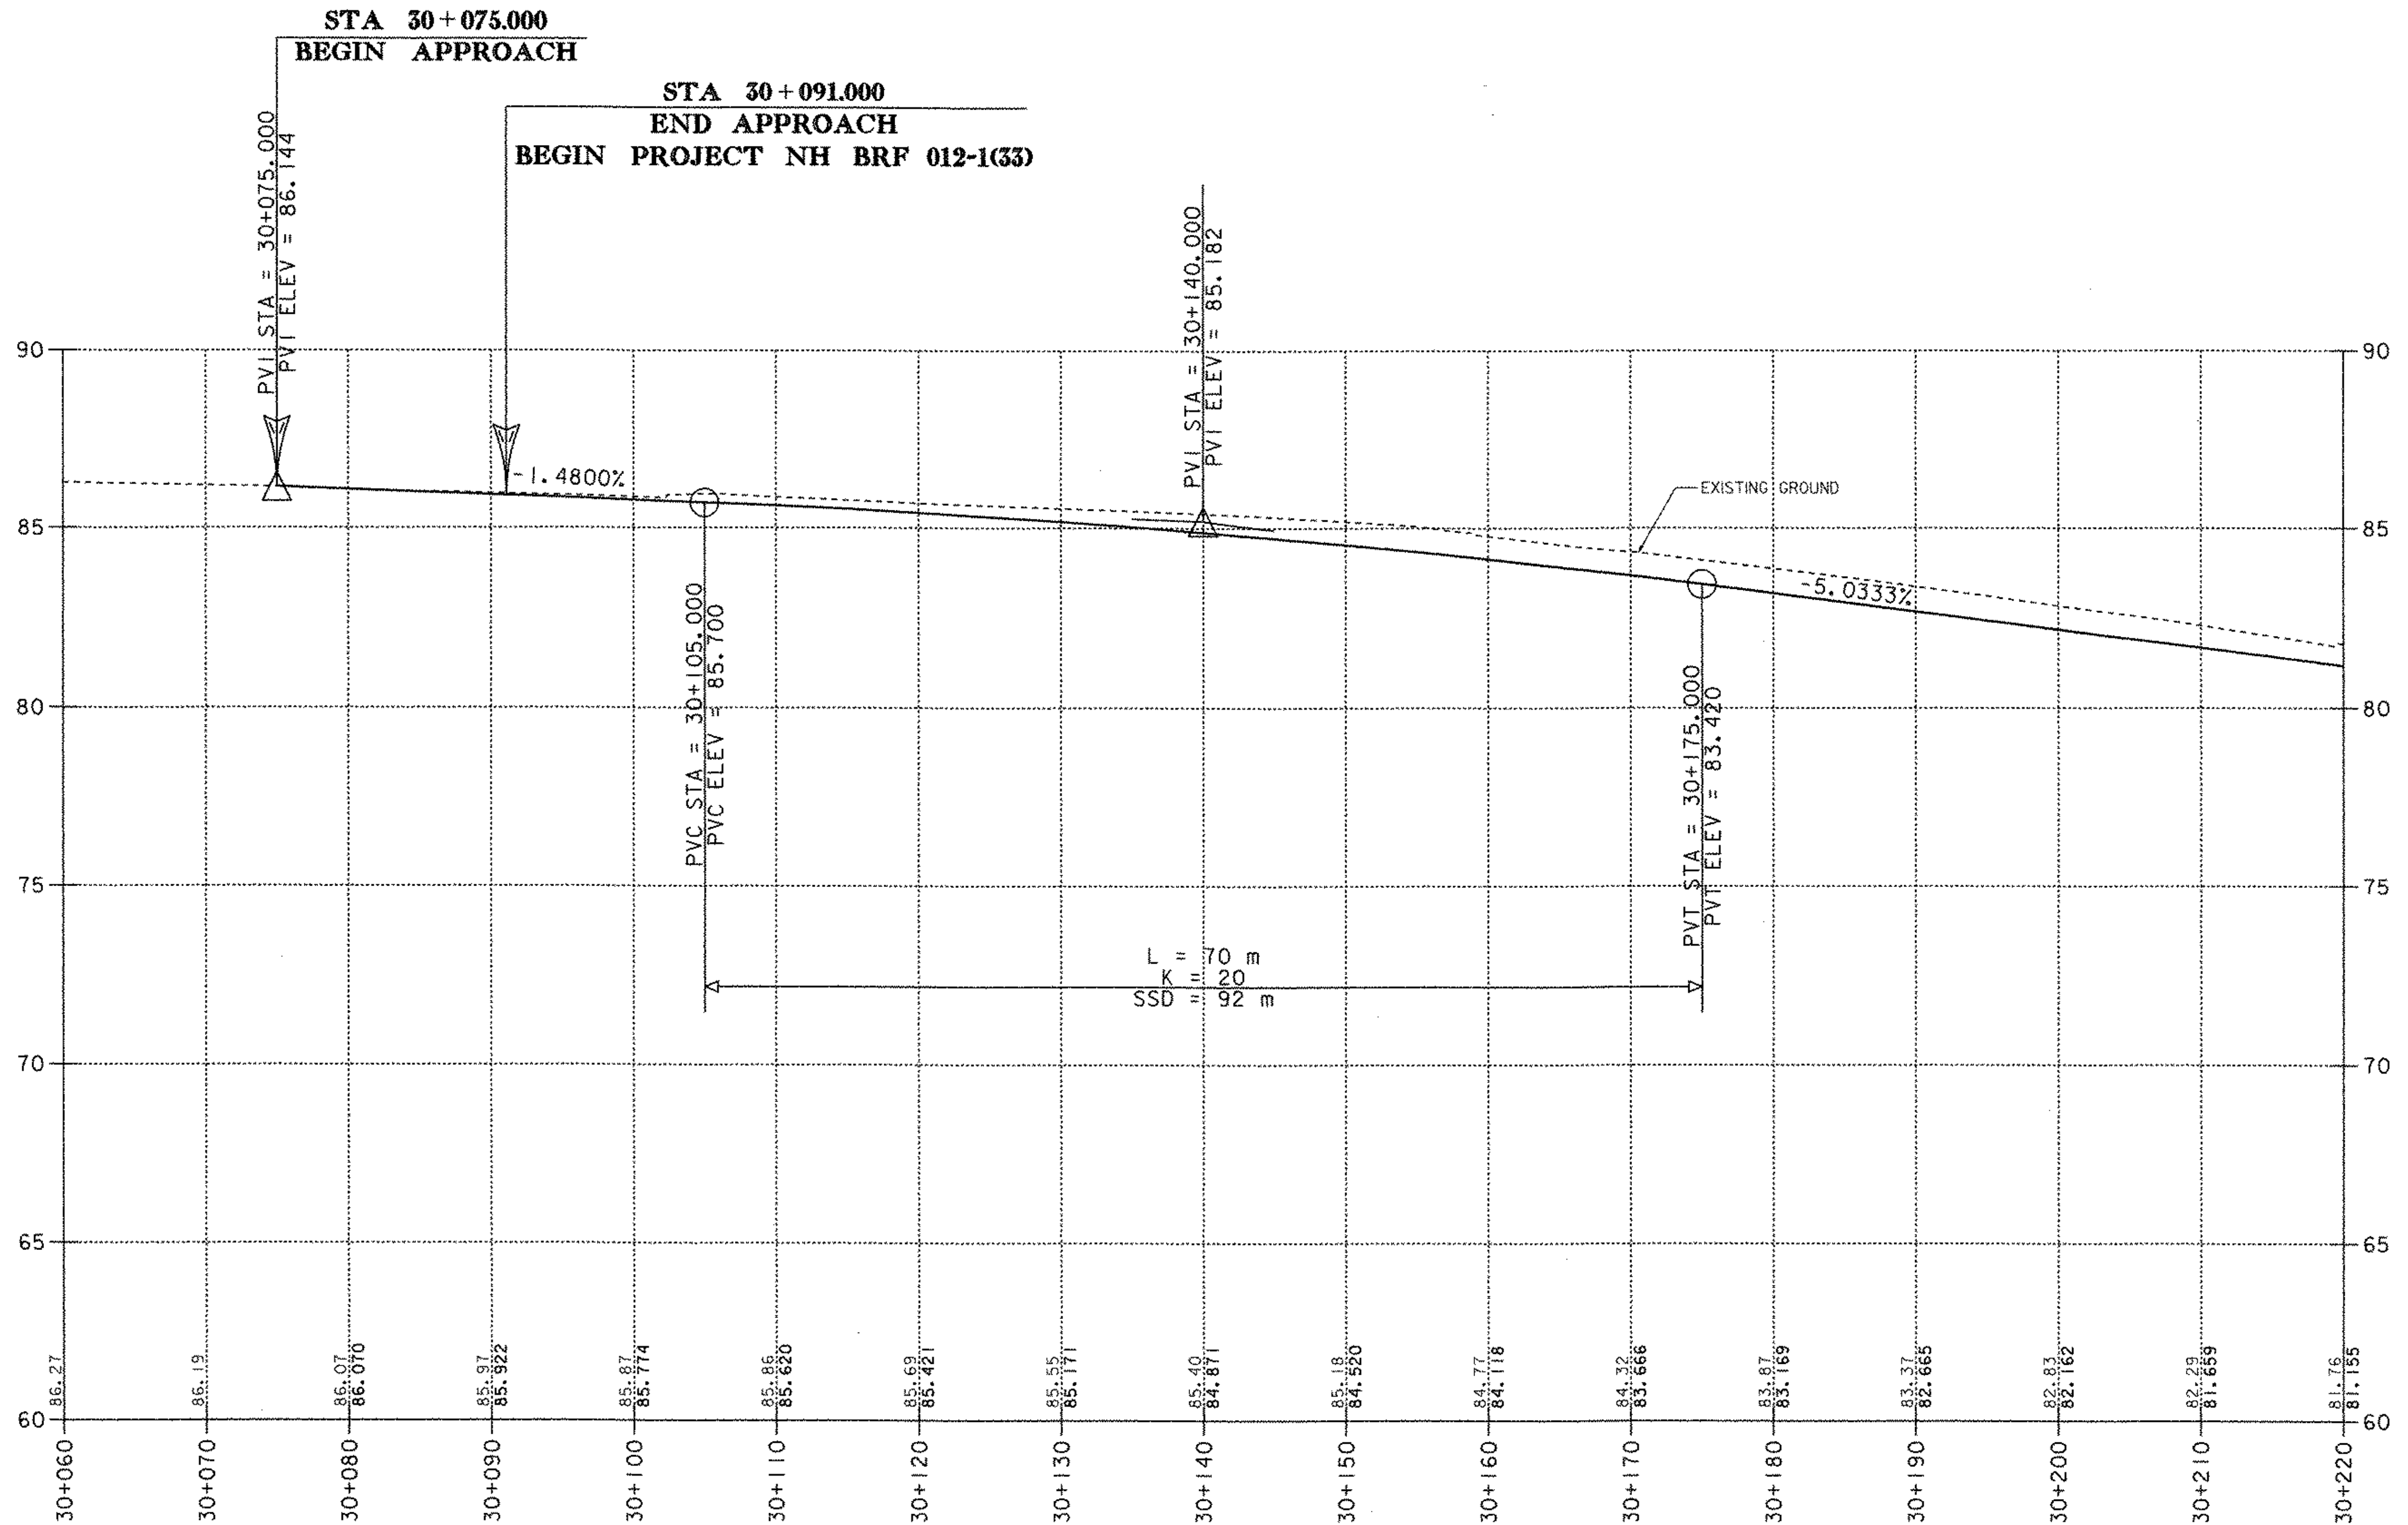

L = 70 m
K = 20
SSD = 92 m

FEB 05 2000

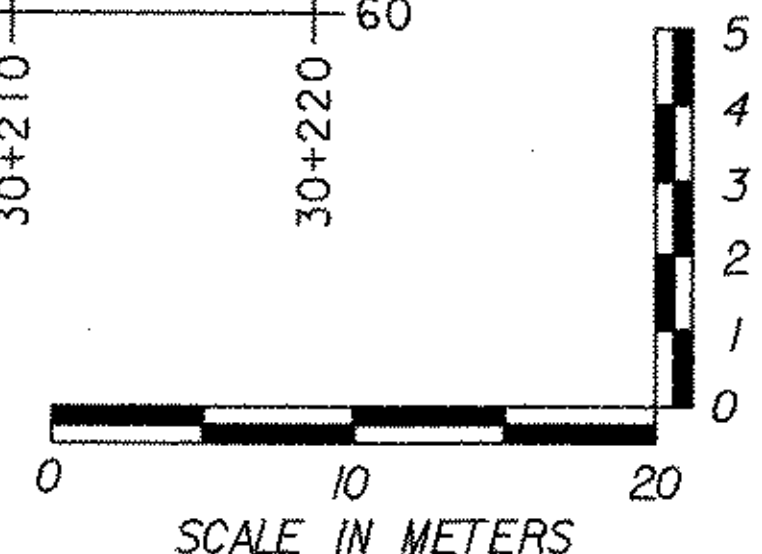


DATUM
VERTICAL NGVD 1929
HORIZONTAL NAD 1983

PROJECT: BRATTLEBORO	PROJECT NO.: NH BRF 012-(33)
DESIGN FILE NAME: 95b270\structures\sb270xs2.dgn	PLOT DATE: 09-MAR-2001
IPARM FILE NAME: sb270prt.l	SURVEY DATE:
SURVEYED BY:	DRAWN BY: P SHEDD
SQUAD LEADER: W HUSBAND	
R.O.W. SHEET 5 OF 27 SHEETS	


214 Row

PROFILE - VT ROUTE 9

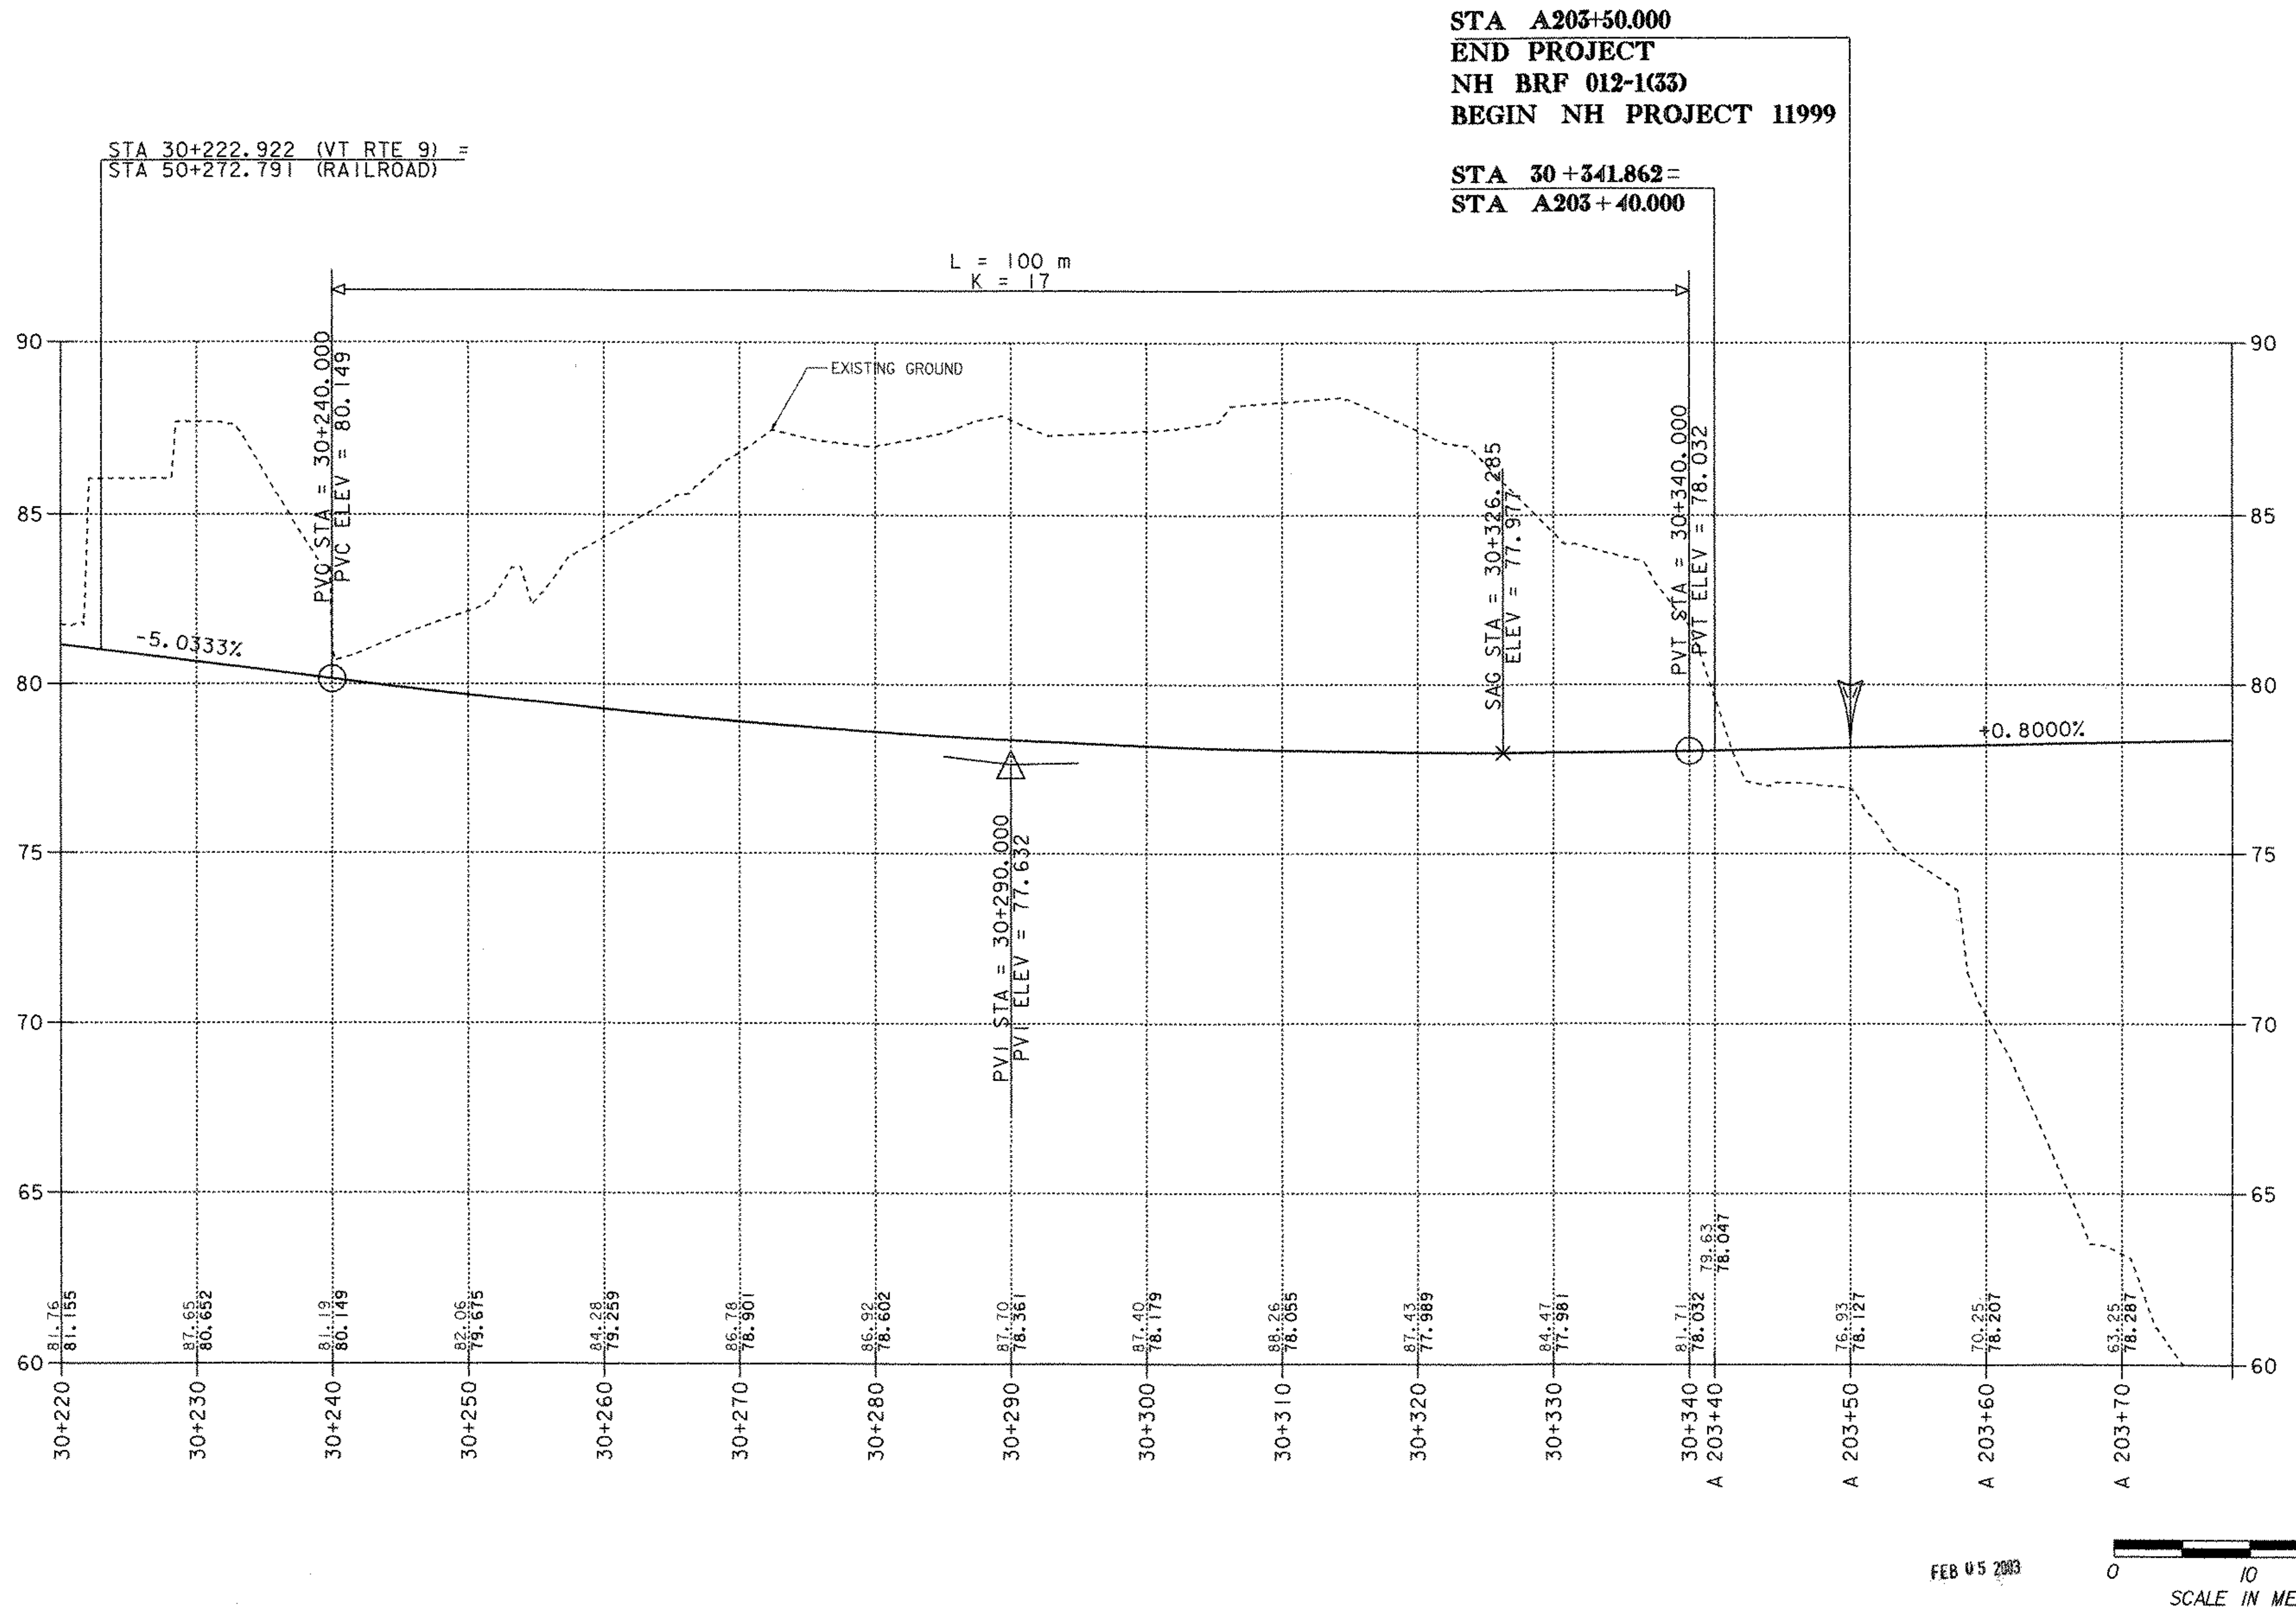


DATUM
VERTICAL NGVD 1929
HORIZONTAL NAD 1983

FEB 05 2003

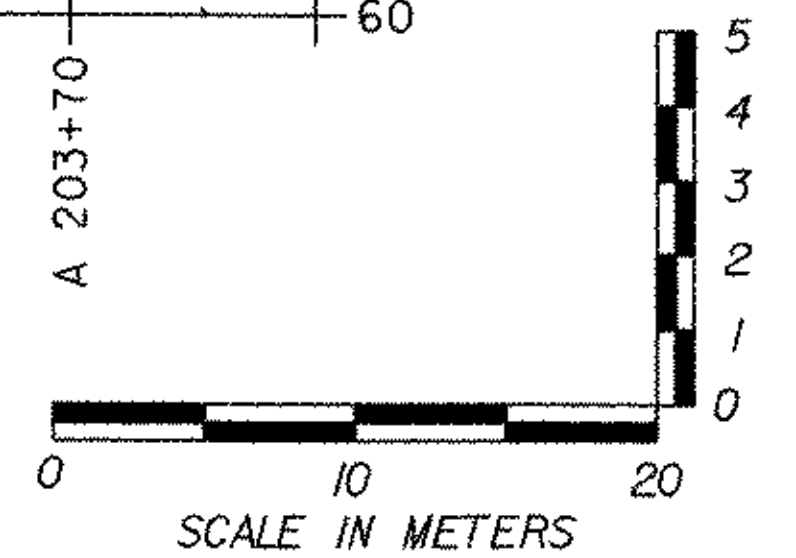

PROJECT:	BRATTLEBORO	PROJECT NO.:	NH BRF 012-1(33)
DESIGN FILE NAME:	95b270\structures\sb270xs2.dgn	PLOT DATE:	09-MAR-2001
IPARM FILE NAME:	sb270pr2.i	SURVEY DATE:	
SURVEYED BY:		SQUAD LEADER:	W HUSBAND
SQUAD LEADER:	W HUSBAND	DRAWN BY:	P SHEDD
R.O.W. SHEET 6 OF 27 SHEETS			

RAILROAD PROFILE

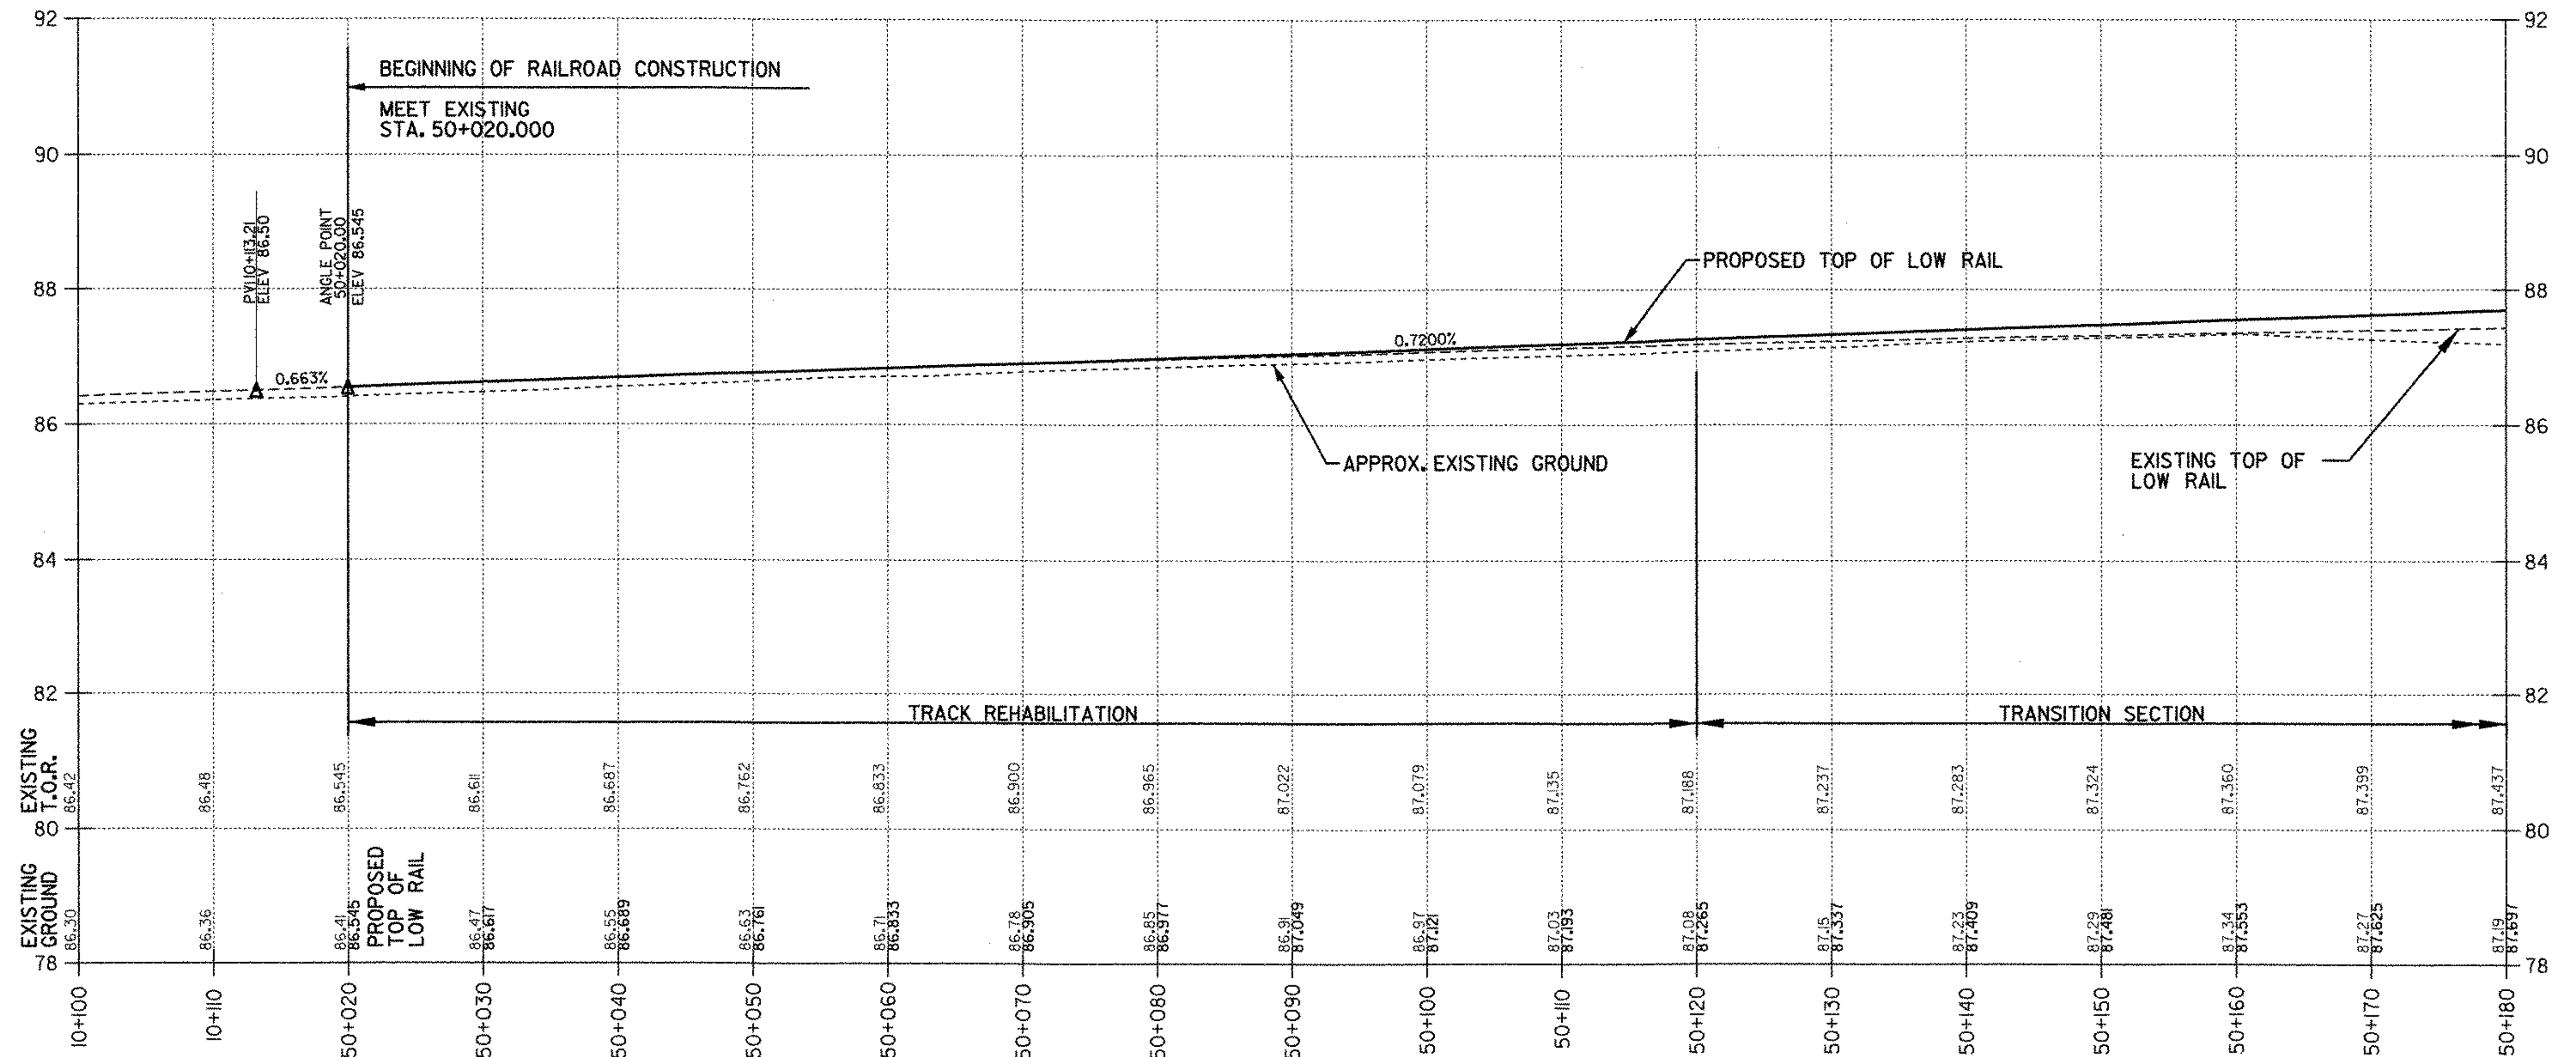

STA. 50+020.000 PROP. RR MAINLINE RELOCATION
 STA. 10+120.000 EXISTING RR MAINLINE


FEB 05 2003

DATUM
 VERTICAL _____
 HORIZONTAL _____

SURVEYED BY N/A DATE N/A
 DRAWN BY LB/LRD DATE _____
 SQUAD LEADER JHR
 DESIGN FILE NO. 95b270\structures\eb270xel.dgn
 IPARM FILE eb270rrpl DATE PLOTTED 09-MAR-2003
BRATTLEBORO
NH BR 012-1(33)
R.O.W. SHEET 7 OF 27 SHEETS

2/6 Row

RAILROAD PROFILE

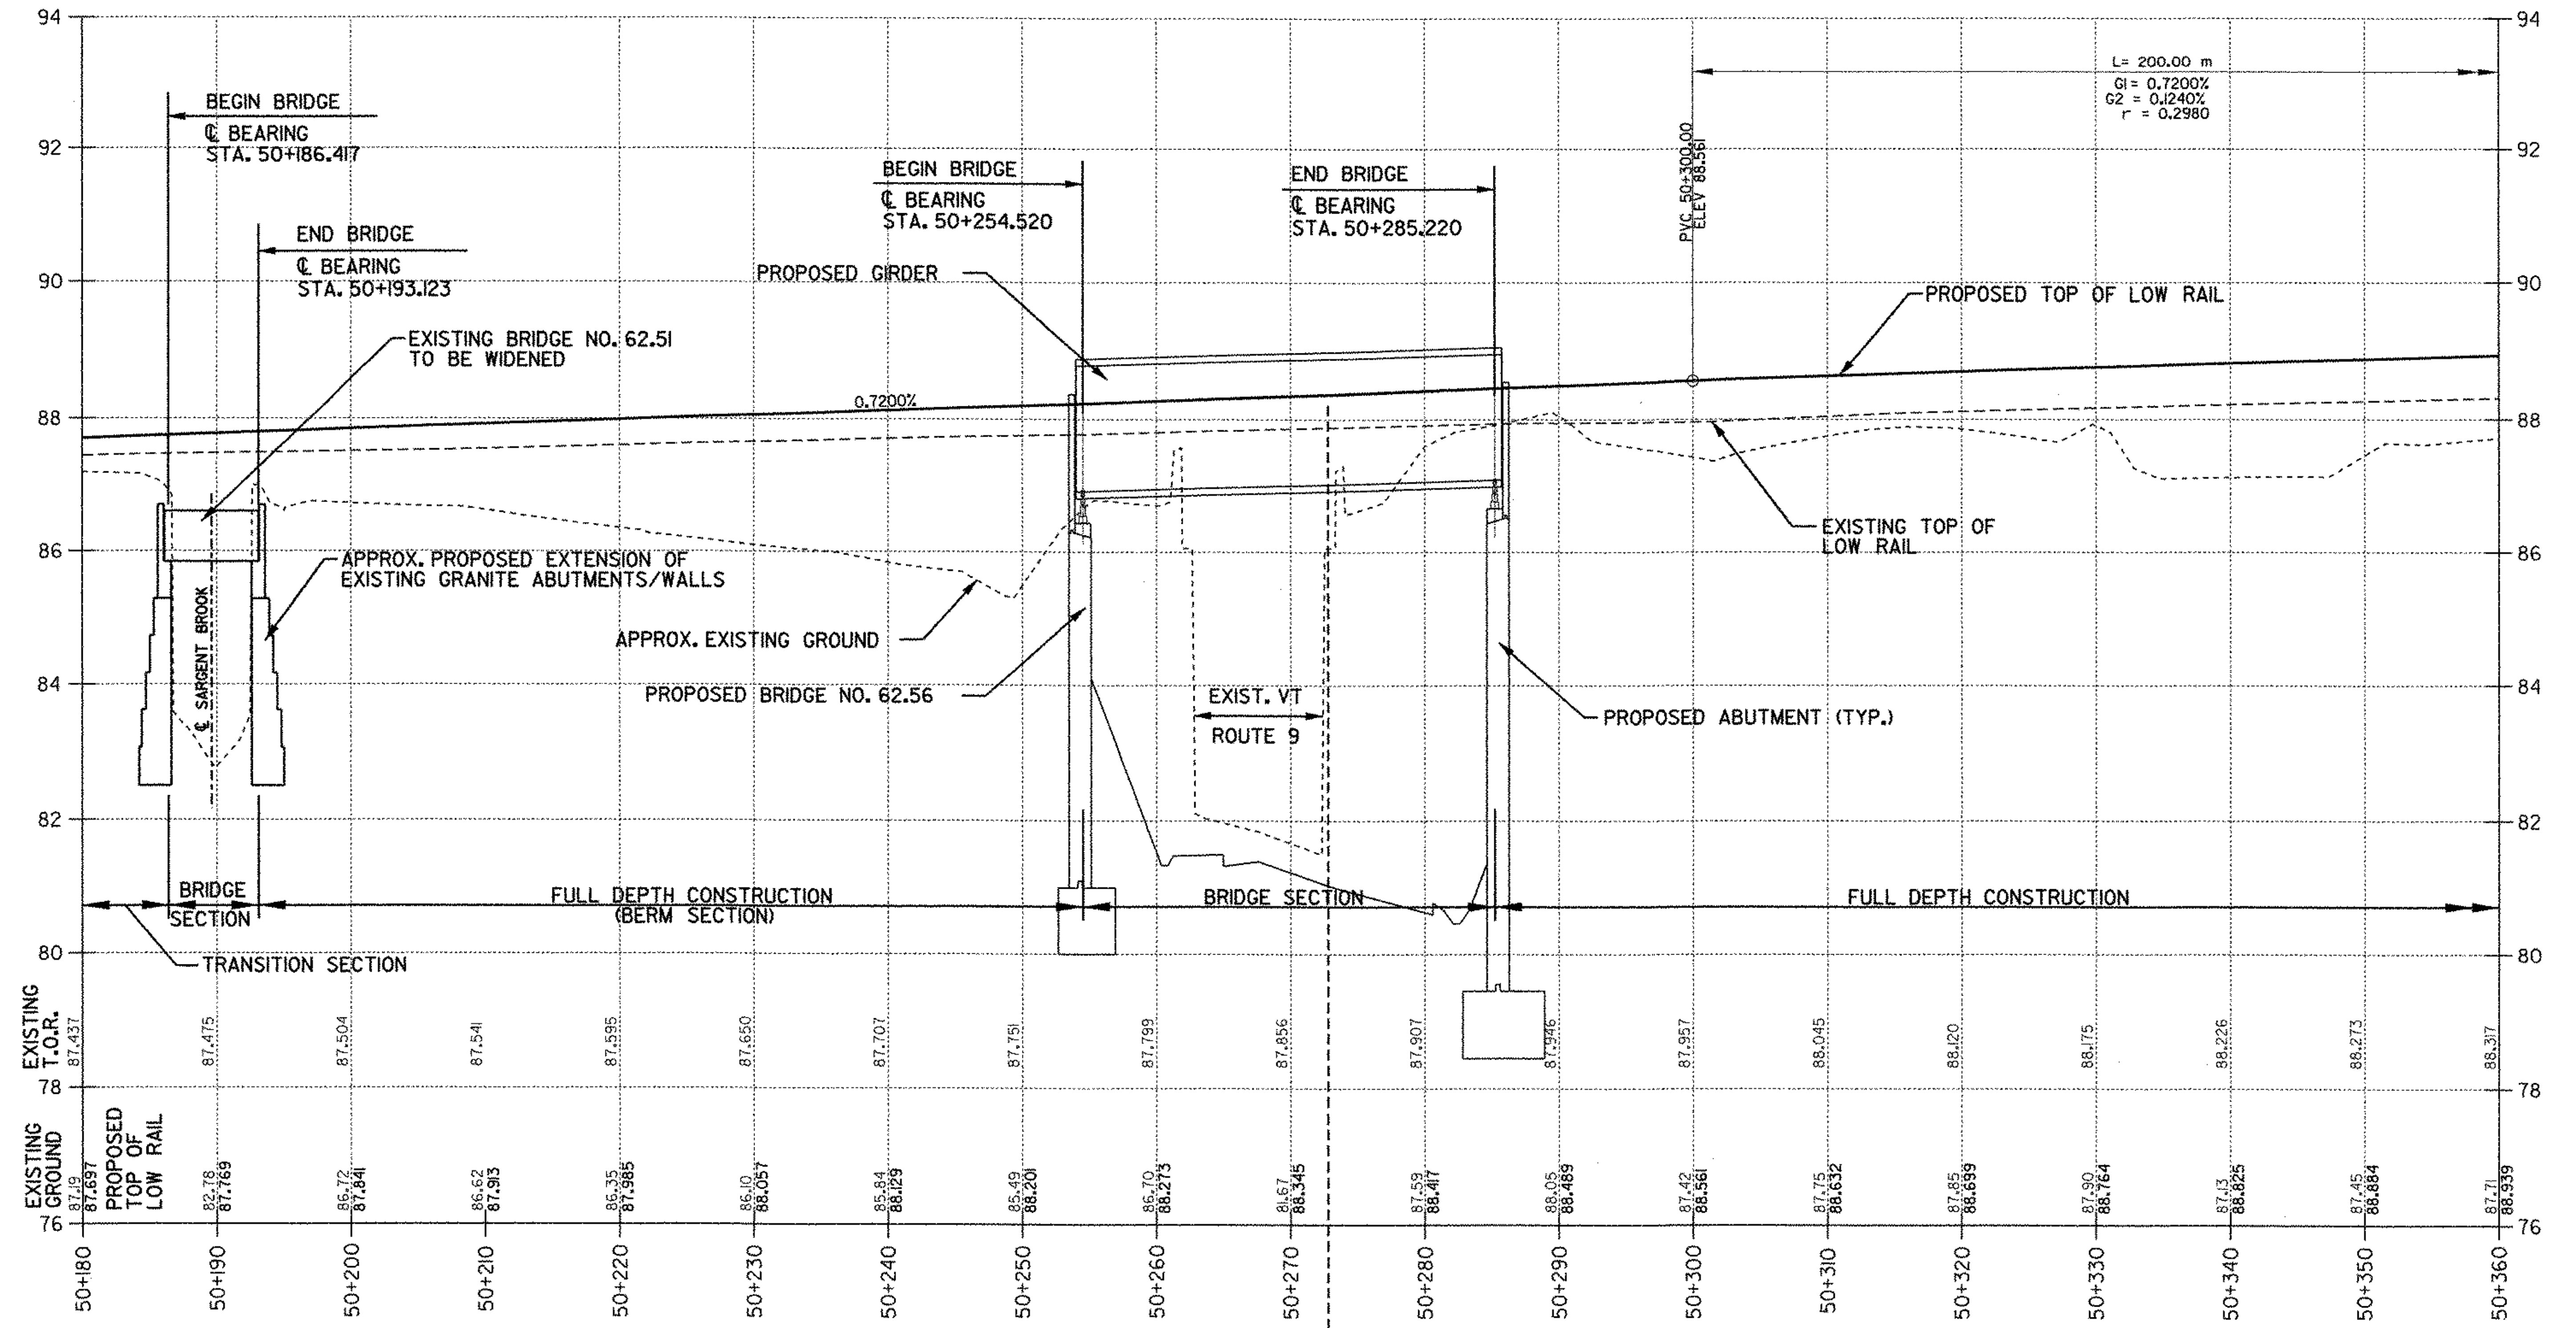

STA. 50+272.791 PROP. RAILROAD MAINLINE RELOCATION
 STA. 30+222.922 PROP. VERMONT ROUTE 9 HIGHWAY

DATUM
 VERTICAL _____
 HORIZONTAL _____


FEB 05 2003

SURVEYED BY N/A DATE N/A
 DRAWN BY LB/LRD DATE _____
 SQUAD LEADER JHR
 DESIGN FILE NO. 95b270\structures\sb270xsl.dgn
 IPARM FILE sb270rrp2.l DATE PLOTTED 09-MAR-2001

BRATTLEBORO
 NH BR F 012-(K33)
 R.O.W. SHEET 8 OF 27 SHEETS

7.17 Row

RAILROAD PROFILE

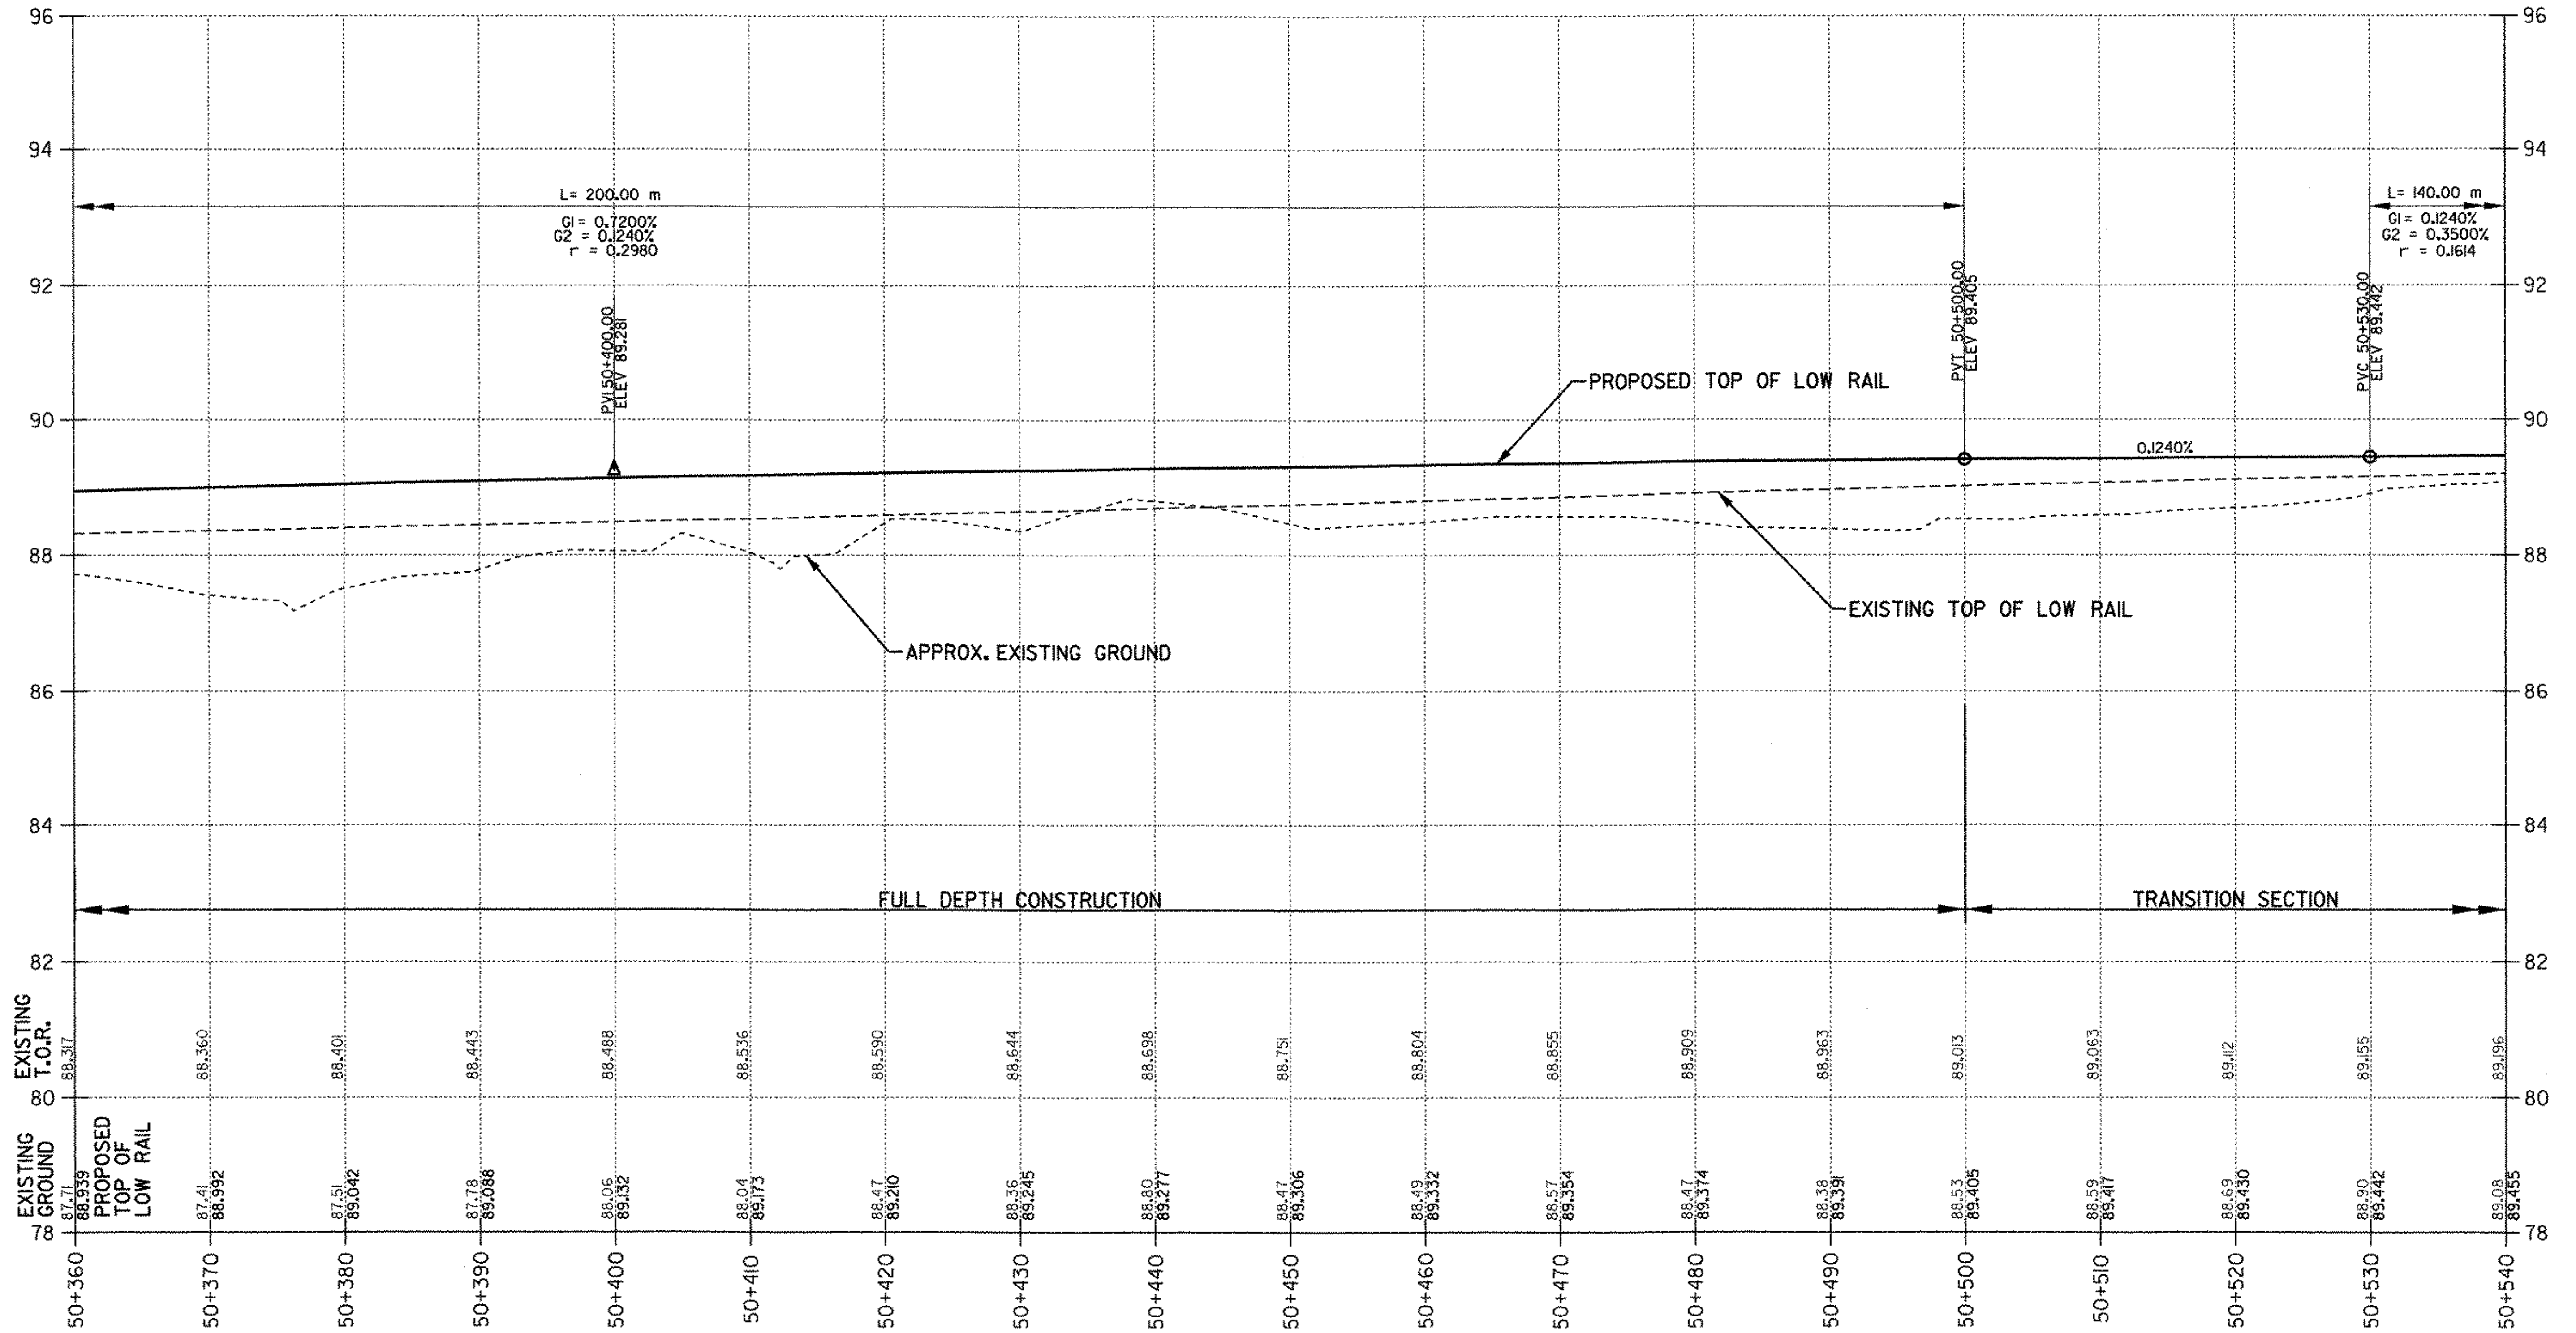


FEB 05 2003

DATUM
 VERTICAL _____
 HORIZONTAL _____

SURVEYED BY N/A DATE N/A
 DRAWN BY LB/LRD DATE _____
 SQUAD LEADER JHR
 DESIGN FILE NO. 95b270\structures\eb270xsl.dgn
 PARM FILE eb270rpp3.i DATE PLOTTED 09-MAR-2001
BRATTLEBORO
NH BR F 012-(K33)
 R.O.W. SHEET 9 OF 27 SHEETS

218 Row

RAILROAD PROFILE

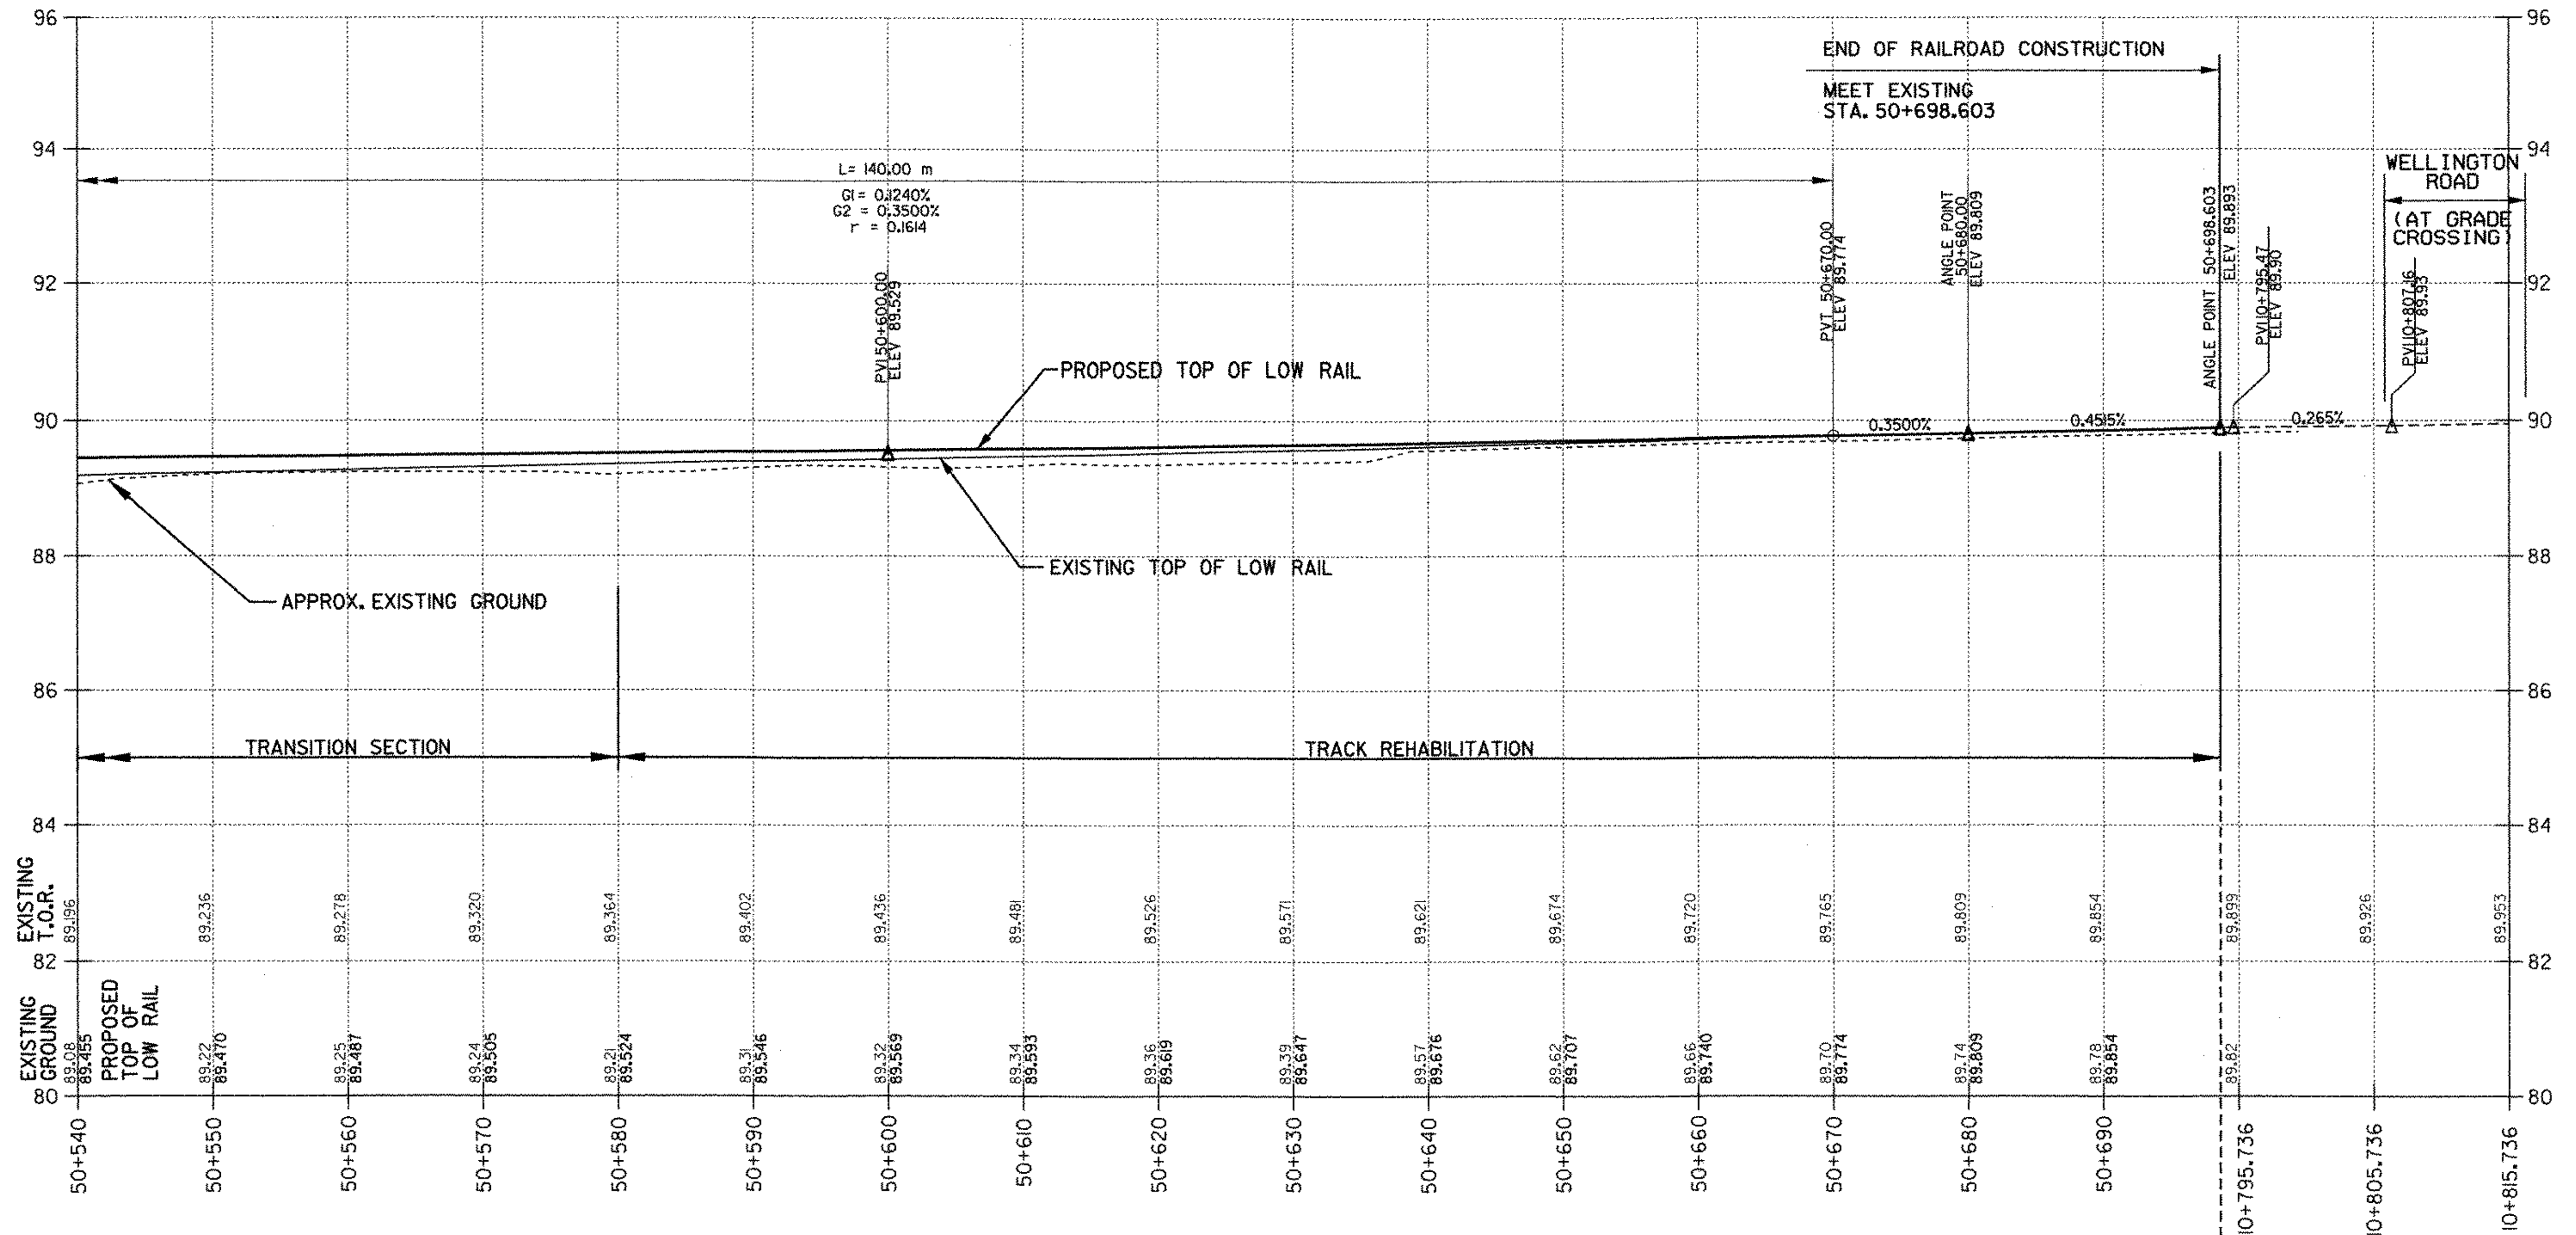

STA. 50+698.603 PROP. RR MAINLINE RELOCATION
 STA. 10+794.364 EXISTING RR MAINLINE




DATUM
 VERTICAL _____
 HORIZONTAL _____

SURVEYED BY N/A DATE N/A
 DRAWN BY LB/LRD DATE _____
 SQUAD LEADER JHR
 DESIGN FILE NO. 95b270\structurees\sb270xsl.dgn
 PARM FILE sb270rrp4.l DATE PLOTTED 09-MAR-2001

FEB 05 2003


BRATTLEBORO
 NH BR F 012-1(33)
 R.O.W. SHEET 10 OF 27 SHEETS

219 ROW

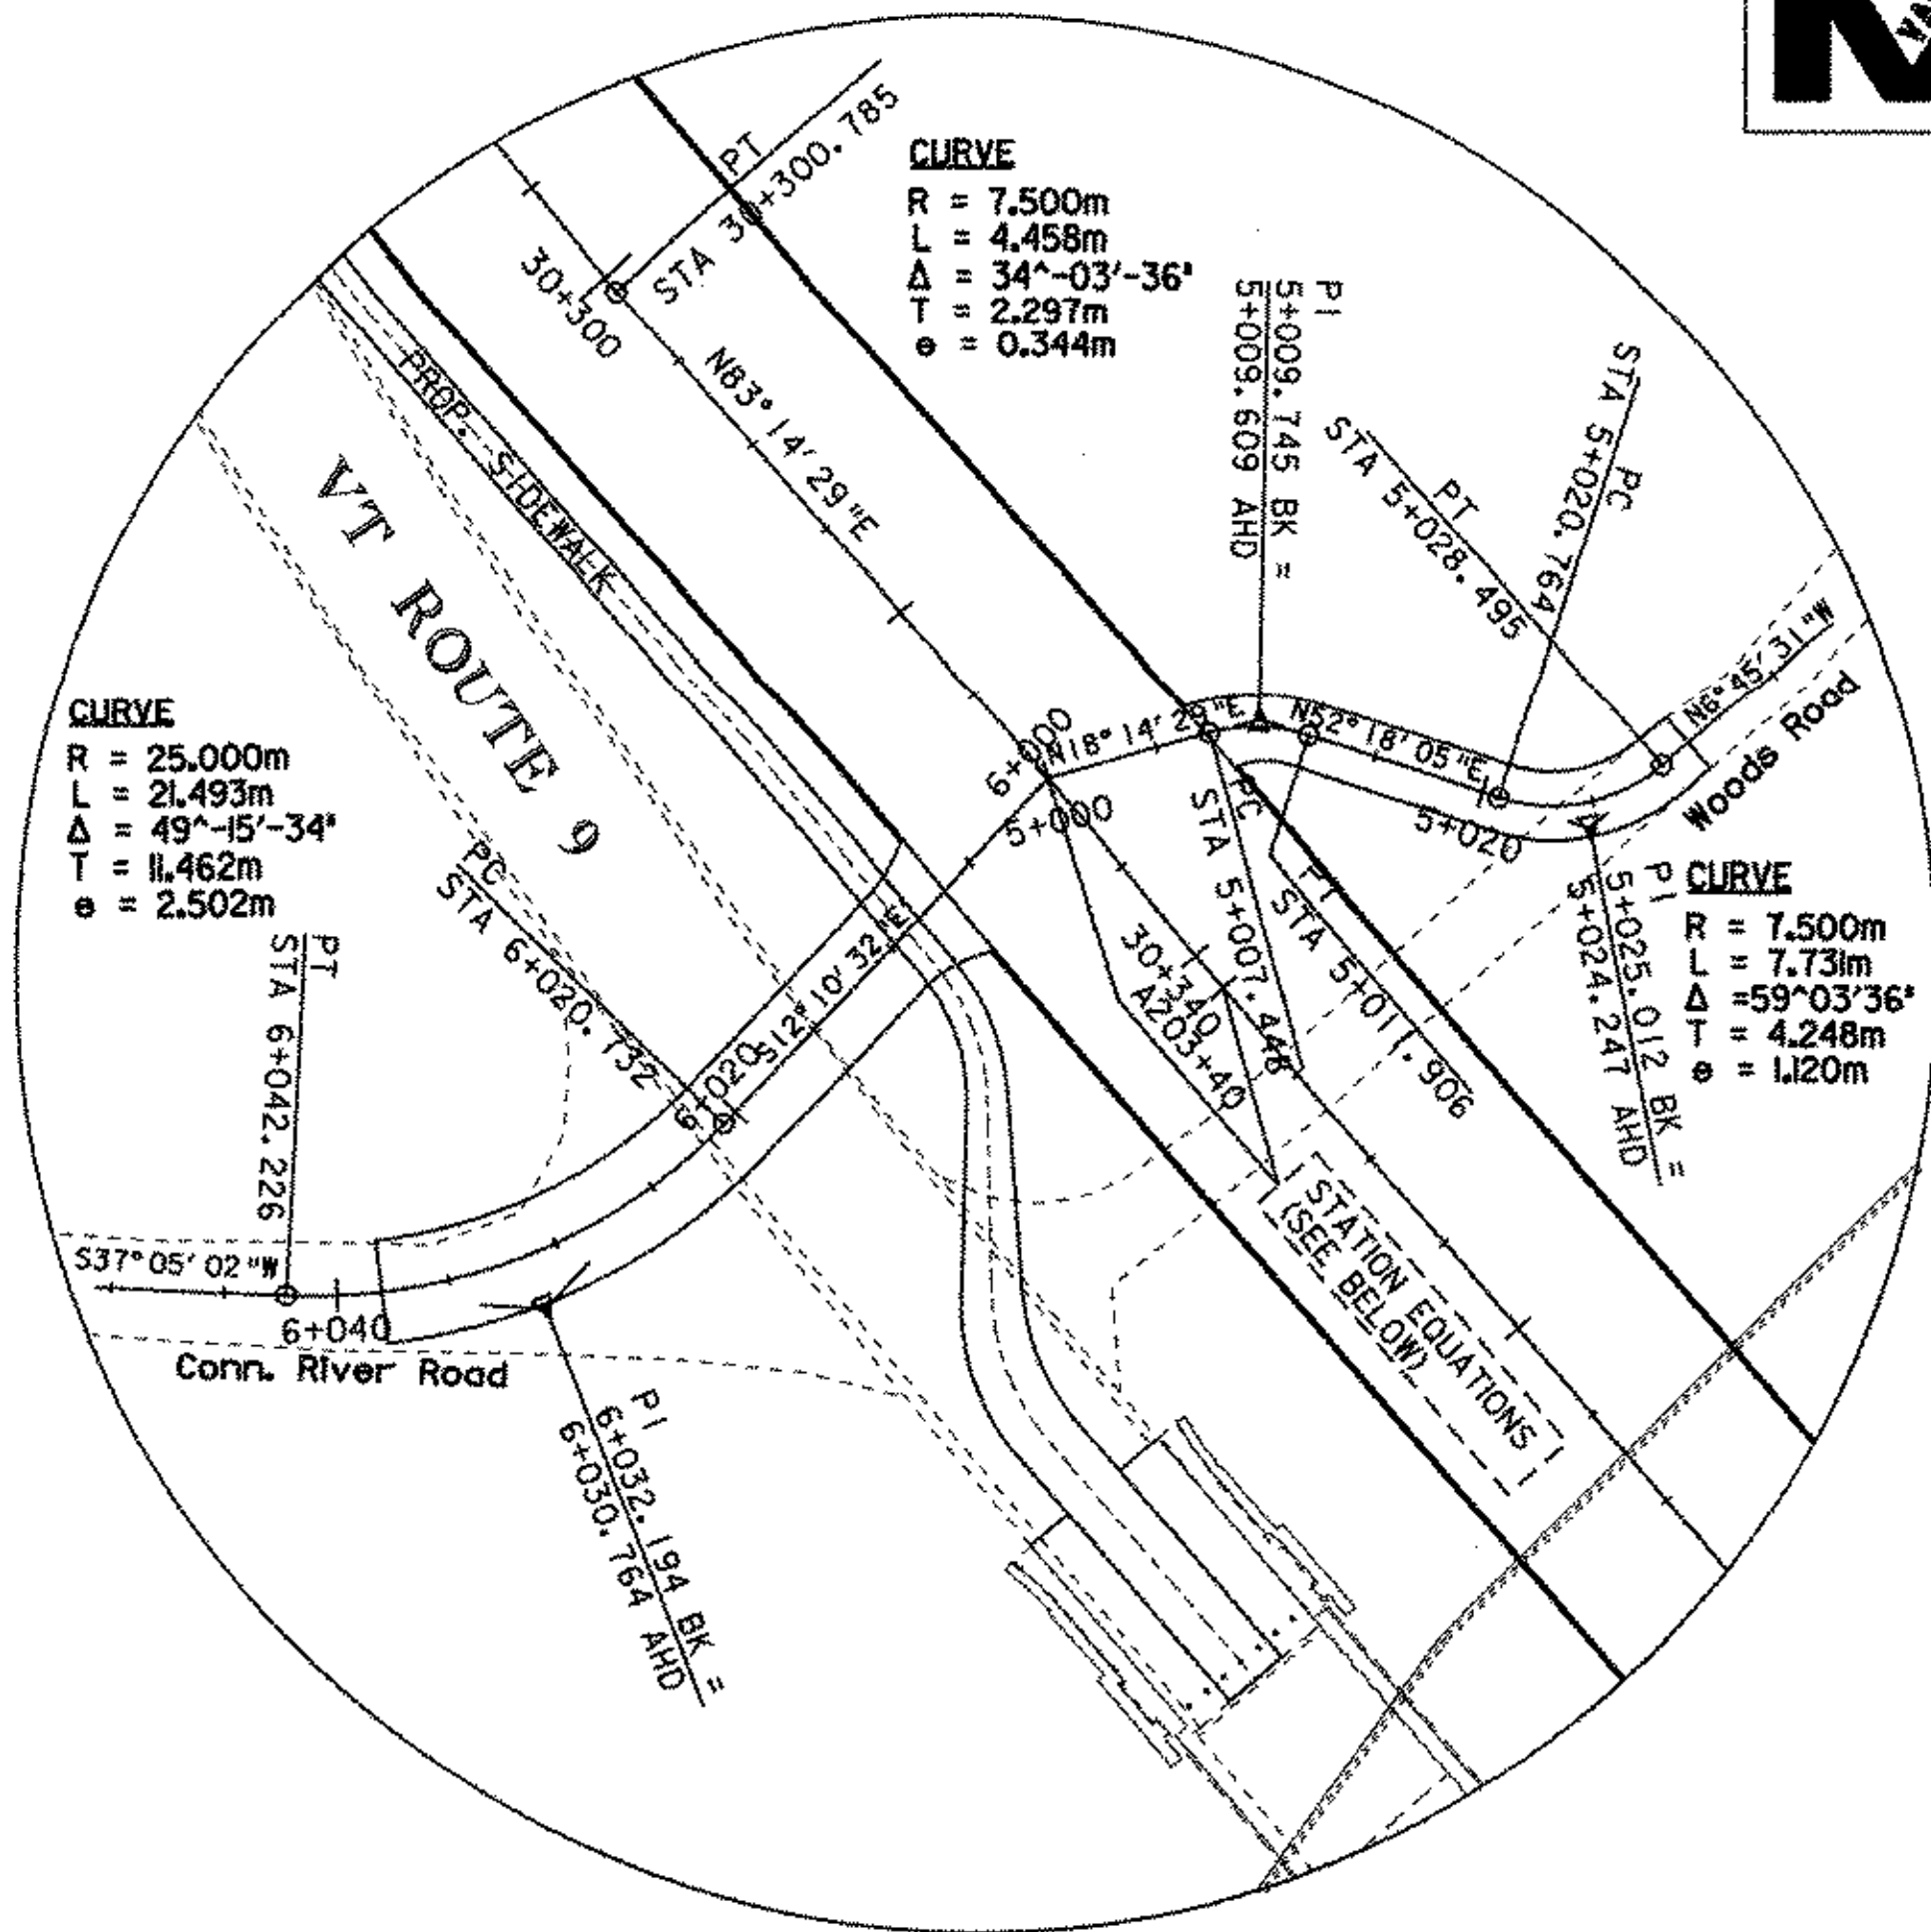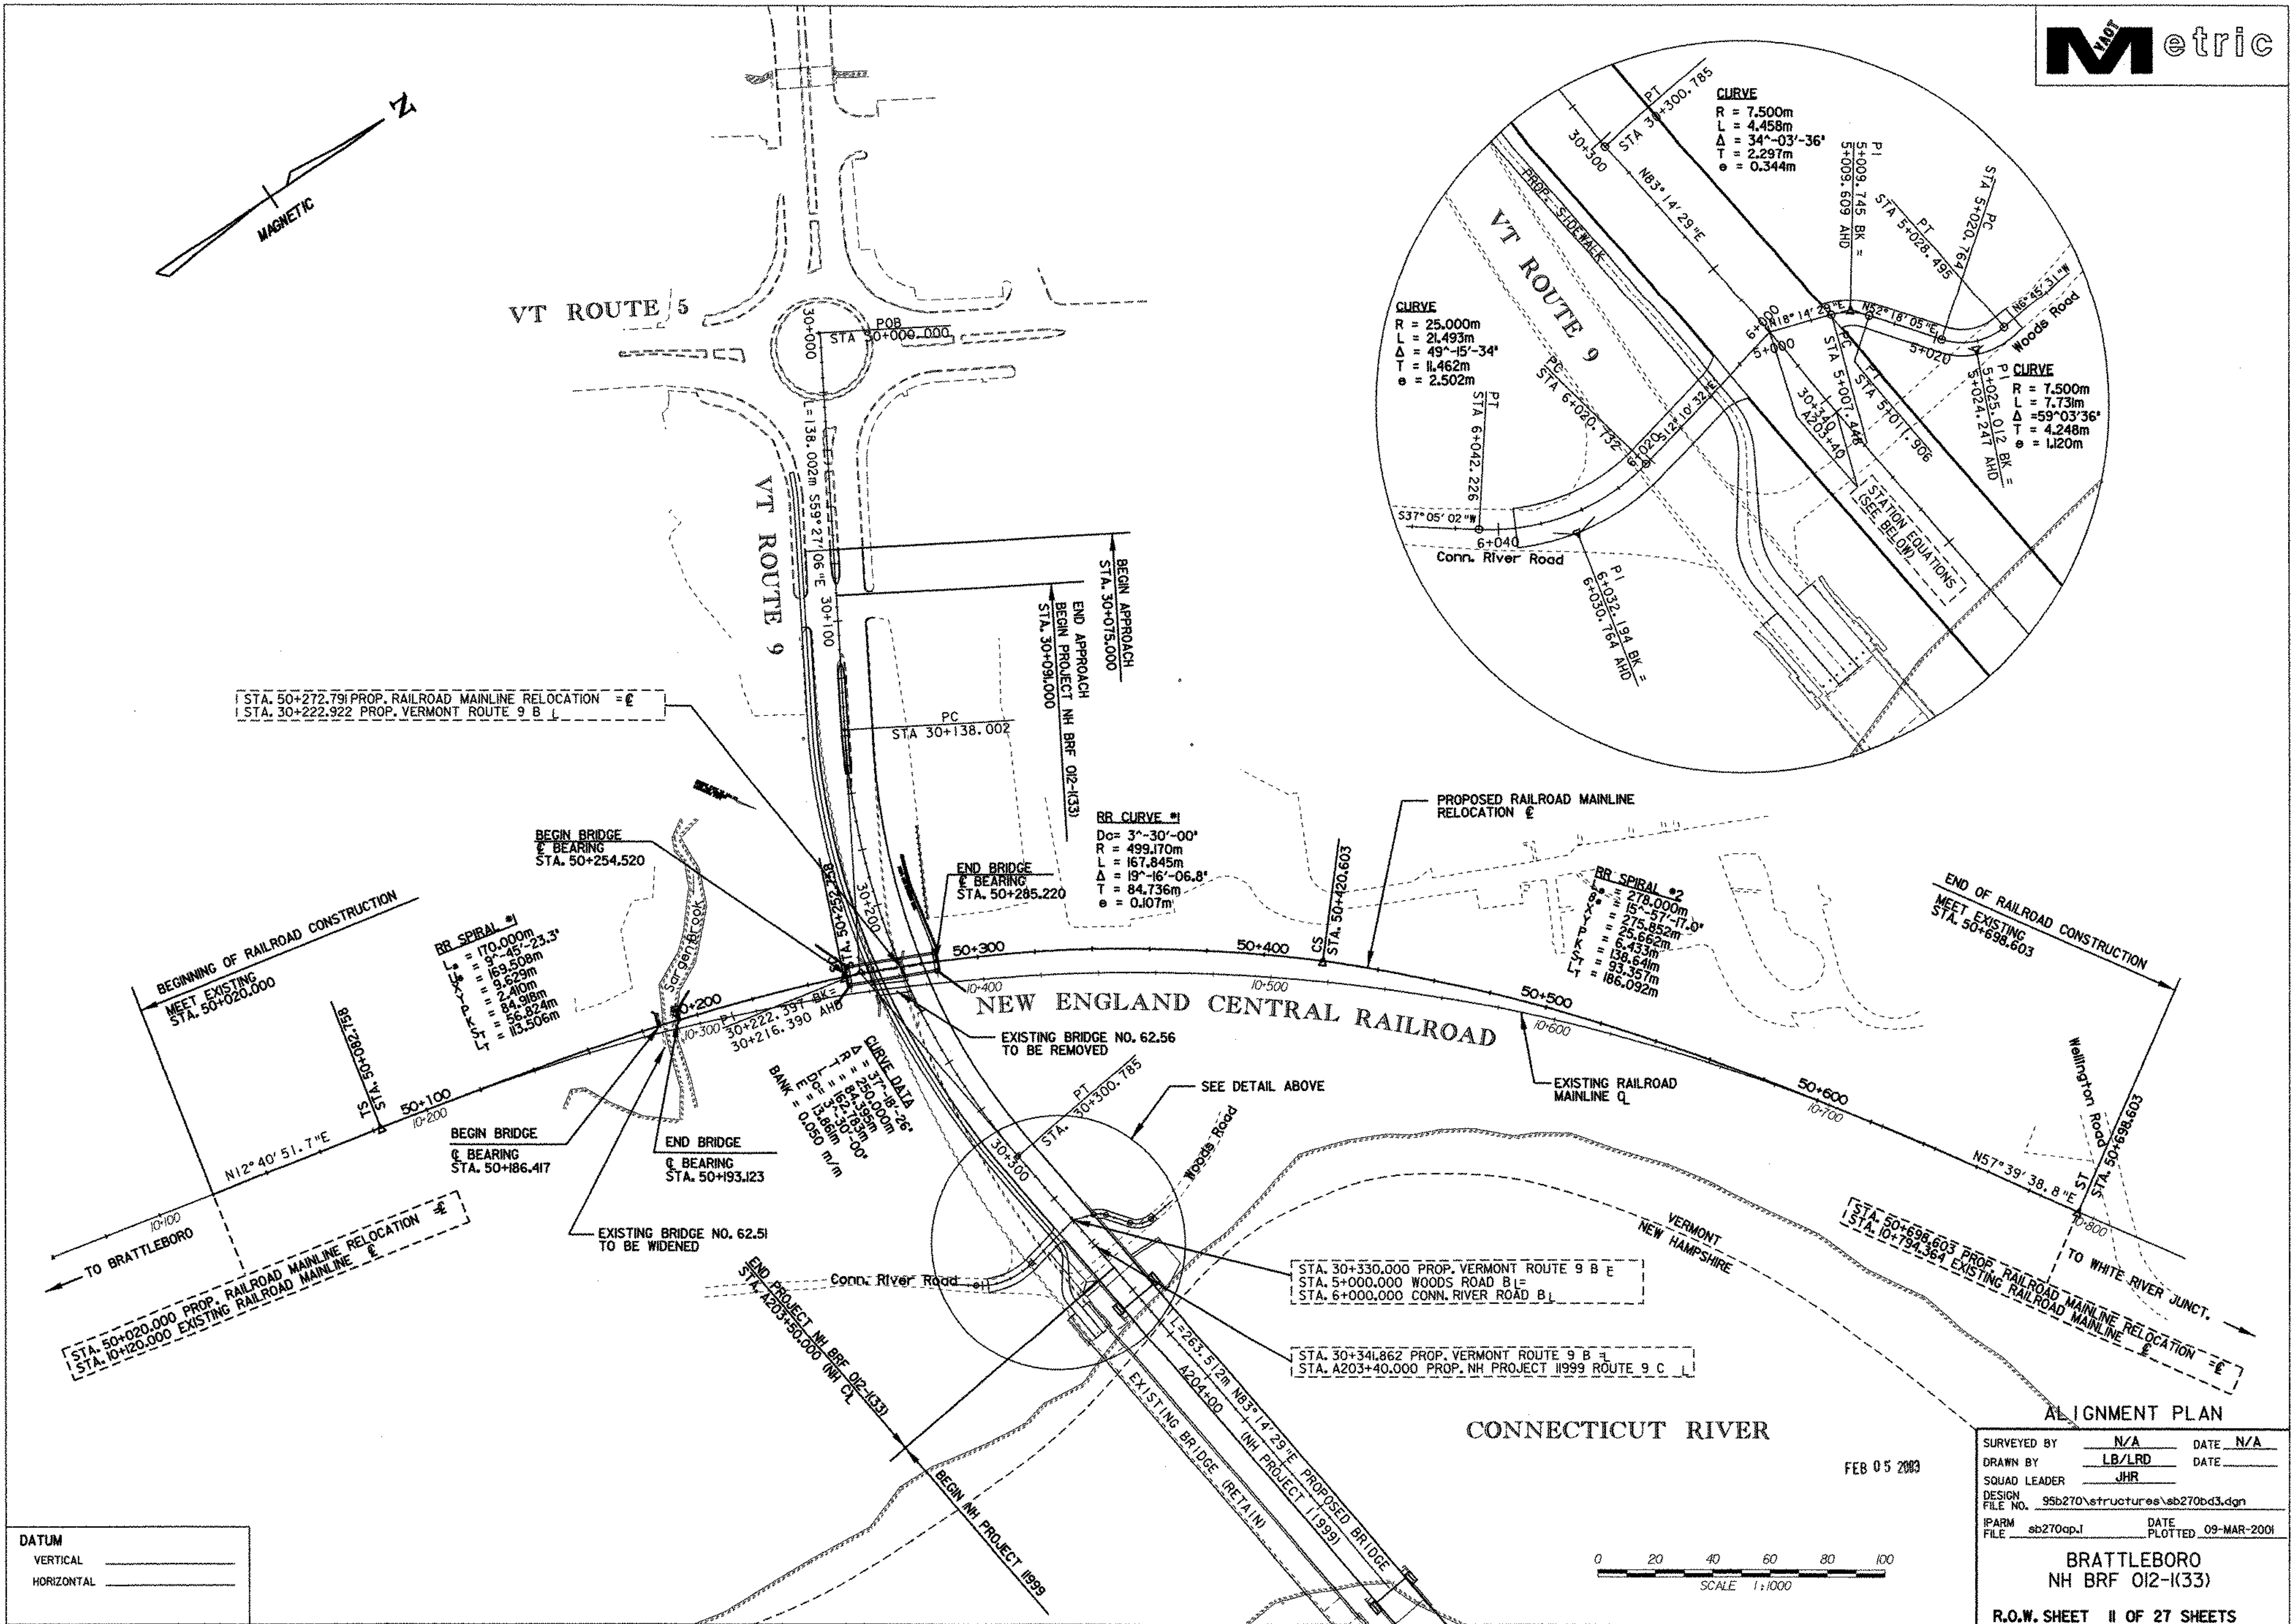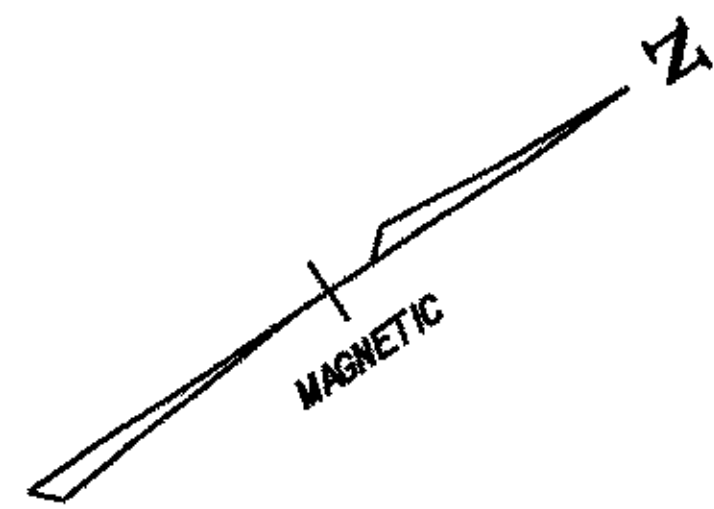

DATUM

VERTICAL	_____
HORIZONTAL	_____

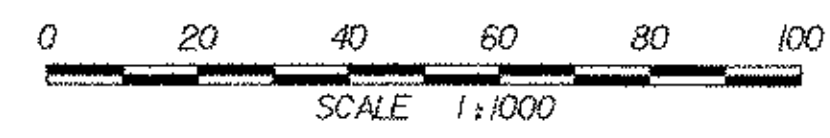


ALIGNMENT PLAN

SURVEYED BY	N/A	DATE	N/A
DRAWN BY	LB/LRD	DATE	
SQUAD LEADER	JHR	DATE	
DESIGN FILE NO.	95b270\structures\sb270bd3.dgn		
IPARM FILE	sb270cp.l	DATE PLOTTED	09-MAR-2001

BRATTLEBORO NH BRF 012-I(33)
 R.O.W. SHEET 11 OF 27 SHEETS

220 Row

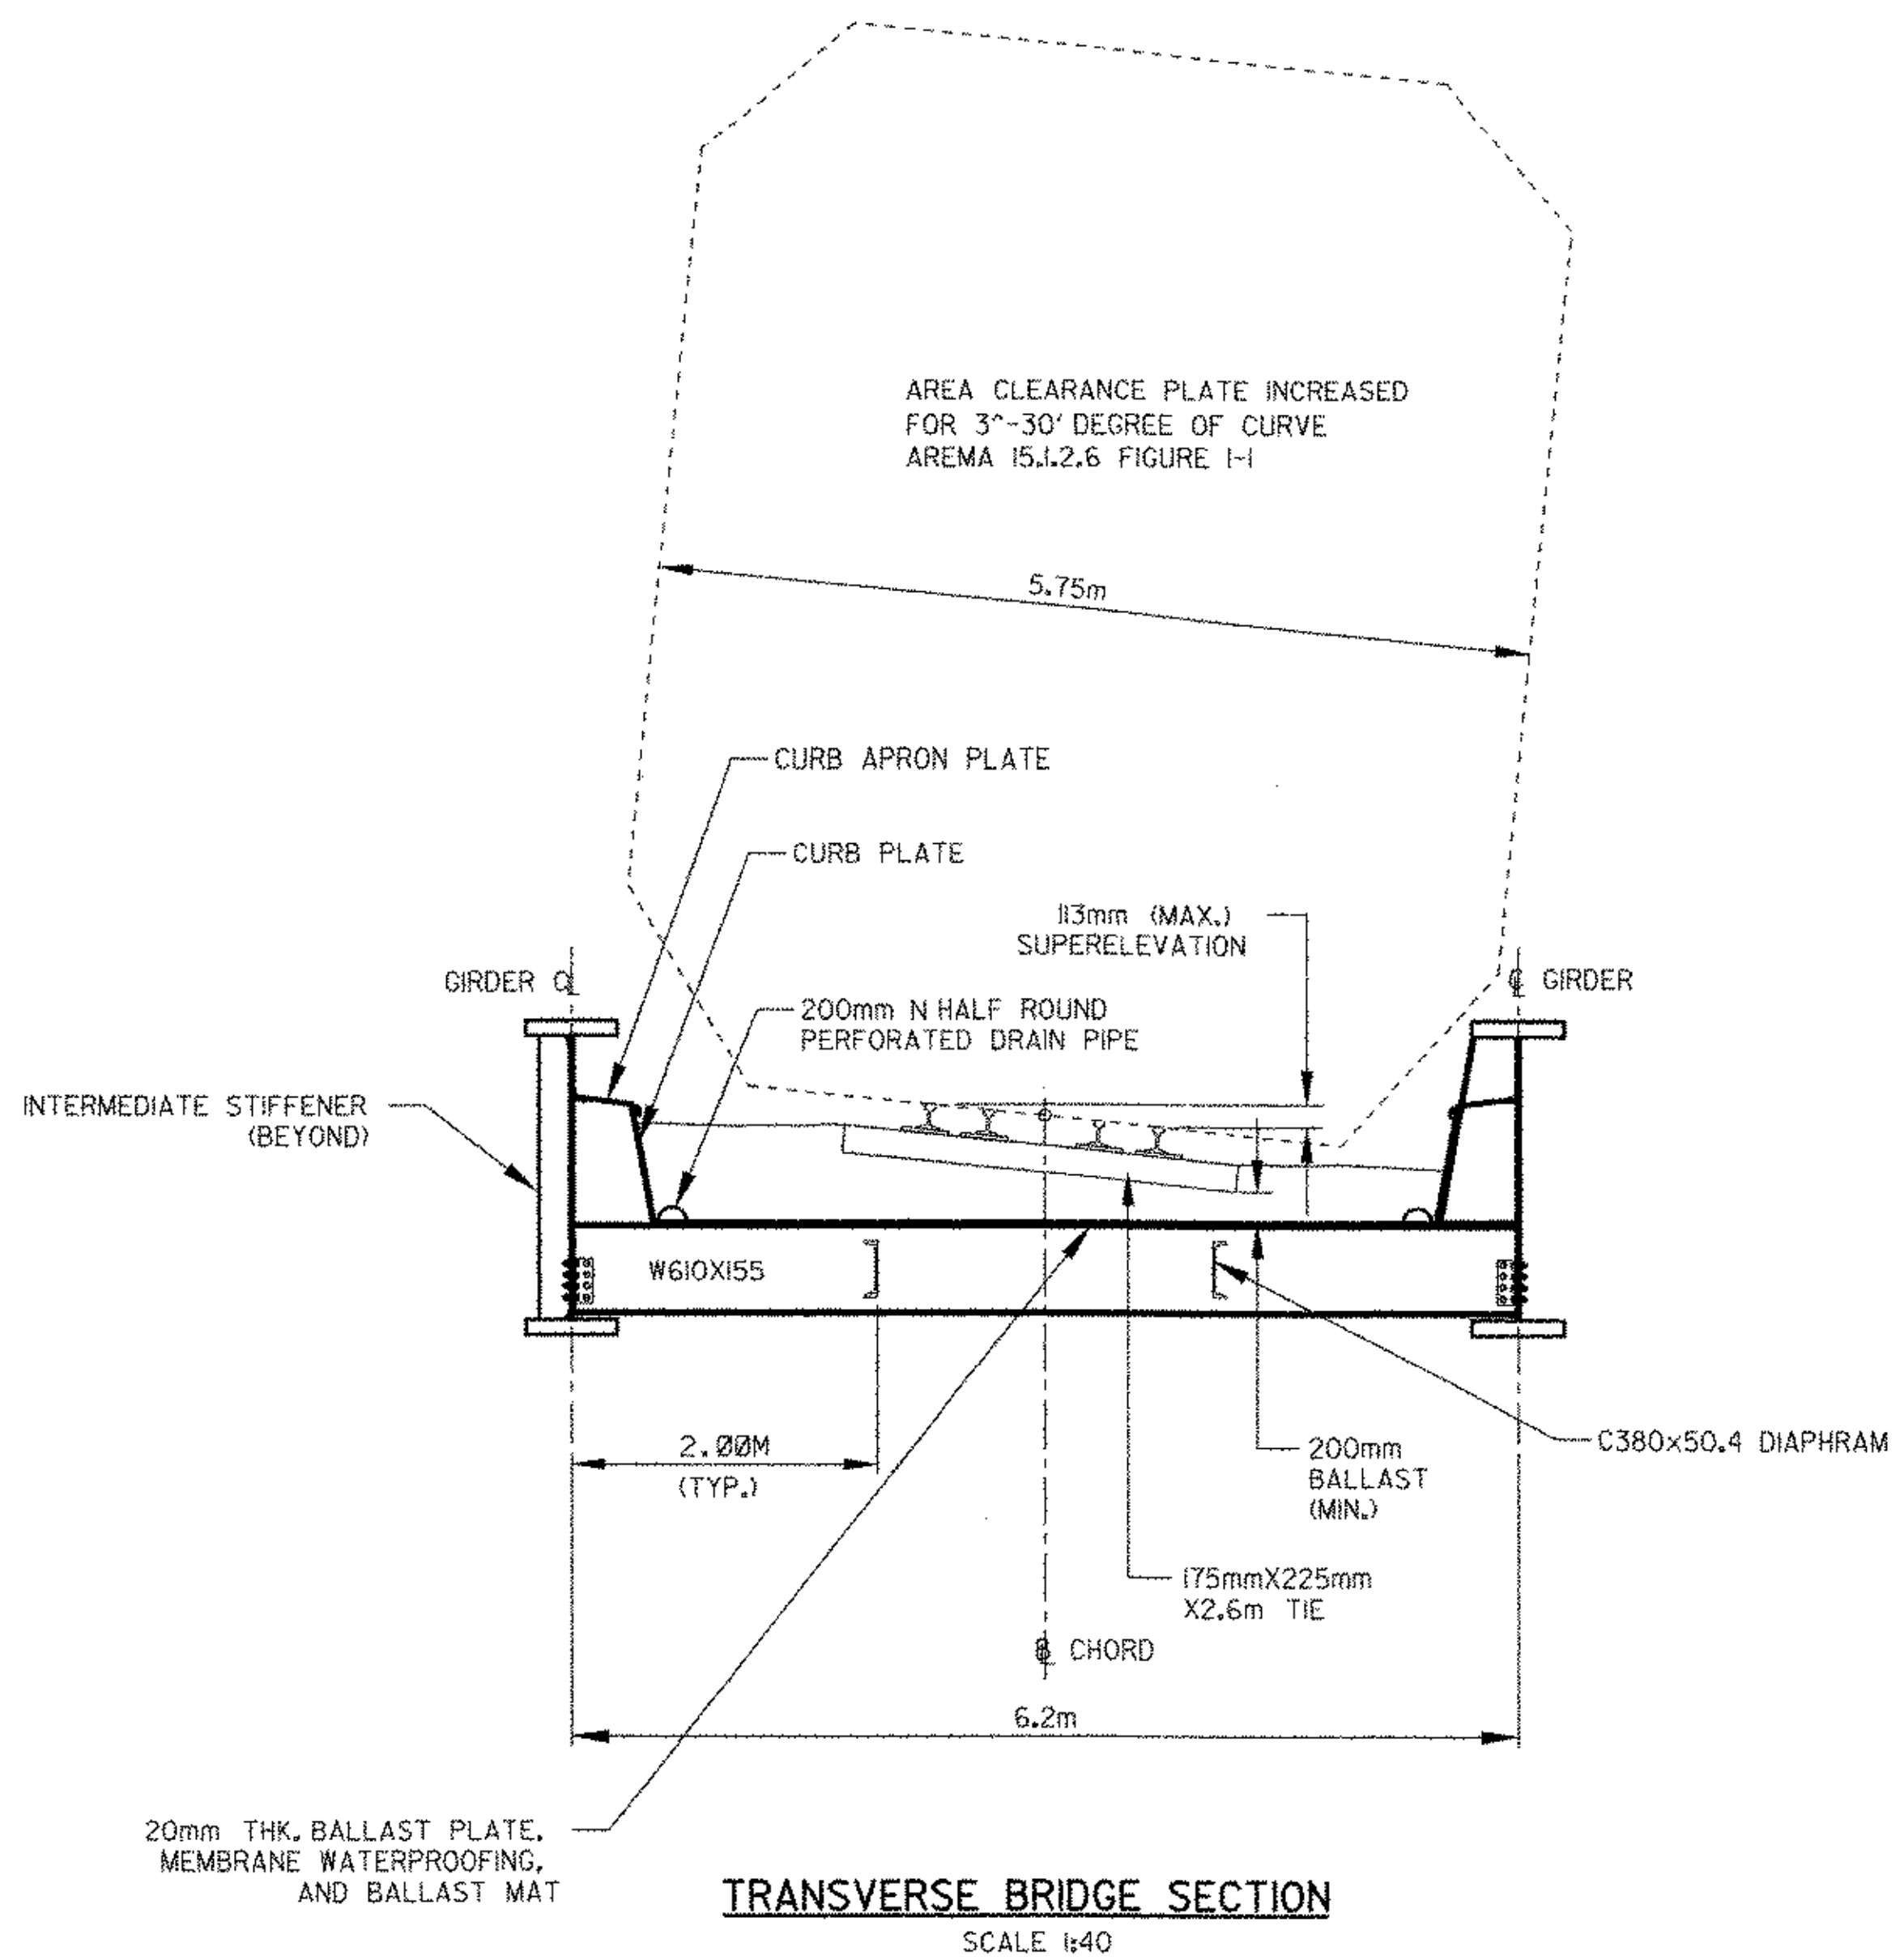

TRANSVERSE BRIDGE SECTION
SCALE 1:40

STRESS TABLE		
GIRDER	SPAN 30.7 meters	
	SHEARS (END OF BEAM)	MOMENTS (MIDSPAN)
DL	871 kN	7,327 kN-m
LL (E80)	1,344 kN	6,585 kN-m
IMP (40%)	537 kN	3,582 kN-m
CENTRIFUGAL	45 kN	343 kN-m
TOTAL	2,797 kN	17,837 kN-m

STRESS TABLE		
FLOOR BEAM	SPAN 6.2m	
	SHEARS (END OF BEAM)	MOMENTS (MIDSPAN)
DL	26.3 kN	41.7 kN-m
LL (E80)	132.6 kN	309.9 kN-m
IMP (50%)	68.0 kN	159.0 kN-m
CENTRIFUGAL	7.0 kN	n/a kN-m
TOTAL	234 kN	510.7 kN-m

PROPERTIES	
A _{web} = 47,625 mm ²	S _{x gross} = 1,323x10 ⁶ mm ³
I _{x gross} = 4,394x10 ⁸ mm ⁴	S _{x net} = 1,323x10 ⁶ mm ³
b _{web} = 1,384x10 ³ mm ⁴	

PROPERTIES	
A _{web} = 6780 mm ²	S _x = 4,220x10 ⁶ mm ³
I _x = 1,25x10 ⁸ mm ⁴	

STRESS		
SHEAR	BENDING (TENSION IN BOT. FLANGE)	DEFLECTION (LL+I)
f _s = 58,730 kPa	f _b = 164,870 kPa	Δ max = 45 mm
ALL f _s = 120,000 kPa	ALL f _b = 189,000 kPa	ALL Δ = 48 mm
	BENDING (COMPRESSION IN TOP FLANGE)	
	f _b = 163,580 kPa	
	ALL f _b = 187,900 kPa	

STRESS		
SHEAR	BENDING (TENSION IN BOT. FLANGE)	DEFLECTION (LL+I)
f _s = 34,760 kPa	f _b = 153,900 kPa	Δ max = 7 mm
ALL f _s = 120,000 kPa	ALL f _b = 189,000 kPa	ALL Δ = 9 mm
	BENDING (COMPRESSION IN TOP FLANGE)	
	f _b = 120,870 kPa	
	ALL f _b = 162,300 kPa	

FATIGUE (FRACTURE CRITICAL)	
(BASE METAL & WELD METAL FLANGE TO WEB CONNECTION)	BENDING
Max LL, IMP (mean) =	79,833 kPa
STRESS RANGE	79,833 kPa
STRESS CATEGORY	B
ALLOW. STRESS RANGE	10,000 kPa

FATIGUE	
(BASE METAL BOT. FLANGE)	BENDING
Max LL, IMP (mean) =	151,300 kPa
STRESS RANGE	151,300 kPa
STRESS CATEGORY	A
ALLOW. STRESS RANGE	165,500 kPa

PROPOSED STRUCTURE	
STRUCTURE GEOMETRY:	
1. STRUCTURE TYPE	SINGLE SPAN HALF-THRU GIRDER
2. CLEAR SPAN LENGTHS:	29.5 meters
3. VERTICAL CLEARANCE ABOVE ROADWAY:	4.95 meters
4. ARE PROVISIONS TO BE MADE FOR PUBLIC UTILITIES?	N/A
EXISTING STRUCTURE	
1. STRUCTURE TYPE:	SINGLE SPAN STEEL DECK GIRDER YEAR BUILT: 1937
2. CLEAR SPAN (NORMAL TO ROADWAY):	9.9 meters
3. VERTICAL CLEARANCE ABOVE ROADWAY:	4.35 meters

DESIGN CRITERIA:	
1. DESIGN LIVE LOAD AREA	E80
2. DESIGN SPAN	6 TO Q BRG. 30.7m
3. ALLOWABLE LOAD FOR SPREAD FOOTINGS ON SOIL	TO - 88 kPa ON LEDGE 950 kPa
4. ALLOWABLE LOAD FOR PILING	N/A TYPE N/A ESTIMATED LENGTH N/A
5. ALLOWABLE STRESS FOR STRUCTURAL STEEL AASHTO	M210M GR 345 WEATHERING STEEL TENSION 186 MPa
6. ALLOWABLE STRESS FOR REINFORCING STEEL AASHTO	M31M GRADE 400 TENSION 165 MPa COMPRESSION 138 MPa
7. ALLOWABLE STRESS FOR CONCRETE CLASS A	f _c 30 MPa f _t NA
	CLASS B f _c 25 MPa f _t NA
	SILICA FUME f _c 35 MPa f _t NA

FEB 05 2003

**STATE OF VERMONT
AGENCY OF TRANSPORTATION**

Town Of	BRATTLEBORO	Bridge No.	62.56
Highway No.	VT. ROUTE 9	Log Sta.	
		Surv. Sta.	
NEW ENGLAND CENTRAL RAILROAD OVER VT. ROUTE 9			

PRELIMINARY INFORMATION			
Designed By	LM	Drawn By	DHL
Checked By	GJB	Date	
		Bridge Design Supervisor	JHR
		Date	
PROJECT	BRATTLEBORO	PROJECT NO.	NH BRF 012-(K33)
I.G.C. Info.			

95b270\structures\rt9br302.dgn
rt9br302.l 09-MAR-2001

221 Row

HYDRAULICS REPORT

HYDRAULIC DATA

1. DRAINAGE AREA 14.2 km²
 2. CHARACTER OF TERRAIN SMALL MOUNTAINS
 3. CHARACTER AND TYPE OF STREAM ALLUVIAL RANDOM VARIATION IN WIDTH
 4. NATURE OF STREAMBED SAND/GRAVEL BOTTOM
 Q2.33 = 6 m³/s Q50 = 30.5 m³/s
 Q10 = 18 m³/s Q100 = 35.5 m³/s
 Q25 = 25.5 m³/s Q500 = 48 m³/s
 5. DATE OF FLOOD OF RECORD UNKNOWN
 6. WATER SURFACE ELEVATION NA ESTIMATED DISCHARGE NA m³/s
 7. NATURAL STREAM VELOCITY @ Q 2.33 = 1.70 m/s
 8. ICE CONDITIONS LIGHT DEBRIS MODERATE TO HEAVY
 9. DOES THE STREAM REACH MAX. HIGHWATER ELEVATION RAPIDLY? YES, STREAM IS CONSIDERED FLASHY
 10. IS ORDINARY RISE RAPID? NO
 11. IS STAGE AFFECTED BY UPSTREAM/DOWNSTREAM CONDITIONS? YES
 IF YES, DESCRIBE: AT GREATER THAN Q2.33 THE WATER OVER FLOWS STREAM BANKS AND TRAVELS ACROSS WETLANDS TO ADJACENT ROUTE 9
 12. WATERSHED STORAGE < 1/2 HEADWATERS UNIFORM THROUGHOUT WATERSHED IMMEDIATELY ABOVE SITE ✓

PROPOSED STRUCTURE

STRUCTURE GEOMETRY:
 1. STRUCTURE TYPE EXISTING BRIDGE WITH DECK AND ABUTMENT CAP EXTENSION
 2. CLEAR SPAN LENGTH(S) 5.6 m
 3. VERTICAL CLEARANCE ABOVE STREAMBED: 3.14 m
 4. ARE PROVISIONS TO BE MADE FOR PUBLIC UTILITIES? NO
 HYDRAULIC DATA:
 1. WATERWAY AREA OF FULL OPENING (NORMAL TO STREAM): 18 m² NA m²/s
 2. WATER SURFACE ELEVATION @ Q 2.33 = 83.77 m VELOCITY = 1.70 m/s
 Q 10 = 84.68 m = 2.68 m/s
 Q 25 = 85.07 m = 3.66 m/s
 Q 50 = 85.32 m = 3.90 m/s
 Q 100 = 85.55 m = 4.8 m/s
 3. IS THE ROADWAY OVERTOPPED BELOW THE Q100? YES FREQUENCY: Q2.5
 4. RELIEF ELEVATION: 84.25 DISCHARGE OVER ROAD @ Q100: 27 m³/s
 5. AVERAGE LOW ELEVATION OF SUPERSTRUCTURE: 85.83 m
 6. VERTICAL CLEARANCE @ Q 80 = 0.73 m
 7. SCOUR: TO BE ADDRESSED IN FINAL HYDRAULIC REPORT
 8. REQUIRED CHANNEL PROTECTION: TO BE ADDRESSED IN FINAL HYDRAULIC REPORT. ANTICIPATED STONE FILL.

PERMIT INFORMATION

AVERAGE DAILY FLOW: NA
 ORDINARY LOW WATER: NA DEPTH: NA
 ORDINARY HIGH WATER: NA DEPTH: NA
 NA = NOT AVAILABLE

TRAFFIC DATA

FUNCTIONAL CLASSIFICATION MINOR ARTERIAL
 2002 ADT = N/A
 2022 ADT = N/A
 2022 ADTT = N/A
 2002 DHV = N/A
 2022 DHV = N/A
 D = N/A
 T = N/A
 V = N/A
 2002-2022 18 KIP ESAL = N/A
 2002-2042 18 KIP ESAL = N/A

TEMPORARY BRIDGE REQUIREMENTS

1. STRUCTURE TYPE NO TEMPORARY STRUCTURE
 2. CLEAR SPAN LENGTH(S) NORMAL TO STREAM: N/A
 3. VERTICAL CLEARANCE ABOVE STREAMBED: N/A
 4. WATERWAY AREA OF FULL OPENING (NORMAL TO STREAM): N/A
 NA = NOT APPLICABLE

NOTE:
 TRAFFIC MAINTENANCE:
 1. IS TRAFFIC TO BE MAINTAINED? YES IF YES, ON EXISTING STRUCTURE X OR ON TEMPORARY BRIDGE _____
 2. TEMPORARY BRIDGE REQUIREMENTS: ONE OR TWO WAY _____
 TRAFFIC CONTROL SIGNALS REQUIRED _____
 ARE SIDEWALKS REQUIRED? _____ IF SO, ON WHAT SIDE? _____
 STRUCTURE TYPE: _____

DESIGN CRITERIA:

1. DESIGN LIVE LOAD AREA E80
 2. DESIGN SPAN 6m
 3. ALLOWABLE LOAD FOR SPREAD FOOTINGS ON SOIL NA ON LEDGE 950kPa
 4. ALLOWABLE LOAD FOR PILING NA TYPE NA ESTIMATED LENGTH NA
 5. ALLOWABLE STRESS FOR STRUCTURAL STEEL AASHTO M270M OR 345 WEATHERING STEEL TENSION 186 MPa
 6. ALLOWABLE STRESS FOR REINFORCING STEEL AASHTO M31M GRADE 400 TENSION TENSION 165 MPa COMPRESSION 138 MPa
 7. ALLOWABLE STRESS FOR CONCRETE CLASS A f_c 25 MPa f_t NA
 CLASS B f_c 25 MPa f_t NA
 SILICA FUME f_c 35 MPa f_t NA

FEB 05 2003

LOAD RATING (TONS)(LOAD FACTOR)

RATING						
INVENTORY						
POSTED						
OPERATING						

STATE OF VERMONT AGENCY OF TRANSPORTATION

Town Of BRATTLEBORO Bridge No. 62.51
 Highway No. VT. ROUTE 9 Log Sta. _____
 Surv. Sta. _____


NEW ENGLAND CENTRAL RAILROAD OVER SARGENT BROOK

PRELIMINARY INFORMATION

Designed By LM Drawn By DHL
 Checked By GJB Date _____ Bridge Design Supervisor JHR Date _____

PROJECT BRATTLEBORO PROJECT NO. NH BRF 012-1K33
 I.G.C. Info. _____


R.O.W. SHEET 13 OF 27 SHEETS

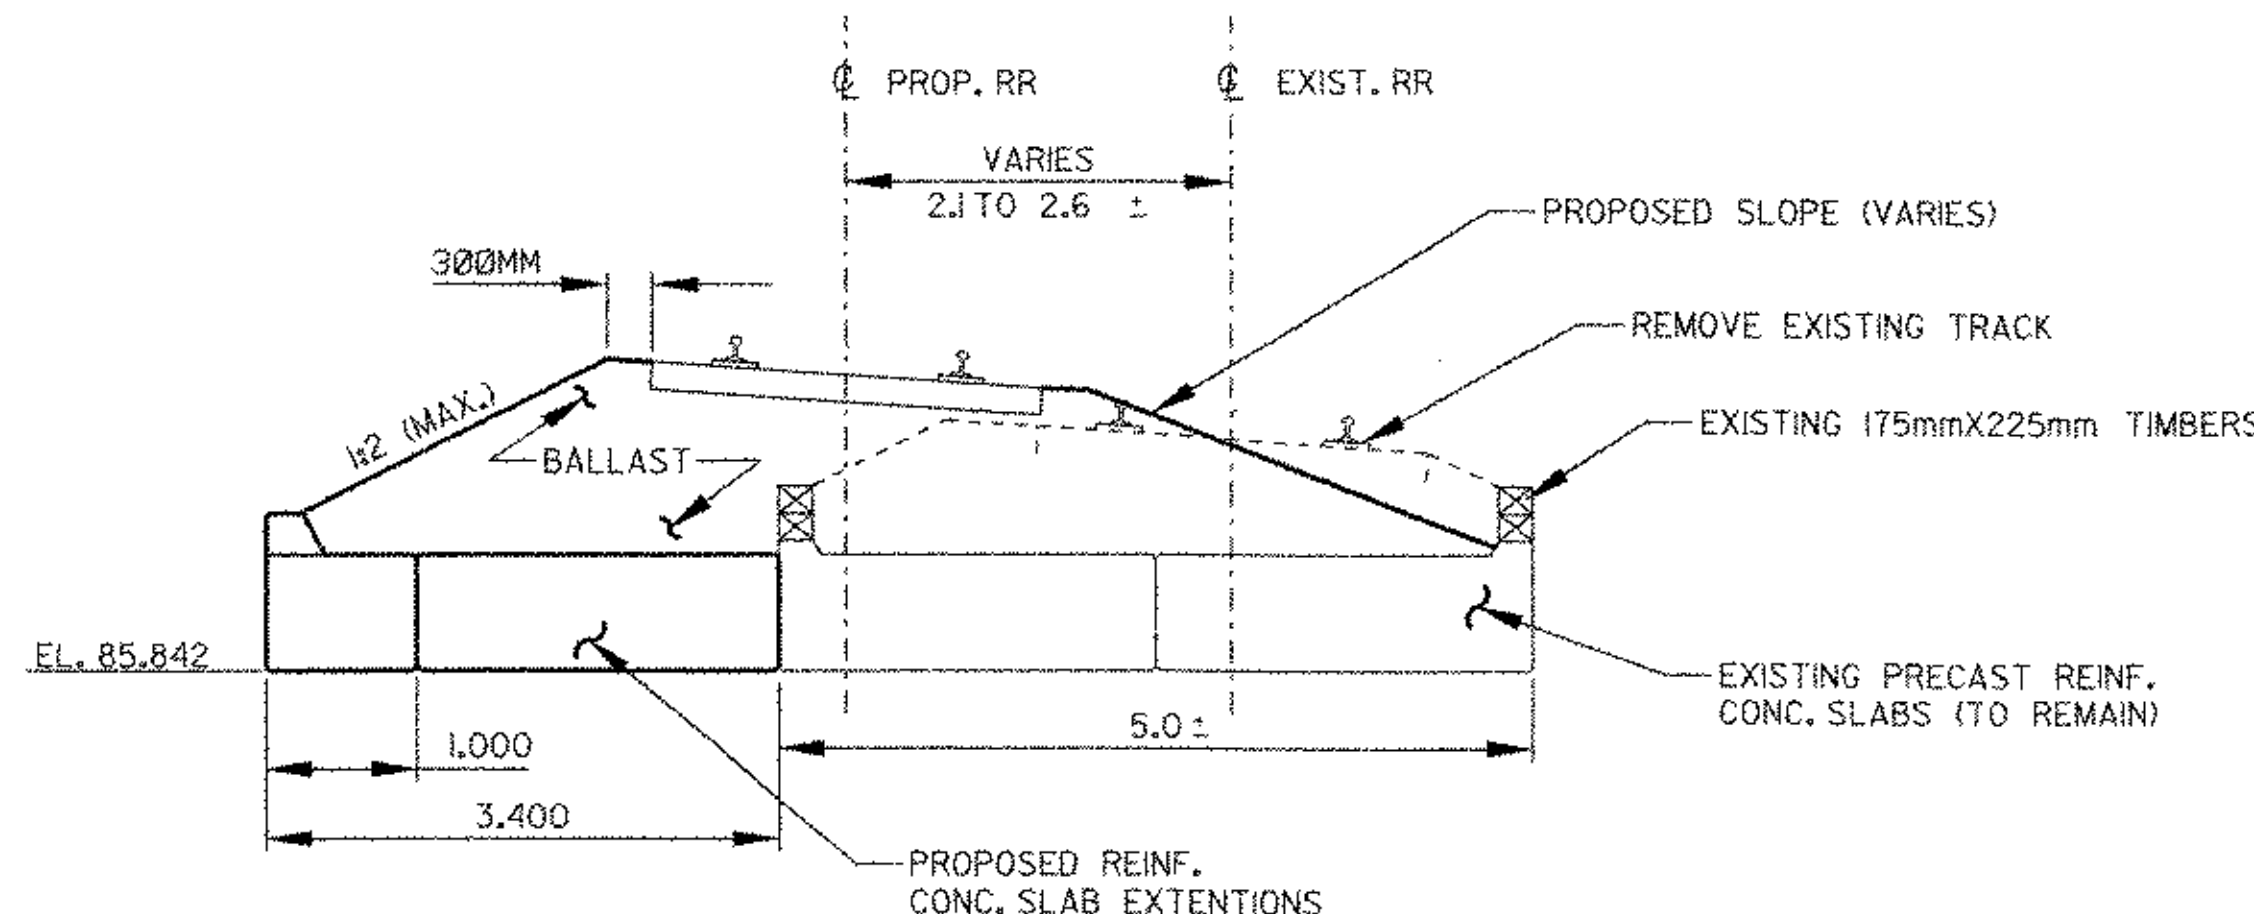

TYPICAL BRIDGE SECTION
 SARGENT BROOK


SCALE 1:50

95b270\structures\sgtbr302.dgn
 sgtbr302.i 09-MAR-2001

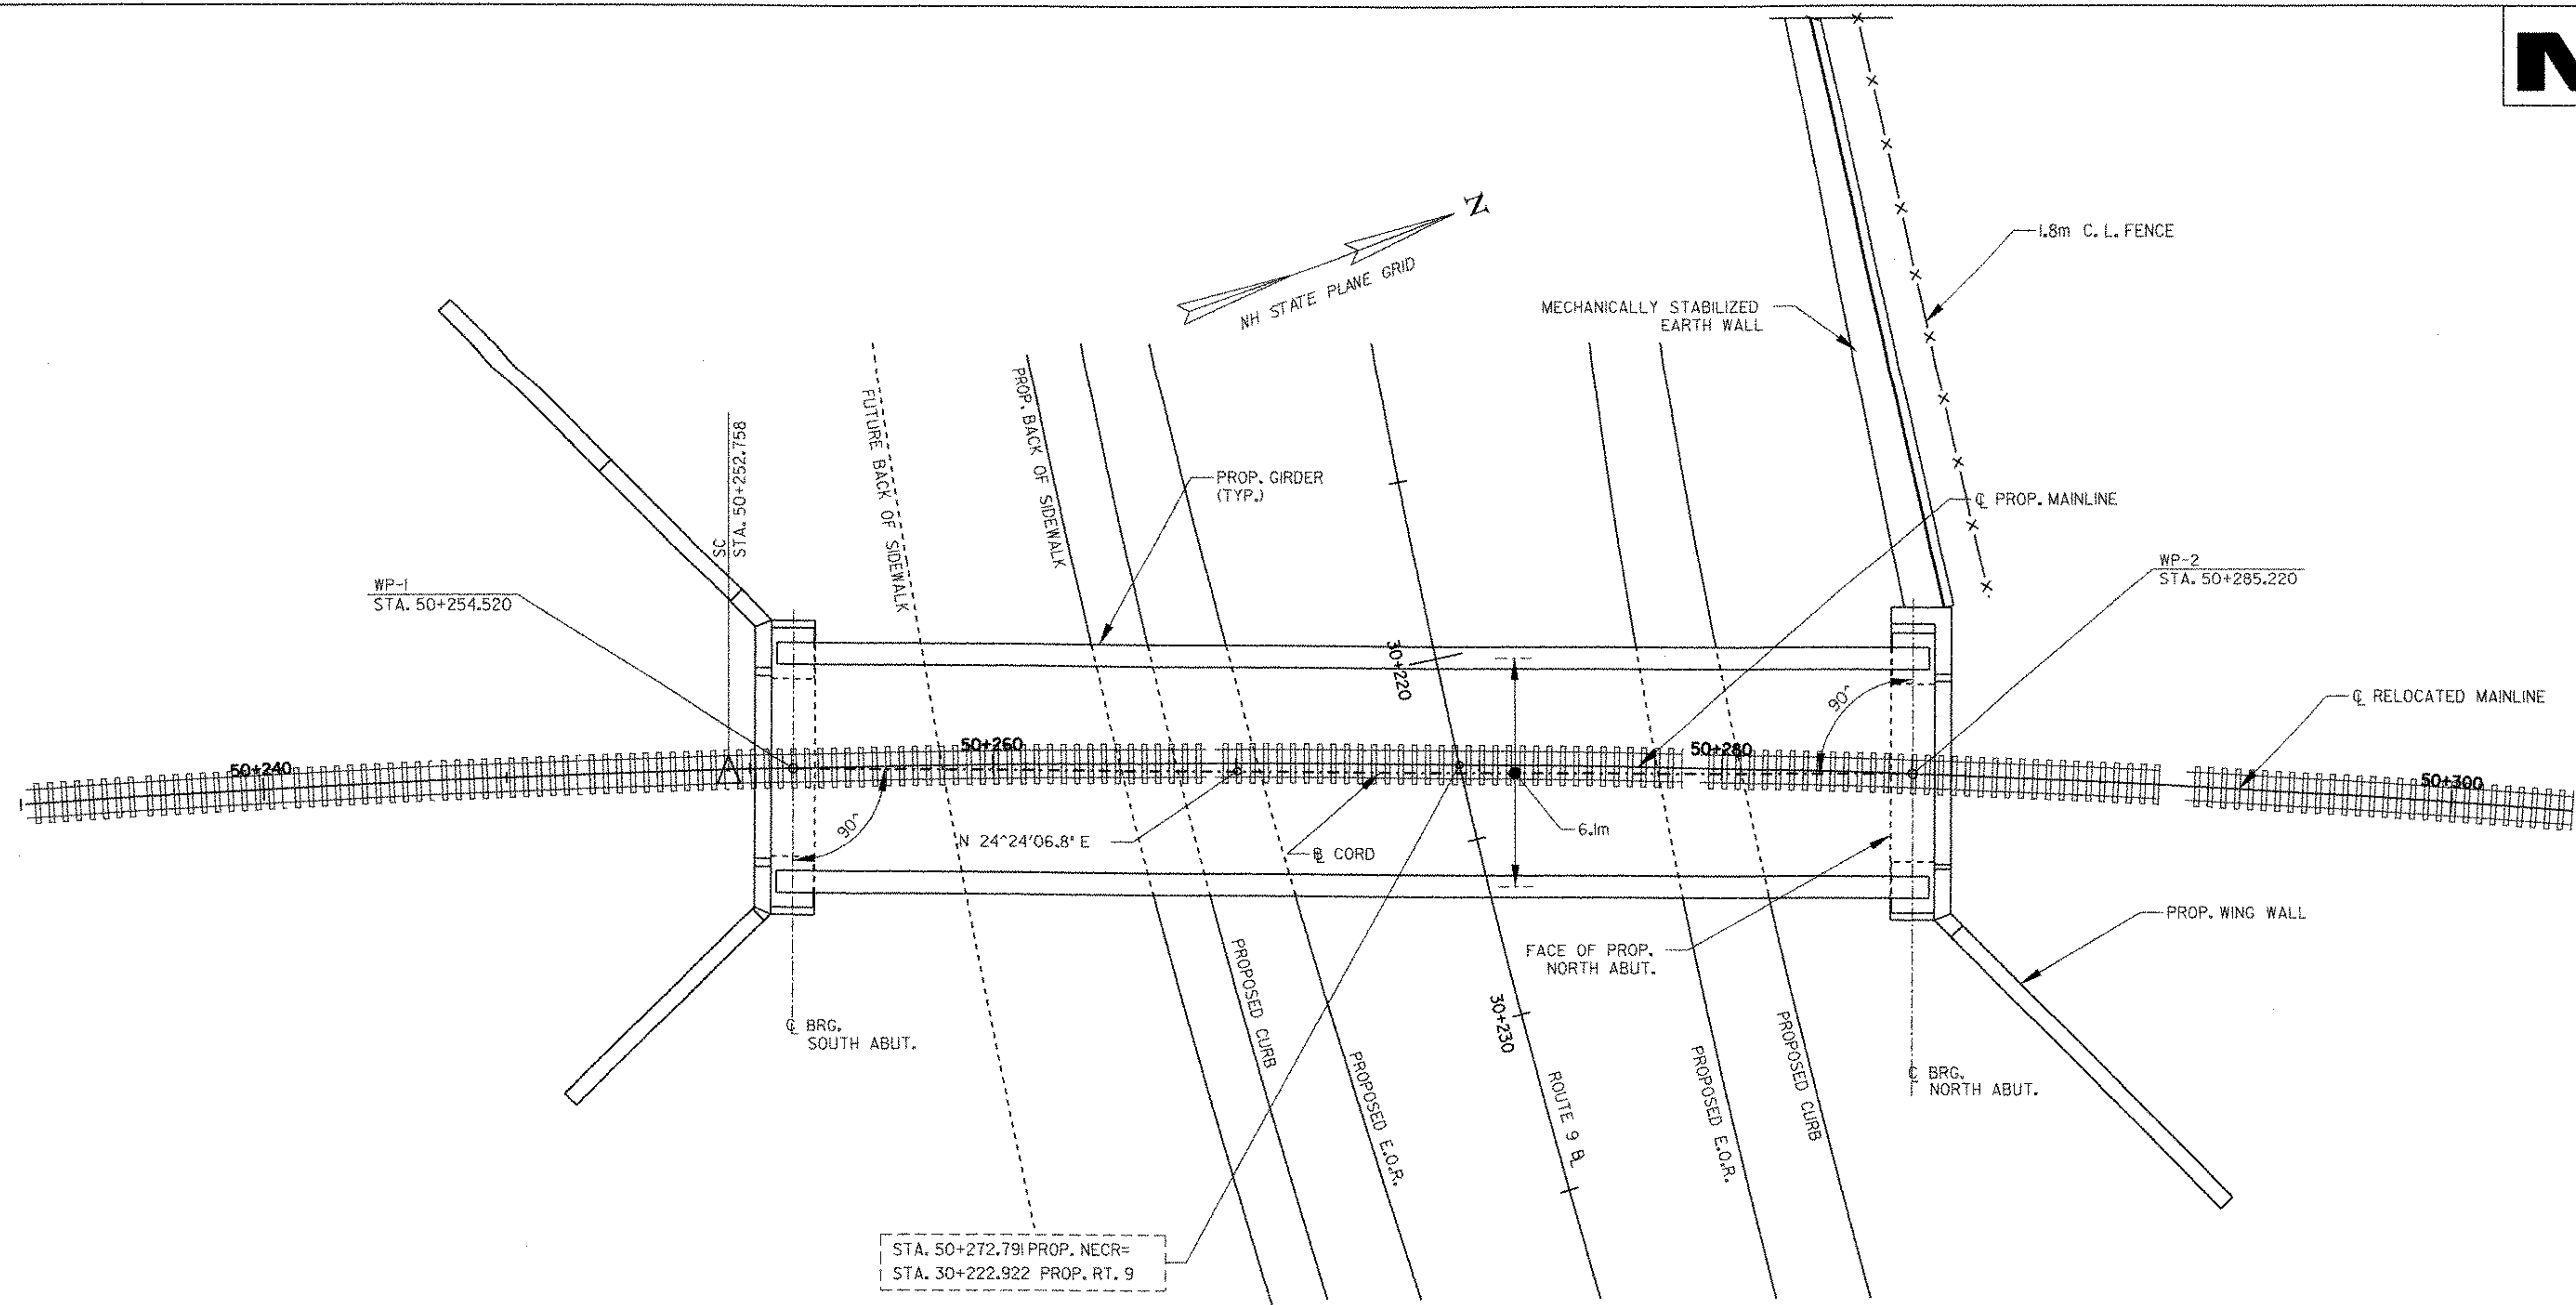

STA. 50+272.791 PROP. NECR=
STA. 30+222.922 PROP. RT. 9

**ROUTE 9 BRIDGE
PLAN**
SCALE 1:100

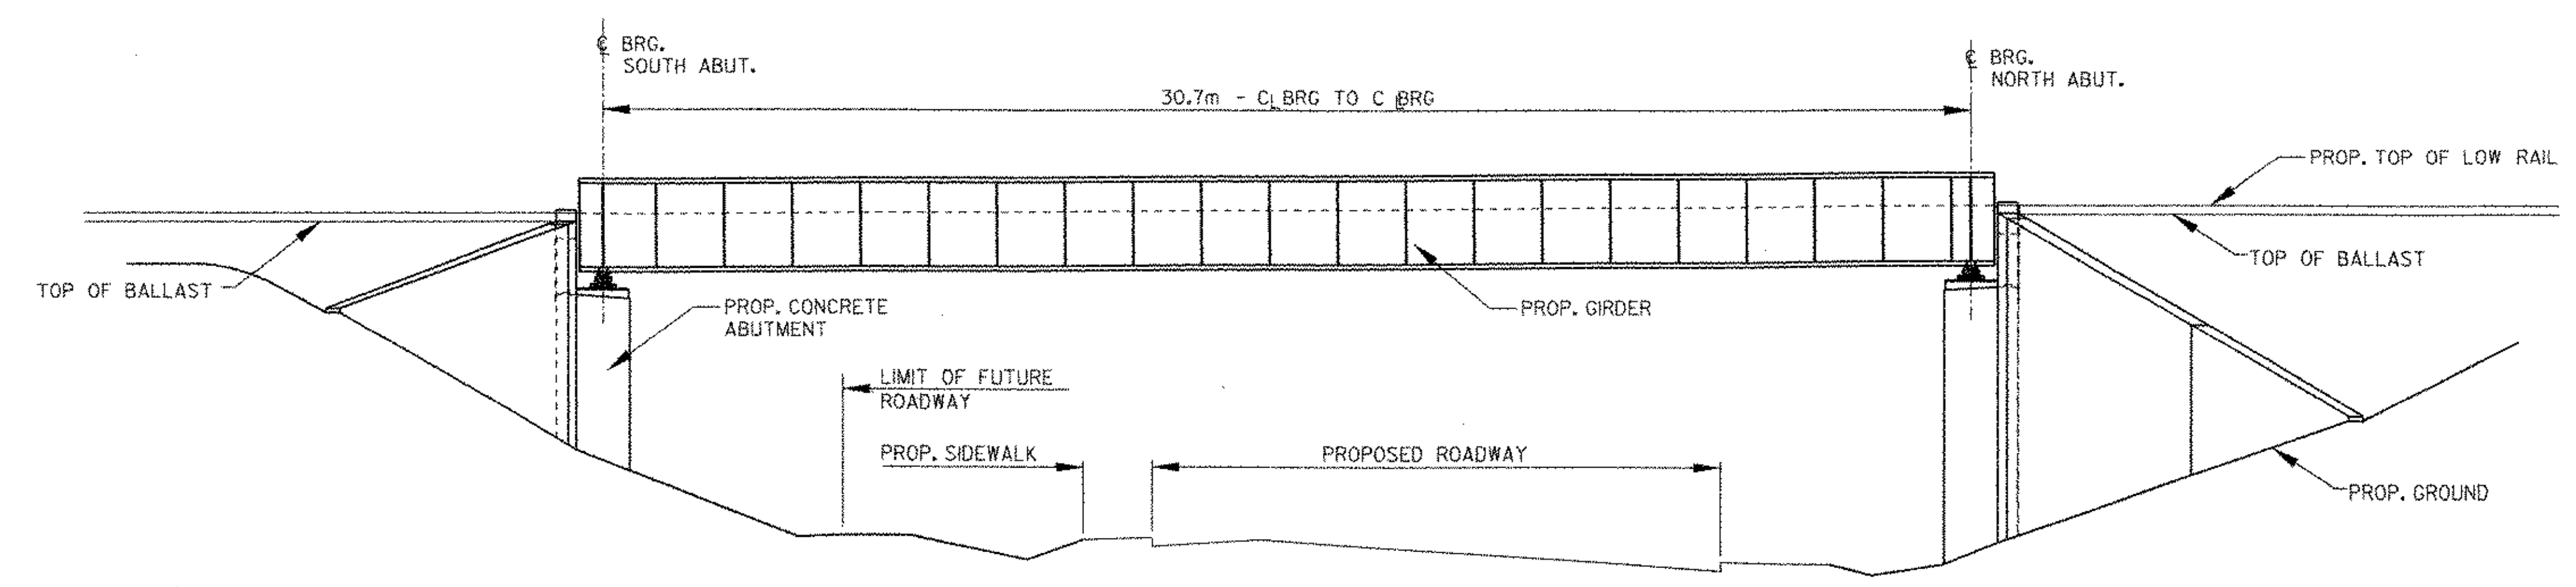

**ROUTE 9 BRIDGE
ELEVATION**
SCALE 1:100

DATUM	
VERTICAL	_____
HORIZONTAL	_____

FEB 05 2003



**VT. ROUTE 9 BRIDGE
PLAN AND ELEVATION**

SURVEYED BY	N/A	DATE	N/A
DRAWN BY	DHL	DATE	_____
SQUAD LEADER	JHR		
DESIGN FILE NO.	95b270\structures\rt9br100.dgn		
IPARM FILE	rt9br100pe.d	DATE PLOTTED	09-MAR-2001

**BRATTLEBORO
NH BR 012-K33)**

R.O.W. SHEET 14 OF 27 SHEETS

223 Row

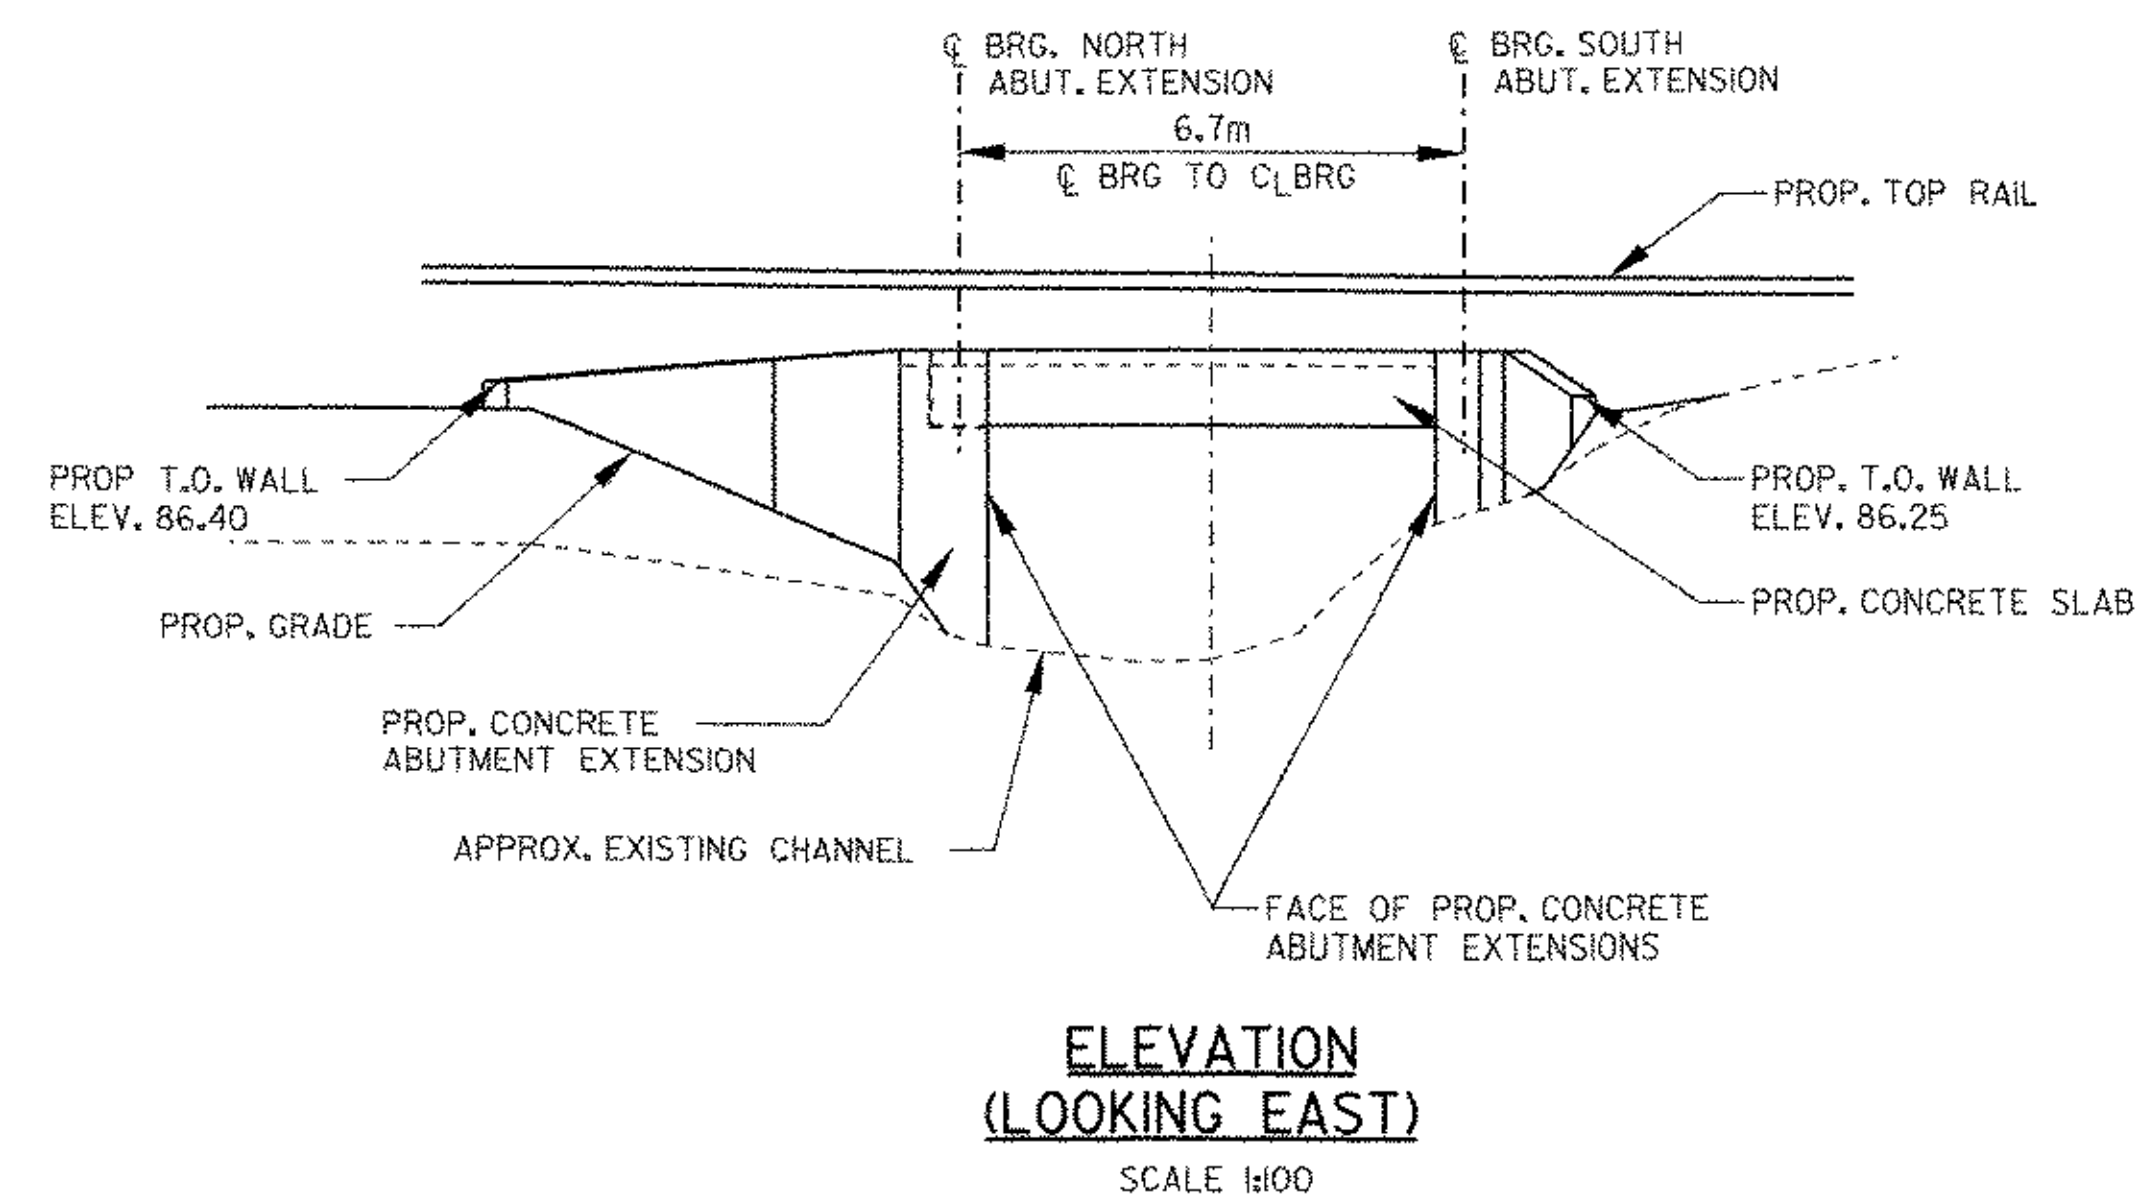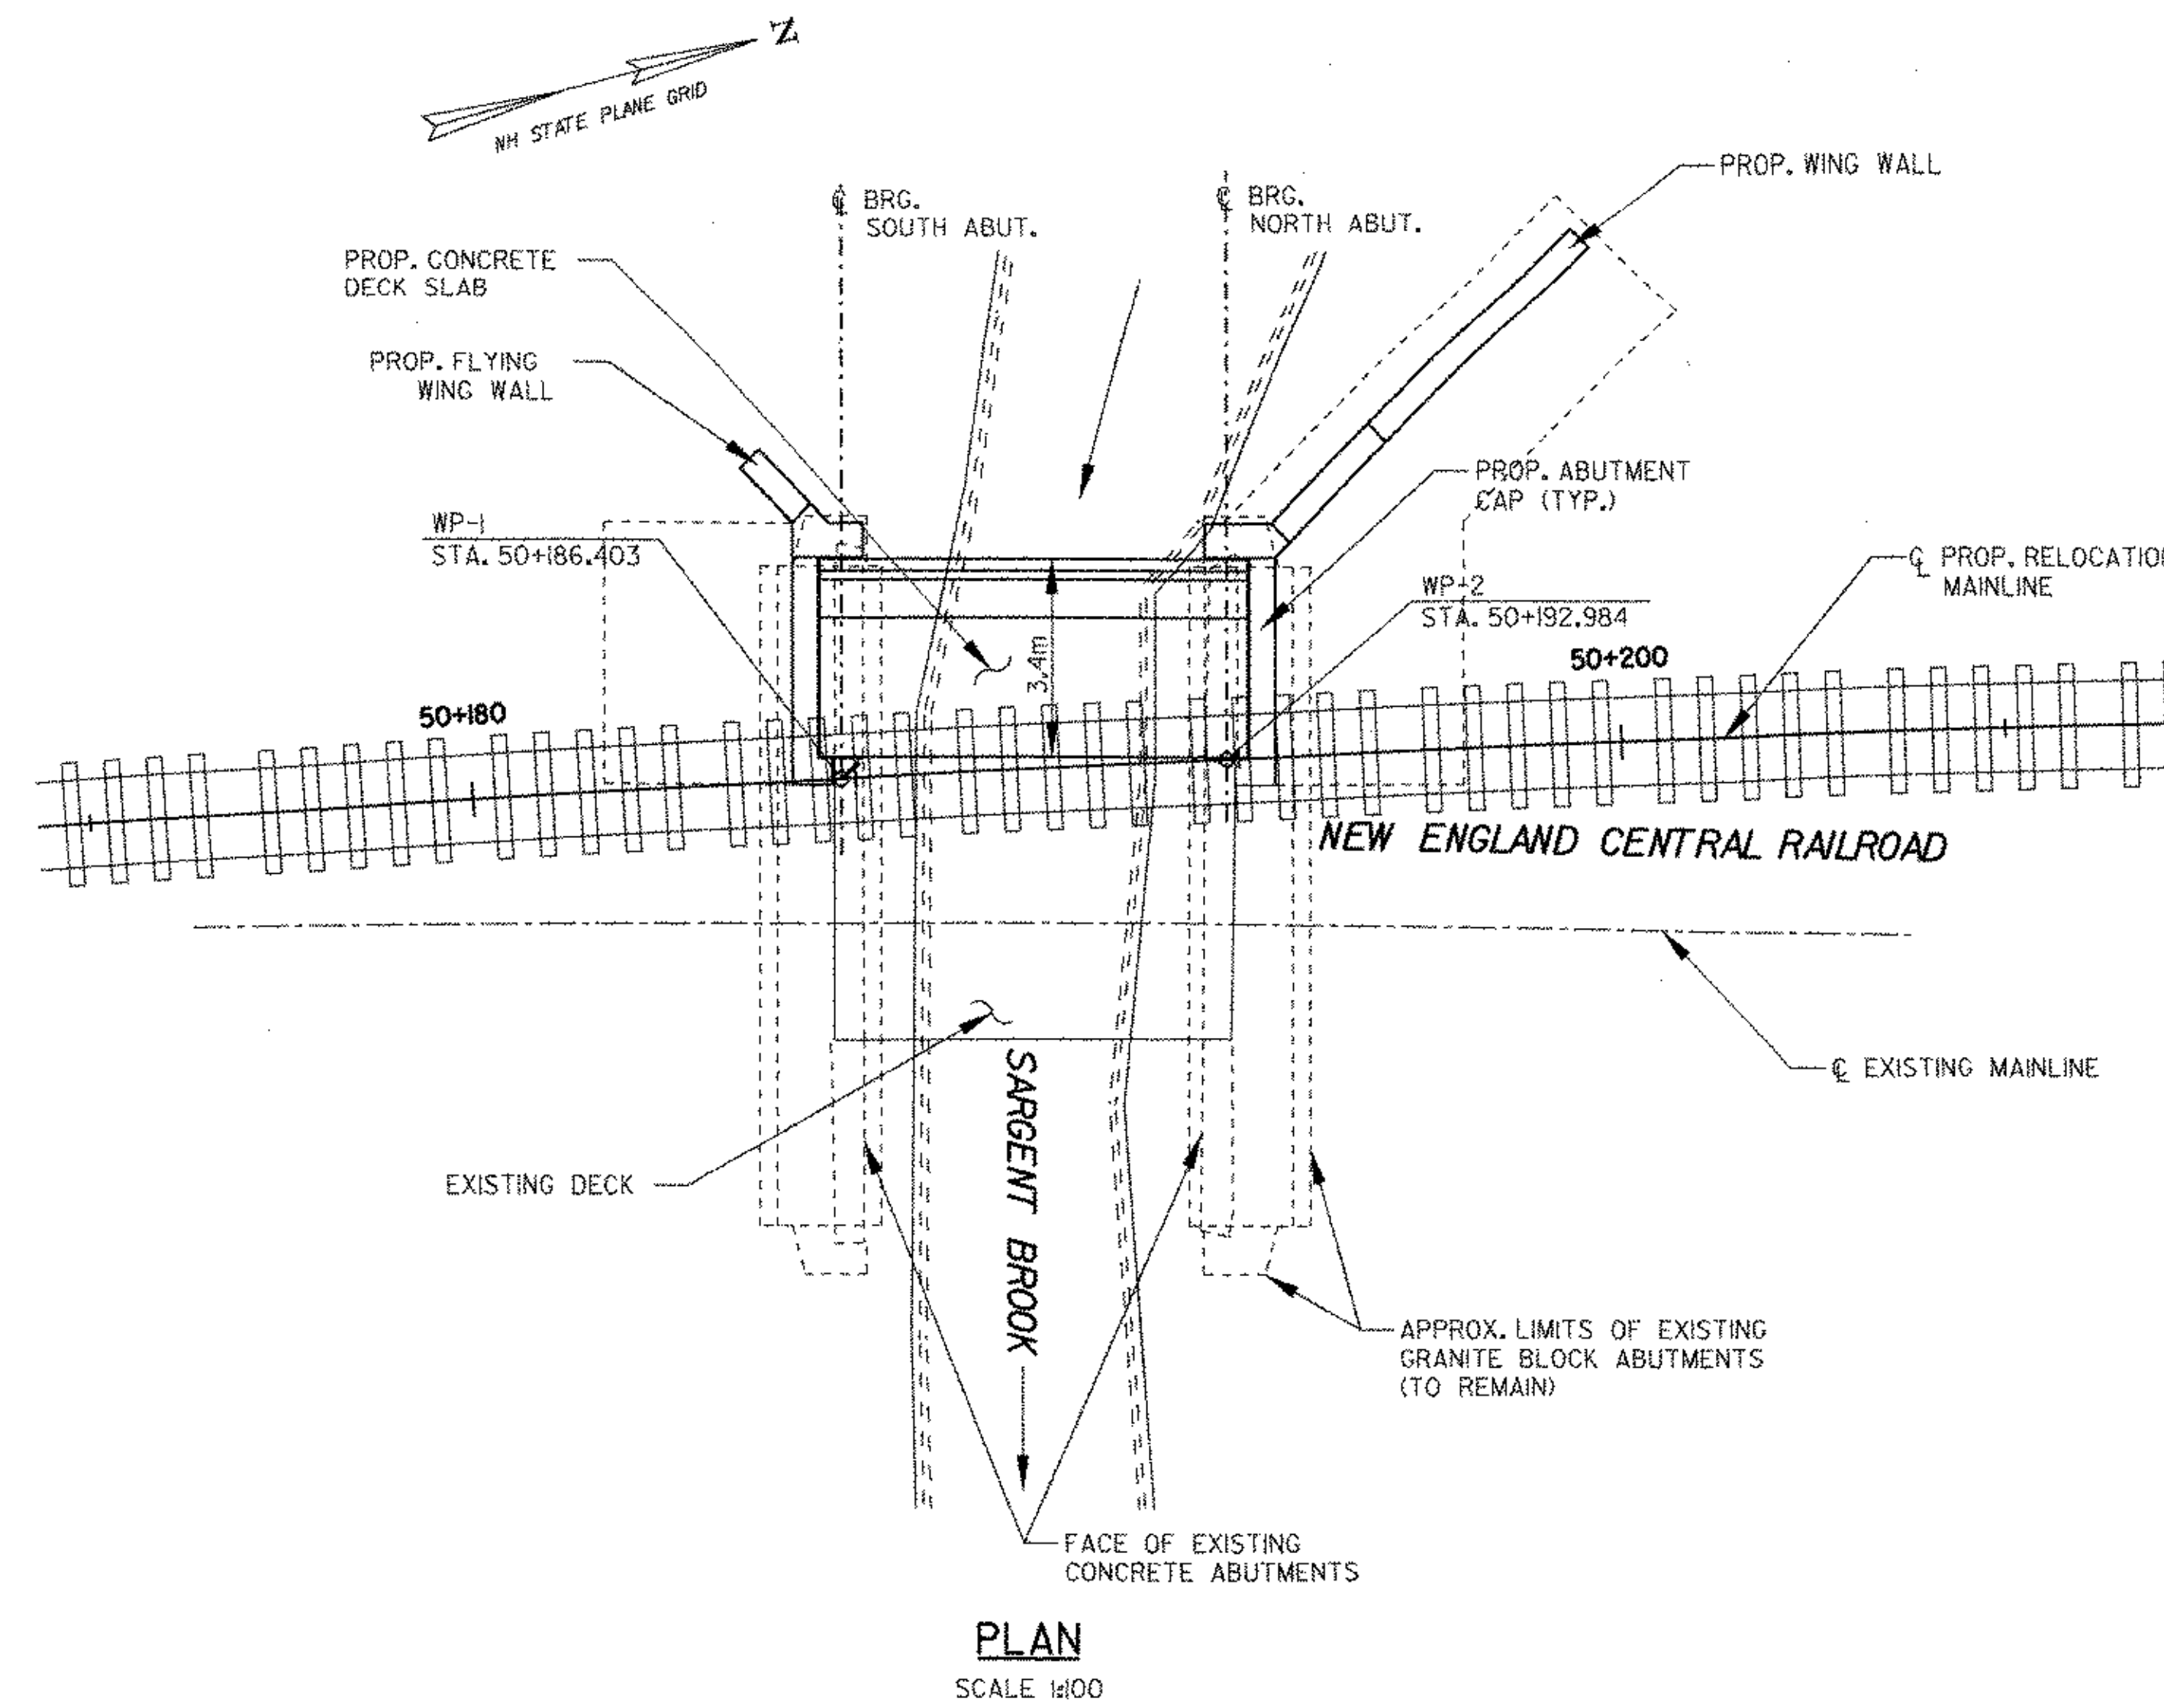

DATUM
VERTICAL _____
HORIZONTAL _____

FEB 05 2003


**SARGENT BROOK BRIDGE
PLAN AND ELEVATION**

SURVEYED BY N/A DATE N/A
DRAWN BY DHL DATE _____
SQUAD LEADER JHR
DESIGN FILE NO. 95b270\structures\sgtbr100.dgn
IPARM FILE sgtbr100pe.l DATE PLOTTED 09-MAR-2001


**BRATTLEBORO
NH BRF 012-1(33)**

R.O.W. SHEET 15 OF 27 SHEETS

2.7.4 Rev. 1

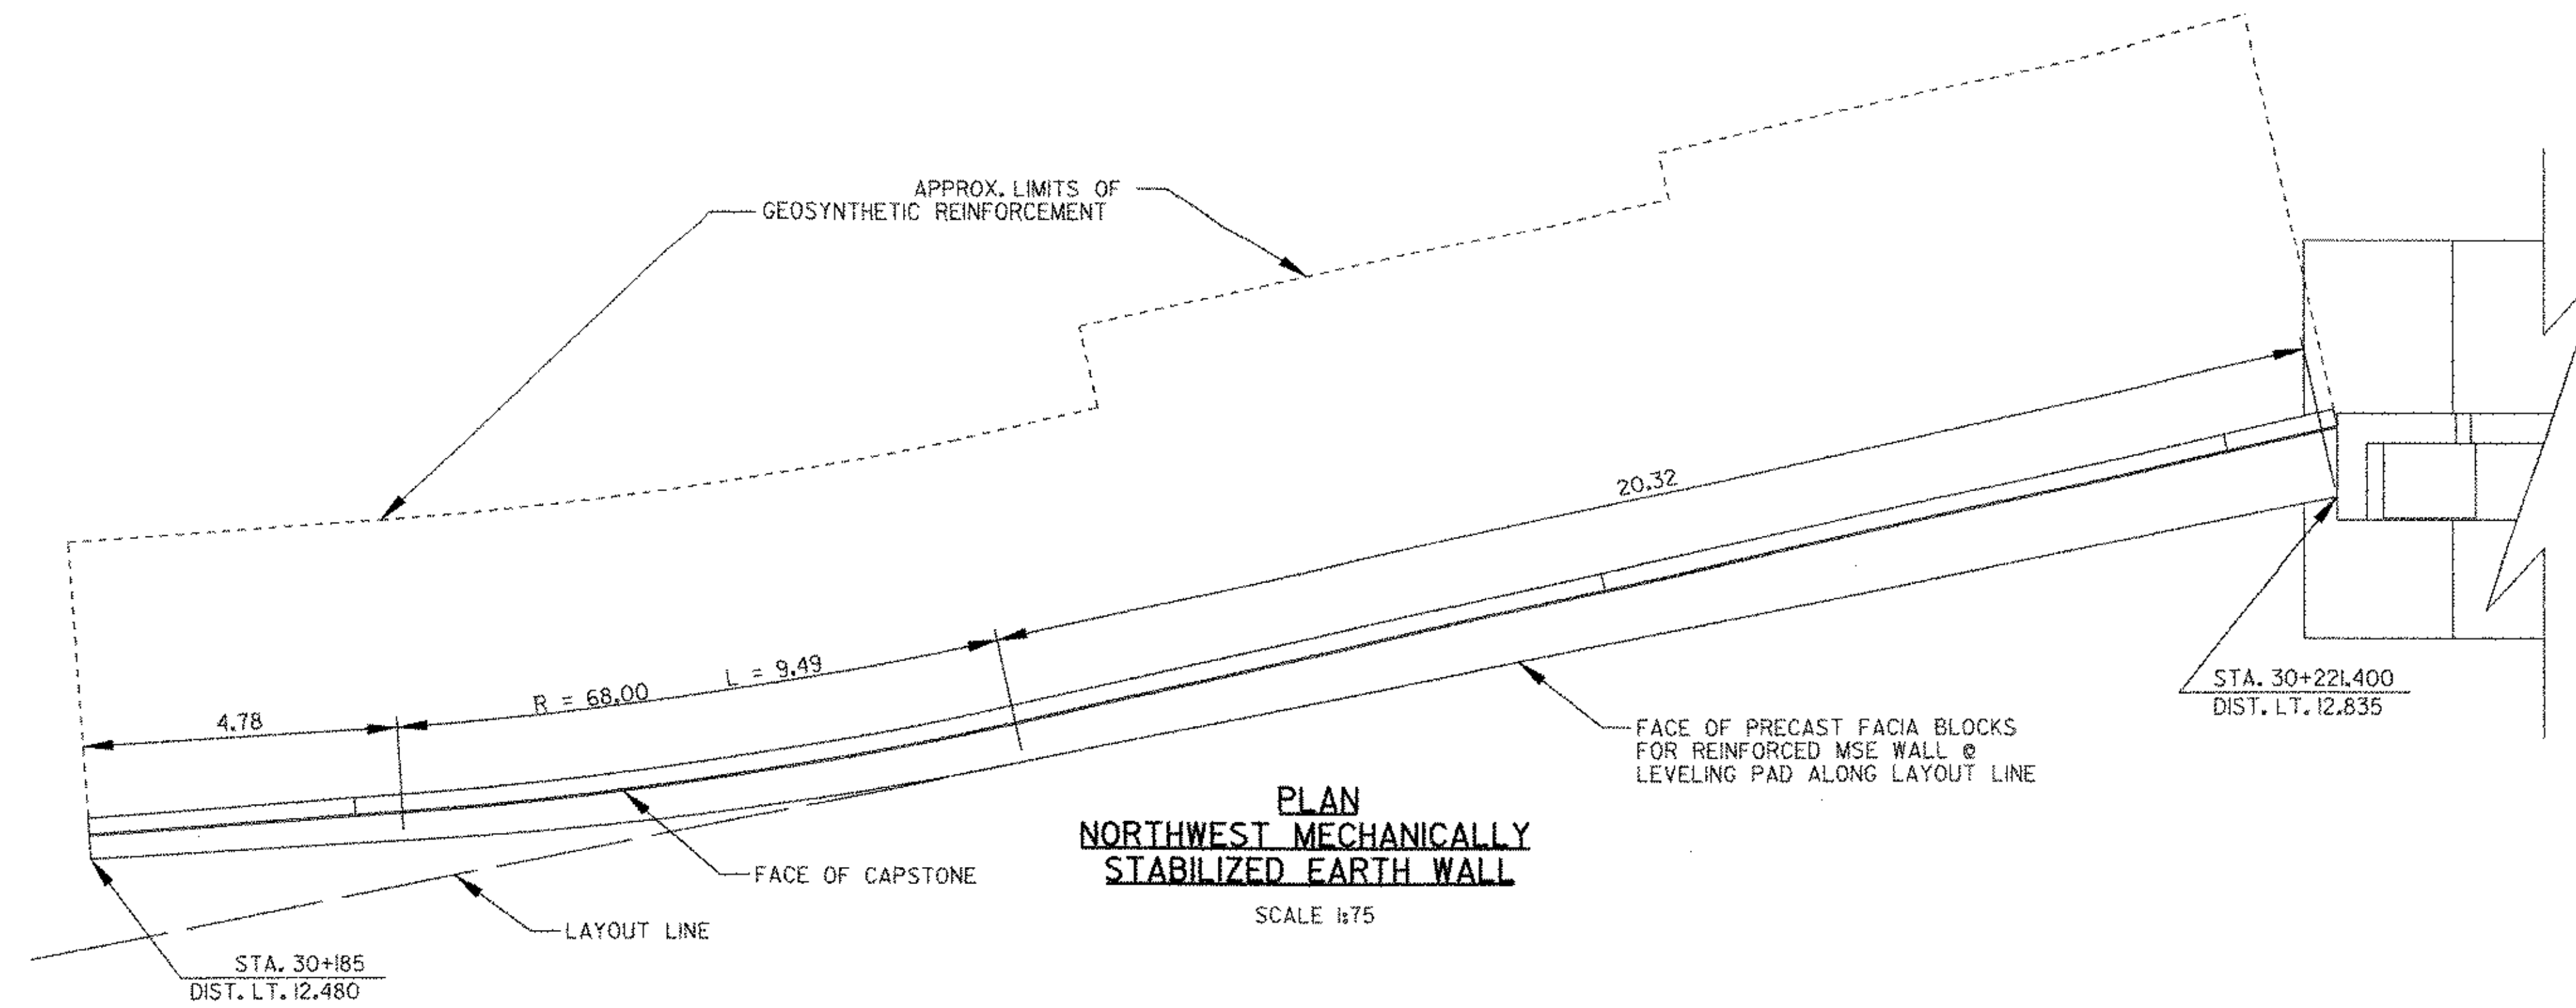

**PLAN
NORTHWEST MECHANICALLY
STABILIZED EARTH WALL**
SCALE 1/75

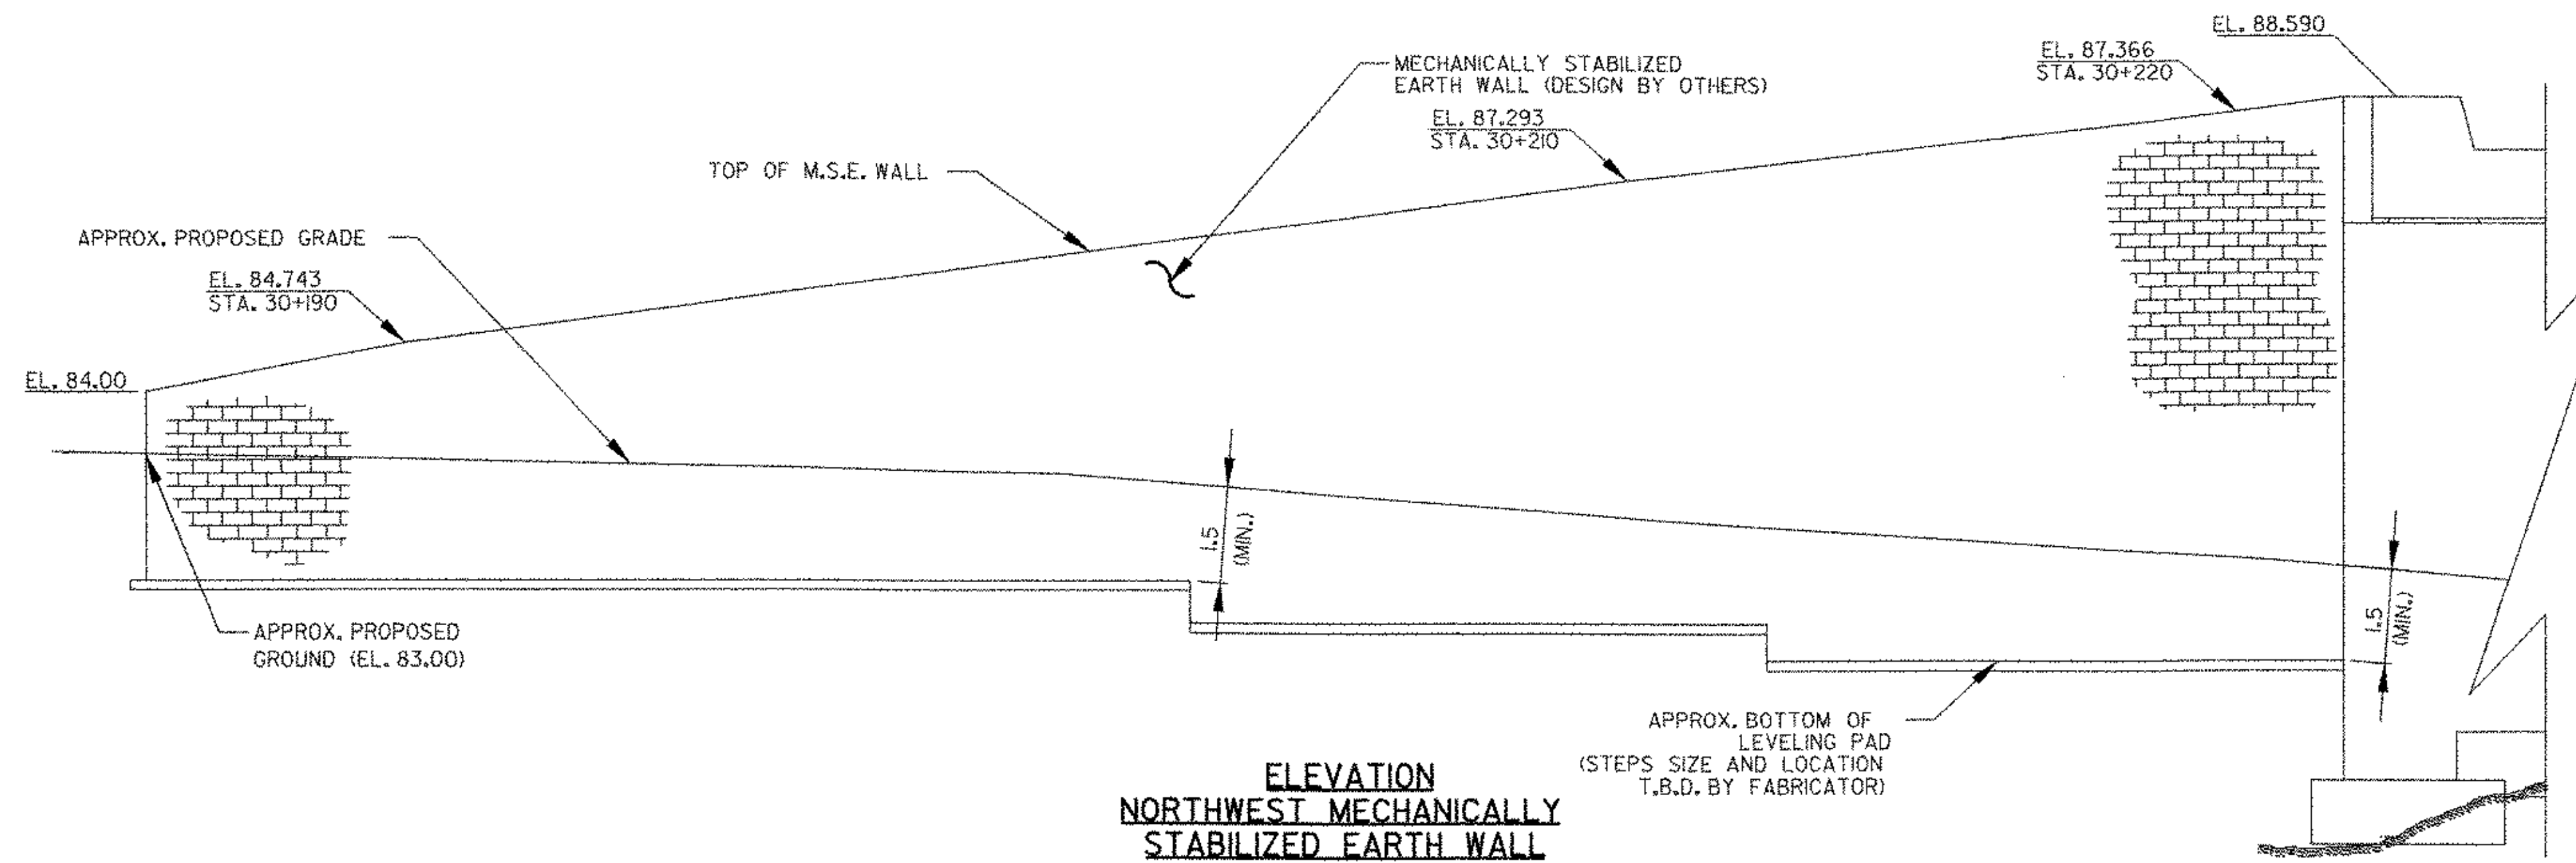

**ELEVATION
NORTHWEST MECHANICALLY
STABILIZED EARTH WALL**
SCALE 1/75

FEB 05 2003

**NORTHWEST M.S.E. WALL
PLAN AND ELEVATION**

SURVEYED BY N/A DATE N/A
 DRAWN BY DHL DATE _____
 SQUAD LEADER JHR
 DESIGN FILE NO. 95b270\structures\rt9br160.dgn
 IPARM FILE r+9br160pe.l DATE PLOTTED 09-MAR-2001


**BRATTLEBORO
NH BR F 012-K33**

R.O.W. SHEET 16 OF 27 SHEETS

DATUM	
VERTICAL _____	
HORIZONTAL _____	

275 Pow

- (D1) STA. 30+147 LT
CONST SPECIAL DITCH
8 m x 2 m TYPE I STONE FILL
- (D2) STA. 30+180 TO STA. 30+220 LT
CONST SPECIAL DITCH
TYPE I STONE FILL
- (U5) STA. 30+182 LT TO STA. 30+250 LT
NEW 150 mm UD w/ FLUSHING BASIN
AT STA 30+182
- (P4) STA. 30+151 LT
NEW 600 mm x 1.5 m RCP (CLASS III) OR CPEP (SL)
RELAYING PIPE CULVERT 525 mm x 2.4 m RCP
NEW PRCCB AT INLET (1.2 m DIA.)
PRCCB IS TO BE PLACED TO INTERCEPT
CULVERT FROM STA 30+147 LT
W/ CI GRATE TYPE A
- (P7) STA. 30+180 LT
NEW 450 mm x 1.5 m RCP (CLASS III) OR CPEP (SL)
OR PCCSP (1.63) OR CAAP (1.52)
NEW PRCCB AT INLET (1.2 m DIA.)
W/ CI GRATE TYPE A
- (P8) STA. 30+180 LT TO STA. 30+250 LT
NEW 750 mm x 68.5 m PCCSP (1.63) OR CAAP (1.52)
NEW PRCCB AT INLET (1.5 m DIA.)
W/ CI GRATE TYPE E

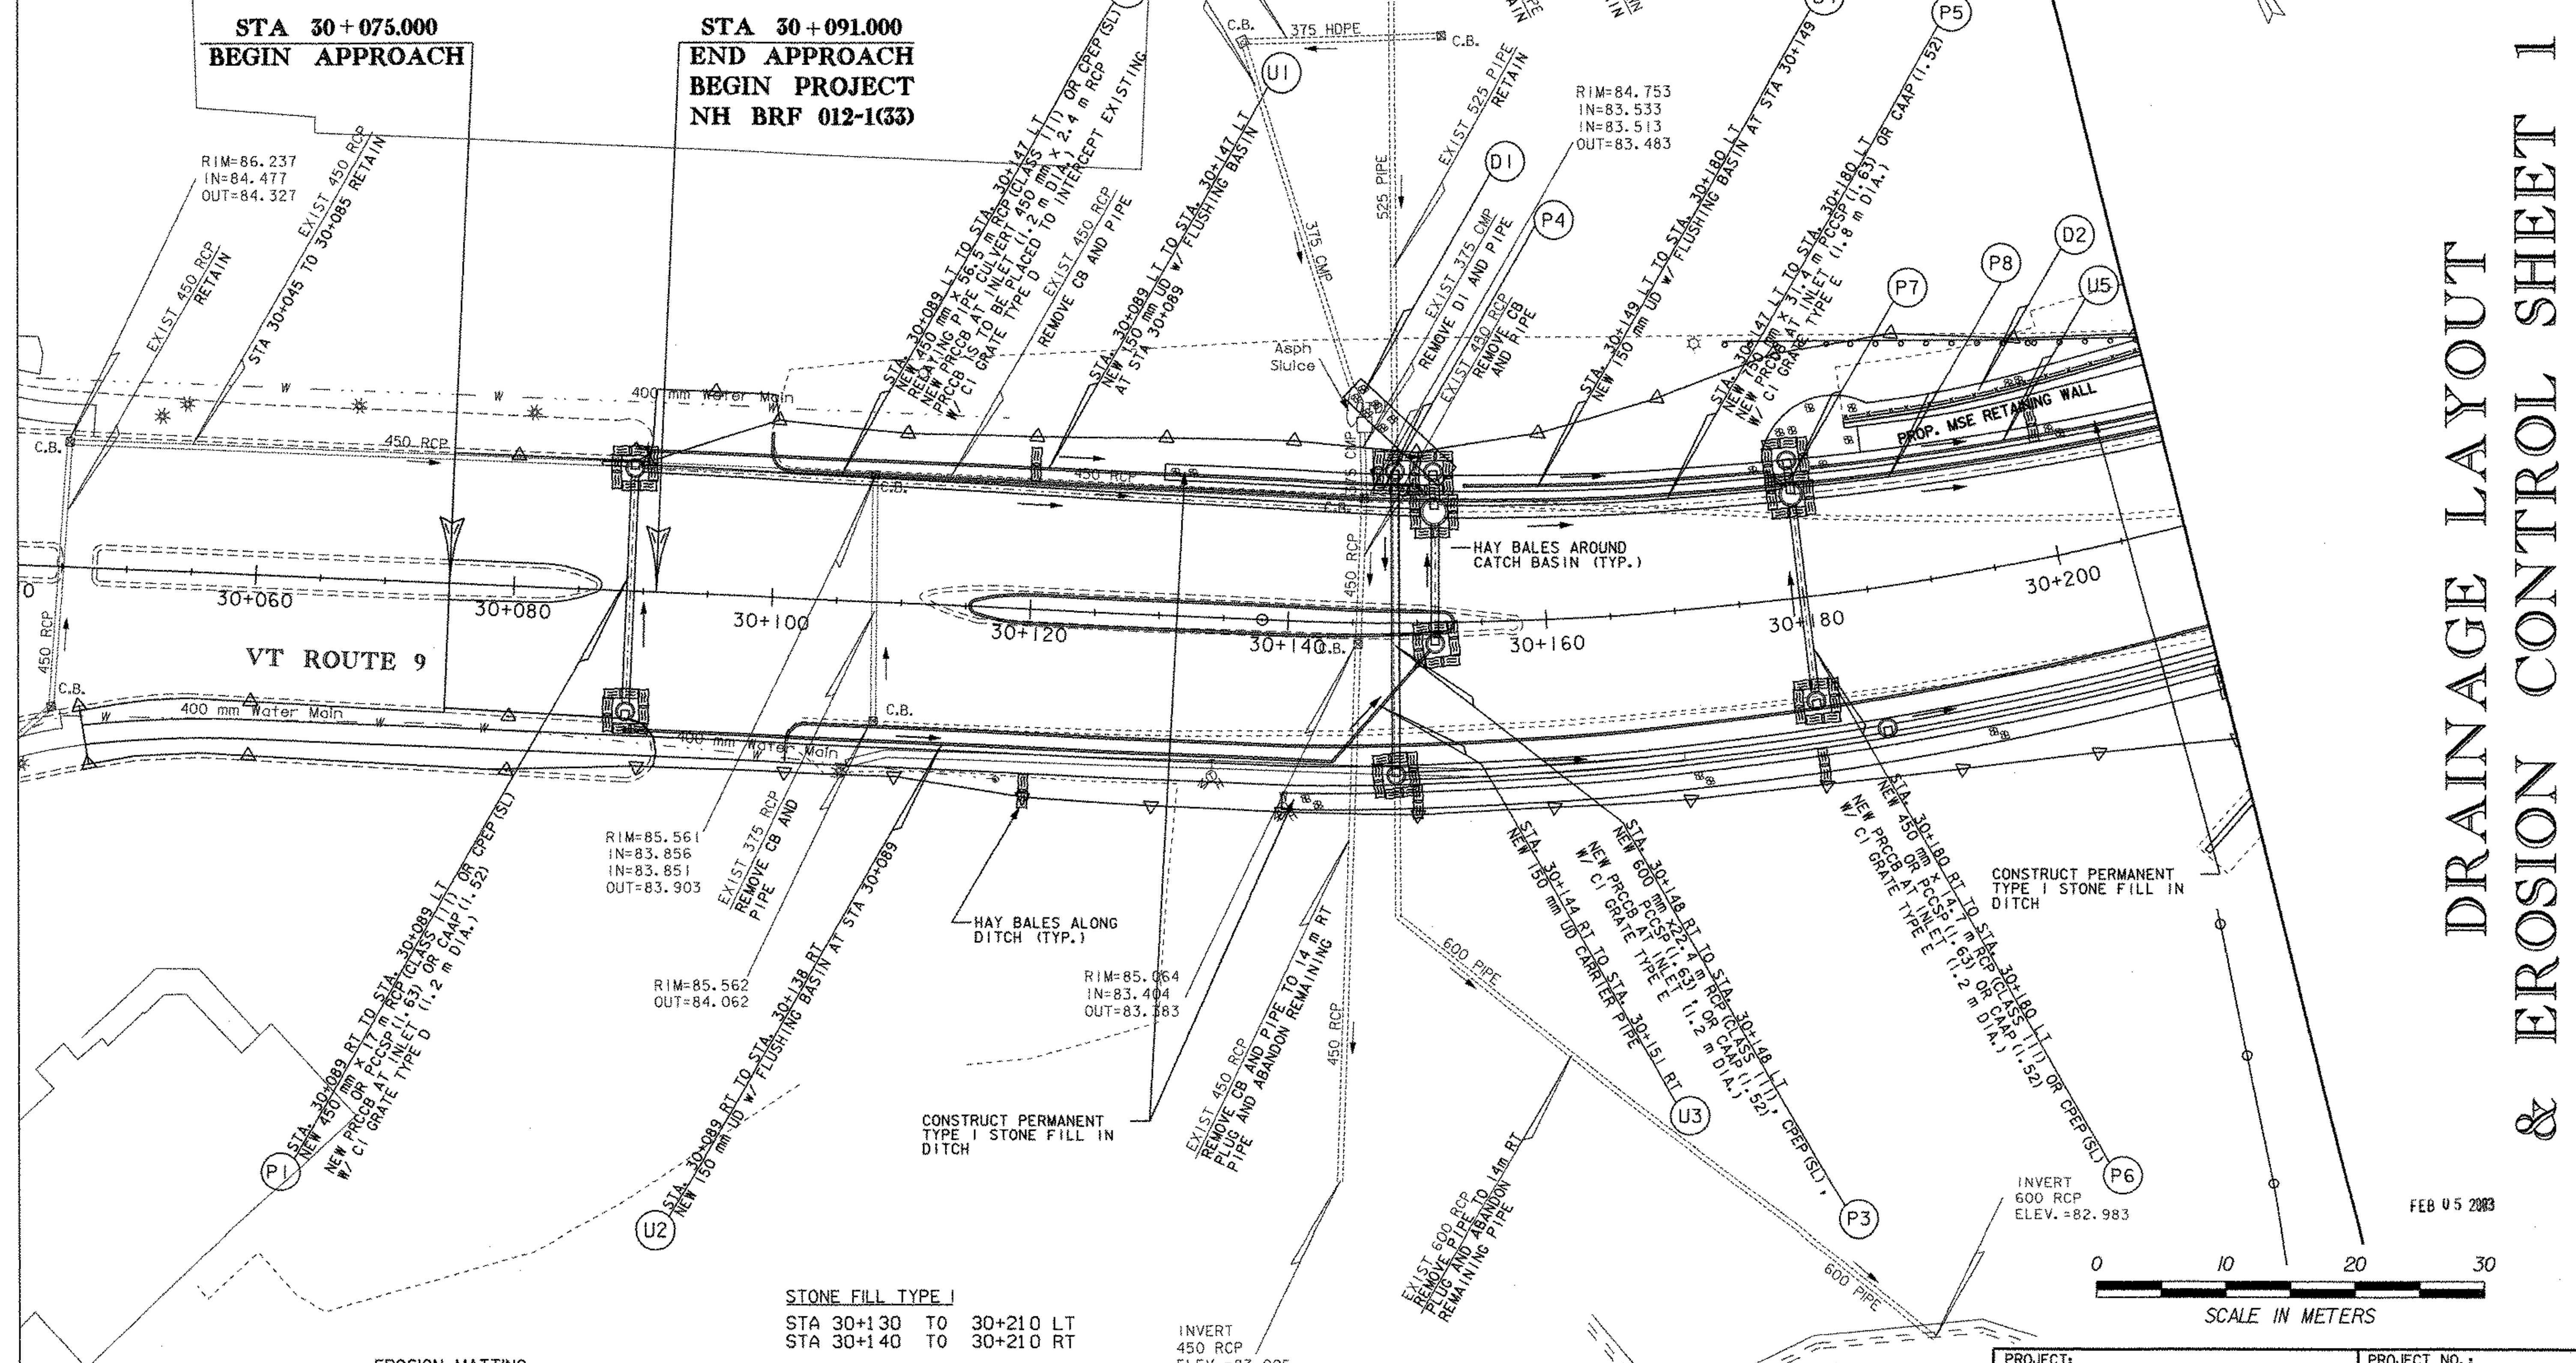

DRAINAGE LAYOUT & EROSION CONTROL SHEET 1

DATUM

VERTICAL	NGVD 1929
HORIZONTAL	NAD 1983

EROSION MATTING
 STA 30+100 TO 30+130 LT
 STA 30+110 TO 30+140 RT


STONE FILL TYPE I
 STA 30+130 TO 30+210 LT
 STA 30+140 TO 30+210 RT




PROJECT:	BRATTLEBORO	PROJECT NO.:	NH BRF 012-1(33)
DESIGN FILE NAME:	95b270\structures\sb270bd2.dgn		
IPARM FILE NAME:	sb270coll1	PLOT DATE:	09-MAR-2001
SURVEYED BY:		SURVEY DATE:	
SQUAD LEADER:	W. HUSBAND	DRAWN BY:	P. SHEDD
R.O.W. SHEET 17 OF 27 SHEETS			

FEB 05 2003


7.76 raw

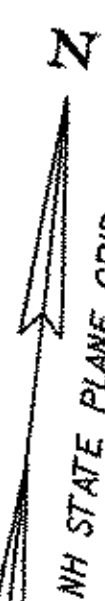

DRAINAGE LAYOUT & EROSION CONTROL SHEET 2

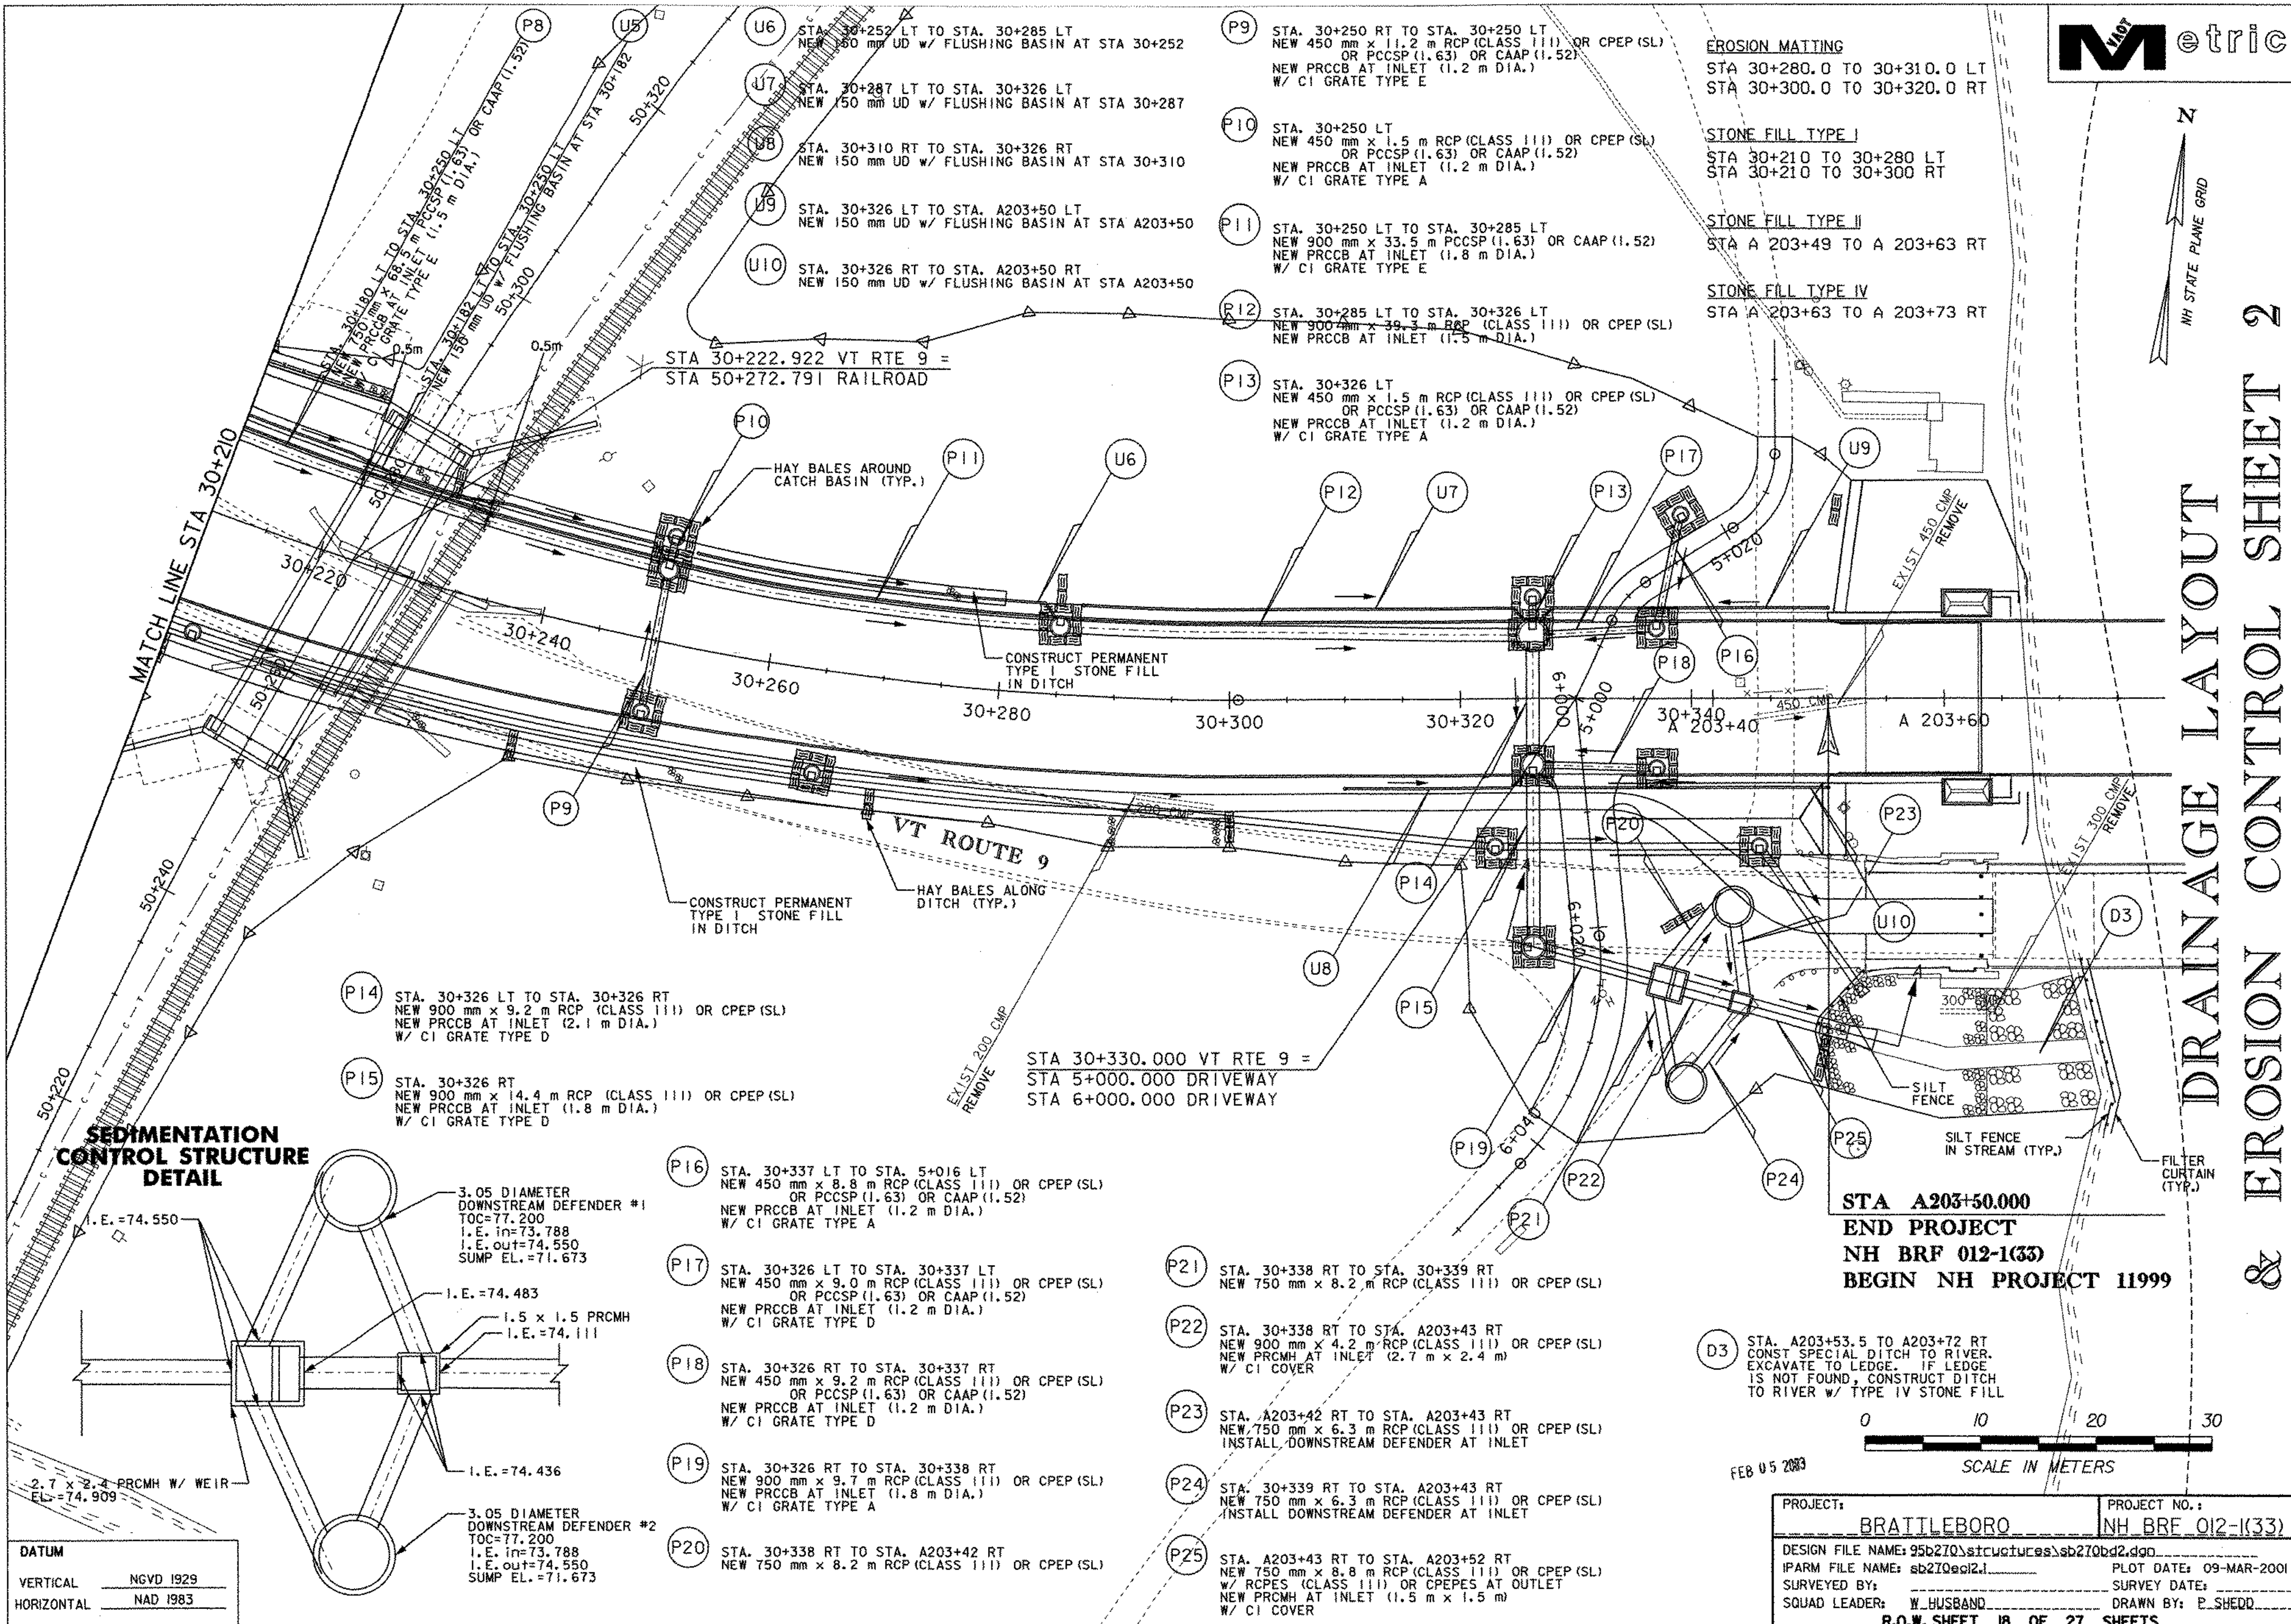

SEDIMENTATION CONTROL STRUCTURE DETAIL

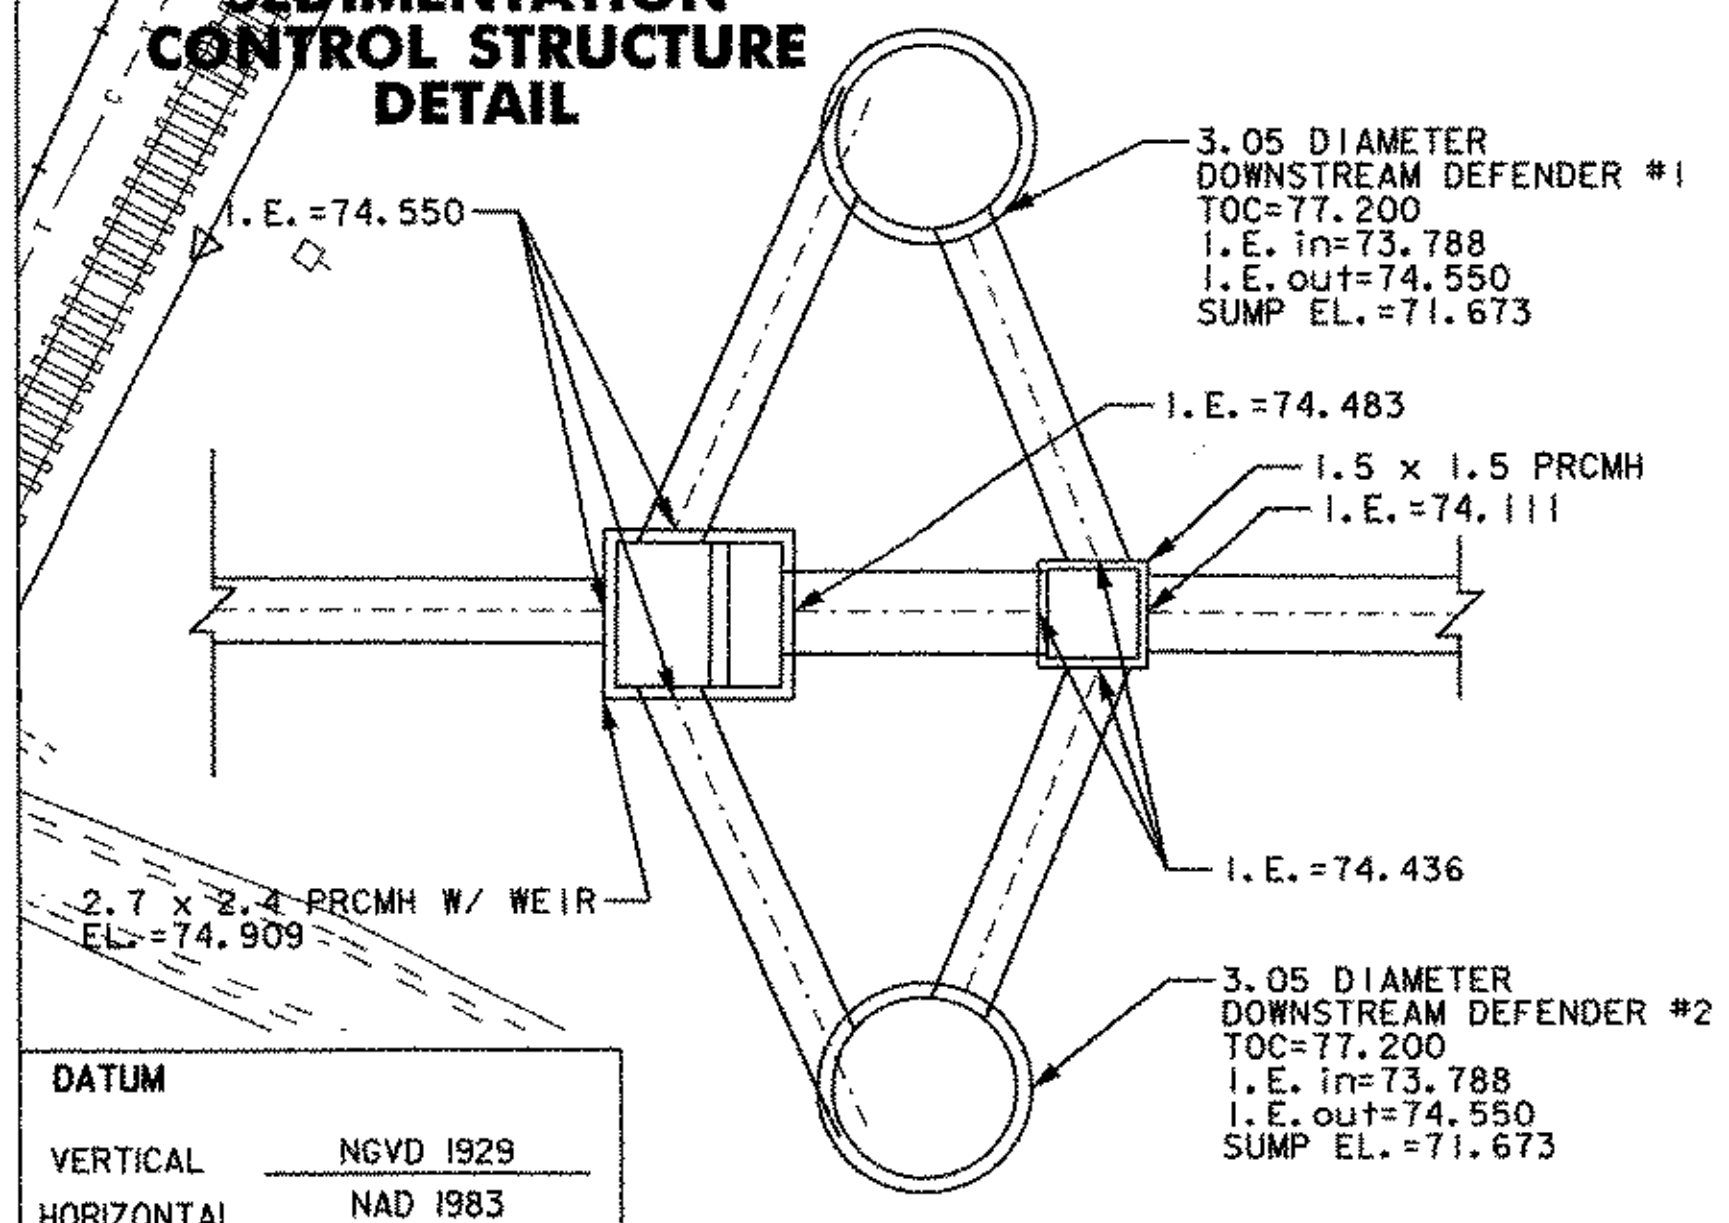

DATUM	
VERTICAL	NGVD 1929
HORIZONTAL	NAD 1983

- P14 STA. 30+326 LT TO STA. 30+326 RT
NEW 900 mm x 9.2 m RCP (CLASS III) OR CPEP (SL)
NEW PRCCB AT INLET (2.1 m DIA.)
W/ CI GRATE TYPE D
- P15 STA. 30+326 RT
NEW 900 mm x 14.4 m RCP (CLASS III) OR CPEP (SL)
NEW PRCCB AT INLET (1.8 m DIA.)
W/ CI GRATE TYPE D

- P16 STA. 30+337 LT TO STA. 5+016 LT
NEW 450 mm x 8.8 m RCP (CLASS III) OR CPEP (SL)
OR PCCSP (1.63) OR CAAP (1.52)
NEW PRCCB AT INLET (1.2 m DIA.)
W/ CI GRATE TYPE A
- P17 STA. 30+326 LT TO STA. 30+337 LT
NEW 450 mm x 9.0 m RCP (CLASS III) OR CPEP (SL)
OR PCCSP (1.63) OR CAAP (1.52)
NEW PRCCB AT INLET (1.2 m DIA.)
W/ CI GRATE TYPE D
- P18 STA. 30+326 RT TO STA. 30+337 RT
NEW 450 mm x 9.2 m RCP (CLASS III) OR CPEP (SL)
OR PCCSP (1.63) OR CAAP (1.52)
NEW PRCCB AT INLET (1.2 m DIA.)
W/ CI GRATE TYPE D
- P19 STA. 30+326 RT TO STA. 30+338 RT
NEW 900 mm x 9.7 m RCP (CLASS III) OR CPEP (SL)
NEW PRCCB AT INLET (1.8 m DIA.)
W/ CI GRATE TYPE A
- P20 STA. 30+338 RT TO STA. A203+42 RT
NEW 750 mm x 8.2 m RCP (CLASS III) OR CPEP (SL)

- P21 STA. 30+338 RT TO STA. 30+339 RT
NEW 750 mm x 8.2 m RCP (CLASS III) OR CPEP (SL)
- P22 STA. 30+338 RT TO STA. A203+43 RT
NEW 900 mm x 4.2 m RCP (CLASS III) OR CPEP (SL)
NEW PRCMH AT INLET (2.7 m x 2.4 m)
W/ CI COVER
- P23 STA. A203+42 RT TO STA. A203+43 RT
NEW 750 mm x 6.3 m RCP (CLASS III) OR CPEP (SL)
INSTALL DOWNSTREAM DEFENDER AT INLET
- P24 STA. 30+339 RT TO STA. A203+43 RT
NEW 750 mm x 6.3 m RCP (CLASS III) OR CPEP (SL)
INSTALL DOWNSTREAM DEFENDER AT INLET
- P25 STA. A203+43 RT TO STA. A203+52 RT
NEW 750 mm x 8.8 m RCP (CLASS III) OR CPEP (SL)
W/ RCPEP (CLASS III) OR CPEPES AT OUTLET
NEW PRCMH AT INLET (1.5 m x 1.5 m)
W/ CI COVER

- D3 STA. A203+53.5 TO A203+72 RT
CONST. SPECIAL DITCH TO RIVER.
EXCAVATE TO LEDGE. IF LEDGE
IS NOT FOUND, CONSTRUCT DITCH
TO RIVER W/ TYPE IV STONE FILL



PROJECT:	BRATTLEBORO	PROJECT NO.:	NH BRF 012-1(33)
DESIGN FILE NAME:	95b2702\structures\sb270bd2.dgn		
IPARM FILE NAME:	sb270bd2.d	PLOT DATE:	09-MAR-2001
SURVEYED BY:	W. HUSBAND	SURVEY DATE:	
SQUAD LEADER:	W. HUSBAND	DRAWN BY:	P. SHEDD
R.O.W. SHEET 18 OF 27 SHEETS			

227 POW



**STATE OF VERMONT
AGENCY OF TRANSPORTATION
RIGHT OF WAY PLANS
DETAIL SHEET**

TABLE OF PROJECT PROPERTY ACQUISITION

PARCEL NO.	GRANTOR	SHEET NO.	BEGINNING STATION	ENDING STATION	TAKING	REM.	RIGHTS	TITLE TAKEN	DATE	TOWN OR CITY RECORDED	BK.	PG.	REMARKS	REVISION NO.	SHEET	DESCRIPTION OF REVISION	DATE	MADE BY	APPROVED BY		
1A	THE ELLIS ROBERTSON COMPANY INC. - LESSOR ROUNTREE MOTORS INC. - D/B/A/ ROUNTREE FORD-MERCURY - LESSEE	22, 23	30+156.3 LT.	30+220.3 LT.	191.5 SM±					BRATTLEBORO			2,061.4 S.F. ±	1	19, 23	PARCEL NO. 1 ROBERTSON & ROUNTREE. ADD EXCEPT AND RESERVE FOR WATERLINE AT THE FOLLOWING STATIONS: NH 203+44.2 LT. ~ NH 203+45.3 LT. AND NH 203+44.2 LT. ~ RR 50+386.3 RT. PER C.O. 9206.	08-27-01	M. J. R.	R. P. D.		
			30+095.0 LT.			DRIVE (T)		9.3M (31') PAVED MM 0711													
			30+100.0 LT.	RR 50+326.6 LT.		CONST. (T) 0.05HA±		INCLUDES EROSION CONTROL & GUARDRAIL 0.12A±													
			30+100.0 LT.	30+145.0 LT.		SLOPE (T) 34.4 SM±		370.3 S.F. ±													
			30+100.0 LT.	30+220.0 LT.		LANDSCAPING (T)		INCLUDES TRANSPLANTING TREES													
			30+143.6 LT.	30+152.6 LT.		DITCH (P)															
			30+145.0 LT.	30+220.3 LT.		SLOPE (P) 136.2 SM±		1,466.1 S.F. ±													
			30+184.0 LT.	30+220.6 LT.		INSTALL & MAINT. (P) 108.1 SM±		1,164 S.F. ± RETAINING WALL & APPURTENANCE													
			30+145.5 LT.			REMOVE (T)		CULVERT, D.I. & ASPHALT SLUICE													
			30+148.6 LT.			CULVERT (T)		CONNECT TO EXISTING CULVERT													
30+152.5 LT.			CULVERT (P)																		
1B		23, 25	30+220.0 LT.	RR 50+326.9 LT.	199.45M±									3	19	PARCEL NO. 1C ELLIS ROBERTSON COMPANY, INC. CHANGE THE BEGINNING STATION OF THE ALL R.T. & I. IN THE RTE. 9 HWY. EASE. FROM 30+120.0 RT. TO 30+102.0 RT. PER C.O. 9209.	10-05-01	M. J. R.	R. P. D.		
								2,146.4 S.F. ± TO BE CONVEYED TO PARCEL #4 RR AFTER PROJECT COMPLETION													
1C		22, 23	30+102.0 RT.	30+223.6 LT.	0.16HA±		ALL R. T. & I.														
			30+145.5 LT. & RT.			ALL R. T. & I.		VT. RTE. 9 HWY. EASE. 0.40A± CULVERT, CAP PIPE RIGHT													
1D		23, 25	30+245.9 LT.	NH 203+45.6 LT.	0.27HA±																
			30+332.3 LT.			DRIVE (T)		0.67A± 3.0M (30') GRAVEL MM 0725 IN COMMON/PARCEL #5B													
			30+263.5 LT.	30+332.3 LT.		CONST. (T) 156.6 SM±		1,685.7 S.F. ±													
			30+276.9 LT.	30+324.0 LT.		SLOPE (P) 35.6 SM±		383.2 S.F. ±													
			NH 203+44.2 LT.	NH 203+45.3 LT.		EXCEPT & RESERVE															
1E		23, 25	RR 50+316.9 RT.	NH 203+45.3 LT.	0.27HA±																
			NH 203+44.2 LT.	RR 50+386.3 RT.		EXCEPT & RESERVE		BY OPTION ONLY 0.67A± APPROXIMATE LOCATION OF WATERLINE													
1F		23	30+238.3 RT.	NH 203+45.6 RT.	0.21HA±		ALL R. T. & I.														
2A	THE ELLIS ROBERTSON COMPANY INC.	22	30+106.3 RT.	30+136.3 RT.						BRATTLEBORO			861.1 S.F. ±								
			30+106.3 RT.	30+136.6 RT.		CONST. (T) 80.0 SM± SLOPE (P) 50.0 SM±		538.1 S.F. ±													
2B		22	30+106.3 RT.	30+136.6 RT.	0.04HA±		ALL R. T. & I.														
3A	THE ELLIS ROBERTSON COMPANY INC.	22	30+135.0 RT.	RR 50+192.9 LT.						BRATTLEBORO			INCLUDES EROSION CONTROL 0.15A±								
			30+136.3 RT.	30+204.3 RT.		SLOPE (P) 214.4 SM±		INCLUDES EROSION CONTROL 2,307.8 S.F. ±													
			30+140.0 RT.	30+172.0 RT.		DITCH (P)															
			30+148.6 RT.			EASMENT (T)		REMOVE PORTION OF CULVERT & CAP.													
3B		22, 23, 25	30+204.3 RT.	RR 50+191.9 LT.	0.05HA±																

FEB 05 2003

ACCT.GFunk
\\vaof...odd\flingcabinet\95b270\RightofWay\95b270d.dgn
DATE PLOTTED 07-OCT-2002

DR. (P)- DRAINAGE RIGHT
DIT. (P)- DITCHING RIGHT
CH. (P)- CHANNEL RT.
DRIVE (T)- DRIVE RIGHT
CUL. (P)- CULVERT RIGHT
[W]- WATER SOURCES

PRESENT R.O.W.
TAKING WITHOUT ACCESS
TAKING WITHOUT ACCESS ALONG PROPERTY LINE
TAKING WITH ACCESS
PERMANENT EASEMENT
TEMPORARY EASEMENT

LEGEND

--- C&T (P) --- CLEARING & TRIMMING
... C&T (P) ... CLEAR ZONE
--- CONST. (T) --- CONSTRUCTION EASEMENT
SR SR SLOPE RIGHTS
P PROPERTY LINE
△ TOP OF CUT
○ TOP OF SLOPE

--- UE (P) --- PERMANENT UTILITY EASEMENT

APPROVED: ROGER P. DUMAS DATE: 02-02-01
CHIEF, PLANS & TITLES

R. O. W. PLANS
BRATTLEBORO
NH BR F 012-1(33)
SHEET 19 OF 27

278 Row



**STATE OF VERMONT
AGENCY OF TRANSPORTATION
RIGHT OF WAY PLANS
DETAIL SHEET**

TABLE OF PROJECT PROPERTY ACQUISITION

PARCEL NO.	GRANTOR	SHEET NO.	BEGINNING STATION	ENDING STATION	TAKING	REM.	RIGHTS	TITLE TAKEN	DATE	TOWN OR CITY RECORDED	BK.	PG.	REMARKS	REVISION NO.	SHEET	DESCRIPTION OF REVISION	DATE	MADE BY	APPROVED BY
3C		22, 23	30+136.6 RT.	30+218.3 RT.	0.11HA±		ALL R. T. & I.						VT. RTE. 9 HWY. EASE 0.27A±						
3D		23	30+232.6 RT. 30+330.0 RT.	NH 203+72.3 RT.	0.30HA±		ALL R. T. & I.						VT. RTE. 9 HWY. EASE. 0.74A± DRIVE 4.6M (15') MM 0725						
4	CV PROPERTIES, INC. JOINED BY NEW ENGLAND CENTRAL RAILROAD, INC.	23, 24 25, 26, 27	RR 50+017.0 CL. 30+214.3 RT.	RR 50+701.6 CL. 30+223.6 LT.			CONST. (T)	1.37HA±		BRATTLEBORO			REALIGN RR TRACKS AND NEW OVERPASS. 3.39A± CROSSING EASE OVER VT RTE. 9 9,888 S.F. ± TO BE CONVEYED TO RR AFTER PROJECT COMPLETION						
5A	MOORE ASSOCIATED COMPANIES INC. (A/K/A THE MOORE COMPANY) (D/B/A/ FULFLEX, INC.)	25, 26	RR 50+326.6 LT. RR 50+326.6 LT. RR 50+386.4 LT.	RR 50+460.3 LT. RR 50+403.0 LT. RR 50+386.9 LT.	0.05HA±		CONST. (T) EXCEPT & RESERVE	76.2 SM±		BRATTLEBORO			0.12A± TO BE CONVEYED BACK TO PARCEL #4 RR 820.2 S.F. ± APPROXIMATE LOCATION OF WATERLINE						
5B		23	NH 203+45.6 LT. 30+332.3 LT.	NH 203+67.0 LT.	374.4 SM±		DRIVE (T)						4,030.1 S.F. ± 3.0M (30') GRAVEL MM 0725 IN COMMON PARCEL 1D						
5C		23	NH 203+45.6 RT.	NH 203+69.9 RT.	0.04HA±		ALL R. T. & I.						RTE. 9 HWY. EASE. 0.10A±						
5D		22	30+148.6 LT. & RT. 30+148.6 LT.				ALL R. T. & I. CULVERT (T)						CULVERT. CAP PIPE RT. CONNECT TO EXISTING CULVERT						
6	JACK TARMY REVOCABLE TRUST, JONATHAN BUMP, TRUSTEE, LESSOR AND ETTA E. TARMY REVOCABLE TRUST, JONATHAN BUMP, TRUSTEE, LESSOR AND JACK TARMY LUMBER COMPANY, INC. - LESSEE	24, 25	RR 50+177.0 LT. RR 50+179.5 LT.	RR 50+180.0 LT. RR 50+193.6 LT.			ACCESS (T) CONST. (T)	165.0 SM±	TEMP. USE PERMIT	01-18-02	BRATTLEBORO	294 450	FROM RTE. 5 FOR EQUIPMENT INCLUDES EROSION CONTROL 1808.4 S.F. ±						

FEB 05 2003

ACCT.GFunk
\\vaof_cadd\fillingcablne+\95b270\RightofWay\95b270d.dgn
DATE PLOTTED 07-OCT-2002

DR. (P)- DRAINAGE RIGHT
DIT. (P)- DITCHING RIGHT
CH. (P)- CHANNEL RT.
DRIVE (T)- DRIVE RIGHT
CUL. (P)- CULVERT RIGHT
[W]- WATER SOURCES

PRESENT R.O.W.
TAKING WITHOUT ACCESS
TAKING WITHOUT ACCESS ALONG PROPERTY LINE
TAKING WITH ACCESS
PERMANENT EASEMENT
TEMPORARY EASEMENT

LEGEND
C&T (P) --- CLEARING & TRIMMING
CZ (P) --- CLEAR ZONE
CONSI. (T) --- CONSTRUCTION EASEMENT
SR --- SLOPE RIGHTS
P --- PROPERTY LINE
L --- TOP OF CUT
L --- TOE OF SLOPE

PERMANENT UTILITY EASEMENT
APPROVED: ROGER P. DUMAS DATE: 02-02-01
CHIEF, PLANS & TITLES

R. O. W. PLANS
BRATTLEBORO
NH BR 012-1(33)
SHEET 20 OF 27

279 row



**STATE OF VERMONT
AGENCY OF TRANSPORTATION
RIGHT OF WAY PLANS
DETAIL SHEET**

TABLE OF PROJECT PROPERTY ACQUISITION

PARCEL NO.	GRANTOR	SHEET NO.	BEGINNING STATION	ENDING STATION	TAKING	REM.	RIGHTS	TITLE TAKEN	DATE	TOWN OR CITY RECORDED	BK.	PG.	REMARKS	REVISION NO.	SHEET	DESCRIPTION OF REVISION	DATE	MADE BY	APPROVED BY
7	VERIZON NEW ENGLAND, INC.												UTILITY						
8	ADELPHIA CABLE COMMUNICATIONS												UTILITY						
9	SPRINT COMMUNICATIONS COMPANY L.P.												UTILITY						

FEB 05 2003

ACCT.Gfunk
\\vaot_eadd\fillingcabinet\95b270\RightOfWay\95b270d.dgn
DATE PLOTTED 07-OCT-2002

DR. (P)- DRAINAGE RIGHT
DIT. (P)- DITCHING RIGHT
CH. (P)- CHANNEL RT.
DRIVE (T)- DRIVE RIGHT
CUL. (P)- CULVERT RIGHT
W- WATER SOURCES


--- PRESENT R.O.W.
 /// --- TAKING WITHOUT ACCESS
 /// P --- TAKING WITHOUT ACCESS ALONG PROPERTY LINE
 /// L --- TAKING WITH ACCESS
 (P) --- PERMANENT EASEMENT
 (T) --- TEMPORARY EASEMENT

LEGEND
 - - - C&T (P) --- CLEARING & TRIMMING
 . . . CZ (P) . . . CLEAR ZONE
 - - - CONST. EASEMENT --- CONSTRUCTION EASEMENT
 SR SR --- SLOPE RIGHTS
 P --- PROPERTY LINE
 △ --- TOP OF CUT
 ○ --- TOE OF SLOPE
 - - - UE (P) . . . PERMANENT UTILITY EASEMENT

APPROVED: ROGER P. DUMAS DATE: 02-02-01
CHIEF, PLANS & TITLES

R. O. W. PLANS
BRATTLEBORO
NH BR 012-1(33)
SHEET 21 OF 27

230 ROW

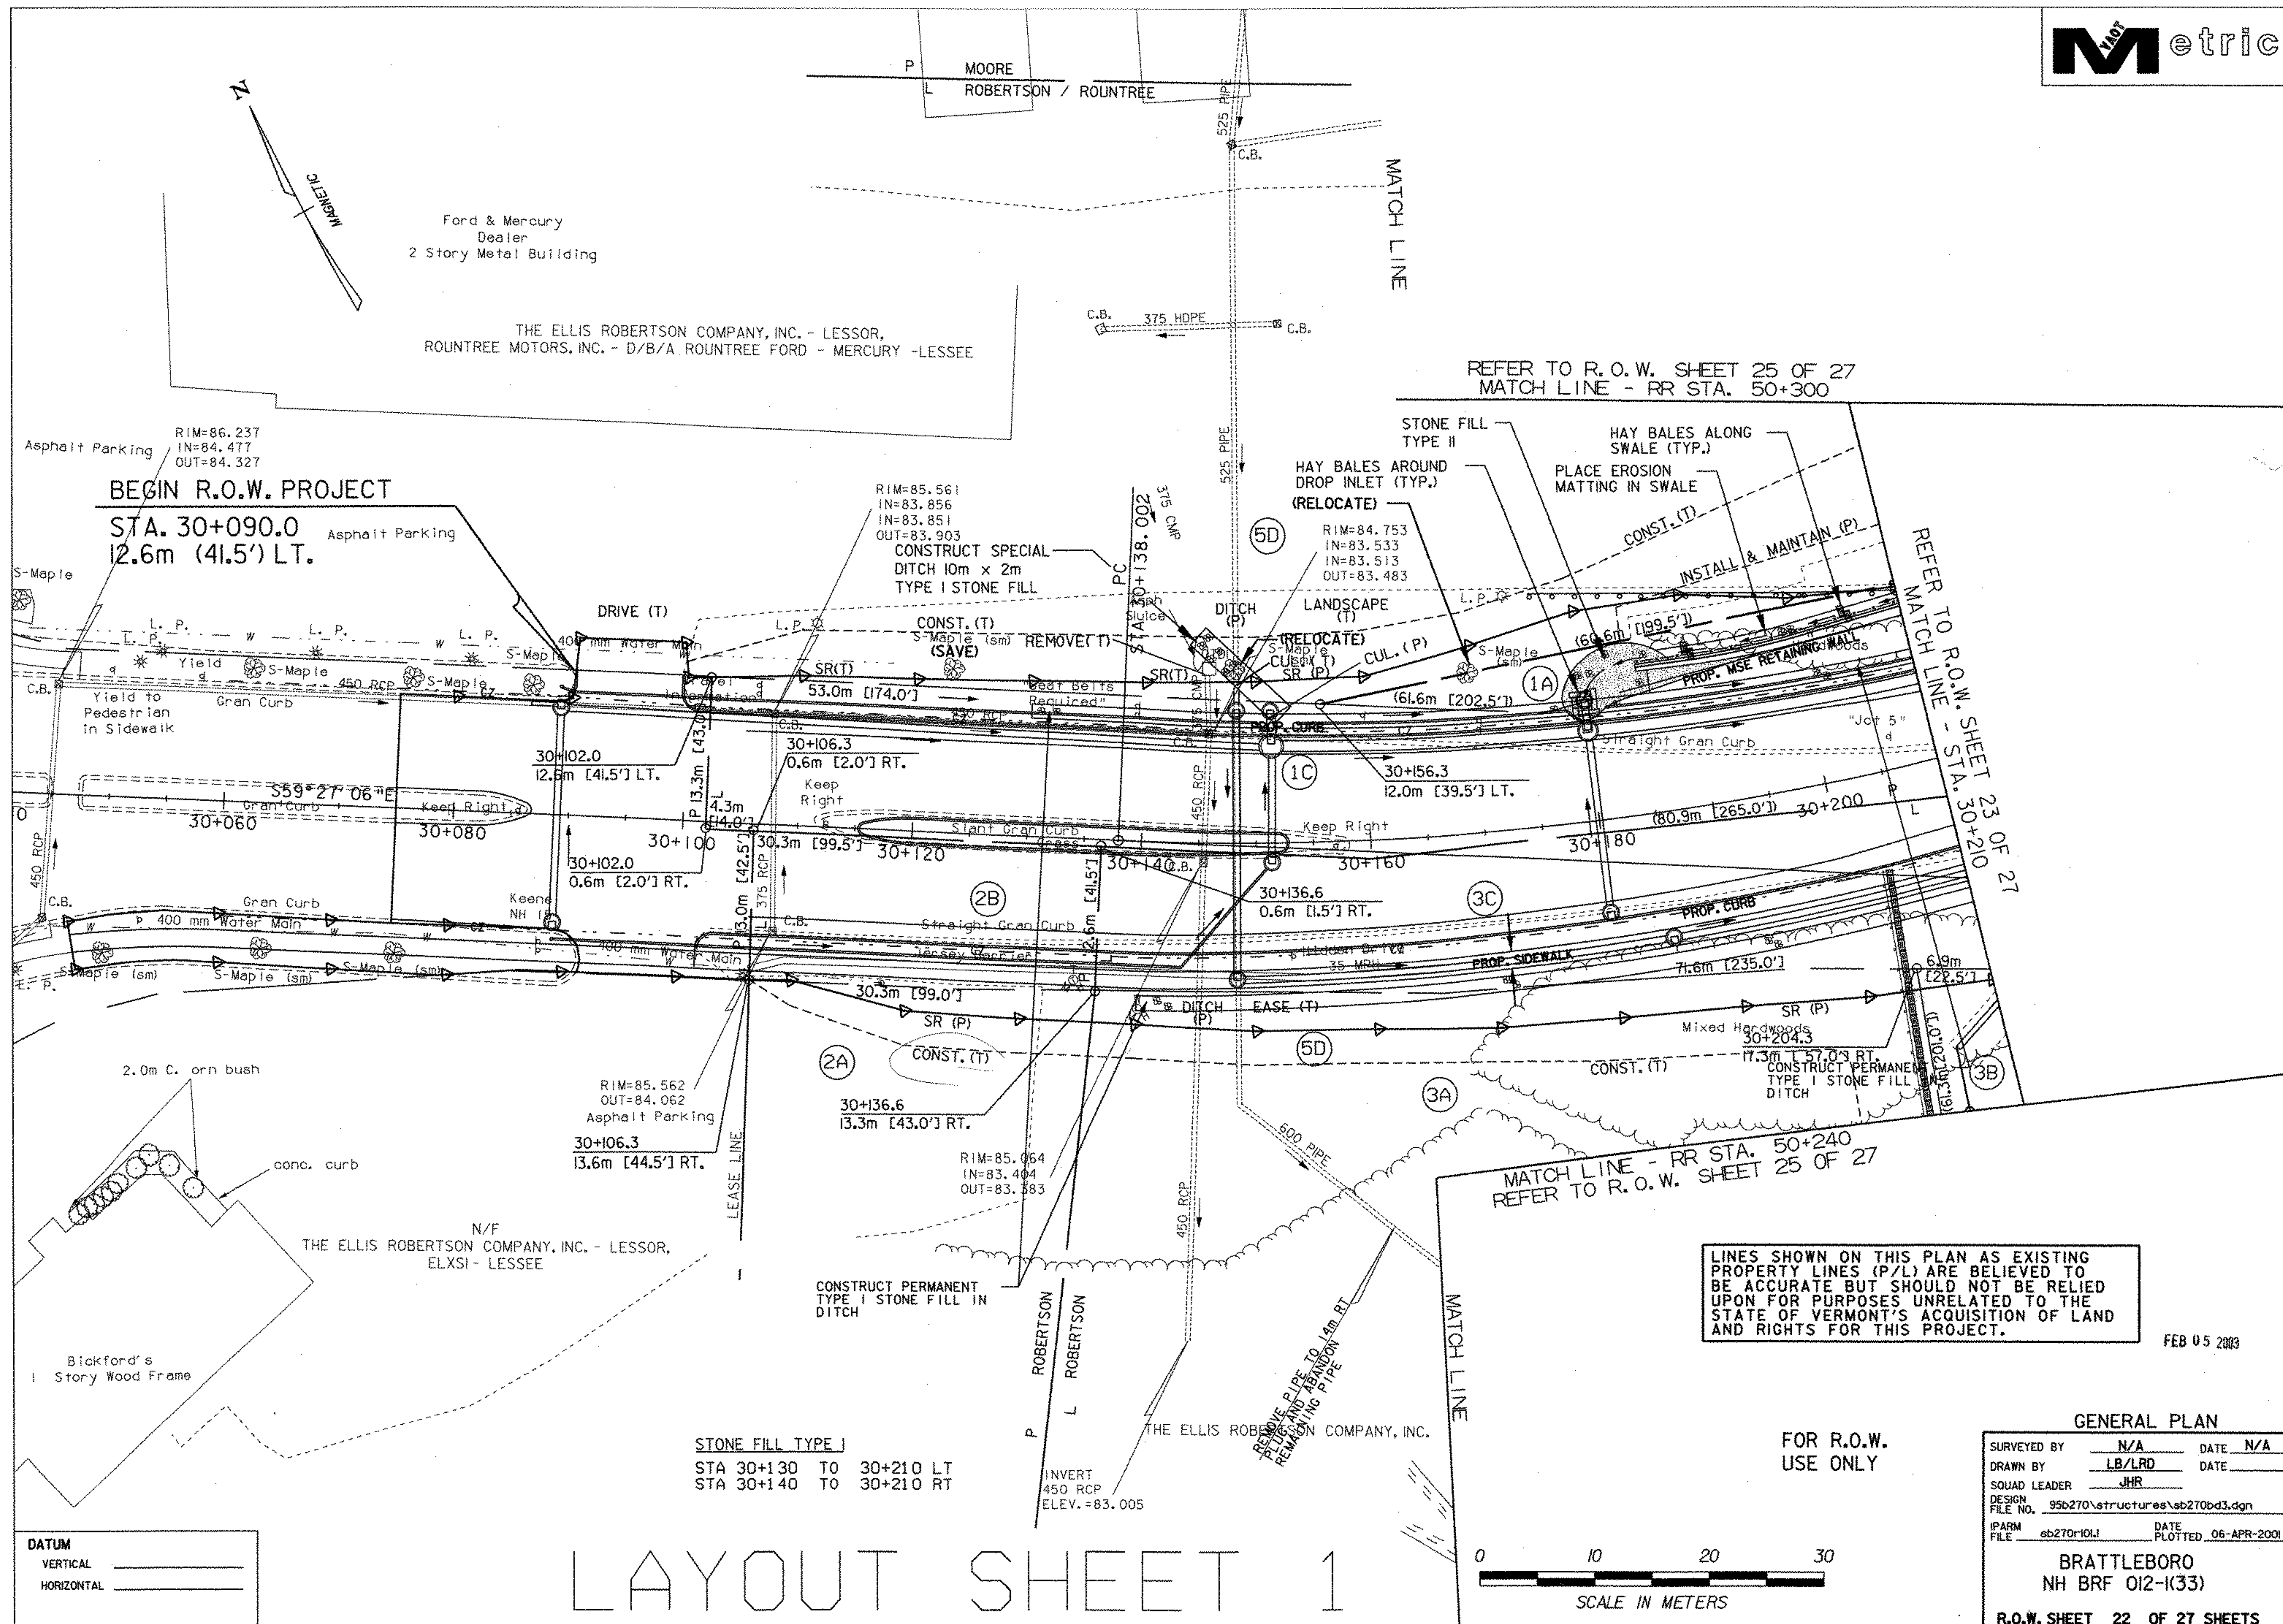

BEGIN R.O.W. PROJECT
STA. 30+090.0
12.6m (41.5') LT.

REFER TO R.O.W. SHEET 25 OF 27
MATCH LINE - RR STA. 50+300

REFER TO R.O.W. SHEET 23 OF 27
MATCH LINE - STA. 30+20

MATCH LINE - RR STA. 50+240
REFER TO R.O.W. SHEET 25 OF 27

LINES SHOWN ON THIS PLAN AS EXISTING
PROPERTY LINES (P/L) ARE BELIEVED TO
BE ACCURATE BUT SHOULD NOT BE RELIED
UPON FOR PURPOSES UNRELATED TO THE
STATE OF VERMONT'S ACQUISITION OF LAND
AND RIGHTS FOR THIS PROJECT.

FEB 05 2003

STONE FILL TYPE I
STA 30+130 TO 30+210 LT
STA 30+140 TO 30+210 RT

DATUM
VERTICAL _____
HORIZONTAL _____


LAYOUT SHEET 1



FOR R.O.W.
USE ONLY

GENERAL PLAN			
SURVEYED BY	N/A	DATE	N/A
DRAWN BY	LB/LRD	DATE	
SQUAD LEADER	JHR		
DESIGN FILE NO.	95b270\structures\sb270bd3.dgn		
IPARM FILE	eb270r101	DATE PLOTTED	06-APR-2001
BRATTLEBORO NH BR# 012-1(33)			
R.O.W. SHEET 22 OF 27 SHEETS			

7.31 Row

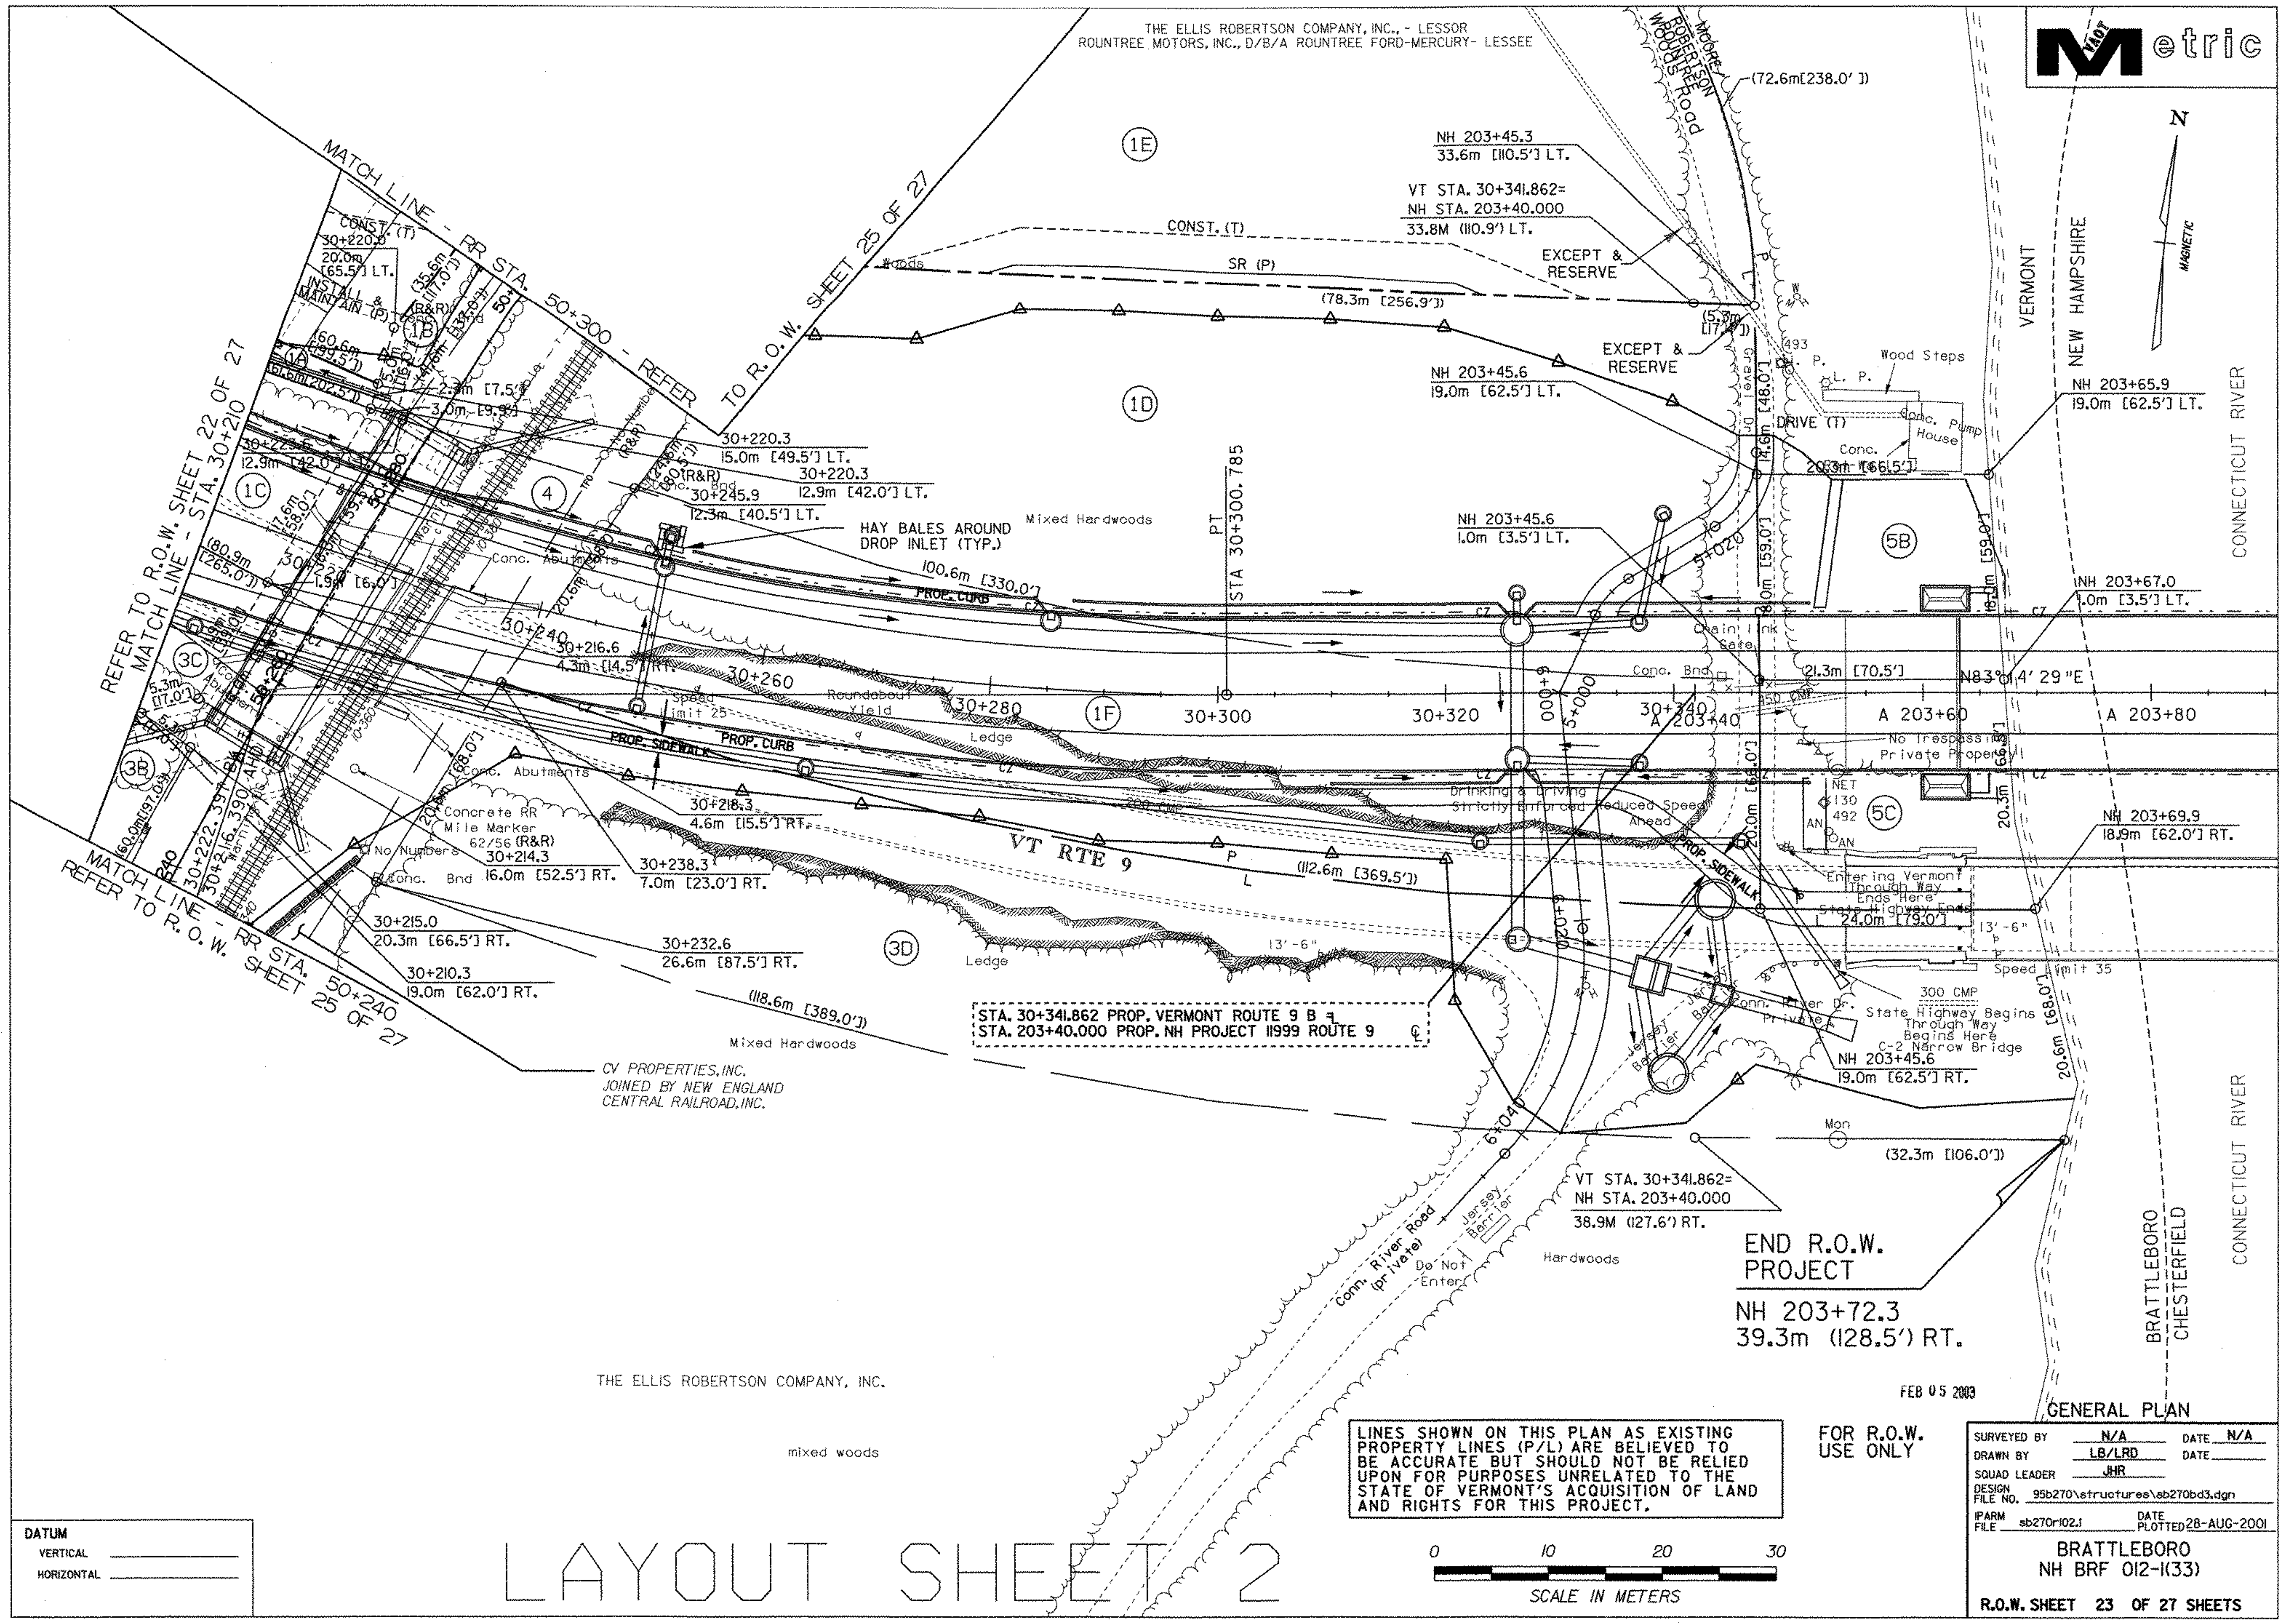

THE ELLIS ROBERTSON COMPANY, INC. - LESSOR
ROUNTREE MOTORS, INC., D/B/A ROUNTREE FORD-MERCURY - LESSEE

MATCH LINE - REFER TO R.O.W. SHEET 22 OF 27
MATCH LINE - STA. 30+210
MATCH LINE - REFER TO R.O.W. SHEET 25 OF 27
MATCH LINE - REFER TO R.O.W. SHEET 25 OF 27

STA. 30+341.862 PROP. VERMONT ROUTE 9 B
STA. 203+40.000 PROP. NH PROJECT 1999 ROUTE 9

END R.O.W. PROJECT
NH 203+72.3
39.3m (128.5') RT.

THE ELLIS ROBERTSON COMPANY, INC.

FEB 05 2003

GENERAL PLAN

LINES SHOWN ON THIS PLAN AS EXISTING PROPERTY LINES (P/L) ARE BELIEVED TO BE ACCURATE BUT SHOULD NOT BE RELIED UPON FOR PURPOSES UNRELATED TO THE STATE OF VERMONT'S ACQUISITION OF LAND AND RIGHTS FOR THIS PROJECT.

FOR R.O.W. USE ONLY

SURVEYED BY	N/A	DATE	N/A
DRAWN BY	LB/LRD	DATE	
SQUAD LEADER	JHR		
DESIGN FILE NO.	95b270\structures\sb270bd3.dgn		
IFARM FILE	sb270r102.f	DATE PLOTTED	28-AUG-2001


BRATTLEBORO NH BR F 012-(K33)
R.O.W. SHEET 23 OF 27 SHEETS

DATUM	
VERTICAL	_____
HORIZONTAL	_____


LAYOUT SHEET 2



237 low

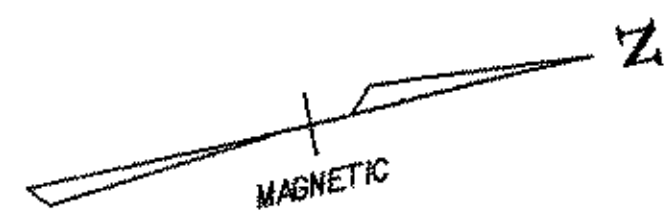

JACK TARMY REVOCABLE TRUST, JONATHAN BUMP, TRUSTEE, LESSOR AND ETTA E. TARMY REVOCABLE TRUST, JONATHAN BUMP TRUSTEE, LESSOR AND JACK TARMY LUMBER COMPANY, INC. - LESSEE

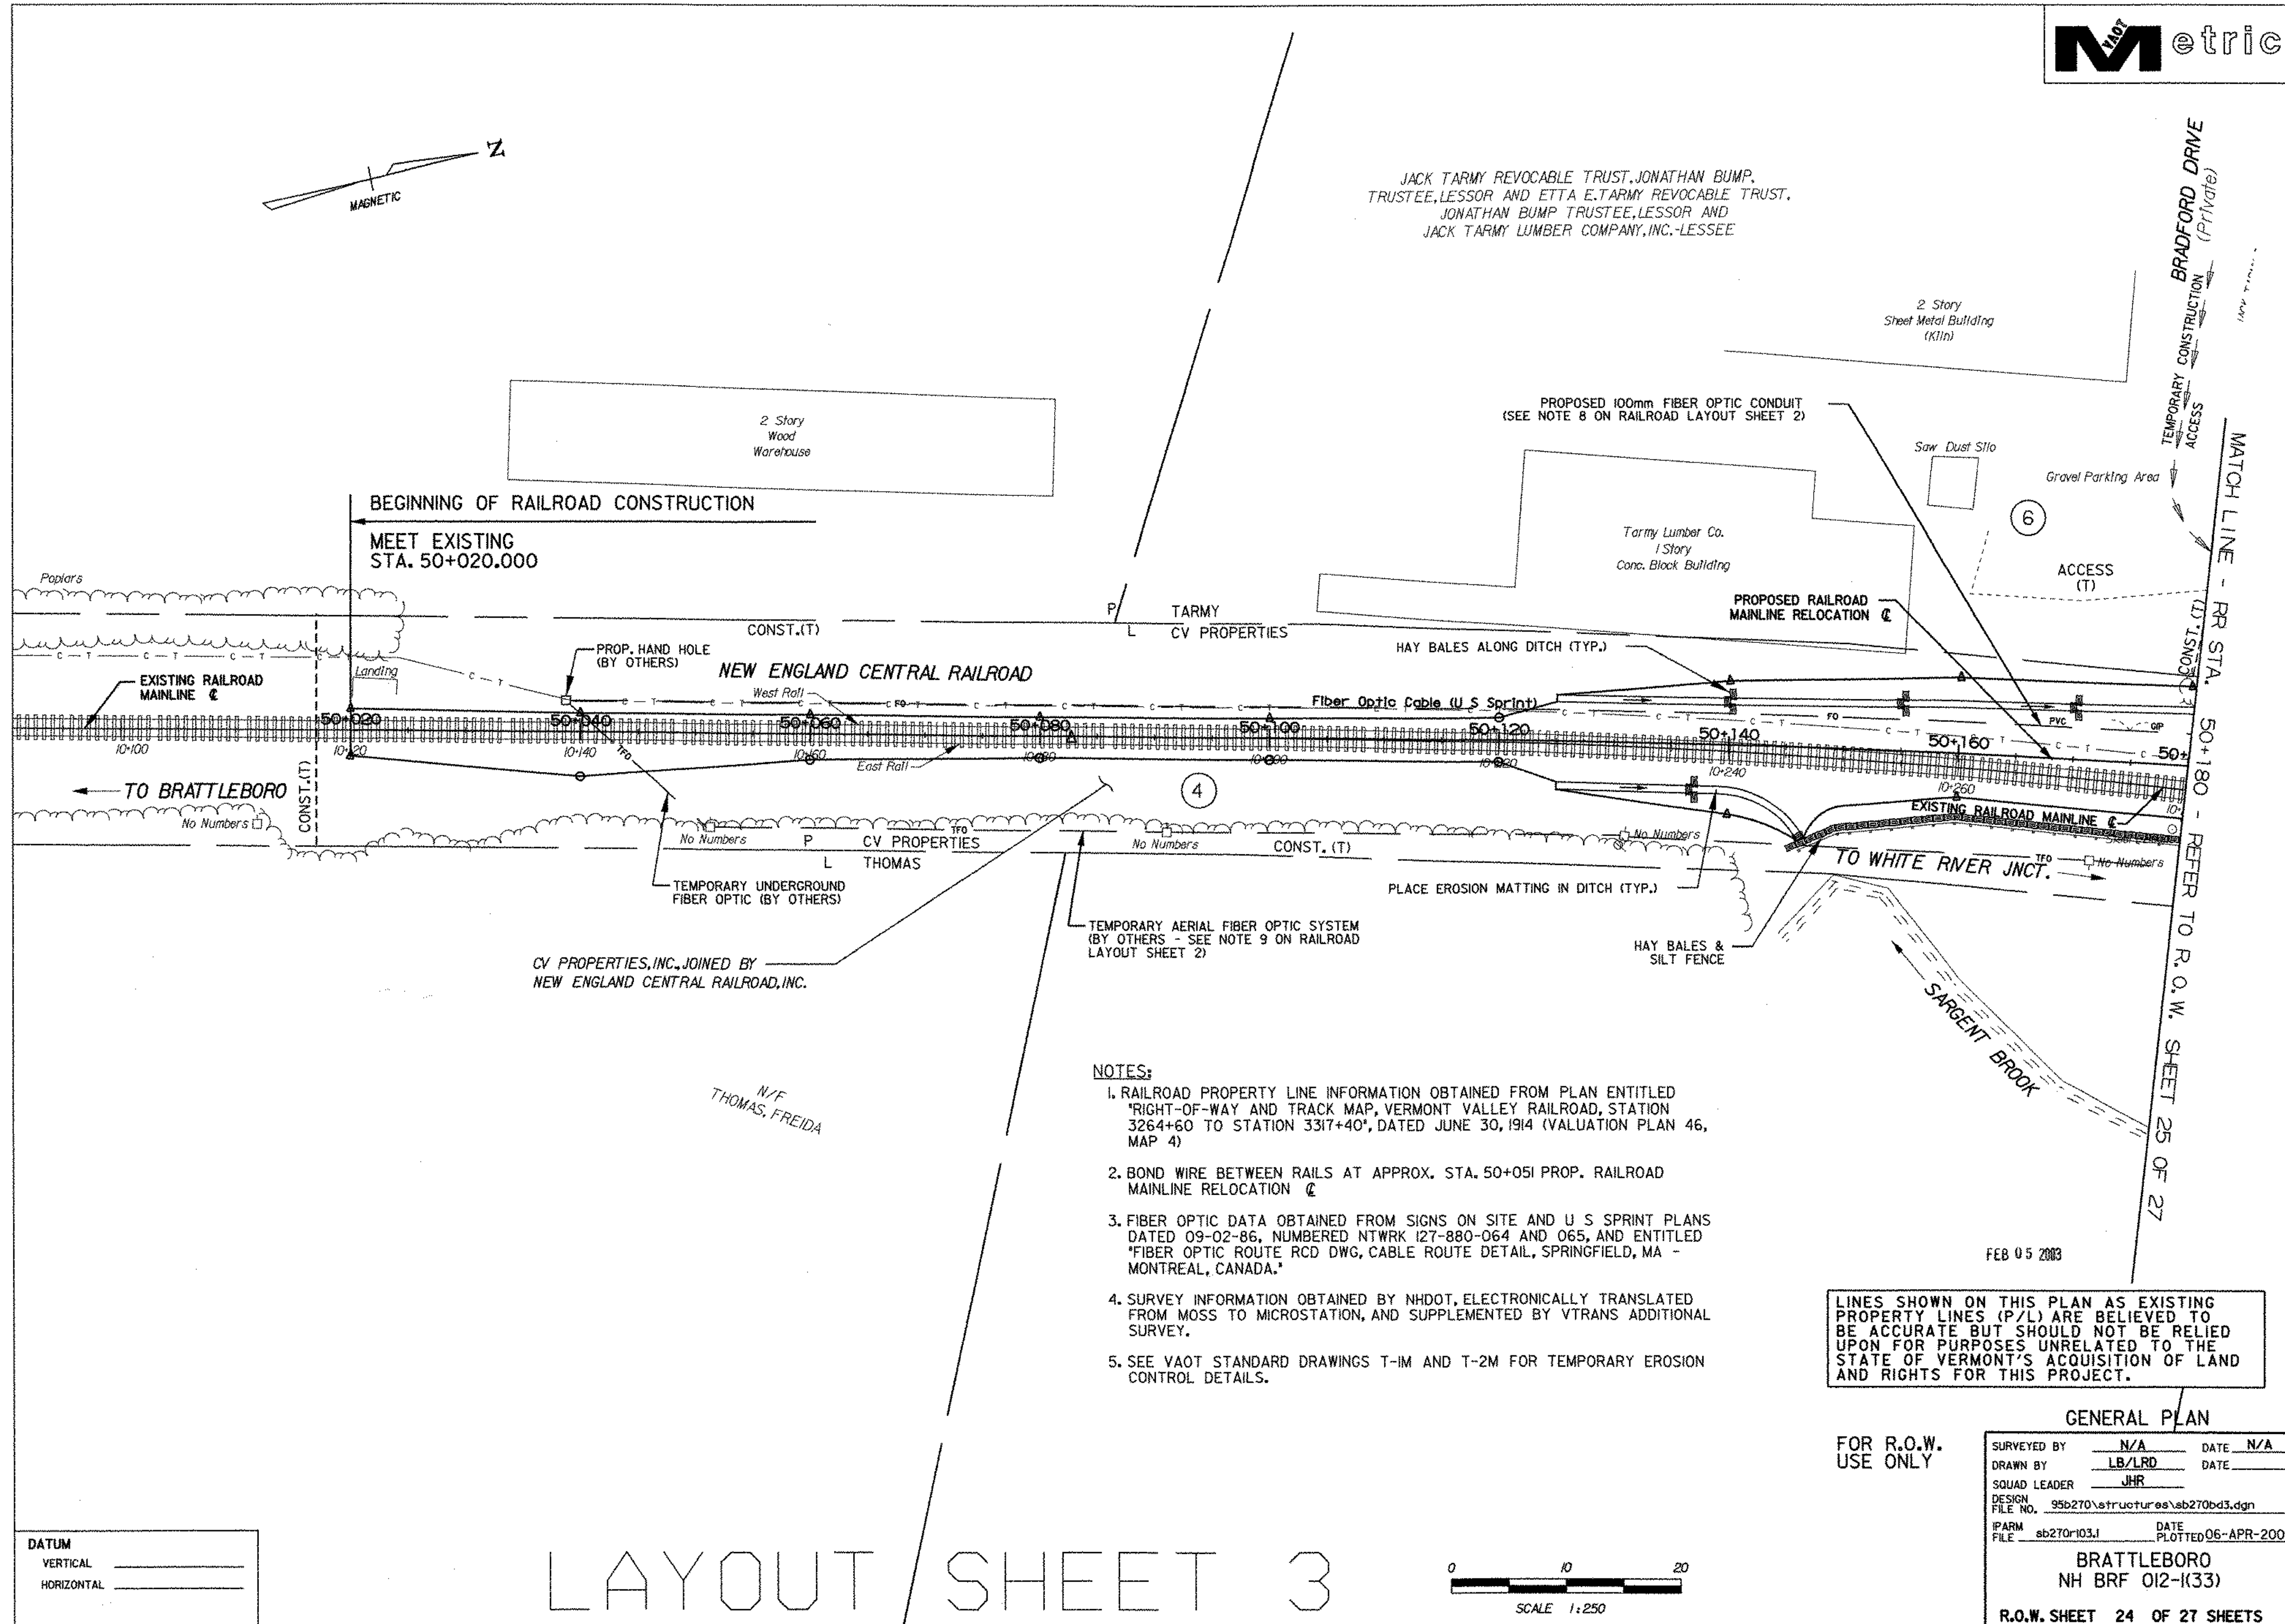

BEGINNING OF RAILROAD CONSTRUCTION

MEET EXISTING STA. 50+020.000

NEW ENGLAND CENTRAL RAILROAD

PROPOSED RAILROAD MAINLINE RELOCATION

EXISTING RAILROAD MAINLINE

TO BRATTLEBORO

TO WHITE RIVER JUNCT.

- NOTES:**
- RAILROAD PROPERTY LINE INFORMATION OBTAINED FROM PLAN ENTITLED "RIGHT-OF-WAY AND TRACK MAP, VERMONT VALLEY RAILROAD, STATION 3264+60 TO STATION 3317+40", DATED JUNE 30, 1914 (VALUATION PLAN 46, MAP 4)
 - BOND WIRE BETWEEN RAILS AT APPROX. STA. 50+051 PROP. RAILROAD MAINLINE RELOCATION
 - FIBER OPTIC DATA OBTAINED FROM SIGNS ON SITE AND U S SPRINT PLANS DATED 09-02-86, NUMBERED NTRK 127-880-064 AND 065, AND ENTITLED "FIBER OPTIC ROUTE RCD DWG, CABLE ROUTE DETAIL, SPRINGFIELD, MA - MONTREAL, CANADA."
 - SURVEY INFORMATION OBTAINED BY NHDOT, ELECTRONICALLY TRANSLATED FROM MOSS TO MICROSTATION, AND SUPPLEMENTED BY VTRANS ADDITIONAL SURVEY.
 - SEE VAOT STANDARD DRAWINGS T-1M AND T-2M FOR TEMPORARY EROSION CONTROL DETAILS.

LINES SHOWN ON THIS PLAN AS EXISTING PROPERTY LINES (P/L) ARE BELIEVED TO BE ACCURATE BUT SHOULD NOT BE RELIED UPON FOR PURPOSES UNRELATED TO THE STATE OF VERMONT'S ACQUISITION OF LAND AND RIGHTS FOR THIS PROJECT.

FEB 05 2003

DATUM
 VERTICAL _____
 HORIZONTAL _____

LAYOUT SHEET 3



GENERAL PLAN



FOR R.O.W. USE ONLY

SURVEYED BY	N/A	DATE	N/A
DRAWN BY	LB/LRD	DATE	
SQUAD LEADER	JHR		
DESIGN FILE NO.	95b270\structures\sb270bd3.dgn		
IPARM FILE	sb270r103.l	DATE PLOTTED	06-APR-2001

BRATTLEBORO
 NH BR 012-1(33)

R.O.W. SHEET 24 OF 27 SHEETS

233 ROW

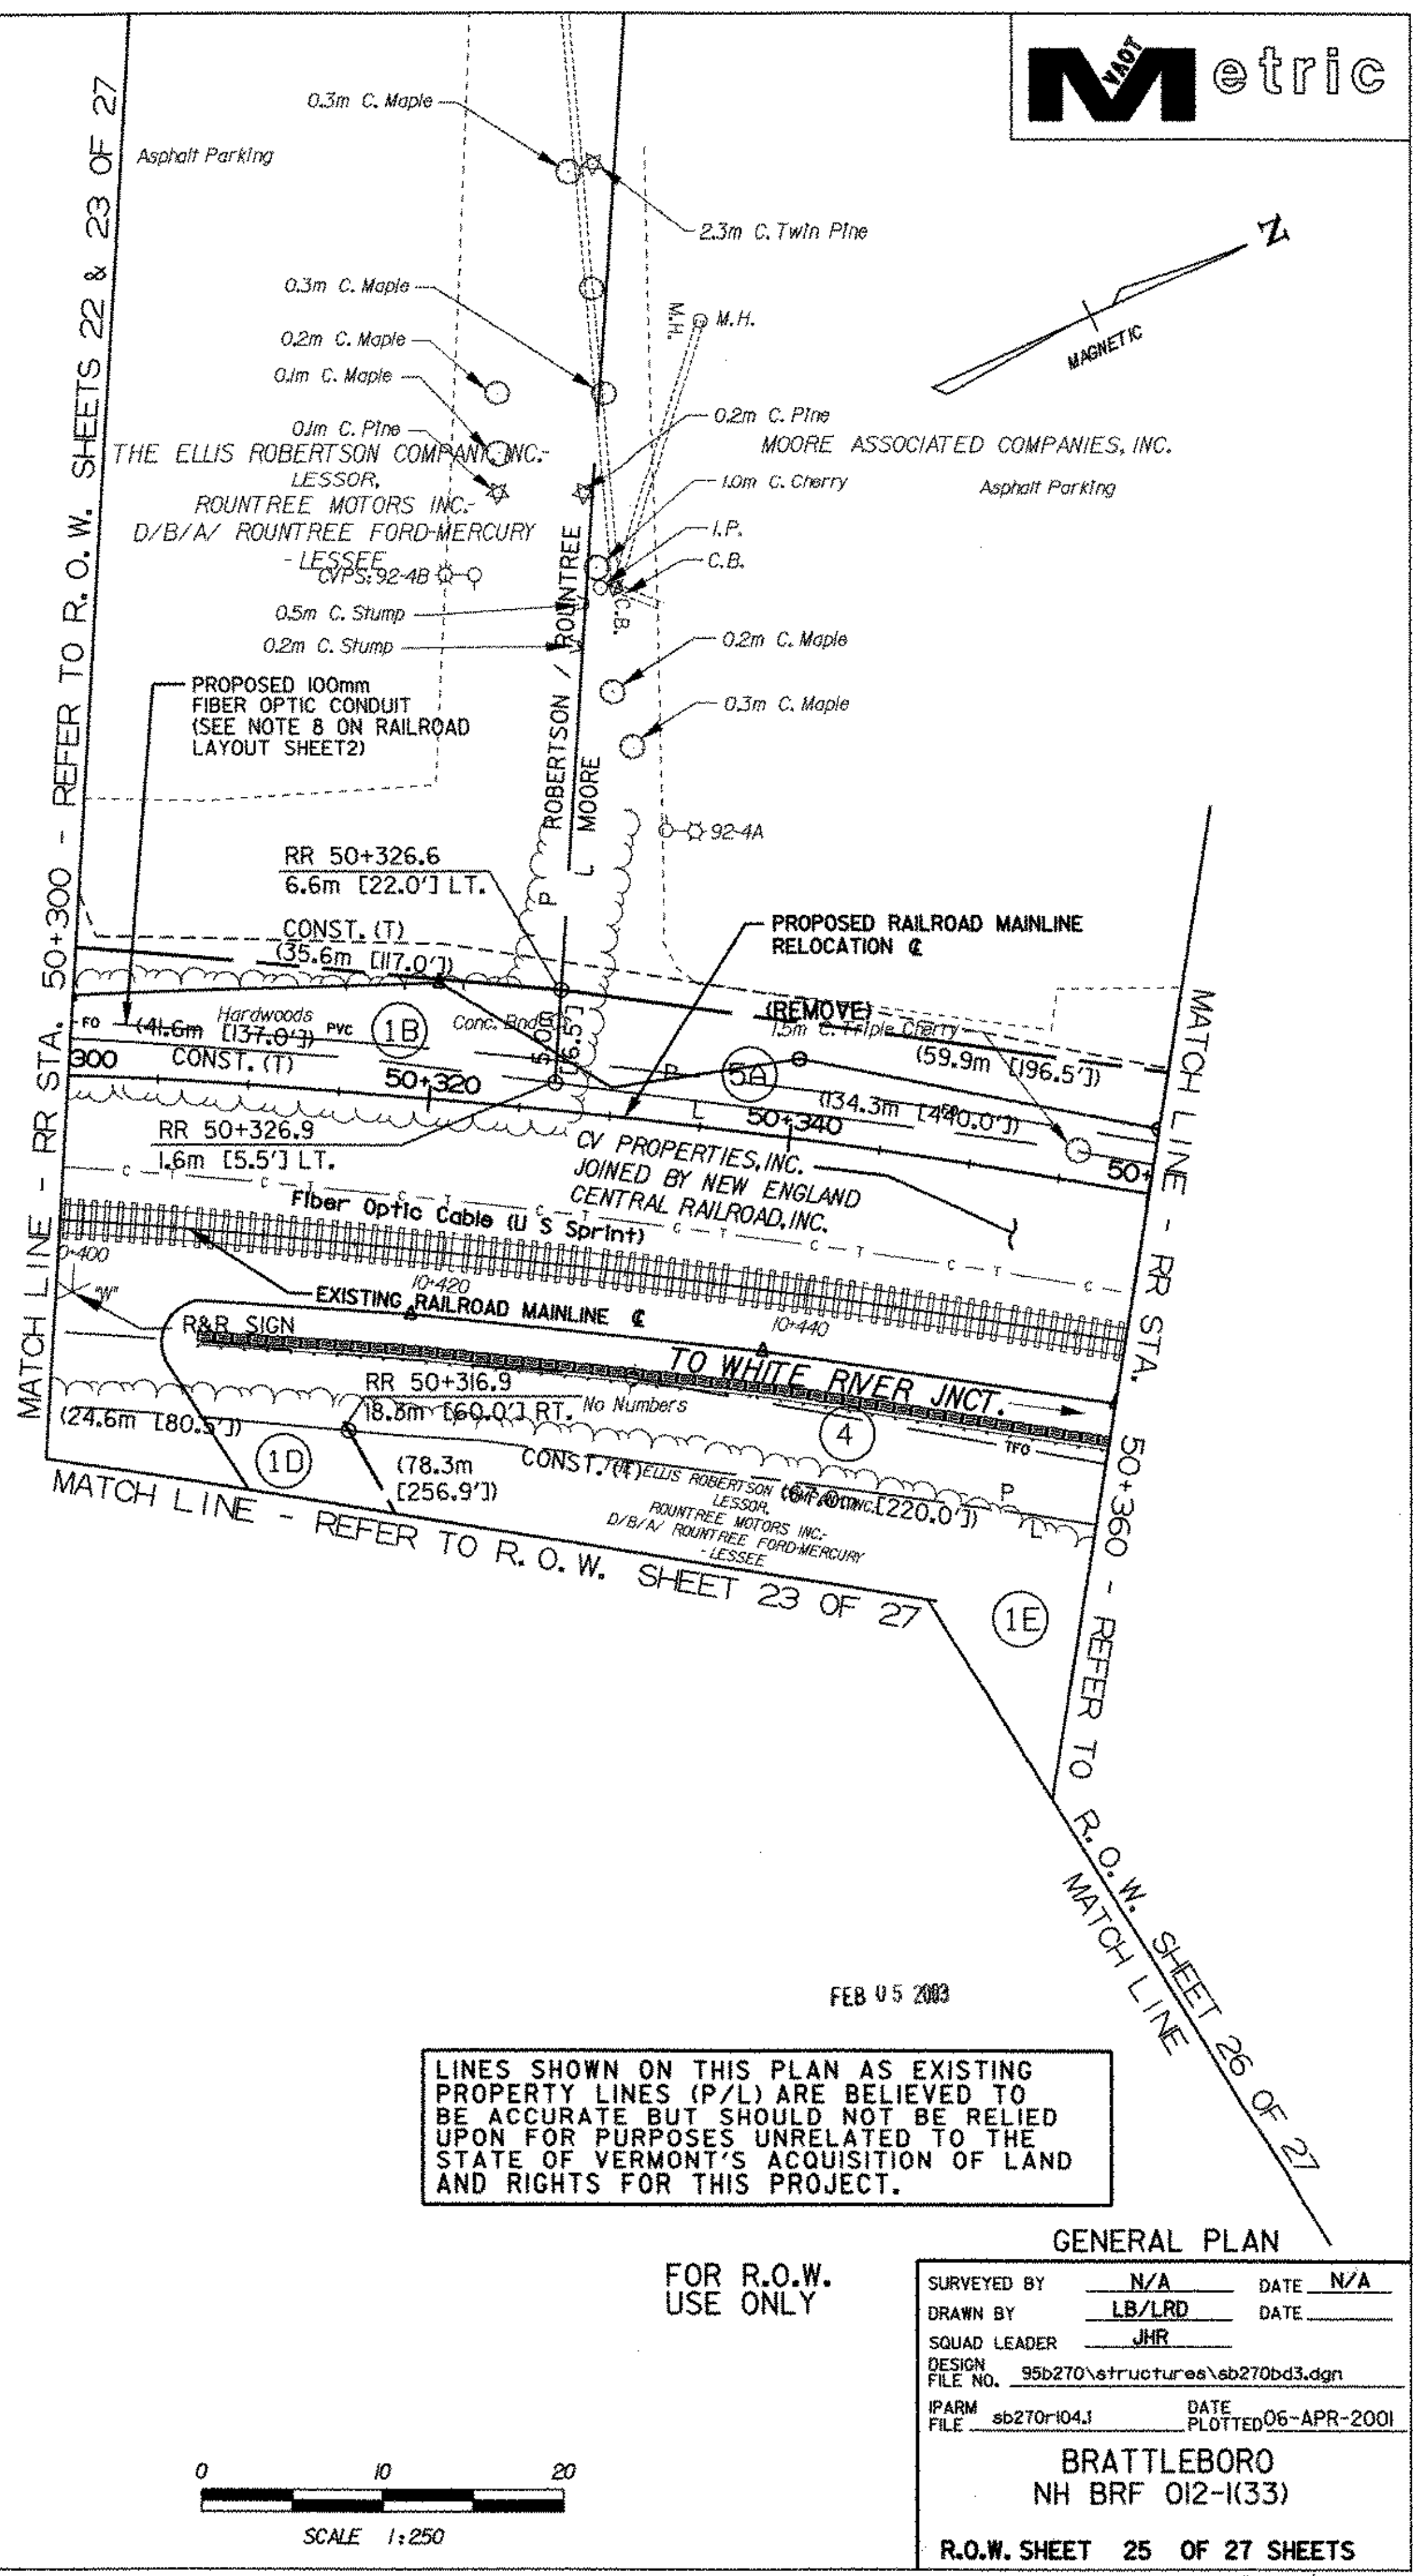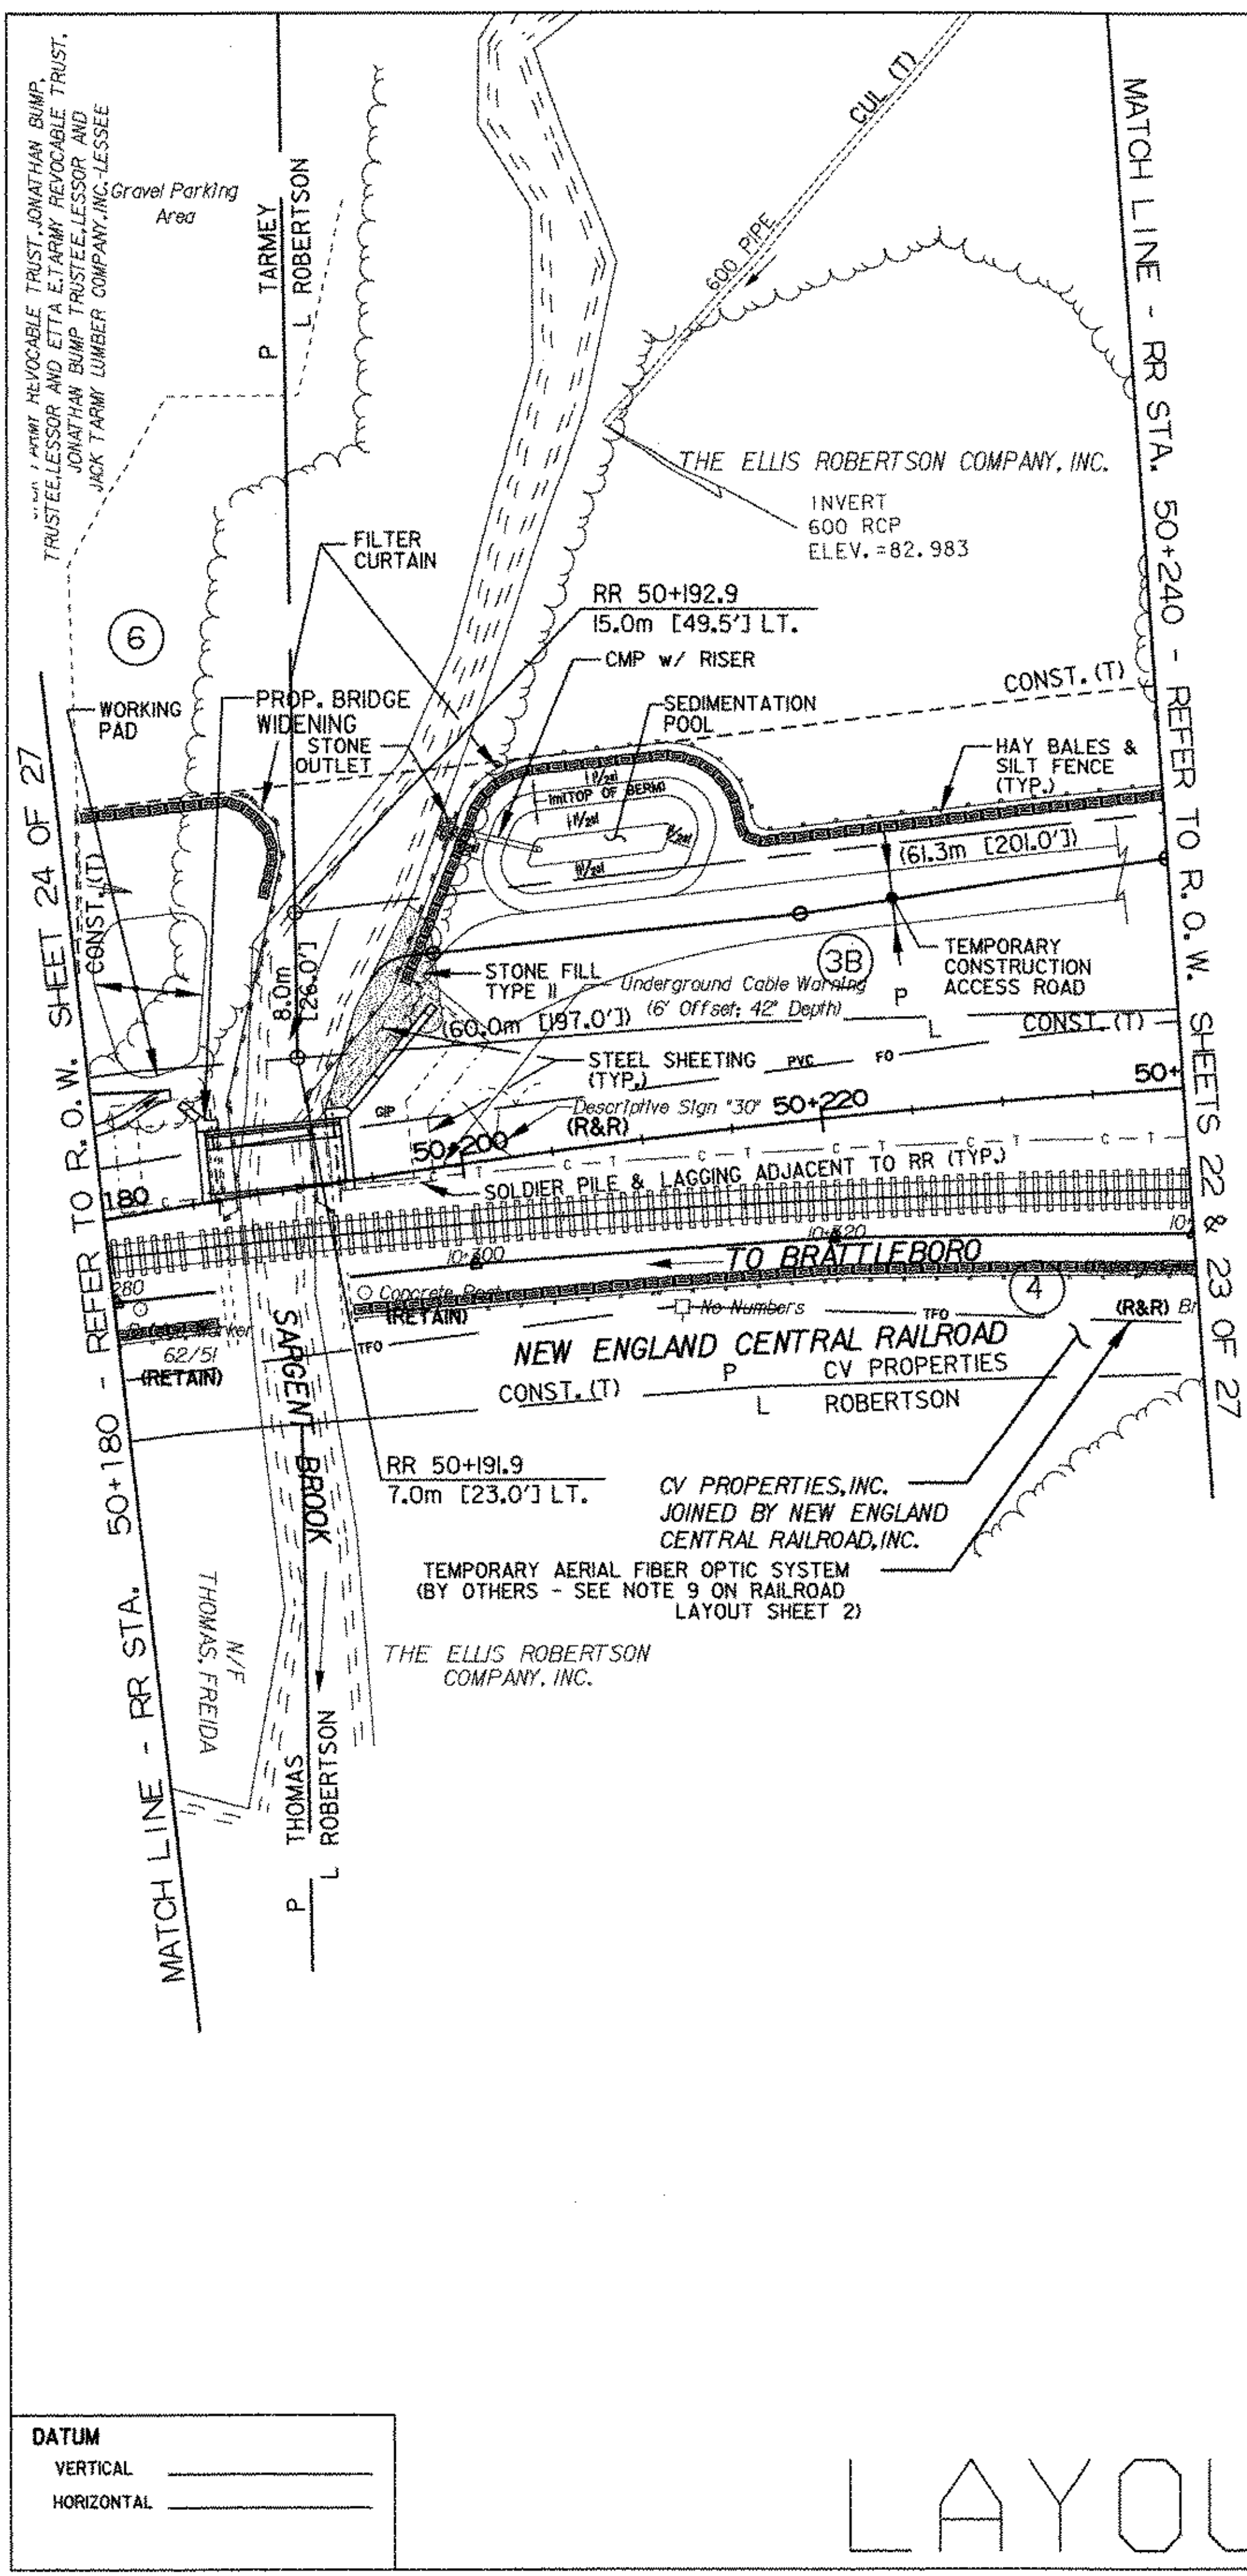

LINES SHOWN ON THIS PLAN AS EXISTING PROPERTY LINES (P/L) ARE BELIEVED TO BE ACCURATE BUT SHOULD NOT BE RELIED UPON FOR PURPOSES UNRELATED TO THE STATE OF VERMONT'S ACQUISITION OF LAND AND RIGHTS FOR THIS PROJECT.

DATUM

VERTICAL	_____
HORIZONTAL	_____

LAYOUT SHEET 4




FOR R.O.W. USE ONLY

GENERAL PLAN

SURVEYED BY	N/A	DATE	N/A
DRAWN BY	LB/LRD	DATE	
SQUAD LEADER	JHR		
DESIGN FILE NO.	95b270\structures\sb270bd3.dgn		
IPARM FILE	sb270r104J	DATE PLOTTED	06-APR-2001
BRATTLEBORO NH BR F 012-I(33)			
R.O.W. SHEET 25 OF 27 SHEETS			

234 ROW

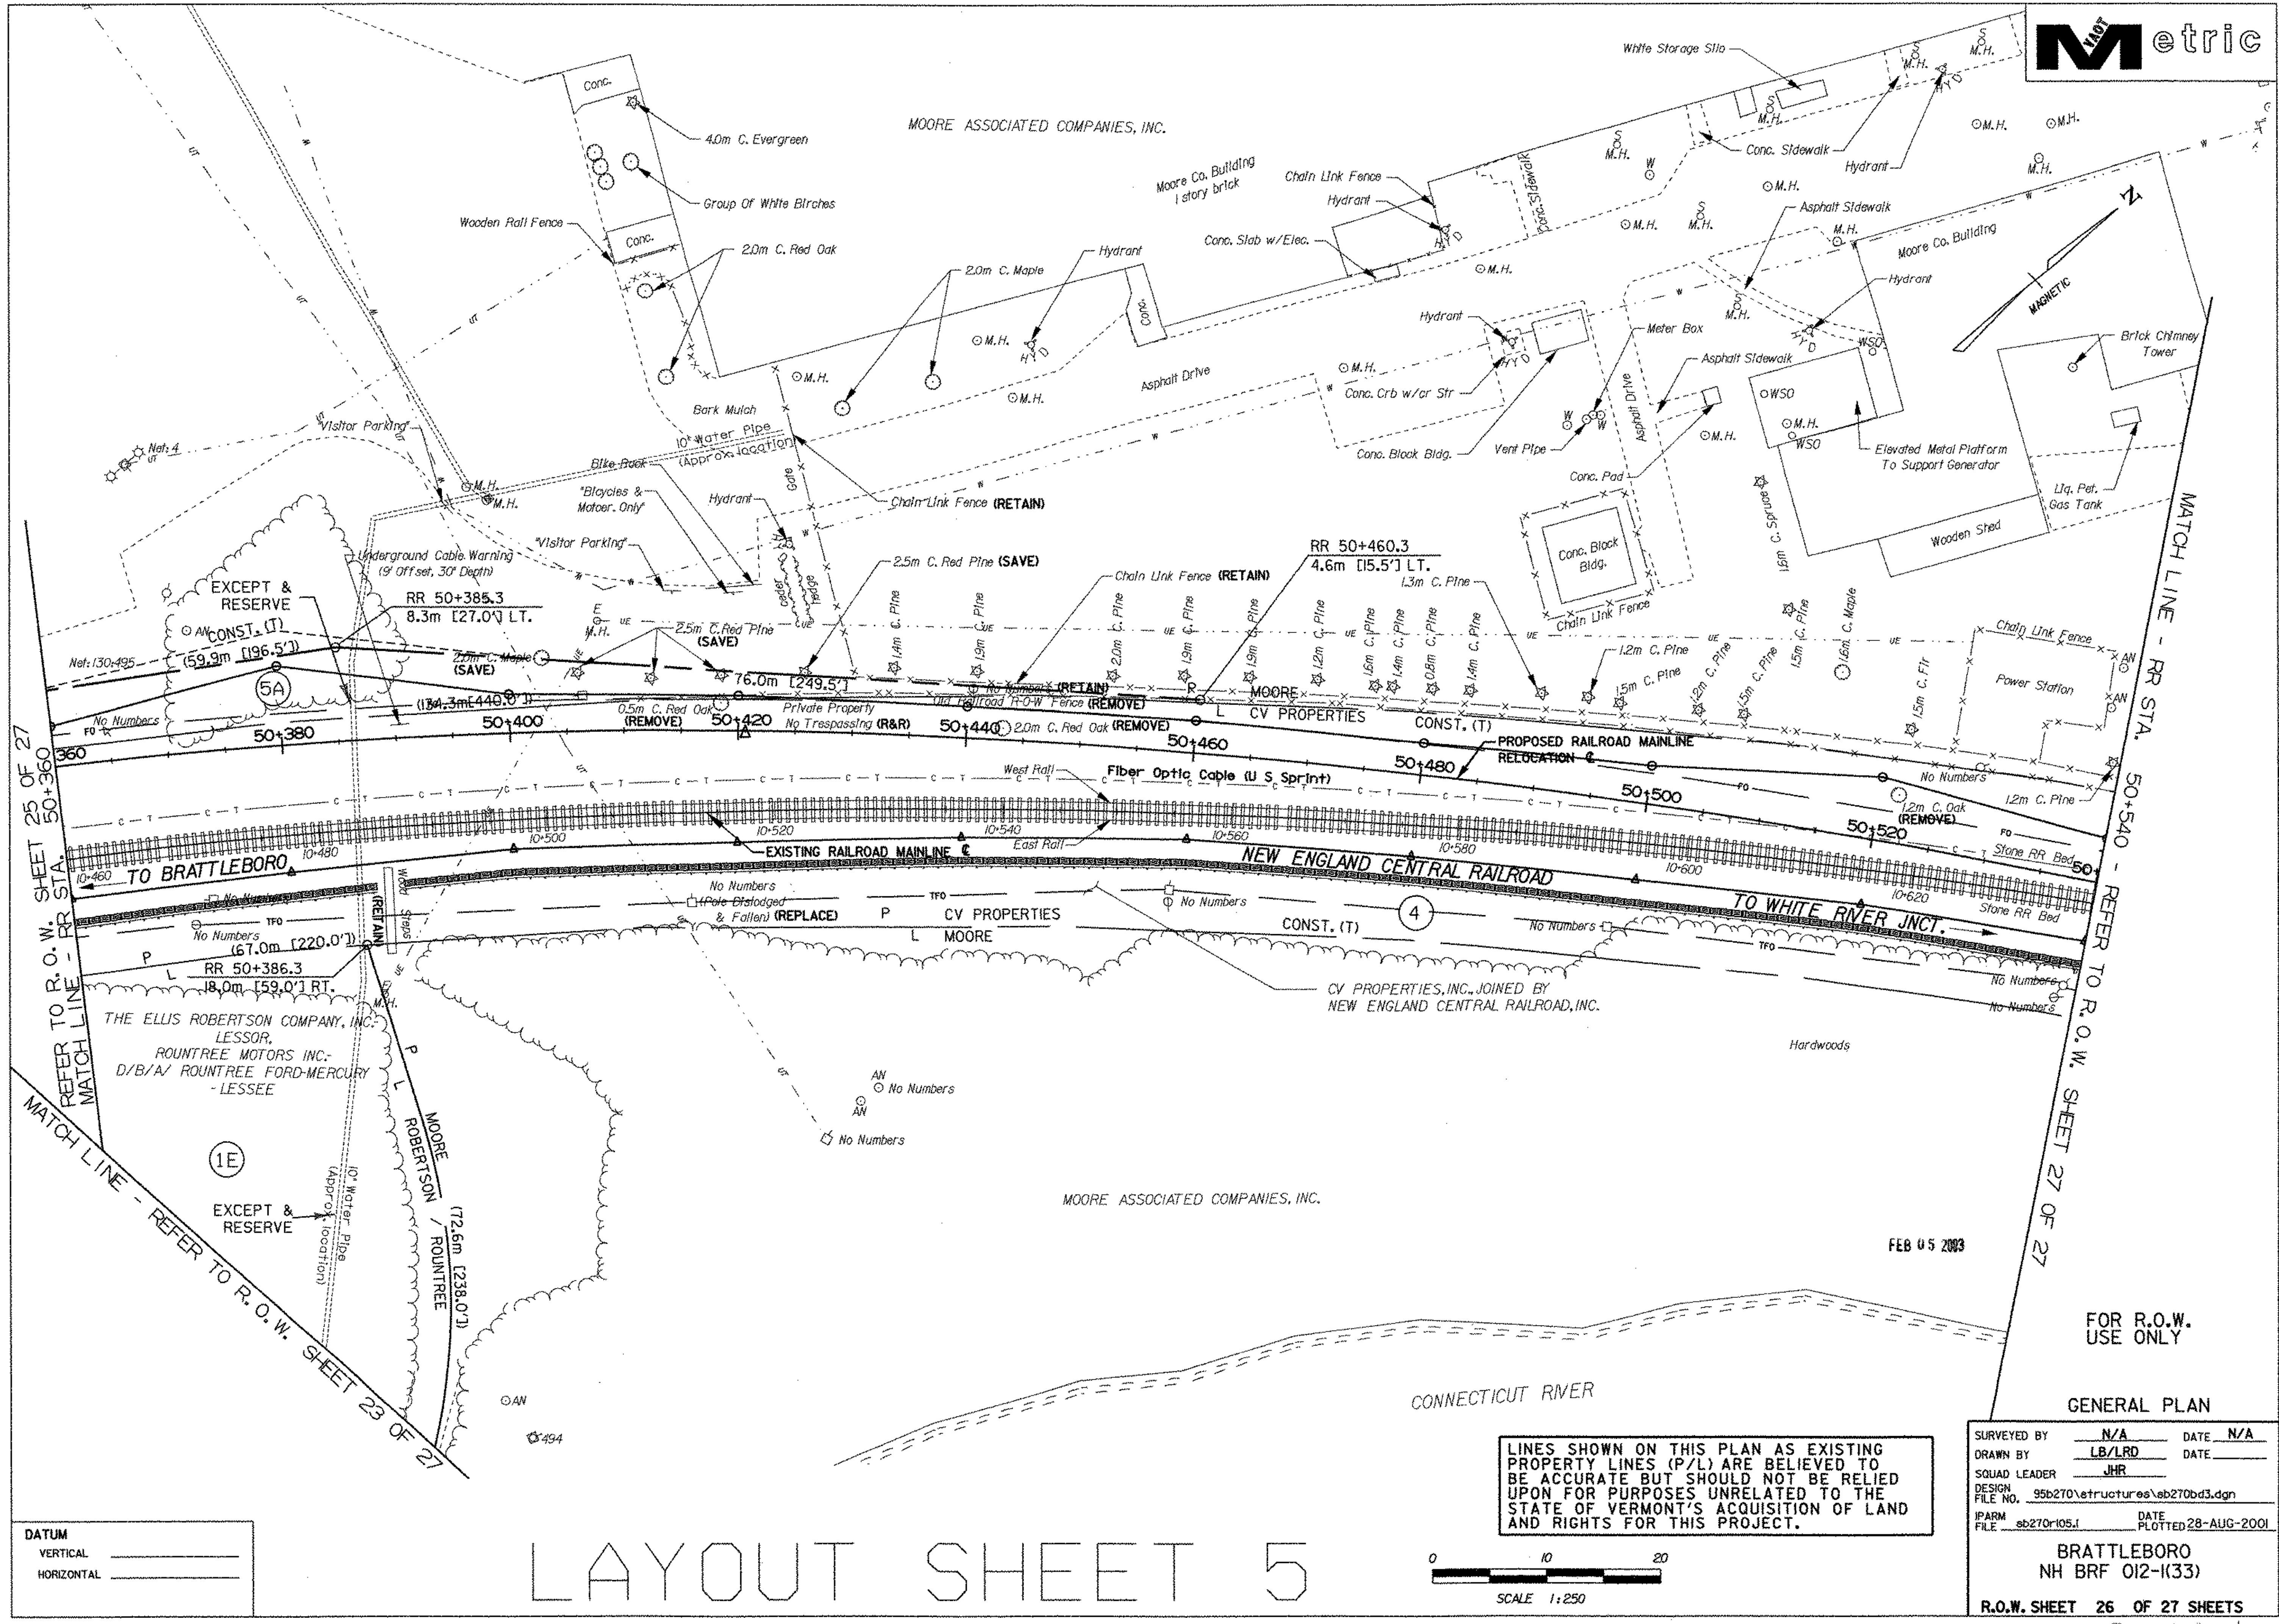


REFER TO R.O.W. SHEET 25 OF 27
MATCH LINE - RR STA 50+360

REFER TO R.O.W. SHEET 23 OF 27
MATCH LINE - REFER TO R.O.W. SHEET 23 OF 27

REFER TO R.O.W. SHEET 27 OF 27
MATCH LINE - RR STA 50+540 - REFER TO R.O.W. SHEET 27 OF 27

DATUM
VERTICAL _____
HORIZONTAL _____



LAYOUT SHEET 5

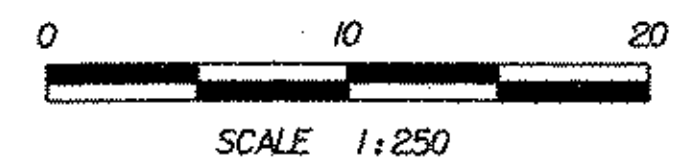

LINES SHOWN ON THIS PLAN AS EXISTING PROPERTY LINES (P/L) ARE BELIEVED TO BE ACCURATE BUT SHOULD NOT BE RELIED UPON FOR PURPOSES UNRELATED TO THE STATE OF VERMONT'S ACQUISITION OF LAND AND RIGHTS FOR THIS PROJECT.

SURVEYED BY	N/A	DATE	N/A
DRAWN BY	LB/LRD	DATE	
SQUAD LEADER	JHR		
DESIGN FILE NO.	95b270\structures\sb270bd3.dgn		
IPARM FILE	sb270r105.l	DATE PLOTTED	28-AUG-2001
BRATTLEBORO NH BR# 012-I(33)			
R.O.W. SHEET 26 OF 27 SHEETS			

235 Row

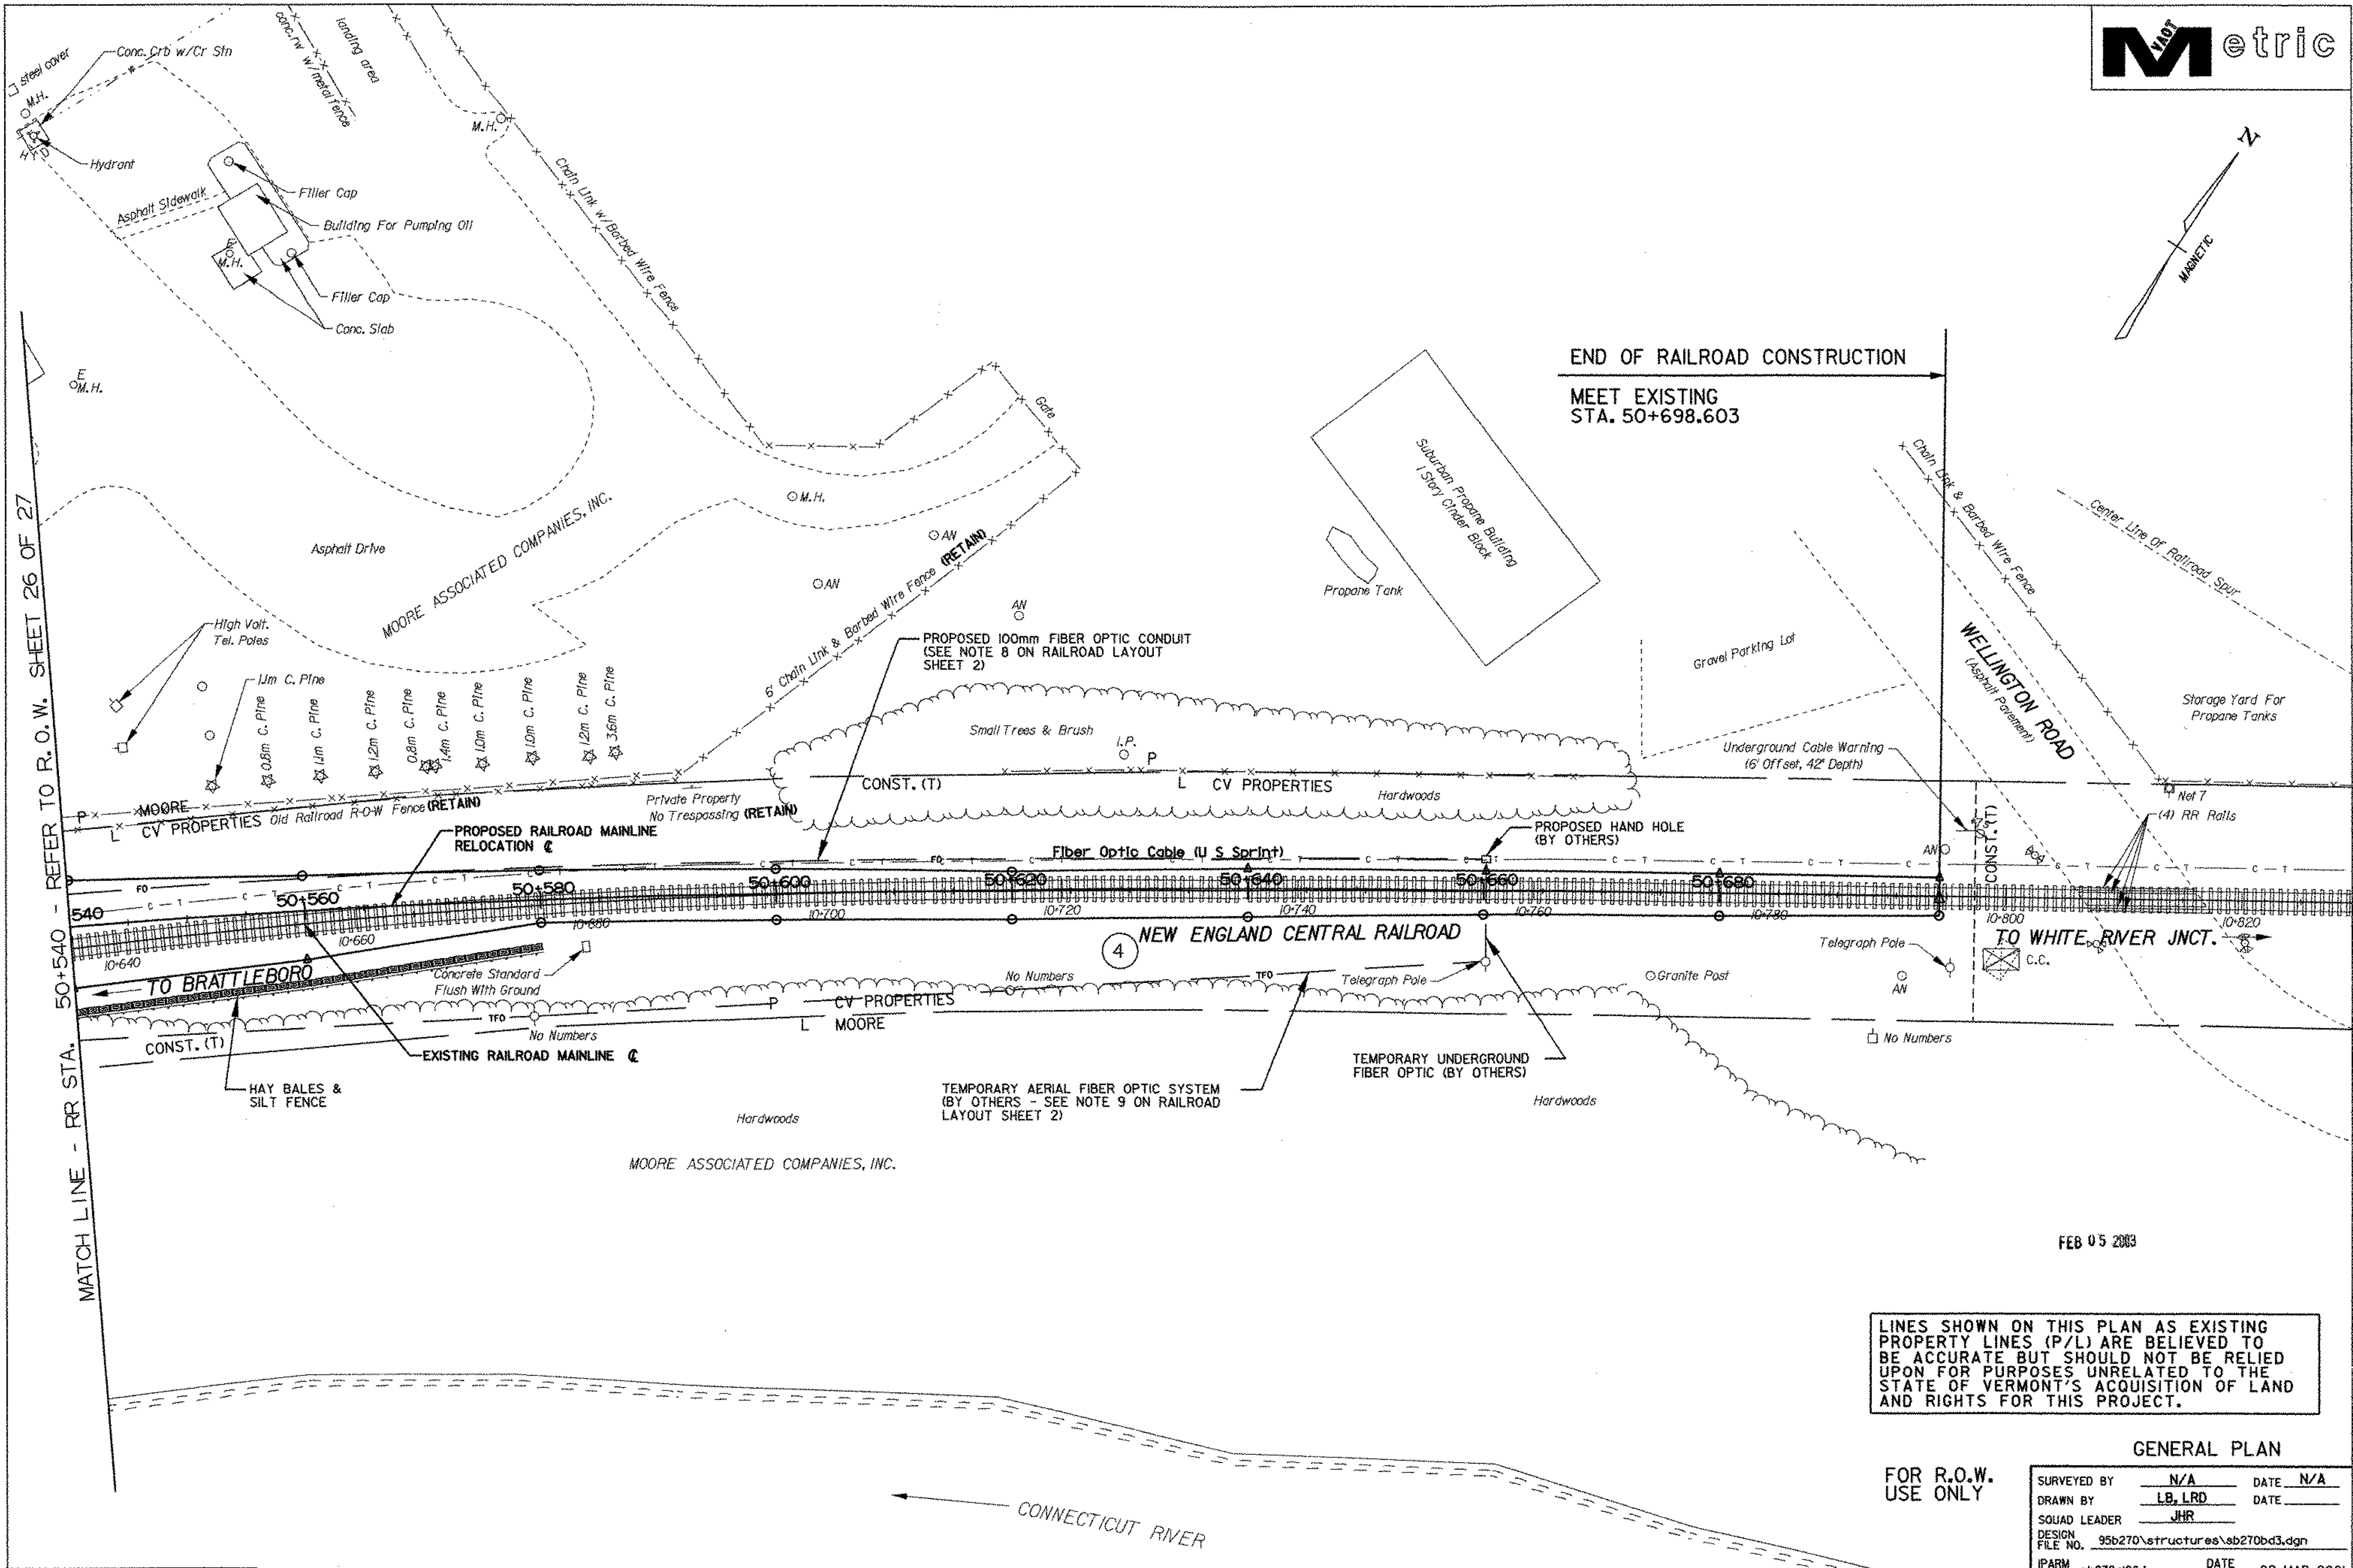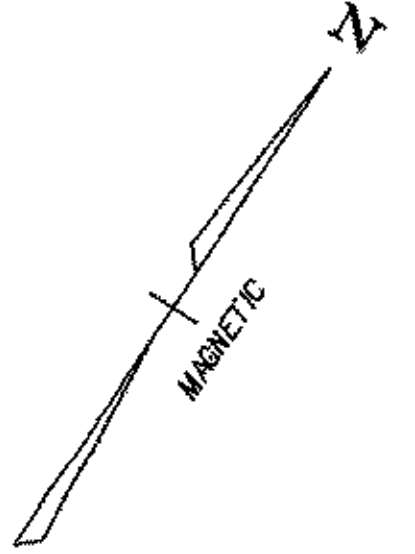

MATCH LINE - RR STA. 50+540 REFER TO R.O.W. SHEET 26 OF 27

LINES SHOWN ON THIS PLAN AS EXISTING PROPERTY LINES (P/L) ARE BELIEVED TO BE ACCURATE BUT SHOULD NOT BE RELIED UPON FOR PURPOSES UNRELATED TO THE STATE OF VERMONT'S ACQUISITION OF LAND AND RIGHTS FOR THIS PROJECT.

FEB 05 2003

GENERAL PLAN

FOR R.O.W. USE ONLY

SURVEYED BY	N/A	DATE	N/A
DRAWN BY	LB, LRD	DATE	
SQUAD LEADER	JHR	DATE	
DESIGN FILE NO.	95b270\structures\sb270bd3.dgn		
IPARM FILE	sb270r106.l	DATE PLOTTED	09-MAR-2001

BRATTLEBORO
NH BR# 012-1(33)


R.O.W. SHEET 27 OF 27 SHEETS

235 ROW

DATUM

VERTICAL	_____
HORIZONTAL	_____

LAYOUT SHEET 6

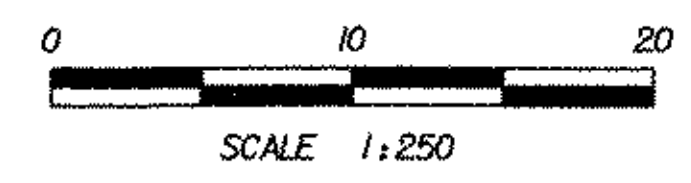

CONNECTICUT RIVER