

PROJECT LOCATION:
ON VT. ROUTE 12, APPROXIMATELY 0.40 MILES SOUTH OF THE JUNCTION
OF VT. ROUTE 12 AND VT. ROUTE 107


PROJECT DATA:
LENGTH OF BRIDGE: 120.55 FT
LENGTH OF ROADWAY: 569.45 FT
LENGTH OF PROJECT: 690.00 FT

PROJECT DESCRIPTION:
THE PROJECT CONSISTS OF REPLACING THE EXISTING STRUCTURE WITH A
NEW SIMPLE SPAN BRIDGE, ROADWAY APPROACHES AND CHANNEL WORK.


STATE OF VERMONT AGENCY OF TRANSPORTATION



PROPOSED IMPROVEMENT BRIDGE PROJECT TOWN OF BETHEL COUNTY OF WINDSOR ROUTE NO. : VT 12, MAJOR COLLECTOR, BRIDGE 30

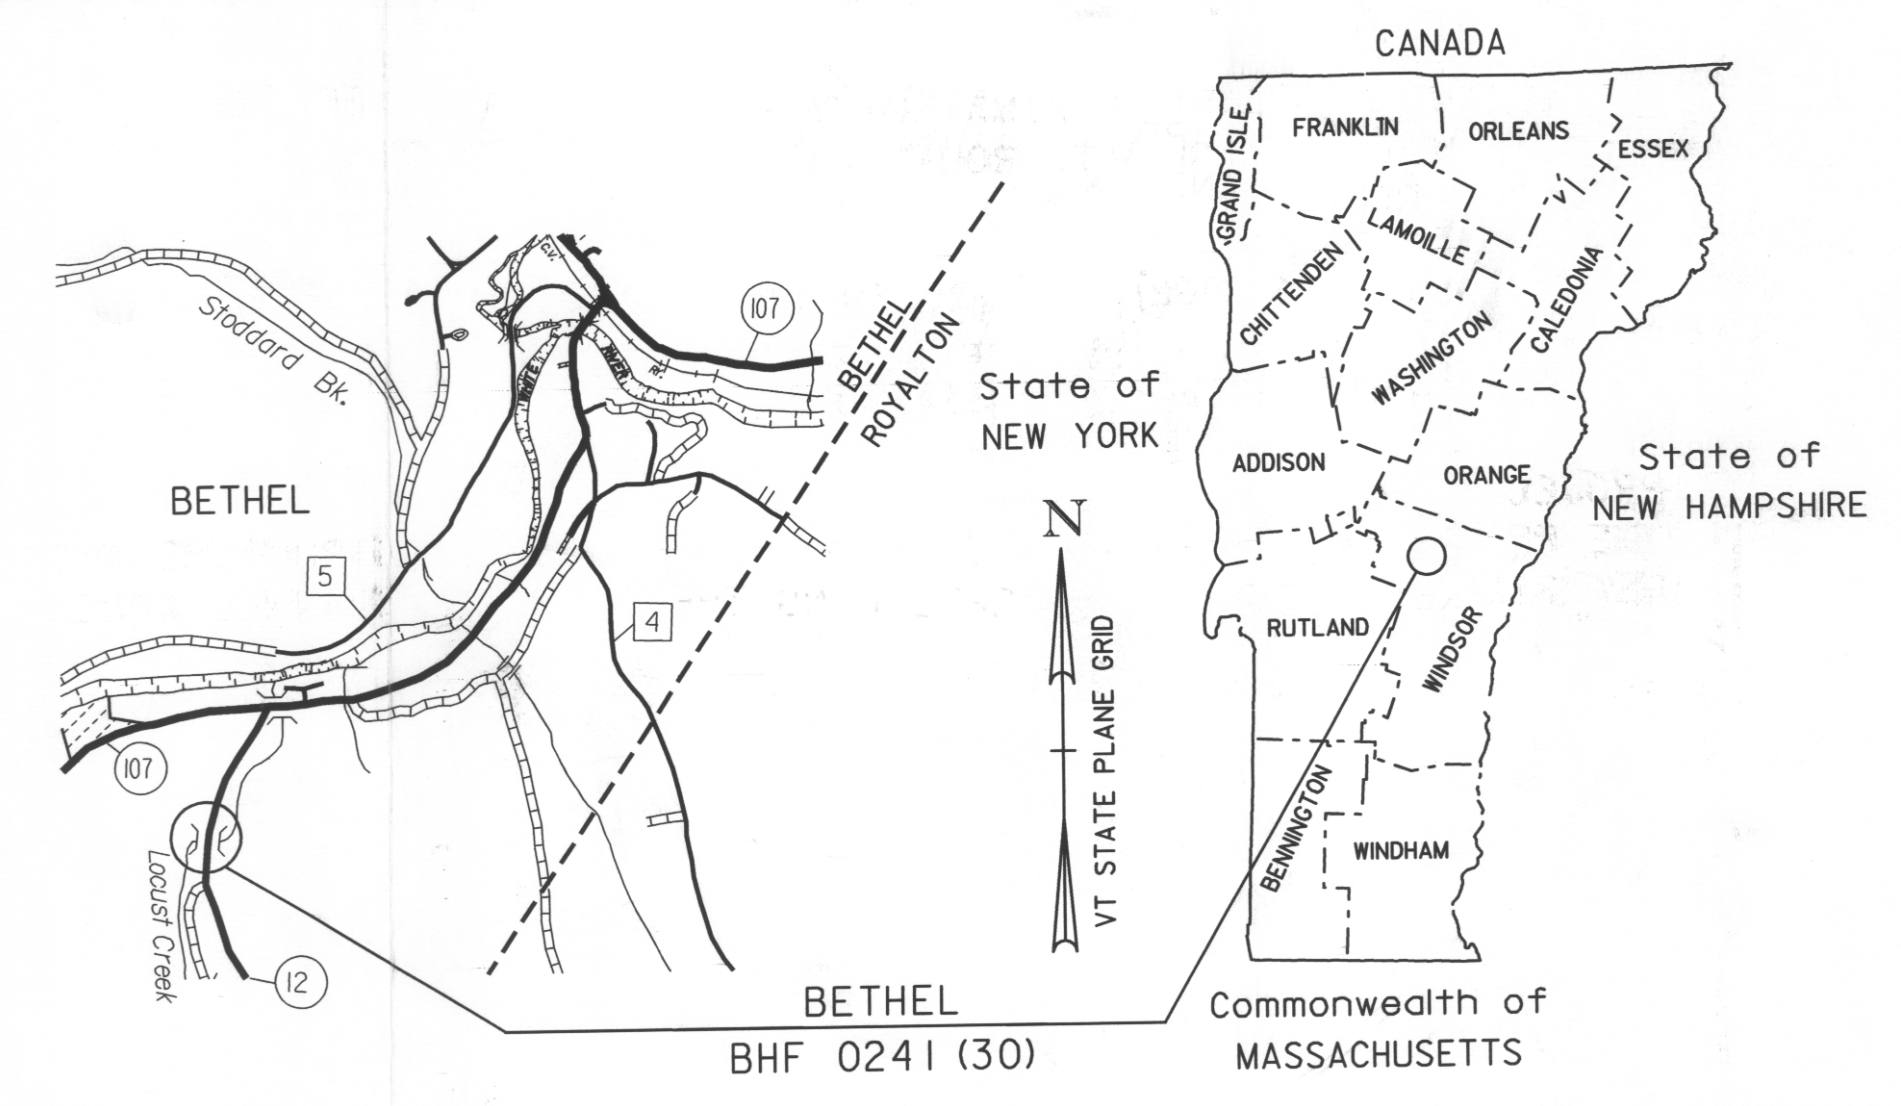

RECORD PLANS	
CONTRACTOR:	WINTERSSET, INC. - LYNDONVILLE, VT
RESIDENT ENGINEER:	TOM CHASE
CONSTRUCTION BEGAN:	SEPTEMBER 27, 2011
CONSTRUCTION COMPLETE:	JULY 12, 2012
RECORD PLANS BY:	TOM CHASE & JENNA HYDE
I HEREBY CERTIFY THAT ALL THE CONSTRUCTION REQUIRED BY THIS SET OF DRAWINGS HAS BEEN ACCOMPLISHED AS INDICATED HEREIN.	
BY	<i>Thomas A. Chase</i> RESIDENT ENGINEER
DATE	4/09/13
NOTE: Any further information concerning final quantities, amounts or other details relative to this project may be found at Central Files in the electronic archives.	

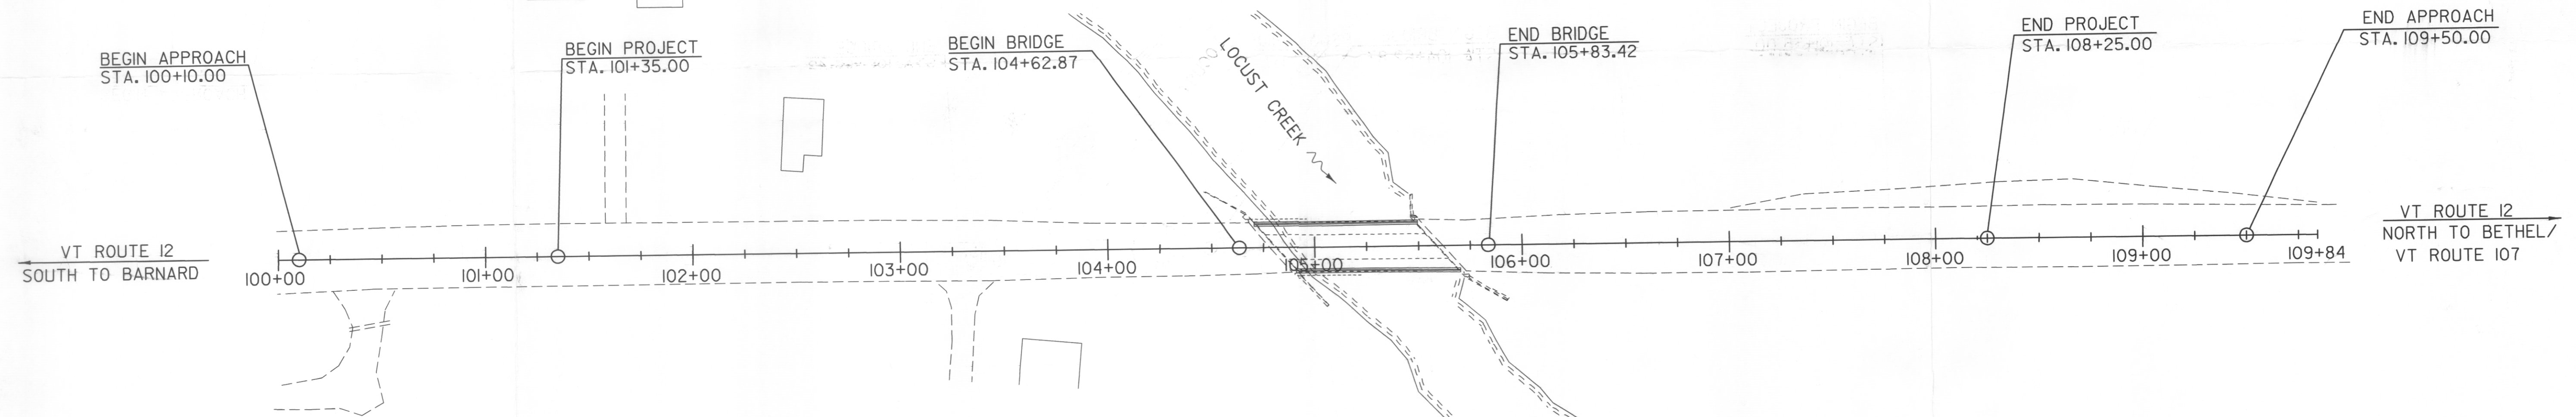

QUALITY ASSURANCE PROGRAM: LEVEL 2

CONVENTIONAL SYMBOLS	
COUNTY LINE	
TOWN LINE	
LIMITS OF ACCESS	
POINT OF ACCESS	
FENCE LINE	
STONE WALL	
TRAVELED WAY	
GUARD RAIL	
RAILROAD	
SURVEY LINE	
CULVERT	
POWER POLE	
TELEPHONE POLE	
TREES	
CONTROL OF ACCESS	
PROPERTY LINE	
R.O.W. TAKING LINE	
SLOPE RIGHTS	
TOP OF CUT	
TOE OF SLOPE	

SURVEYED BY : R. D. GILMAN
SURVEYED DATE : NOV 1995

DATUM
VERTICAL NAVD 88
HORIZONTAL NAD 83/92

SCALE 1" = 40'-0"
40 0 40

THESE PLANS ARE SUBJECT TO SUCH ENGINEERING CHANGES AS MAY BE REQUIRED BY THE FEDERAL HIGHWAY ADMINISTRATION OR THE DIRECTOR OF PROGRAM DEVELOPMENT.
CONSTRUCTION IS TO BE CARRIED ON IN ACCORDANCE WITH THESE PLANS AND THE STANDARD SPECIFICATIONS FOR CONSTRUCTION DATED 2006, AS APPROVED BY THE FEDERAL HIGHWAY ADMINISTRATION ON JUNE 15, 2006 FOR USE ON THIS PROJECT, INCLUDING ALL SUBSEQUENT REVISIONS AND SUCH REVISED SPECIFICATIONS AND SPECIAL PROVISIONS AS ARE INCORPORATED IN THESE PLANS.

DIRECTOR OF PROGRAM DEVELOPMENT	
APPROVED <i>[Signature]</i>	DATE 8/30/14
PROJECT MANAGER : M. EVANS-MONGEON	
PROJECT NAME : BETHEL	
PROJECT NUMBER : BHF 0241(30)	
SHEET 1 OF	SHEETS 64