

GPS CONTROL POINTS

HVCTRL # 1

Standard Disk Stamped
 Cleveland Az
 NORTH = 478386.150
 EAST = 1603594.342
 ELEV. = 553.601

TO REACH FROM THE JUNCTION OF VT 107 AND VT 12 SOUTH OF BETHEL, PROCEED EASTERLY ALONG VT 107 AND VT 12 FOR APPROX 0.3 M (1.0 FT) TO THE MARK ON THE LEFT. THE MARK IS DIRECTLY OPPOSITE CLEVELAND BROOK ROAD, 25.5 FT (7.8 M) NORTH FROM THE CENTERLINE OF VT 107 AND VT 12. OWNERSHIP STATE OF VERMONT STATION MARK IS A STATE OF VERMONT SURVEY MARK SET IN THE TOP OF A 12 INCH DIAMETER CONCRETE POST SET FLUSH WITH GROUND. IT IS 25.5 FT (7.8 M) NORTH OF CENTERLINE VT 107 AND VT 12, 4.5 FT (1.4 M) NORTH OF 3 CABLE GUARD RAIL, 45 FT (13.7 M) SOUTHEAST FROM COMBINATION POLE 4/49/57, 15 FT (4.6 M) SOUTH OF THE NORTH END OF A 4 FT (1.2 M) X 5 FT (1.5 M) CONCRETE BOX, 72 FT (21.9 M) NORTH OF THE SOUTH END OF A 4 FT (1.2 M) X 5 FT (1.5 M) CONCRETE BOX.

 
 



HVCTRL # 2

Standard Disk Stamped
 Cleveland
 NORTH = 477609.622
 EAST = 1601931.471
 ELEV. = 580.160

TO REACH FROM THE JUNCTION OF VT ROUTE 107 AND VT ROUTE 12, SOUTH OF BETHEL, PROCEED EASTERLY ALONG VT 107 AND VT 12 FOR APPROX 0.6 M (2.0 FT) TO THE MARK ON THE LEFT. STATION MARK IS A STATE OF VERMONT SURVEY MARK SET IN THE TOP OF A 12 INCH DIAMETER CONCRETE POST SET FLUSH WITH GROUND. IT IS 26 FT (7.9 M) NORTHWEST OF THE CENTERLINE OF THE ROAD, 88.5 FT (27.0 M) SOUTHWEST OF COMBINATION POLE 49/4/41, 143 FT (43.6 M) WEST OF 18 INCH CGMP WITH 7 FT (2.1 M) MARBLE HEADWALL.




• Description provided by Vermont Agency of Transportation Geodetic Survey Unit

TRAVERSE TIES

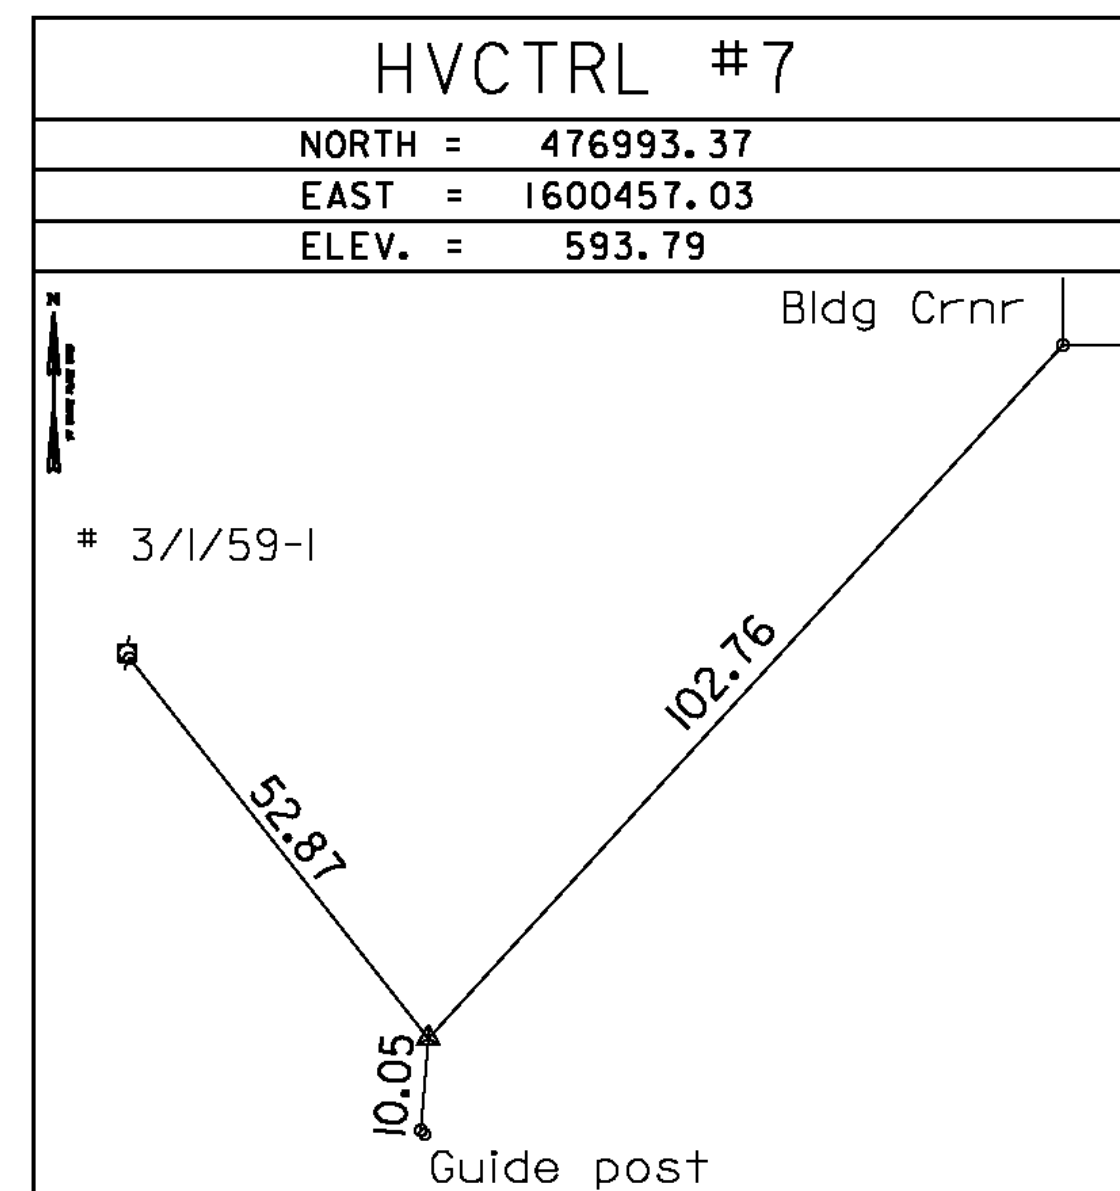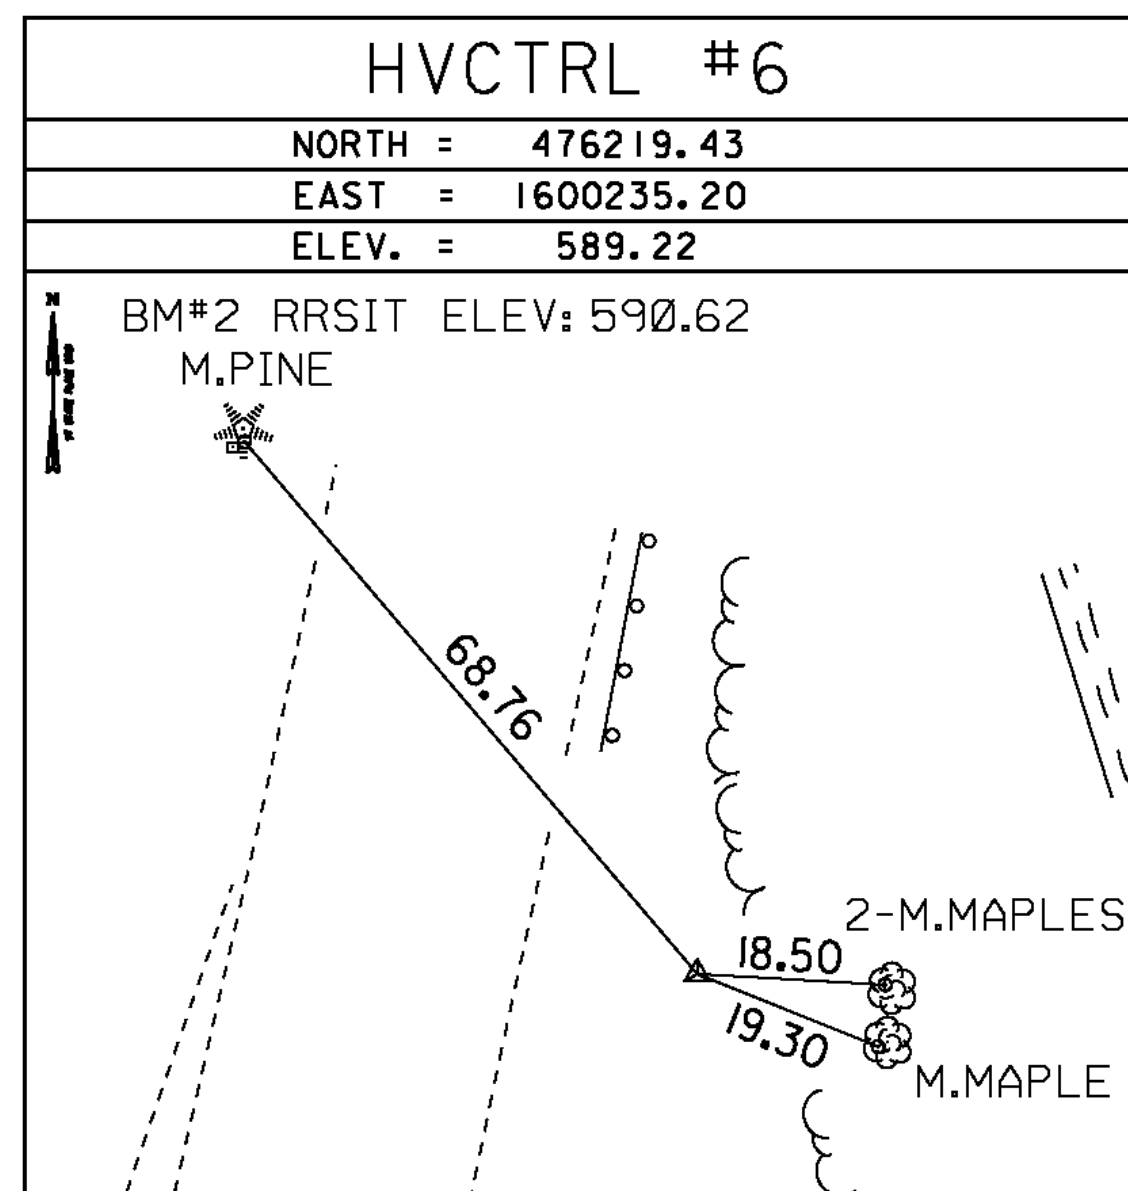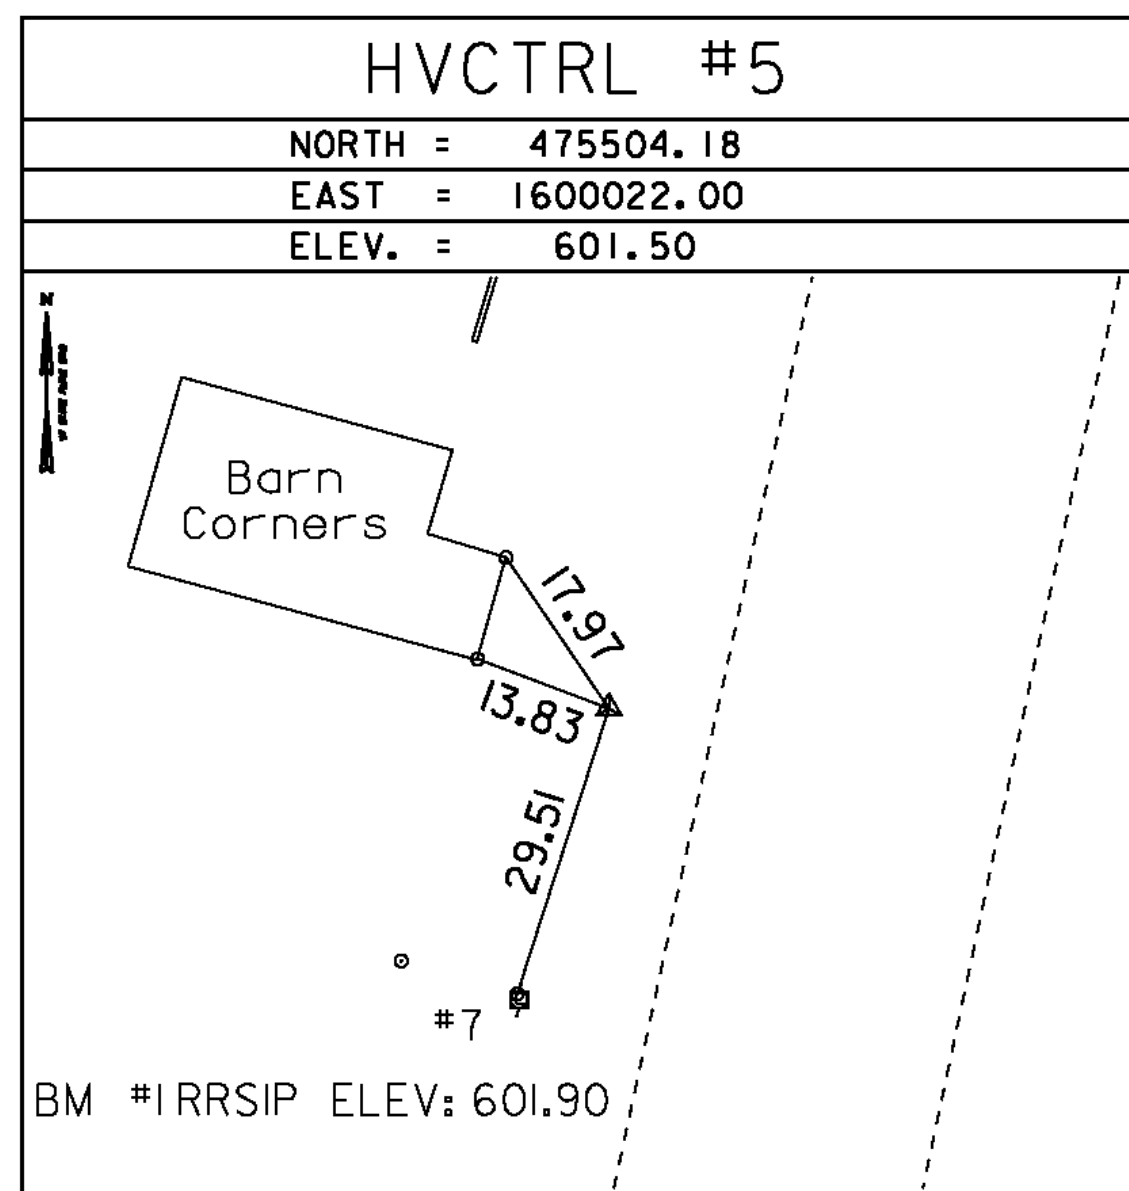

* Main Traverse Completed 11/09/95 by R. Gilman P.C. & T. Morse

ALIGNMENT TIES

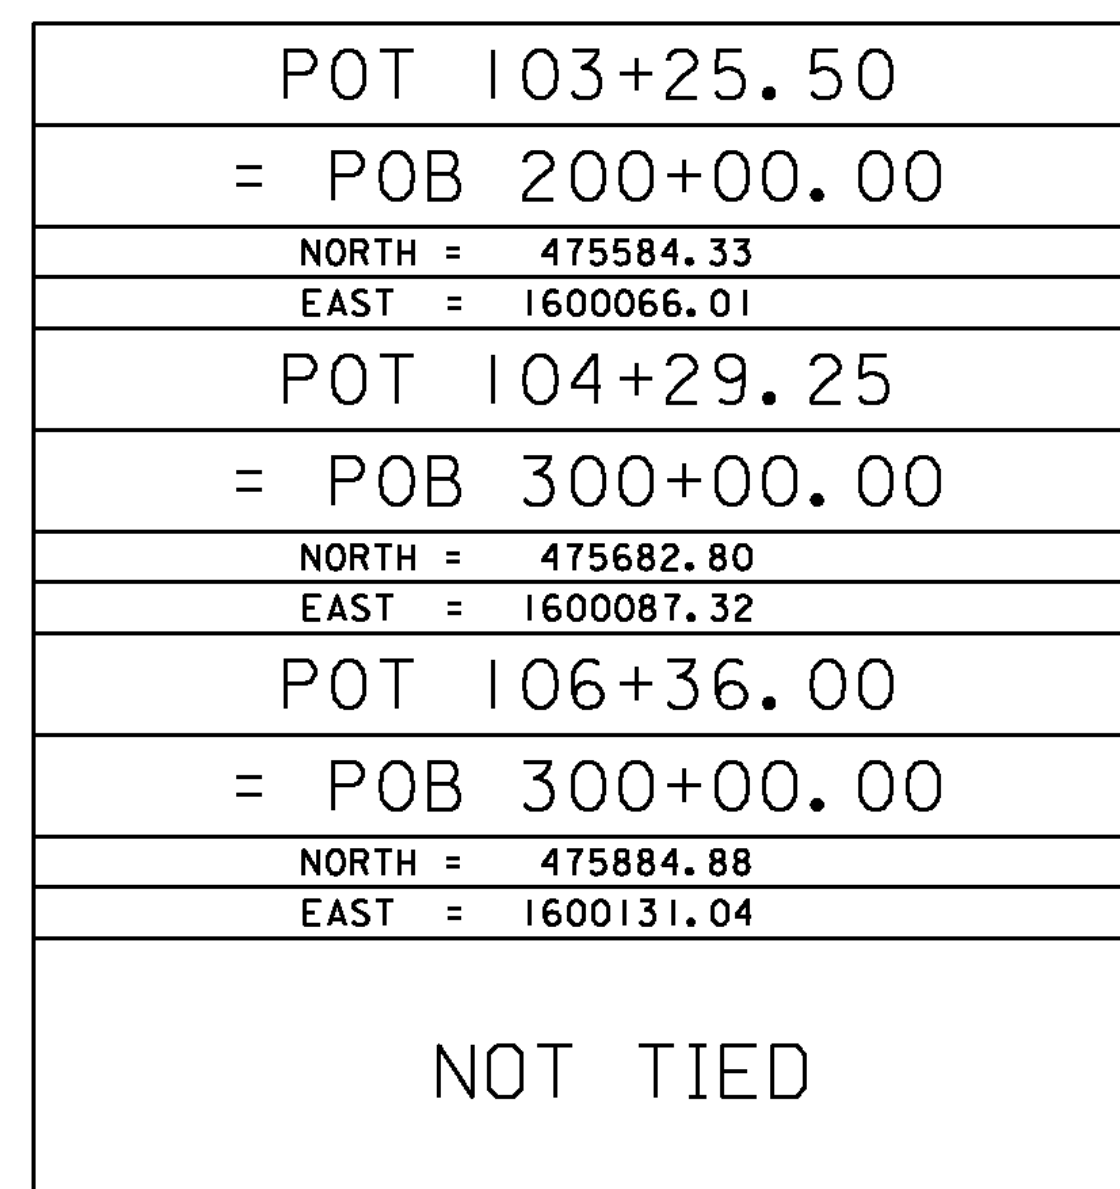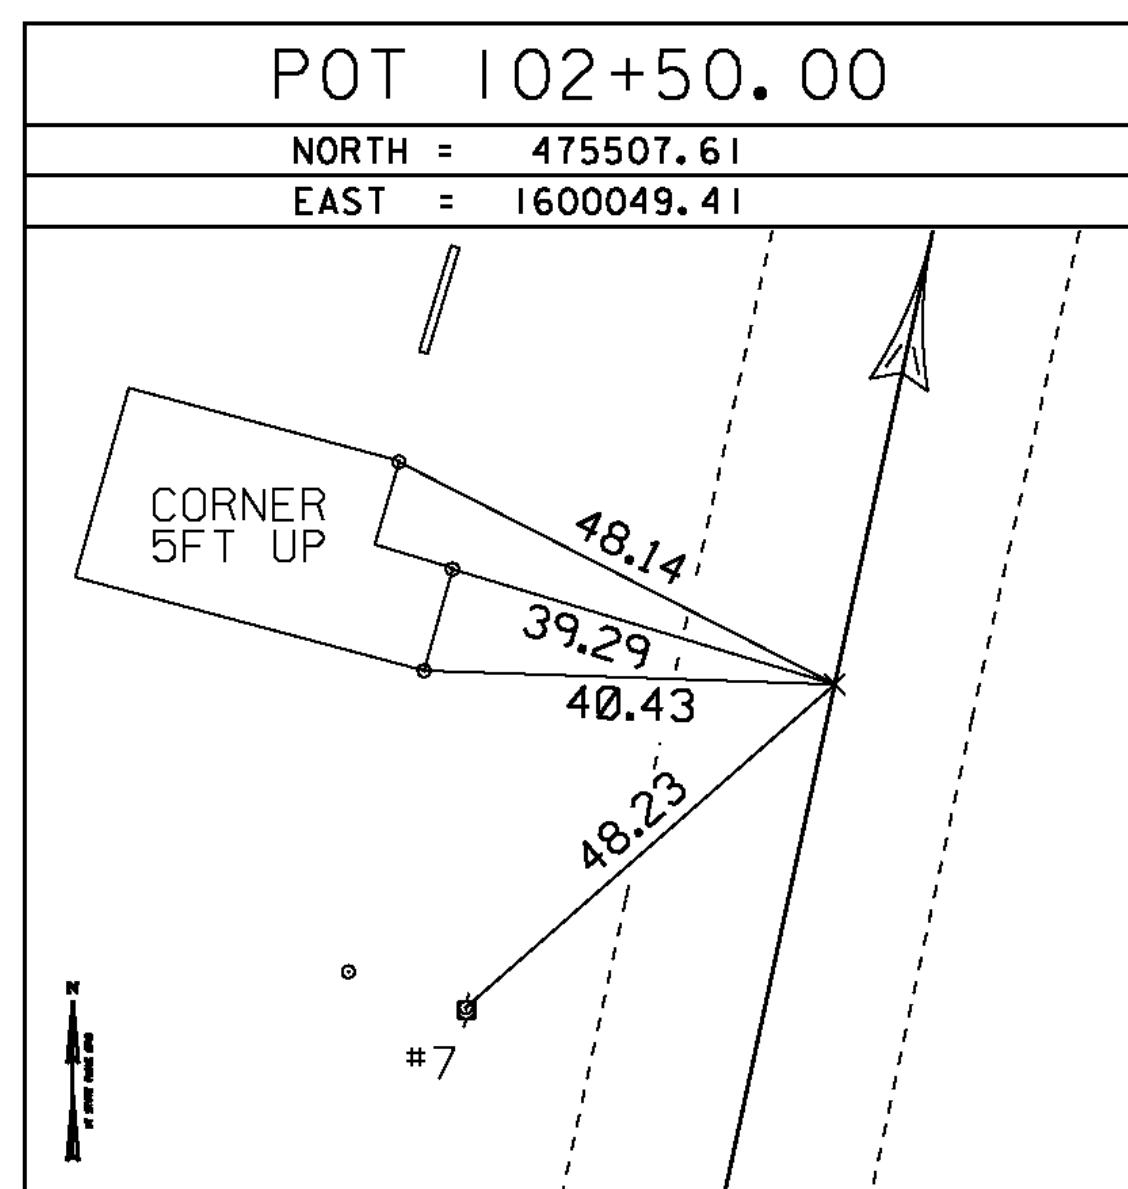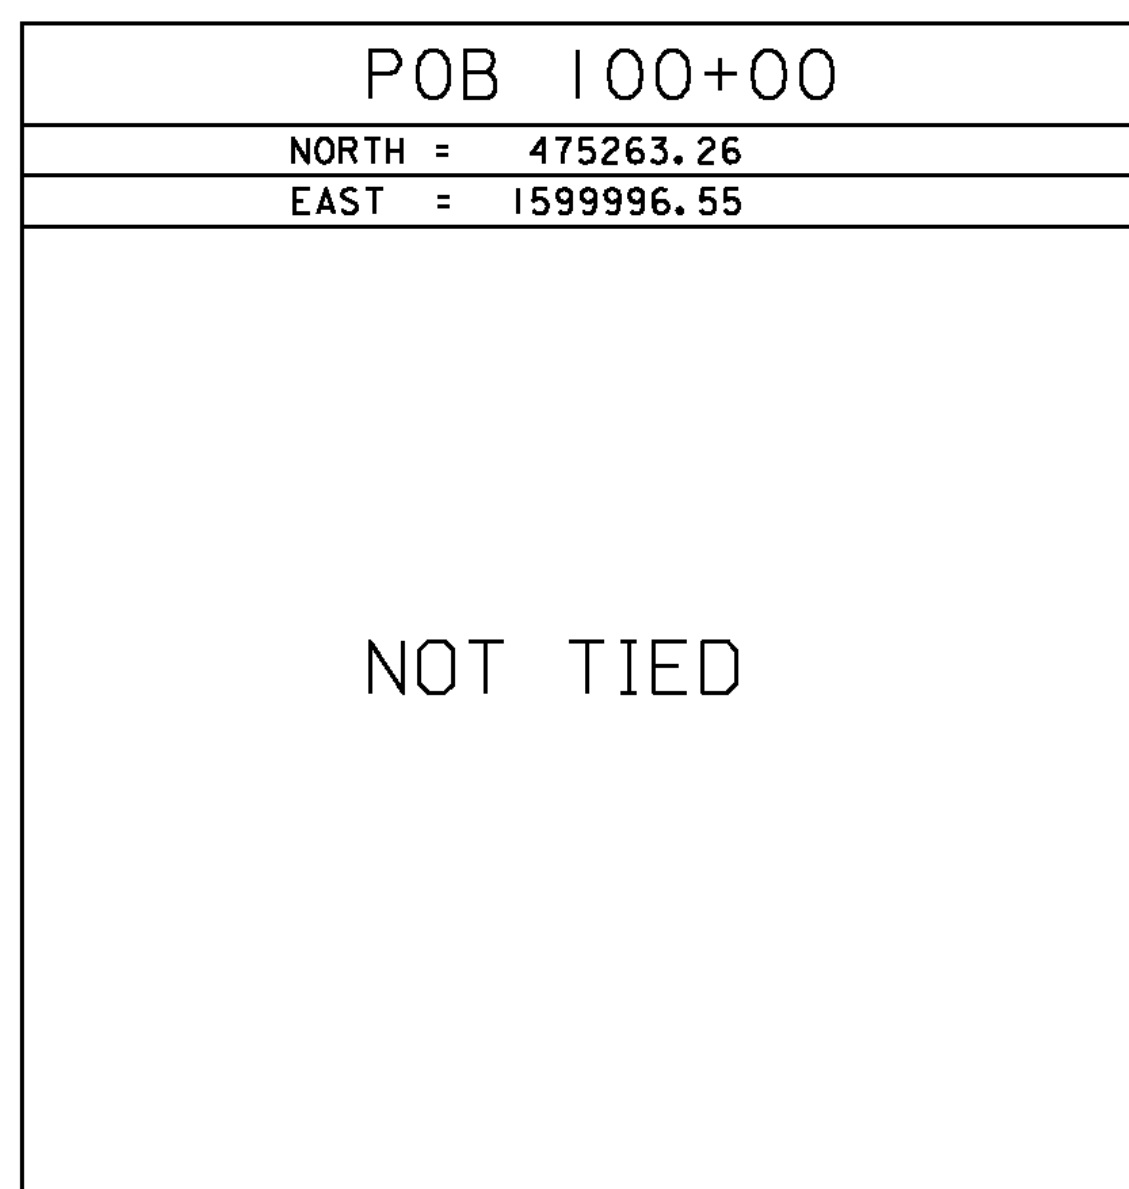

* Alignment Staked 9/24/08 by R. Gilman P.C. & P. Winters & T. Parker

DATUM	
VERTICAL	NAVD 88
HORIZONTAL	NAD 83 (92)
ADJUSTMENT	Compass

PROJECT NAME:	BETHEL
PROJECT NUMBER:	BHF 0214 (30)
FILE NAME:	sc002+1.dgn
PROJECT LEADER:	M. EVANS-MONGEON
DESIGNED BY:	R. BULLOCK
TIE SHEET	
PLOT DATE:	31-AUG-2011
DRAWN BY:	R. BULLOCK
CHECKED BY:	U. STANLEY
SHEET	10 OF 64