

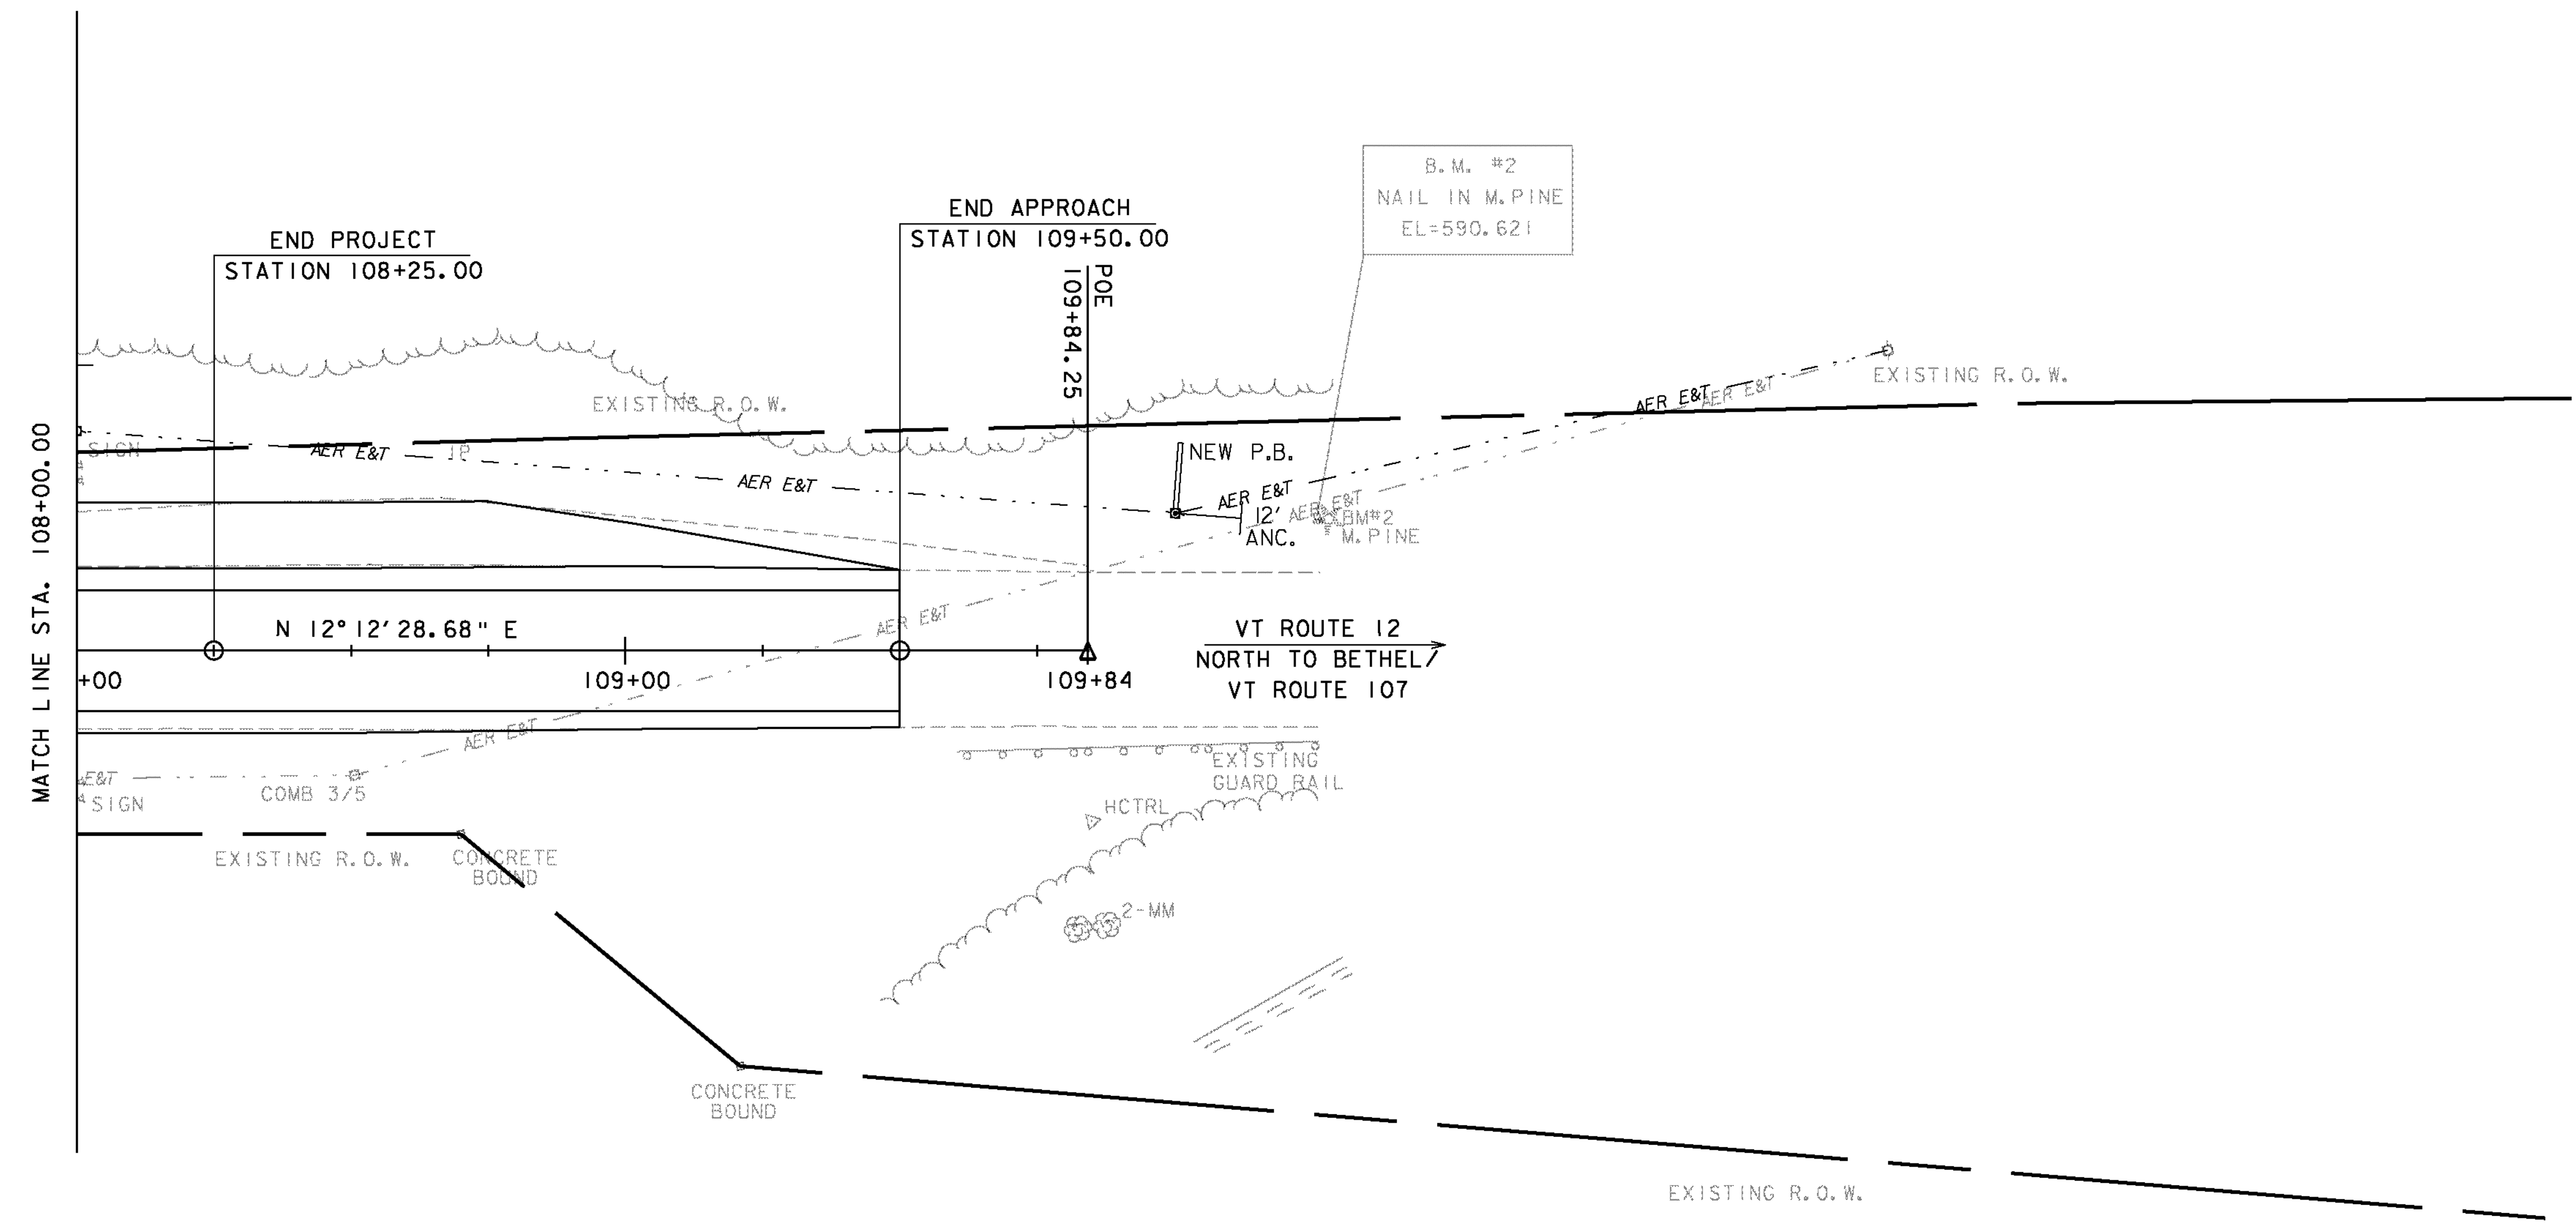


4" WHITE LINE
 FROM STA. TO STA.
 108+00.00 LT - 109+50.00 LT
 108+00.00 RT - 109+50.00 RT

4" YELLOW LINE (DOUBLE)
 FROM STA. TO STA.
 108+00.00 - 109+50.00

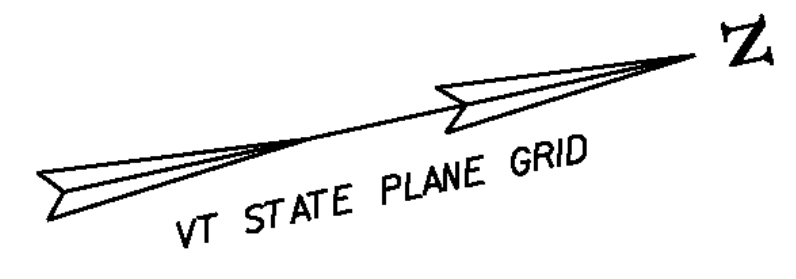

MATCH LINE STA. 108+00.00

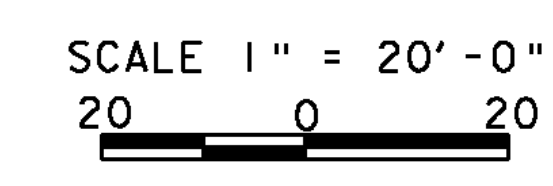

PROJECT NAME:	BETHEL	PLOT DATE:	31-AUG-2011
PROJECT NUMBER:	BHF 0241(30)	DRAWN BY:	G. ROKES
FILE NAME:	sc002bdr.dgn	CHECKED BY:	U. STANLEY
PROJECT LEADER:	M. EVANS-MONGEON	SHEET	13 OF 64
DESIGNED BY:	U. STANLEY	LAYOUT SHEET	3