


# VT 12 PROFILE

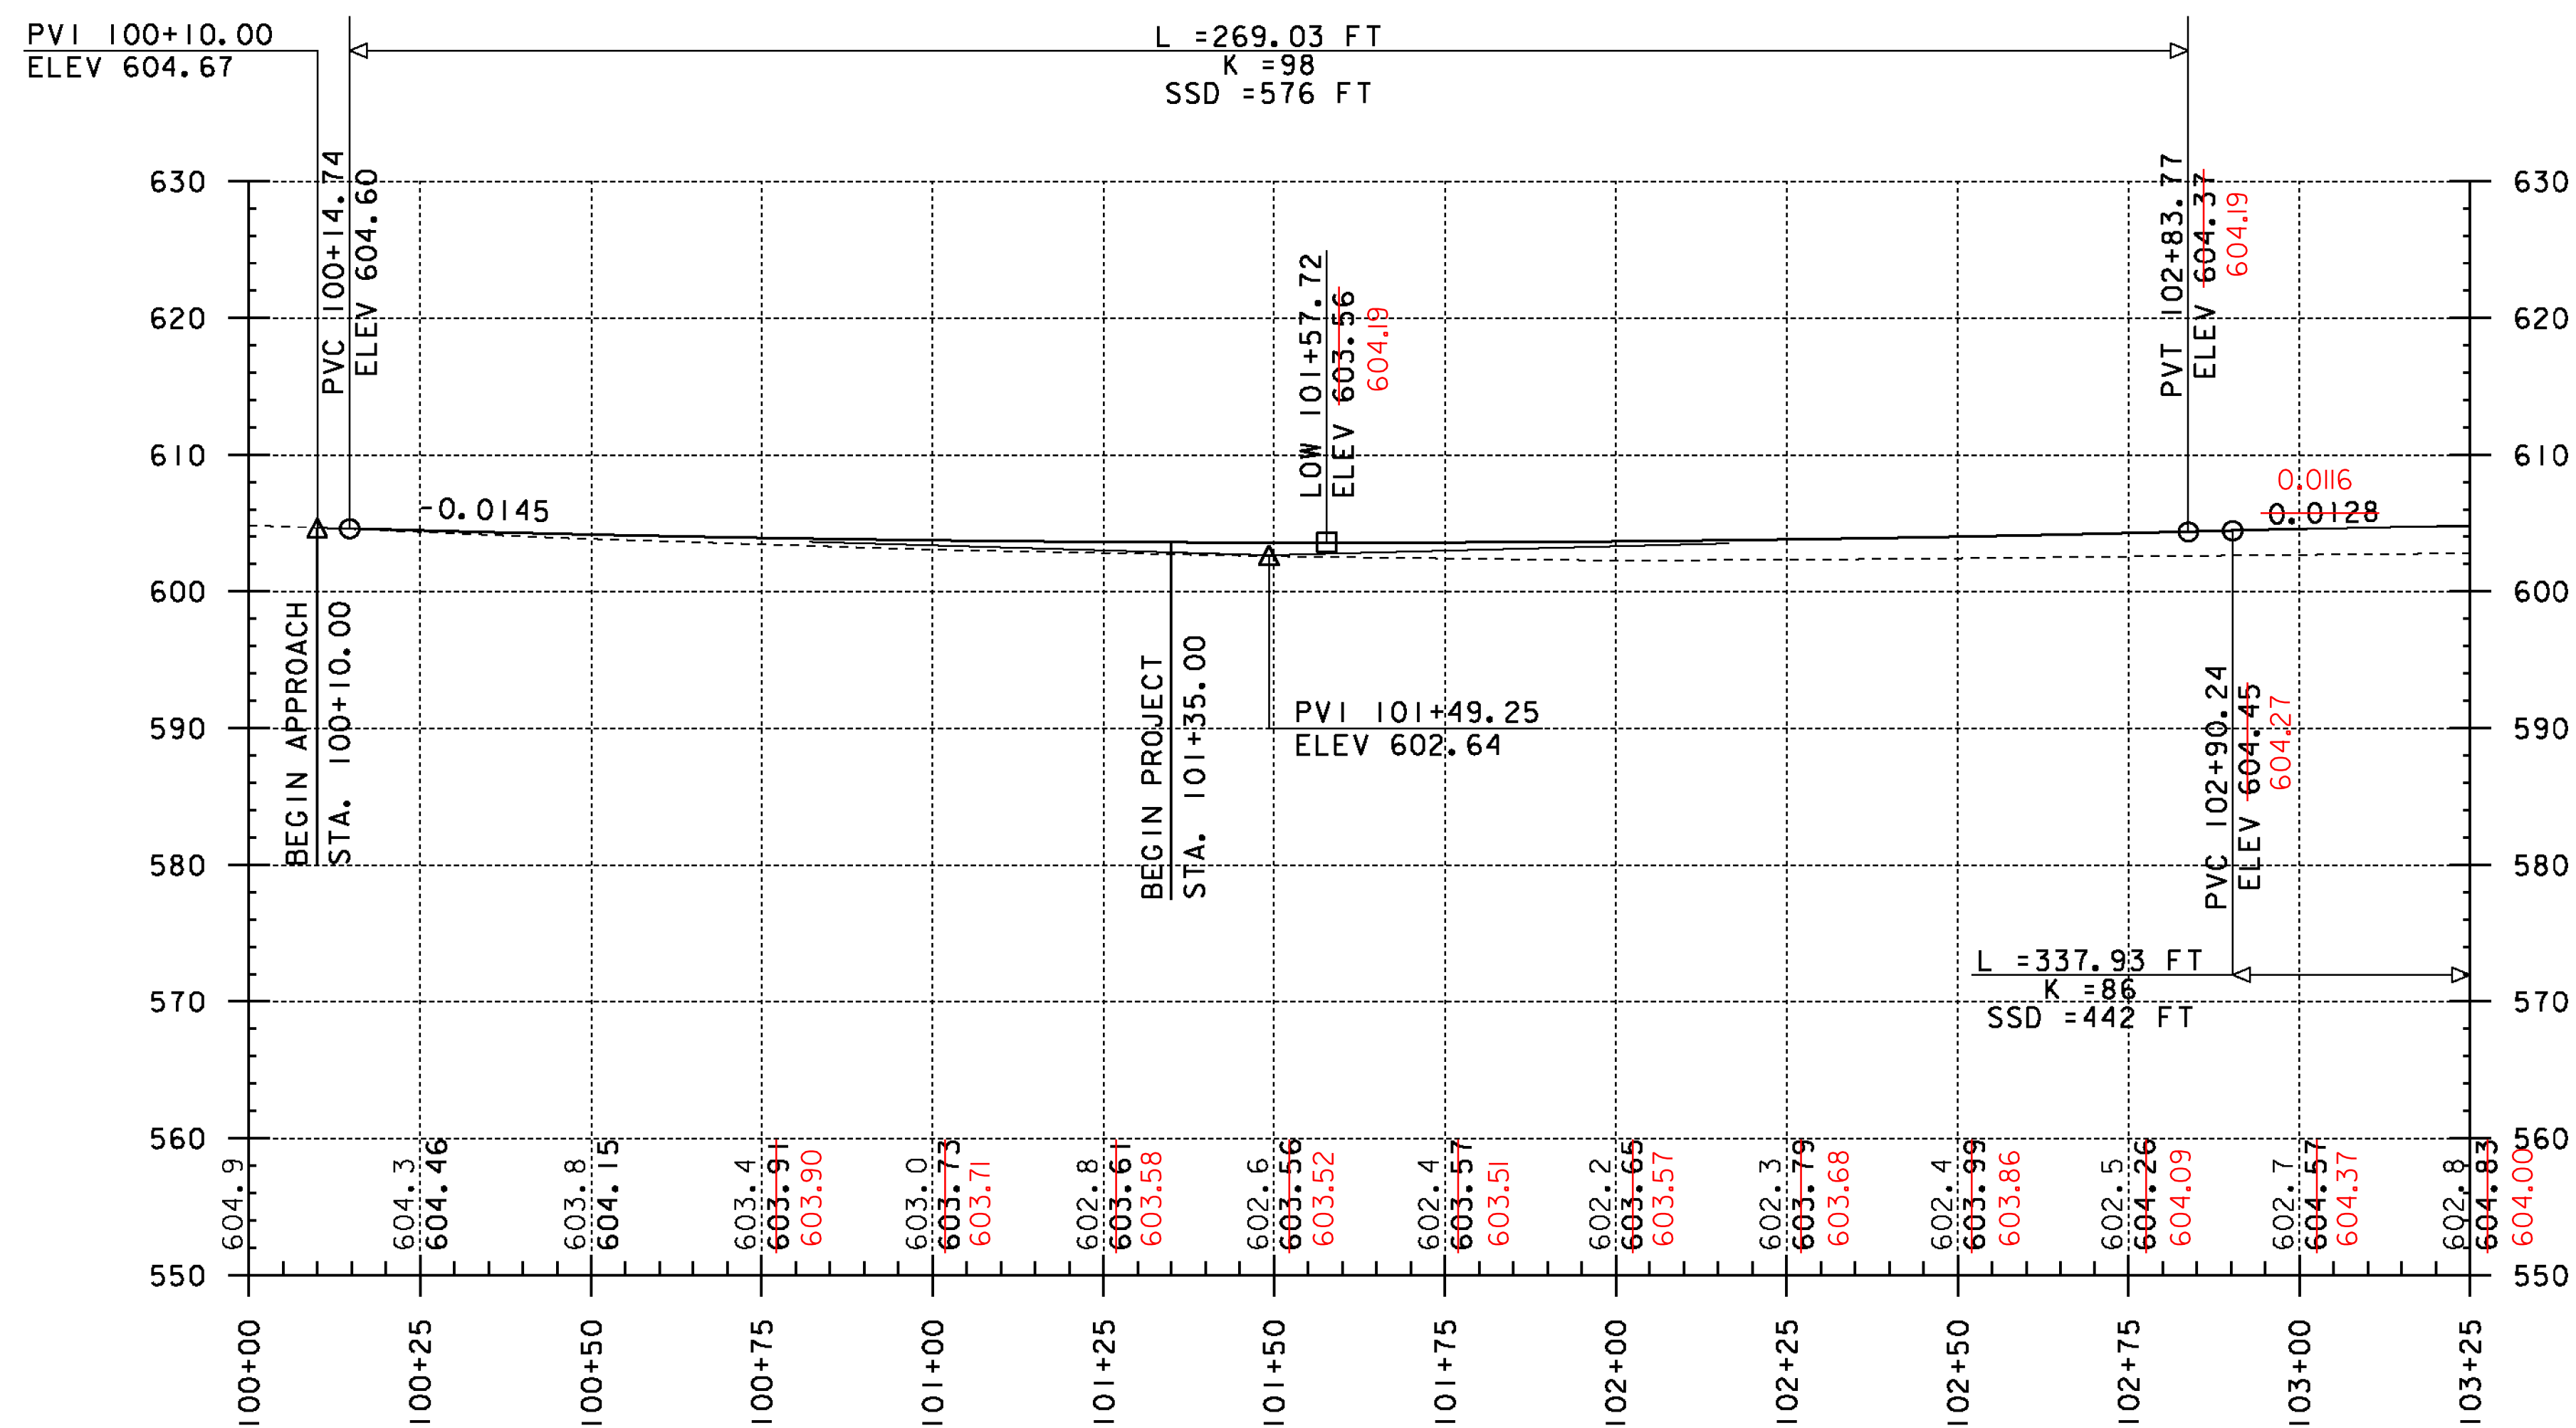

GRADES SHOWN TO THE NEAREST TENTH ARE EXISTING GROUND  
 GRADES SHOWN TO THE NEAREST HUNDREDTH ARE FINISH GRADE

PROJECT NAME: BETHEL  
 PROJECT NUMBER: BHF 0241 (30)

FILE NAME: sc002xs.dgn  
 PROJECT LEADER: M. EVANS-MONGEON  
 DESIGNED BY: U. STANLEY  
 MAINLINE PROFILE SHEET 1

PLOT DATE: 31-AUG-2011  
 DRAWN BY: U. STANLEY  
 CHECKED BY: G. ROKES  
 SHEET 14 OF 64