


VT 12 PROFILE

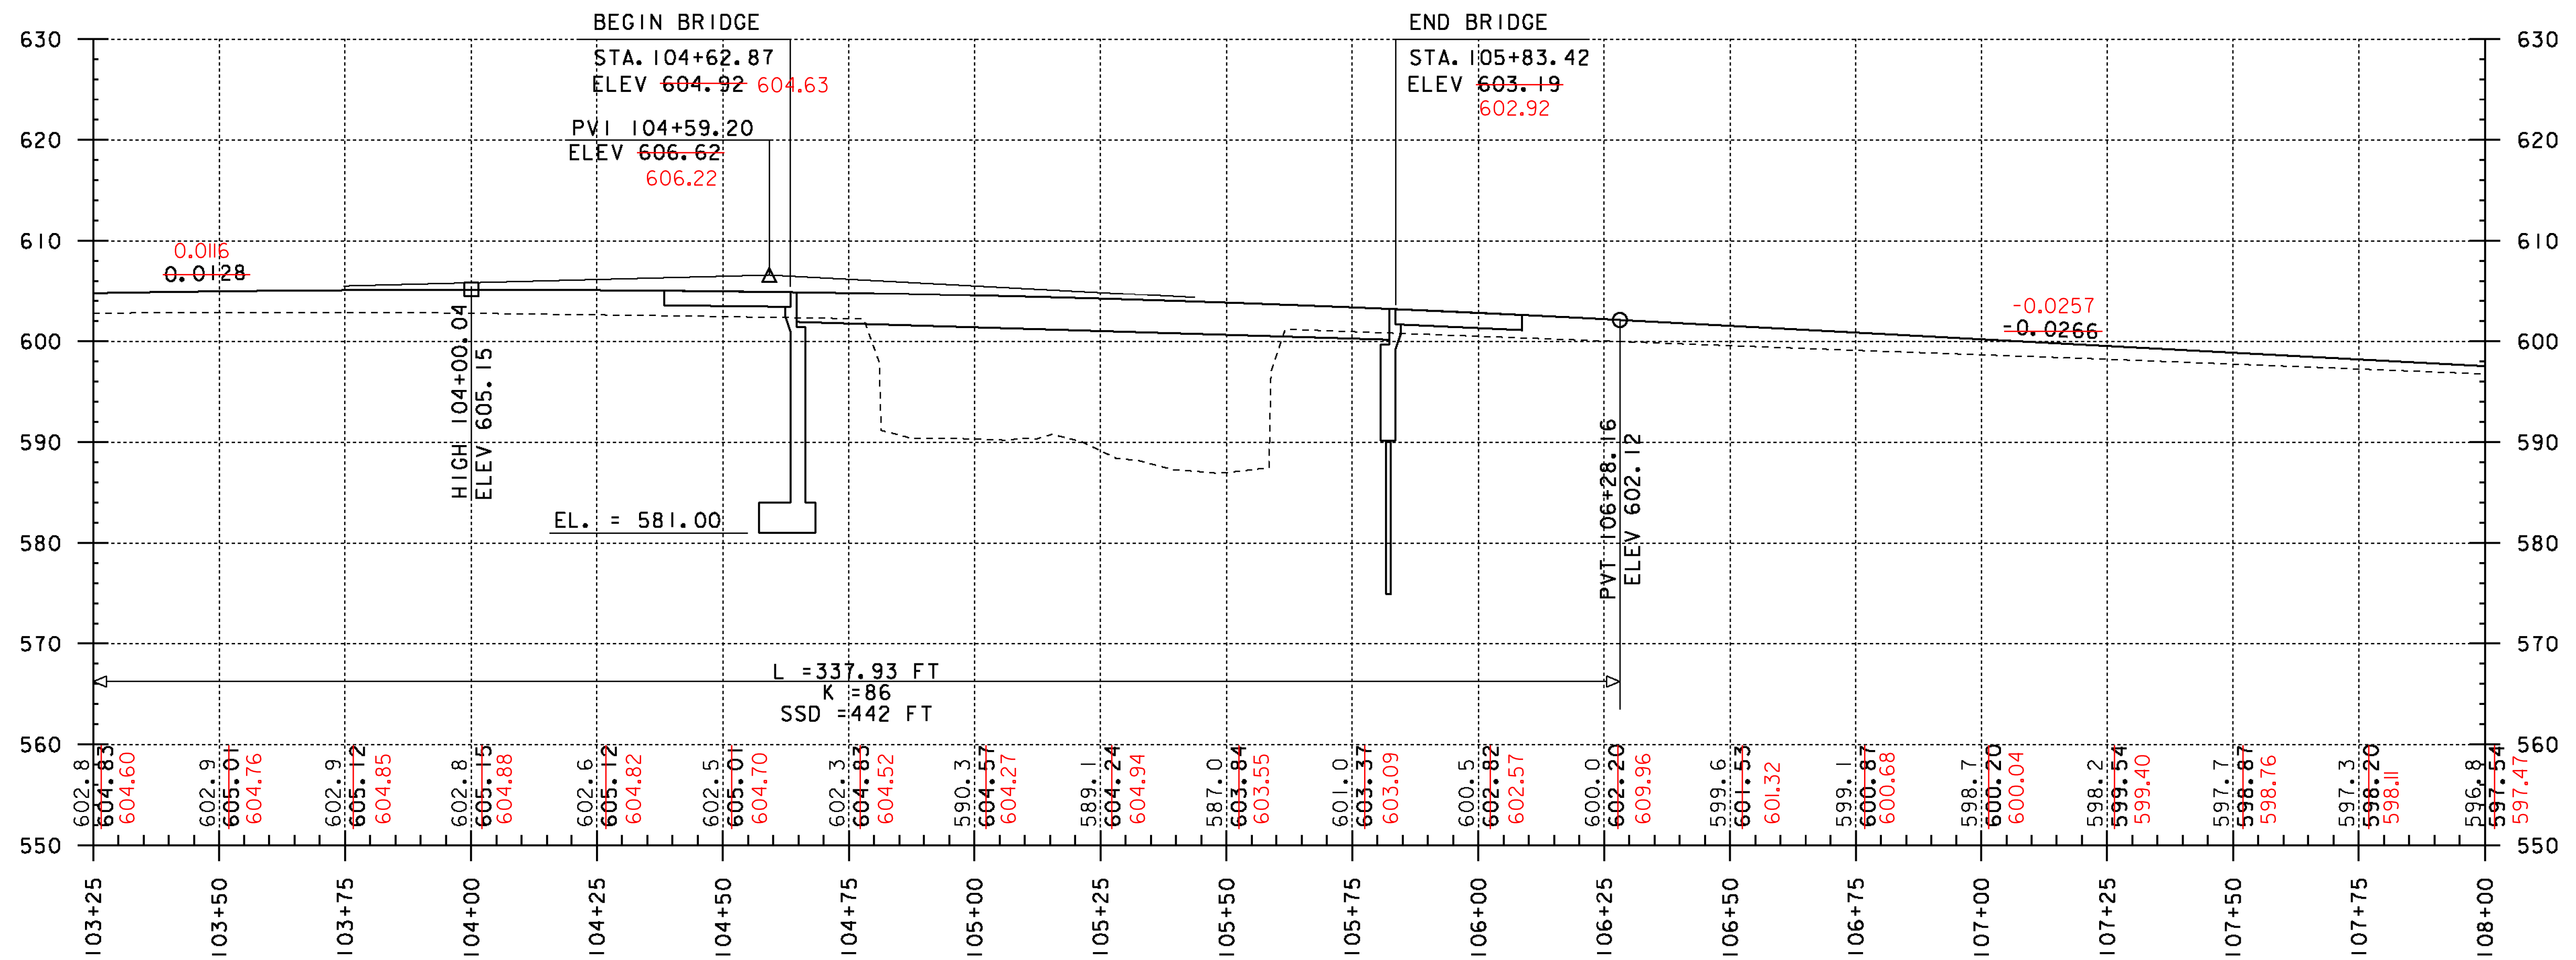

GRADES SHOWN TO THE NEAREST TENTH ARE EXISTING GROUND
 GRADES SHOWN TO THE NEAREST HUNDREDTH ARE FINISH GRADE

PROJECT NAME: BETHEL
 PROJECT NUMBER: BHF 0241(30)

FILE NAME: sc002xs.dgn	PLOT DATE: 31-AUG-2011
PROJECT LEADER: M. EVANS-MONGEON	DRAWN BY: U. STANLEY
DESIGNED BY: U. STANLEY	CHECKED BY: G. ROKES
MAINLINE PROFILE SHEET 2	SHEET 15 OF 64