


VT 12 PROFILE

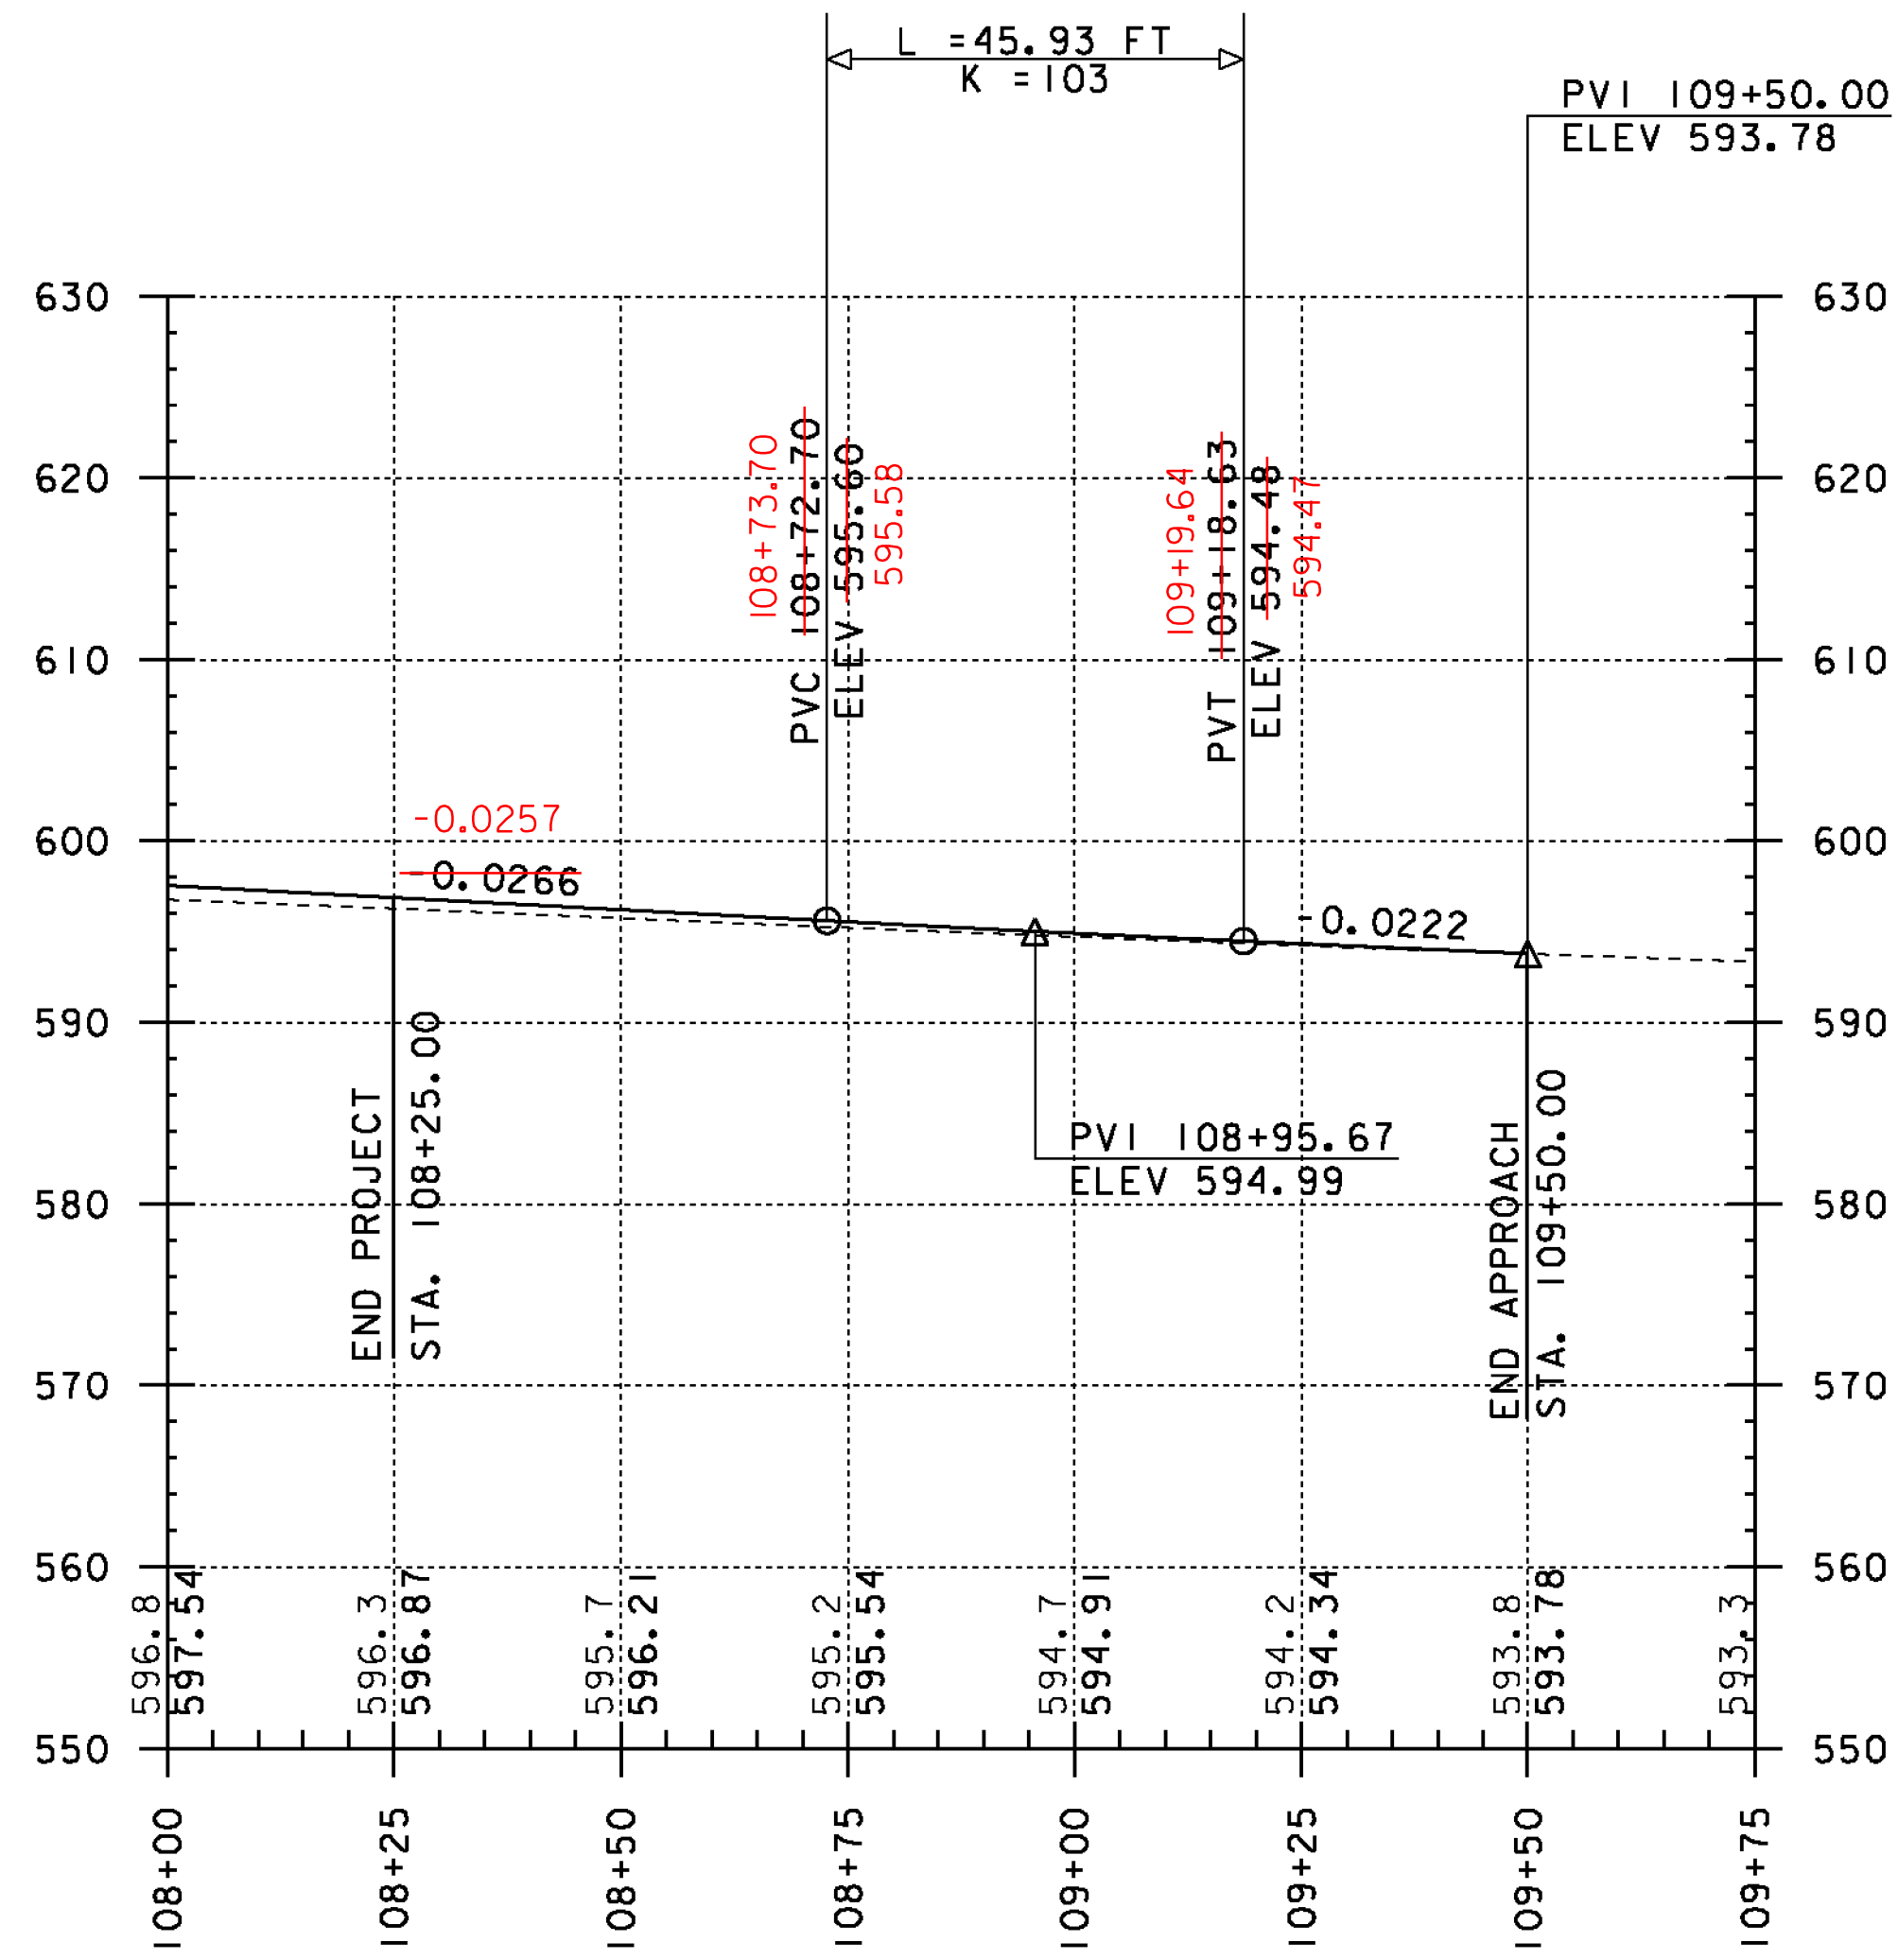

GRADES SHOWN TO THE NEAREST TENTH ARE EXISTING GROUND
 GRADES SHOWN TO THE NEAREST HUNDREDTH ARE FINISH GRADE

PROJECT NAME: BETHEL	PLOT DATE: 31-AUG-2011
PROJECT NUMBER: BHF 0241 (30)	DRAWN BY: U. STANLEY
FILE NAME: sc002xs.dgn	CHECKED BY: G. ROKES
PROJECT LEADER: M. EVANS-MONGEON	SHEET 16 OF 64
DESIGNED BY: U. STANLEY	
MAINLINE PROFILE SHEET 3	