


DRIVE AT STA. 103+28.50 PROFILE

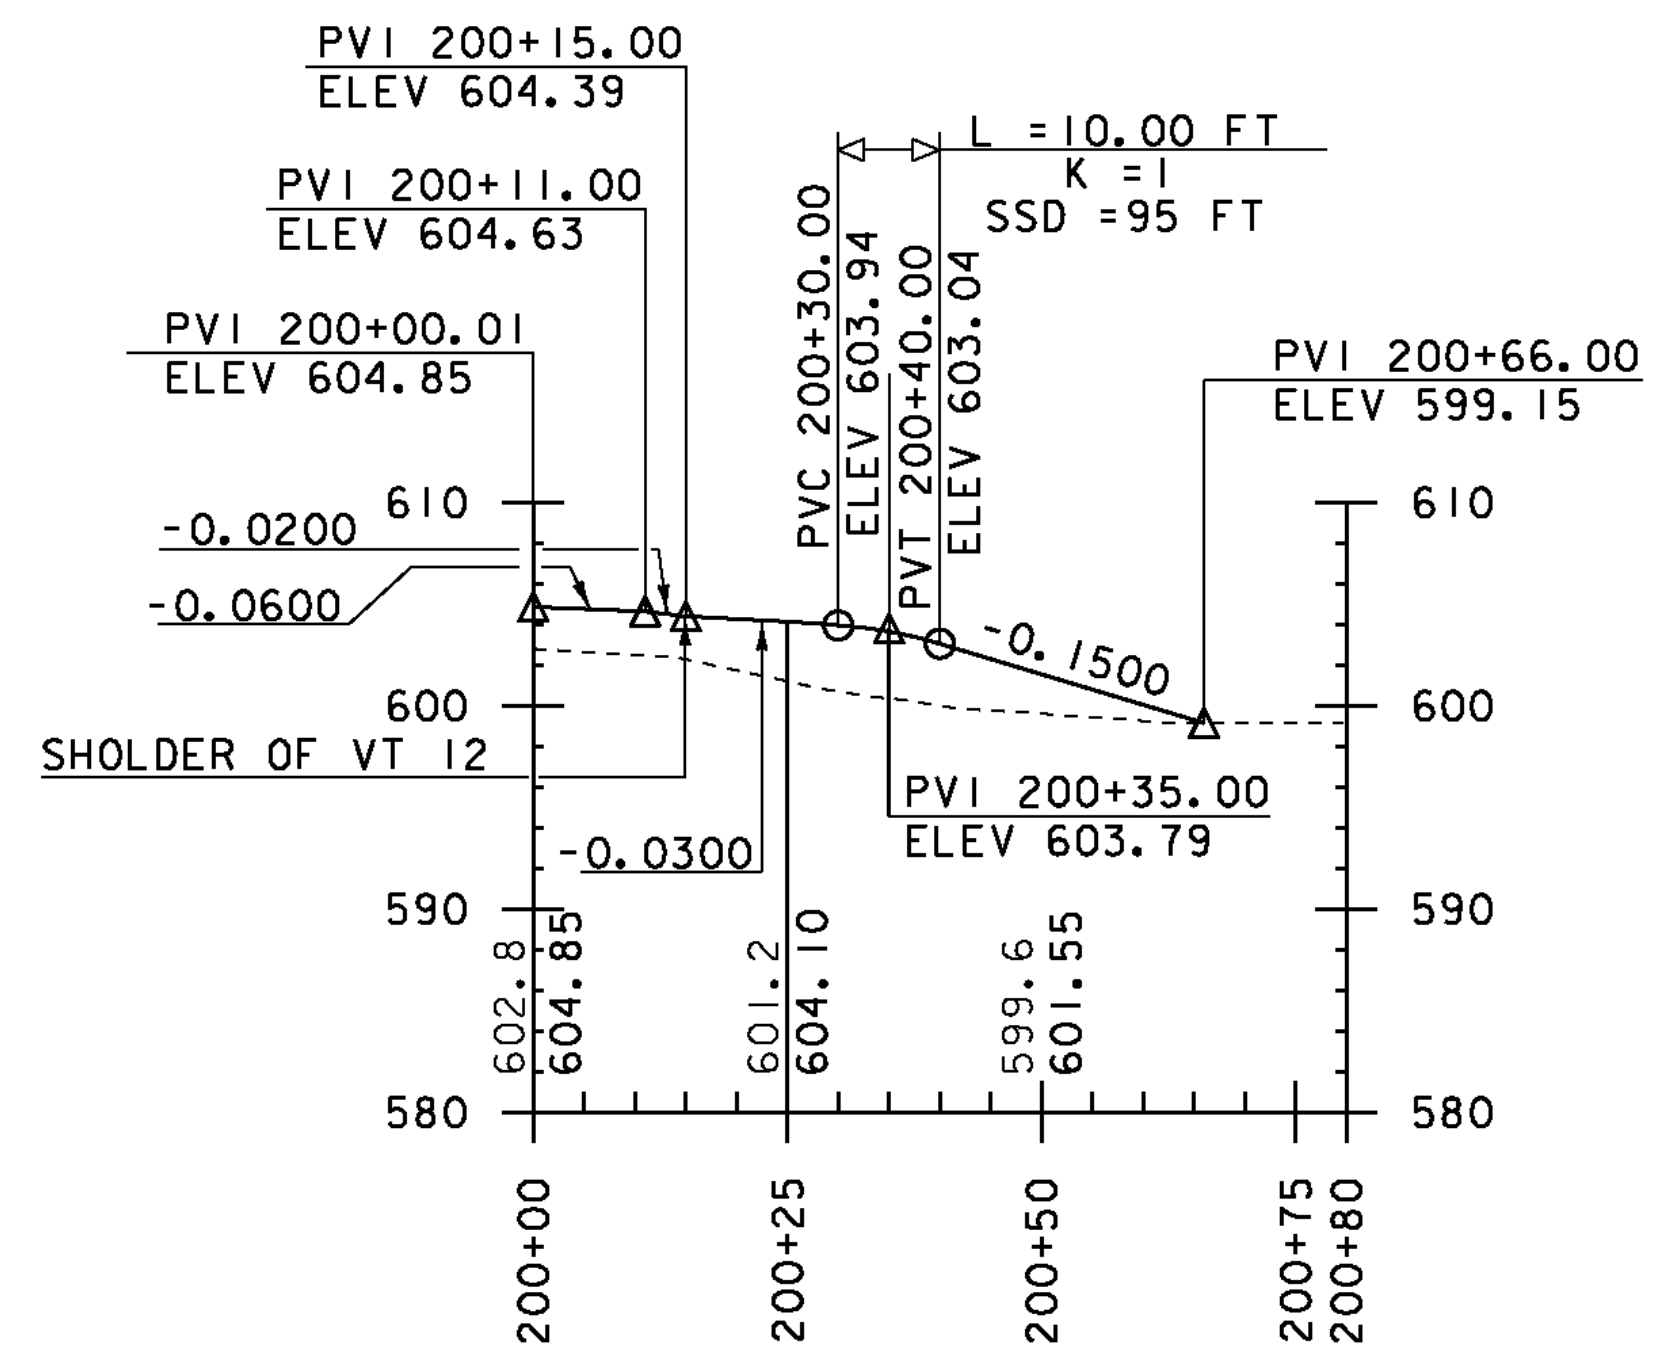

GRADES SHOWN TO THE NEAREST TENTH ARE EXISTING GROUND
 GRADES SHOWN TO THE NEAREST HUNDREDTH ARE FINISH GRADE

PROJECT NAME: BETHEL
 PROJECT NUMBER: BHF 0241(30)

FILE NAME: sc002xs.dgn
 PROJECT LEADER: M. EVANS-MONGEON
 DESIGNED BY: U. STANLEY
 PRIVATE DRIVE PROFILE SHEET

PLOT DATE: 31-AUG-2011
 DRAWN BY: U. STANLEY
 CHECKED BY: G. ROKES
 SHEET 17 OF 64