


LEGEND	
AG	AGRICULTURAL LAND
ARCH	ARCHEOLOGICAL SITE
---	SILT FENCE
PDF	PROJECT DEMARCATION FENCE
[Cross-hatched symbol]	EROSION CONTROL MATTING

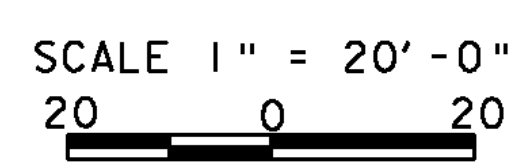

PROJECT NAME: BETHEL	PLOT DATE: 31-AUG-2011
PROJECT NUMBER: BHF 0241(30)	DRAWN BY: G. ROKES
FILE NAME: sc002erobdr.dgn	CHECKED BY: U. STANLEY
PROJECT LEADER: M. EVANS-MONGEON	SHEET 28 OF 64
DESIGNED BY: U. STANLEY	
EPSC CONSTRUCTION SHEET 3	