
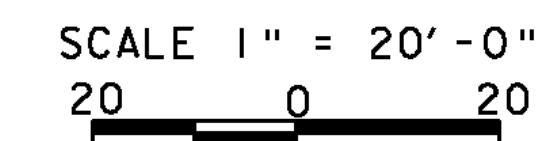


LEGEND	
— HIST —	HISTORIC / HISTORIC DISTRICT
— ARCH —	ARCHEOLOGICAL SITE
— AG —	AGRICULTURAL LAND
	DISTURBED AREAS REQUIRING RE-VEGETATION

REFER TO CROSS SECTIONS FOR FINAL GRADING INFORMATION



PROJECT NAME: BETHEL
PROJECT NUMBER: BHF 0241(30)

FILE NAME: sc002erobdr.dgn
PROJECT LEADER: M. EVANS-MONGEON
DESIGNED BY: U. STANLEY
EPSC FINAL CONDITIONS SHEET 1

PLOT DATE: 31-AUG-2011
DRAWN BY: G. ROKES
CHECKED BY: U. STANLEY
SHEET 29 OF 64