


LEGEND	
-----	RIPARIAN BUFFER
- HIST -	HISTORIC/HISTORIC DISTRICT
AG	AGRICULTURAL LAND
— ARCH —	ARCHEOLOGICAL SITE
	STONE FILL
	EROSION CONTROL MATTING
	DISTURBED AREAS REQUIRING RE-VEGETATION
— FLOOD PLAIN —	FLOOD PLAIN BOUNDARY

REFER TO CROSS SECTIONS FOR FINAL GRADING INFORMATION

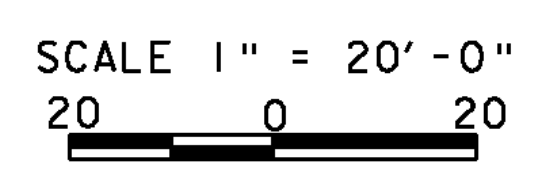

PROJECT NAME: BETHEL	PLOT DATE: 31-AUG-2011
PROJECT NUMBER: BHF 0241(30)	DRAWN BY: G. ROKES
FILE NAME: sc002erobdr.dgn	CHECKED BY: U. STANLEY
PROJECT LEADER: M. EVANS-MONGEON	SHEET 30 OF 64
DESIGNED BY: U. STANLEY	
EPSC FINAL CONDITIONS SHEET 2	