


LEGEND	
AG	AGRICULTURAL LAND
ARCH	ARCHEOLOGICAL SITE
	DISTURBED AREAS REQUIRING RE-VEGETATION
	EROSION CONTROL MATTING

REFER TO CROSS SECTIONS FOR FINAL GRADING INFORMATION

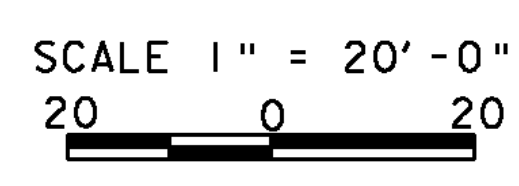

PROJECT NAME:	BETHEL	PLOT DATE:	31-AUG-2011
PROJECT NUMBER:	BHF 0241(30)	DRAWN BY:	G. ROKES
FILE NAME:	sc002erobdr.dgn	CHECKED BY:	U. STANLEY
PROJECT LEADER:	M. EVANS-MONGEON	SHEET	31 OF 64
DESIGNED BY:	U. STANLEY		
EPSC FINAL CONDITIONS SHEET 3			