


DECK TYPICAL


SCALE 3/4" = 1'-0"

* 1.) MODIFIED S-360a "BRIDGE RAILING, GALVANIZED NETC 2 RAIL" AS NOTED.

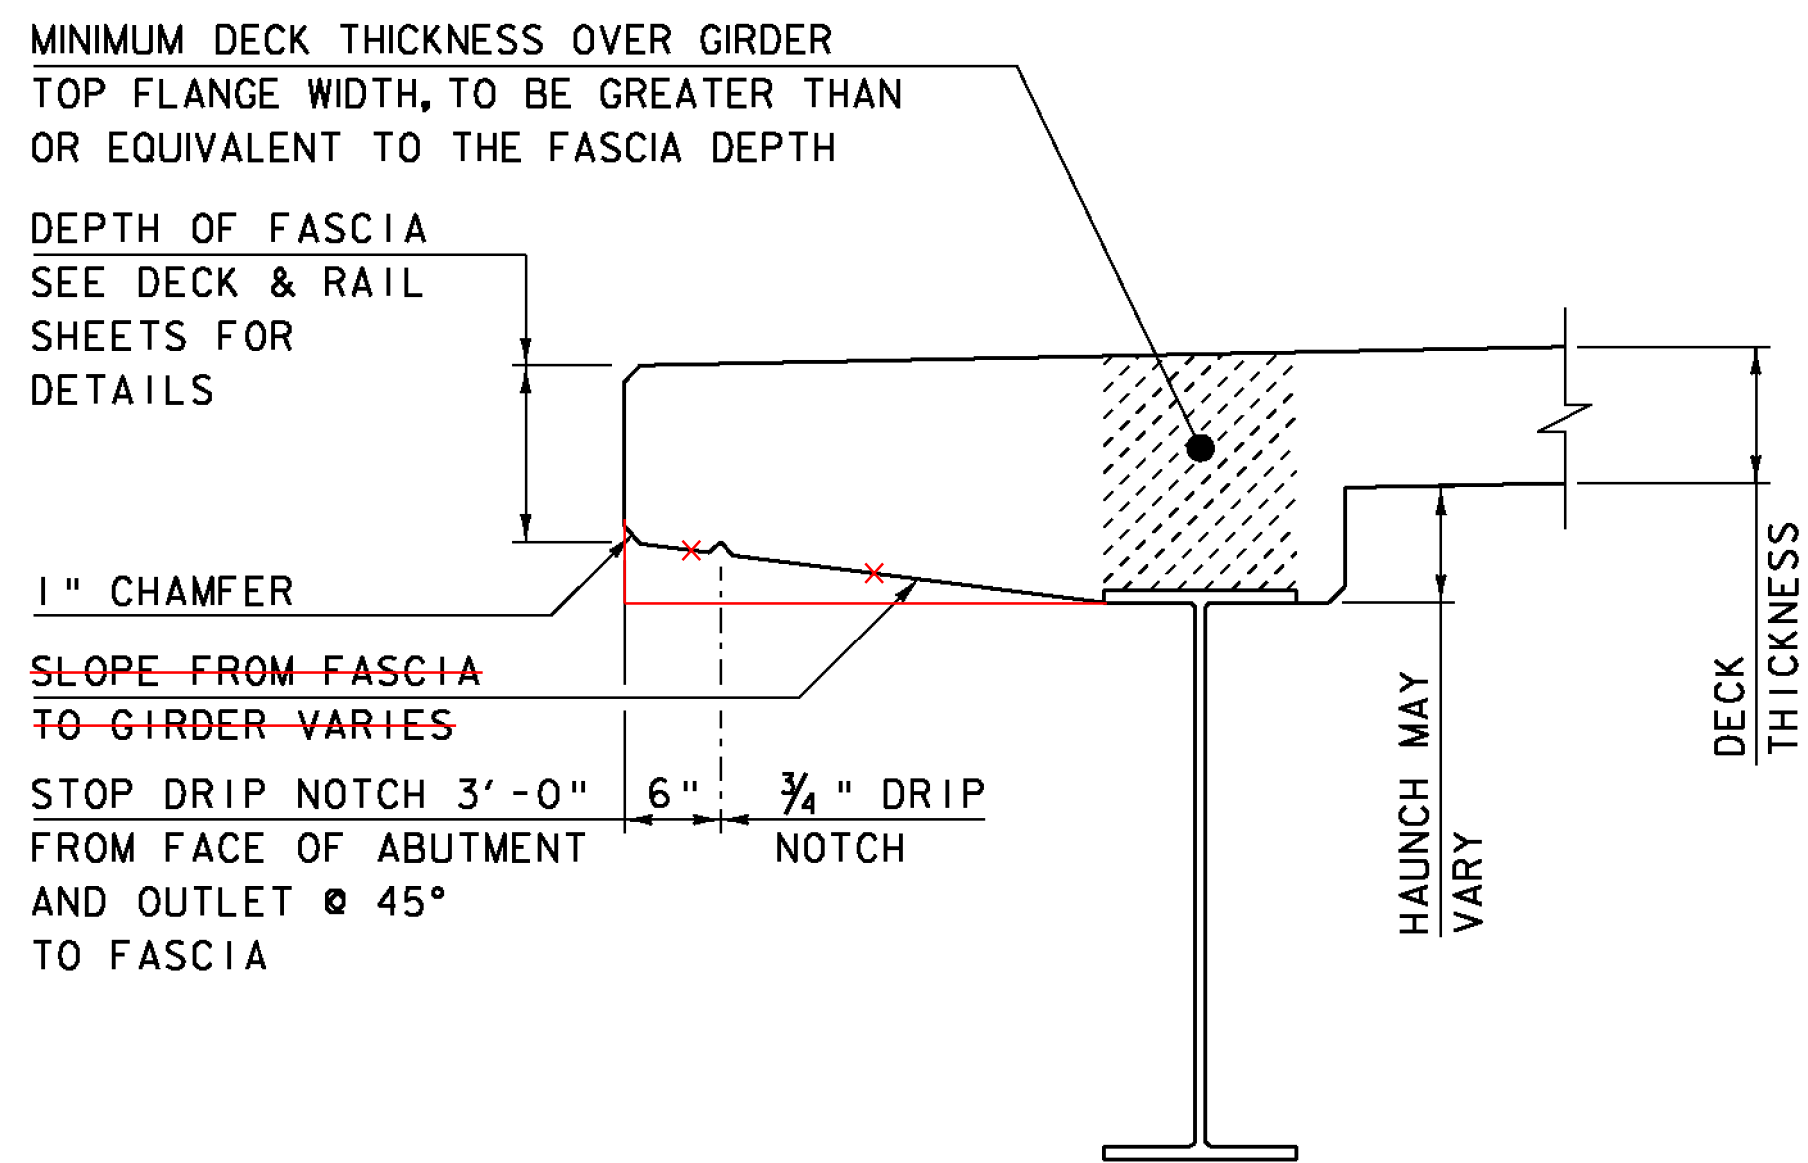

FASCIA & DRIP NOTCH DETAIL


NOT TO SCALE

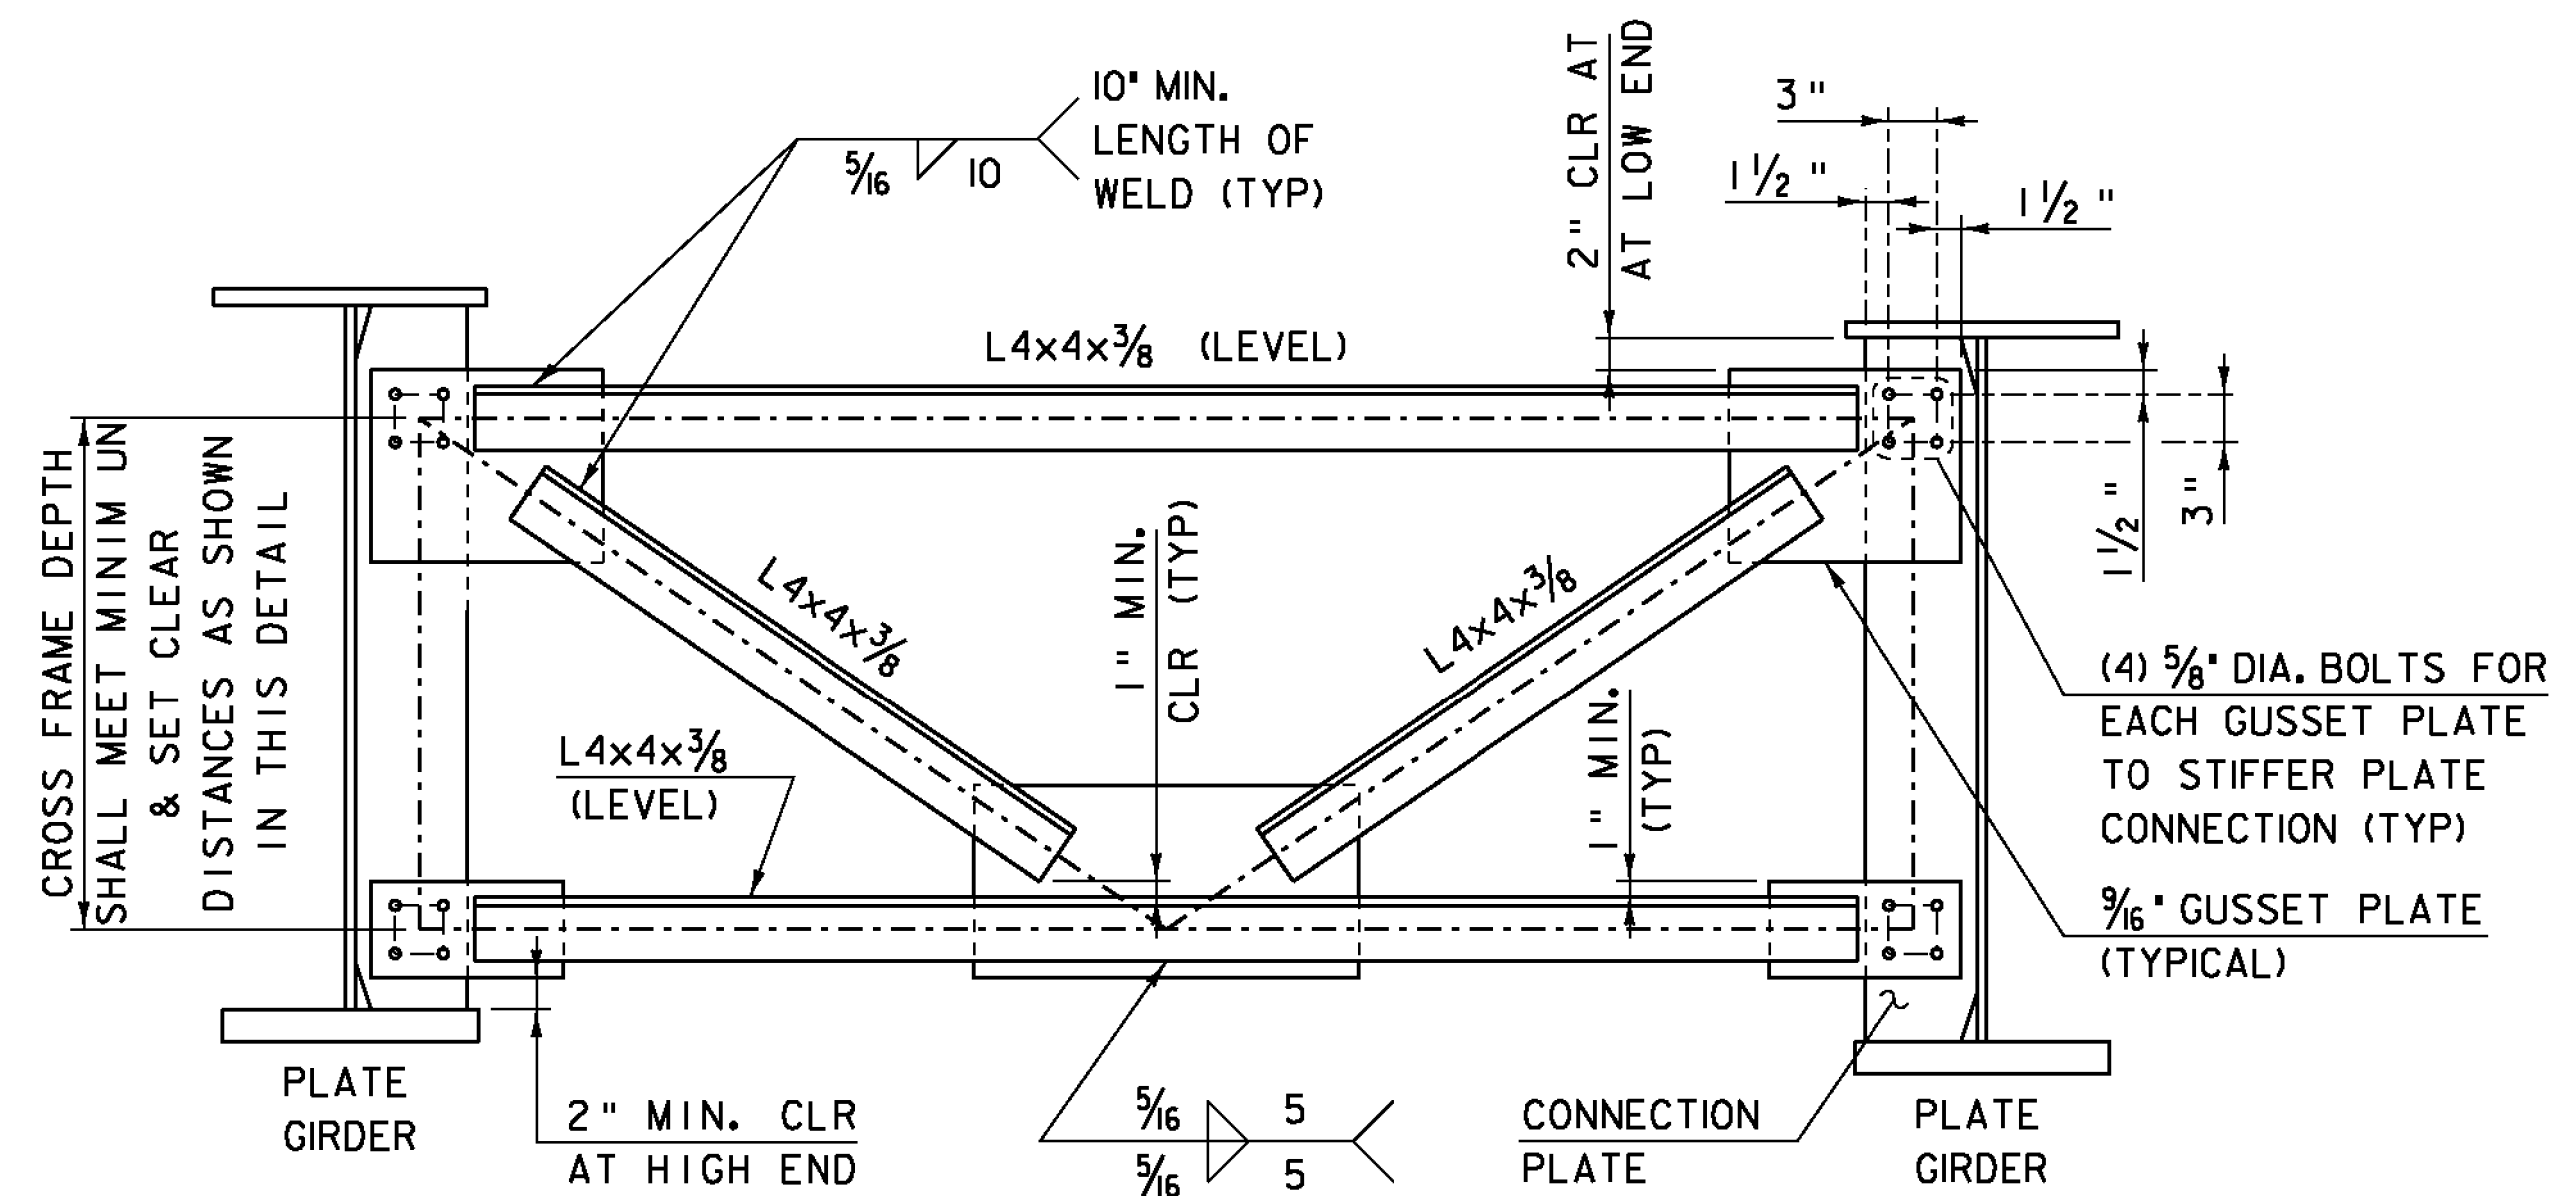

INTERMEDIATE CROSSFRAME DETAILS

SCALE 1" = 1'-0"

1) THE FABRICATOR MAY ALTER THE SHAPE OF THE GUSSET PLATES AS REQUIRED TO MEET MINIMUM WELDING LENGTH AND MAINTAINING THE BOLT HOLE LOCATIONS.

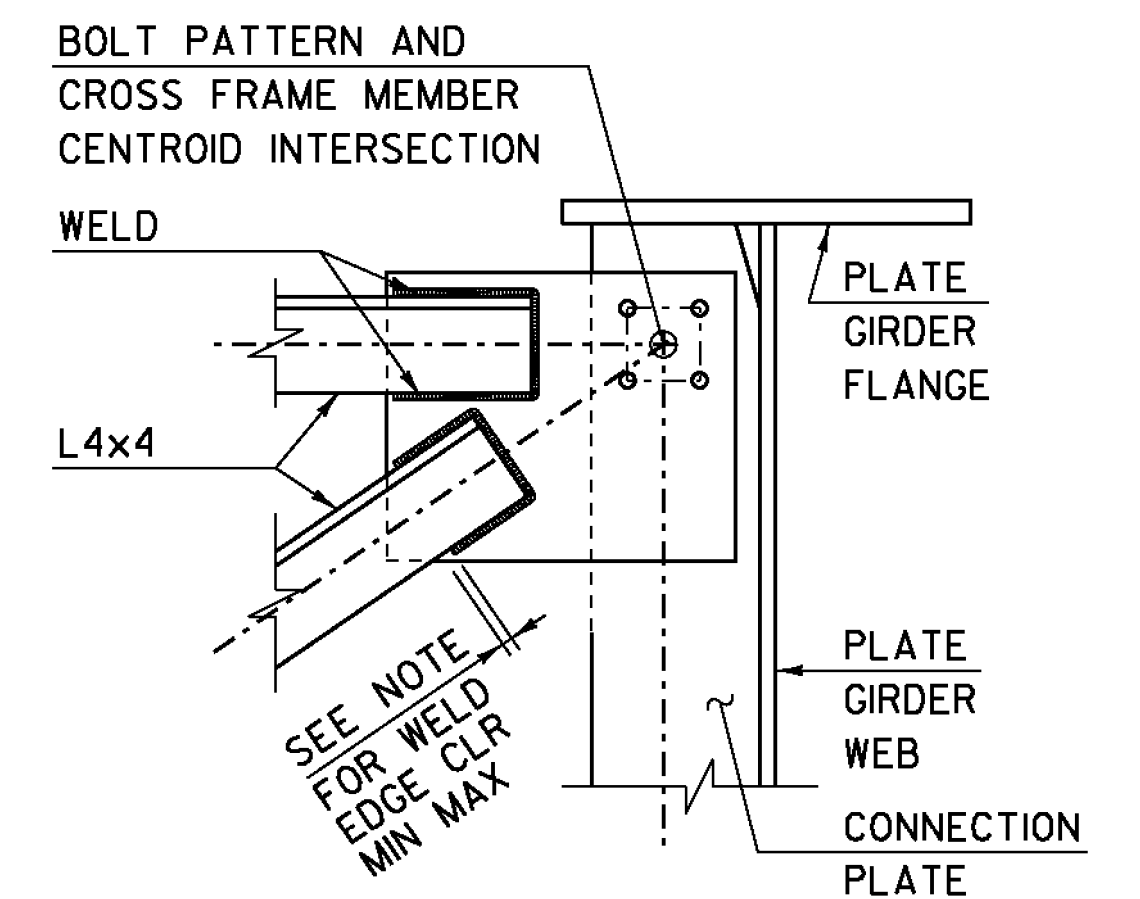

CROSSFRAME GUSSET PLATE & WELD DETAIL

SCALE 1/2" = 1'-0"

NOTE: NO WELD FOR 1/4" MIN. - 1/2" MAX. DISTANCE FROM GUSSET PLATE EDGES

PROJECT NAME:	BETHEL	FILE NAME:	s95c002sup.dgn	PLOT DATE:	31-AUG-2011
PROJECT NUMBER:	BRF 0241 (30)	PROJECT LEADER:	M. EVANS-MONGEON	DRAWN BY:	M. LONGSTREET
		DESIGNED BY:	U. STANLEY	CHECKED BY:	U. STANLEY
		DECK TYPICAL & DETAILS			SHEET 42 OF 64