



ABUTMENT I FIXED BEARING END ELEVATION

SCALE 3" = 1'-0"

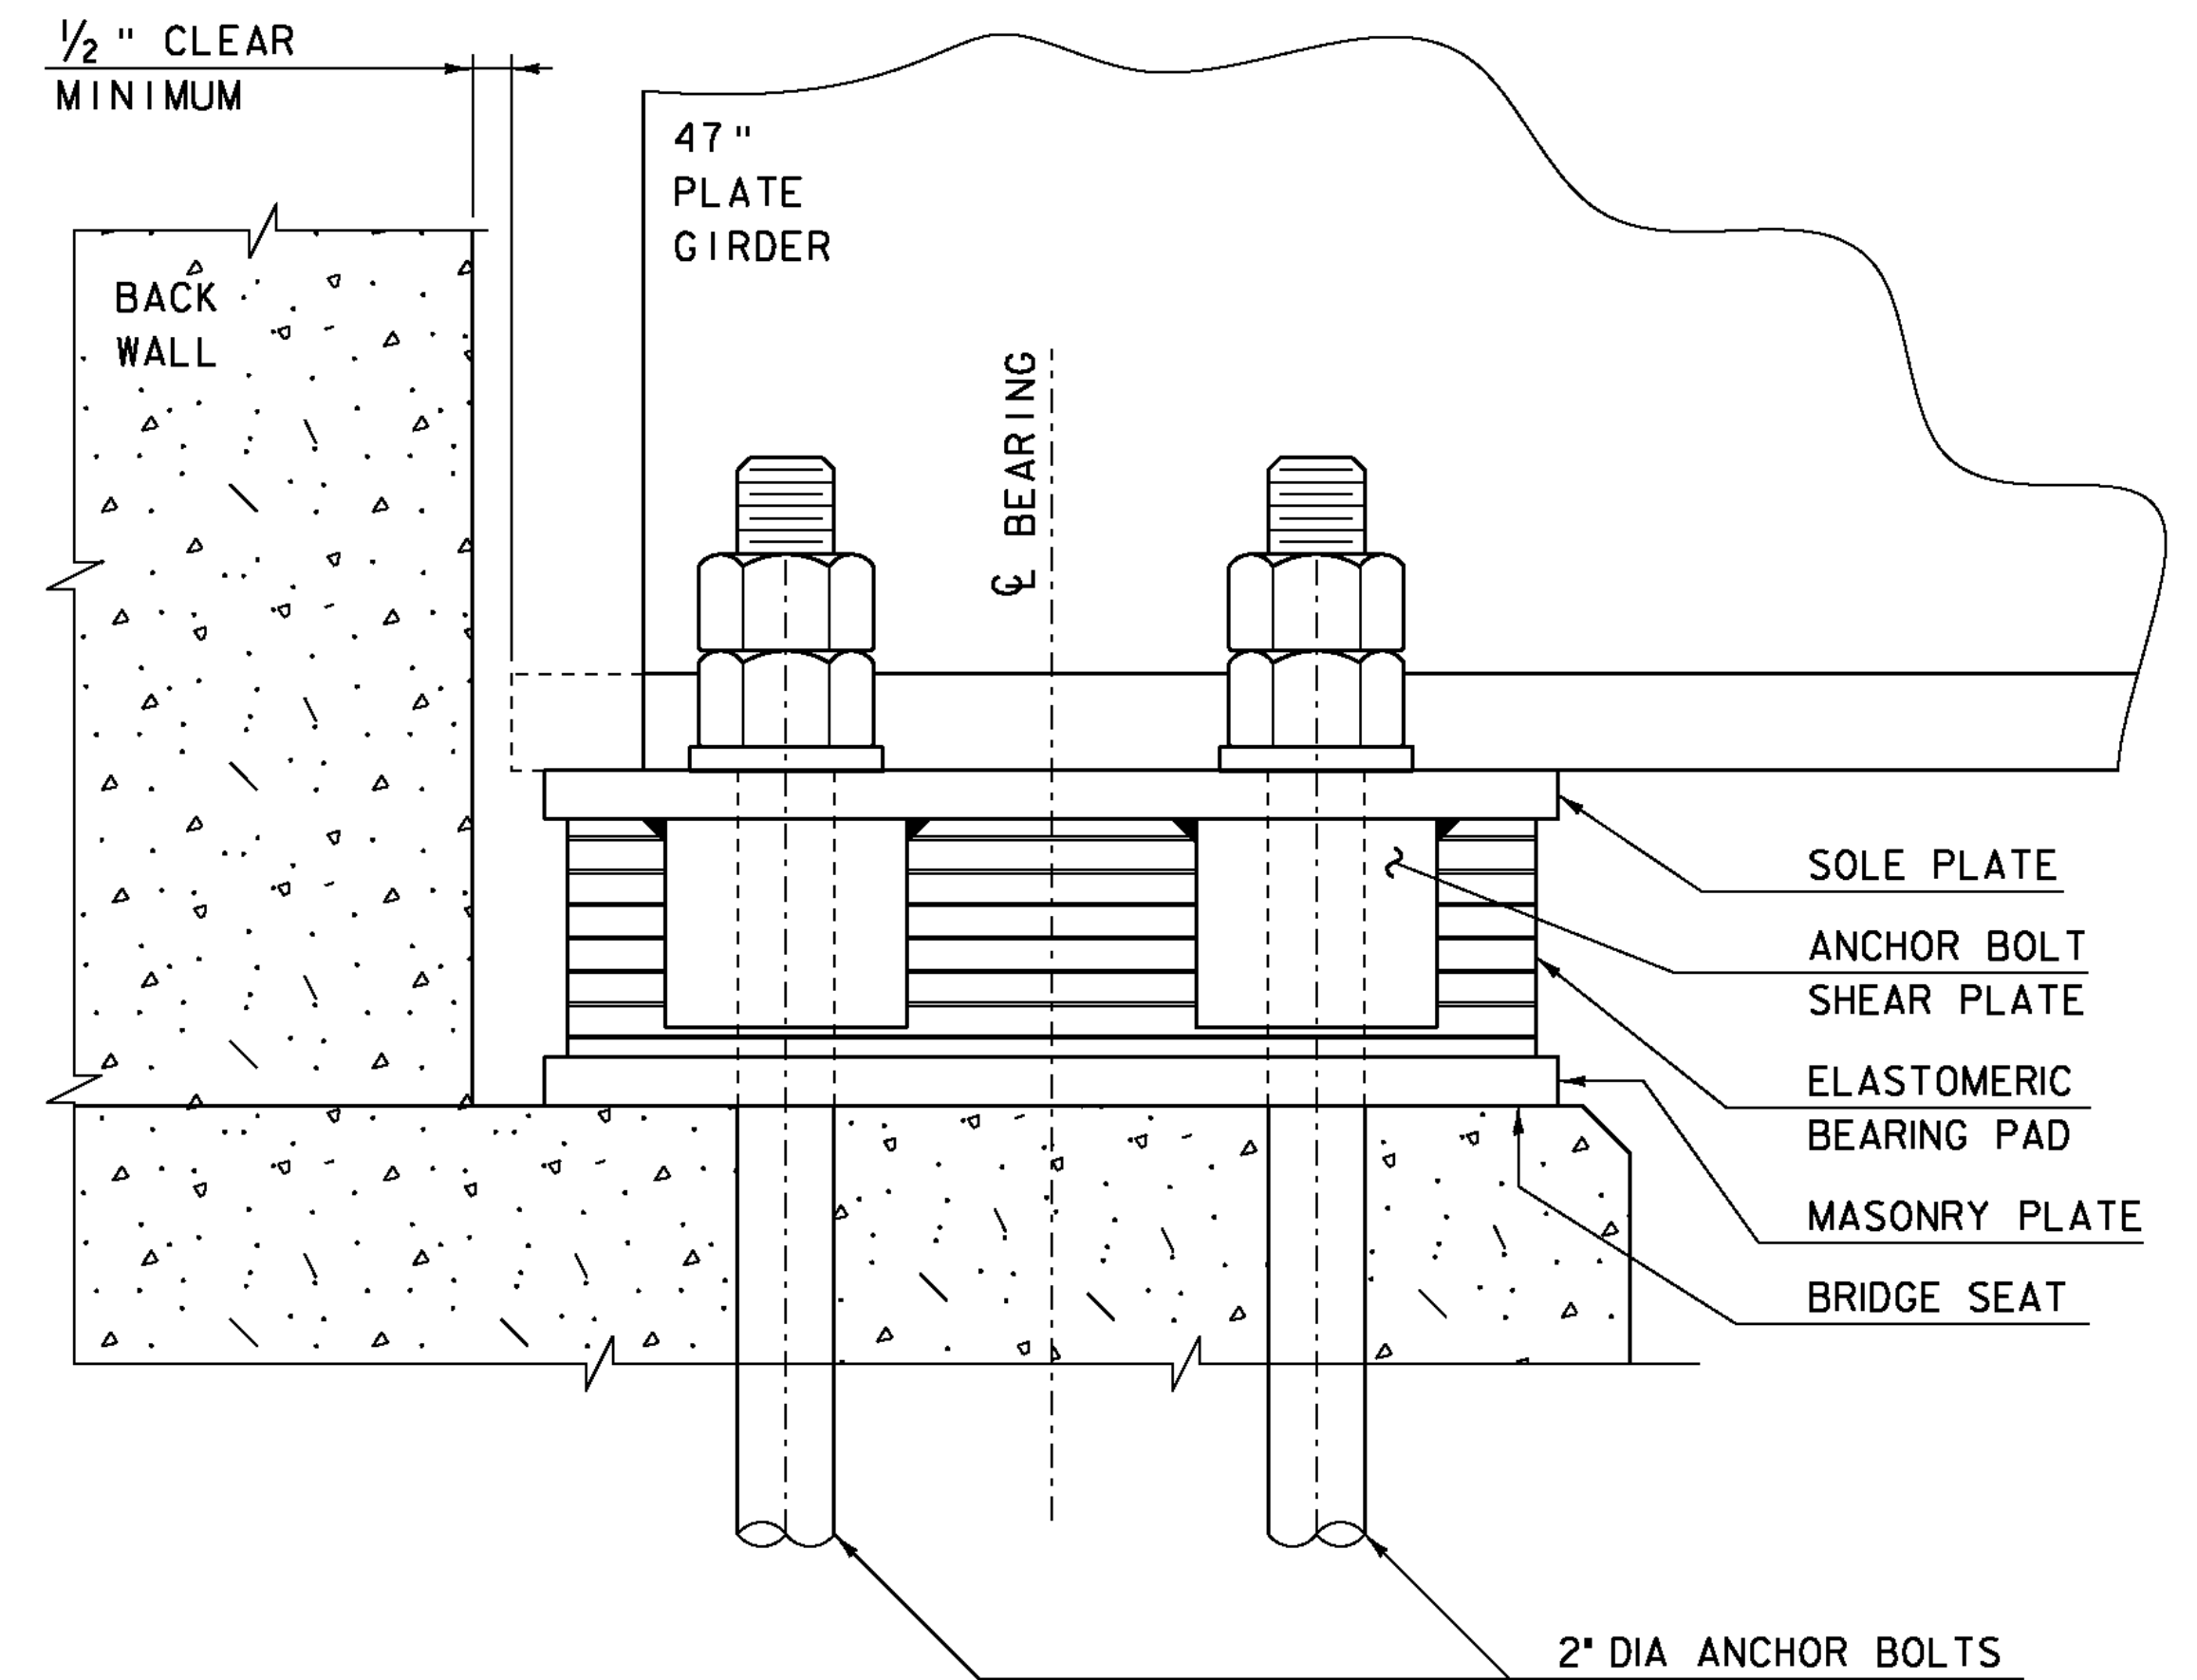


ABUTMENT I FIXED BEARING SIDE ELEVATION

SCALE 3" = 1'-0"

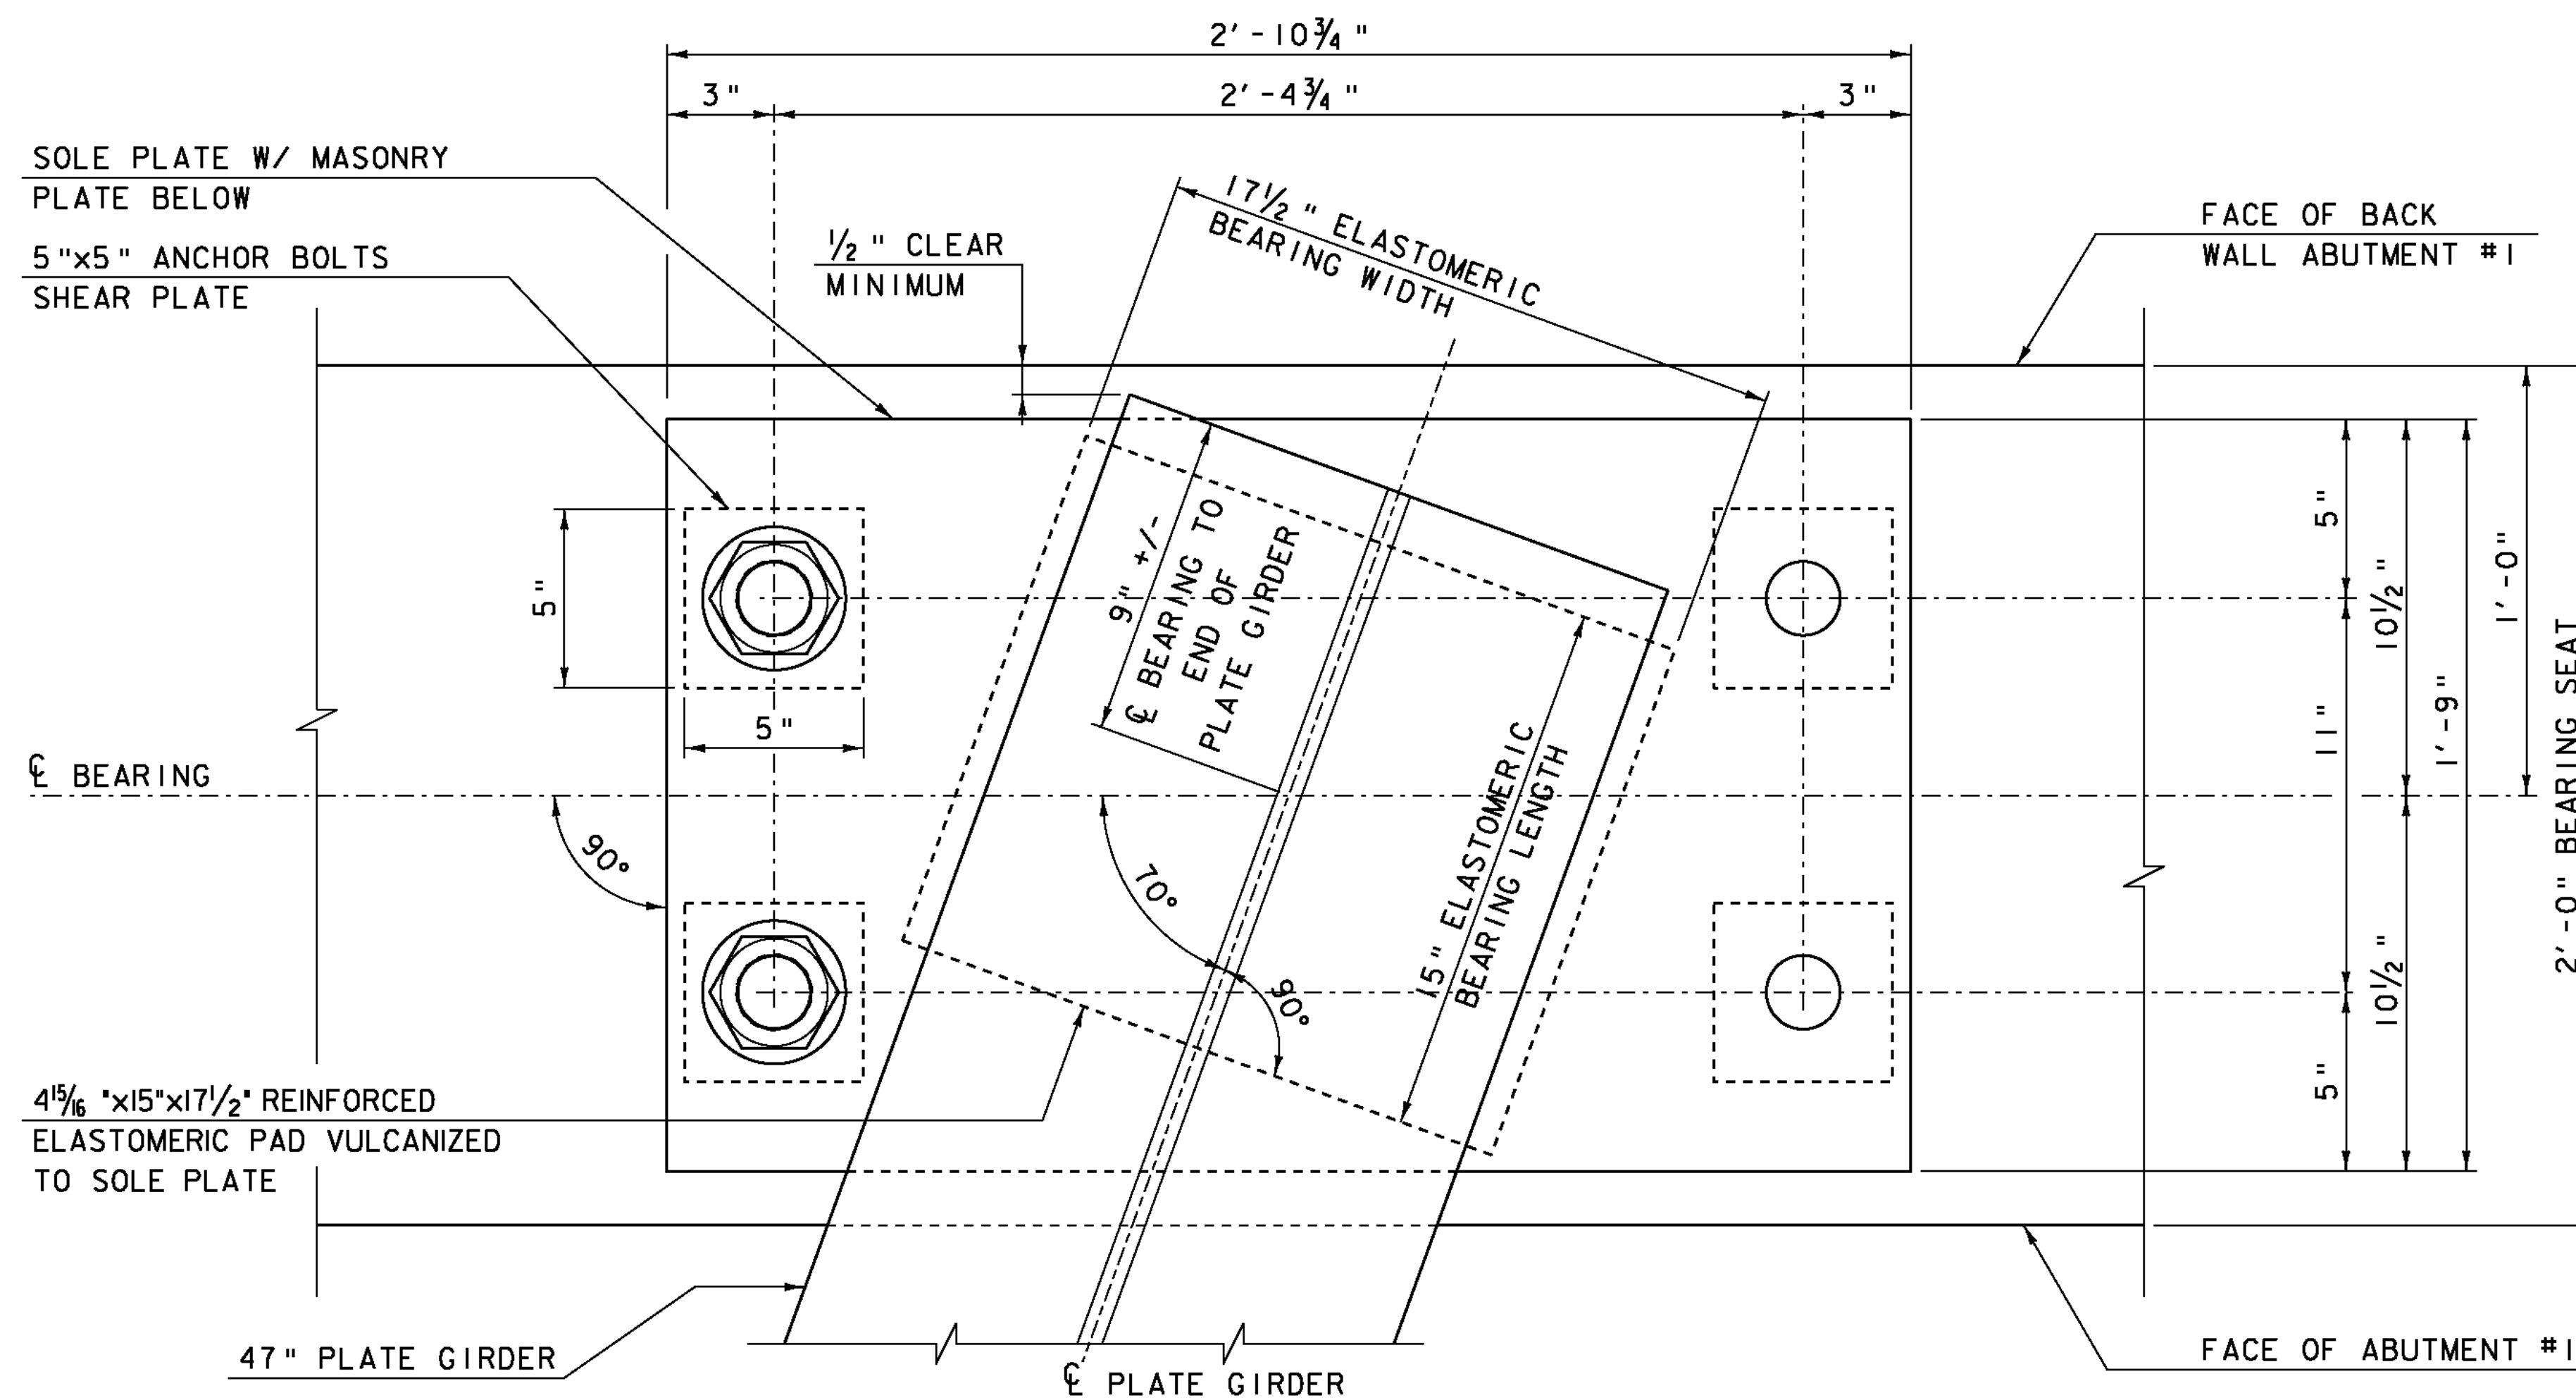

ABUTMENT I FIXED BEARING PLAN

SCALE 3" = 1'-0"

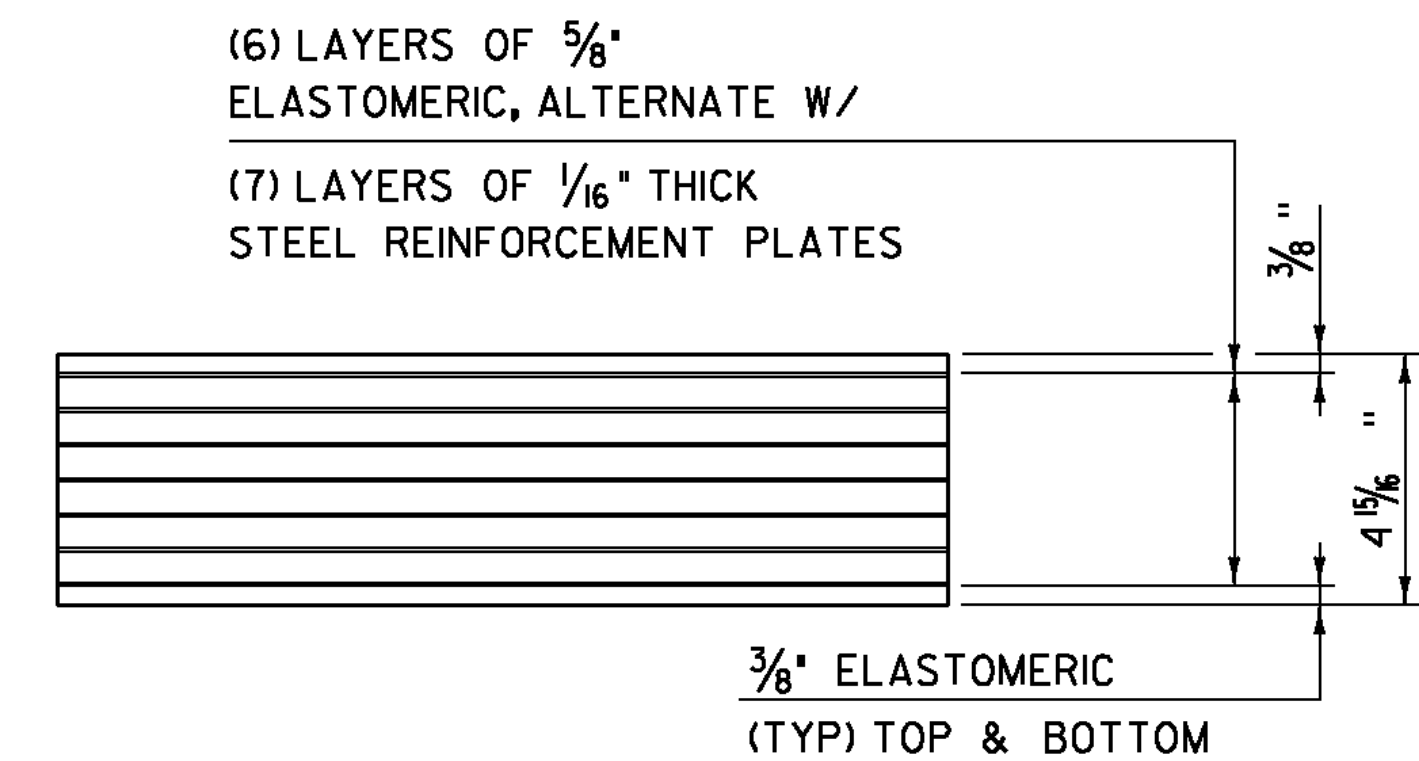

ABUTMENT I ELASTOMERIC BEARING MAKEUP

SCALE 3" = 1'-0"

PROJECT NAME: BETHEL
PROJECT NUMBER: BHF 0241(30)

FILE NAME: s95c002brg.dgn
PROJECT LEADER: M. EVANS-MONGEON
DESIGNED BY: U. STANLEY
ABUTMENT I FIXED BEARING DETAILS

PLOT DATE: 31-AUG-2011
DRAWN BY: M. LONGSTREET
CHECKED BY: U. STANLEY
SHEET 46 OF 64