




100+50

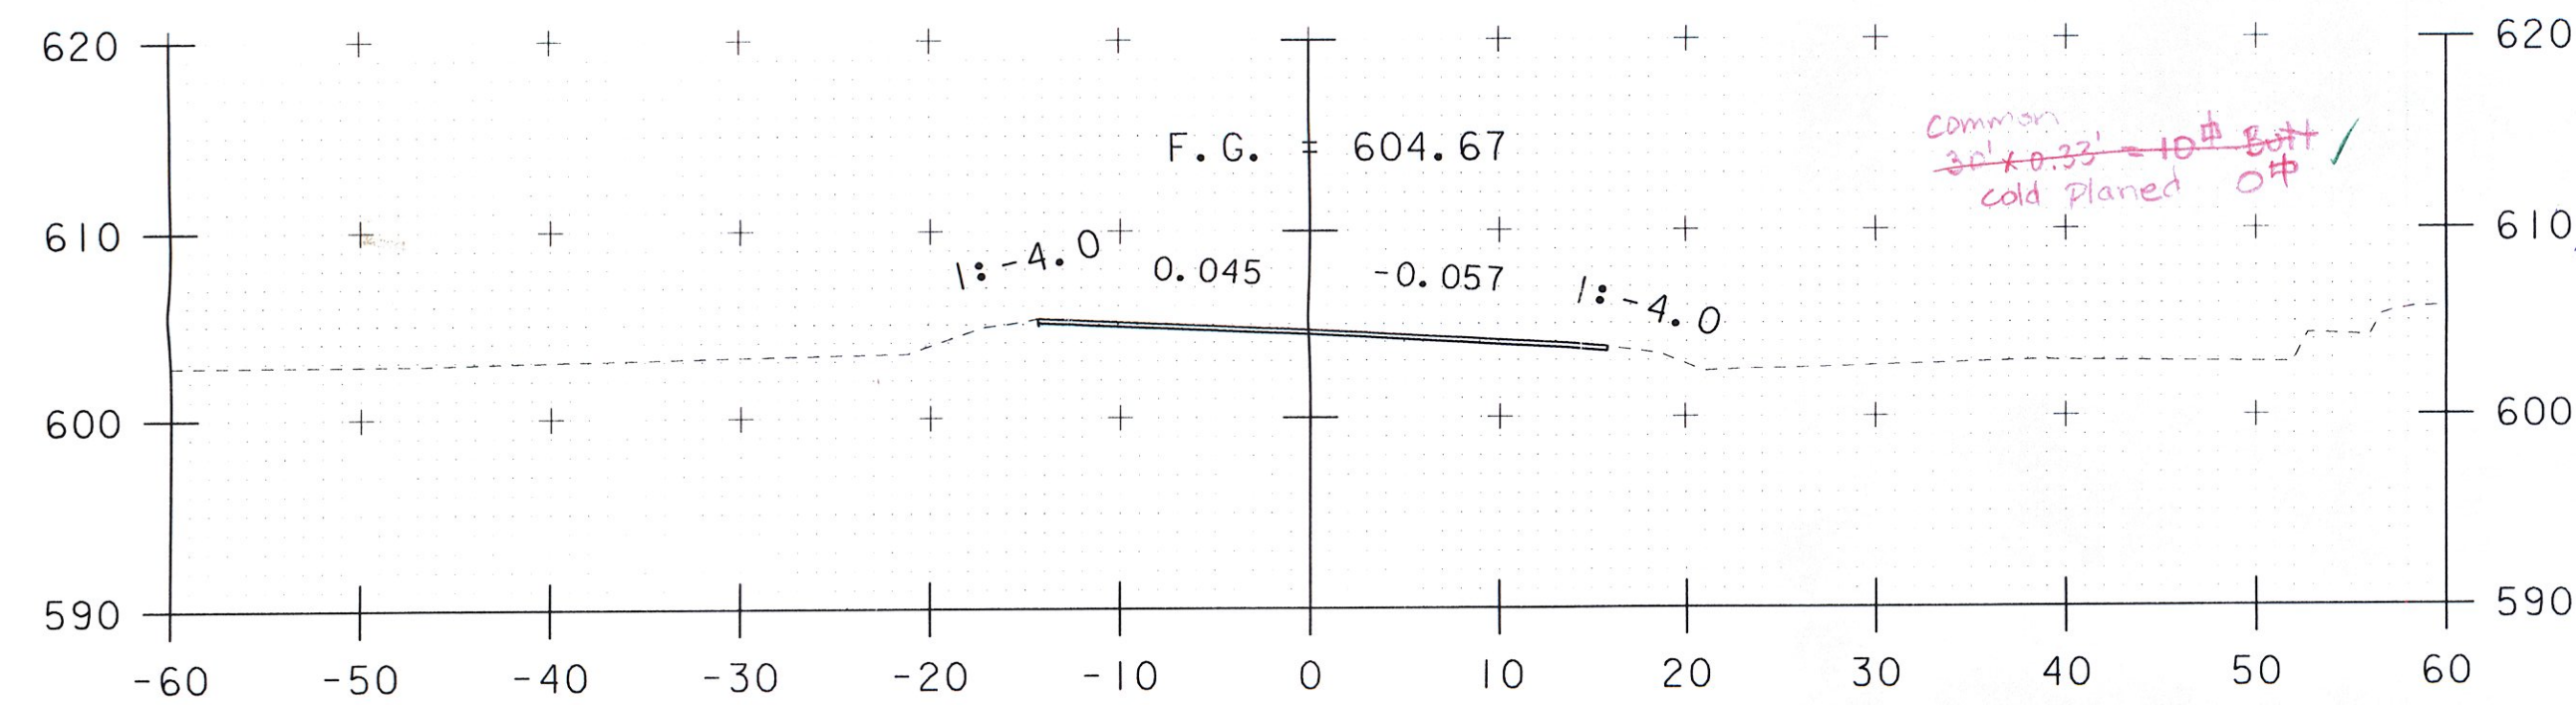


100+10  
BEGIN APPROACH

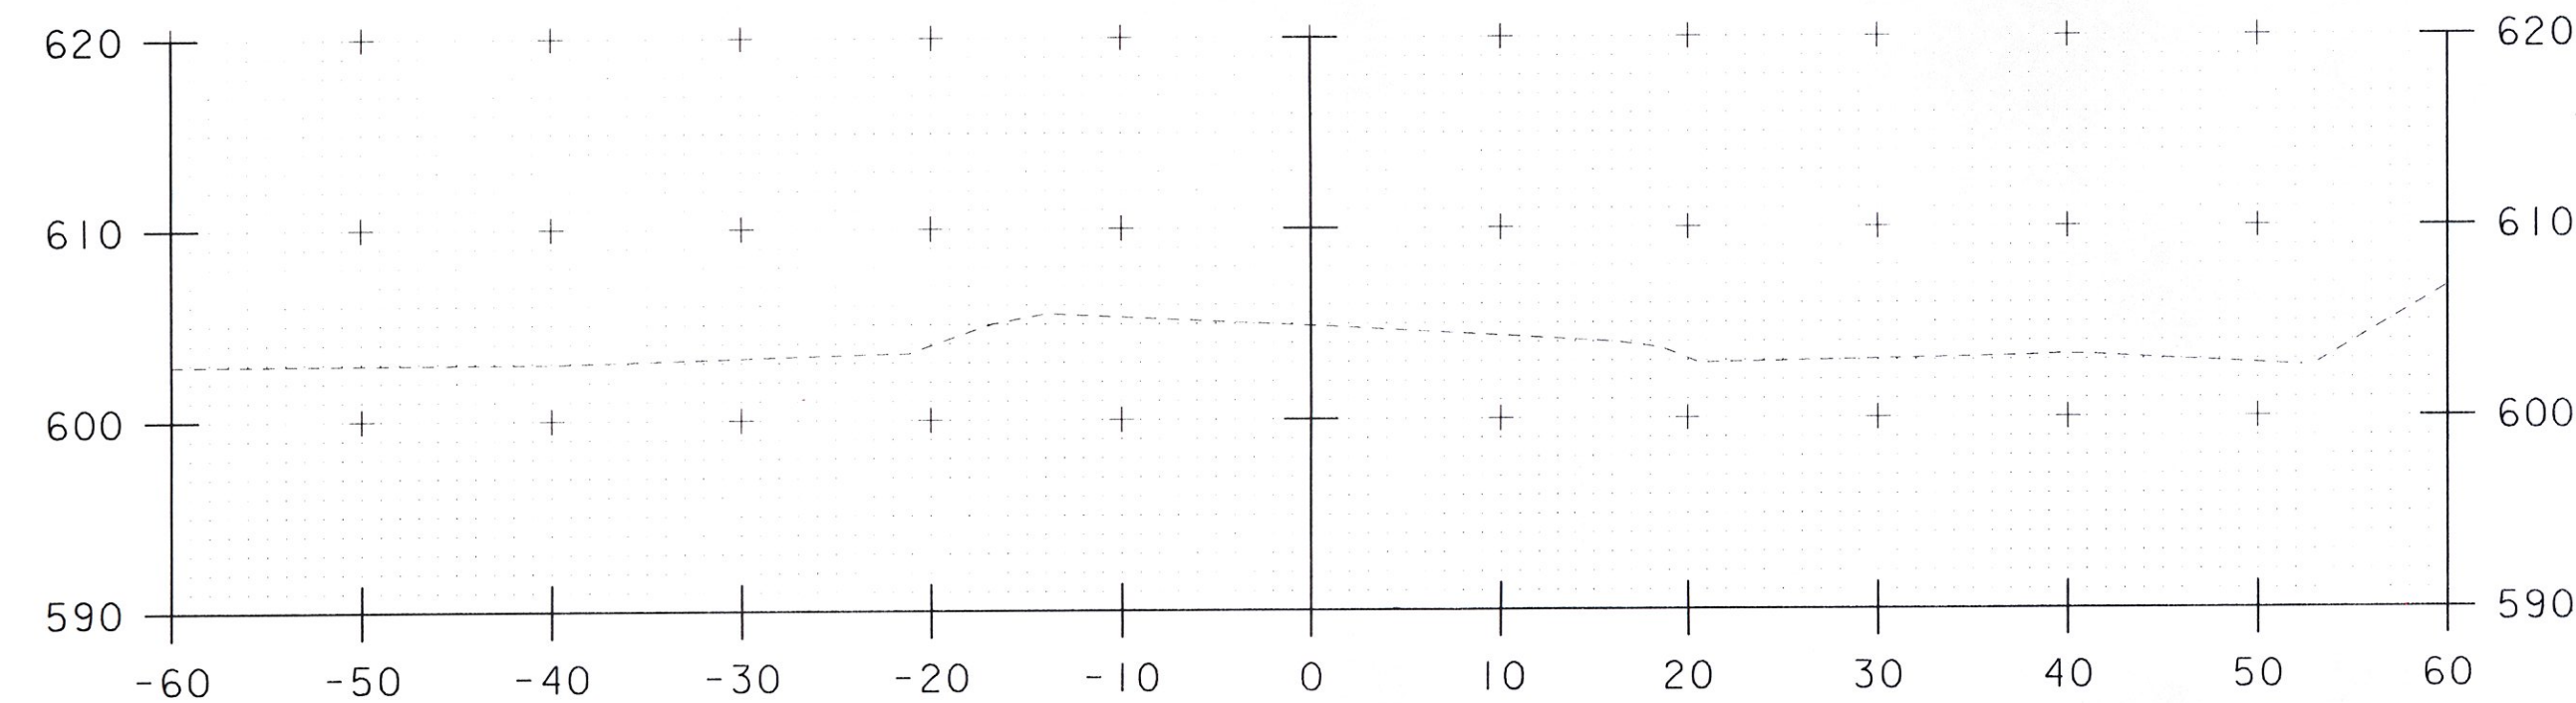


100+00

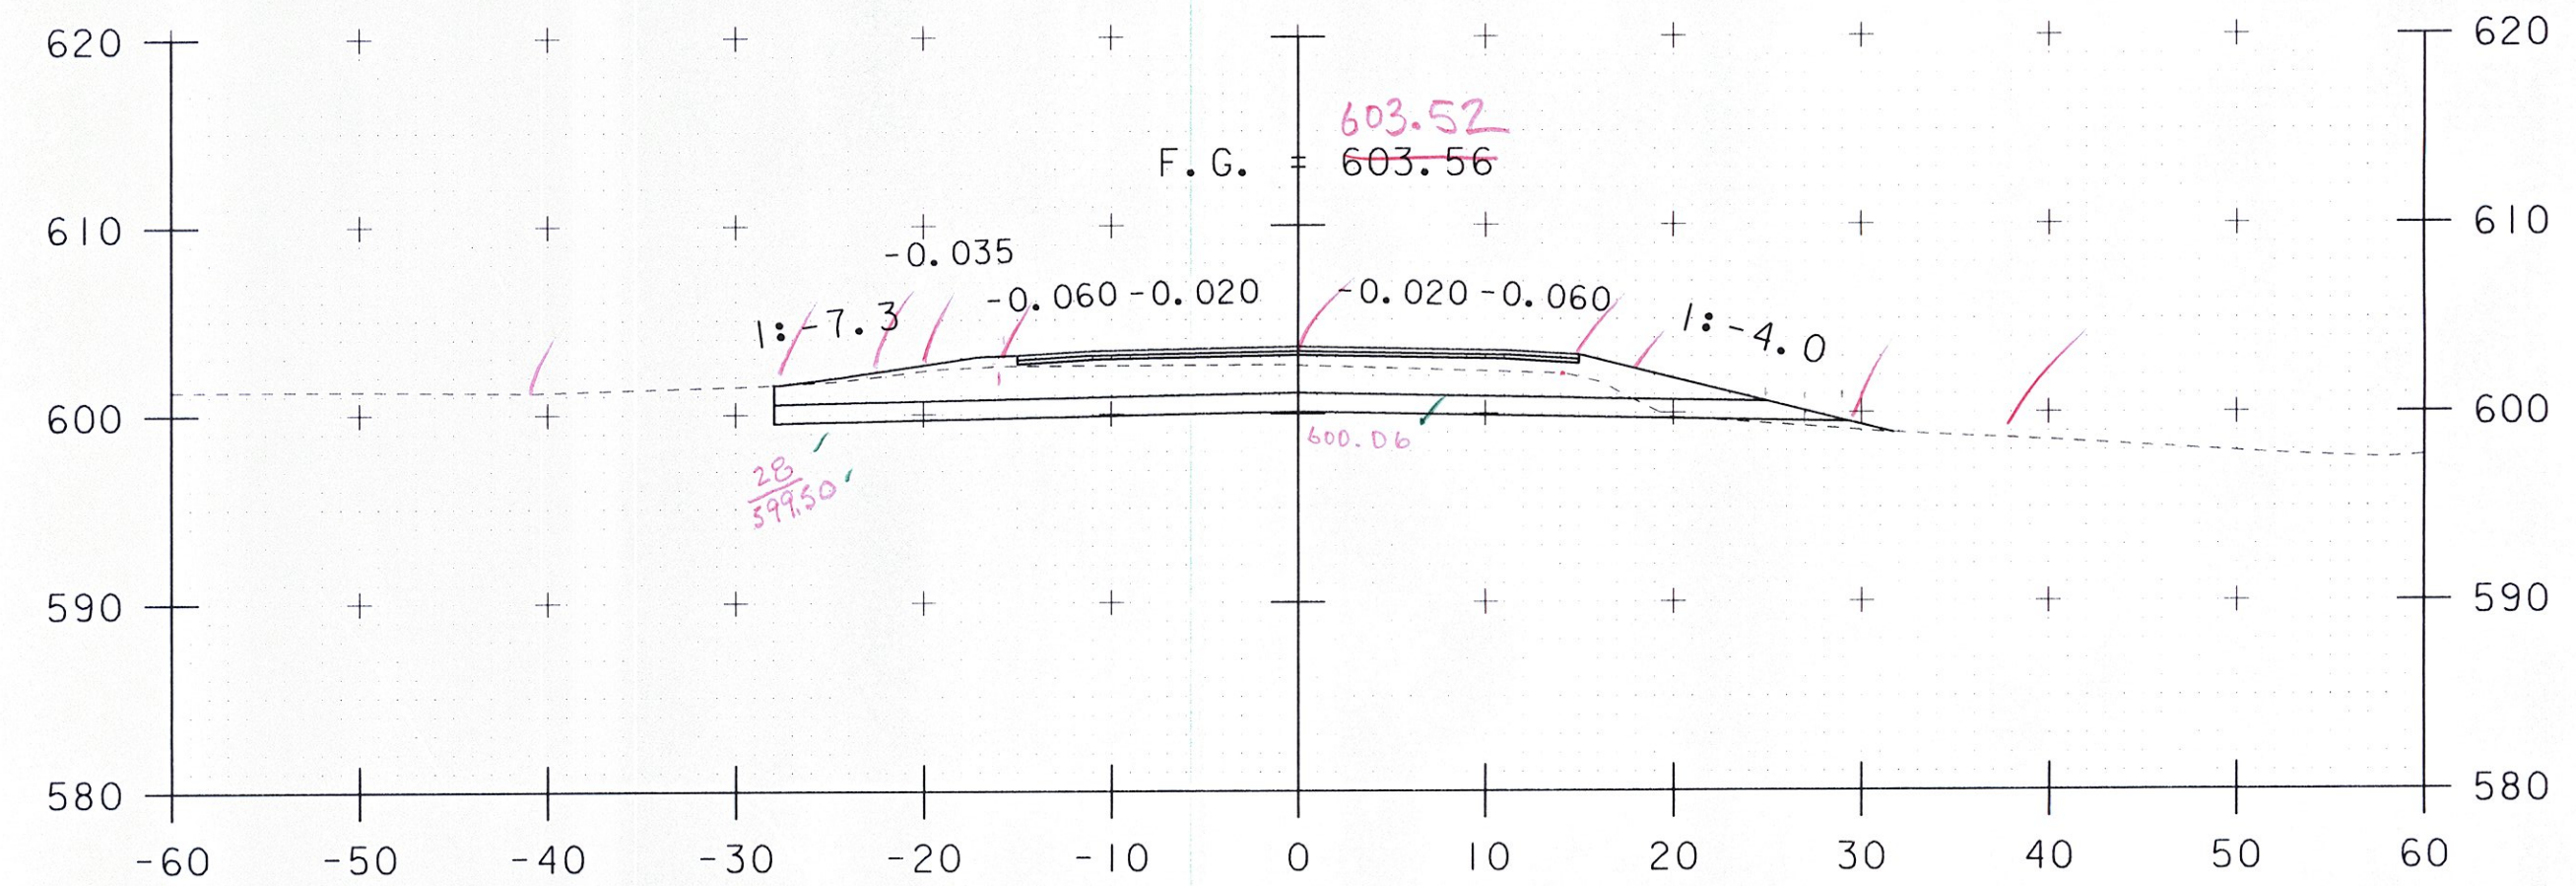

101+50

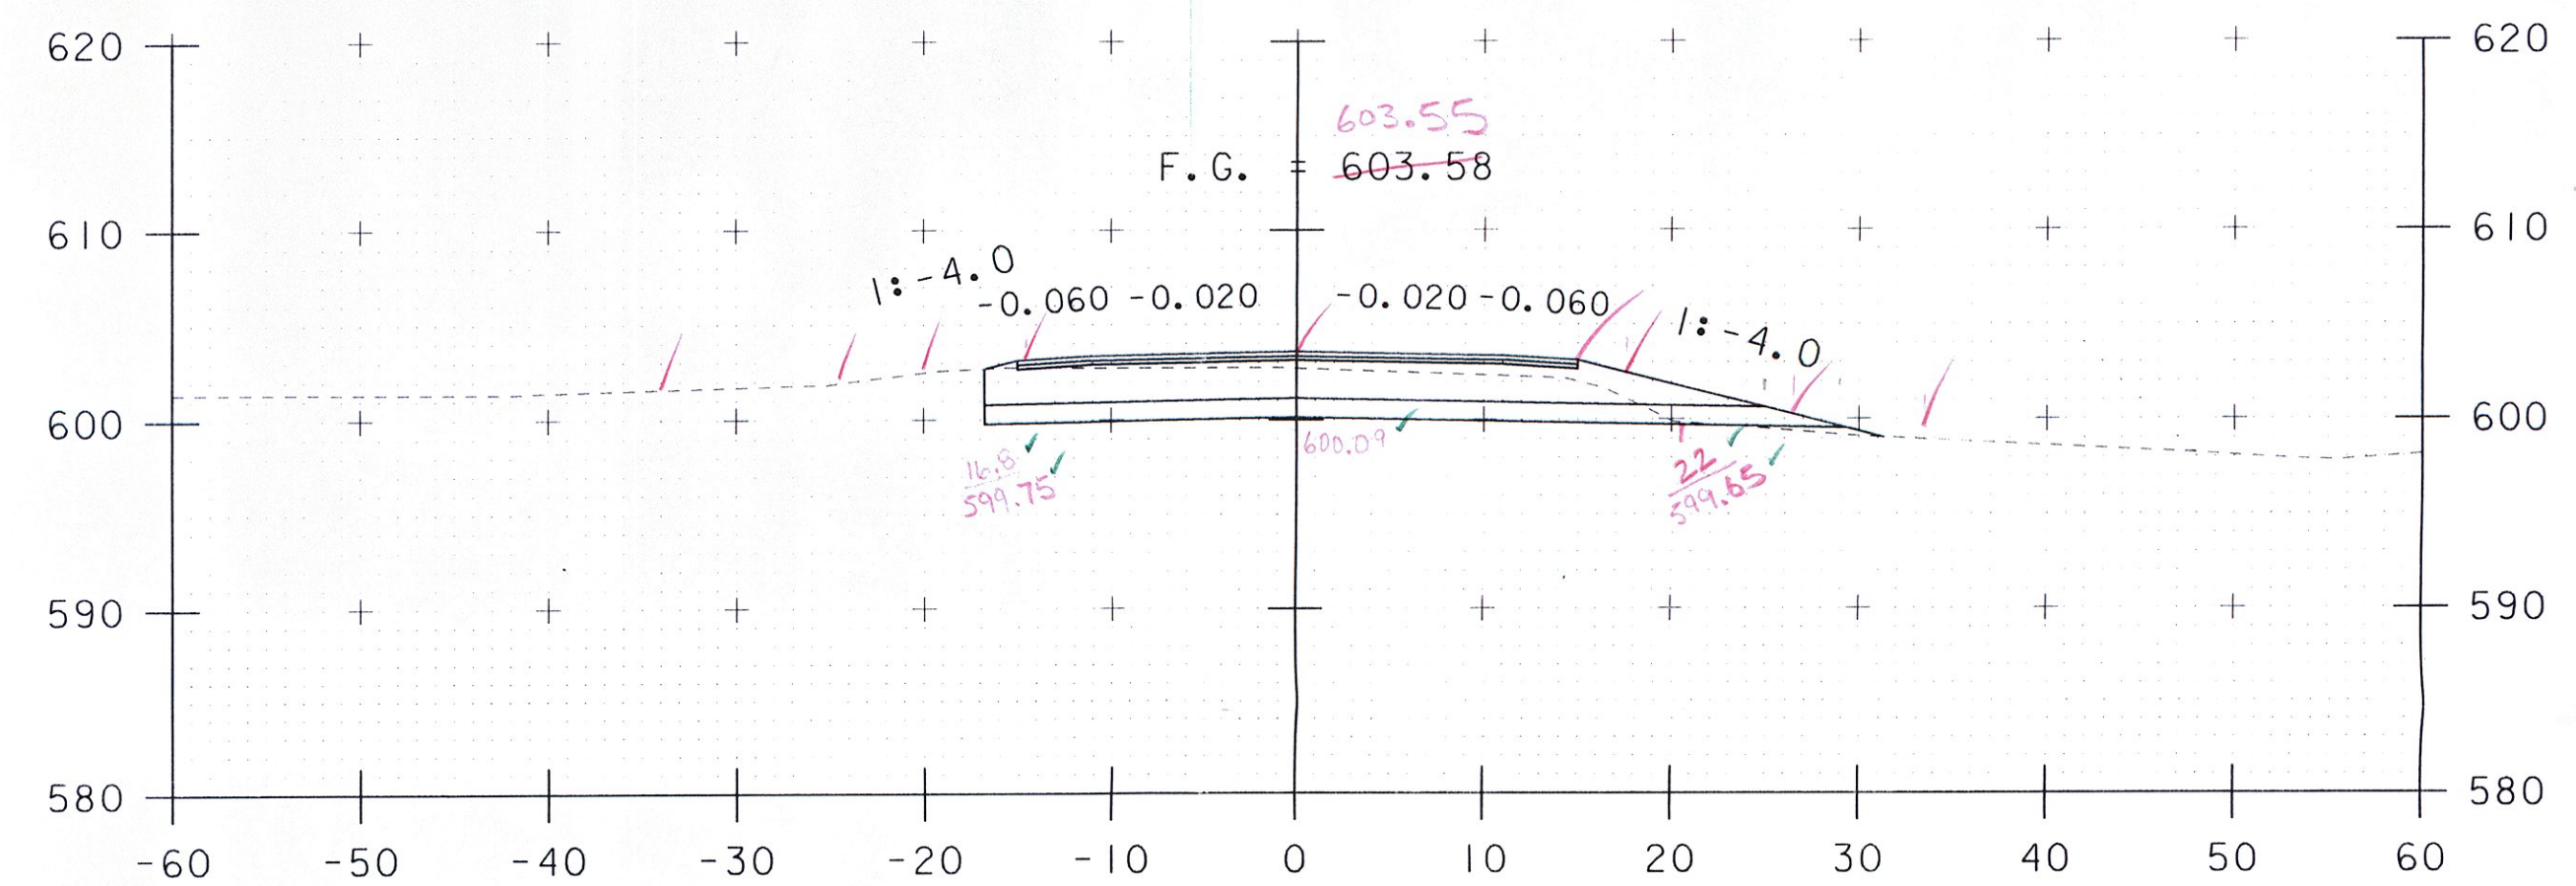

101+35  
BEGIN PROJECT

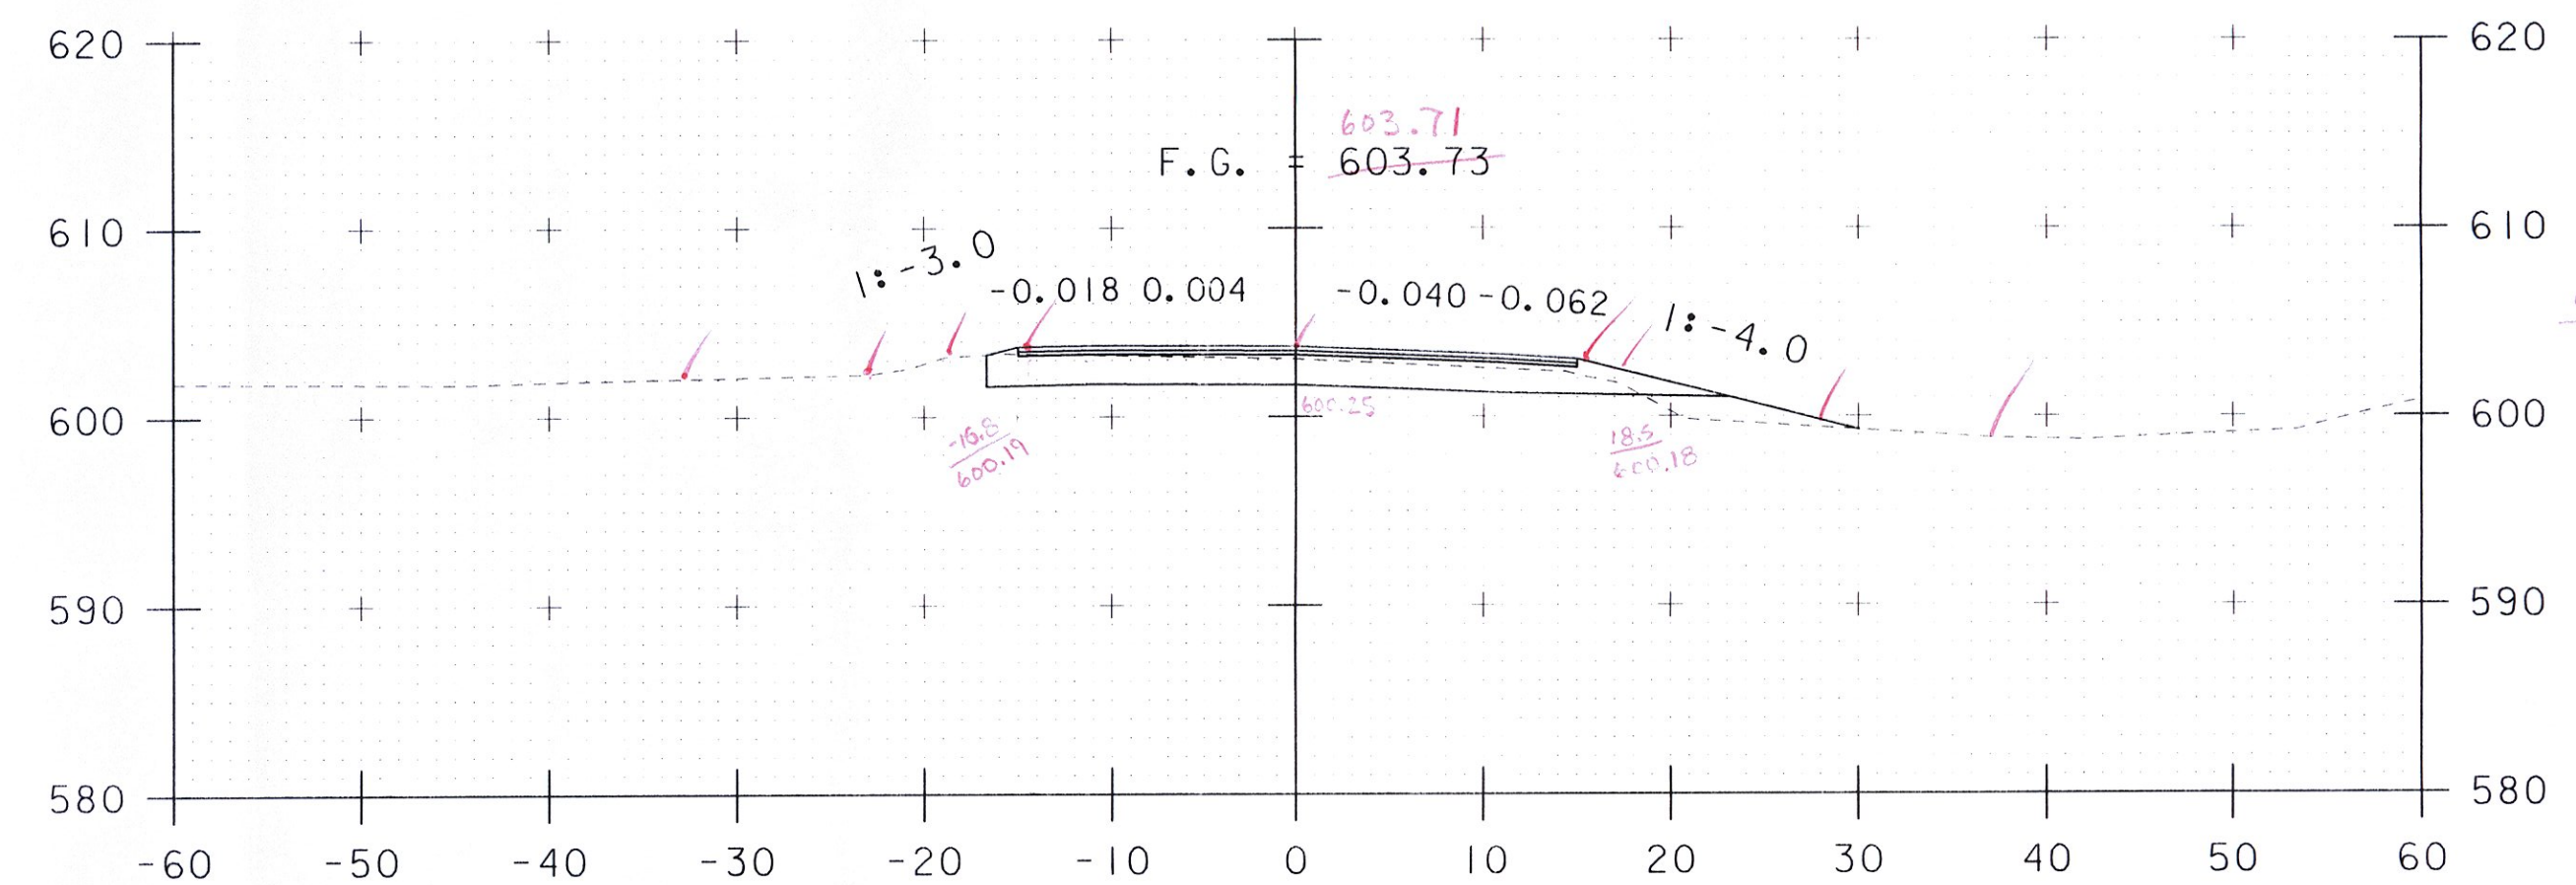

101+00

PROJECT NAME: BETHEL  
PROJECT NUMBER: BHF 0241(30)

FILE NAME: sc002xs.dgn  
PROJECT LEADER: M. EVANS-MONGEON  
DESIGNED BY: U. STANLEY  
MAINLINE SECTIONS SHEET 1

PLOT DATE: 31-AUG-2011  
DRAWN BY: U. STANLEY  
CHECKED BY: G. ROKES  
SHEET 56 OF 64