




102+50

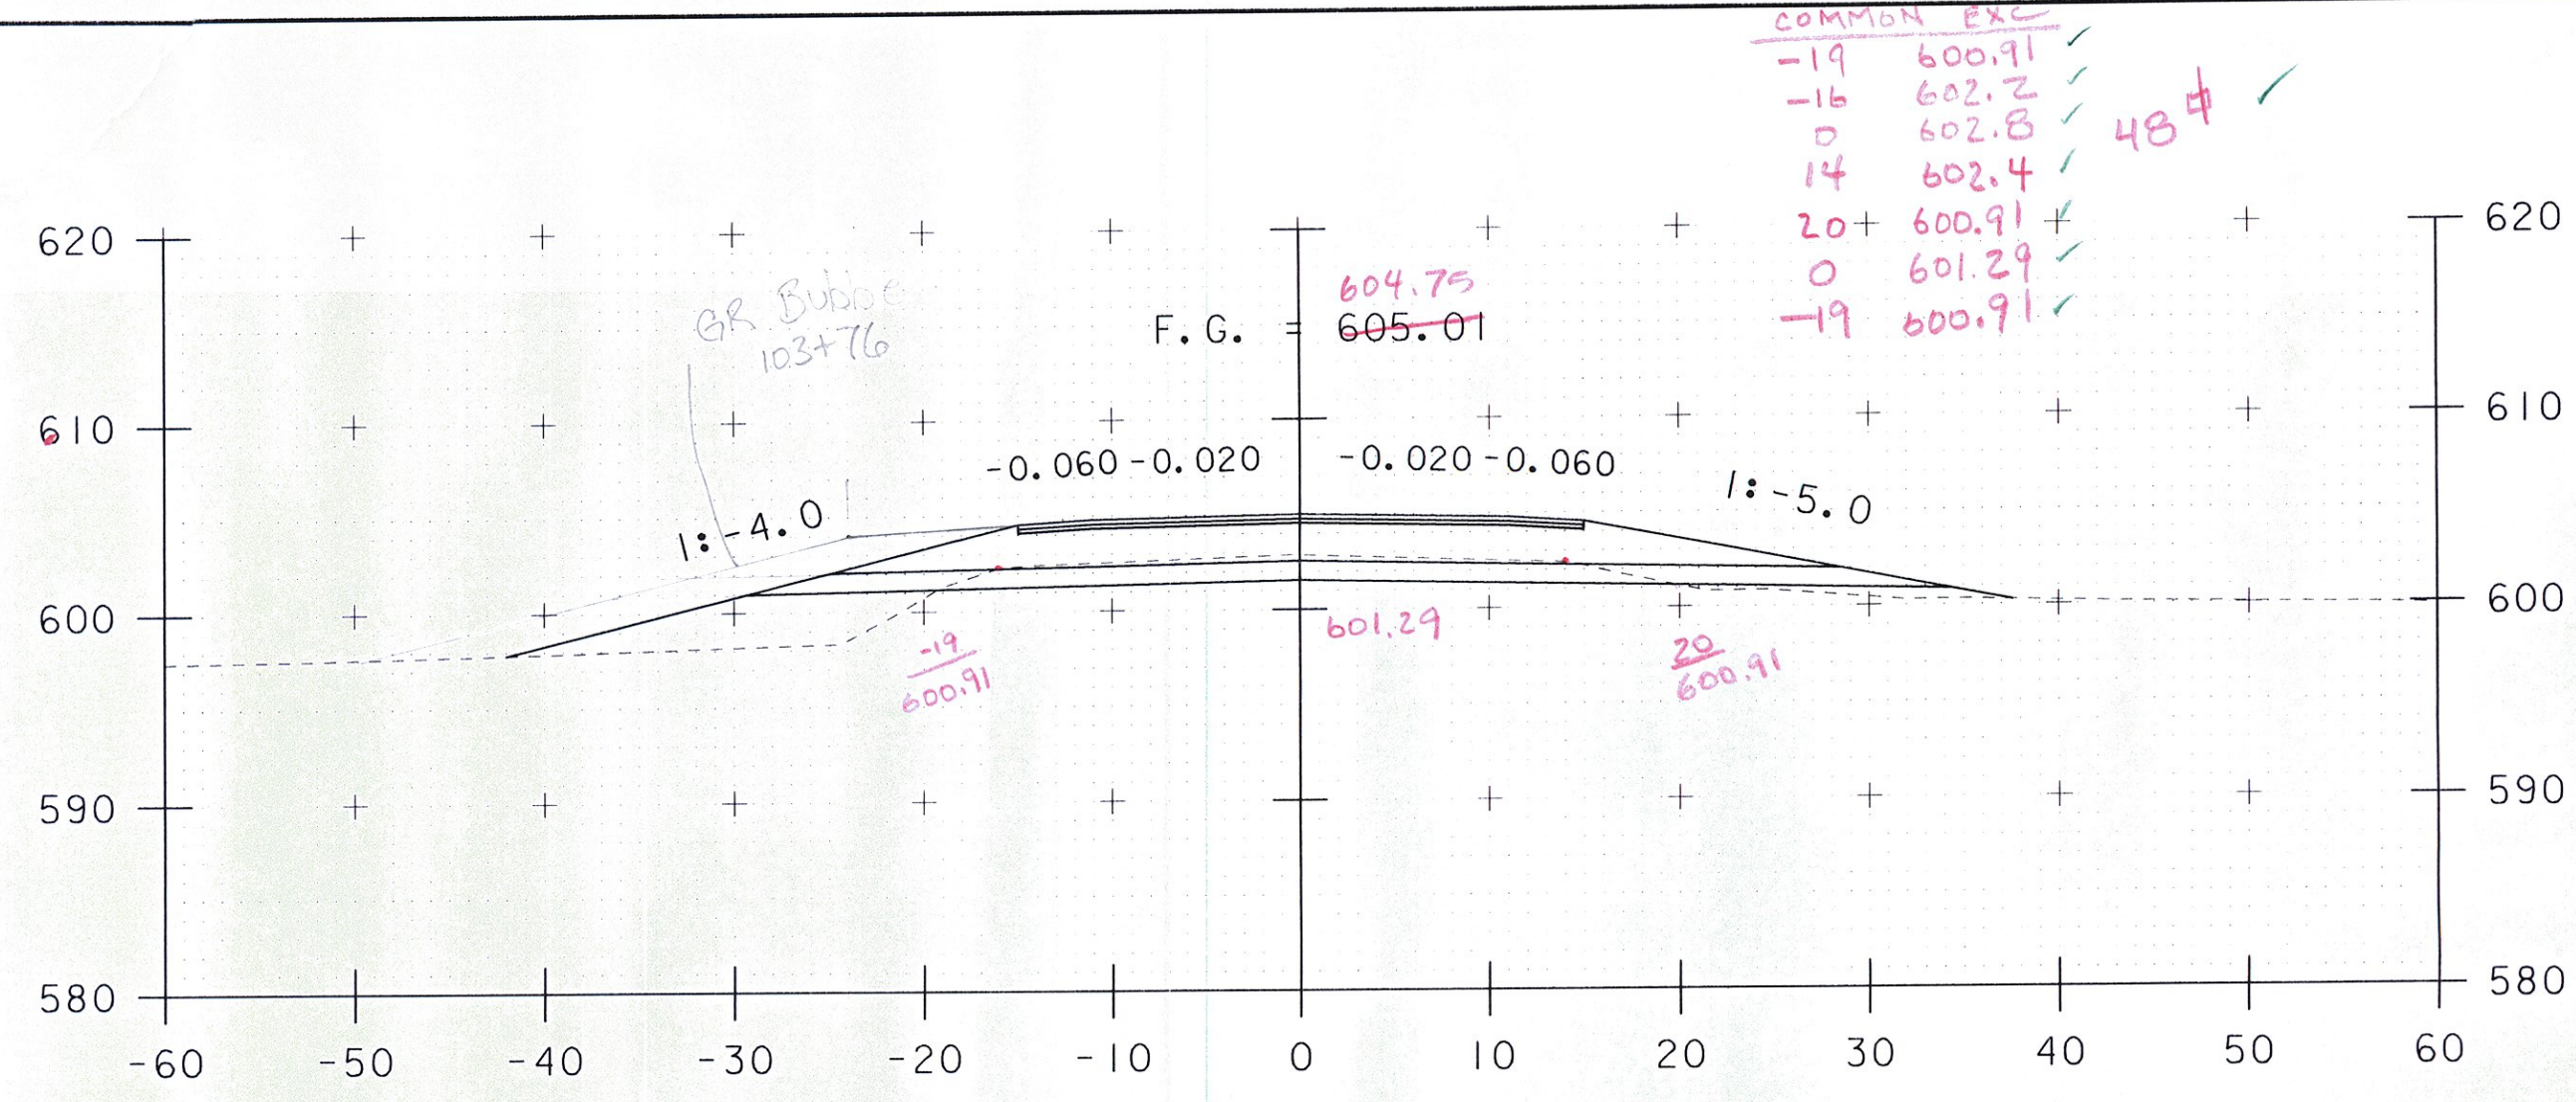


103+50

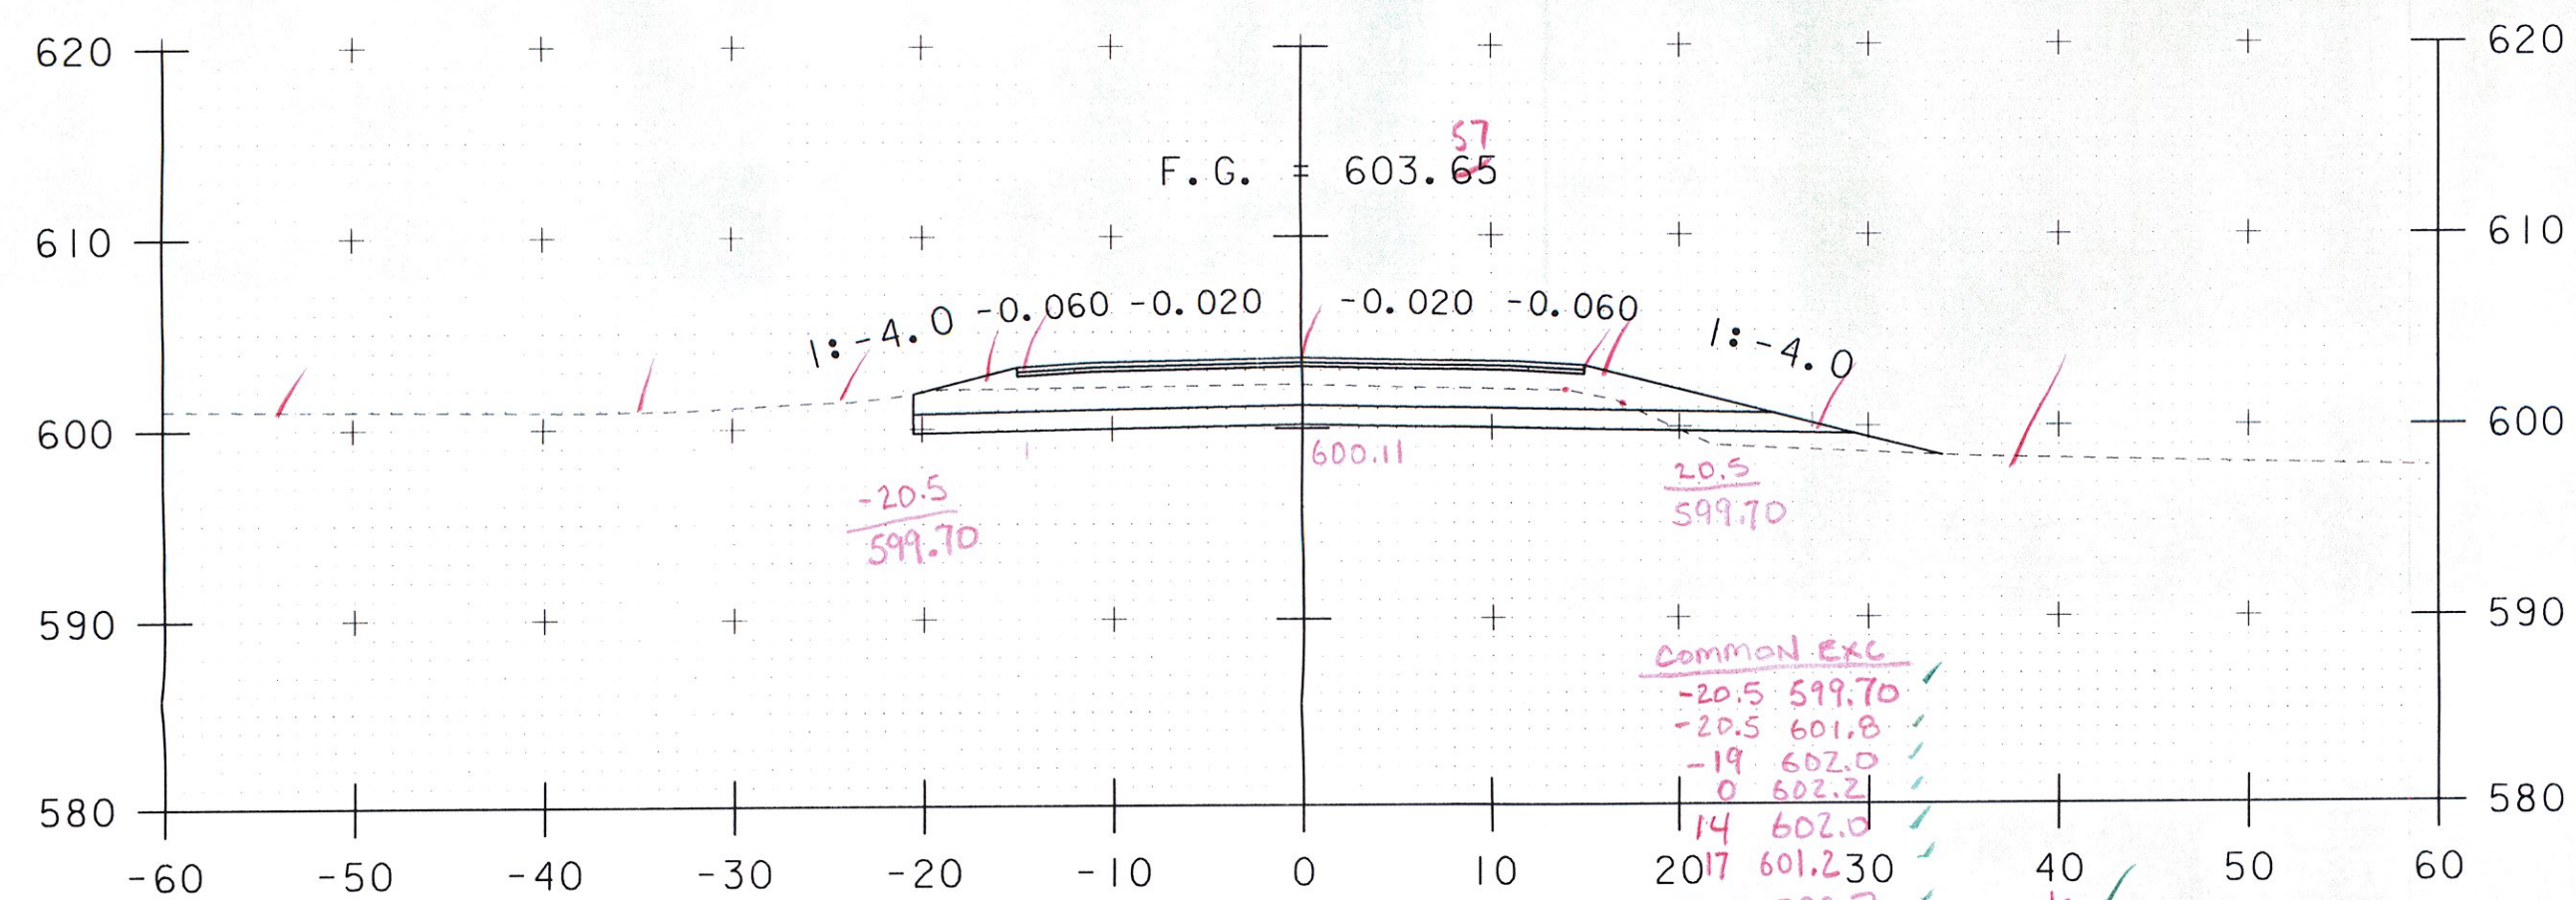


102+00

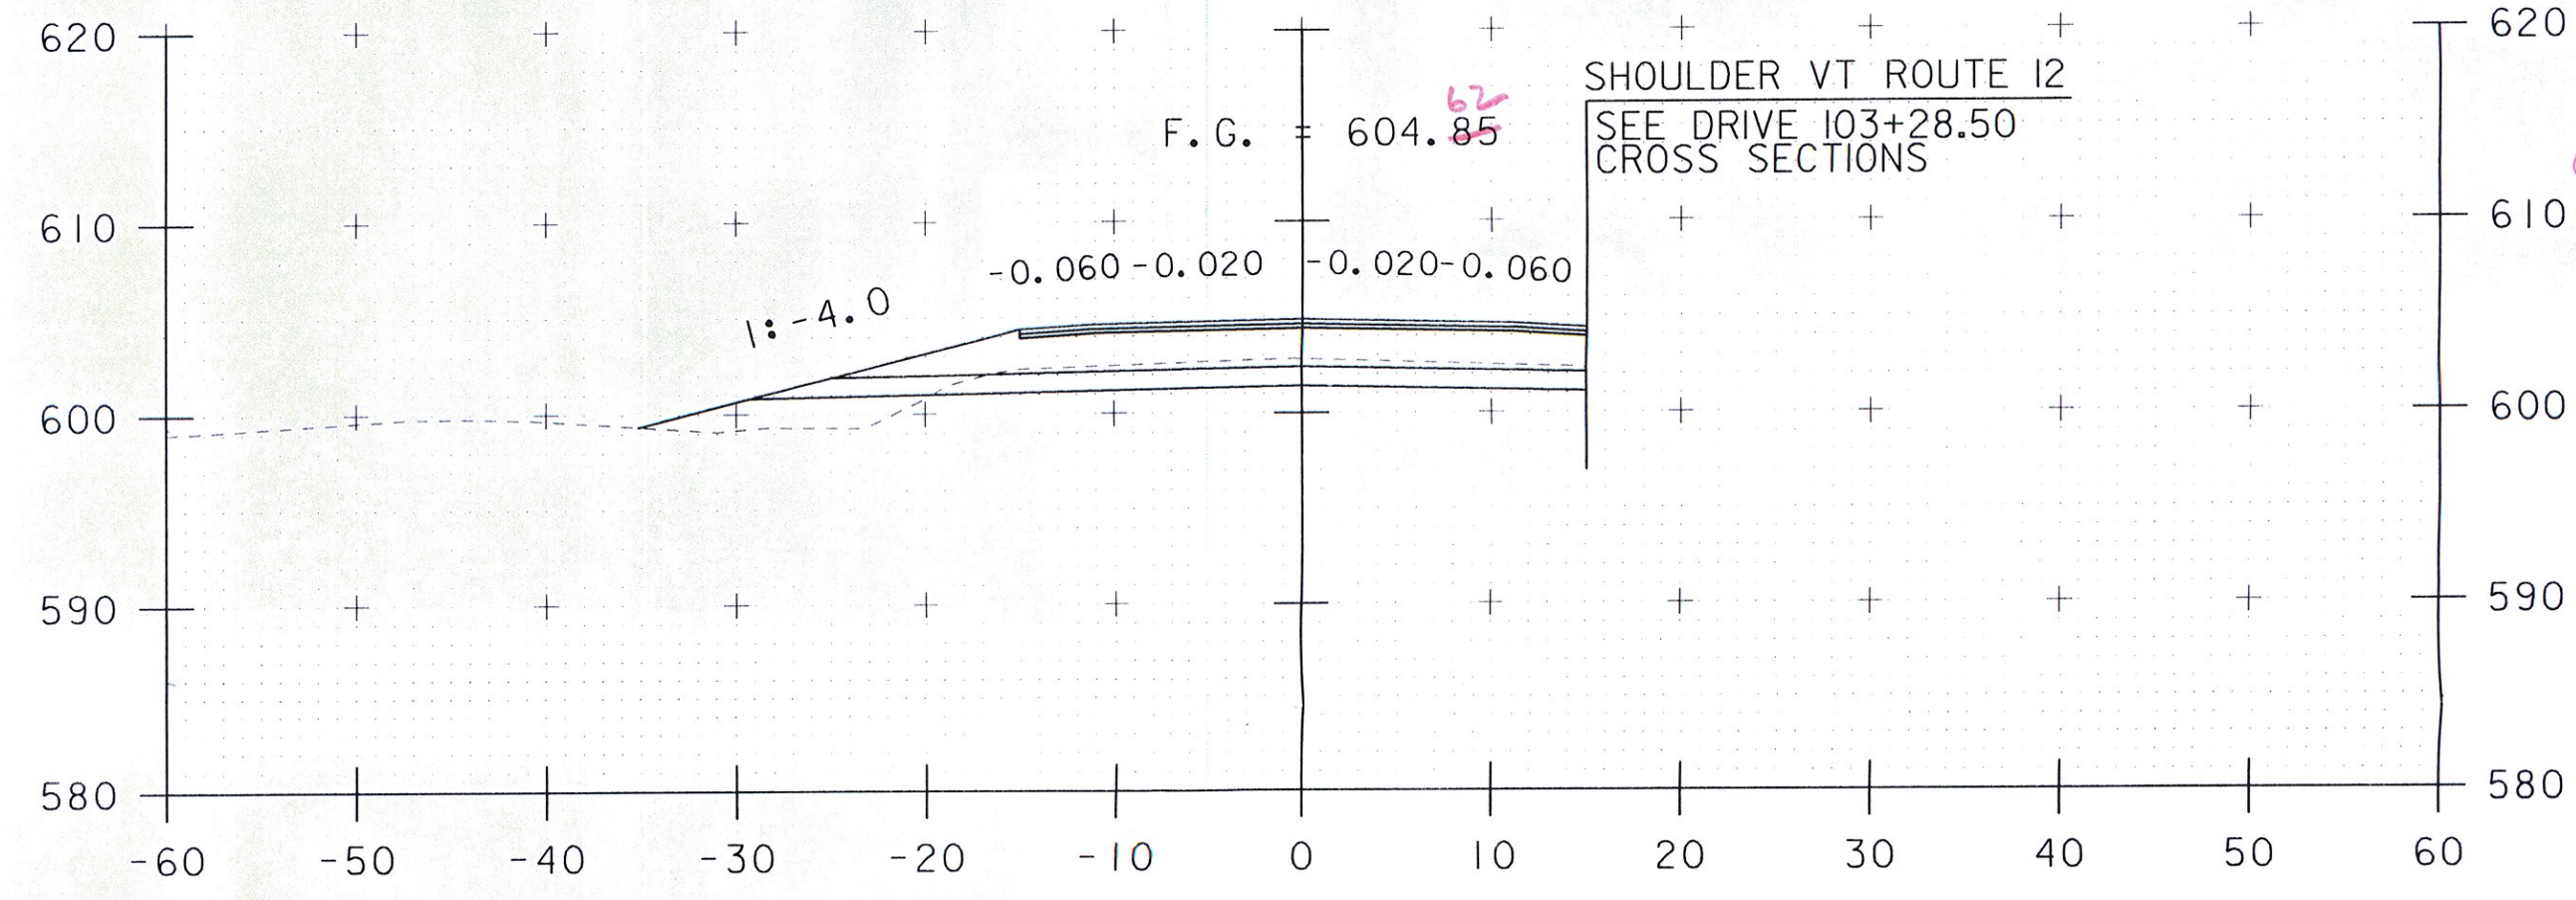

103+28

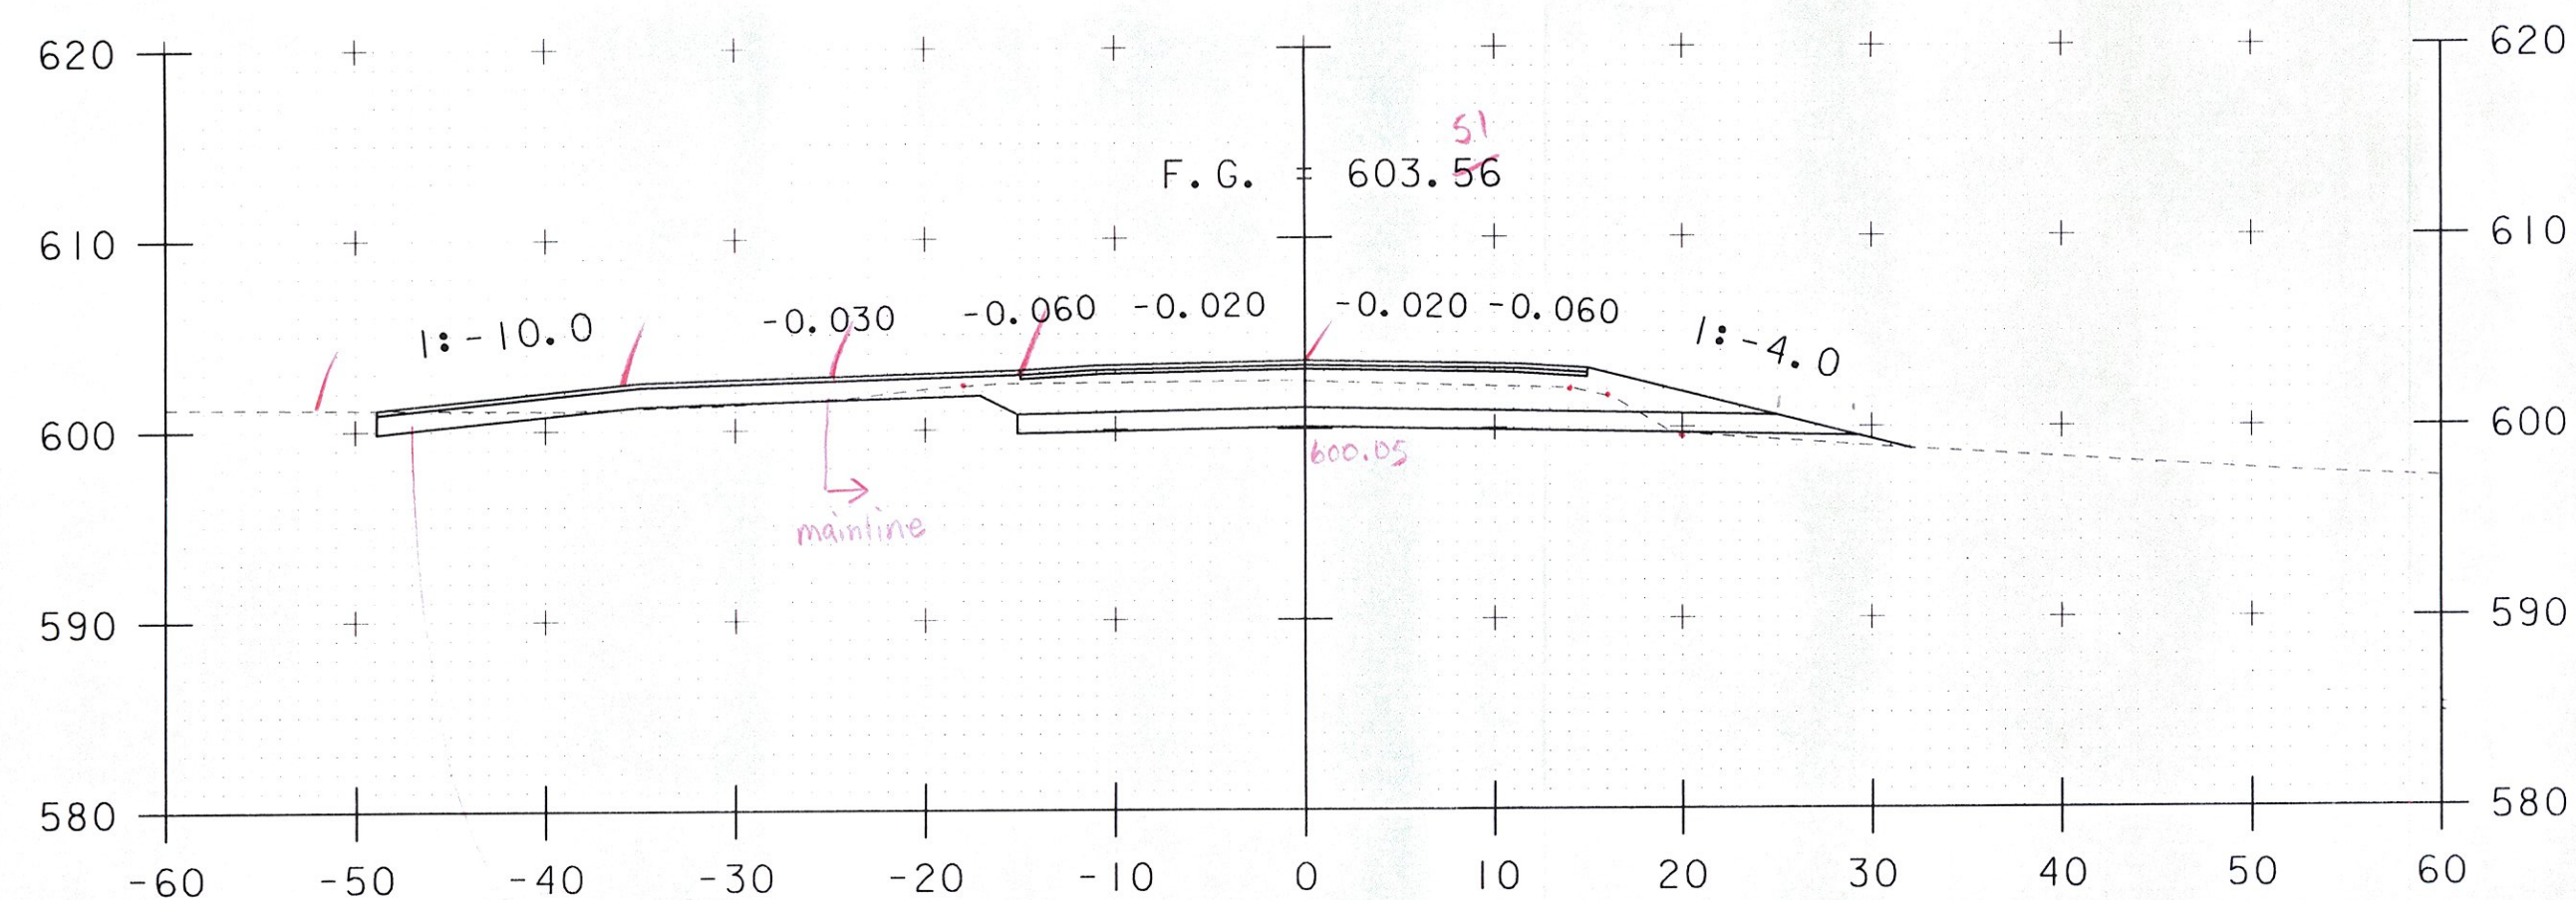

101+63  
DRIVE LEFT

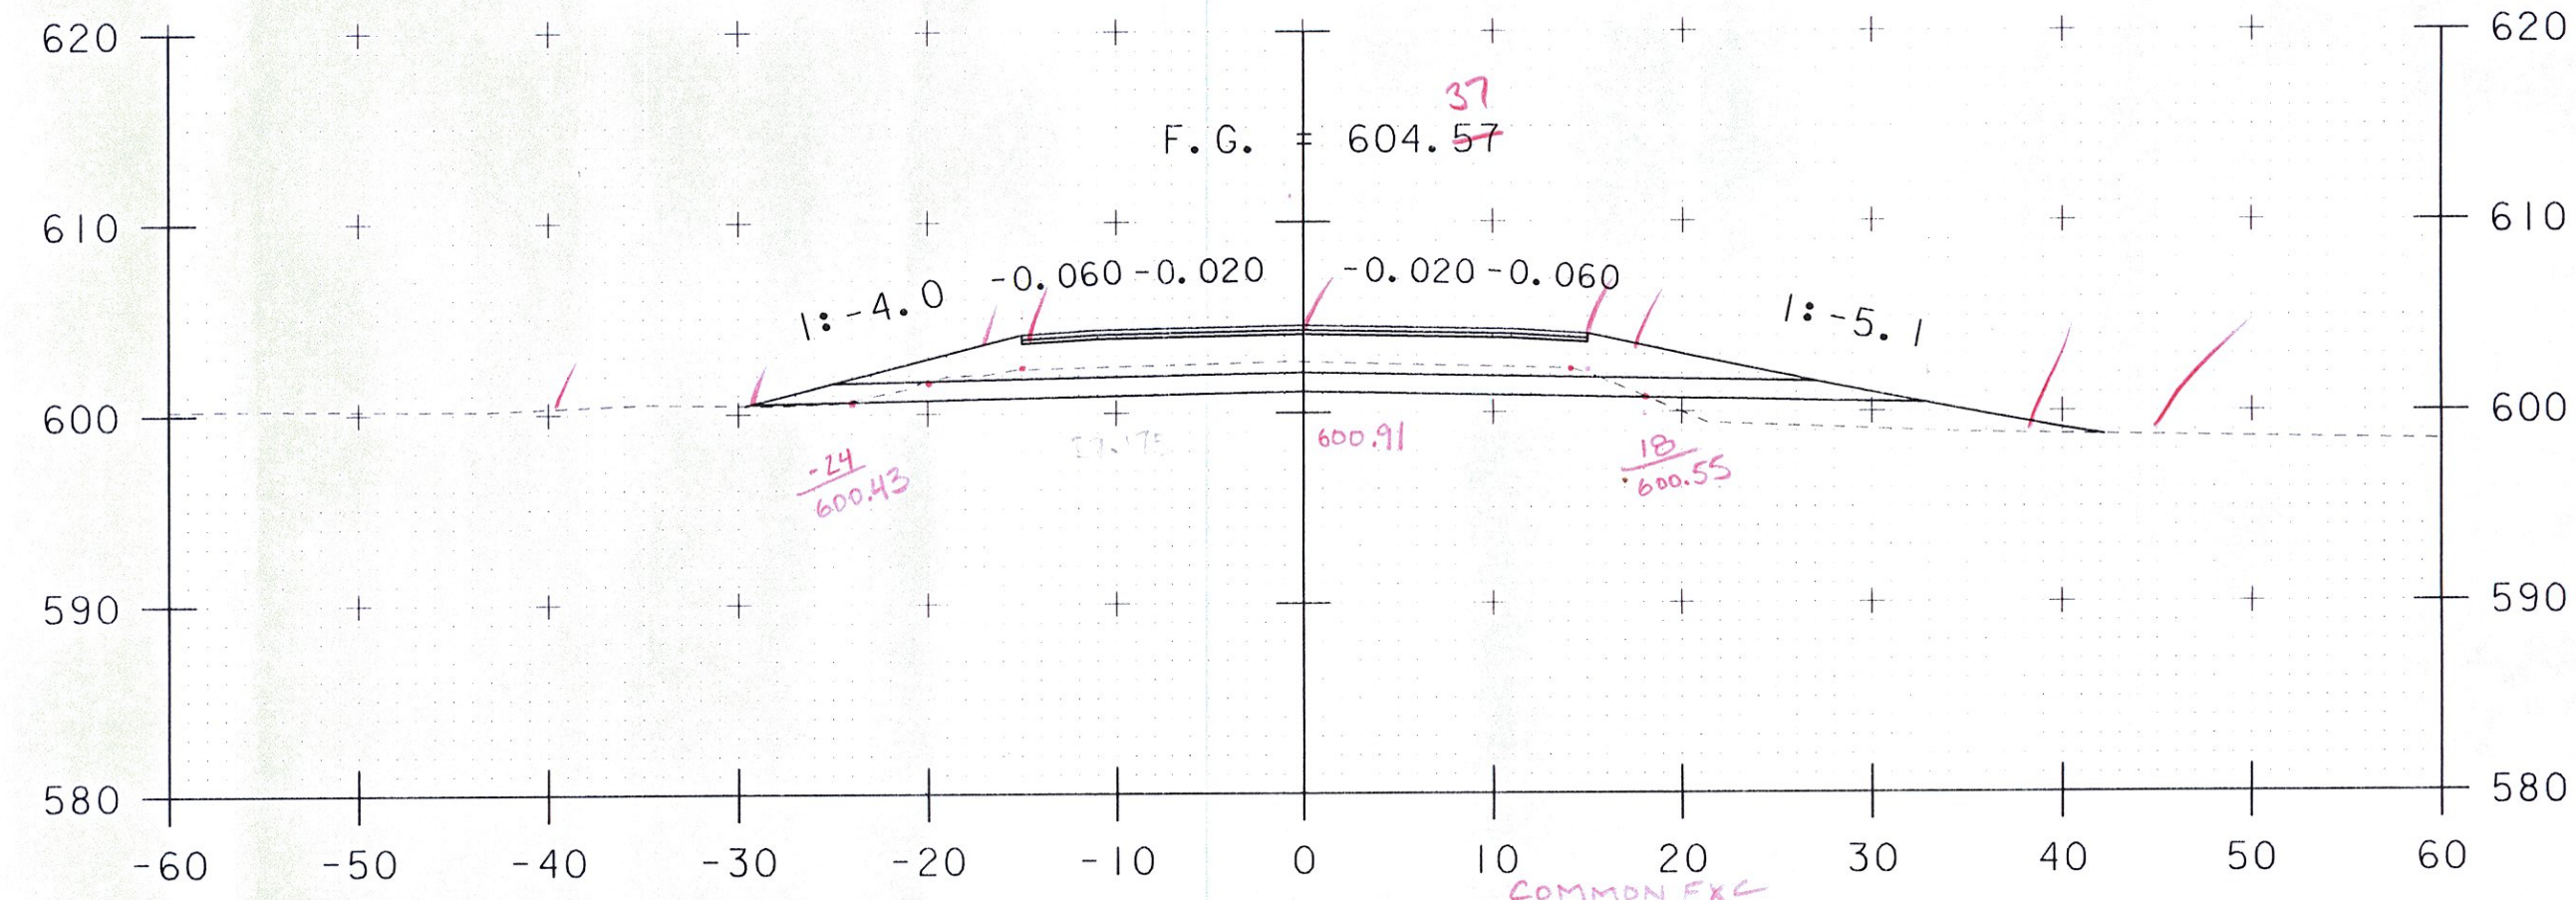

103+00

Common Exc  
9' x 12' wide  
27'  
pay 2.00'  
12/17/12

Common Exc  
@ Drive  
pay  
9' x 12' wide  
27'  
12/17/12

1-24-13

PROJECT NAME:	BETHEL	PLOT DATE:	31-AUG-2011
PROJECT NUMBER:	BHF 0241(30)	DRAWN BY:	U. STANLEY
FILE NAME:	sc002xs.dgn	CHECKED BY:	G. ROKES
PROJECT LEADER:	M. EVANS-MONGEON	SHEET	57 OF 64
DESIGNED BY:	U. STANLEY		
MAINLINE SECTIONS SHEET 2			