


109+50
END APPROACH

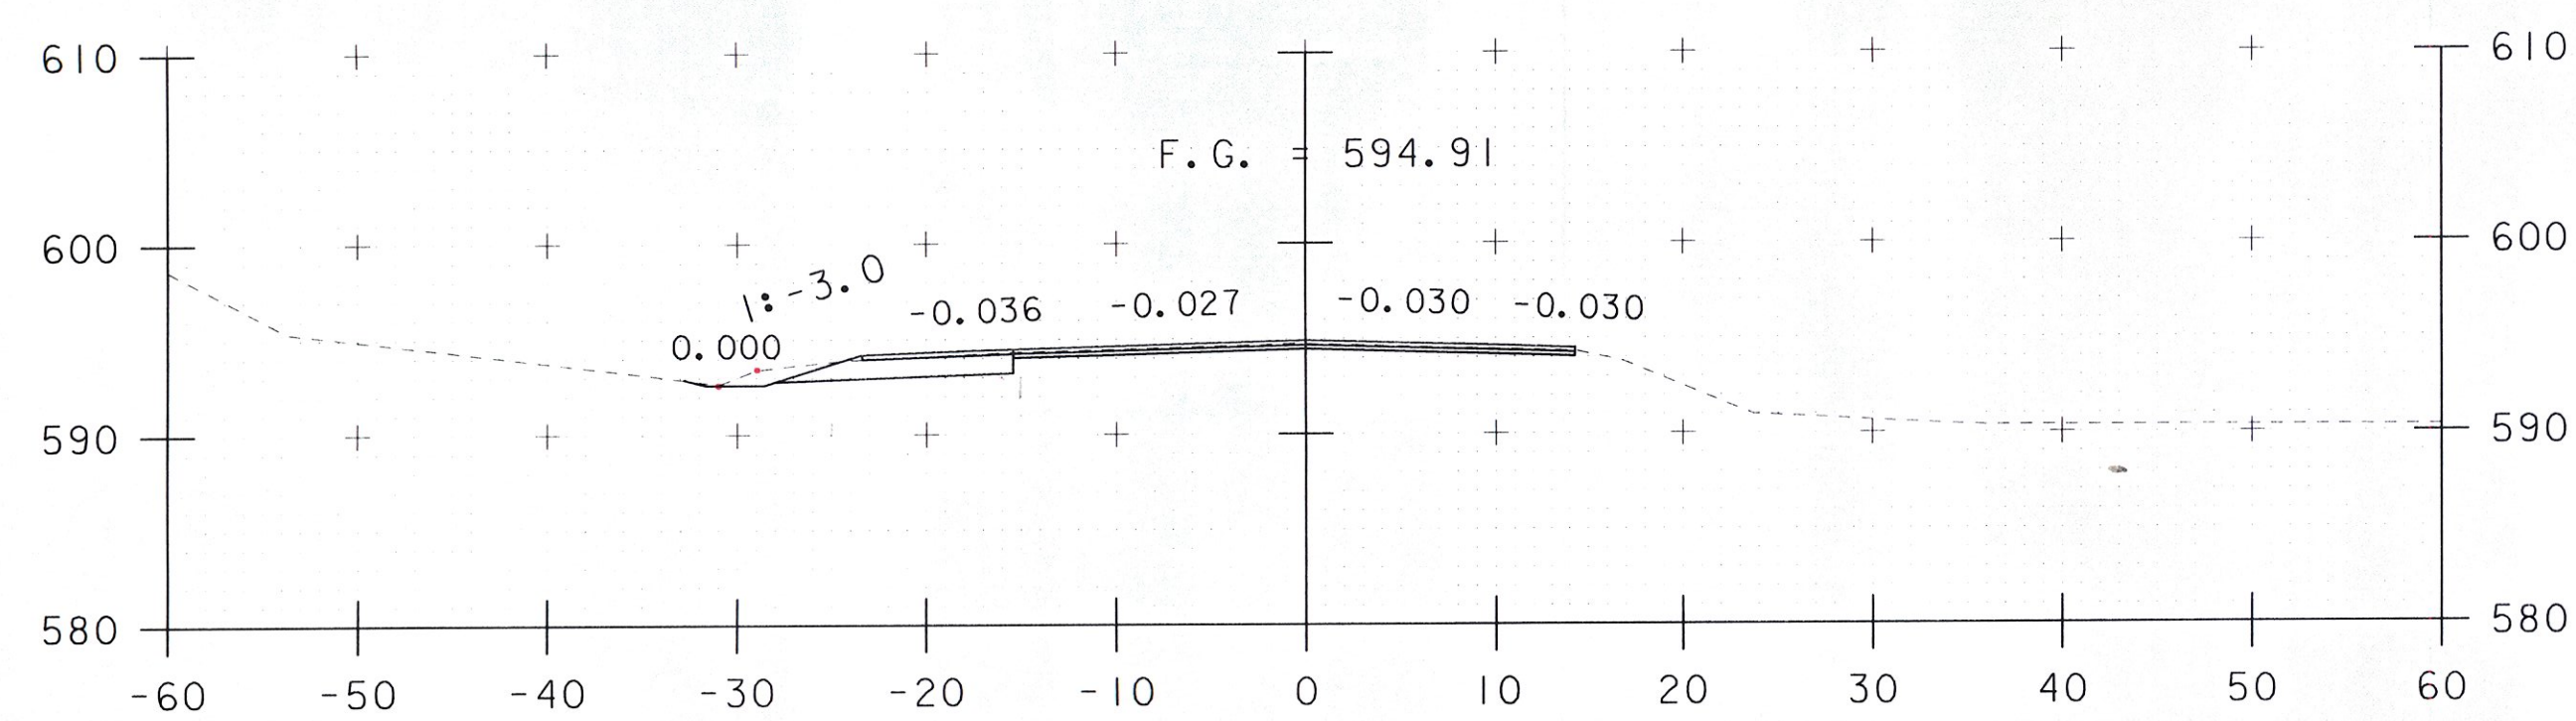

109+00

109+00 Begin Cold Plane
see sheet 55

Common EXC
0.3 x 30' 15.5 ft to far right (9#)
13# + 9# = 22# BUTT

- 15.5 / 592.2
- 31 / 592.5
- 29 / 593.4
- 15.5 / 594.2
- 15.5 / 598.2

PKP
1-24-13

PROJECT NAME:	BETHEL
PROJECT NUMBER:	BHF 0241(30)
FILE NAME: sc002xs.dgn	PLOT DATE: 31-AUG-2011
PROJECT LEADER: M. EVANS-MONGEON	DRAWN BY: U. STANLEY
DESIGNED BY: U. STANLEY	CHECKED BY: G. ROKES
MAINLINE SECTIONS SHEET 6	SHEET 61 OF 64