




401+00

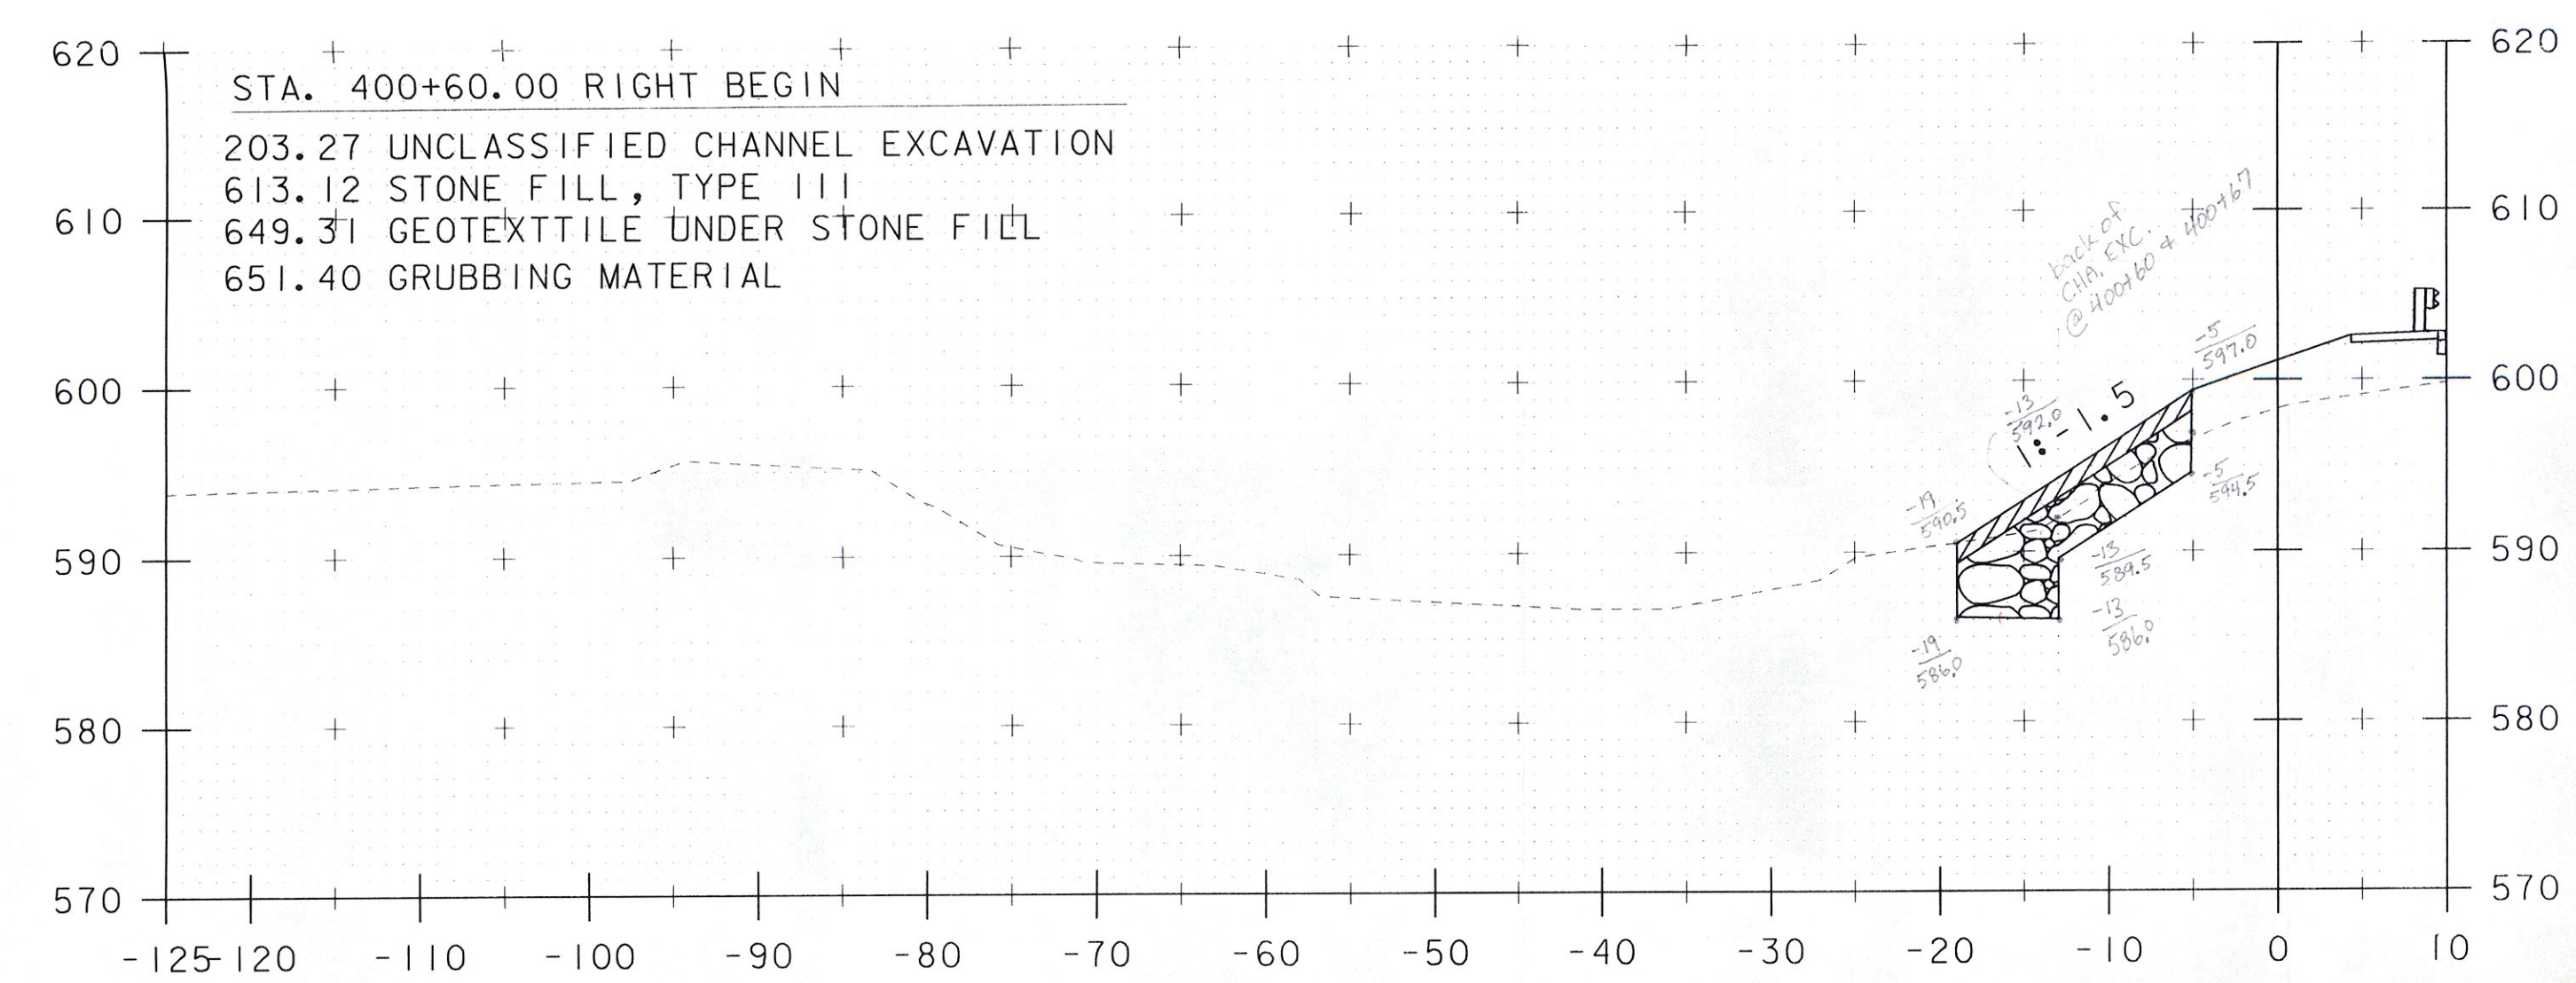

400+75

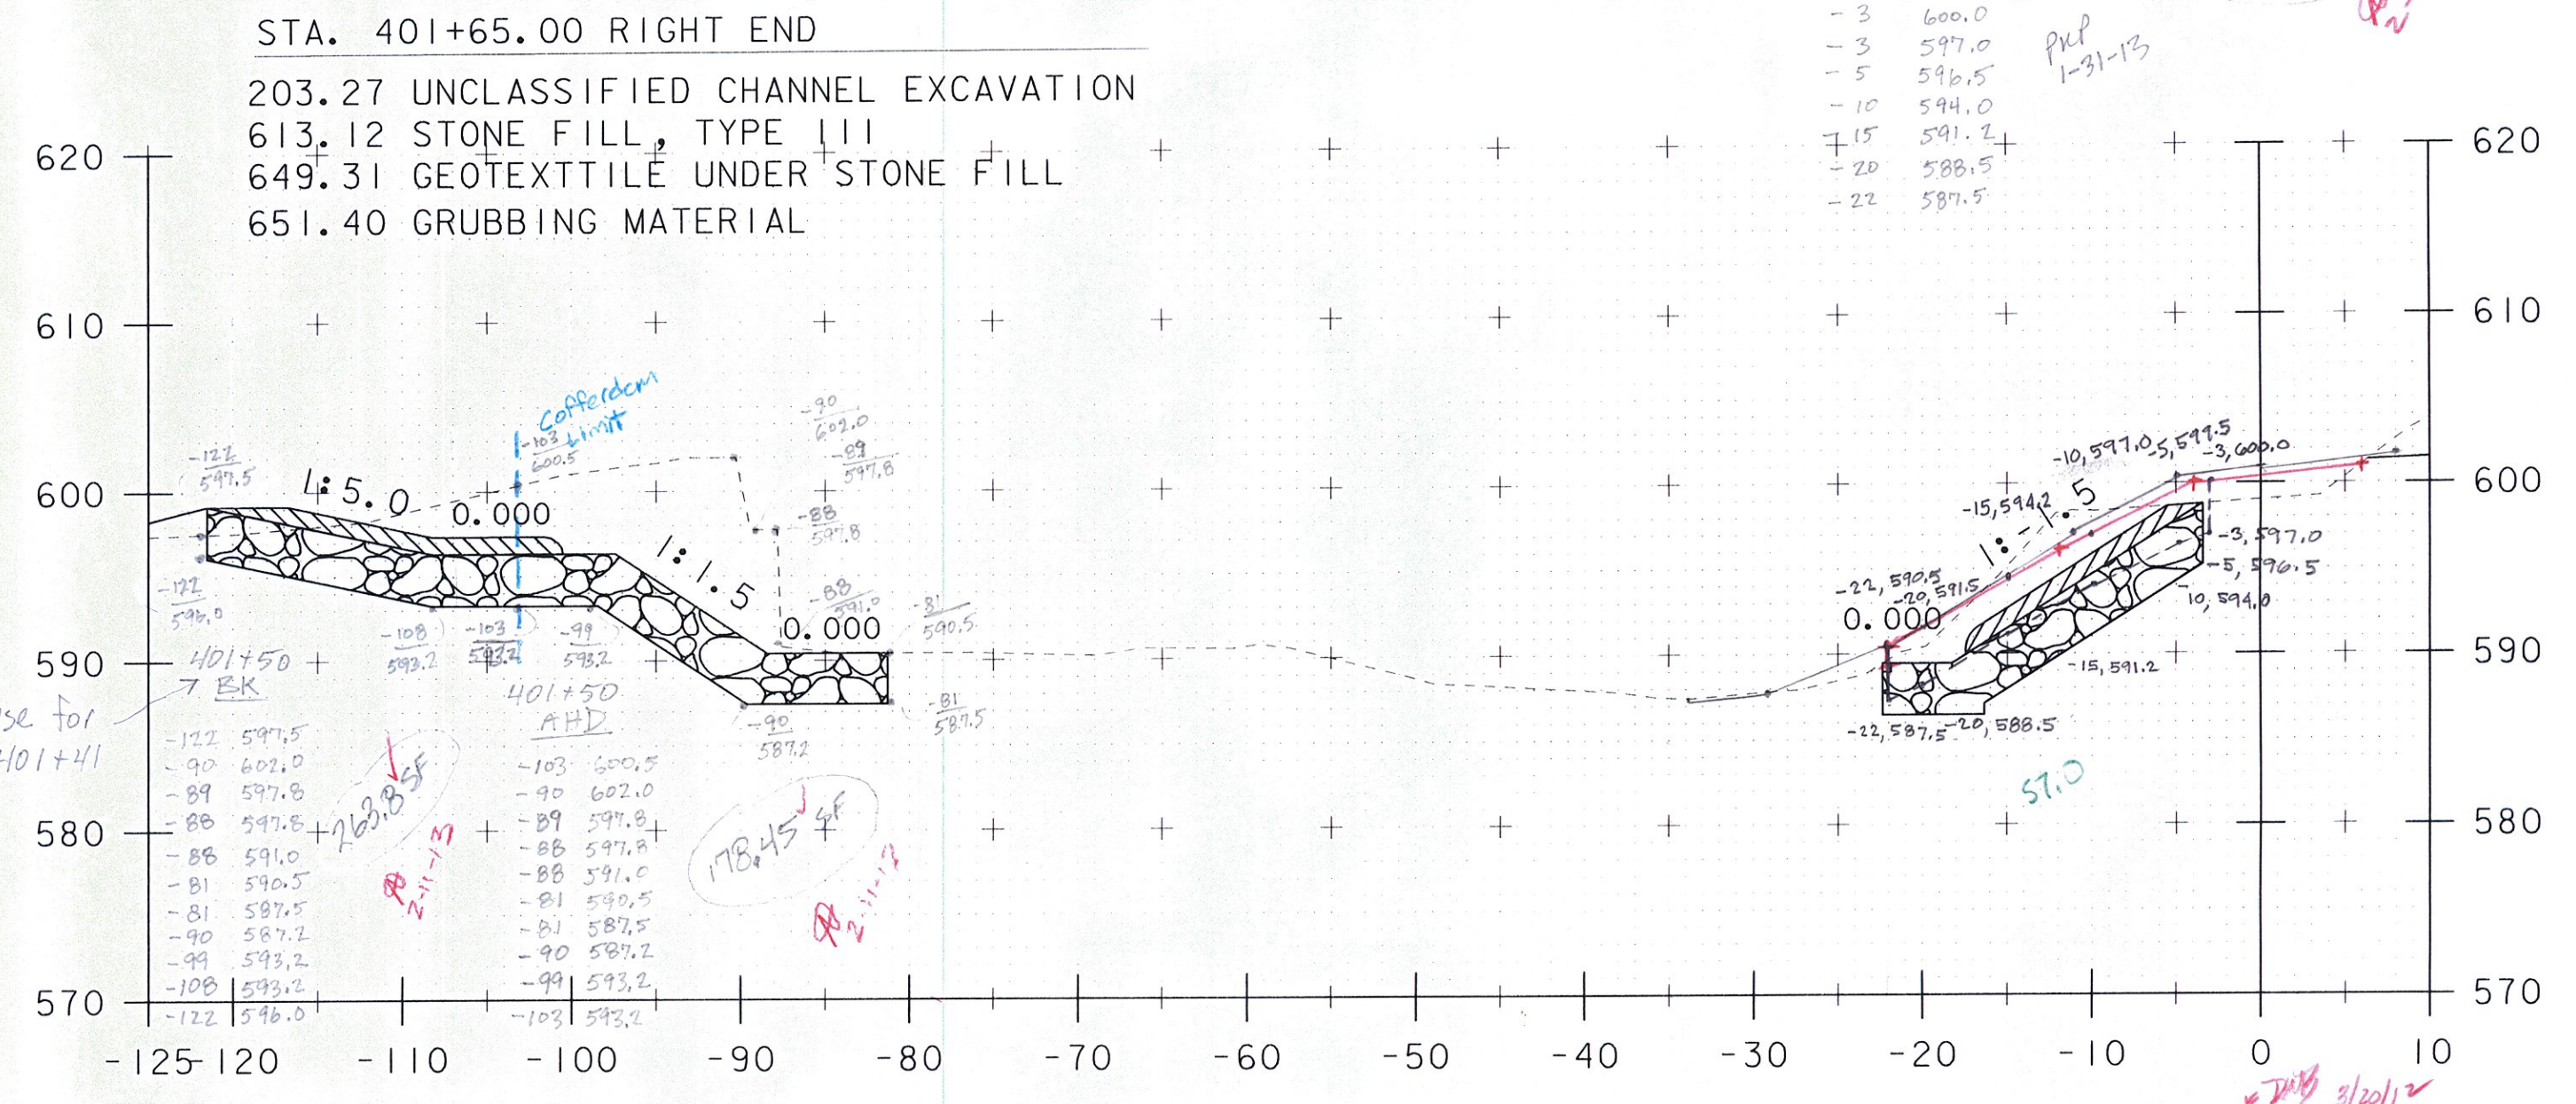

401+50

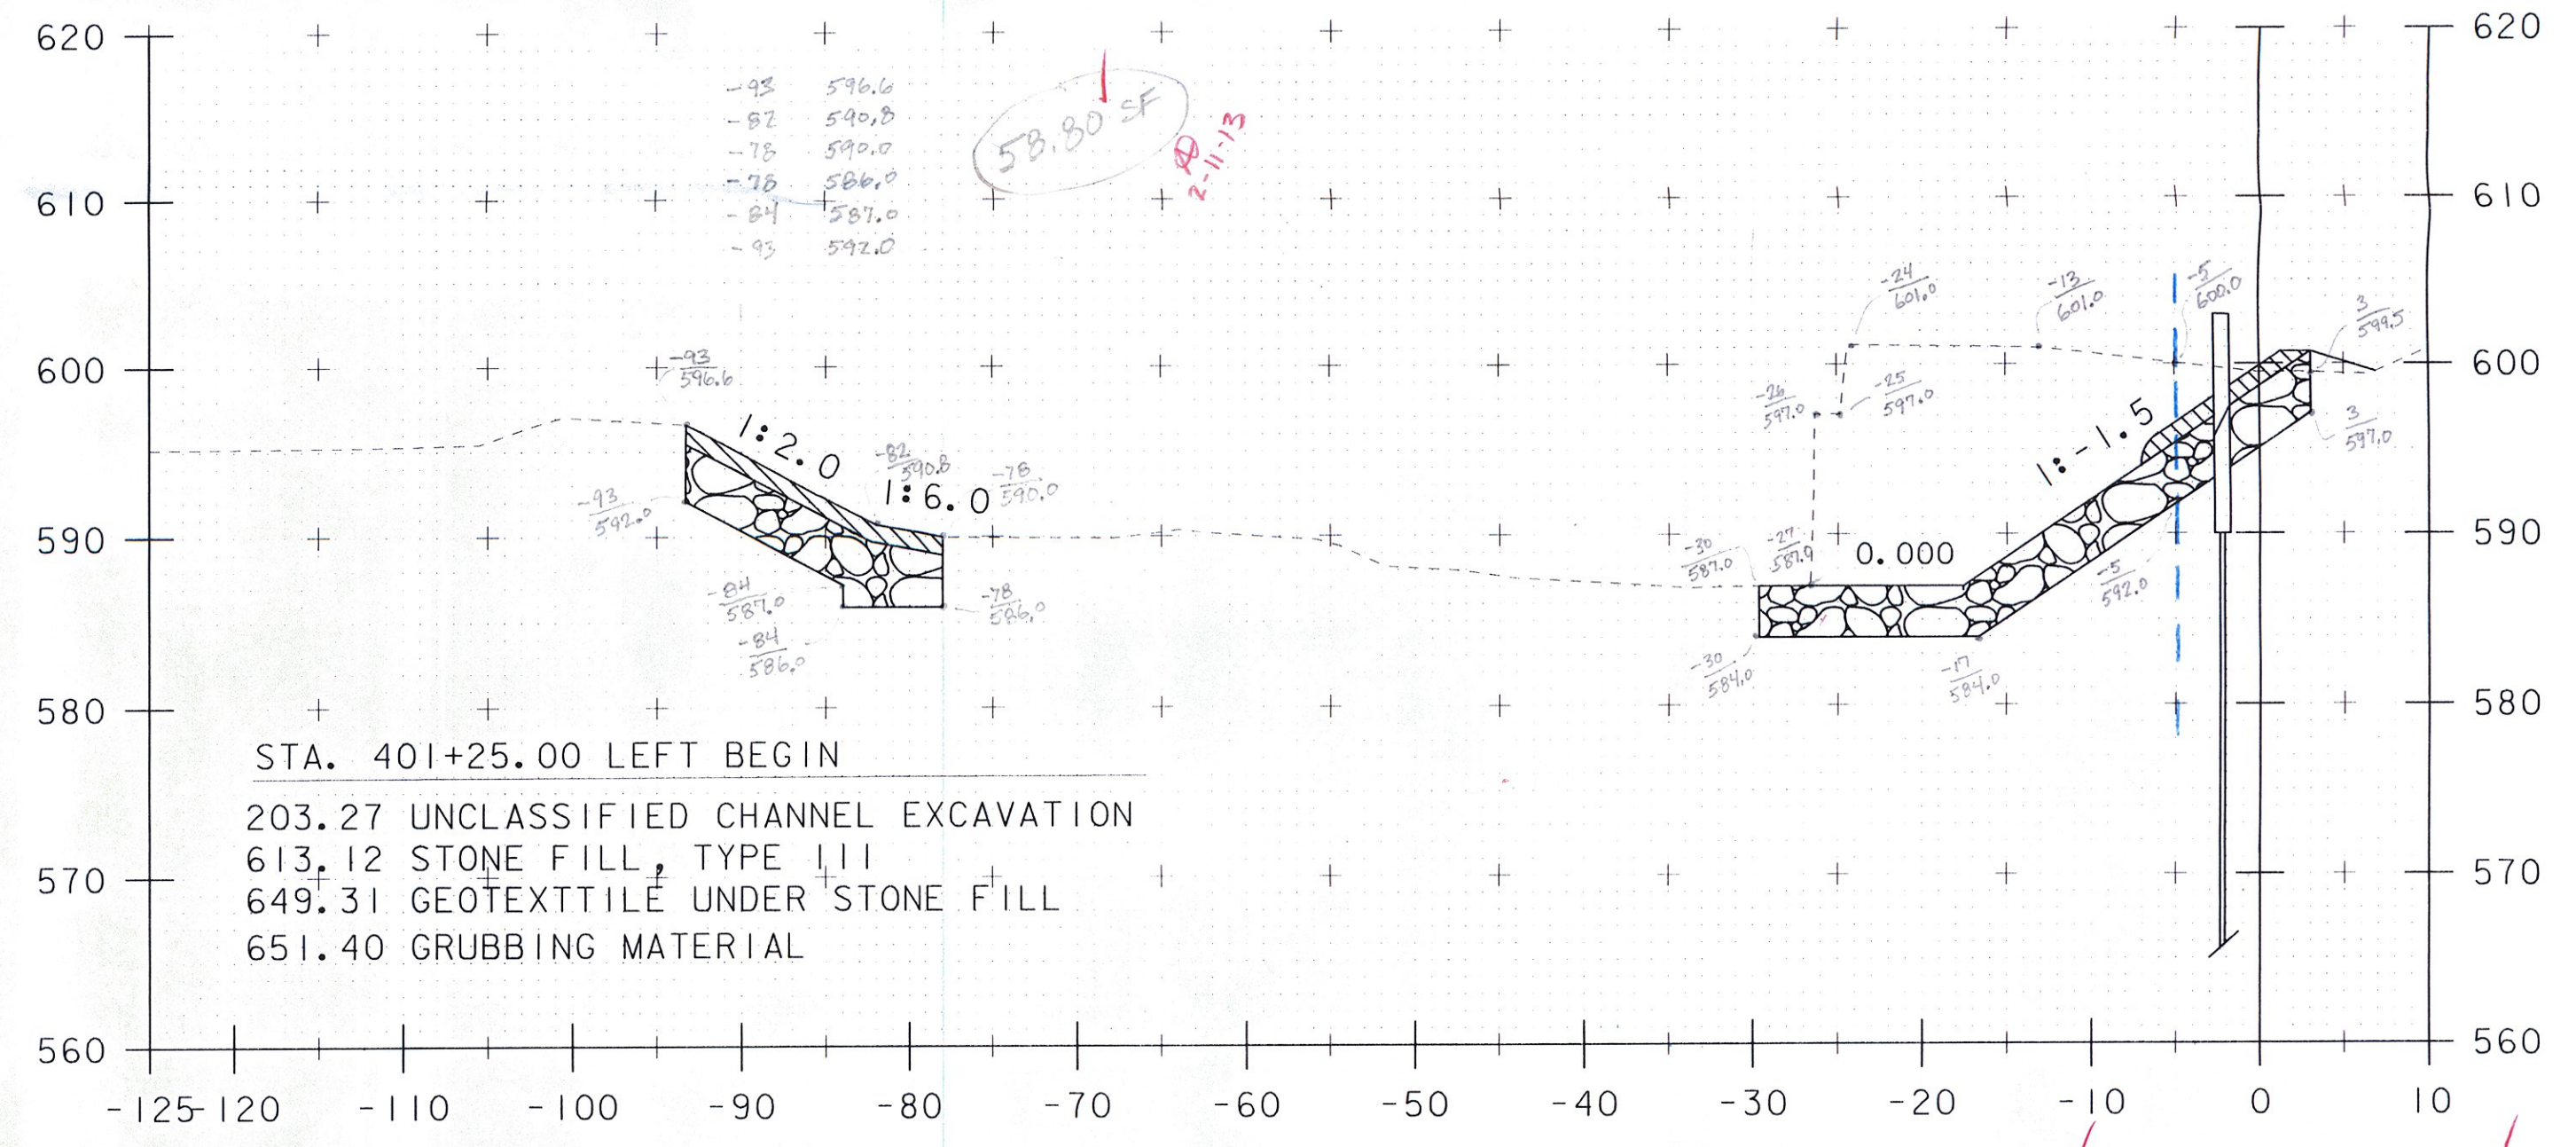

401+25

400+75	400+77
19	590.5
20	590.5
21	590.5
PROJECT NAME: BETHEL
 PROJECT NUMBER: BHF 0241(30)
 FILE NAME: sc002xs.dgn
 PROJECT LEADER: M. EVANS-MONGEON
 DESIGNED BY: U. STANLEY
 CHANNEL SECTIONS SHEET 1

PLOT DATE: 31-AUG-2011
 DRAWN BY: U. STANLEY
 CHECKED BY: G. ROKES
 SHEET 63 OF 64