




402+00

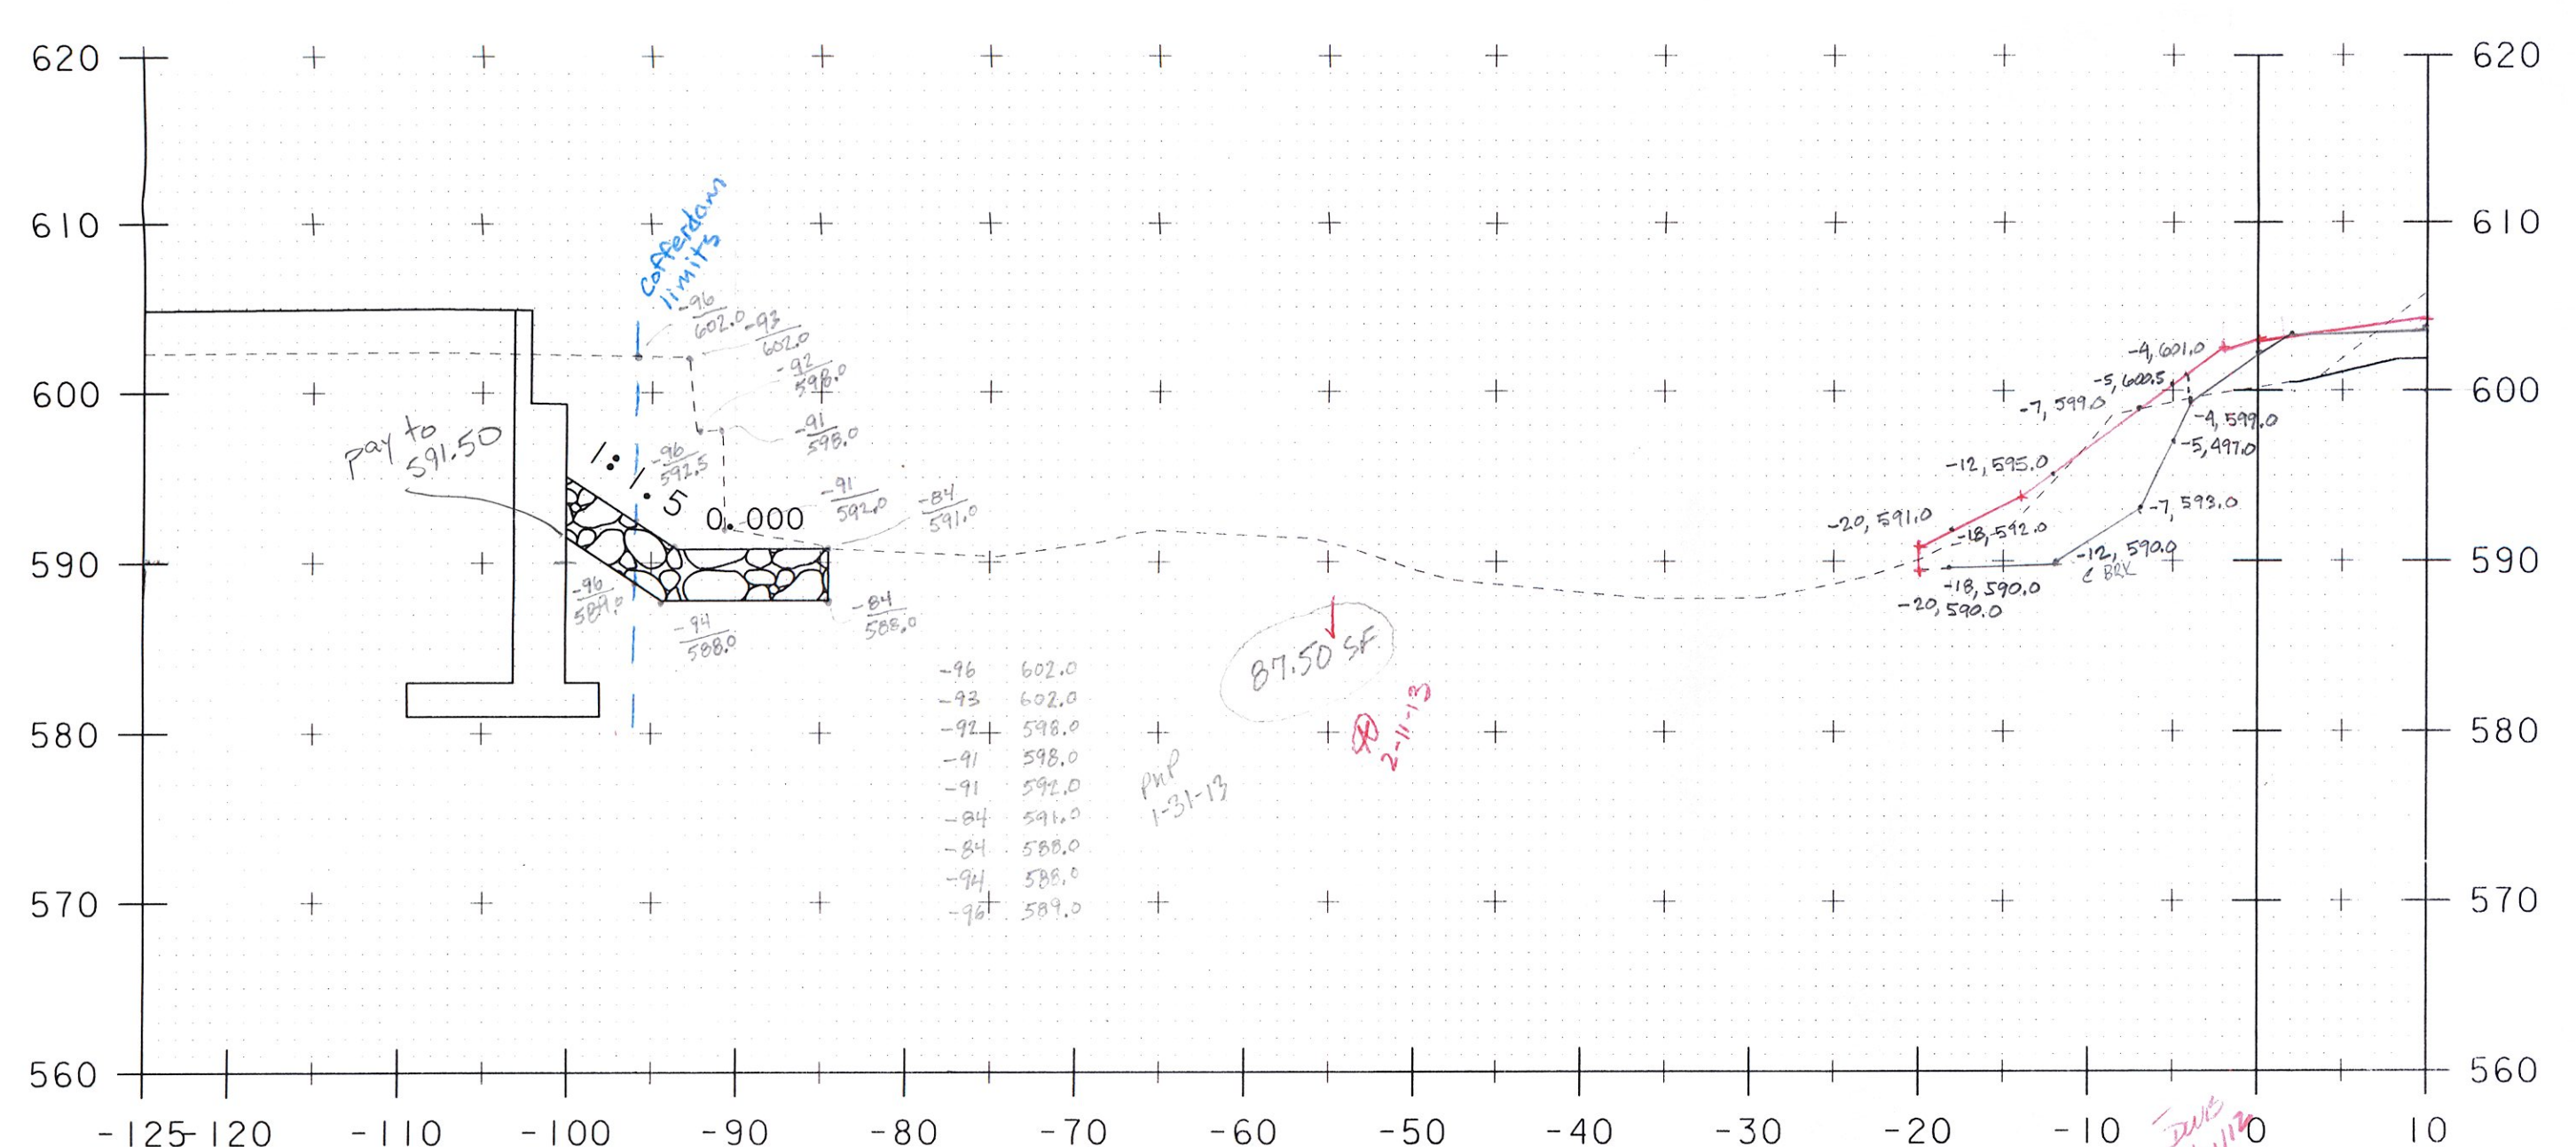

401+75

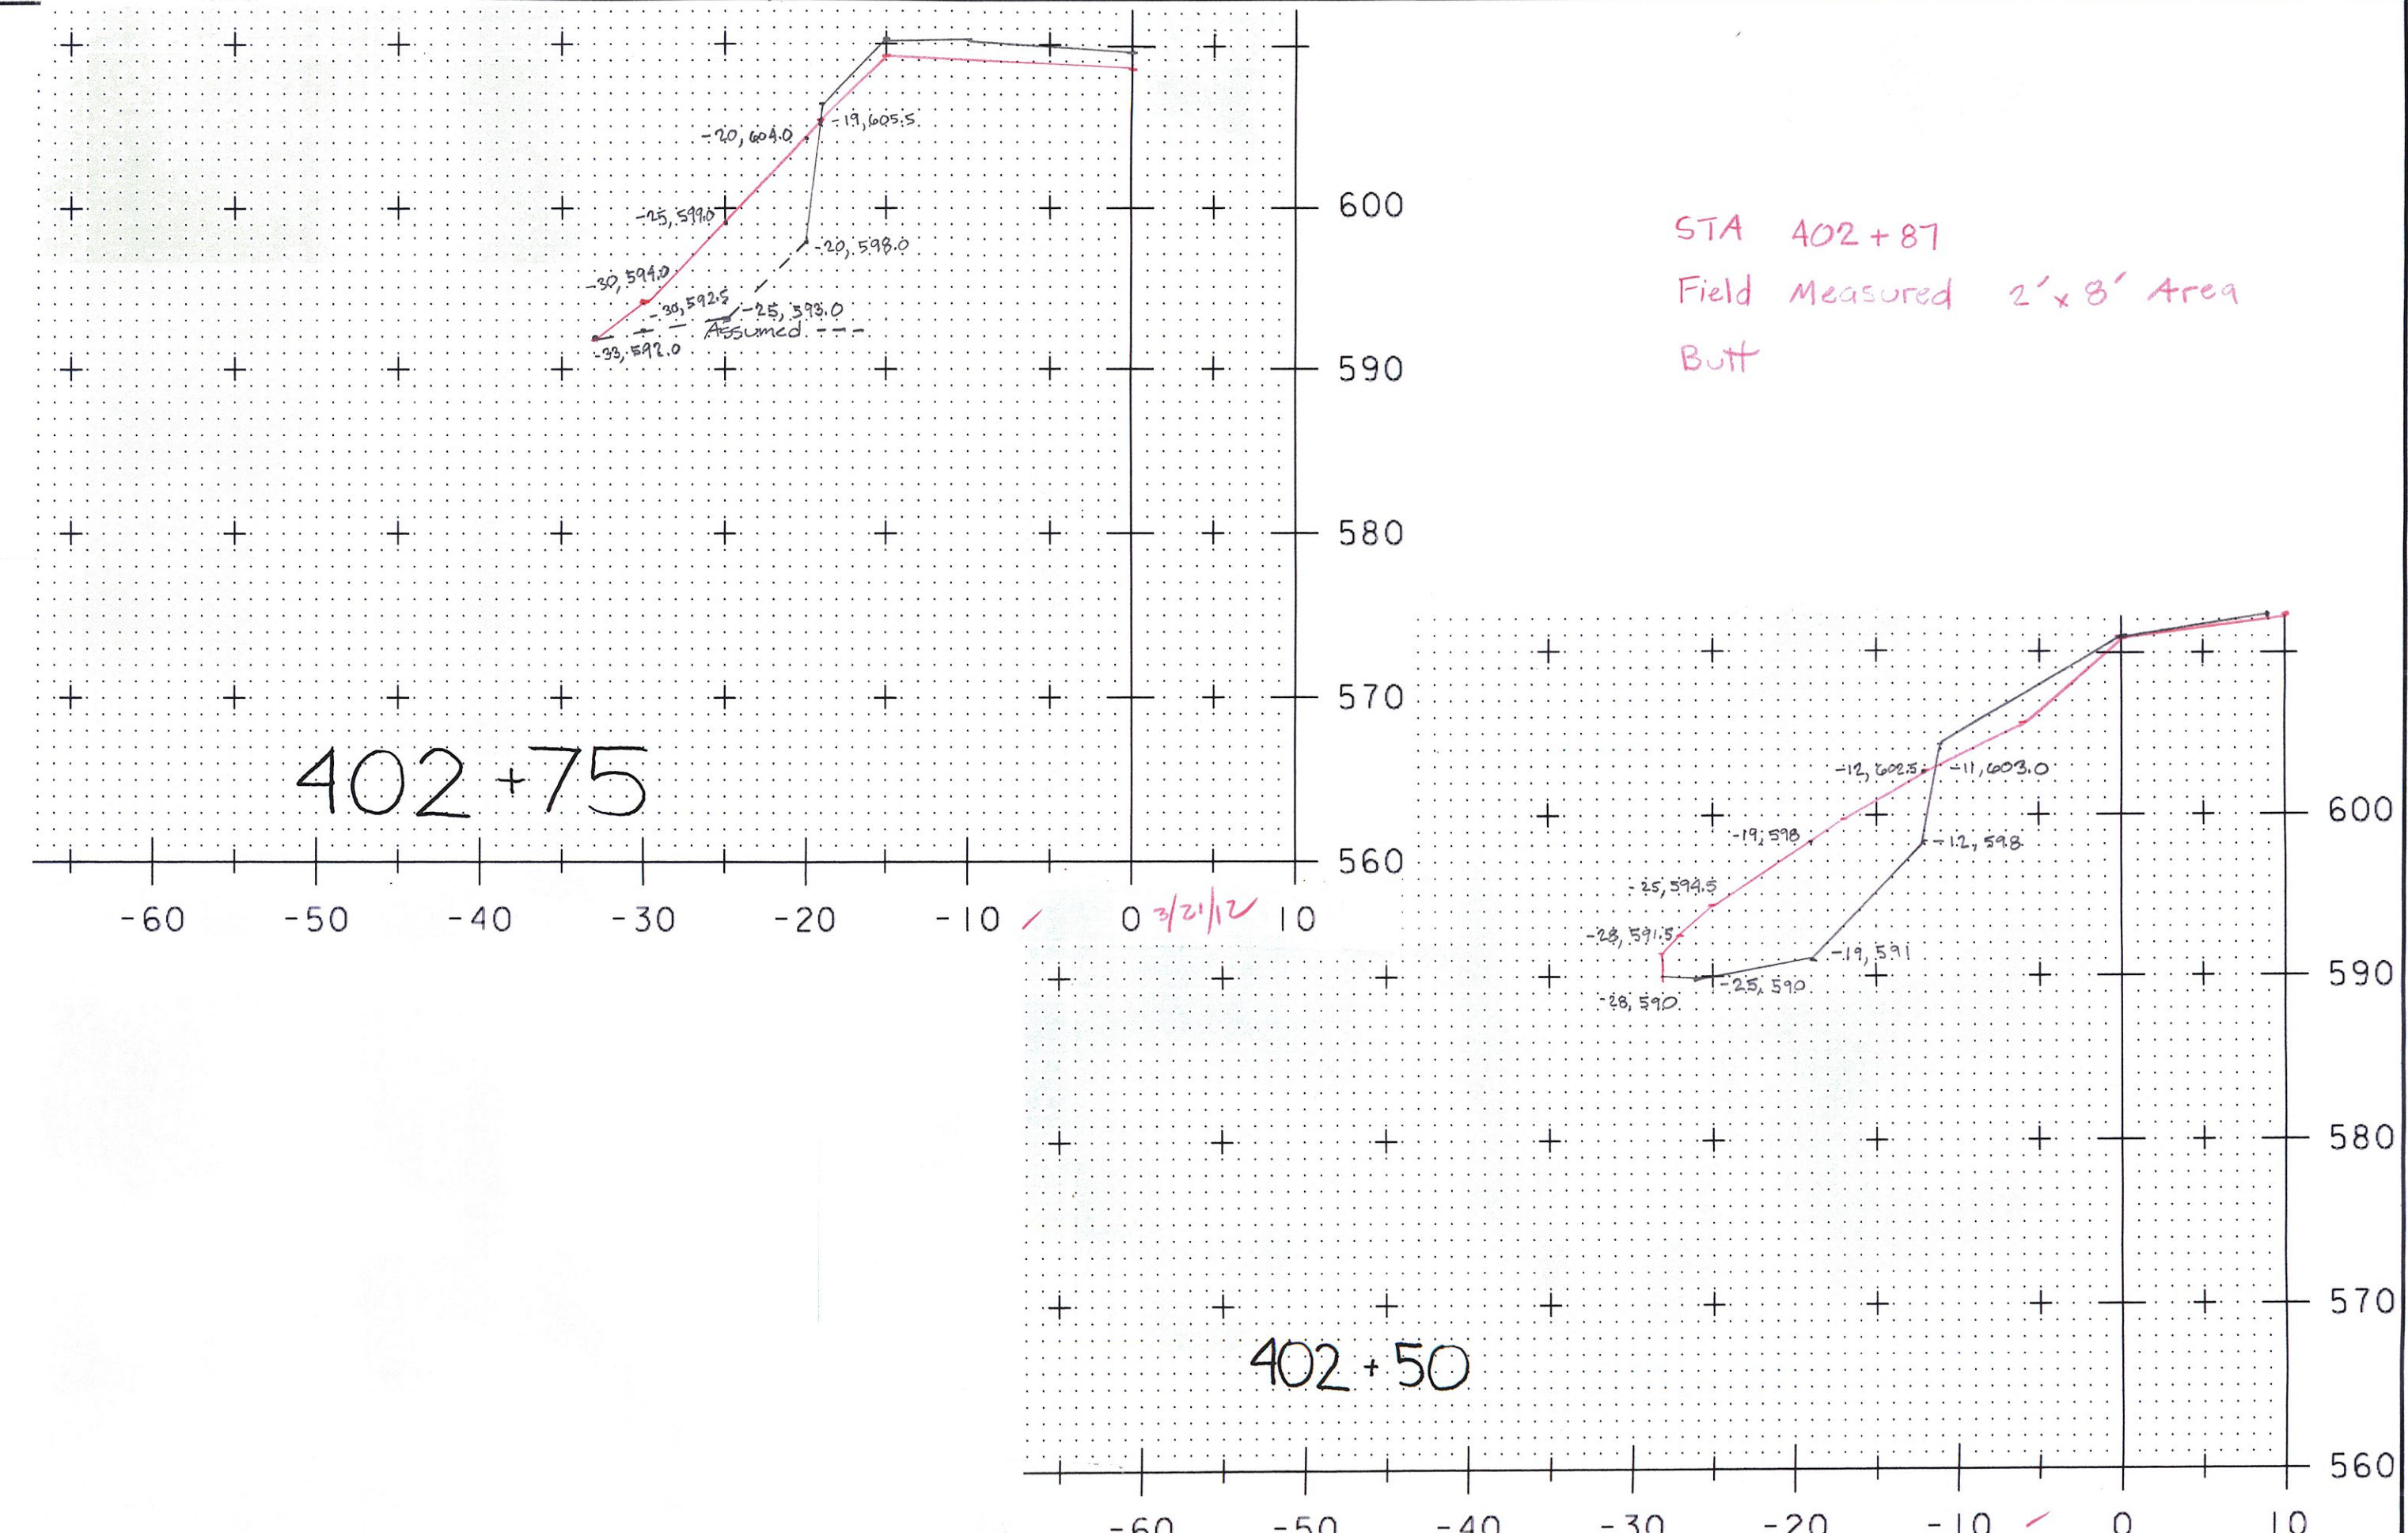

402+50

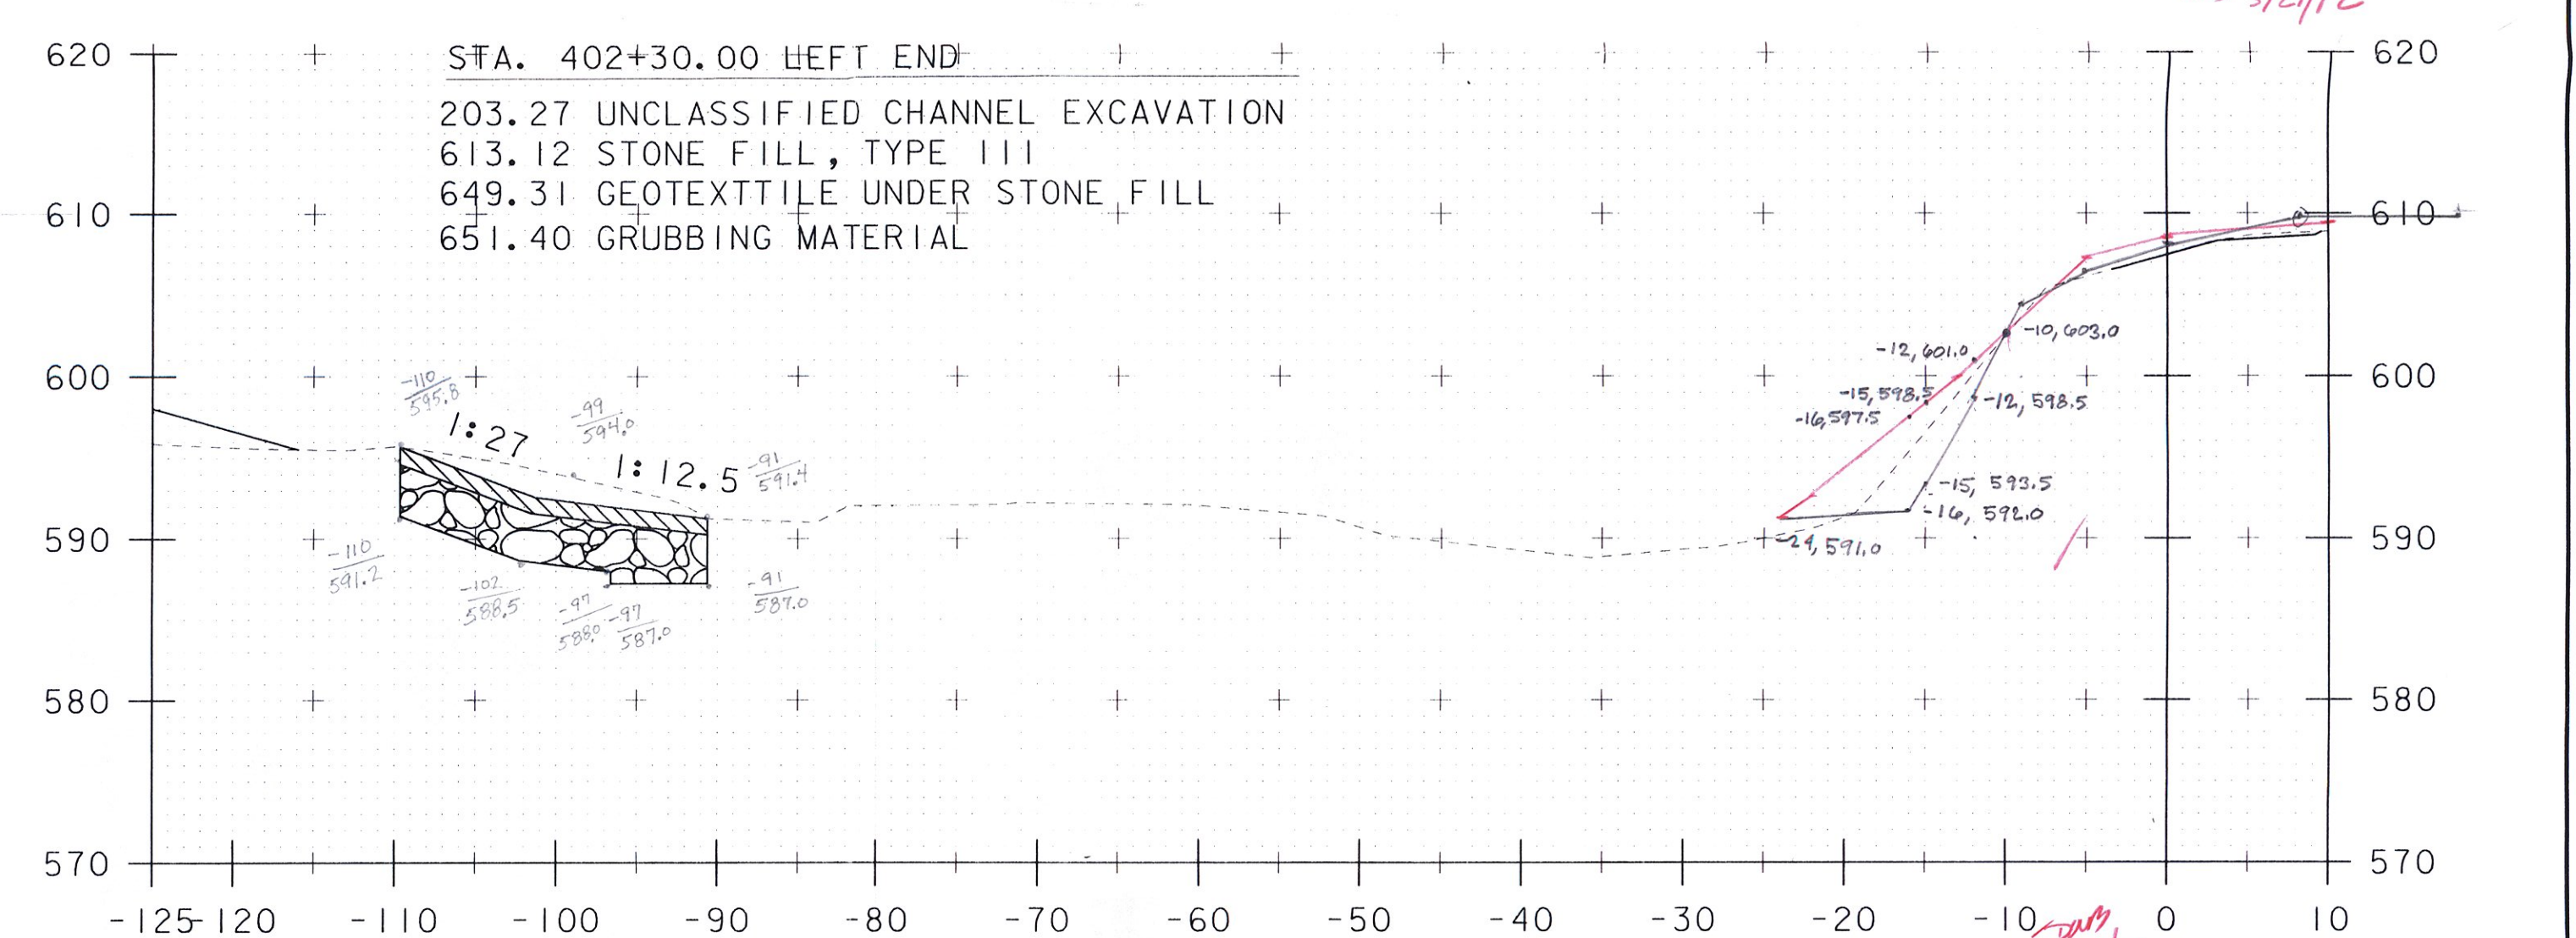

402+25

use for 402+17 & 402+29
PKP 1-31-13
103.15
2-11-17

PROJECT NAME:	BETHEL	FILE NAME:	sc002xs.dgn	PLOT DATE:	31-AUG-2011
PROJECT NUMBER:	BHF 0241(30)	PROJECT LEADER:	M. EVANS-MONGEON	DRAWN BY:	U. STANLEY
		DESIGNED BY:	U. STANLEY	CHECKED BY:	G. ROKES
		CHANNEL SECTIONS SHEET 2		SHEET	64 OF 64