




**VT ROUTE 12
STA 4+940
BEGIN PROJECT STP 9602(1)S**

TEMPORARY AND DURABLE 100 mm YELLOW LINE
 STA 4+940 TO 5+731 SOLID LT & RT
 STA 5+731 TO 5+919 DASHED LT, SOLID RT
 STA 5+919 TO 6+000 SOLID LT & RT
 (WITH CENTER LINE BREAKS FOR TOWN HIGHWAYS)

TEMPORARY AND DURABLE 100 mm WHITE LINE
 STA 4+940 TO 6+000 SOLID LT & RT
 (WITH EDGELINE BREAKS FOR TOWN HIGHWAYS)

REMOVING SIGNS
 AS NOTED 2



REHABILITATION OF DL, CB OR MH, CLASS I
 REHABILITATION OF DL, CB OR MH, CLASS II
 REHABILITATION OF DL, CB OR MH, CLASS III
 STA 4+952 LT - GRATE TYPE D

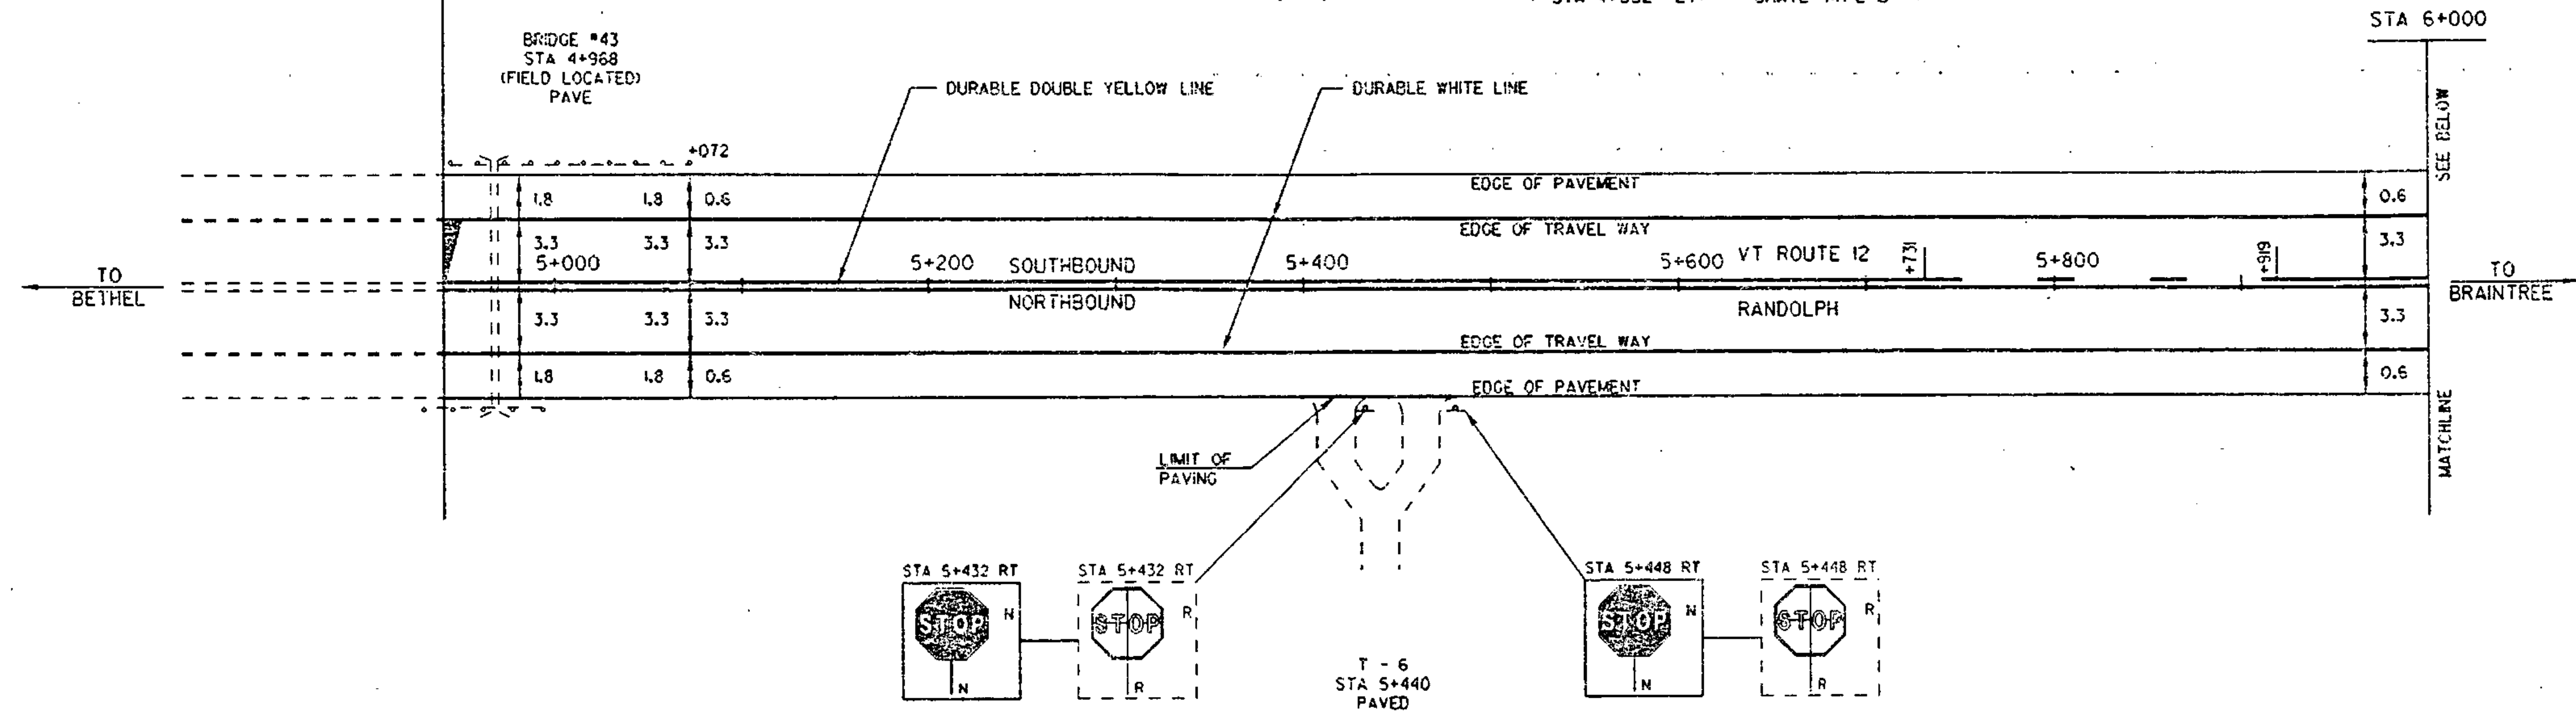

TEMPORARY AND DURABLE 100 mm YELLOW LINE
 STA 6+000 TO 7+021 SOLID LT & RT
 STA 7+021 TO 7+200 SOLID LT, DASHED RT
 (WITH CENTER LINE BREAKS FOR TOWN HIGHWAYS)

TEMPORARY AND DURABLE 100 mm WHITE LINE
 STA 6+00 TO 7+200 SOLID LT & RT
 (WITH EDGELINE BREAKS FOR TOWN HIGHWAYS)

REHABILITATION OF DL, CB OR MH, CLASS I
 REHABILITATION OF DL, CB OR MH, CLASS II
 REHABILITATION OF DL, CB OR MH, CLASS III
 STA 7+169 RT - GRATE TYPE A

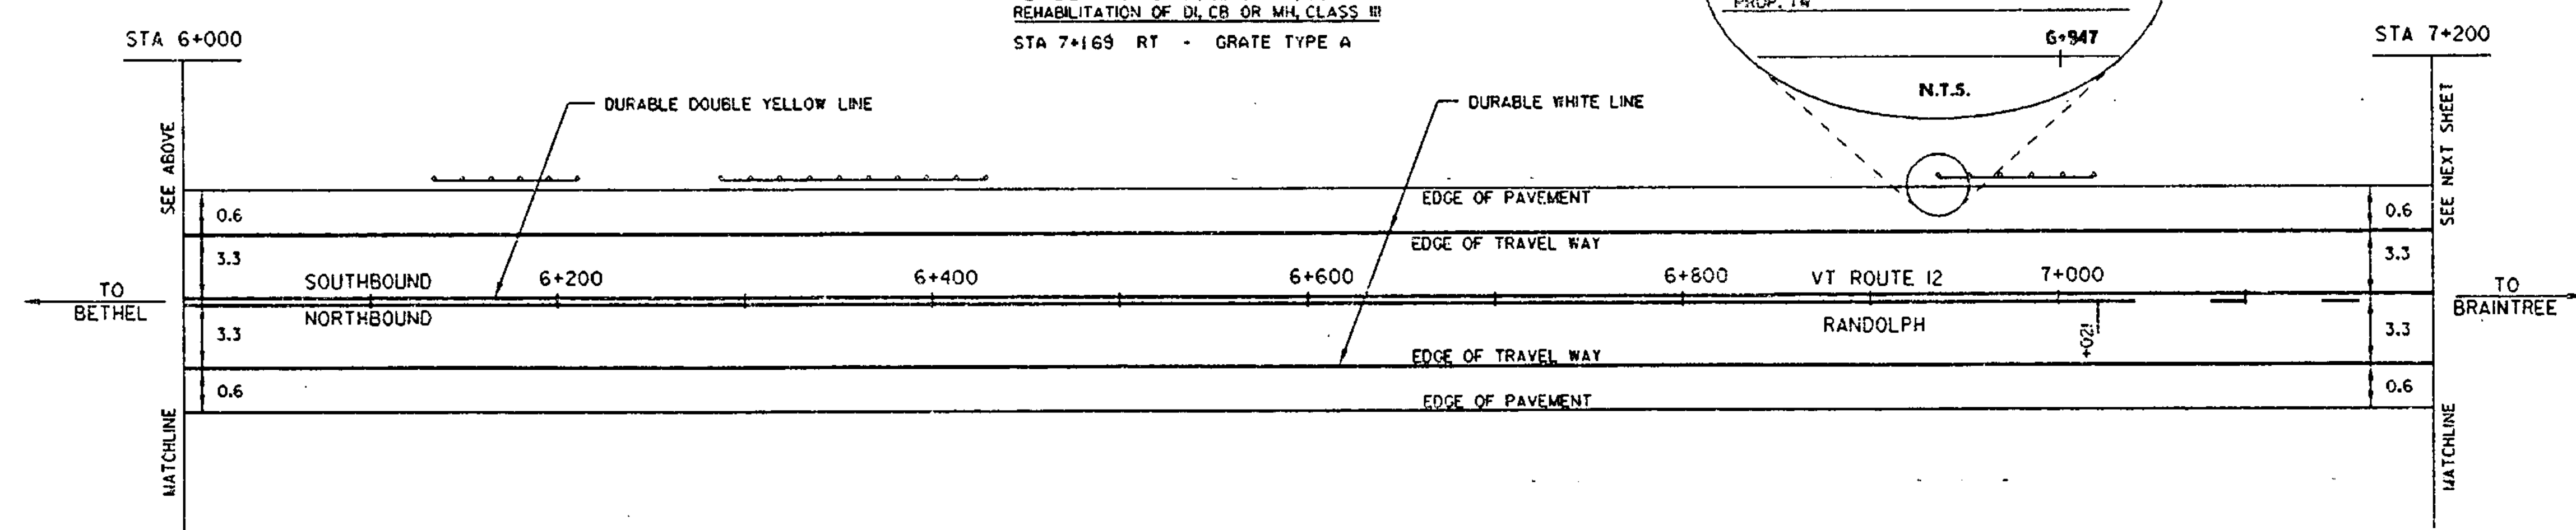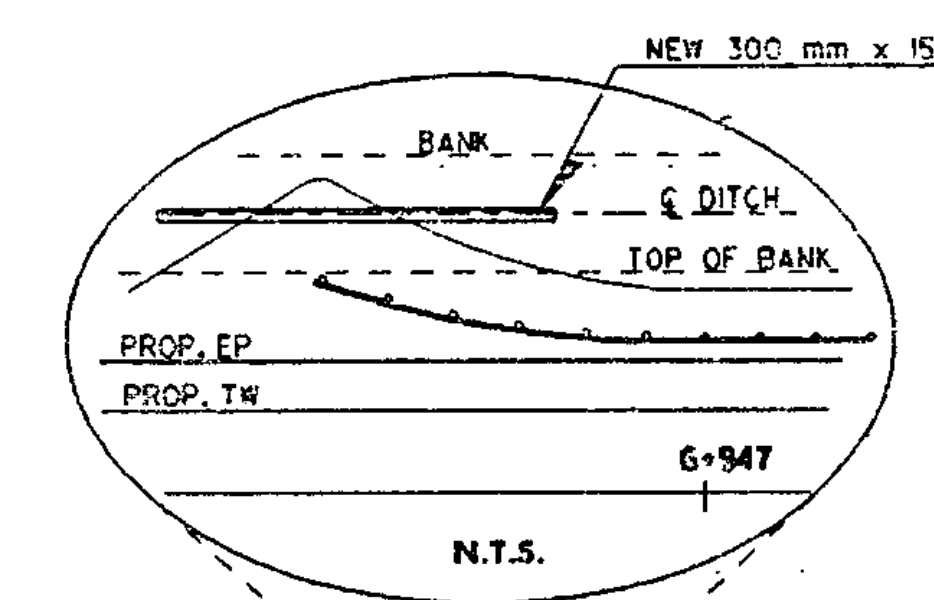

STEEL BEAM GUARDRAIL
 STA 6+146 TO 6+199 LT
 STA 6+947 TO 7+008 LT

2.5 m POST STEEL BEAM GUARDRAIL
 STA 6+299 TO 6+417 LT

MODIFIED ECCENTRIC LOADER TERMINAL
 STA 6+146 LT
 STA 6+199 LT
 STA 6+299 LT
 STA 6+417 LT
 STA 6+947 LT
 STA 7+008 LT

REMOVAL AND DISPOSAL OF GUARDRAIL
 STA 6+142 TO 6+201 LT
 STA 6+295 TO 6+421 LT
 STA 6+979 TO 7+012 LT

LEGEND
 R = REMOVE EXISTING
 N = NEW
 B-B = BACK TO BACK
 --- = NEW RAIL
 --- = EXIST RAIL

PAVING PROJECT LAYOUT	PROJECT:	RANDOLPH-BRAINTREE	PROJECT NO.:	STP 9602(1)S
	DESIGN FILE NAME:	/pave/95c018/cc018.dgn		
	PARM FILE NAME:	cc01801	PLOT DATE:	8/95
	SURVEYED BY:	CLD	SURVEY DATE:	11/95
	SQUAD LEADER:	JAW	DRAWN BY:	NLT
		SHEET: 6 OF 14		

DATUM	
VERTICAL	N/A
HORIZONTAL	N/A

NOT TO SCALE

Sheet Number: 6