




**VT ROUTE 12
STA 2+505
END PROJECT STP 9602(1)S**

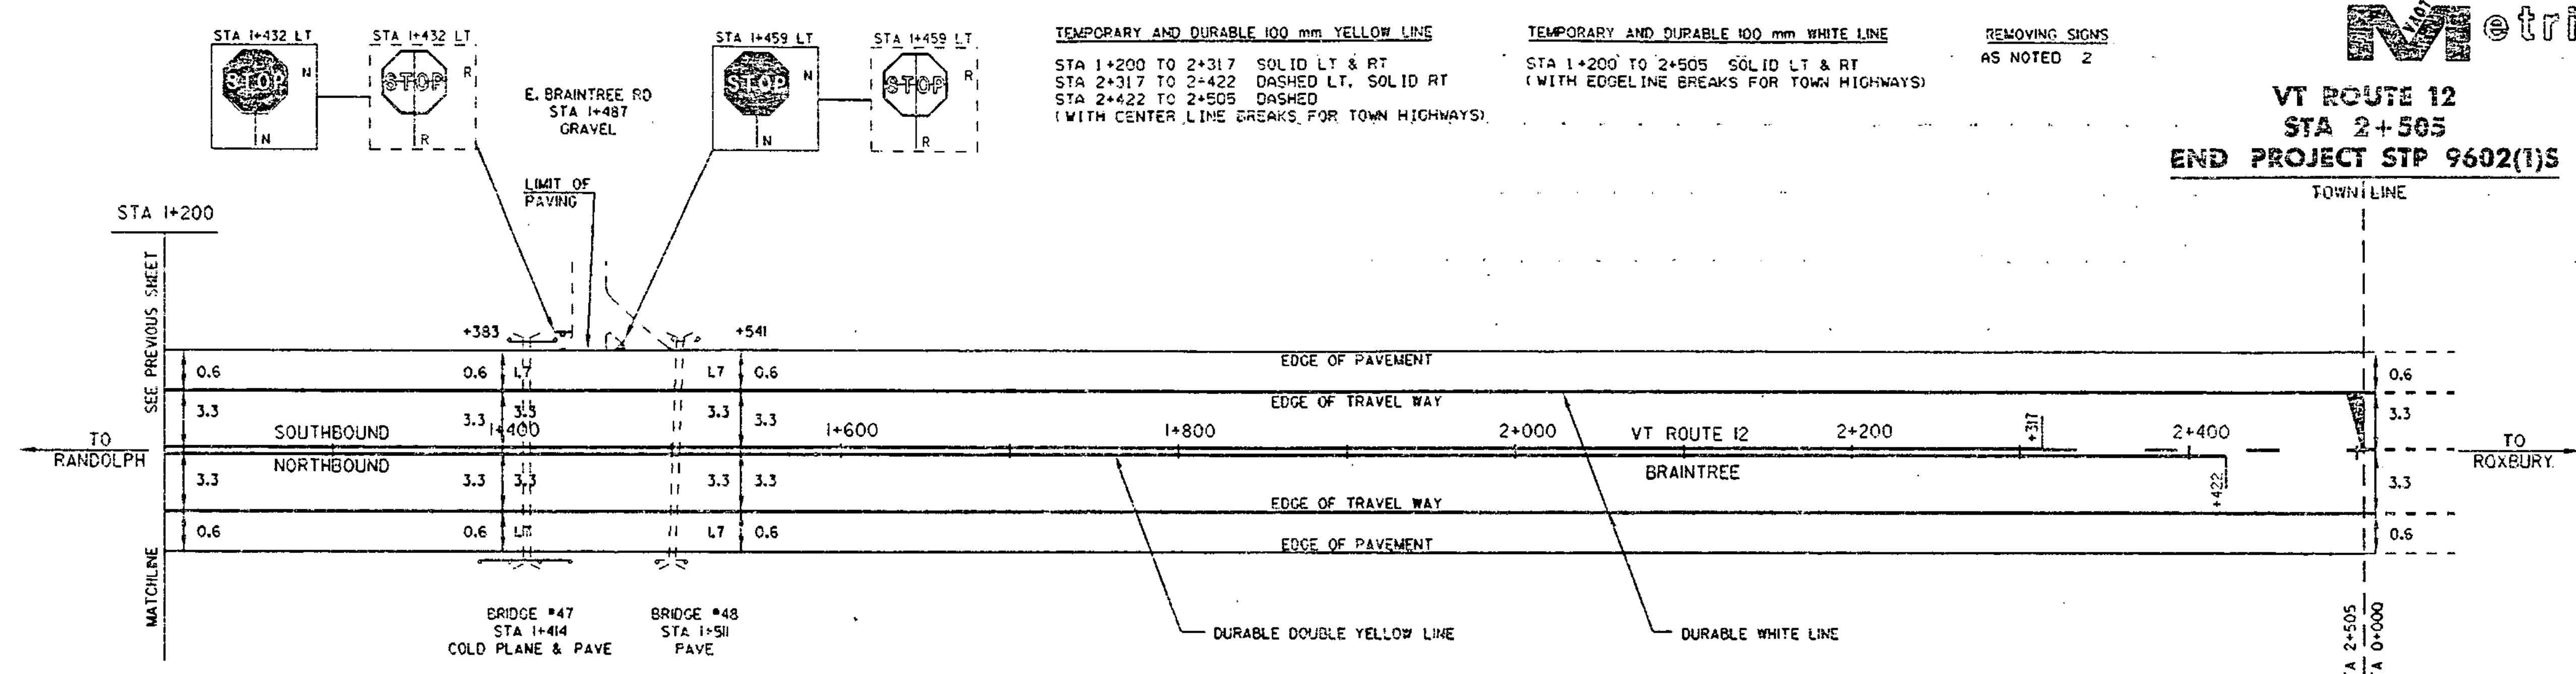

TEMPORARY AND DURABLE 100 mm YELLOW LINE
 STA 1+200 TO 2+317 SOLID LT & RT
 STA 2+317 TO 2+422 DASHED LT, SOLID RT
 STA 2+422 TO 2+505 DASHED
 (WITH CENTER LINE BREAKS FOR TOWN HIGHWAYS)

TEMPORARY AND DURABLE 100 mm WHITE LINE
 STA 1+200 TO 2+505 SOLID LT & RT
 (WITH EDGELINE BREAKS FOR TOWN HIGHWAYS)

REMOVING SIGNS
 AS NOTED 2

- | | | | | |
|--|---|---|---|---|
| BRIDGE RAIL - HD STEEL BEAM/FASCIA MOUNTED
STA 1+408 TO 1+420 LT | STEEL BEAM GUARDRAIL
STA 1+398 TO 1+428 RT | MODIFIED ECCENTRIC LOADER TERMINAL
STA 1+398 RT
STA 1+428 RT | REMOVAL AND DISPOSAL OF BRIDGE RAIL
STA 1+403 TO 1+429 LT | REHABILITATION OF DI, CB OR MH, CLASS I
REHABILITATION OF DI, CB OR MH, CLASS II
REHABILITATION OF DI, CB OR MH, CLASS III
STA 1+257 RT - GRATE TYPE A
STA 1+299 RT - GRATE TYPE D
STA 1+332 RT - GRATE TYPE D
STA 2+056 LT - GRATE TYPE A |
| HD STEEL BEAM GUARDRAIL
STA 1+404 TO 1+408 LT
STA 1+420 TO 1+431 LT | ANCHOR FOR STEEL BEAM RAIL
STA 1+404 LT
STA 1+431 LT | REMOVAL AND DISPOSAL OF GUARDRAIL
STA 1+386 TO 1+408 RT | | |

DATUM	
VERTICAL	N/A
HORIZONTAL	N/A

NOT TO SCALE

- LEGEND**
- R = REMOVE EXISTING
 - N = NEW
 - B-B = BACK TO BACK
 - ▬ = NEW RAIL
 - ▬ = EXIST RAIL

PAVING PROJECT LAYOUT	PROJECT :	RANDOLPH-BRAINTREE	PROJECT NO. :	STP 9602(1)S
	DESIGN FILE NAME:	/pave/95c018/nc018.dgn	PLOT DATE:	8/96
	IPARM FILE NAME:	nc018i04.1	SURVEY DATE:	11/95
	SURVEYED BY:	CLD	DRAWN BY:	NLE
	SQUAD LEADER:	JAW	SHEET:	9 OF 14

: Sheet Number: 9