

TEMPORARY AND DURABLE 100mm WHITE LINE
 STA 1+300 TO 2+600 SOLID LT & RT

TEMPORARY AND DURABLE 100mm YELLOW LINE
 STA 1+300 TO 2+600 SOLID LT & RT

REMOVAL & DISP. OF GUARDRAIL
 2+065 STA ~~2+072~~ TO ~~2+199~~ RT 2+173
 STA 2+304 TO 2+558 RT

REMOVAL & DISP. OF GUIDE POST
 STA ~~2+548~~ TO ~~2+578~~ RT ~~(19)~~

STEEL BEAM GUARDRAIL
 2+065 STA ~~2+060~~ TO ~~2+189~~ RT 2+184
 2+296 STA ~~2+391~~ TO ~~2+547~~ RT 2+525

STEEL BEAM GUARDRAIL (2.4m POST)(MOD)
 STA ~~2+292~~ TO ~~2+391~~ RT
 2+525 2+533



MODIFIED ECCENTRIC LOADER TERMINAL
 STA 2+060 RT 2+054 TO 2+065
 STA 2+189 RT 2+184 TO 2+195
 STA 2+292 RT 2+285 TO 2+296
 STA 2+547 RT 2+533 TO 2+544

CHANGING ELEV. OF DI, CB, OR MH
 REHABILITATION OF DI, CB, OR MH, CLASS I
 REHABILITATION OF DI, CB, OR MH, CLASS II
 REHABILITATION OF DI, CB, OR MH, CLASS III
 STA ~~1+415~~ RT 1+400
 STA ~~1+445~~ RT 1+424
 STA ~~1+445~~ LT

ADJUST ELEVATION OF VALVE BOX
 STA ~~1+461~~ RT
 1+441

REMOVING SIGNS
 AS SHOWN - 2

CHANGE ELEV. SMH
 STA 2+105 RT

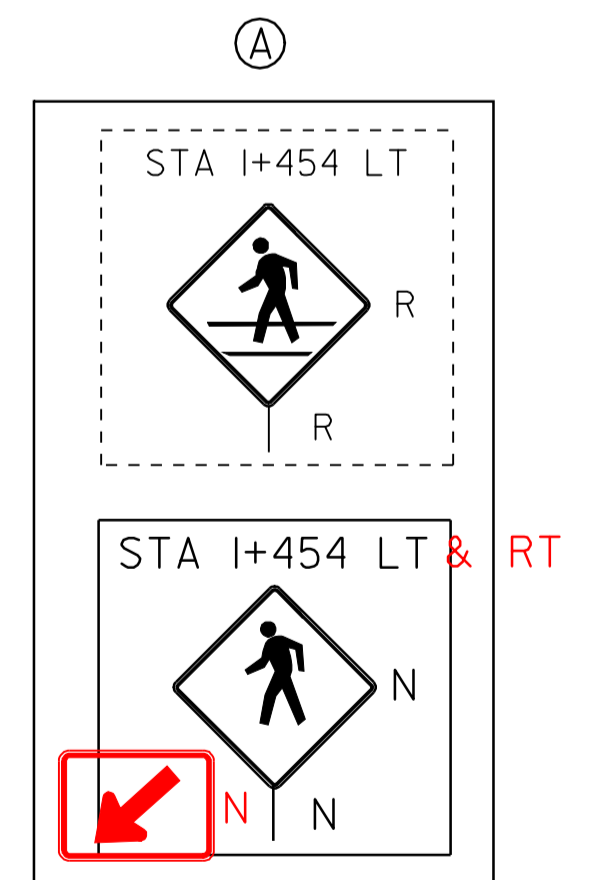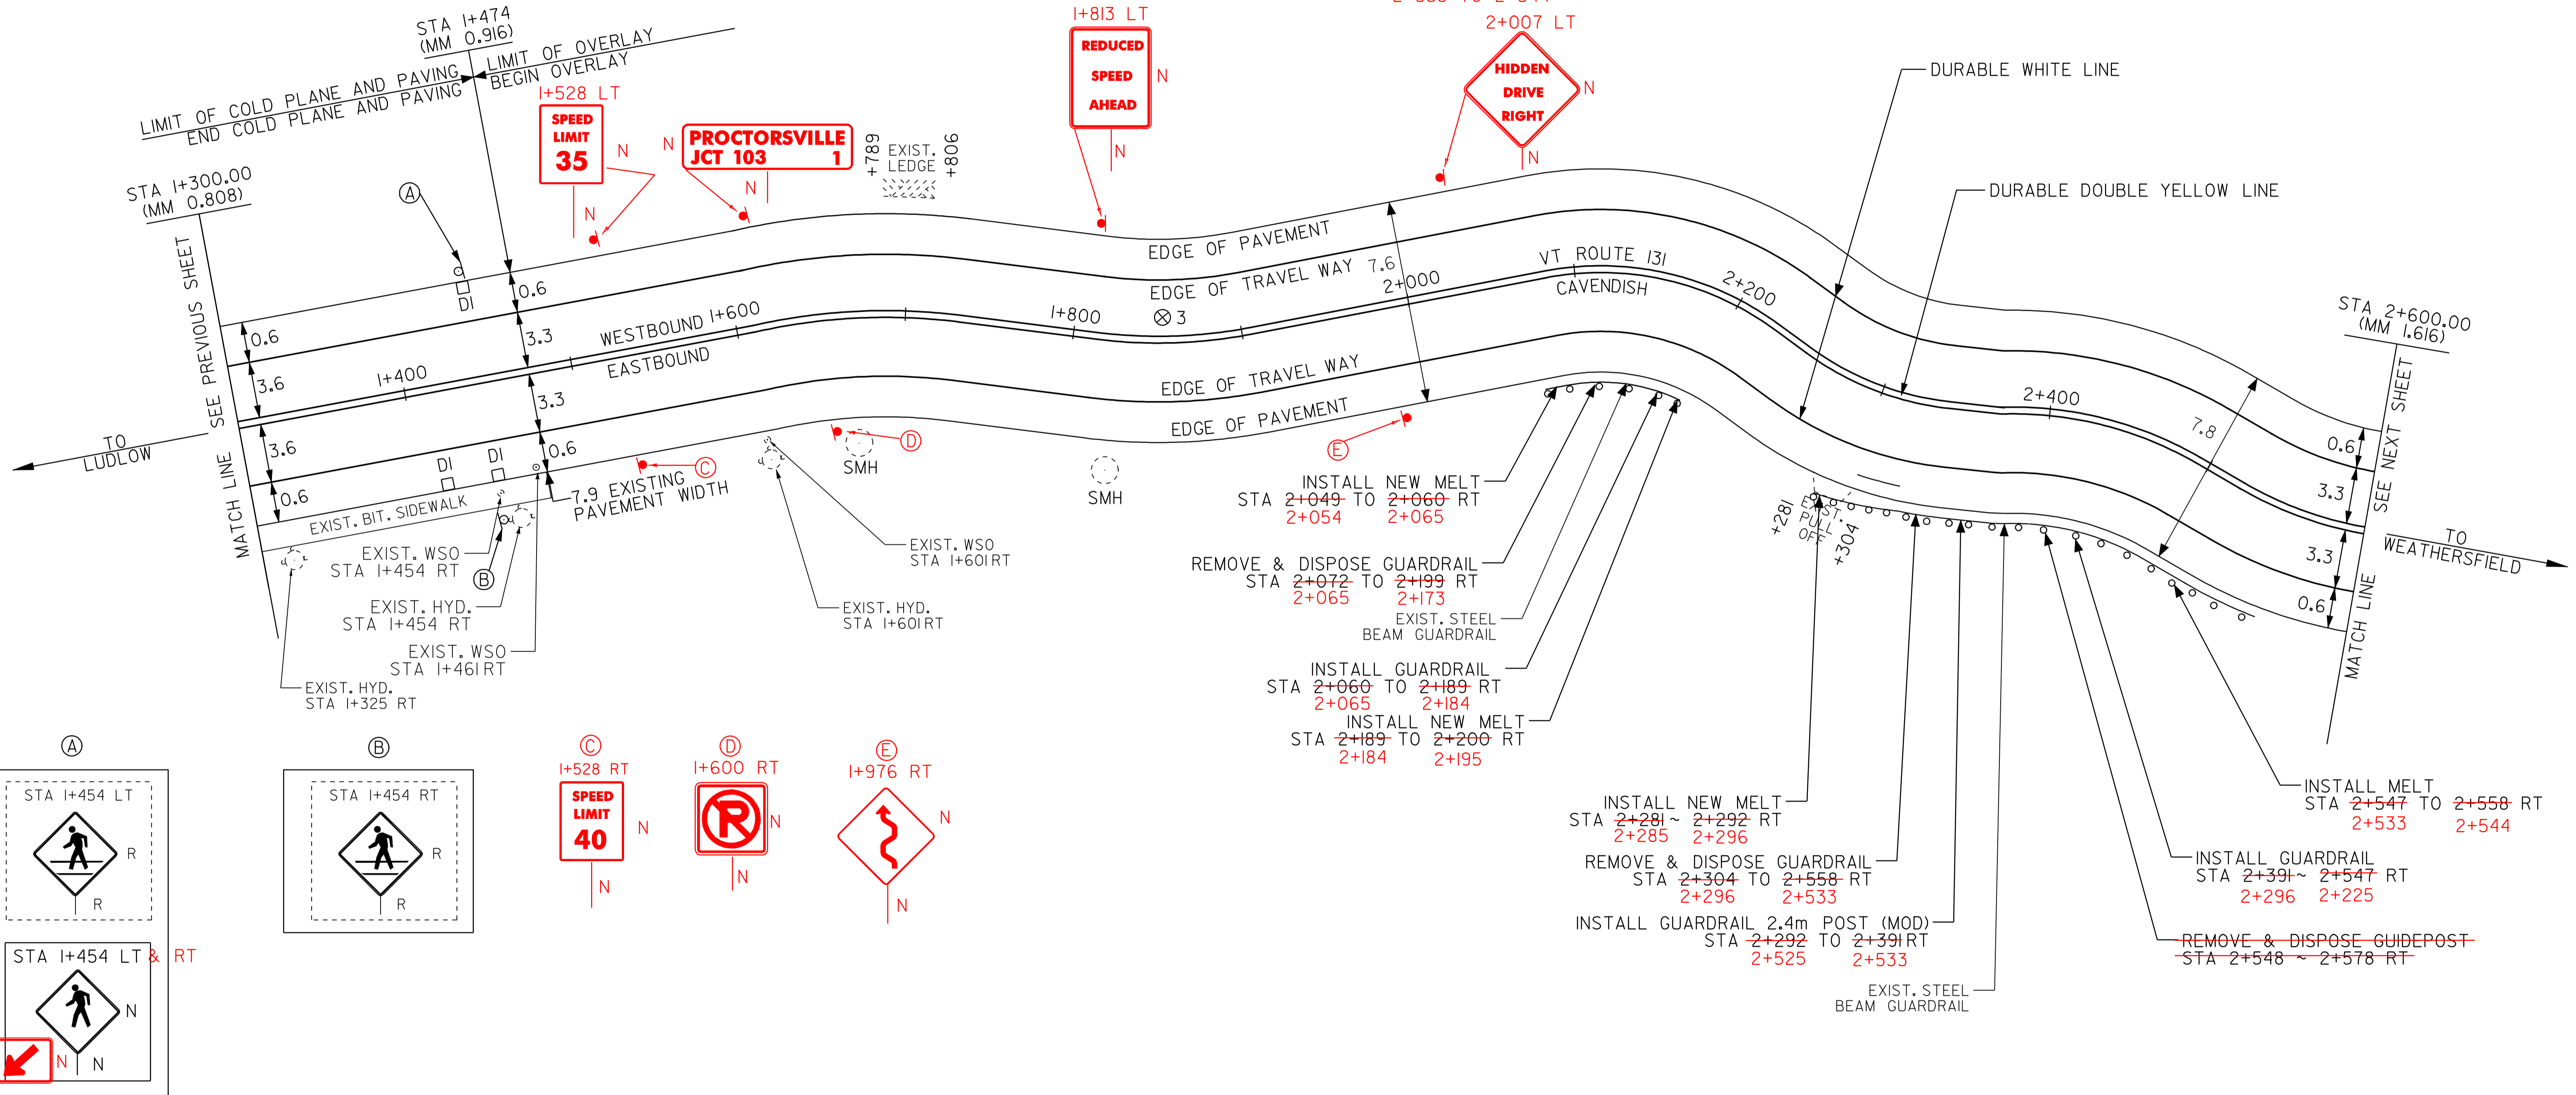

PAVEMENT CORES - ⊗

#	STA	TOTAL DEPTH (MM)	PCC
3	1+852 LT	114	NO

DATUM _____
 VERTICAL _____
 HORIZONTAL _____

NOT TO SCALE

LEGEND

R	=	REMOVE EXISTING
S	=	SALVAGE
R&S	=	REMOVE AND SALVAGE
N	=	NEW
RET	=	RETAIN
B-B	=	BACK TO BACK
—	=	NEW RAIL
—	=	EXISTING RAIL
⊗	=	BORING LOCATION

PAVING PROJECT LAYOUT

NOTE: ALL DIMENSIONS IN METERS EXCEPT AS INDICATED

PROJECT: CAVENDISH-WEATHERSFIELD	PROJECT NO.: STP 9661(1) S
DESIGN FILE NAME: /pave/95cl34/pol34.dgn	PLOT DATE: 27-JAN-2006
IPARM FILE NAME: pol34i02.i	SURVEYED BY: CLD, Inc.
SURVEYED BY: CLD, Inc.	SURVEY DATE: 06/97
SQUAD LEADER: JAW	DRAWN BY: JPC
	SHEET: 10 OF 32

ARCHIVED IN DPR