

**TEMPORARY AND DURABLE 100mm WHITE LINE**

STA 3+550	TO	4+300	SOLID LT
STA 3+550	TO	3+593	SOLID RT
STA 3+617	TO	3+693	SOLID RT
STA 3+717	TO	4+089	SOLID RT
STA 4+113	TO	4+300	SOLID RT

**TEMPORARY AND DURABLE 100mm YELLOW LINE**

STA 3+550	TO	3+599	SOLID LT & RT
STA 3+611	TO	3+699	SOLID LT & RT
STA 3+711	TO	4+095	SOLID LT & RT
STA 4+110	TO	DOUBLE SOLID RT (TH #68)	
STA 4+107	TO	4+300	SOLID LT & RT

**TEMPORARY AND DURABLE 600 mm STOP BAR**

STA 4+101	RT (TH #68)
-----------	-------------

**TEMPORARY AND DURABLE LETTER OR SYMBOL**

STA 4+101	RT "STOP" (TH # 68)
074	

**STEEL BEAM GUARDRAIL (2.4m POST)(MOD.)**

STA 3+788-727	TO	3+838	RT 812
---------------	----	-------	--------

**TREATED TIMBER CURB**

STA 3+788-727	TO	3+846	RT 812
STA 3+876-867	TO	4+077	RT 066

**MODIFIED ECCENTRIC LOADER TERMINAL**

STA 3+788	RT
STA 3+838	RT
STA 3+876	RT 3+856 TO 3+867 RT
STA 4+077	RT 4+066 TO 4+077 RT

**BITUMINOUS CONCRETE GUTTERS & TRAFFIC ISLANDS**

STA 3+755	TO	3+764	RT (1M)
STA 3+870	TO	4+084	RT (1M)
STA 4+129	TO	4+280	RT (1.1M)

**REMOVAL & DISPOSAL OF GUARDRAIL**

731 STA 3+770	~	3+849	RT 812
867 STA 3+865	~	4+087	RT 066

**STEEL BEAM GUARDRAIL**

STA 3+876	TO	4+077	RT 066
-----------	----	-------	--------

**ANCHOR G ID**

STA 3+731	RT
STA 3+809	RT

CHANGING ELEV. OF DI, CB, OR MH  
REHABILITATION OF DI, CB, OR MH, CLASS I  
REHABILITATION OF DI, CB, OR MH, CLASS II  
REHABILITATION OF DI, CB, OR MH, CLASS III

~~STA 3+568 RT~~

**CHANGING ELEVATION OF SEWER MANHOLE (SMH)**

STA 3+600	RT 569
<del>STA 3+690</del>	<del>RT</del>
<del>STA 3+764</del>	<del>RT</del>
<del>STA 4+084</del>	<del>LT</del>

**REMOVING SIGNS**



AS SHOWN - 6

**ERECTING SALVAGED SIGNS**

AS SHOWN - 2

**ADJUST ELEV. VALVE BOX**

STA. 3+571	LT
STA. 3+572	LT
STA. 3+862	LT (2)

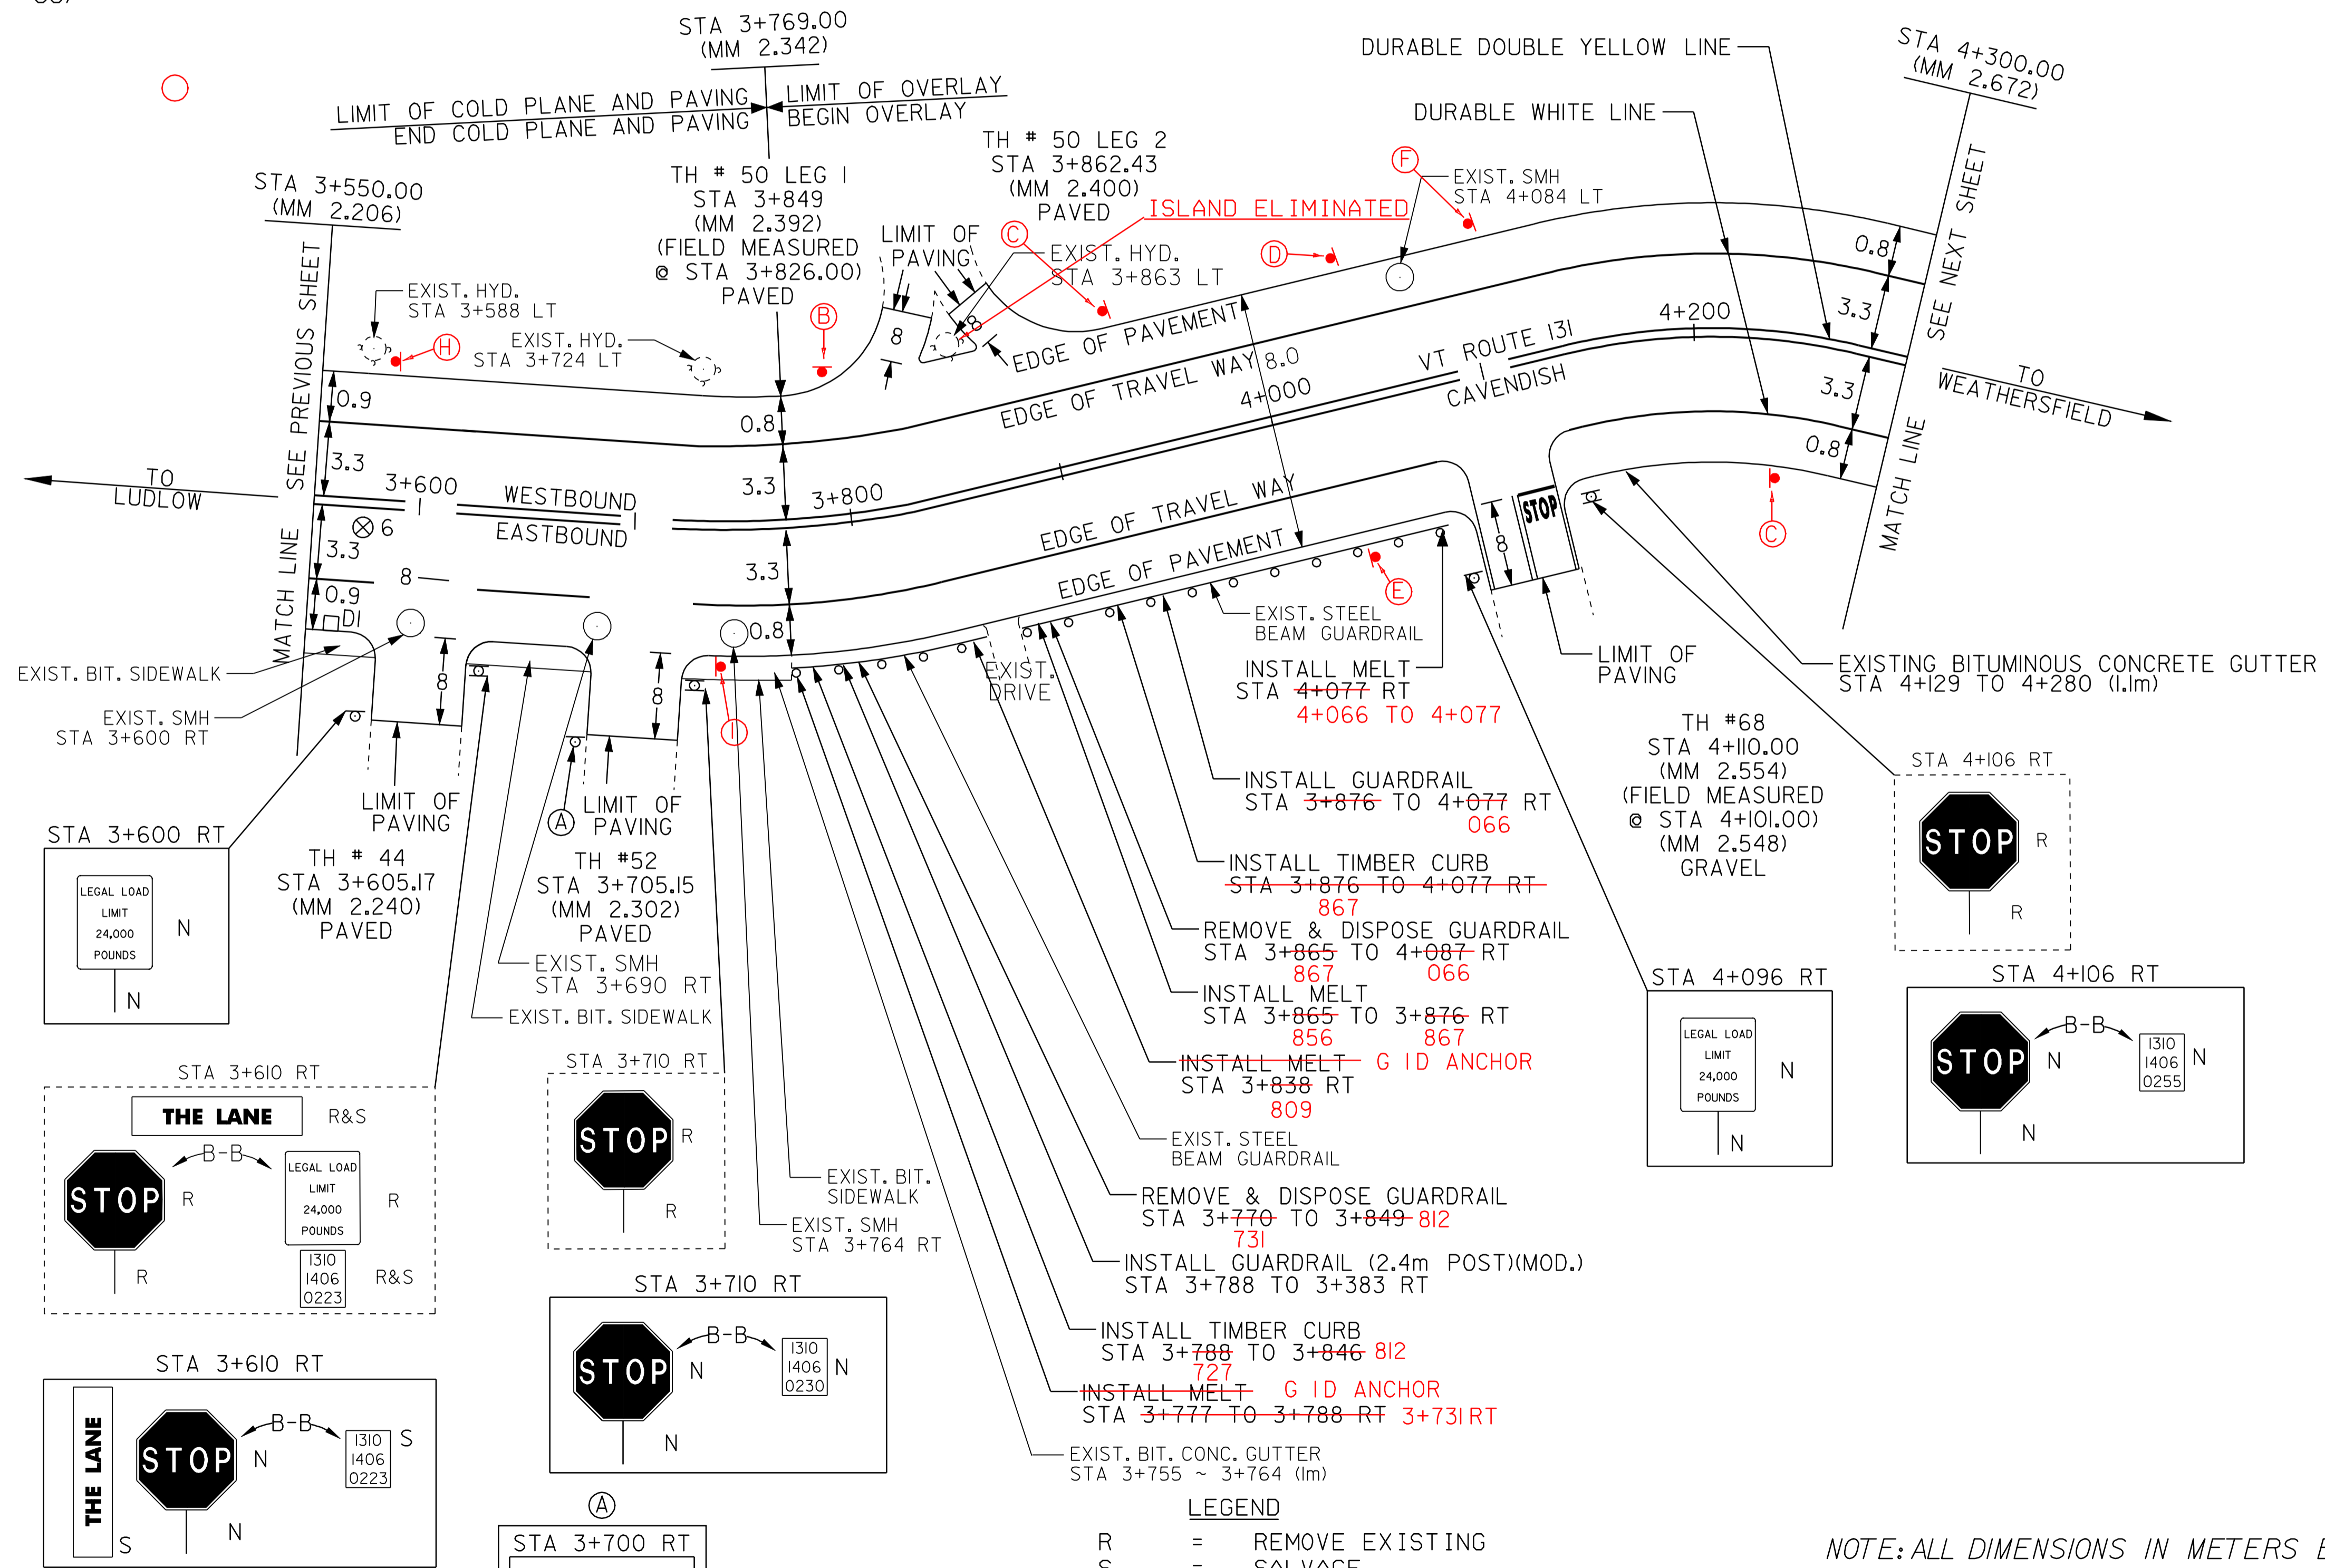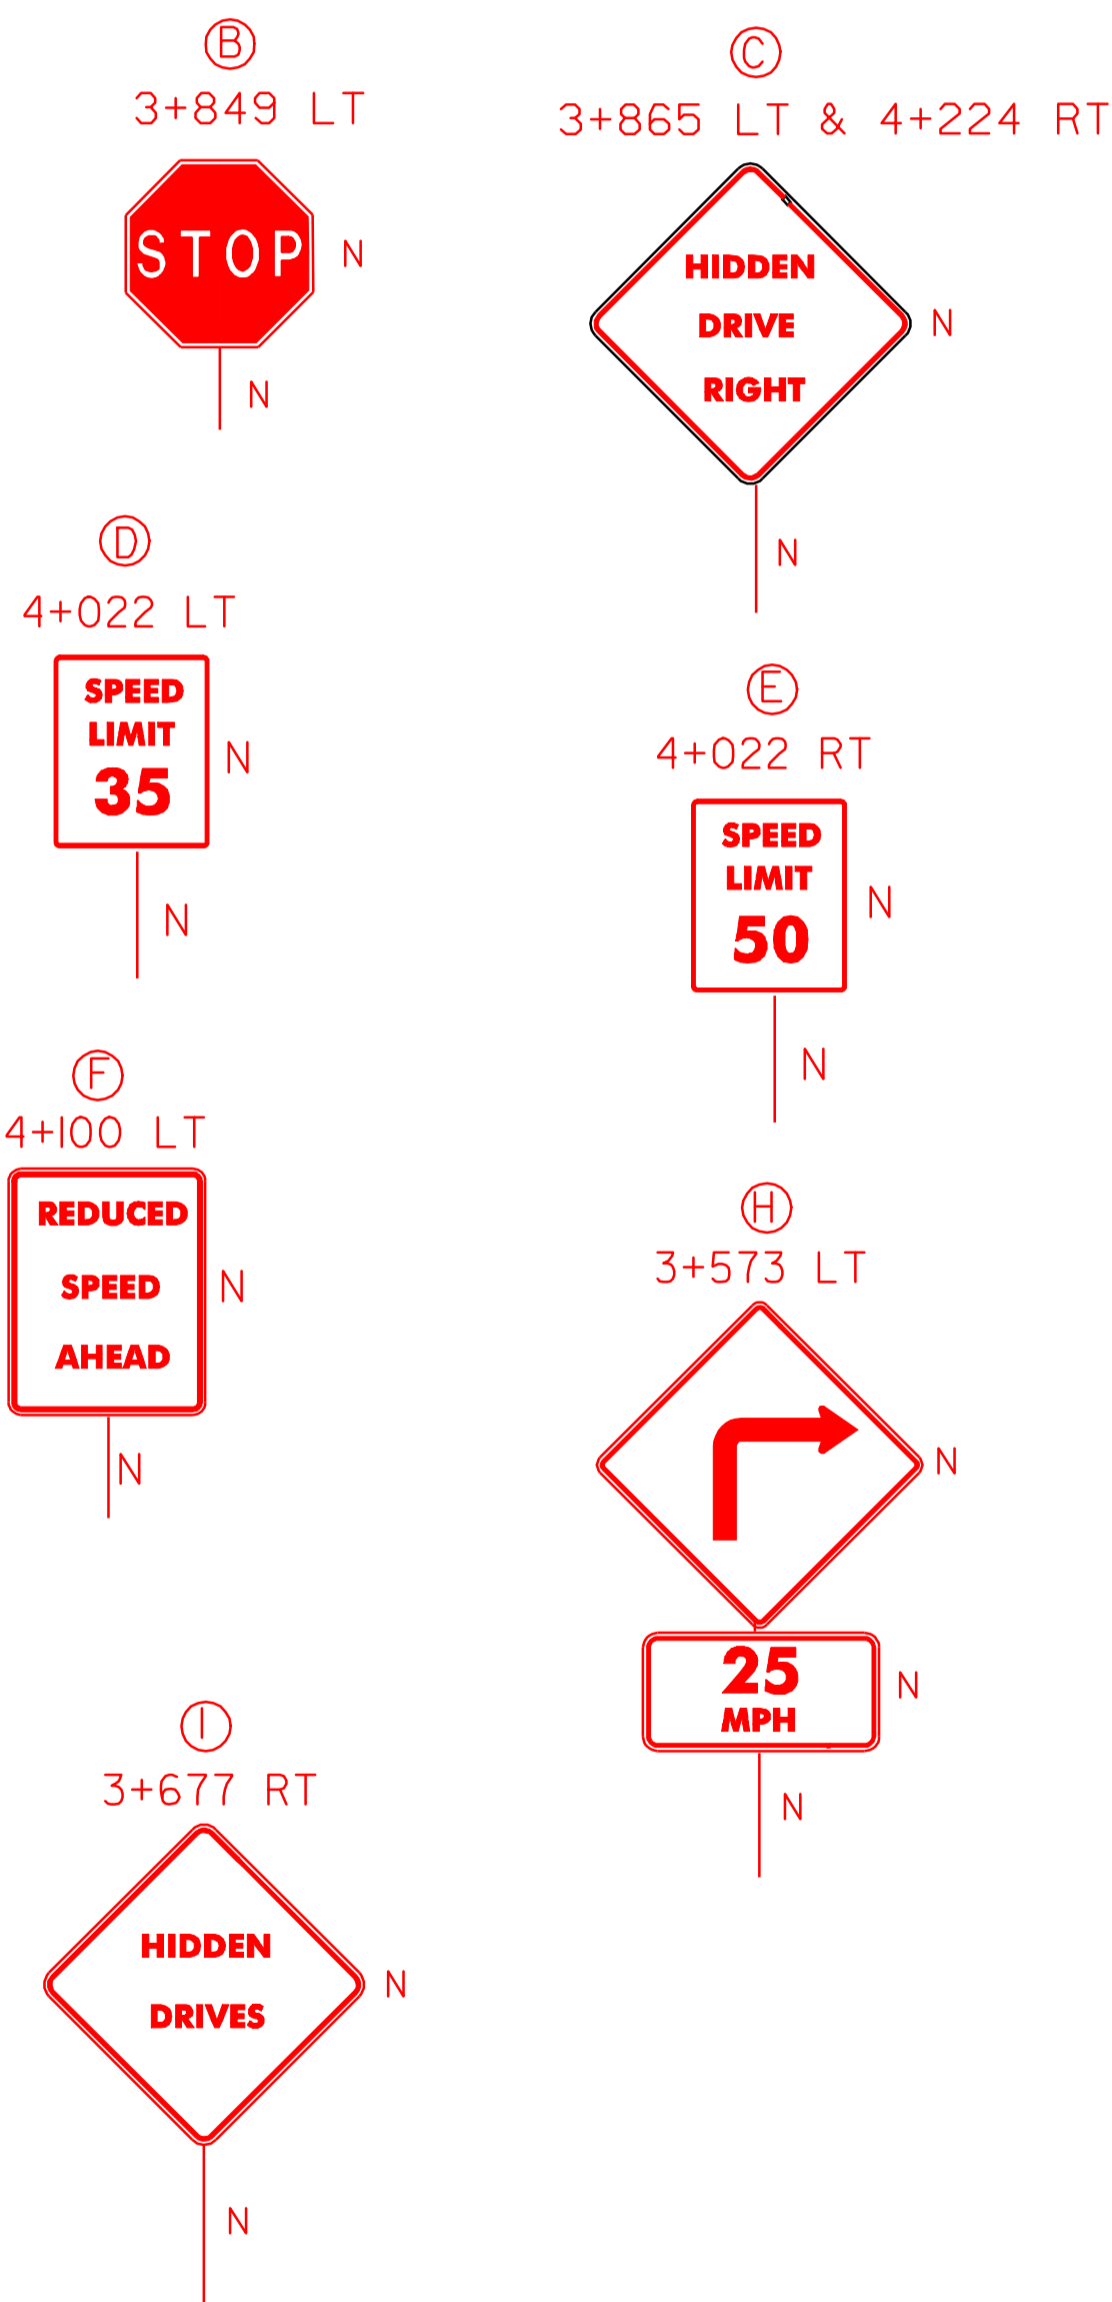

PAVEMENT CORES - ⊗

#	STA	TOTAL DEPTH (MM)	PCC
6	3+576 RT	171	NO

DATUM

VERTICAL \_\_\_\_\_

HORIZONTAL \_\_\_\_\_

- LEGEND**
- R = REMOVE EXISTING
  - S = SALVAGE
  - R&S = REMOVE AND SALVAGE
  - N = NEW
  - RET = RETAIN
  - B-B = BACK TO BACK
  - = NEW RAIL
  - = EXISTING RAIL
  - ⊗ = BORING LOCATION

**PAVING PROJECT LAYOUT**

NOTE: ALL DIMENSIONS IN METERS EXCEPT AS INDICATED

PROJECT: CAVENDISH-WEATHERSFIELD	PROJECT NO.: STP 9661(1) S
DESIGN FILE NAME: /pave/95cl34/pcl34.dgn	PLOT DATE: 27-JAN-2006
IPARM FILE NAME: pcl34i04.i	SURVEY DATE: 06/97
SURVEYED BY: CLD, Inc.	DRAWN BY: JPC
SQUAD LEADER: JAW	SHEET: 12 OF 32

**ARCHIVED IN DPR**

NOT TO SCALE