


TEMPORARY AND DURABLE 100mm WHITE LINE
 STA 8+600 TO 10+400 SOLID LT & RT

TEMPORARY AND DURABLE 100mm YELLOW LINE
 STA 8+600 TO 10+400 SOLID LT & RT

STEEL BEAM GUARDRAIL
 STA 8+600 TO 9+143 RT 087
 STA 9+600 TO 10+330 RT
 REMOVE & DISPOSE GUARDRAIL
 STA 8+600 TO 9+153 RT
 436 087

MODIFIED ECCENTRIC LOADER TERMINAL
 STA 9+143 RT 9+087 TO 9+098 RT
 STA 9+589 TO 9+600 RT

SHOULDER BERM REMOVAL
 STA 10+089 TO 10+400 RT

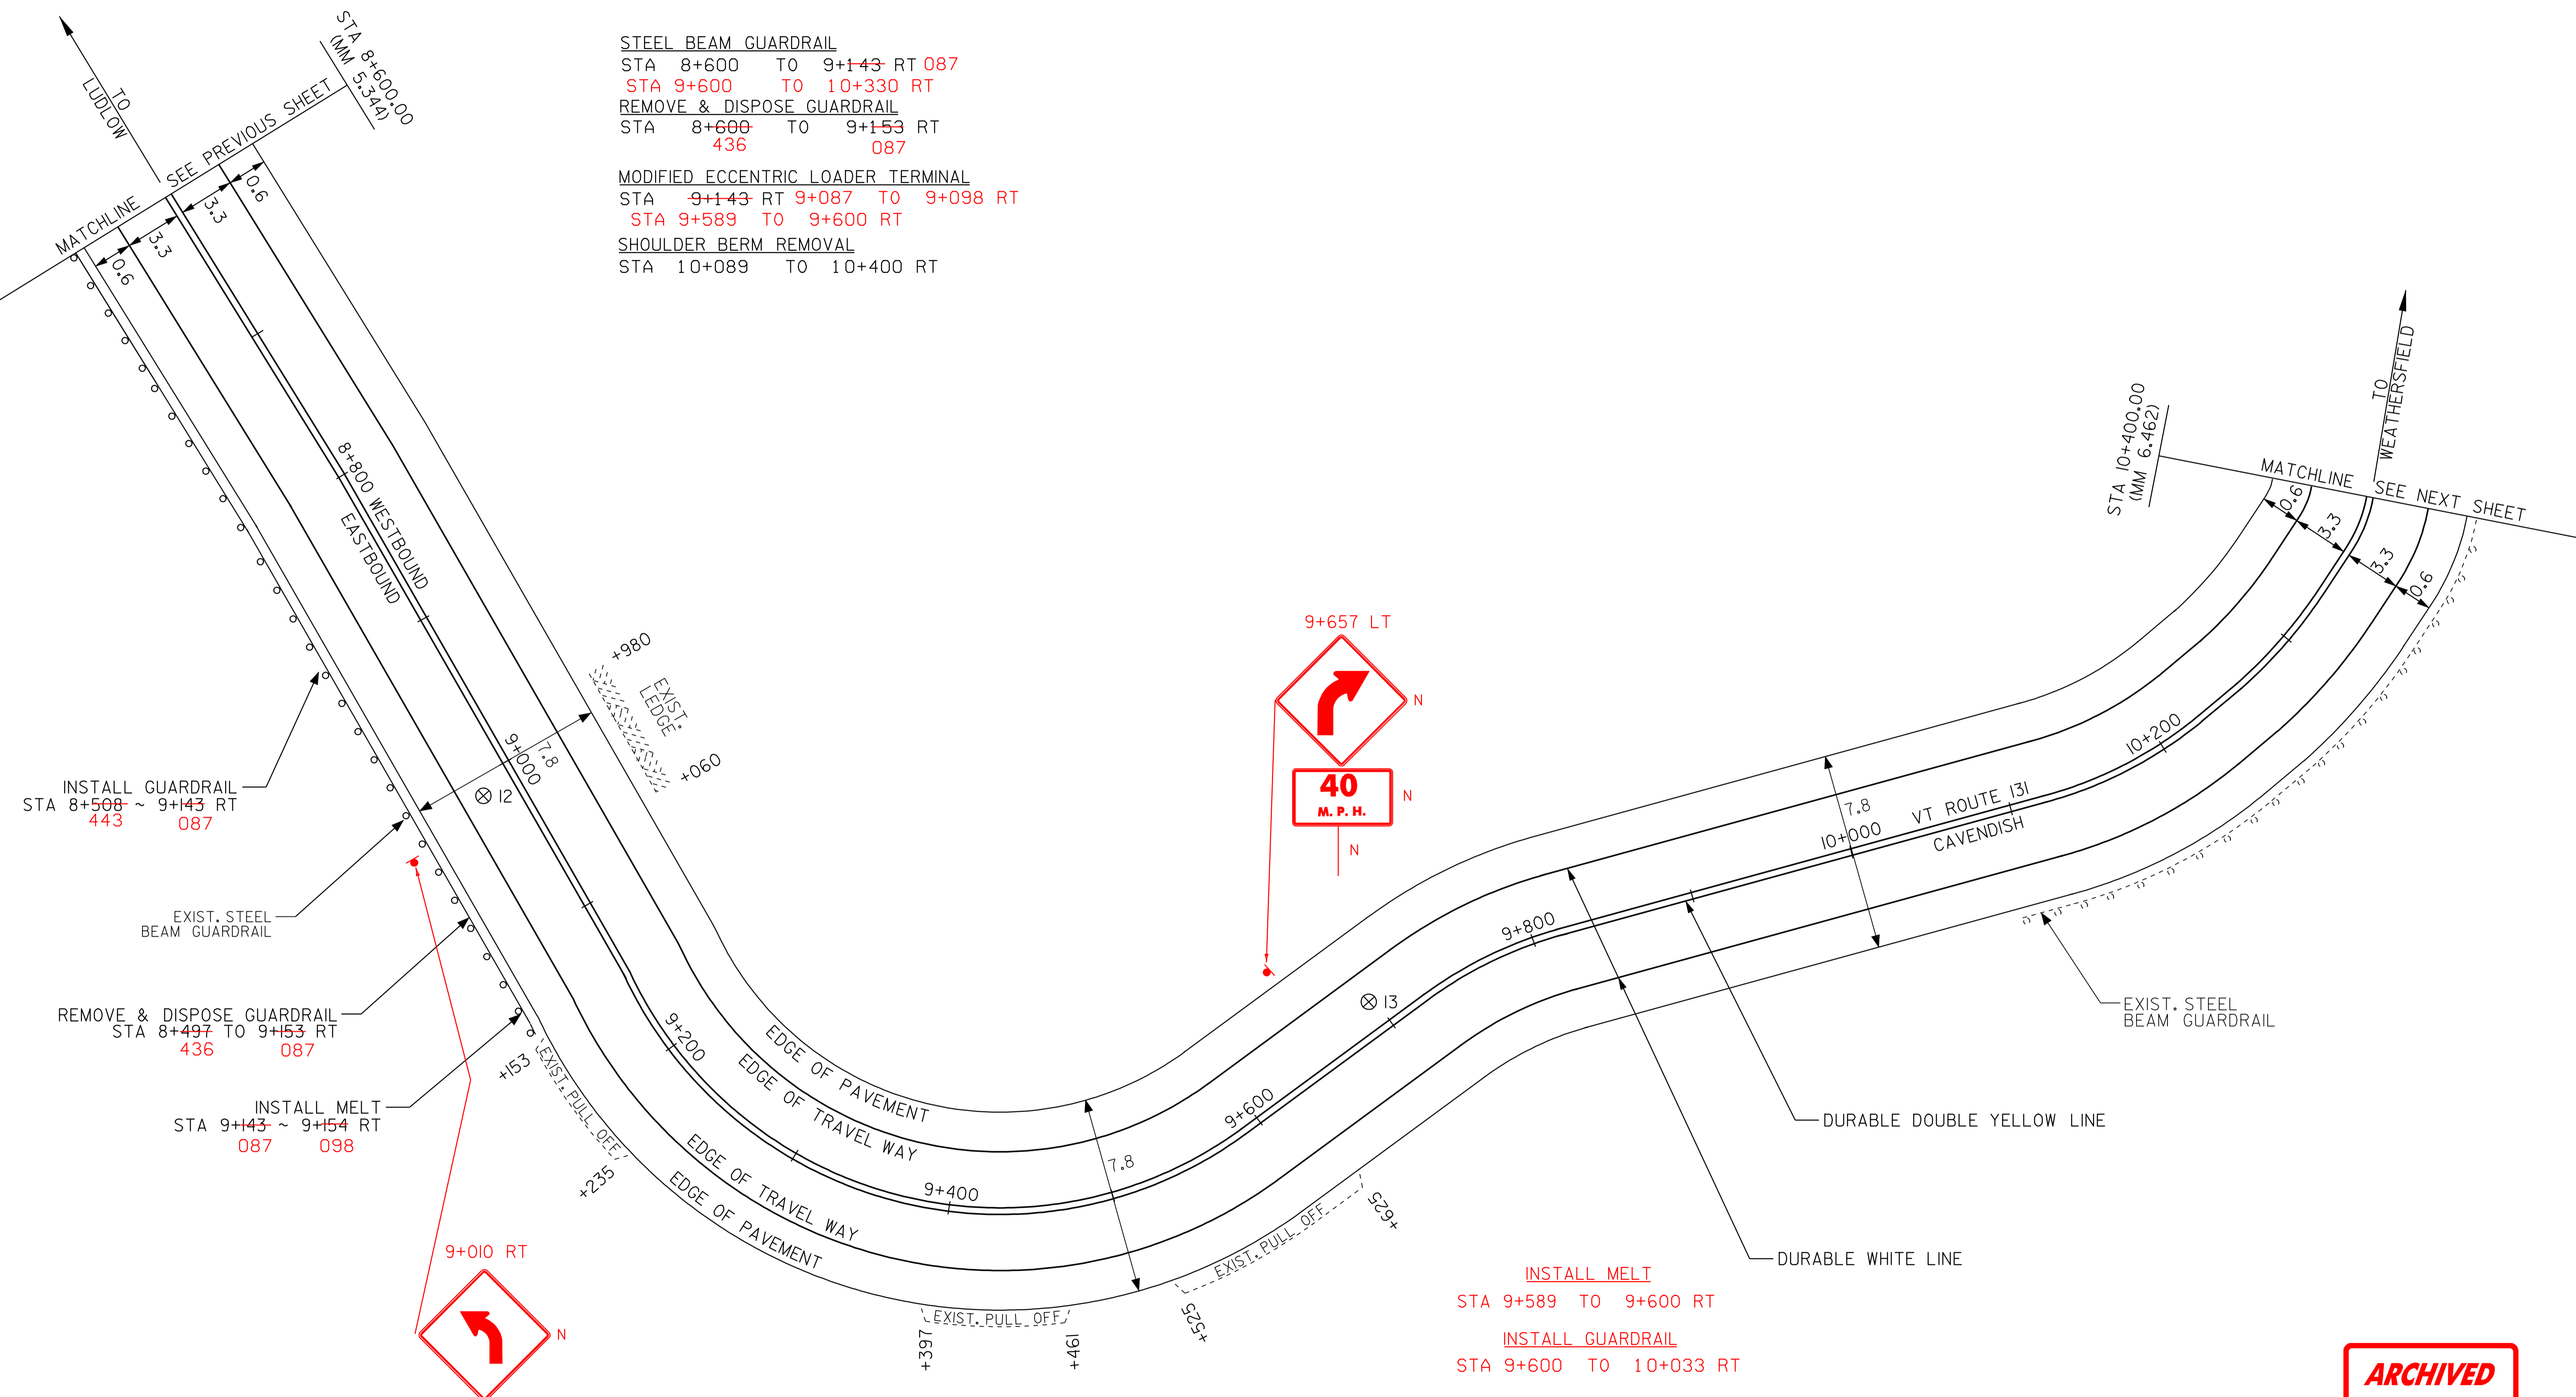


INSTALL GUARDRAIL
 STA 8+508 ~ 9+143 RT
 443 087

EXIST. STEEL BEAM GUARDRAIL

REMOVE & DISPOSE GUARDRAIL
 STA 8+497 TO 9+153 RT
 436 087

INSTALL MELT
 STA 9+143 ~ 9+154 RT
 087 098

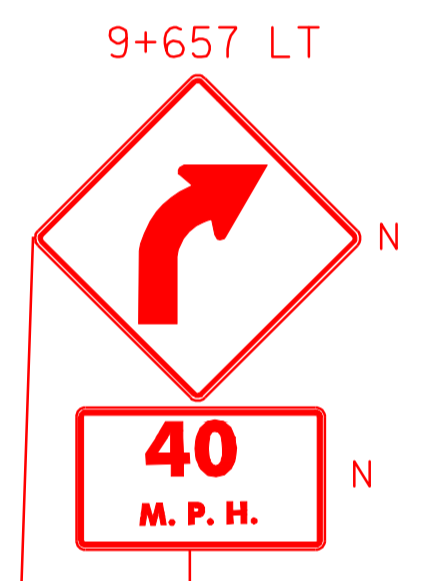

PAVEMENT CORES - ⊗

#	STA	TOTAL DEPTH (MM)	PCC
12	9+012 RT	203	N0
13	9+796 LT	127	N0

DATUM
 VERTICAL _____
 HORIZONTAL _____

- LEGEND
- R = REMOVE EXISTING
 - S = SALVAGE
 - R&S = REMOVE AND SALVAGE
 - N = NEW
 - RET = RETAIN
 - B-B = BACK TO BACK
 - o = NEW RAIL
 - o---o = EXISTING RAIL
 - ⊗ = BORING LOCATION

NOTE: ALL DIMENSIONS IN METERS EXCEPT AS INDICATED

PAVING PROJECT LAYOUT	PROJECT: CAVENDISH-WEATHERSFIELD	PROJECT NO.: STP 9661(1) S
	DESIGN FILE NAME: /pave/95cl34/pcl34.dgn	PLOT DATE: 27-JAN-2006
	IPARM FILE NAME: pcl34i08.i	SURVEY DATE: 06/97
	SURVEYED BY: CLD, Inc.	DRAWN BY: JPC
	SQUAD LEADER: JAW	SHEET: 16 OF 32

NOT TO SCALE

ARCHIVED
IN DPR