


TEMPORARY AND DURABLE 100mm WHITE LINE
 STA 10+400 TO 11+800 SOLID LT & RT
 TEMPORARY AND DURABLE 100mm YELLOW LINE
 STA 10+400 TO 11+800 SOLID LT & RT

STEEL BEAM GUARDRAIL (2.4m POST) (MOD)
 STA 10+534 TO 10+663 RT
 REMOVAL & DISP. OF GUARDRAIL
 STA 10+531 TO 10+674 RT
 SHOULDER BERM REMOVAL
 STA 10+400 TO 10+450 RT
 STA 10+728 TO 10+238 RT
 STA 11+434 TO 11+800 RT

MODIFIED ECCENTRIC LOADER TERMINAL
 STA 10+534 RT
 STA 10+663 RT

CHANGING ELEV. OF DI, CB, OR MH
 REHABILITATION OF DI, CB, OR MH, CLASS I
 REHABILITATION OF DI, CB, OR MH, CLASS II
 REHABILITATION OF DI, CB, OR MH, CLASS III
 STA 11+727 LT

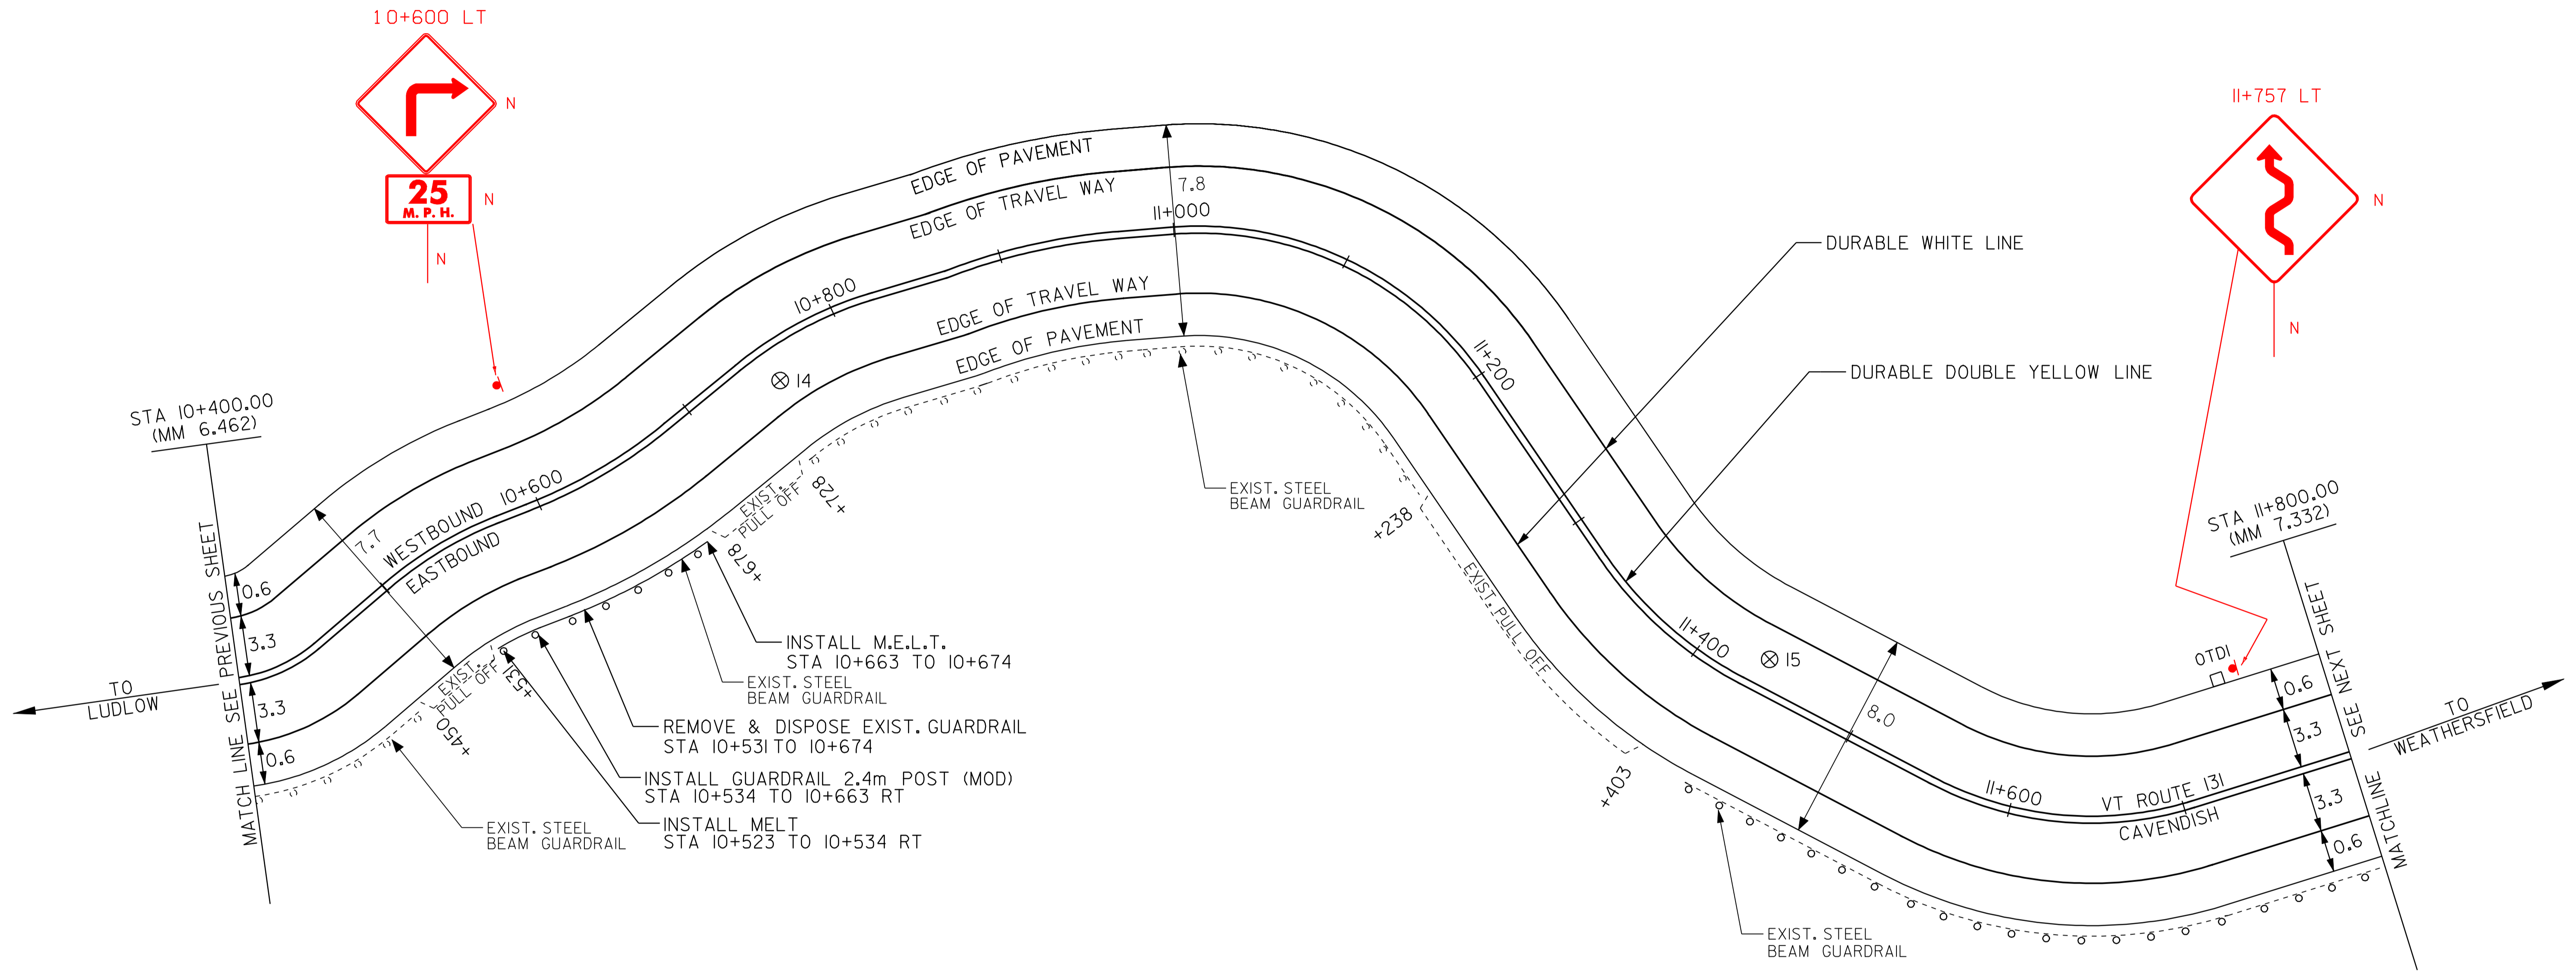

PAVEMENT CORES - ⊗

#	STA	TOTAL DEPTH (MM)	PCC
14	10+752 RT	140	NO
15	11+439 LT	178	NO

DATUM
 VERTICAL _____
 HORIZONTAL _____

LEGEND

- R = REMOVE EXISTING
- S = SALVAGE
- R&S = REMOVE AND SALVAGE
- N = NEW
- RET = RETAIN
- B-B = BACK TO BACK
- = NEW RAIL
- = EXISTING RAIL

NOT TO SCALE

NOTE: ALL DIMENSIONS IN METERS EXCEPT AS INDICATED

PAVING PROJECT LAYOUT

PROJECT: CAVENDISH-WEATHERSFIELD	PROJECT NO.: STP 9661(1)S
DESIGN FILE NAME: /pave/95cl34/pcl34.dgn	PLOT DATE: 27-JAN-2006
IPARM FILE NAME: pcl34i09.i	SURVEY DATE: 06/97
SURVEYED BY: CLD, Inc.	DRAWN BY: JPC
SQUAD LEADER: JAW	SHEET: 17 OF 32

**ARCHIVED
 IN DPR**