

TEMPORARY AND DURABLE 100mm WHITE LINE

STA 3+340 TO 3+390 SOLID LT
 STA 3+340 TO 3+351 SOLID RT
 STA 3+375 TO 3+390 SOLID RT

TEMPORARY AND DURABLE 100mm YELLOW LINE

STA 3+340 TO 3+357 SOLID LT & RT
 STA 3+363 DOUBLE SOLID RT
 STA 3+369 TO 3+390 SOLID LT & RT

TEMPORARY AND DURABLE 600 mm STOP BAR

STA 3+363 RT (S. A. 4)

TEMPORARY AND DURABLE LETTER OR SYMBOL

STA 3+363 RT "STOP" (S. A. 4)

330

BITUMINOUS CONCRETE GUTTERS & TRAFFIC ISLANDS

STA 3+340 TO 3+342 RT (1.0m)

CHANGING ELEV. OF DI, CB, OR MH
 REHABILITATION OF DI, CB, OR MH, CLASS I

STA 3+346 LT
 STA 3+349 RT

CHANGE ELEV. OF SEWER MANHOLE(MH)

STA 3+365 RT

ADJUST ELEVATION OF VALVE BOX

STA 3+368 LT
 STA 3+368 RT

REMOVING SIGNS

AS SHOWN - 2

PORTALND CEMENT CONCRETE SIDEWALK, 125 mm


STA 3+367 ~ 3+380 RT

VERTICAL GRANITE CURBING

STA 3+367 ~ 3+380 RT

CONSTRUCT SIDEWALK RAMP, TYPE I

STA 3+367 ~ 3+380 RT

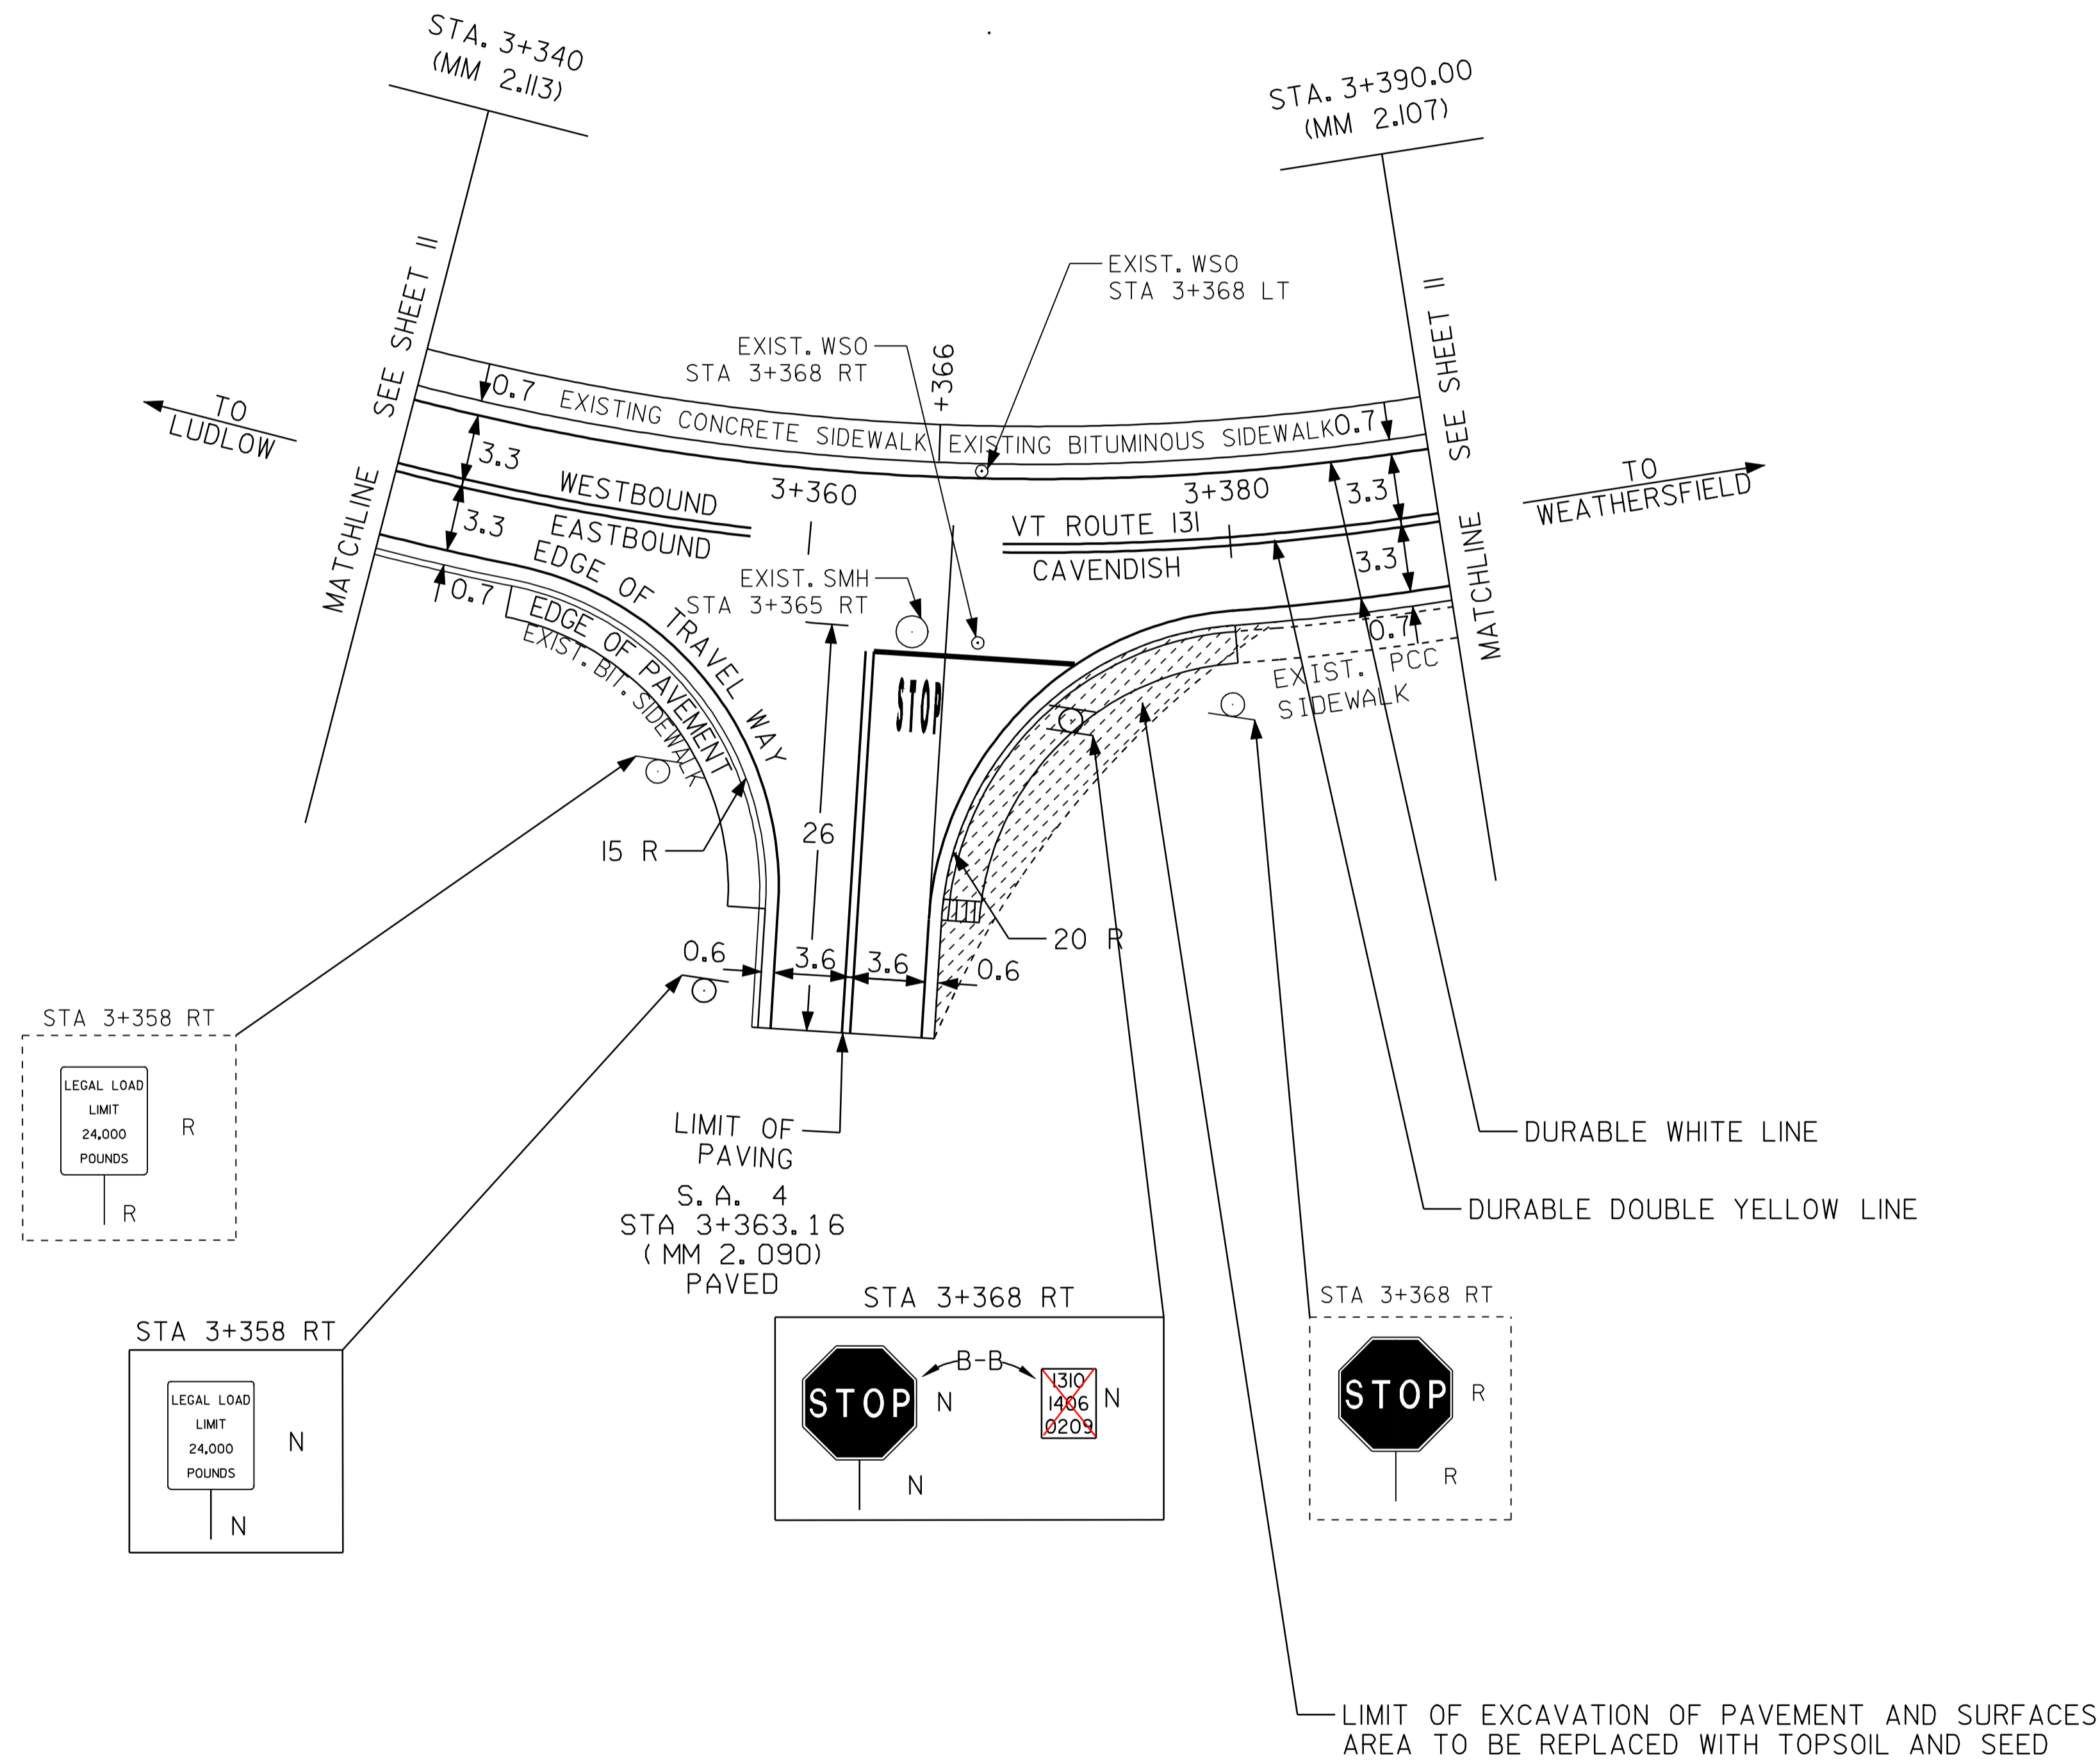

**ARCHIVED
 IN DPR**

NOT TO SCALE

LEGEND

- R = REMOVE EXISTING
- S = SALVAGE
- R&S = REMOVE AND SALVAGE
- N = NEW
- RET = RETAIN
- B-B = BACK TO BACK
- = NEW RAIL
- = EXISTING RAIL

NOTE: ALL DIMENSIONS IN METERS EXCEPT AS INDICATED

DATUM	
VERTICAL	
HORIZONTAL	

**INTERSECTION
 DETAIL
 SHEET #2**

PROJECT: CAVENDISH - WEATHERSFIELD	PROJECT NO.: STP 9661(1)S
DESIGN FILE NAME: /pave/95a134/pcl34.dgn	PLOT DATE: 27-JAN-2006
IPARM FILE NAME: pcl34i02.j	SURVEY DATE: 06/97
SURVEYED BY: CLD Inc.	DRAWN BY: JJM
SQUAD LEADER: JAW	SHEET: 21 OF 32