



TH #6
STA 4+967.02
(MM 3.086)

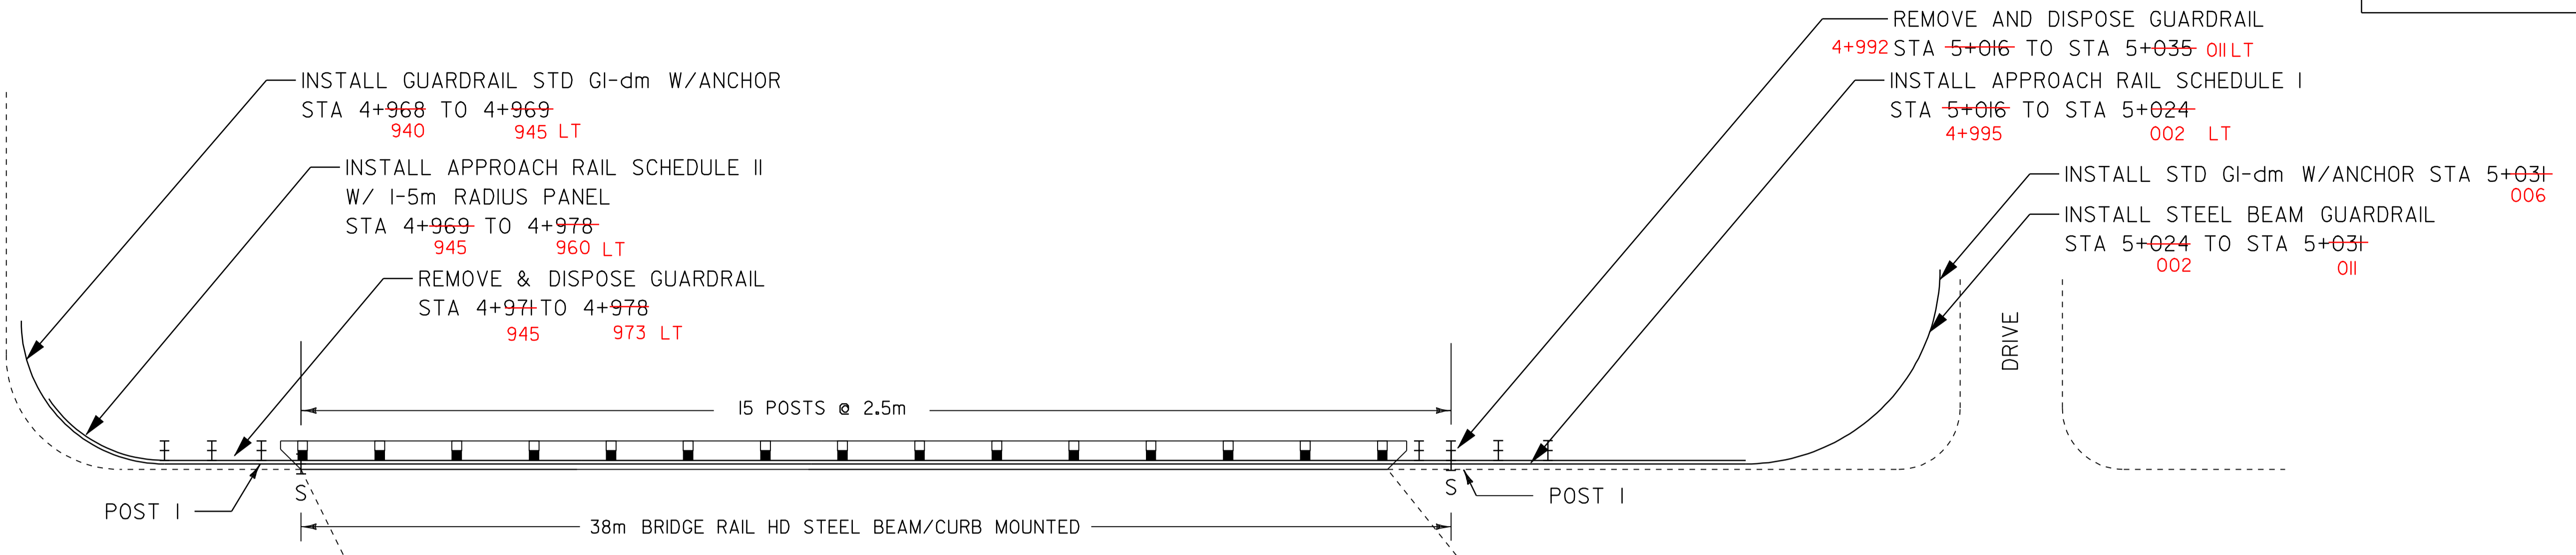

TH #30
STA 4+967.02
(MM 3.086)
PAVED

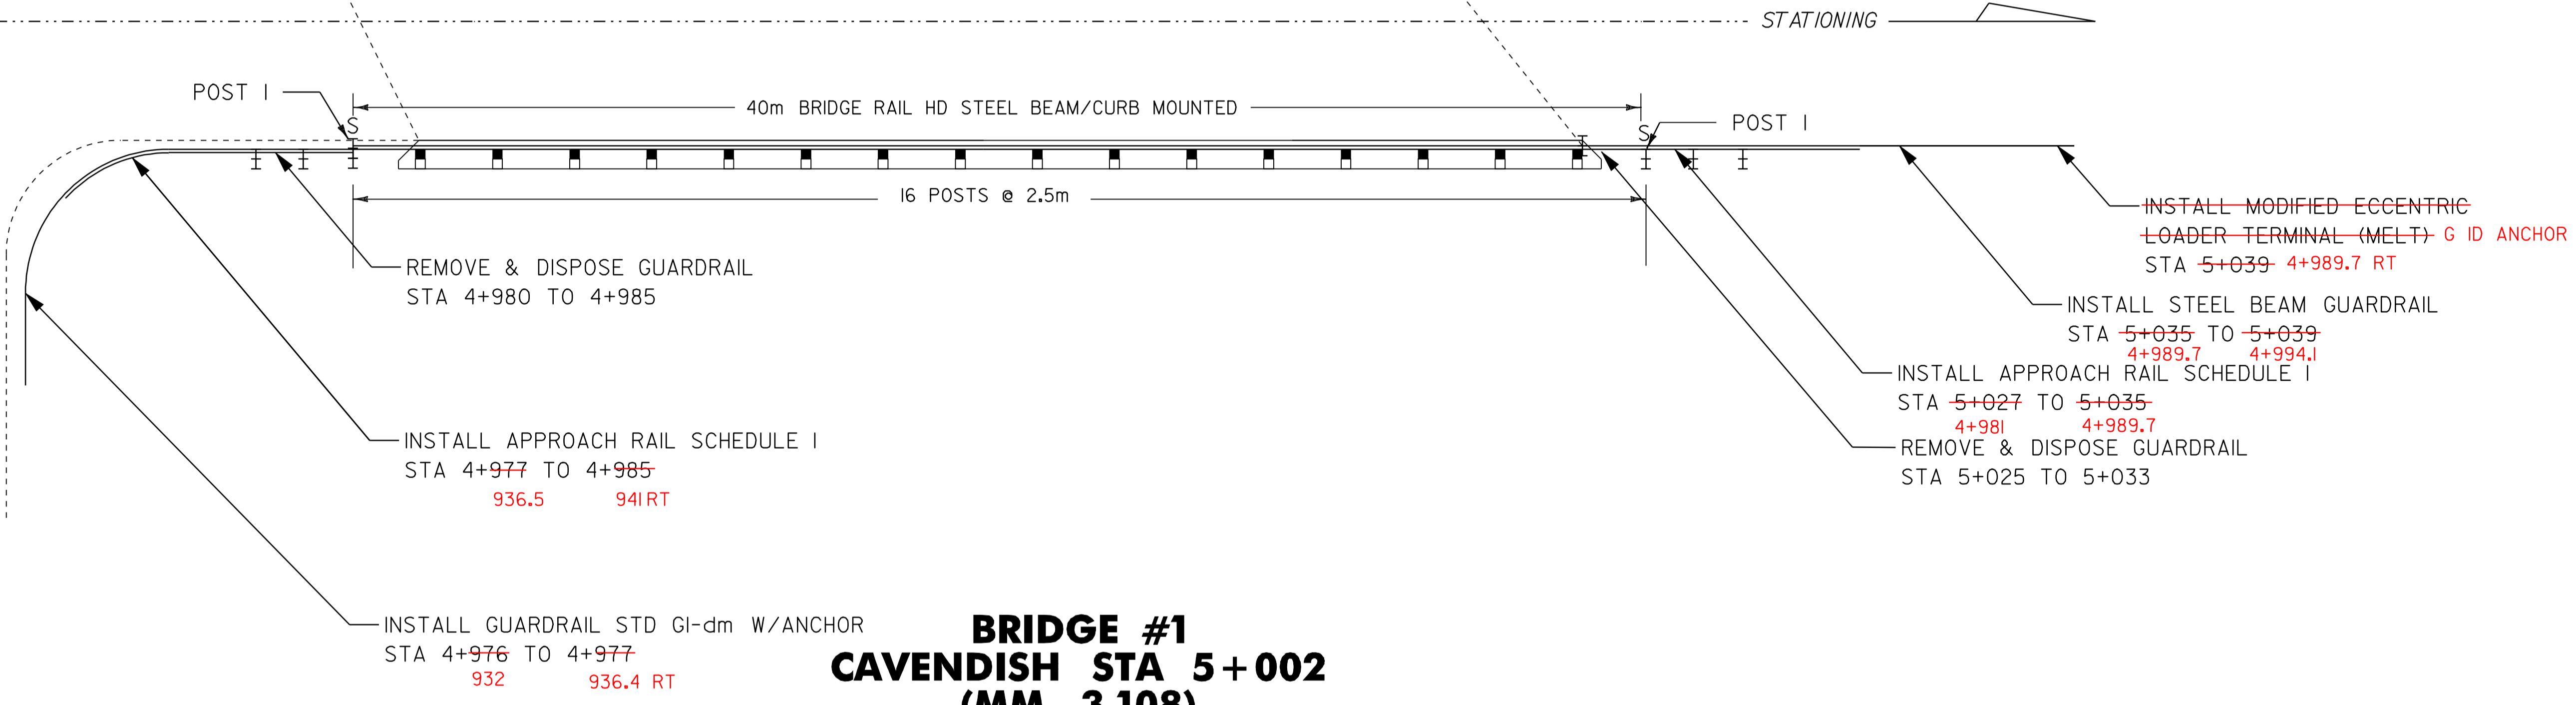

**BRIDGE #1
CAVENDISH STA 5+002
(MM 3.108)**

STEEL BEAM GUARDRAIL

STA 4+968 940	TO	4+969	LT 945
STA 4+976 932	TO	4+977	RT 936.4
STA 5+024 002	TO	5+031	LT 011
STA 5+035 4+989.7	TO	5+039	RT 4+994.1

ANCHOR FOR STEEL BEAM RAIL

STA 4+968	LT 845
STA 4+977	RT 936
STA 5+031	LT 006
STA 4+990	RT
MODIFIED ECCENTRIC LOADER TERMINAL	
STA 5+039	RT

HEAVY DUTY STEEL BEAM GUARDRAIL

STA 4+969 945	TO	4+978	LT 960
936.5 STA 4+977	TO	4+985	RT 941
4+981 STA 5+016	TO	5+024	LT 4+989.7 RT
STA 5+027 4+995	TO	5+035	RT 002 LT

REMOVAL & DISP. OF GUARDRAIL

STA 4+971 945	TO	4+978	LT 973
STA 4+980	TO	4+985	RT
4+992 STA 5+016	TO	5+035	LT 011
STA 5+025	TO	5+033	RT

**ARCHIVED
IN DPR**

NOTE: ALL DIMENSIONS IN MILLIMETERS EXCEPT AS INDICATED

DATUM	_____
VERTICAL	_____
HORIZONTAL	_____

NOT TO SCALE

BRIDGE DETAIL SHEET	PROJECT: CAVENDISH - WEATHERSFIELD	PROJECT NO.: STP 9661(1) S
	DESIGN FILE NAME: /pave/95c134/pol34.dgn	PLOT DATE: 27-JAN-2006
	IPARM FILE NAME: pol34br1.i	SURVEY DATE: 06/97
	SURVEYED BY: CLD Inc.	DRAWN BY: JPC
	SQUAD LEADER: JAW	SHEET: 30 OF 32