



**TYPICAL SECTION
COLD PLANE WITH EXISTING CURB
AND SIDEWALK TO REMAIN LT & RT**
VT. ROUTE 67A STA. 5+160.000 - STA. 5+338.194

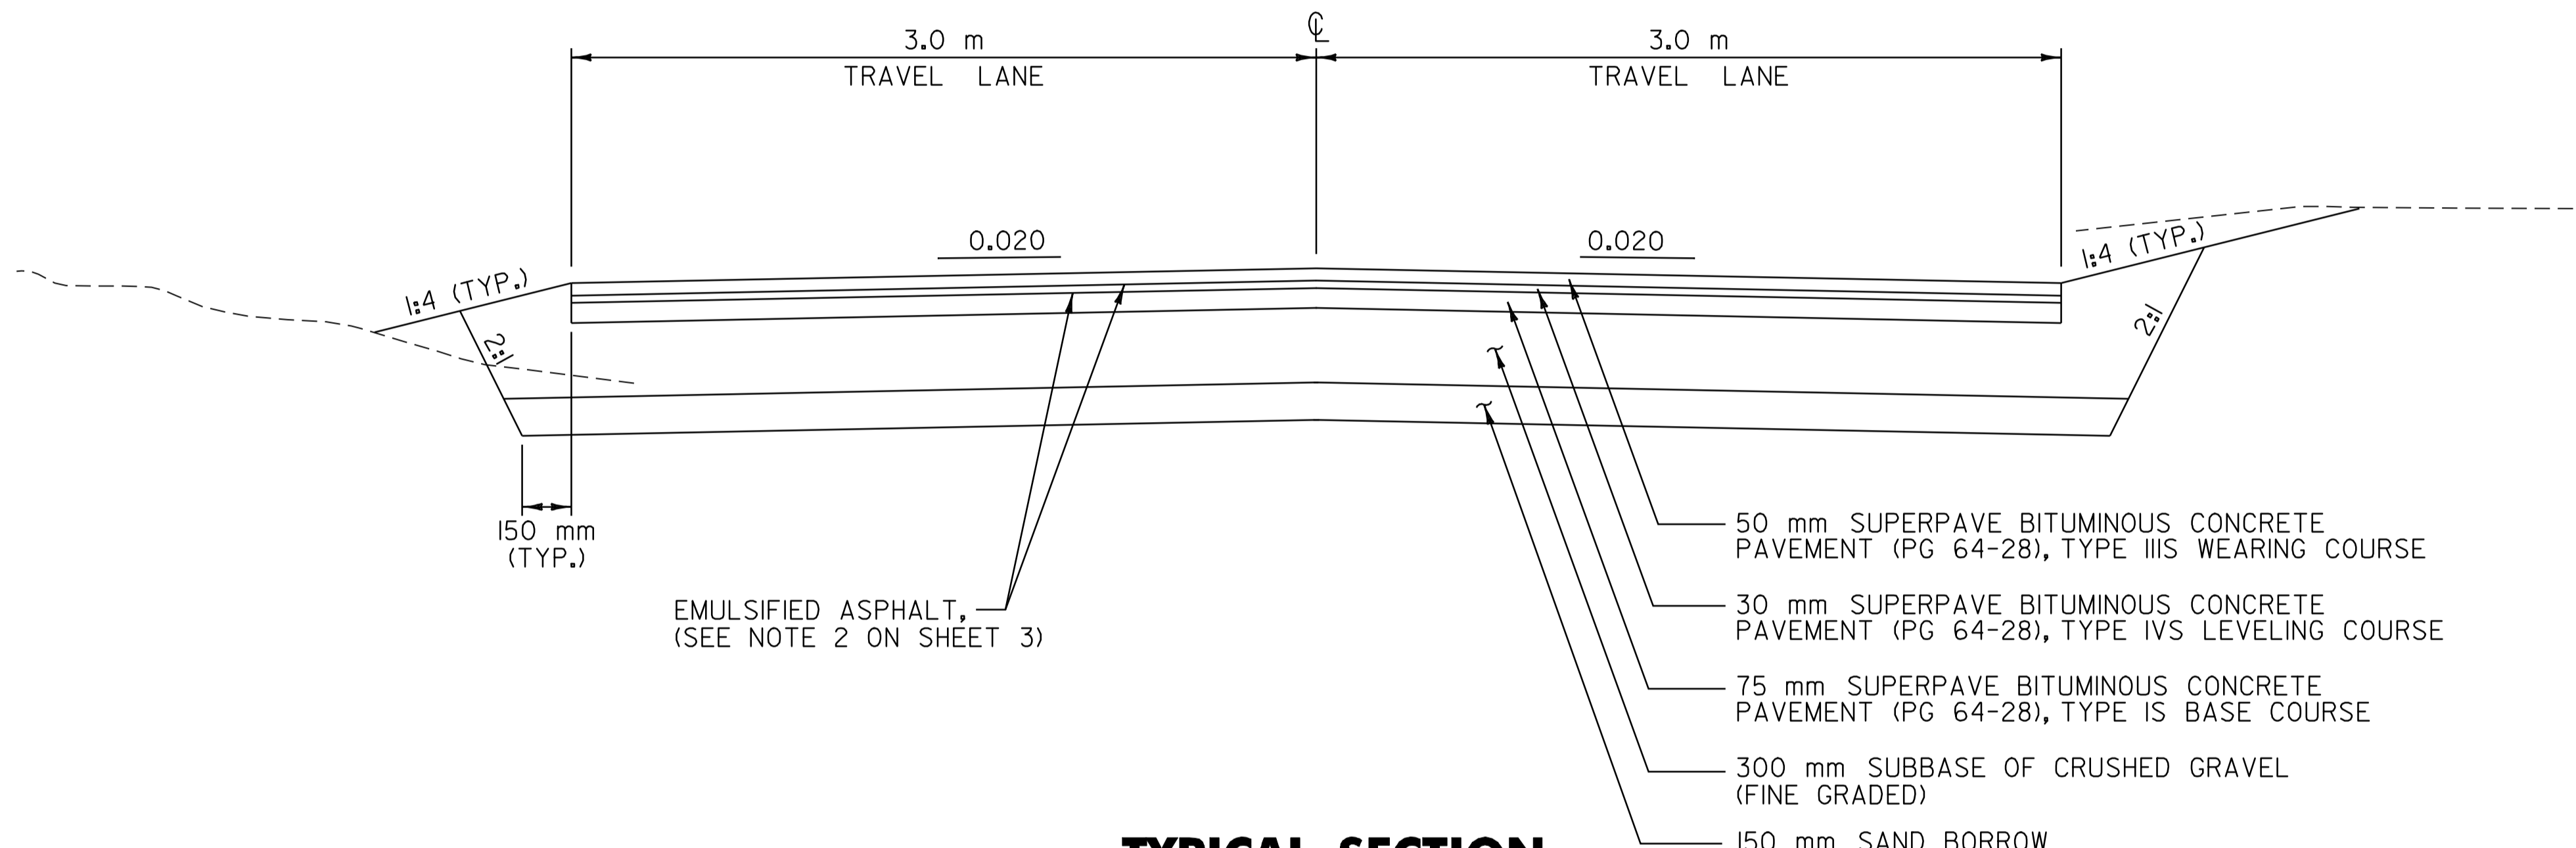

**TYPICAL SECTION
RIVER ROAD**
STA. R I+000.000 - STA. R I+060.000

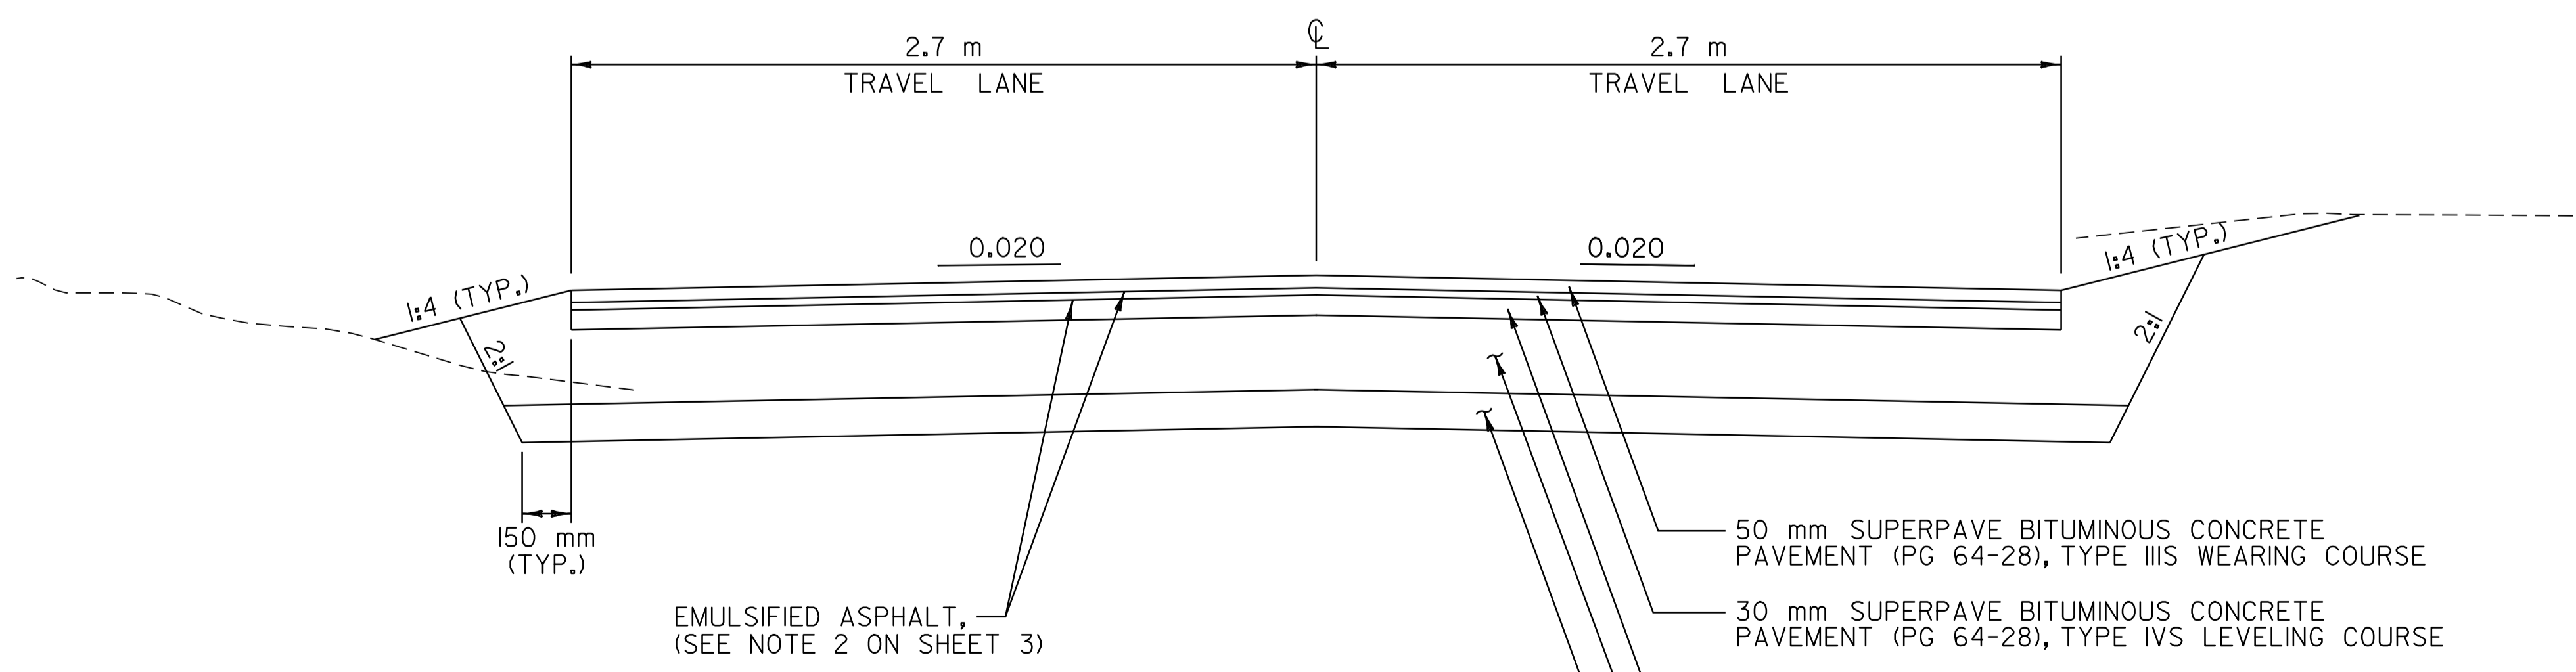

**TYPICAL SECTION
HILLSIDE STREET**
STA. H I+000.000 - STA. H I+060.000

URBAN AREA SEED MIXTURE

% MASS	kg/ha.	NAME	PUR.%	GERM.%
42.2	38.0	CREEPING RED FESCUE	98	85
10.0	9.0	PERENNIAL RYEGRASS	95	90
42.2	38.0	KENTUCKY BLUEGRASS	85	85
5.6	5.0	ANNUAL RYEGRASS	95	85
100.0	90.0			

SEED MIXTURE:
SHALL NOT HAVE A WEED CONTENT EXCEEDING 0.40% BY MASS AND SHALL BE FREE OF ALL NOXIOUS SEED.

SEED:
TO BE APPLIED PER SEEDING FORMULA OR AS DIRECTED BY THE RESIDENT ENGINEER.

FERTILIZER:
FORMULA 10-20-10 TO BE USED WITH SEED, APPLIED AT THE RATE OF 560 kg/ha (HYDRO SEEDERS MAY USE 19-19-19 FORMULA)

AGRICULTURAL LIMESTONE:
TO BE APPLIED AT THE RATE OF 4.5 tons/ha OR AS DIRECTED BY THE RESIDENT ENGINEER.

HAY MULCH:
TO BE APPLIED ON EARTH SLOPES AT THE RATE OF 4.5 tons/ha OR AS DIRECTED BY THE RESIDENT ENGINEER.

TOPSOIL:
TO BE USED WITH SEED AS INDICATED ON THE PLANS OR AS DIRECTED BY THE RESIDENT ENGINEER.

DATUM	
VERTICAL	N/A
HORIZONTAL	NAD83 (1996)

PROJECT TYPICAL SHEET 2	SURVEYED BY <u>L.R.S.C.</u> DATE <u>4/03</u>
	DRAWN BY <u>C.A.K.</u> DATE <u>3/06</u>
	SQUAD LEADER <u>D.E.G.</u>
	DESIGN FILE NO. <u>/pave/95dl04/pdl04.dgn</u>
	IPARM FILE <u>pdl04pt2.1</u> DATE <u>20-AUG-2010 12:</u> PLOT DATE
PROJ. NAME	NORTH BENNINGTON
PROJ. NO.	STP 9646(I)S
SHEET 4 OF 151	SHEETS